

PERMIT

SEWAGE DISPOSAL SYSTEM

MARYLAND STATE DEPARTMENT OF HEALTH

HOWARD COUNTY

BUREAU OF ENVIRONMENTAL HEALTH
461-9933

INDEXED

04-337840

P 45618

A 45464

DISTRICT 4th

DATE 2/28/90

DATE SYSTEM APPROVED 3/16/90

INSPECTOR C. B. A. 47

House
Connect
as

Fogle's Septic Service, Inc. IS PERMITTED TO INSTALL ☒ ALTER ☐

ADDRESS 558 Obrecht Road, Sykesville, Maryland 21784 PHONE 795-5670

SUBDIVISION Rover Mill Estates ROAD 14009 Tall Ships Dr. LOT 5

PROPERTY OWNER Ronald J. & Carole B. Eber

ADDRESS

~~IF GARBAGE GRINDER IS USED INCREASE SEPTIC TANK CAPACITY BY 50% AND ABSORPTION AREA BY 25%~~

~~GARBAGE GRINDER XXXXXX XXXXXXXXXXXXXXXXXXXX~~

SEPTIC TANK CAPACITY 1500 GALLONS NUMBER OF BEDROOMS 5

TRENCHES - 180 sq. ft. per bedroom. Trench to be 2 feet wide. Inlet 3 feet below original grade. Bottom maximum depth 8 feet below original grade. Effective area begins at 3 feet below original grade. 5 feet of stone below distribution pipe.

LOCATION = Place the distribution box 110 feet from the well approximately 160 feet from the rear lot line and 230 feet from the right lot line as seen when facing the property from Tall Ships Drive. Run trenches along contour toward right side of lot.

NOTE - No trench to exceed 100 feet in length. Provide 6" - 8" diameter cleanout and cap to grade or above on septic tank. *ok/cw*

PLANS APPROVED BY C. Williams DATE 2/16/90

COVER NO WORK UNTIL INSPECTED AND APPROVED

NEITHER THE HOWARD COUNTY COUNCIL NOR THE HEALTH DEPARTMENT IS RESPONSIBLE FOR THE SUCCESSFUL OPERATION OF ANY SYSTEM

NOTE: CLEANOUT REQUIRED EVERY 70 FEET OF SEWER LINE AND/OR AT 90° SWEEPS IN LINES FROM HOUSE TO DRAIN FIELDS

NOTE: ALL PARTS OF SEPTIC SYSTEMS (I.E. TANK, DISTRIBUTION BOX, TRENCHES) TO BE 100 FEET FROM WELL (UNLESS OTHERWISE SPECIFICALLY AUTHORIZED)

NOTE: IF DEEP TRENCHES ARE USED CALL FOR INSPECTION BEFORE AND AFTER PLACING GRAVEL IN TRENCHES

NOTE: NO DRY WELL SHALL EXCEED 15 FOOT IN DIAMETER NO ABSORPTION TRENCH TO EXCEED 100 FEET IN LENGTH

NOTE: ALL PIPE FROM HOUSE TO SEPTIC TANK MUST BE CAST IRON OR SCHEDULE 40 PVC OR ABS

PERMIT VOID AFTER TWO YEARS

NOTE: INSTALL STAND PIPE ON SEPTIC TANK AND DRY WELL. STAND PIPES MUST BE 6 INCHES IN DIAMETER. CAST IRON, CONCRETE OR TERRA COTTA OR PVC OR ABS ACCEPTED. IF TOP OF SEPTIC TANK IS DEEPER THAN 3 FEET, MANHOLE TO GRADE REQUIRED

NOTE: DISTRIBUTION BOXES MUST HAVE BAFFLES

BLDG. PERMIT SIGNED

AND RETURNED 10-22-98

Seal # B10 114673

Call for inspection


new price

*INSTALLER IS RESPONSIBLE FOR OBTAINING FINAL APPROVAL ON THIS PERMIT

*CALL 461-9933 FOR INSPECTION OF SEPTIC SYSTEMS.

45464

T-32
B-10

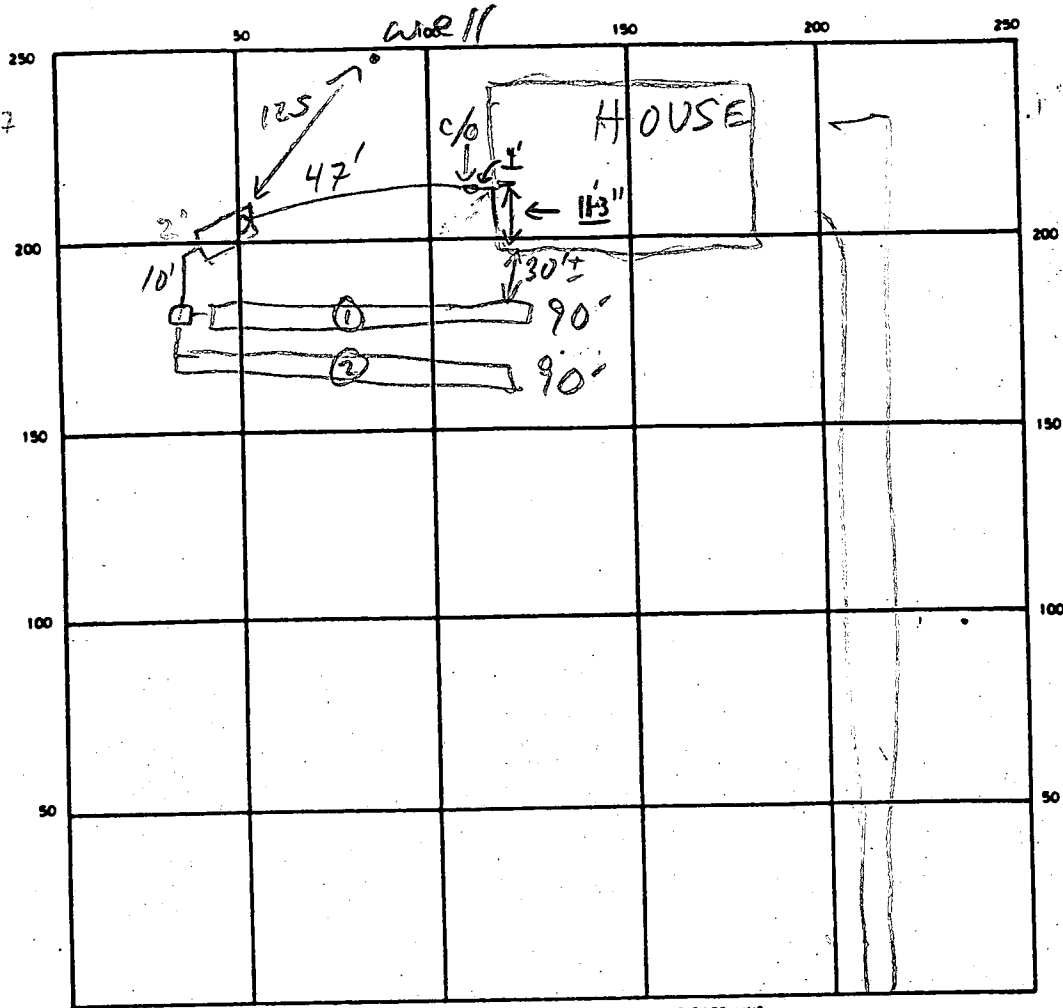

INDICATE NORTH - NAME ADJOINING ROADWAY AS BASE LINE

TALL SHIPS DR

SEPTIC TANK LEVEL 1500 GAL-OK CLEANOUTS OK

DISTRIBUTION BOX LEVEL OK BAFFLE IN

DRAIN FIELD/TILE FIELD. DEPTH 8 FT. TRENCH WIDTH 2 FT. INLET DEPTH 3 FT.

EFFECTIVE GRAVEL DEPTH 5 FT. TOTAL LENGTH 180 FT.

NUMBER OF TRENCHES 2 ONE SIDEWALL/BOTTOM AREA 1450 SQ. FT.

DRYWELL INSIDE DIAMETER — FT. EFFECTIVE DEPTH BELOW INLET — FT.

ABSORBENT AREA 900± SQ. FT.

REMARKS 2/22/90 OK TO CONTINUE, NO HOUSE CONN MR
3/16/90 OK TO COVER - FINAL
C.B.R.

DATE SYSTEM APPROVED 3/15/90 INSPECTOR Charles Bryan Thurst

APPLICATION

PERCOLATION TESTING

A 45464

P _____

HOWARD COUNTY HEALTH DEPARTMENT
BUREAU OF ENVIRONMENTAL HEALTH
P.O. BOX 476 ELLICOTT CITY, MARYLAND 21043
TELEPHONE: 461-9933

DISTRICT _____

DATE 1/25/90

Preview incomplete.
Need more info from
owner as to perc locations
for retest. 1-26-90 JEN

TO: THE COUNTY HEALTH OFFICER
ELLICOTT CITY, MARYLAND

I, HEREBY, APPLY FOR THE NECESSARY TEST IN ORDER TO CONSTRUCT (OR RECONSTRUCT) A SEWAGE DISPOSAL SYSTEM.

PROPERTY OWNER Ronald J. Eber

ADDRESS 517 Washington Rd., Westminster, MD. 21157 PHONE 848-7904

PROSPECTIVE BUYER None

ADDRESS _____ PHONE _____

PROPERTY LOCATION:

SUBDIVISION Rover Mill Estates LOT NO. 5

ROAD AND DESCRIPTION 14009 Tall Ships Drive

Building Permit No. 30707

TAX MAP _____ PARCEL # _____

SIZE OF LOT 2.954 Acres TYPE BLDG. Single Family
(SINGLE FAMILY DWELLING OR COMMERCIAL)

THE SYSTEM INSTALLED UNDER THIS APPLICATION IS ACCEPTABLE ONLY UNTIL PUBLIC FACILITIES BECOME AVAILABLE. I FULLY UNDERSTAND THE

FEE CONNECTED WITH THE FILING OF THIS PERC TEST APPLICATION IS NON-REFUNDABLE UNDER ANY CIRCUMSTANCES. I ALSO AGREE TO COMPLY

WITH ALL M.O.S.H.A. REQUIREMENTS IN TESTING THIS LOT. Ronald J. Eber
(SIGNATURE OF APPLICANT)

APPROVED BY C Waller FOR TROUCHES DATE 2/14/90

REJECTED BY _____ FOR _____ DATE _____

HOLD PENDING FURTHER TESTS _____ DATE _____

REASONS FOR REJECTION OR HOLDING BUILDING TO SUBMIT CP REVISION

BUDG. PERMIT SIGNED
AND RETURNED 2/14/90

Serial 431707-SFD-
5 Bedrooms

THIS IS NOT A PERMIT

12


3

CLAY
LOAM
TO 10'
ROCK
FRAGMENTS

4

12

12 +

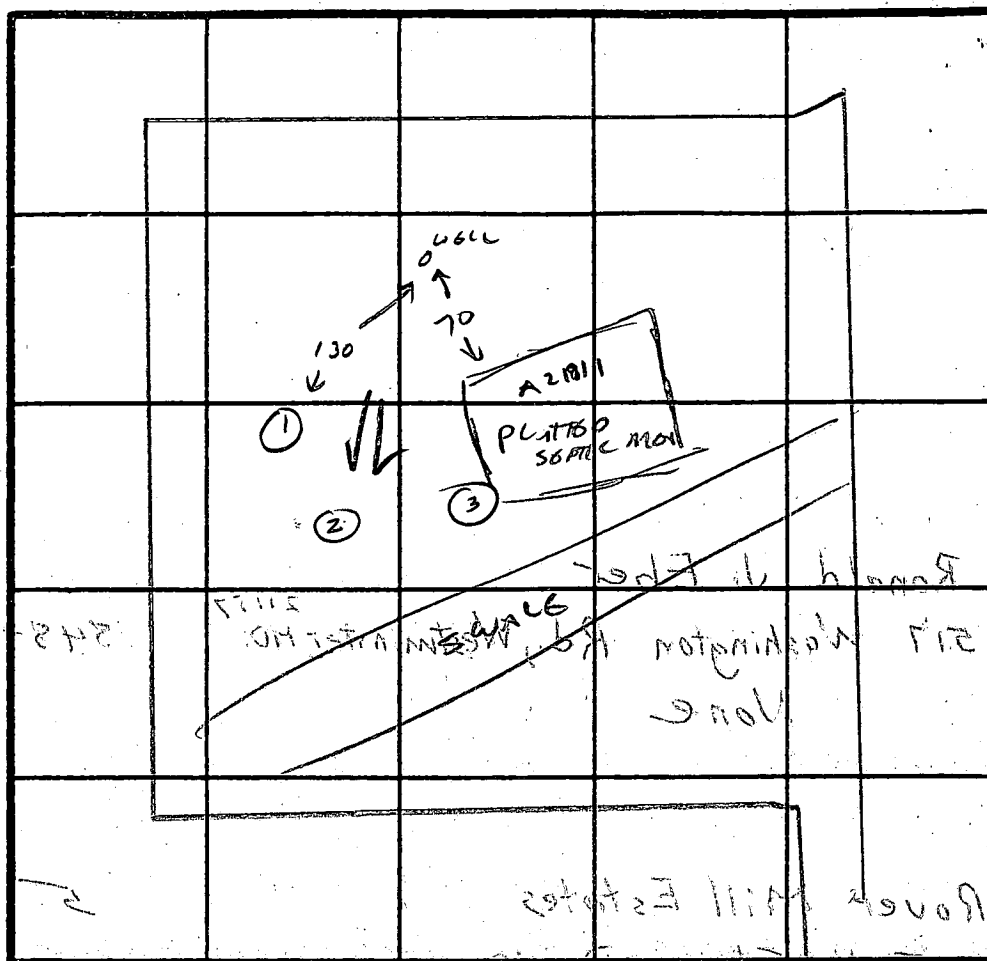

INGOT $3\frac{1}{2}$
~~180~~

INDICATE NORTH - NAME ADJOINING ROADWAY AS BASE LINE

DATE	TEST NO.	DEPTH	PRE-WET		TEST - 1" DROP		TIME
			START	STOP	START	STOP	
2/8/98	1	4 8	10:07	10:09	10:09	10:11	2 MIN
	2	12			2:00 PM	2:00 PM	
	2	4 8	10:09	10:11	10:11	10:14	3 MIN
		12					
	3	12	VIS. OK - AT EDGE OF MASON SWALE				
			KEEP SEATTLE AREA TO HIGH SIDE OF THIS HOLE.				

REMARKS WELL TOO CLOSE TO PLATTED SCOTCH ALGA, P61C TO ADJUST ALGA

REMARKS TO ACCOMMODATE HOUSE & WELL SITE,
SWALES AND COMPLEX TOPOGRAPHY DICTATE START SYSTEM AT

TESTED BY C. Wilton / G. Mellon HIGH SIDE OF HOLE 1 - OTHERWISE OK
ALSO PRESENT BP REVISION TU

~~ALSO PRESENT~~ BP REVISION TO BS SUBMITTED
↓
DAYS FUGG, AUL 05

APPLICATION

A 21811

P _____

SEWAGE DISPOSAL TESTING

STATE OF MARYLAND - DEPARTMENT OF HEALTH AND MENTAL HYGIENE

HOWARD COUNTY HEALTH DEPARTMENT
ENVIRONMENTAL HEALTH SERVICESP. O. BOX 476, ELLICOTT CITY, MARYLAND 21043
TELEPHONE: 465-5000, EXT. 356DISTRICT 4DATE 7/14/75TO: THE COUNTY HEALTH OFFICER
ELLICOTT CITY, MARYLAND

I, HEREBY, APPLY FOR THE NECESSARY TEST IN ORDER TO CONSTRUCT (OR RECONSTRUCT) A SEWAGE DISPOSAL SYSTEM.

PROPERTY OWNER John J. and Evelyn Keenan
C/O Chas. H. Steffey, Inc.
ADDRESS 9338 Baltimore Nat'l Pike PHONE 465-8500
Ellicott City, Md.

PROPERTY LOCATION:

SUBDIVISION Rover Mill Rd. Addition ~~XXXXXXXXXXXX~~ Estates - Addition LOT NO. 5ROAD AND DESCRIPTION Road 'A'
Rover Mill Rd. to Road A & 'A'SIZE OF LOT 3.0Ac. TYPE BLDG. 4 Bedroom
NUMBER OF BEDROOMS

IF NOT SINGLE RESIDENCE DESCRIBE _____

THE SYSTEM INSTALLED UNDER THIS APPLICATION IS ACCEPTABLE ONLY UNTIL PUBLIC FACILITIES BECOME AVAILABLE.

SIGNATURE OF APPLICANT John J. Keenan
by nrsAPPROVED BY _____ FOR _____ DATE _____
(KIND OF SYSTEM)REJECTED BY _____ FOR _____ DATE _____
(KIND OF SYSTEM)

HOLD PENDING FURTHER TESTS _____ DATE _____


REASONS FOR REJECTION OR HOLDING _____

THIS IS NOT A PERMIT

Lot 5

Old Route Rd

Lot 6

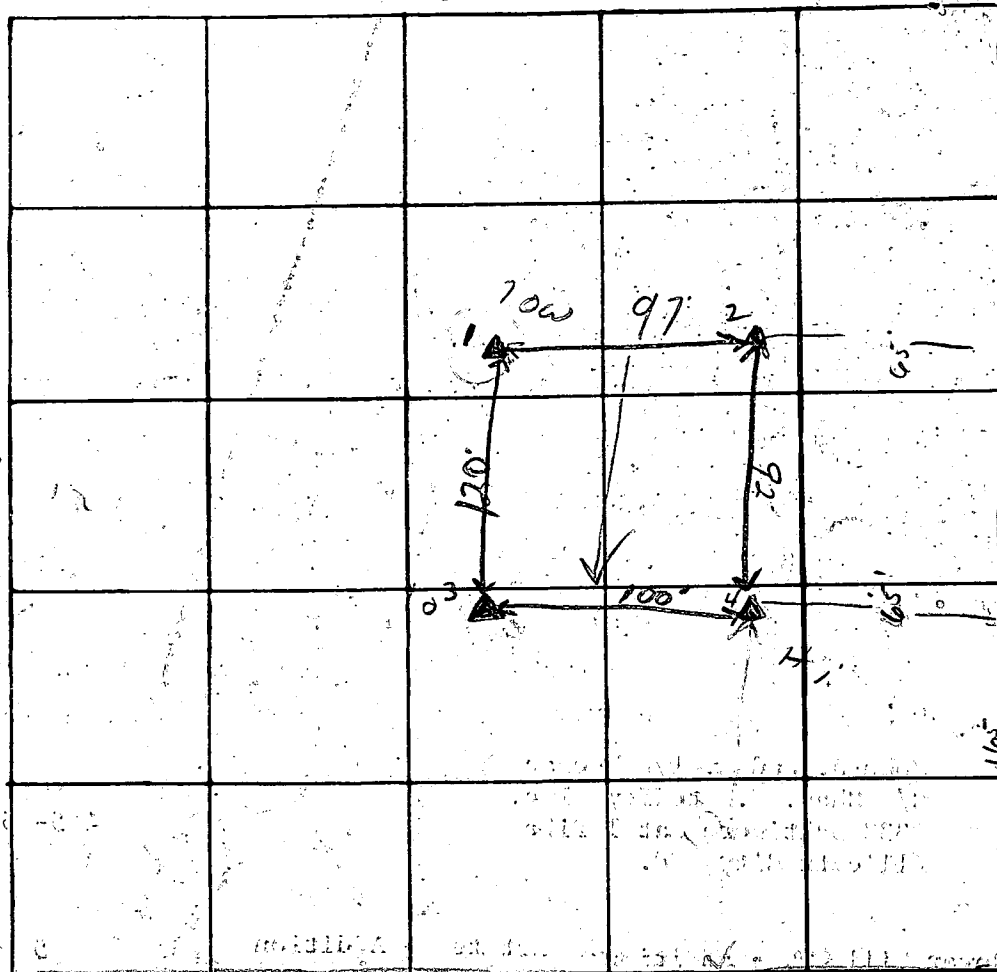

INDICATE NORTH - NAME ADJOINING ROADWAY AS BASE LINE.

Lot 4

DATE	TEST NO.	DEPTH	PRE-WET		TEST - 1" DROP		TIME
			START	STOP	START	STOP	
8-7-75	15	4 1/2'	1150	1156	1156	1200	4
	10	11 1/2'	1150	1155	1155	1201	6
	2	VISUAL	SILT-LOAM SAME AS ALL OTHERS				
			4-11 1/2' -				
	35	4'	1155	1200	1200	1212	12
	30	11'	1155	1159	1159	1200	3
	45	3'	1220	1235	1235	1245	10
8-7-75	40	13'	1220	1230	1230	1235	5

ABSORBANT AT 2 1/2'

REMARKS

TYPE OF SOIL

TESTED BY

Silt-Loam
H2. DJON

ALSO PRESENT:

FYOCK & ASSOC.



HOWARD COUNTY HEALTH DEPARTMENT

Joyce M. Boyd, M.D., County Health Officer

February 21, 1990

Reply to:

Craig Williams, Director
461-9933 or 461-9934

Mr. Nick Musgrove
"A" Frame Unlimited
1608 Pin Knob Road
Sykesville, Maryland 21784

Re: Building Permit No. 30707
Rover Mill Estates - Lot 5
14009 Tallships Drive

Dear Mr. Musgrove:

You will recall that relative to the above referenced property, the submitted building permit application revealed that the well had been drilled at a location that conflicted with the platted sewage reserve area and the house was proposed for a location that also conflicted with the platted sewage reserve area.

To remedy these problems a percolation re-test was conducted February 8, 1990, which allowed modification of the sewage reserve area. A very informal plat was accepted, sufficient to allow issuance of the building permit and septic system permit. The house and septic system are currently under construction.

As discussed with you in the field on February 20, the adjusted house and septic location are acceptable to this office. However, if additions or other structures are proposed, problems may arise because the location of the adjusted septic reserve area is so sketchy.

To protect against a problem developing, an "as-built" percolation certification plat by a registered engineer must be submitted through this office for Health Officer's signature prior to occupancy approval. This plat should provide scaled, accurate location of the well, house, installed septic system, and adjusted septic reserve area, as well as the drainage easement. I would suggest that this document could most conveniently be generated when the routine "wall check" plat is developed.


Bureau of Environmental Health

3525 Ellicott Mills Drive Ellicott City, Maryland 21043-4544

Director 461-9956 Water and Sewerage, Permits 461-9933 Community Environmental Health 461-9944
Technical Services 461-9955

Also, please be certain to request inspection by this office when the septic system is connected to the house. In many cases, when the septic system is installed before the house plumbing is complete, the builder incorrectly assumes that the final plumbing inspection provides approval of connection to the septic system. Failure to have the house connection inspected by the Health Department can delay final occupancy approval.

Yours truly

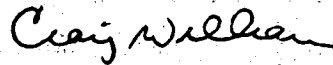

Craig Williams, Director
Water and Sewerage Program

CW:cm

A-FRAMES UNLIMITED INC.

NICKLAS E. MUSGRAVE
President



1680 Pine Knob Road
Sykesville, Md. 21784

Bus. (301) 795-7670

Res. (301) 781-7284

CAC 978 9270


A# 45464

LOT 5
ROUSE MILL ESTATES
14009 TAIL SHIPS RD
WEST FRIENDSHIP MD

Approved for Private Water and Sewer
Howard County Health Department.

Howard Country Health Officer

Date

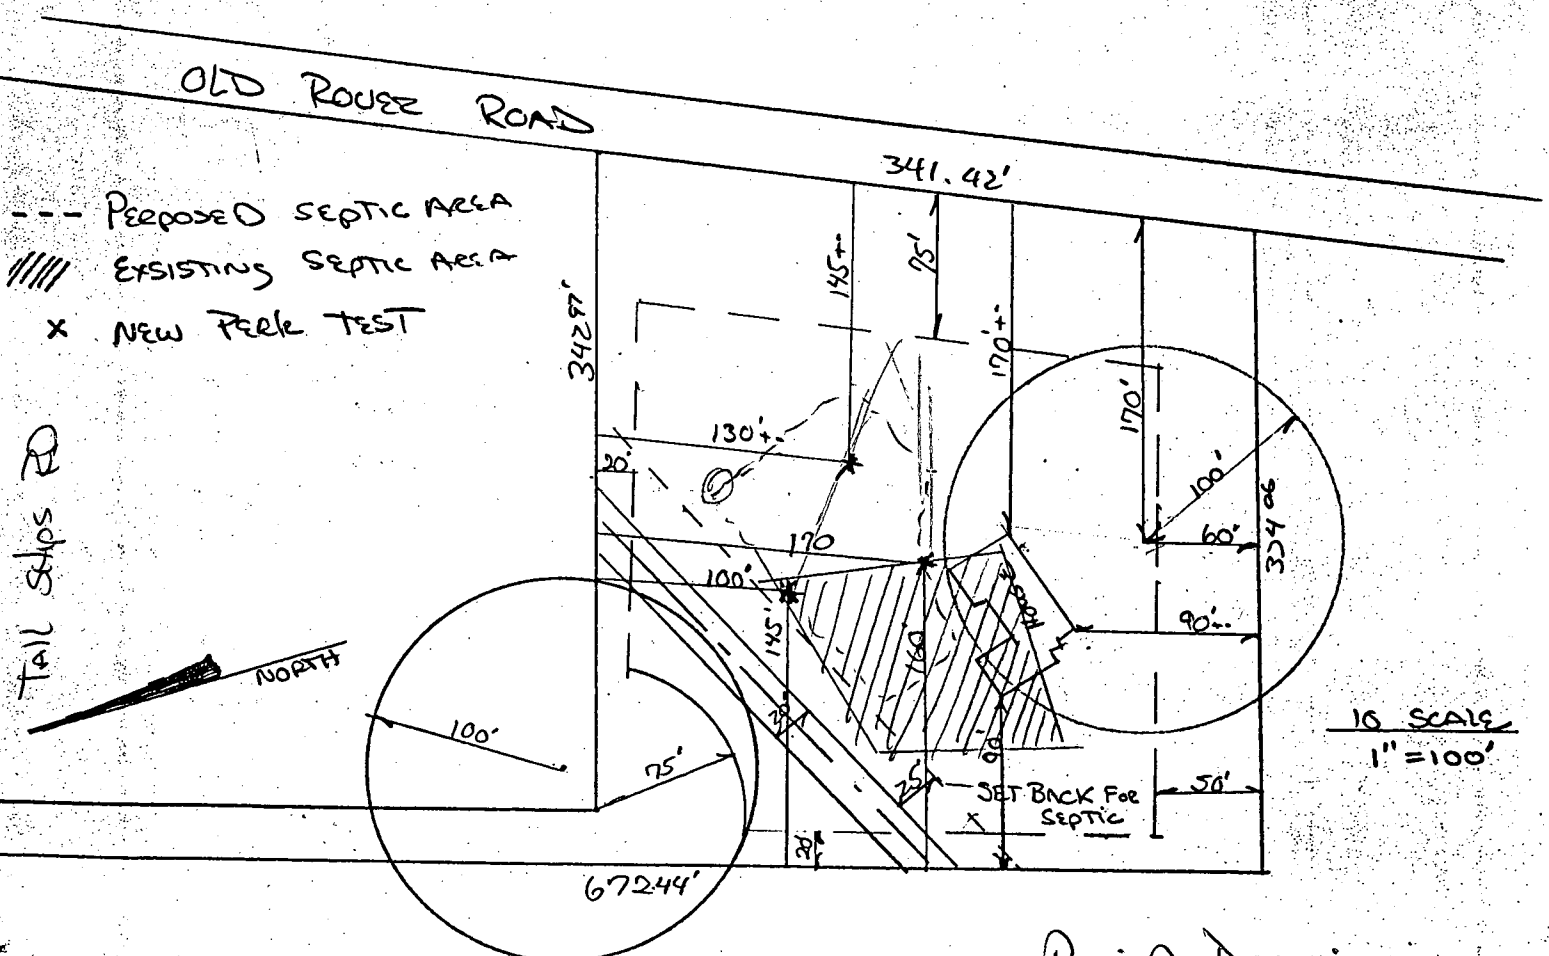

REUSED DRAWING

2-8-90

NEM.

Q 103

Tank 90.0

INVELEU out of
House 91.4



20 SCALE

$$S'' = 100$$

INC. E/EC (INTC)

Dist. Box 86

INV ELEU. INFO

Septic tank 87.4


INVELEC.(INTO)

trench 85.5

EXISTING ELEV. AT DIST. BOX 885

EXIST ELEMENT TREES

87.5

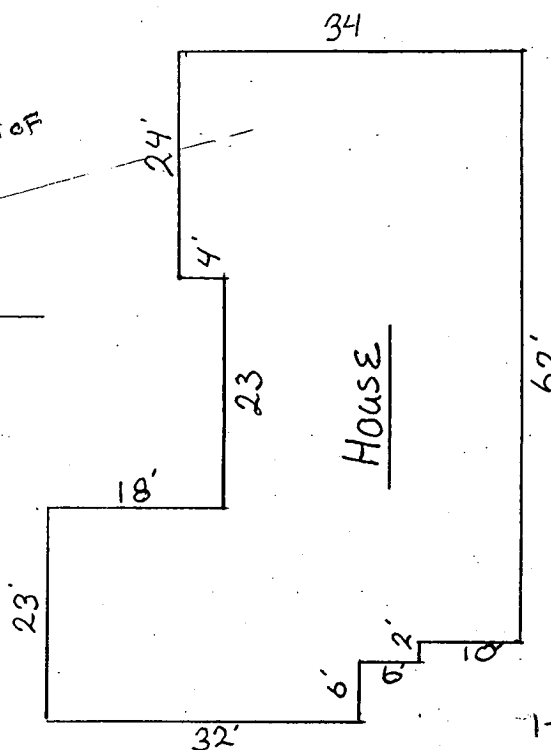


FF ELEVA 100

BFLEUA 92


1-29-90

Order confirmed
that well had not
been drilled in approved
location because it
was wooded and
difficult to get
to. No approval
for this well site by
Health Dept. JEN

OLD ROVER ROAD

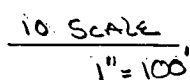

NORTH

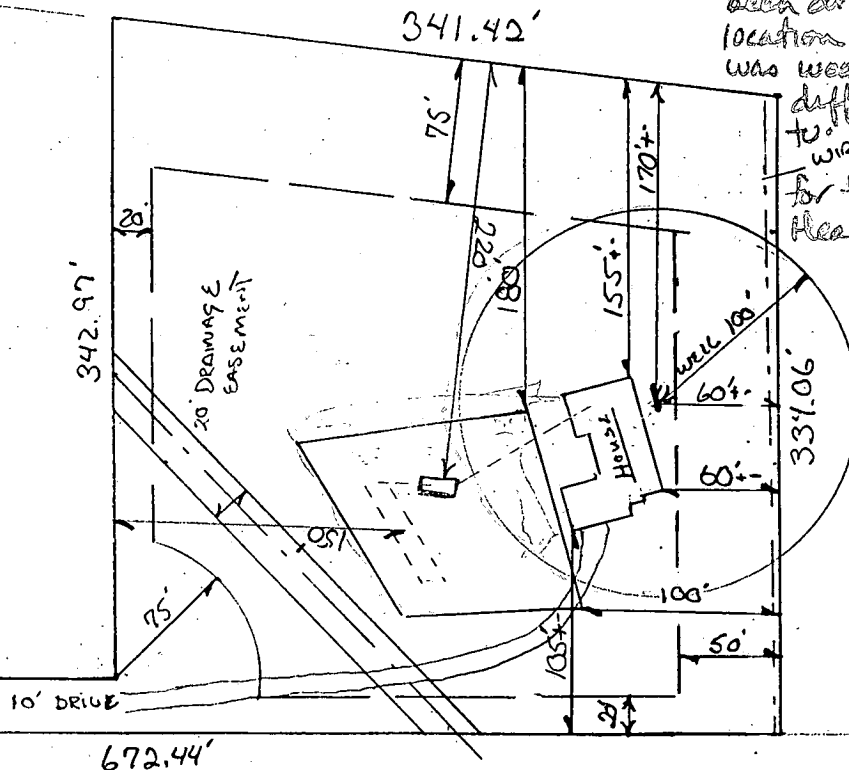

LOT 5

ROVER MILL ESTATES
14009 TALL SHIPS DRIVE
WEST FRIENDSHIP, MD

RONALD J. AND CAROLE EBER
517 WASHINGTON RD
WESTMINSTER MD 21157
848-7904

LOT 5

ROVER MILL ESTATES

14009 TAIL SHOPS DR

WEST FRIENDSHIP MD

Approved for Private Water and Sewer
Howard County Health Department.

Howard County Health Officer

Date

Percolation

CERTIFICATION

PLAT

PERMIT # 30707

THIS INFORMATION IS
BASED UPON FIELD
MEASUREMENTS AND IS
CORRECT TO THE BEST OF
MY ABILITY

Phil S. Meyer P.E.D.

2-14-90

REVISED SEPTIC AREA
ACCEPTED

BP 30707 SIGNED
2/14/90

PLAT NOT SENT
FOR HEALTH OFFICER'S
SIGNATURE,
TOO INFORMAL TO
BE ACCEPTED,
Althea

NOTE:

1. THIS AREA IS DESIGNATED AS A PRIVATE SEWAGE EASEMENT OF 10,000 SQUARE FEET AS REQUIRED BY THE MARYLAND DEPARTMENT OF THE ENVIRONMENT FOR INDIVIDUAL SEWAGE DISPOSAL. IMPROVEMENTS OF ANY NATURE IN THIS AREA ARE RESTRICTED UNTIL PUBLIC SEWAGE IS AVAILABLE. THESE EASEMENTS SHALL BECOME NULL AND VOID UPON CONNECTION TO A PUBLIC SEWAGE SYSTEM. THE COUNTY HEALTH OFFICER SHALL HAVE THE AUTHORITY TO GRANT VARIANCES FOR ENCROACHMENTS INTO THE PRIVATE SEWAGE EASEMENT. RECORDATION OF A MODIFIED SEWAGE EASEMENT SHALL NOT BE NECESSARY.


OLD ROVER ROAD

Proposed Septic

* NEW PERK TEST

TOPOG

TAIL SHOPS RD

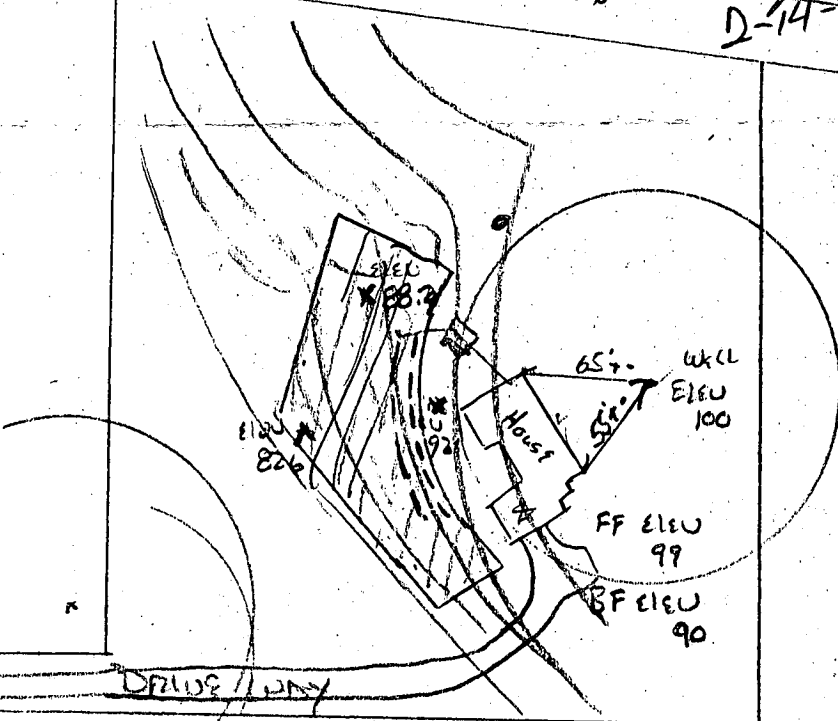


Phil S. Meyer
2-14-90

10 SCALE
1" = 100'

LIST 2120 AT DIST BOX 91

ELEVATIONS OF
2/14/90
C. W. L. H. A. R.

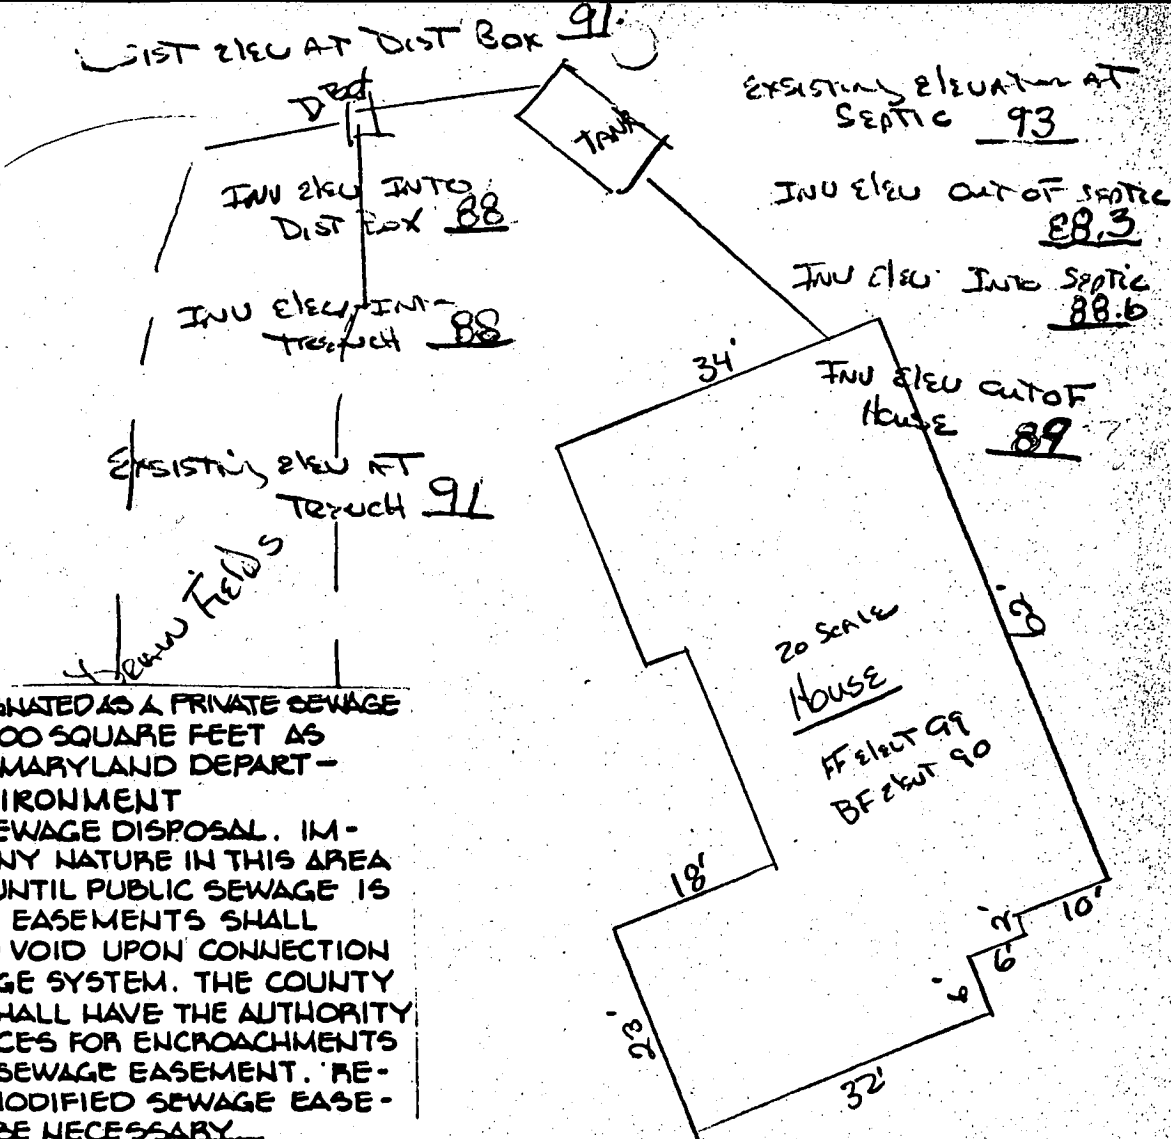

NOTE:

1. THIS AREA IS DESIGNATED AS A PRIVATE SEWAGE EASEMENT OF 10,000 SQUARE FEET AS REQUIRED BY THE MARYLAND DEPARTMENT OF THE ENVIRONMENT FOR INDIVIDUAL SEWAGE DISPOSAL. IMPROVEMENTS OF ANY NATURE IN THIS AREA ARE RESTRICTED UNTIL PUBLIC SEWAGE IS AVAILABLE. THESE EASEMENTS SHALL BECOME NULL AND VOID UPON CONNECTION TO A PUBLIC SEWAGE SYSTEM. THE COUNTY HEALTH OFFICER SHALL HAVE THE AUTHORITY TO GRANT VARIANCES FOR ENCROACHMENTS INTO THE PRIVATE SEWAGE EASEMENT. RECORDATION OF A MODIFIED SEWAGE EASEMENT SHALL NOT BE NECESSARY.

OLD POWER ROAD


Mark E. Meyer
2-14-90

Perseps O Septic

NEW PERK TEST

TO FOG

TAIL SHOPS RD

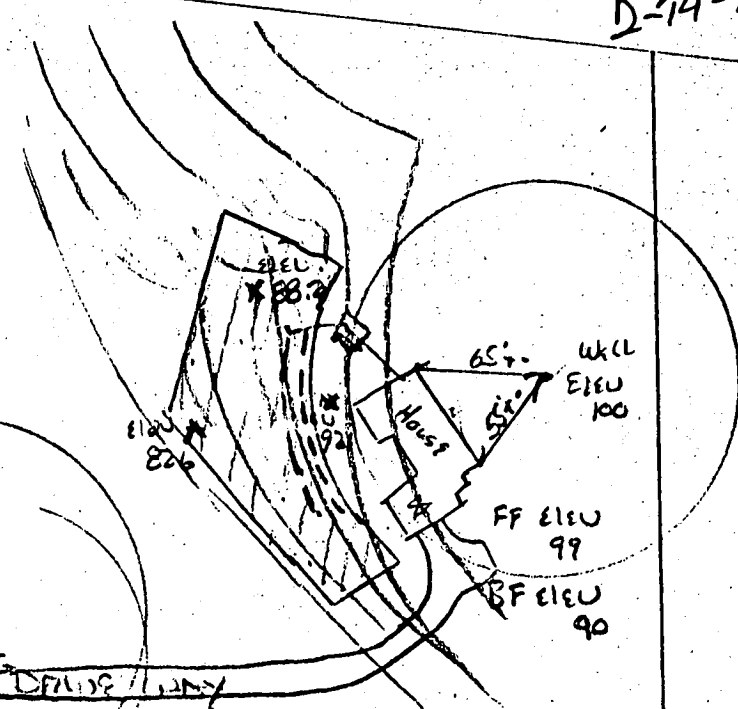

10 SCALE
1" = 100'

9	0818.58	10581.82					
8	10024.60	9986.42	37-38	1223.00	256.85	170.87	11-47-37 S 07°33' 40" E 756.53'
32	10711.88	10168.86					
33	10600.41	10334.37					
34	10498.81	10780.44					
35	10477.25	10020.98					
36	10424.31	10814.02					
37	10454.65	10756.86					
38	10552.58	10519.85					
39	10844.03	10152.34					
40	10687.27	10057.18					
41	10738.42	10066.37					
42	10376.12	9979.08					
77	10428.38	10835.53					
78	10493.42	10887.18					
80	10423.72	10879.82					
81	0812.22	10594.86					
41A	10742.84	10967.42					

ROVE
505°05'43"W
573°07'37"E 23.45'

1

2°37'00" L 844'
U 53°27'29"E 59.65'
U 53°27'54"E 41.76'
U 61°00'00"E 45.92'
39°07'37"E 330.11'

37°00'00" (X)

11,000
E 10,500

575°07'57"E
105.92'
OPEN SPACE 0.005Ac.
510°54'42"W5.

SHEET	SHEET 1 OF 6	SHEET 2 OF 6	SHEET 3 OF 6	SHEET 4 OF 6	TOTAL
TOTAL NUMBER OF LOTS TO BE RECORDED	0	0	0	11	11
TOTAL AREA OF LOTS	11,380 AC.-2	10,320 AC.-2	10,320 AC.-2	10,470 AC.-2	42,490 AC.-2
TOTAL AREA TO BE DEDICATED TO OR RESERVED FOR PUBLIC PURPOSES OF PUBLIC USES	0.00 AC.-2	0.00	0.00	0.00	0.000 AC.-2
TOTAL AREA OF ROAD	0.937 AC.-2	1.063 AC.-2	1.174 AC.-2	1.022 AC.-2	4.196 AC.-2
TOTAL AREA OF OPEN SPACE	3.771 AC.-2	0.000	0.00	0.00	3.771 AC.-2
TOTAL AREA OF SUBDIVISION	12,777 AC.-2	10,763 AC.-2	20,560 AC.-2	10,992 AC.-2	54,192 AC.-2

APPROVED: For private water and private sewerage
systems, Howard County Health Depart-
ment.
John P. Gorman 9-15-77
County Health Officer Date

APPROVED: Howard County Office of Planning and Zoning
Thomas L. Amig 9-19-77
 Director Date

APPROVED: For storm drainage systems, public road
Howard County Department of Public Works

OWNER'S CERTIFICATE

[illegible]

WITNESS MY HANDS THIS 29th DAY OF May 1961

SURVEYOR'S CERTIFICATE

I HEREBY CERTIFY THAT THE FINAL PLAT SHOWN HEREON IS CORRECT, THAT IT IS A SUBSTITUTION OF ALL OF THE LANDS CONVEYED BY MORRIS A. STIER AND ETHEL B. STIER, HIS WIFE, BY DEED DATED JANUARY 8, 1910, AND RECORDED IN THE LAND RECORDS OF HOWARD COUNTY IN LIBER C.M.P. 104 AT F210 163 AND ALL OF THE LANDS CONVEYED BY ETHEL WIFE BY DEED DATED SEPTEMBER 11, 1953 AND RECORDED IN THE LAND RECORDS OF HOWARD COUNTY IN LIBER C.M.P. 2ND AT FOLIO 303 AND THAT ALL MONUMENTS ARE IN PLACE AS SHOWN, IN ACCORDANCE WITH THE ANNOTATED CODE OF MARYLAND AS AMENDED.

PURDUM & JESCHKE
Consulting Engineers
Land Surveyors
1023 U. Calvert Street
Baltimore, Maryland 21202

SHEET 1 OF 4

ROVER MILL

3/16/90

HOWARD COUNTY HEALTH DEPARTMENT
Bureau of Environmental Health
3525-H Ellicott Mills Drive
Ellicott City, MD 21043
461-9933

3/16/90
Final
C.B.D.

APPLICATION FOR PITLESS ADAPTER, WELL PUMP AND PRESSURE TANK INSTALLATION

New Installation X
Replacement _____

Receipt # 45671
Date March 8 1990

Name of Installer Gartland Plumbing

Telephone 829-9238

License Number 6352

Certified Well Pump Installer _____ Well Driller _____ Registered Plumber X

Name of Property Owner RONALD EDER

Telephone _____

Subdivision ROVER MILLESTATES Lot # 5

Well Tag # HO-88-1039

Site Address 14009 TALL SHIPS DR

Pump

1. Type
 - a. Deep well jet _____
 - b. Shallow well jet _____
 - c. Submersible X
2. Make Goulds
3. Model # 7EGF
4. Capacity 7 GPM

Motor

1. Horsepower 1/2
2. RPM _____
3. Voltage _____
 - a. 110 _____
 - b. 220 X

Pitless Adapter

1. Make Harvard
2. Model # _____
3. Depth 42"

5. Pump exceeds well capacity Yes _____ No X
6. If Yes, is low pressure cutoff switch installed? Yes _____ No X
7. What methods are used to protect the pump and electrical wiring from vibrations? Torque arrestors _____ Cable guards _____ Other X

Tank

1. Capacity 42
2. Pressure relief valve? Yes

Piping

1. Type 1601b
2. Size 1"
3. NSF and/or BOCA Code approved yes
4. Depth of supply line 42"

Well data

1. Depth 200 ft.
2. Yield 12 GPM
3. Static water level 37 ft.
4. Will water supply be disinfected by installer? Builder

I understand that it is my responsibility to notify the Howard County Health Department when the installation is ready for inspection (otherwise this permit is null and void).

All information given above is true to the best of my knowledge.

Signature of Applicant: [Signature]

Date: 3-8-90

Note: A sticker indicating approval/status of the installation will be placed on the well casing at the time of the inspection.

C1 1148

SEQUENCE NO.
(DENY USE ONLY)STATE OF MARYLAND
WELL COMPLETION REPORT
FILL IN THIS FORM COMPLETELY
PLEASE PRINT OR TYPETHIS REPORT MUST BE SUBMITTED WITHIN
45 DAYS AFTER WELL IS COMPLETED.COUNTY
NUMBER

A 21814

ST/CO USE ONLY.
DATE Received

DATE WELL COMPLETED

8 9 10 11 12 13

110289

Depth of Well

22 23 24 25 26
(TO NEAREST FOOT)PERMIT NO.
FROM "PERMIT TO DRILL WELL"

40-88-1039

OWNER ELER RONOLD last name OLD ROVER RD first name GLENWOOD
STREET OR RFD. TOWN
SUBDIVISION ROVER MILL EST SECTION — LOT 5

WELL LOG

Not required for driven wells

STATE THE KIND OF FORMATIONS
PENETRATED, THEIR COLOR, DEPTH,
THICKNESS AND IF WATER BEARINGDESCRIPTION (Use
additional sheets if needed)

	FEET	Check if water bearing
	FROM	TO
Top Soil	0	2
Gravel	2	25
Gravel	25	60
Gravel	60	70
Gravel	70	70
Gravel	70	200

GROUTING RECORD

WELL HAS BEEN GROUTED
(Circle Appropriate Box)yes ☒ no ☐

TYPE OF GROUTING MATERIAL

CEMENT ☒ BENTONITE CLAY ☐NO. OF BAGS 16 NO. OF POUNDS 1600GALLONS OF WATER 80

DEPTH OF GROUT SEAL (to nearest foot)

from 0 ft. to 39 ft.
(enter 0 if from surface)

CASING RECORD

casing
types
insert
appropriate
code
belowST CO
STEEL CONCRETE
PL OT
PLASTIC OTHER

MAIN CASING TYPE Nominal diameter top (main) casing (nearest inch) Total depth of main casing (nearest foot)

ST 60 61 63 64 40 65 70

OTHER CASING (if used)

diameter inch depth (feet) from to

EACH CASING

screen type or open hole

SCREEN RECORD

insert appropriate code below

ST BR HO
STEEL BRASS OPEN
PL BRONZE HOLE
PLASTIC OTHER

C2

DEPTH (nearest ft.)

1	40	38	36	34	32	30	28	26	24	22	20	18	16	14	12	10	8	6	4	2
2																				
3																				

EACH SCREEN

CIRCLE APPROPRIATE LETTER

- A A WELL WAS ABANDONED AND SEALED WHEN THIS WELL WAS COMPLETED
- E ELECTRIC LOG OBTAINED
- P TEST WELL CONVERTED TO PRODUCTION WELL

I HEREBY CERTIFY THAT THIS WELL HAS BEEN CONSTRUCTED IN ACCORDANCE WITH COMAR 26.04.04. "WELL CONSTRUCTION" AND IN CONFORMANCE WITH ALL CONDITIONS STATED IN THE ABOVE CAPTIONED PERMIT, AND THAT THE INFORMATION PRESENTED HEREIN IS ACCURATE AND COMPLETE TO THE BEST OF MY KNOWLEDGE.

DRILLERS IDENT. NO. 40DRILLERS SIGNATURE
(MUST MATCH SIGNATURE ON APPLICATION)Howard J. Shaben

SITE SUPERVISOR (sign of driller or journeyman responsible for sitework if different from permittee)

GRAVEL PACK

IF WELL DRILLED WAS

FLOWING WELL INSERT

F IN BOX-68

OEP USE ONLY (NOT TO BE FILLED IN BY DRILLER)

T (E.R.O.S.) WQ

70 72 74 75 76

TELESCOPE LOG OTHER DATA

CASING INDICATOR

C3

PUMPING TEST

HOURS PUMPED (nearest hour) 3PUMPING RATE (gal. per min. to nearest gal.) 12METHOD USED TO MEASURE PUMPING RATE Bucket

WATER LEVEL (distance from land surface)

BEFORE PUMPING 37WHEN PUMPING 27

TYPE OF PUMP USED (for test)

A air P piston T turbine
C centrifugal R rotary O other (describe below)
J jet S submersible

PUMP INSTALLED

DRILLER WILL INSTALL PUMP YES NO

IF DRILLER INSTALLS PUMP, THIS SECTION MUST BE COMPLETED FOR ALL WELLS EXCEPT HOME USE TYPE OF PUMP INSTALLED PLACE (A,C,J,P,R,S,T,O) IN BOX - SEE ABOVE

CAPACITY: GALLONS PER MINUTE (to nearest gallon)

PUMP HORSE POWER

PUMP COLUMN LENGTH (nearest ft.)

CASING HEIGHT (circle appropriate box and enter casing height)

LAND SURFACE (nearest foot)

LOCATION OF WELL ON LOT

SHOW PERMANENT STRUCTURE SUCH AS BUILDING, SEPTIC TANKS, AND/OR LANDMARKS AND INDICATE NOT LESS THAN TWO DISTANCES (MEASUREMENTS TO WELL)

COUNTY

Elber



Plat Reference: Revised Plat of Lot 5, 1 through 6, 27 and 28, Boyer Mill Estates, recorded in Platbook 4141.

DEPARTMENT OF INSPECTIONS, LICENSES AND PERMITS
3430 COURT HOUSE DRIVE
ELLCOTT CITY, MD 21043
PERMITS (410) 313-2466 INSPECTIONS (410) 313-1810
AUTOMATED INFORMATION (410) 313-3800

HOWARD COUNTY
PERMIT APPLICATION

PERMIT NUMBER
B00114673

Building Address
14009 Tall Ships Dr
West Friendship MD 21794

Suite/Apt. #: SDP/WP/Petition #:

Census Tract Subdivision

Section N/A Area N/A Lot 5

Tax Map 15 Parcel 233 Grid 13

Zoning RRUC Map Coordinates Lot size

Existing Use

Proposed Use Same with add-on

Estimated Construction Cost \$ 1,357.00

Description of Work Enclose EXHIBIT
near porch 16'x12

Owner's Name Eber, Ronald & Carol

Address 14009 Tall Ships Dr

City West Friendship State MD Zip Code 21794

Home Phone 410-272- Work Phone

Applicant's Name & Mailing Address, (if other than stated hereon):

Phone Fax

Contractor Company Pate & Associates Inc

Contact Person Steve A...

Address 224 WTA Ave NW

City Glen Ridge State MD Zip Code 21061

License No. 12747

Phone 760-1915 Fax 760-1909

Engineer or Architect Company

Contact Person

Address

City State Zip Code

Phone Fax

Occupant or Tenant

Contact Name

Address

City State Zip Code

Phone Fax

Engineer or Architect Company

Contact Person

Address

City State Zip Code

Phone Fax

BUILDING DESCRIPTION - COMMERCIAL

BUILDING DESCRIPTION - RESIDENTIAL

Building Characteristics

Height: 8

No. of stories: 1

Gross area, sq. ft. per floor: 1400

Use group:

Construction type:
Reinforced Concrete
Structural Steel
Masonry
Wood Frame
State Certified Modular

Utilities

Water Supply:
Public
Private

Sewage Disposal:
Public
Private

Electric Yes No
Gas Yes No

Heating System:
Electric Oil
Natural Gas
Propane Gas

Sprinkler system: N/A
NFPA #13
Full
Partial
Other Suppression

Building Characteristics

SF Dwelling: SF Townhouse
1st floor: Depth Width
2nd floor:
Basement: N/A
Finished Basement Unfinished Basement
Crawl space Slab on Grade
No. of Bedrooms
Multi-family dwellings:
No. of efficiency units:
No. of 1 BR units:
No. of 2 BR units:
No. of 3 BR units:
Other:
Dimensions:
Footings:
Roof:
State Certified Modular
Manufactured Home

Utilities

Water Supply:
Public
Private

Sewage Disposal:
Public
Private

Electric Yes No
Gas Yes No

Heating System:
Electric Oil
Natural Gas
Propane Gas

Sprinkler system: N/A
NFPA #13D
NFPA #13R
Other:

THE UNDERSIGNED HEREBY CERTIFIES AND AGREES AS FOLLOWS: (1) THAT HE/SHE IS AUTHORIZED TO MAKE THIS APPLICATION; (2) THAT THE INFORMATION IS CORRECT; (3) THAT HE/SHE WILL COMPLY WITH ALL REGULATIONS OF HOWARD COUNTY WHICH ARE APPLICABLE THERETO; (4) THAT HE/SHE WILL PERFORM NO WORK ON THE ABOVE REFERENCED PROPERTY NOT SPECIFICALLY DESCRIBED IN THIS APPLICATION; (5) THAT HE/SHE GRANTS COUNTY OFFICIALS THE RIGHT TO ENTER ONTO THIS PROPERTY FOR THE PURPOSE OF INSPECTING THE WORK PERMITTED AND POSTING NOTICES.

Applicant's Signature [Signature]

Print Name [Name]

Title/Company

Date

Checks payable to: DIRECTOR OF FINANCE OF HOWARD COUNTY
** PLEASE WRITE NEATLY AND LEGIBLY. **

AGENCY DATE SIGNATURE APPROVAL

Land Development DPZ

State Highways

Building Official

Dev. Engineering DPZ

Health 10/22/98 [Signature]

Fire Protection

Is Sediment Control approval required prior to issuance?
YES NO

CONTINGENCY CONSTRUCTION START: ONE STOP SHOP:

DPZ SETBACK INFORMATION

Front:

Rear:

Side:

Side St.:

All minimum setbacks met?
YES NO

Is Entrance Permit required?
YES NO

Historic District?
YES NO

Lot Coverage for New Town Zone

SDP/Red-line approval date

PROPERTY ID# 23202

Filing Fee \$

Permit Fee \$ 25

(10 sq. ft.) (.15 sq. ft.)

Excise Tax \$

(40 sq. ft.) (.80 sq. ft.)

TOTAL FEES

Check # 1410

Validation #

Accepted by:

Distribution of Copies- White: Building Official Green: LDD, DPZ Yellow: DED, DPZ Pink: Health Gold: SHA

Rev. 8/25/98