

PERMIT

SEWAGE DISPOSAL SYSTEM

DEPARTMENT OF HEALTH AND MENTAL HYGIENE

HOWARD COUNTY HEALTH DEPARTMENT

BUREAU OF ENVIRONMENTAL HEALTH

XX-XXXXXX 313-2640

INDEXED

05-379253

P 48958

A 45673

DISTRICT 5th

DATE 2/22/93

DATE SYSTEM APPROVED 12/4/92

INSPECTOR CW/JN

Jack Fyock Septic Service IS PERMITTED TO INSTALL ☒ ALTER ☐

ADDRESS 13775 Triadelphia Road, Glenelg, Maryland 21737 PHONE 988-9270

SUBDIVISION Sabine Property LOT 11 ROAD 13720 Triadelphia Mill Road

PROPERTY OWNER Ronald L. Hines

ADDRESS

SEPTIC TANK CAPACITY 1500 GALLONS

NUMBER OF BEDROOMS 5

210 SQUARE FEET PER BEDROOM

LINEAR FEET OF TRENCH REQUIRED 263

TRENCHES - Trench to be 2 feet wide. Inlet 3 feet below original grade. Bottom maximum depth 7 feet below original grade. Effective area begins at 3 feet below original grade. 4 feet of stone below distribution pipe.

LOCATION - From the inside lot corner at the end of the pipe-stem access, place the distribution box 235 feet down the front (823') lot line and 10 feet off that lot line. Run trenches along contour toward rear (861') lot line.

NOTES - No trench to exceed 100 feet in length. Provide 6" - 8" diameter cleanout and cap to grade or above on septic tank. ok/cw

PLANS APPROVED BY C. Williams DATE 6/12/92

COVER NO WORK UNTIL INSPECTED AND APPROVED

NEITHER THE HOWARD COUNTY COUNCIL NOR THE HEALTH DEPARTMENT IS RESPONSIBLE FOR THE SUCCESSFUL OPERATION OF ANY SYSTEM

NOTE: CLEANOUT REQUIRED EVERY 70 FEET OF SEWER LINE AND/OR AT 90° SWEEPS IN LINES FROM HOUSE TO DRAIN FIELDS, 90° ELBOWS NOT ACCEPTABLE.

NOTE: ALL PARTS OF SEPTIC SYSTEMS (I.E. TANK, DISTRIBUTION BOX TRENCHES) TO BE 100 FEET FROM WELL (UNLESS OTHERWISE SPECIFICALLY AUTHORIZED)

NOTE: IF DEEP TRENCH(ES) ARE USED CALL FOR INSPECTION BEFORE AND AFTER PLACING GRAVEL IN TRENCH(ES)

NOTE: NO DRY WELL SHALL EXCEED 15 FOOT IN DIAMETER NO ABSORPTION TRENCH TO EXCEED 100 FEET IN LENGTH

NOTE: ALL PIPE FROM HOUSE TO SEPTIC TANK MUST BE CAST IRON OR SCHEDULE 35/40 PVC OR ABS

PERMIT VOID AFTER TWO YEARS

NOTE: INSTALL STAND PIPE ON SEPTIC TANK AND DRY WELL STAND PIPES MUST BE 6 INCHES IN DIAMETER CAST IRON. CONCRETE OR TERRA COTTA OR PVA OR ABS ACCEPTED. IF TOP OF SEPTIC TANK IS DEEPER THAN 3 FEET. MANHOLE TO GRADE REQUIRED.

NOTE: DISTRIBUTION BOXES MUST HAVE BAFFLES

*INSTALLER IS RESPONSIBLE FOR OBTAINING FINAL APPROVAL ON THIS PERMIT

APPLICATION

PERCOLATION TESTING

A 45673

P _____

HOWARD COUNTY HEALTH DEPARTMENT
BUREAU OF ENVIRONMENTAL HEALTH
P.O. BOX 476 ELLICOTT CITY, MARYLAND 21043
TELEPHONE: 461-9933

RETEST OF A23198 (OLD LOT 4)
LOT LINE ADJUSTMENT
PLATTED PERC AREA POSSIBLE
BUT HOUSE SITE IMPROVED IF
MOVED DOWNHILL. C.W.

DISTRICT _____

DATE 3/13/90

TO: THE COUNTY HEALTH OFFICER
ELLICOTT CITY, MARYLAND

I HEREBY APPLY FOR THE NECESSARY TEST IN ORDER TO CONSTRUCT (OR RECONSTRUCT) A SEWAGE DISPOSAL SYSTEM.

PROPERTY OWNER ROBERT L. ORNDORFF & JOYCE M. ORNDORFF Ronald L. Hines

ADDRESS P.O. Box 57, DINTON, MD. 21036 PHONE 531-6367
596-9490

PROSPECTIVE BUYER _____

ADDRESS _____ PHONE _____

PROPERTY LOCATION:

SUBDIVISION SABINE PROPERTY LOT NO. 11 (OLD LOT # 4 ON PAT #3710)

ROAD AND DESCRIPTION NORTH SIDE OF TRIADELPHIA MILL RD.
3500' WEST OF HIGHLAND RD. (13720 Triadelphia Mill Road)

TAX MAP 20 PARCEL # 300

SIZE OF LOT 11.98947 AC TYPE BLDG. SINGLE-FAMILY DWELLING
(SINGLE FAMILY DWELLING OR COMMERCIAL)

THE SYSTEM INSTALLED UNDER THIS APPLICATION IS ACCEPTABLE ONLY UNTIL PUBLIC FACILITIES BECOME AVAILABLE. I FULLY UNDERSTAND THE FEE CONNECTED WITH THE FILING OF THIS PERC TEST APPLICATION IS NON-REFUNDABLE UNDER ANY CIRCUMSTANCES. I ALSO AGREE TO COMPLY WITH ALL M.O.S.H.A. REQUIREMENTS IN TESTING THIS LOT.

[Signature] 3/7/90
(SIGNATURE OF APPLICANT)

APPROVED BY C.W. FOR TRENCHES DATE 4/11/90

REJECTED BY _____ FOR _____ DATE _____

HOLD PENDING FURTHER TESTS _____ DATE _____

REASONS FOR REJECTION OR HOLDING 3/29/90 - RETEST OK HOLD FOR

REVISED PLAT RH BLDG. PERMIT SIGNED
AND RETURNED 4/19/90
Serial # 43817 - SFD-3 Bedroom

THIS IS NOT A PERMIT

SOIL PROFILE

0
3
BROWN CLAY
ORANGE BROWN FLAKY SAND MICA LOAM

0

3

12

(8)

BROWN CLAY

PULL BROWN LUMPY SAND LOAM

(9)


ORANGE BROWN CLAY

PULL BROWN FLAKY SAND MICA LOAM

(10)

ORANGE BROWN CLAY

BROWN FINE SAND LOAM

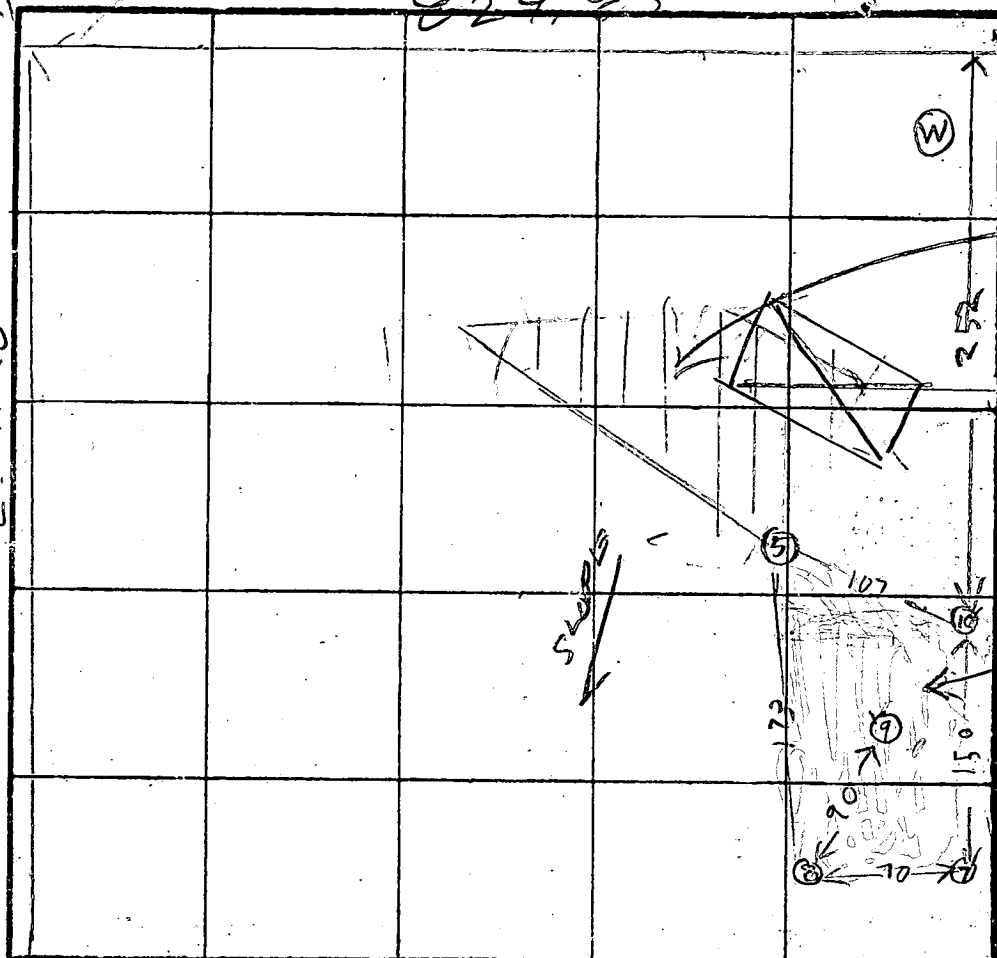

INDICATE NORTH - NAME ADJOINING ROADWAY AS BASE LINE.

DATE	TEST NO.	DEPTH	PRE-WET		TEST - 1" DROP		TIME
			START	STOP	START	STOP	
3/28/70	5	13	OK BELOW	4 hr 7	(SEE OTHER TEST)		
	7 S	4	1235	1244	1244	110	26
	7 D	8	1235	1240	1240	1254	14
	7 V	12	OK				
	8 D	8	1241	1244	1244	1253	9
	8 S	14	1242	1256	1256	127	21/2 hr
	9 V	12	OK DEEP	SYSTEM BELOW ST-7			
	9 V	14	OK				
	10 S	5	101	140	140	126	16
	10 D	8 1/2	100	140	140	120	10
	10 V	13	OK				

210 SQ FT PER BR

REMARKS

TYPE OF SOIL

TESTED BY

B. HODGES

ALSO PRESENT

B. ORNDORF

APPLICATION

A 23198

SEWAGE DISPOSAL TESTING

P _____

STATE OF MARYLAND - DEPARTMENT OF HEALTH AND MENTAL HYGIENE

HOWARD COUNTY HEALTH DEPARTMENT
ENVIRONMENTAL HEALTH SERVICES

P. O. BOX 476, ELLICOTT CITY, MARYLAND 21043
TELEPHONE: 465-8000, EXT. 356

DISTRICT 5

DATE 4/16/76

TO: THE COUNTY HEALTH OFFICER
ELLICOTT CITY, MARYLAND

I, HEREBY, APPLY FOR THE NECESSARY TEST IN ORDER TO CONSTRUCT (OR RECONSTRUCT) A SEWAGE DISPOSAL SYSTEM.

PROPERTY OWNER Walter M. Sabine

ADDRESS Triadelphia Mill Road, Clarksville Md. PHONE 988-9437
office 531-5115

PROPERTY LOCATION:

SUBDIVISION Sabine Estates LOT NO. 44

ROAD AND DESCRIPTION Triadelphia Mill Road, Clarksville

SIZE OF LOT 1/6 acres TYPE BLDG. 4

NUMBER OF BEDROOMS

IF NOT SINGLE RESIDENCE DESCRIBE _____

THE SYSTEM INSTALLED UNDER THIS APPLICATION IS ACCEPTABLE ONLY UNTIL PUBLIC FACILITIES BECOME AVAILABLE.

SIGNATURE OF APPLICANT Walter M. Sabine

APPROVED BY _____ FOR _____ DATE _____

(KIND OF SYSTEM)

REJECTED BY _____ FOR _____ DATE _____


(KIND OF SYSTEM)

HOLD PENDING FURTHER TESTS _____ DATE _____

REASONS FOR REJECTION OR HOLDING _____

THIS IS NOT A PERMIT

59

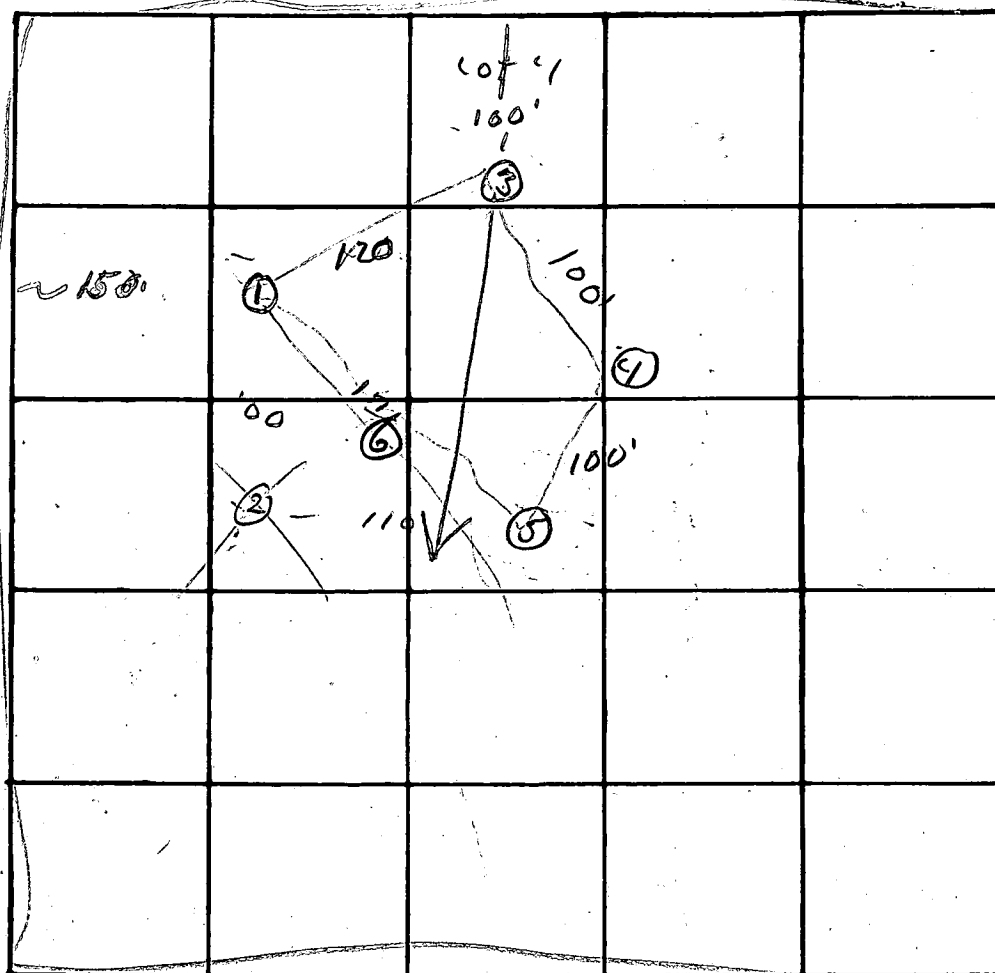

ROW

lot 3

lot 2

INDICATE NORTH. - NAME ADJOINING ROADWAY AS BASE LINE.

DATE	TEST NO.	DEPTH	PRE-WET		TEST - 1" DROP		TIME
			START	STOP	START	STOP	
	15	4' 50.11 5 1/8 test	250	250	251	251	1
	14	11'	250	252	252	258	6
	2	Rock	11'				
	55	4' 50.11 5 1/8 test	301	307	307	315	8
	51	13'	256	301	301	312	11
	45	4'	315	316	316	317	1
	40	13'	317	319	319	323	3
	35	4'	310	312	312	317	5
	31	10'	308	312	312	320	8
	6	Visual	-12	At sandy loam 4 - 12			


REMARKS


TYPE OF SOIL

Vic. Carl. Seppel
Shenabeger Lane


* LOT 11 VERTICAL ELEVATION DIFFERENCE BETWEEN HOUSE AND STREAM = 60'

* LOT 12 VERTICAL ELEVATION DIFFERENCE BETWEEN HOUSE AND STREAM = 40'

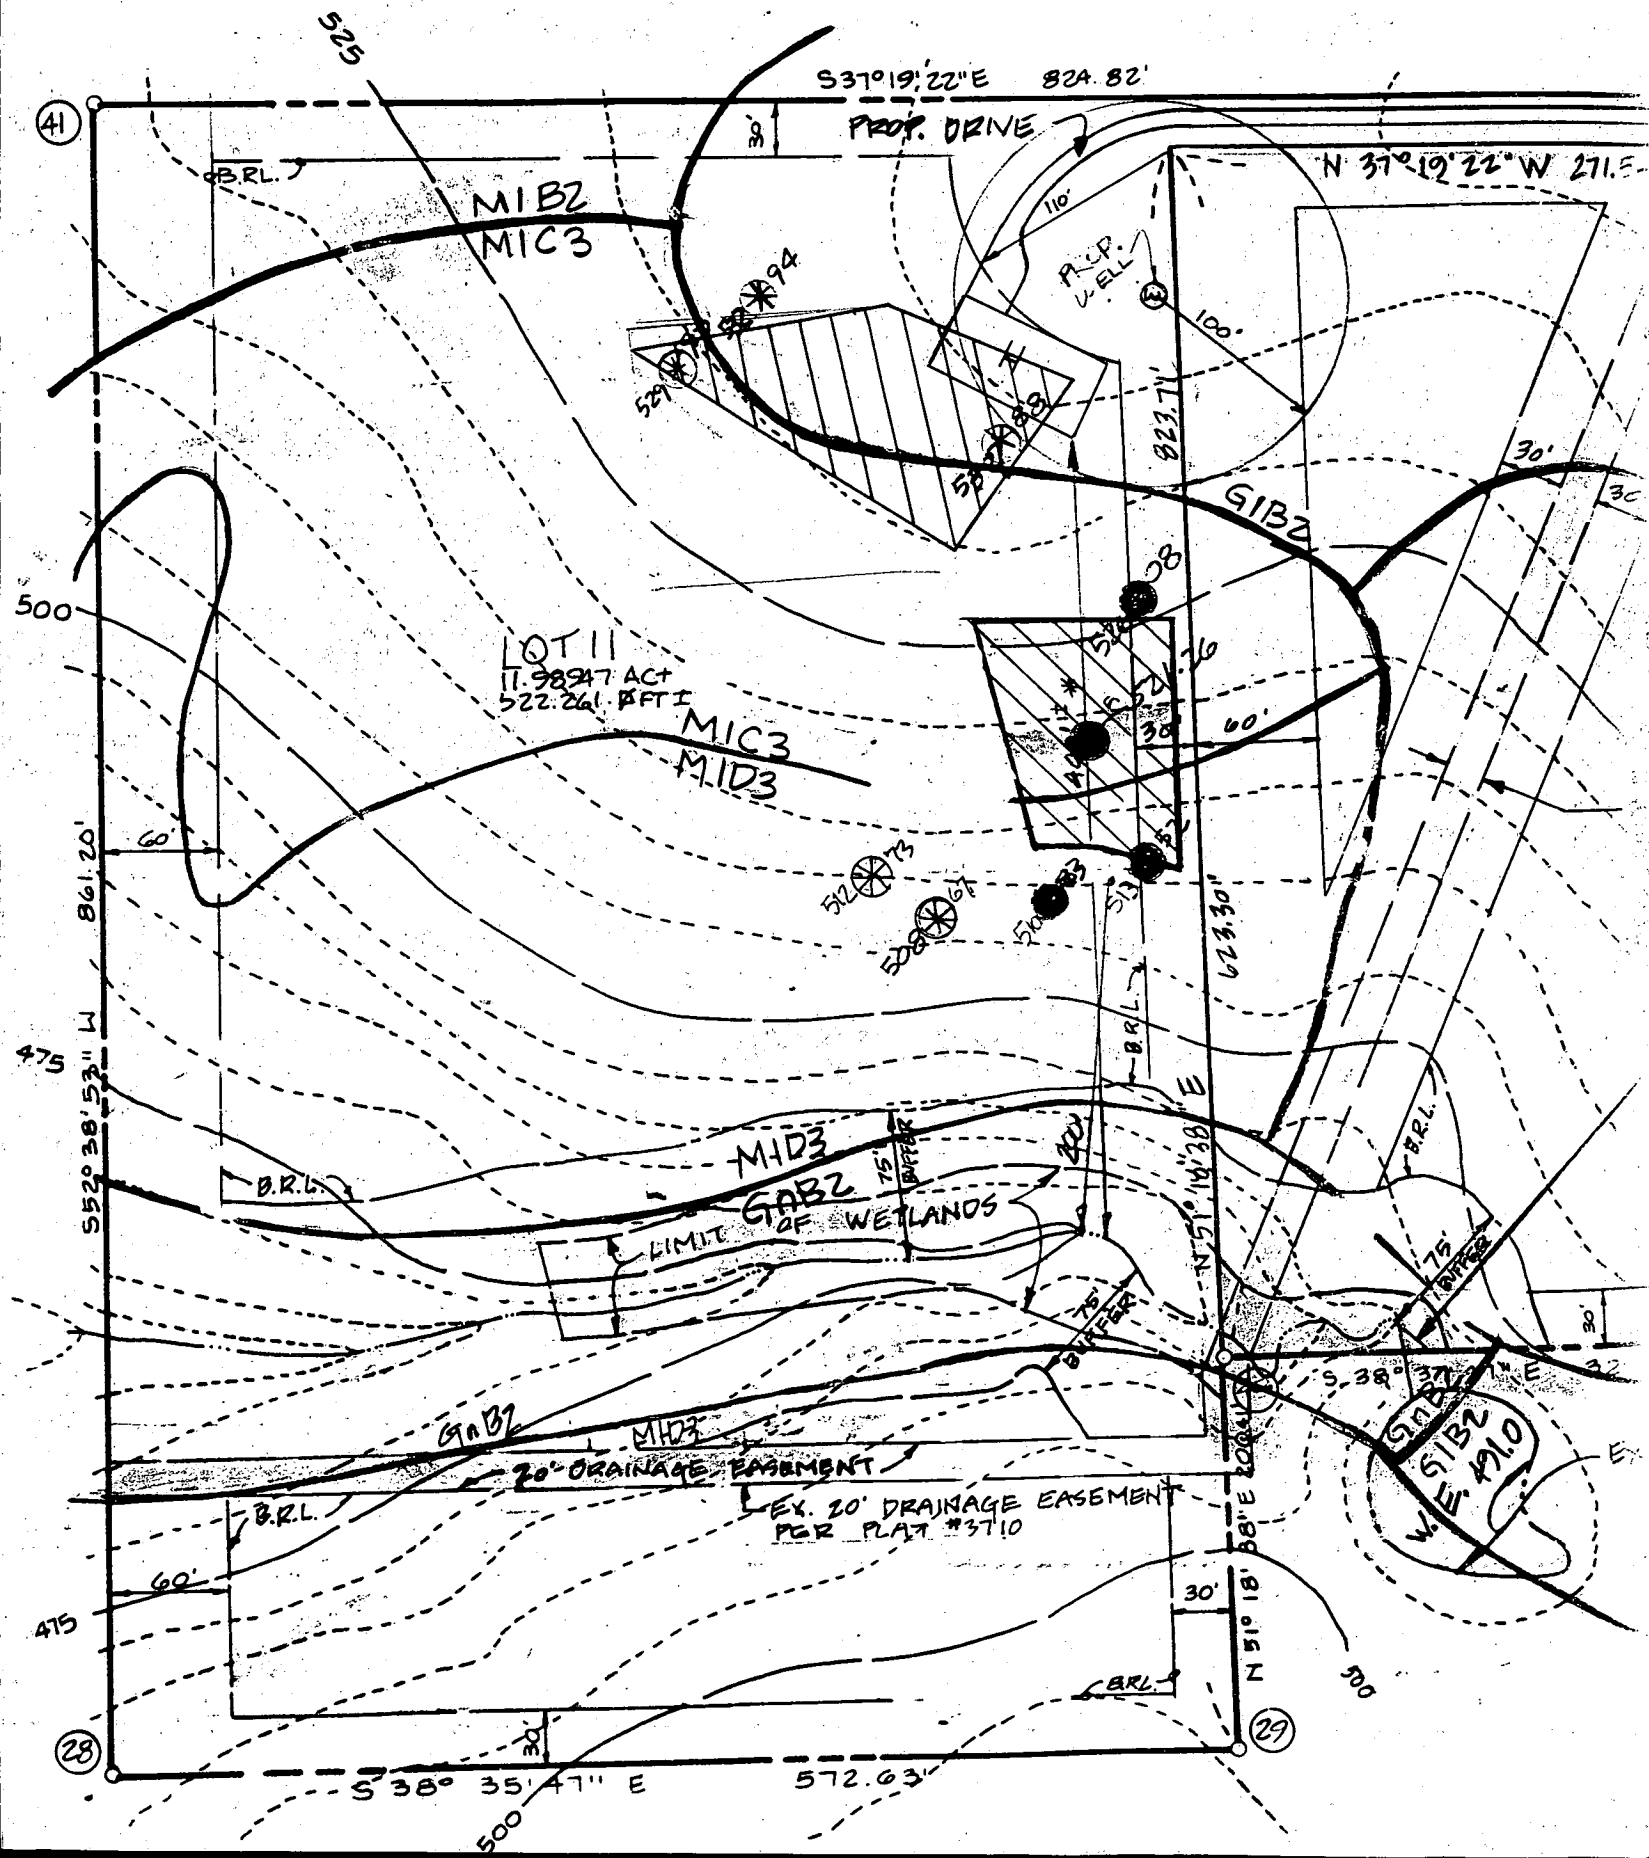

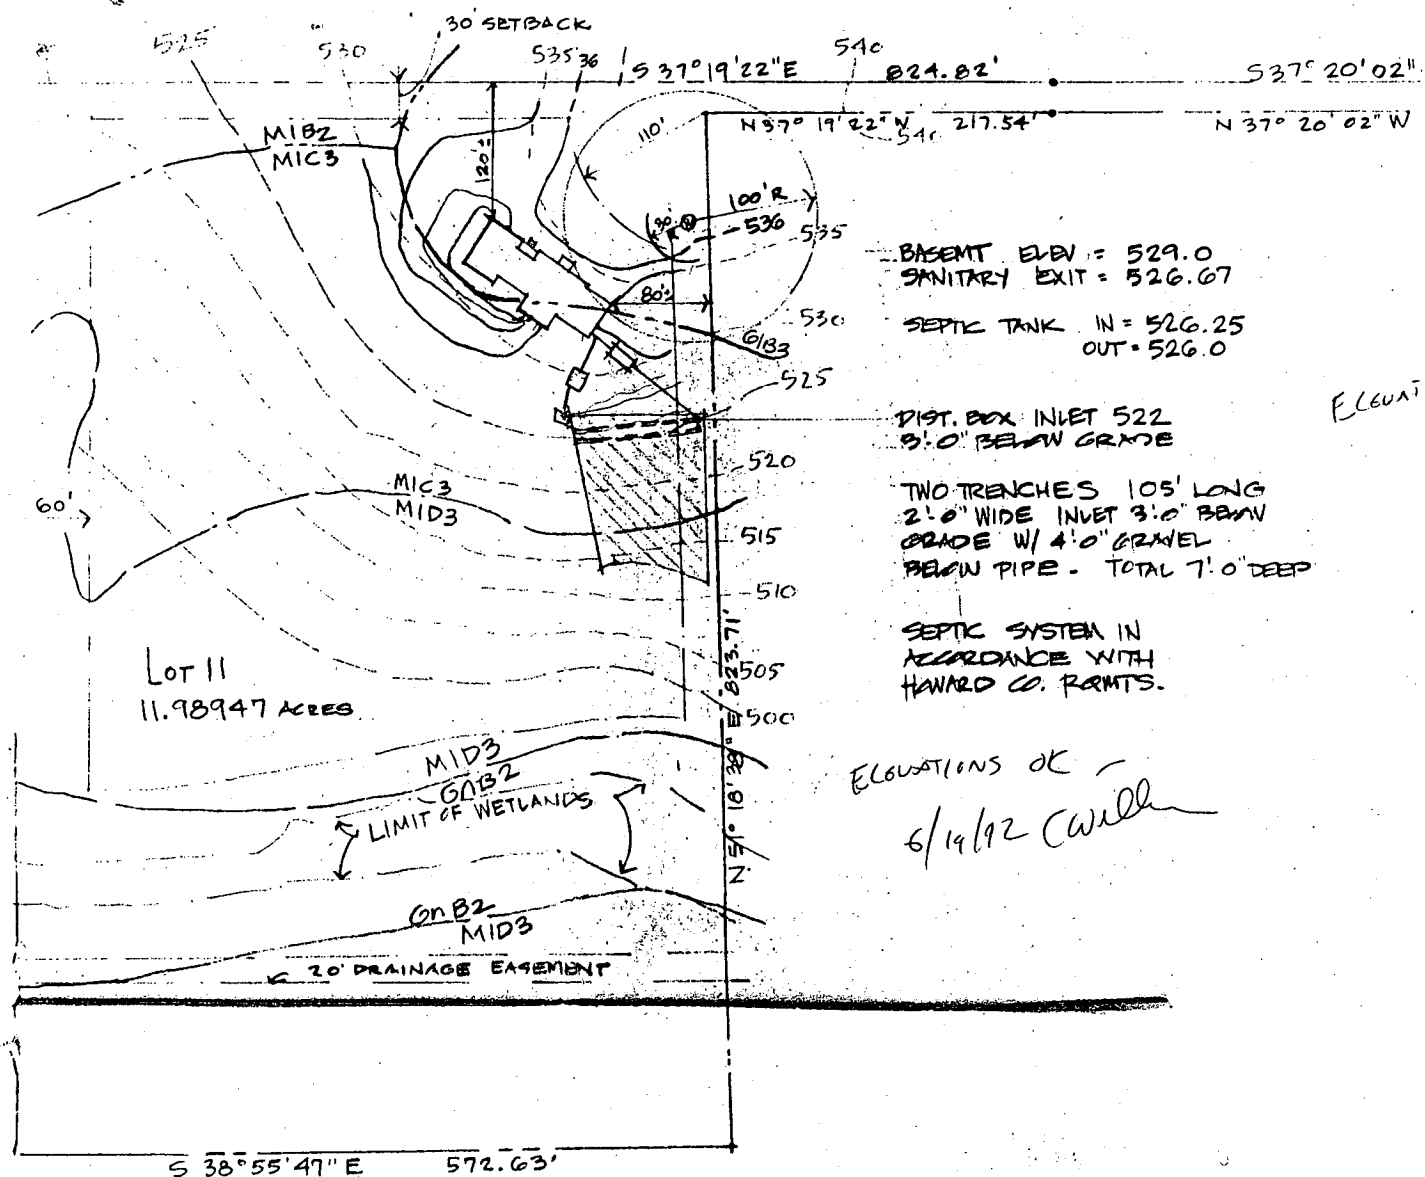

SITE PLAN Scale 1" = 100' 0"

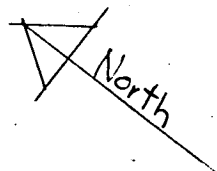

INFORMATION FOR THIS SITE PLAN
WAS TAKEN FROM FINAL PLAT
SABINE PROPERTY DATED 2.5.90
PREPARED BY SHANATSEGER & LANE

505119.745	802093.690	182	504680.558	802931.704
505308.592	802764.721	194	504735.036	803202.190
504583.744	803220.259	196	504119.275	803016.248

S 37° 19' 22" E 824.82'


NOTES (CONT.)

- FOR FLAG OR PIPE STEM LOTS, REFUSE COLLECTION, SNOW REMOVAL AND ROAD MAINTENANCE TO BE PROVIDED AT THE JUNCTION OF FLAG OR PIPE STEM AND THE ROAD R/W AND NOT INTO THE FLAG OR PIPE STEM LOT DRIVEWAY.

LOT 11
11.98947 AC±
522,261.7 FT. ±

LOT 4
PLOT # 3710

EXISTING
20' DRAINAGE
EASEMENT
PER PLAT
3710

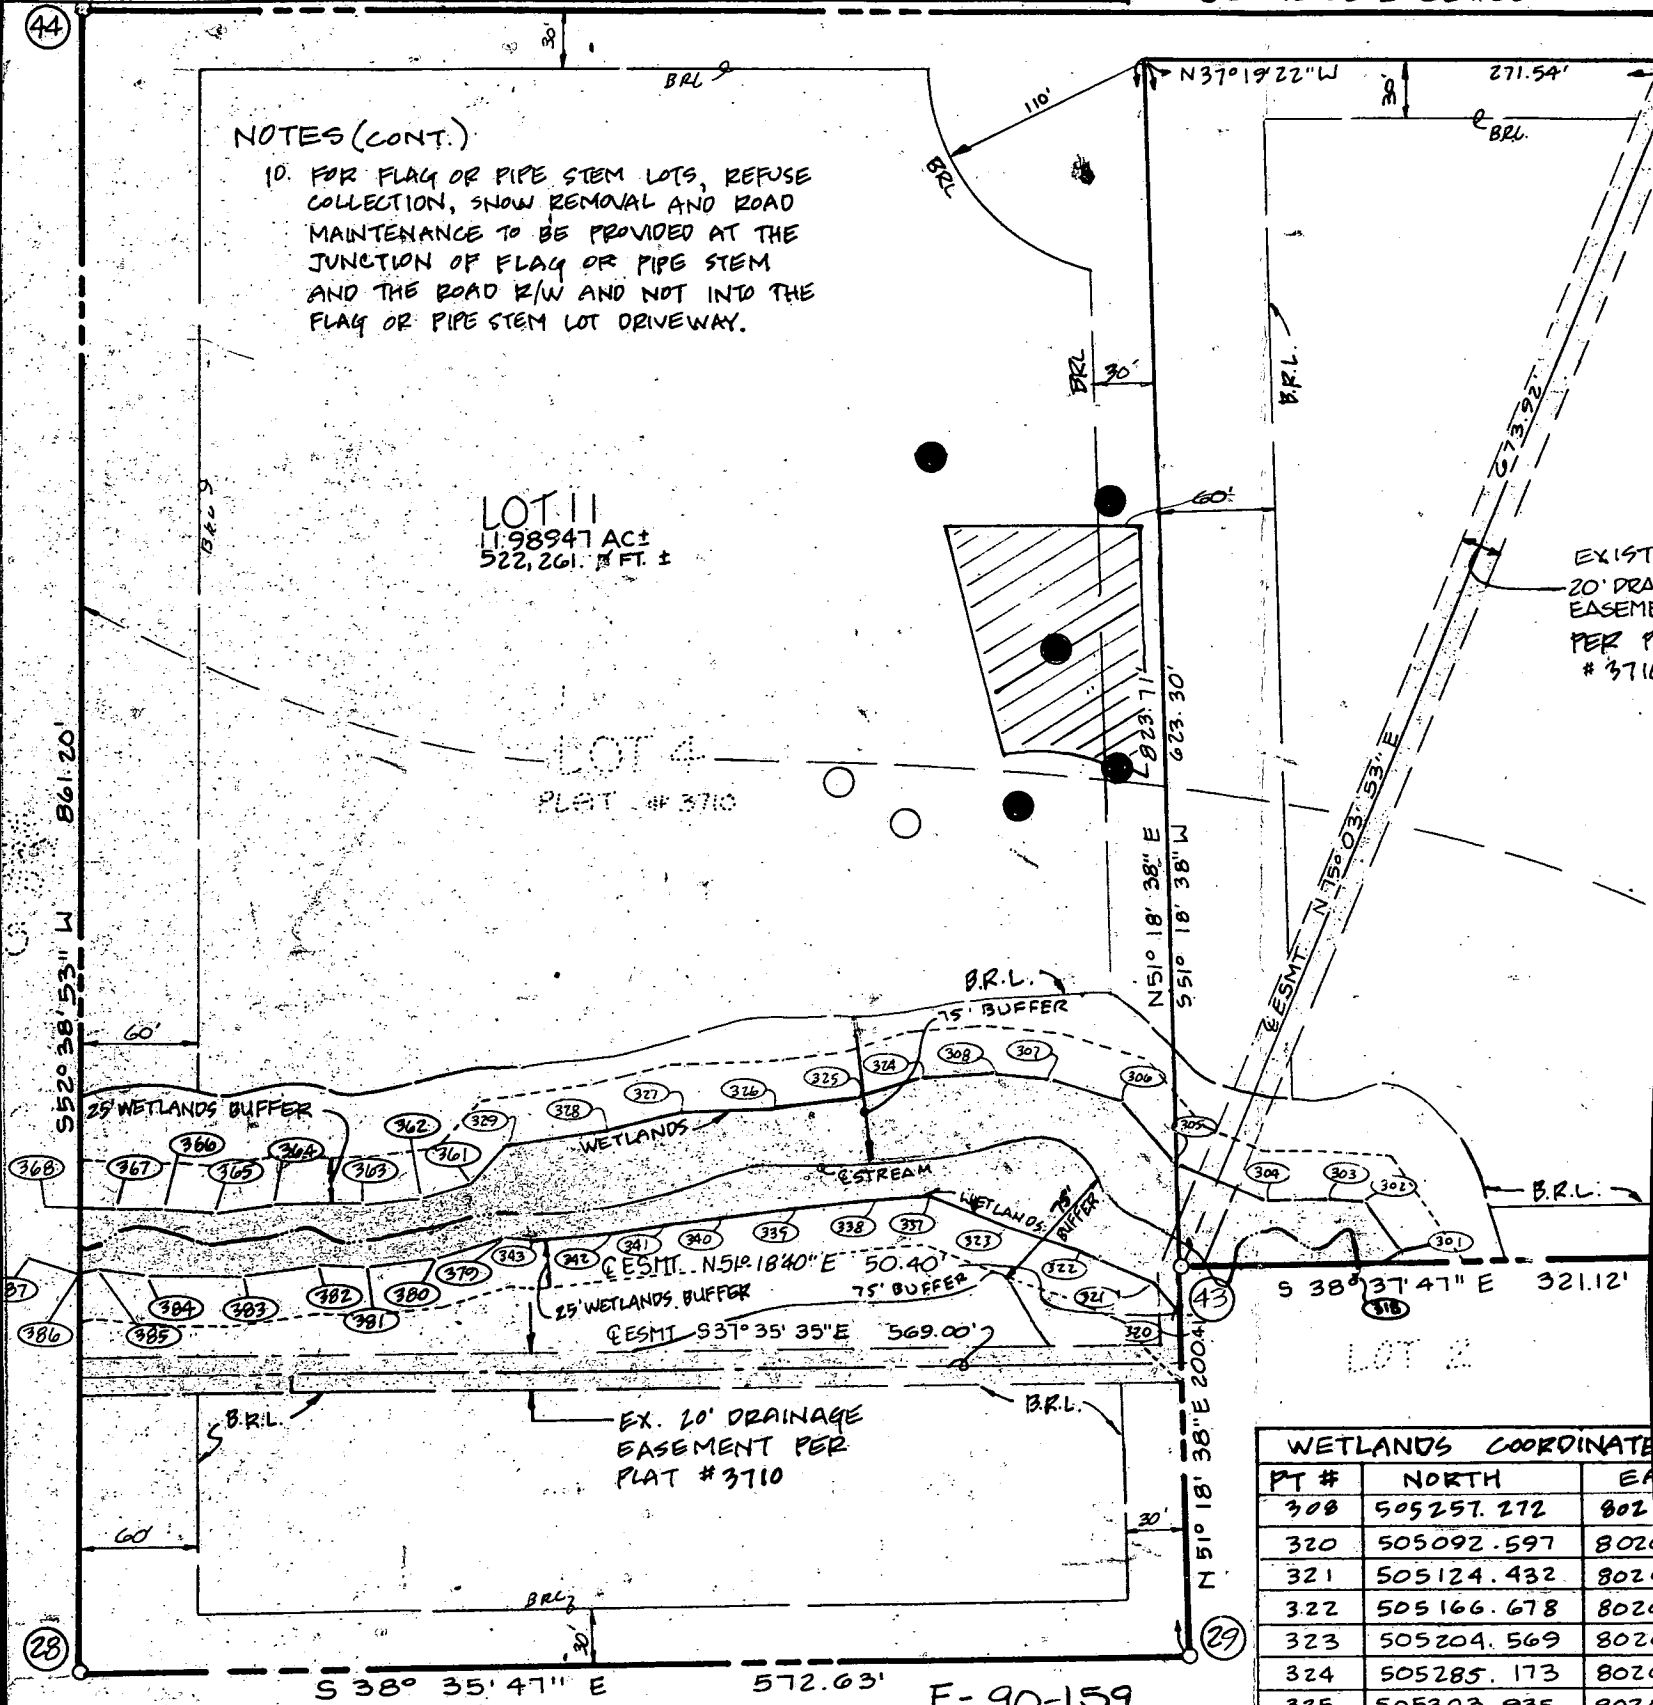

WETLANDS COORDINATE		
PT #	NORTH	EAST
308	505257.272	802
320	505092.597	802
321	505124.432	802
322	505166.678	802
323	505204.569	802
324	505285.173	802
325	505303.935	802
326	505335.162	802
327	505372.404	802
328	505398.338	801
329	505433.580	801


TABULATION OF FINAL PLOT

TOTAL NUMBER OF LOTS AND/OR PARCEL TO BE RECORDED:	2
BUILDABLE	0
OPEN SPACE	0
TOTAL AREA OF LOTS AND/OR PARCEL:	25.58309 AC±
BUILDABLE	0
TOTAL OPEN SPACE:	0
(AREA AND % OF DRY GROUND USABLE OPEN SPACE):	0
TOTAL AREA OF ROAD RIGHT OF WAY TO BE RECORDED	0


F-90-159
Signed
8-29-90

CURVE			
NO.	RADIUS	ARC	DELTA
159 TO 157	125.00'	133.18'	61° 02' 48"
194 TO 195	150.00'	159.82'	61° 02' 48"
LOT #	GROSS AREA ACRES	FLOOD PLAIN/STEEP SLOPES	

FROM PT#	TO PT#	WETLANDS BEARING	DIST.
318	301	S 71° 39' 31" E	14.77'
301	302	N 11° 50' 06" E	32.11'
302	303	N 30° 51' 38" W	14.09'
303	304	N 38° 28' 56" W	34.32'
304	305	N 14° 25' 29" W	50.61'
305	306	N 12° 16' 22" E	41.03'
306	307	N 27° 39' 53" W	40.97'
307	308	N 19° 37' 20" W	25.06'
308	324	N 41° 10' 26" W	37.07'
324	325	N 57° 46' 32" W	35.19'
325	326	N 45° 39' 28" W	44.68'

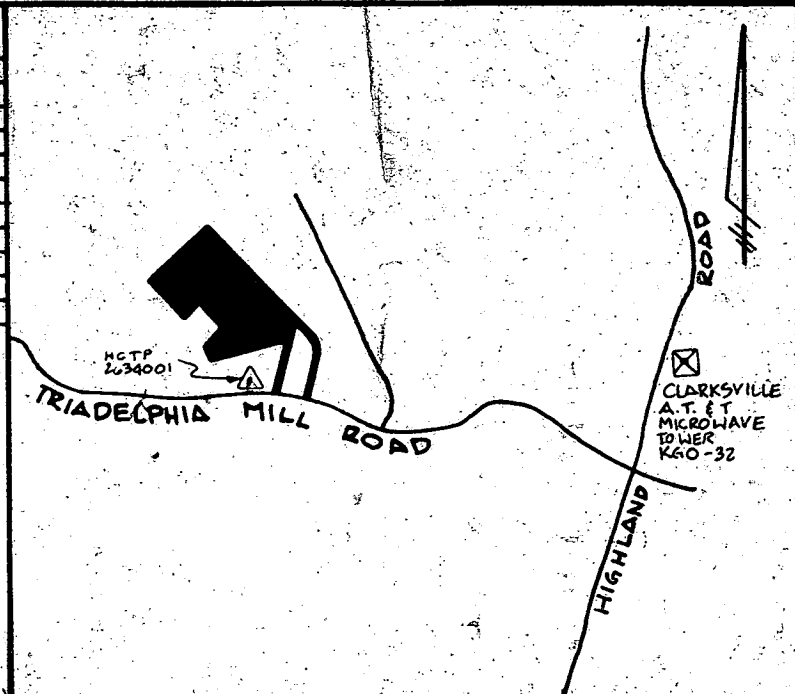

YICINITY MAP
SCALE: 1"=2000'

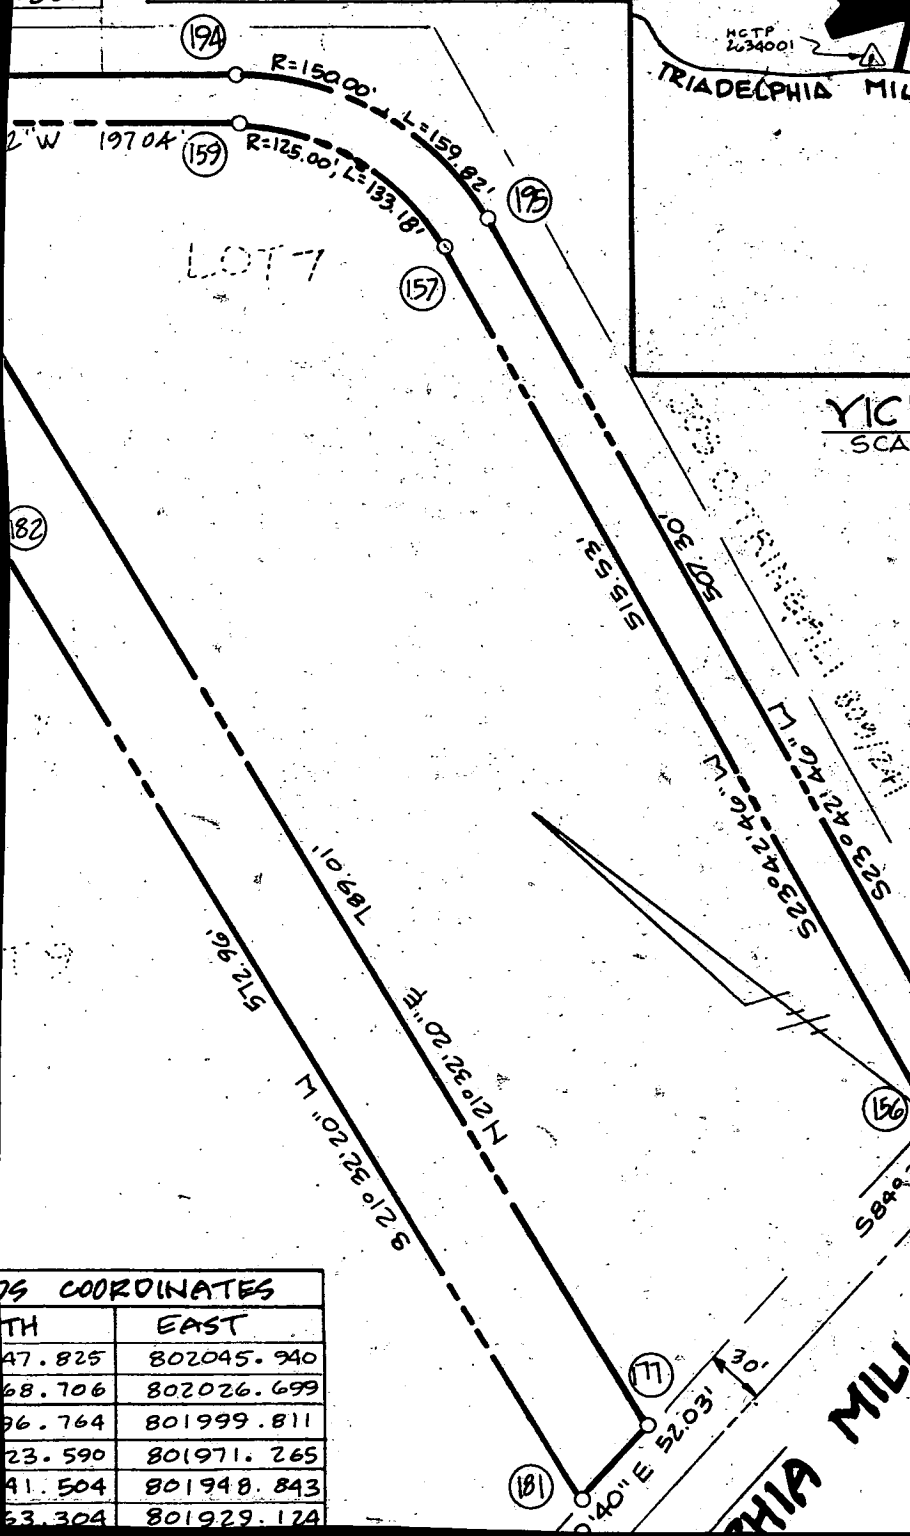

FROM PT#	TO PT#	WETLANDS BEARING	DIST.
326	327	N 38° 7' 45" W	47.34'
327	328	N 49° 46' 02" W	40.15'
328	329	N 46° 59' 0" W	51.66'
329	343	S 40° 3' 42" W	50.02'
343	342	S 42° 51' 5" E	43.64'
342	341	S 42° 07' 52" E	29.40'
341	340	S 51° 22' 36" E	28.70'
340	339	S 46° 46' 45" E	39.17'
339	338	S 43° 46' 47" E	38.86'
338	337	S 42° 39' 34" E	28.39'
337	323	S 13° 37' 41" E	44.51'
323	322	S 14° 48' 33" E	39.19'
322	321	S 15° 36' 40" E	43.86'
321	320	S 13° 7' 1" W	32.69'

TH	EAST
47.825	802045.940
68.706	802026.699
36.764	801999.811
23.590	801971.265
41.504	801948.843
63.304	801929.124

FROM PT#	TO PT#	WETLANDS BEARING	DIST.
329	361	N 81° 15' 14" W	27.54'
361	362	N 57° 10' 27" W	25.05'
362	363	N 41° 58' 18" W	28.67'
363	364	N 38° 55' 09" W	47.39'
364	365	N 44° 51' 14" W	28.02'
366	367	N 42° 32' 10" W	25.87'
367	368	N 36° 37' 40" W	38.87'
387	386	S 24° 25' 13" E	32.66'
386	385	S 55° 41' 13" E	47.01'

12/9/92

HOWARD COUNTY HEALTH DEPARTMENT
Bureau of Environmental Health
3525-H Ellicott Mills Drive
Ellicott City, MD 21043
461-9933

APPLICATION FOR PITLESS ADAPTER, WELL PUMP AND PRESSURE TANK INSTALLATION

New Installation ☒
Replacement ☐

Receipt # 48390
Date 7/31/92

Name of Installer Allen M. VanSant Inc Telephone 442-2221

License Number 1862
Certified Well Pump Installer ☐ Well Driller ☐ Registered Plumber ☒

Name of Property Owner Ronald L Hines Telephone 596-9090
Subdivision Savine Property Lot # 11 Well Tag # HO-88-1636
Site Address 13720 Trindale Mill Rd.

Pump
1. Type
a. Deep well jet ☐
b. Shallow well jet ☐
c. Submersible ☒
2. Make Goolds
3. Model # TEH10412
4. Capacity 5 GPM
5. Pump exceeds well capacity Yes ☒ No ☐
6. If Yes, is low pressure cutoff switch installed? Yes ☒ No ☐
7. What methods are used to protect the pump and electrical wiring from vibrations? Torque arrestors ☐ Cable guards ☒ Other ☐
Motor
1. Horsepower 1HP
2. RPM ☐
3. Voltage ☐
a. 110 ☐
b. 220 ☒
Pitless Adapter
1. Make Howard
2. Model # ☐
3. Depth 3ft

Tank
1. Capacity 42
2. Pressure relief valve? Yes
Pitless adapter @ 4ft
+ water line OK to cover
HP 12/7/92
Piping
1. Type 1/2"
2. Size 1"
3. NSF and/or BOCA Code approved 1/24
4. Depth of supply line 3ft
Well data
1. Depth 400 ft.
2. Yield 4 1/2 GPM
3. Static water level ☐ ft.
4. Will water supply be disinfected by installer? Yes

I understand that it is my responsibility to notify the Howard County Health Department when the installation is ready for inspection (otherwise this permit is null and void).

All information given above is true to the best of my knowledge.

Signature of Applicant: _____

Date: 7-28-92

Note: A sticker indicating approval/status of the installation will be placed on the well casing at the time of the inspection.

C1 0973 SEQUENCE NO. (DENY USE ONLY)
(THIS NUMBER IS TO BE PUNCHED IN COLS. 3-6 ON ALL CARDS)

STATE OF MARYLAND
WELL COMPLETION REPORT
FILL IN THIS FORM COMPLETELY
PLEASE PRINT OR TYPE

THIS REPORT MUST BE SUBMITTED WITHIN
45 DAYS AFTER WELL IS COMPLETED.

COUNTY NUMBER A45673

ST/CO USE ONLY
DATE Received

DATE WELL COMPLETED

Depth of Well

OK MR
1/2/91

PERMIT NO.
FROM "PERMIT TO DRILL WELL"
47-80-1636

OWNER Hines last name first name
STREET OR RD Triadelphia Mill Rd TOWN Dayton
SUBDIVISION SARINE PRDP SECTION LOT 11

WELL LOG

Not required for driven wells

STATE THE KIND OF FORMATIONS
PENETRATED, THEIR COLOR, DEPTH,
THICKNESS AND IF WATER BEARING

DESCRIPTION (Use additional sheets if needed) FEET FROM TO Check if water bearing

SANDSTONE 0 58
Gneiss rock 58 400

GROUTING RECORD

WELL HAS BEEN GROUTED (Circle Appropriate Box) YES [Y] NO [N]
TYPE OF GROUTING MATERIAL CEMENT [CM] BENTONITE CLAY [BC]
NO. OF BAGS 15 NO. OF POUNDS 140
GALLONS OF WATER 90
DEPTH OF GROUT SEAL (to nearest foot) from 0 ft. to 50+ ft.
(enter 0 if from surface)

CASING RECORD

casing types insert appropriate code below
STEEL [ST] CONCRETE [CO]
PLASTIC [PL] OTHER [OT]
MAIN CASING TYPE Nominal diameter top (main) casing (nearest inch) Total depth of main casing (nearest foot)
ST 6 13

OTHER CASING (if used) diameter inch depth (feet) from to

screen type or open hole

SCREEN RECORD

insert appropriate code below
STEEL [ST] BRASS [BR] OPEN HOLE [HO]
PLASTIC [PL] OTHER [OT]

C2

DEPTH (nearest ft.)
Hole 60 400
SLOT SIZE 1 2 3
DIAMETER OF SCREEN (NEAREST INCH) 56 60
from to

GRAVEL PACK IF WELL DRILLED WAS FLOWING WELL INSERT F IN BOX 68

OEP USE ONLY (NOT TO BE FILLED IN BY DRILLER)
T (E.R.O.S.)
70 72
TELESCOPE CASING LOG INDICATOR OTHER DATA

C3

PUMPING TEST

HOURS PUMPED (nearest hour) 3
PUMPING RATE (gal. per min. to nearest gal.) 56
METHOD USED TO MEASURE PUMPING RATE Bucket
WATER LEVEL (distance from land surface) BEFORE PUMPING 28
WHEN PUMPING 165
TYPE OF PUMP USED (for test) A air P piston T turbine C centrifugal R rotary O other (describe below) J jet S submersible

PUMP INSTALLED

DRILLER WILL INSTALL PUMP YES [X] NO []
(CIRCLE) (YES or NO)
IF DRILLER INSTALLS PUMP, THIS SECTION MUST BE COMPLETED FOR ALL WELLS EXCEPT HOME USE
TYPE OF PUMP INSTALLED PLACE (A,C,J,P,R,S,T,O) IN BOX - SEE ABOVE: 29
CAPACITY: GALLONS PER MINUTE (to nearest gallon) 31 35
PUMP HORSE POWER 37 41
PUMP COLUMN LENGTH (nearest ft.) 43 47
CASING HEIGHT (circle appropriate box and enter casing height) above [X] below [] LAND SURFACE (nearest foot) 50 51

LOCATION OF WELL ON LOT

SHOW PERMANENT STRUCTURE SUCH AS BUILDING, SEPTIC TANKS, AND/OR LANDMARKS AND INDICATE NOT LESS THAN TWO DISTANCES (MEASUREMENTS TO WELL)

CIRCLE APPROPRIATE LETTER
A A WELL WAS ABANDONED AND SEALED WHEN THIS WELL WAS COMPLETED
E ELECTRIC LOG OBTAINED
P TEST WELL CONVERTED TO PRODUCTION WELL

I HEREBY CERTIFY THAT THIS WELL HAS BEEN CONSTRUCTED IN ACCORDANCE WITH COMAR 26.04.04 "WELL CONSTRUCTION" AND IN CONFORMANCE WITH ALL CONDITIONS STATED IN THE ABOVE CAPTIONED PERMIT, AND THAT THE INFORMATION PRESENTED HEREIN IS ACCURATE AND COMPLETE TO THE BEST OF MY KNOWLEDGE.

DRILLERS IDENT. NO. 238
DRILLERS SIGNATURE (MUST MATCH SIGNATURE ON APPLICATION)
SITE SUPERVISOR (sign. of driller or journeyman responsible for sitework if different from permittee)

COUNTY

B 1 2629 SEQUENCE NO.
(DP USE ONLY)STATE OF MARYLAND
APPLICATION FOR PERMIT TO DRILL WELL
please print or type

STATE PERMIT NUMBER

H0-88-1636
fill in this form completely(THIS NUMBER IS TO BE PUNCHED
IN COLS. 3-6 ON ALL CARDS)

Date Received (APA)

103090

OWNER INFORMATION

HINES L. RONALL

15 Last Name 34 Owner First Name

18307EN OAKS RD

36 Street or RFD 55 DAYTON MD

57 Town 70 State 72 Zip 76

DRILLER INFORMATION

Driller's Name 77 License No. 80

Firm Name WELL DRILLING

Address 5512 Ridge Rd. Mt. Airy, Md. 21778

Signature 10/29/90 Date

WELL INFORMATION

APPROX. PUMPING RATE (GAL. PER MIN.) 3

AVERAGE DAILY QUANTITY NEEDED (GAL. PER DAY) 500

USE FOR WATER (CIRCLE APPROPRIATE BOX)

- ☒ HOME (SINGLE OR DOUBLE HOUSEHOLD UNIT ONLY)
- ☐ FARMING (LIVESTOCK WATERING & AGRICULTURAL IRRIGATION)
- ☐ INDUSTRIAL, COMMERCIAL, STATE AND FEDERAL GOV. OTHER (REQUIRES APPROPRIATION PERMIT)
- ☐ PUBLIC OR PRIVATE WATER COMPANY (REQUIRES APPROPRIATION PERMIT AND STATE HEALTH DEPARTMENT APPROVAL)
- ☐ TEST, OBSERVATION, MONITORING (MAY REQUIRE APPROPRIATION PERMIT)

APPROXIMATE DEPTH OF WELL 300 FEET

APPROXIMATE DIAMETER OF WELL 6 NEAREST INCH

METHOD OF DRILLING (circle one)

BORED (or Augered) JETTED Jetted & DRIVEN

30 AIR-ROTARY 37 AIR-PERCussion ROTARY (Hydraulic Rotary)

CABLE REVerse-ROTary Drive-POINT

other

REPLACEMENT OR DEEPEMED WELLS

(CIRCLE APPROPRIATE BOX)

- ☒ THIS WELL WILL NOT REPLACE AN EXISTING WELL
- ☐ THIS WELL WILL REPLACE A WELL THAT WILL BE ABANDONED AND SEALED
- ☐ THIS WELL WILL REPLACE A WELL THAT WILL BE USED AS A STANDBY
- ☐ THIS WELL WILL DEEPEMED AN EXISTING WELL

PERMIT NUMBER OF WELL TO BE REPLACED OR DEEPEMED (IF AVAILABLE) 41

Not to be filled in by driller (OEP USE ONLY)

APPROX. PERMIT NUMBER 54 GAP 63

FORCE MR WRITE INITIALS IN BOX PERMIT No. H0-88-1636

SPECIAL CONDITIONS

B 3

LOCATION OF WELL

HOWARD

8 COUNTY 21

23 SUBDIVISION 42


SECTION 44 46 LOT 11 48 50

52 NEAREST TOWN 71

MILES FROM TOWN (enter 0 if in town) 3 73 76 77 78

B 4

DIRECTION OF WELL FROM TOWN (CIRCLE BOX)

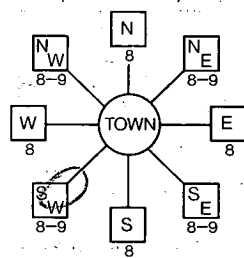

Triadelphia mill Road

11 NEAR WHAT ROAD 30

ON WHICH SIDE OF ROAD (CIRCLE APPROPRIATE BOX)

34 37

DISTANCE FROM ROAD

ENTER FT or MI 41

NOT TO BE FILLED IN BY DRILLER
HEALTH DEPARTMENT APPROVAL

Howard

COUNTY NAME COUNTY NO.

STATE SIGNATURE

DATE ISSUED

112090 Mark E. Riffin 5/20/90

43 48 CO SIGNATURE 57

NORTH GRID 50 55

EAST GRID 57 63

SHOW MAJOR FEATURES OF BOX & LOCATE WELL WITH AN X

SOURCES OF DRILLING WATER

1. WELL

2.

3.

WRITE THE BOX NUMBER FROM THE MAP HERE

E 80X3

N 50X5

000 000

DRAW A SKETCH BELOW SHOWING LOCATION OF WELL IN RELATION TO NEARBY TOWNS AND ROADS AND GIVE DISTANCE FROM WELL TO NEAREST ROAD JUNCTION

