

8/30/91 12:00
Late P.M.

Tax ID - 04-326652

PERMIT

SEWAGE DISPOSAL SYSTEM

DEPARTMENT OF HEALTH AND MENTAL HYGIENE

HOWARD COUNTY HEALTH DEPARTMENT
BUREAU OF ENVIRONMENTAL HEALTH
461-9933

INDEXED

P 47422

A 46667

DISTRICT 4th

DATE 8/23/91

DATE SYSTEM APPROVED 8/22/91

INSPECTOR C. B. A.

HOLLIS MCKINNEY - PENNA QUALITY HOMES IS PERMITTED TO INSTALL ALTER

ADDRESS 1125 CALLISE ST HANOVER, PA. PHONE 717-632-7583

SUBDIVISION Riggs Property LOT Parcel A ROAD Union Chapel and McNeal Road
15675

PROPERTY OWNER Mr. Michael C. Barry Quyn & Theresa Simmons

ADDRESS _____

SEPTIC TANK CAPACITY 1000 GALLONS (2) { PUMP TANK TO BE INSTALLED FOR FUTURE PUMP INSTALLATION. c.w. }

NUMBER OF BEDROOMS 3

180 SQUARE FEET PER BEDROOM

LINEAR FEET OF TRENCH REQUIRED 135

BLDG. PERMIT SIGNED
AND RETURNED 4/12/95
Serial # 58923 - deck

TRENCHES - 180 sq. ft. per bedroom. Trench to be 2 feet wide. Inlet 3 feet below original grade. Bottom maximum depth 7 feet below original grade. Effective area begins at 3 feet below original grade. 4 feet of stone below distribution pipe.

LOCATION - Place the distribution box on the 485' contour interval, approximately 80' from the rear (429') lot line and 250' from the right (538') lot line. Run trenches along contour toward right-rear corner of lot. "Keep 100' + from water well with septic. OR HIGHER IF POSSIBLE.


NOTE - No trench to exceed 100 feet in length. Provide 6" - 8" diameter cleanout and cap to grade or above on septic tank. OK 6/7/91 Bit

PLANS APPROVED BY Mark Rifkin cm DATE 03/18/91

- COVER NO WORK UNTIL INSPECTED AND APPROVED
- NEITHER THE HOWARD COUNTY COUNCIL NOR THE HEALTH DEPARTMENT IS RESPONSIBLE FOR THE SUCCESSFUL OPERATION OF ANY SYSTEM
- NOTE: CLEANOUT REQUIRED EVERY 70 FEET OF SEWER LINE AND/OR AT 90° SWEEPS IN LINES FROM HOUSE TO DRAIN FIELDS, 90° ELBOWS NOT ACCEPTABLE.
- NOTE: ALL PARTS OF SEPTIC SYSTEMS (I.E. TANK, DISTRIBUTION BOX TRENCHES) TO BE 100 FEET FROM WELL (UNLESS OTHERWISE SPECIFICALLY AUTHORIZED)
- NOTE: IF DEEP TRENCH(ES) ARE USED CALL FOR INSPECTION BEFORE AND AFTER PLACING GRAVEL IN TRENCH(ES)
- NOTE: NO DRY WELL SHALL EXCEED 15 FOOT IN DIAMETER NO ABSORPTION TRENCH TO EXCEED 100 FEET IN LENGTH
- NOTE: ALL PIPE FROM HOUSE TO SEPTIC TANK MUST BE CAST IRON OR SCHEDULE 35/40 PVC OR ABS
- PERMIT VOID AFTER TWO YEARS
- NOTE: INSTALL STAND PIPE ON SEPTIC TANK AND DRY WELL STAND PIPES MUST BE 6 INCHES IN DIAMETER CAST IRON. CONCRETE OR TERRA COTTA OR PVA OR ABS ACCEPTED. IF TOP OF SEPTIC TANK IS DEEPER THAN 3 FEET. MANHOLE TO GRADE REQUIRED.
- NOTE: DISTRIBUTION BOXES MUST HAVE BAFFLES

***INSTALLER IS RESPONSIBLE FOR OBTAINING FINAL APPROVAL ON THIS PERMIT**

A 46667

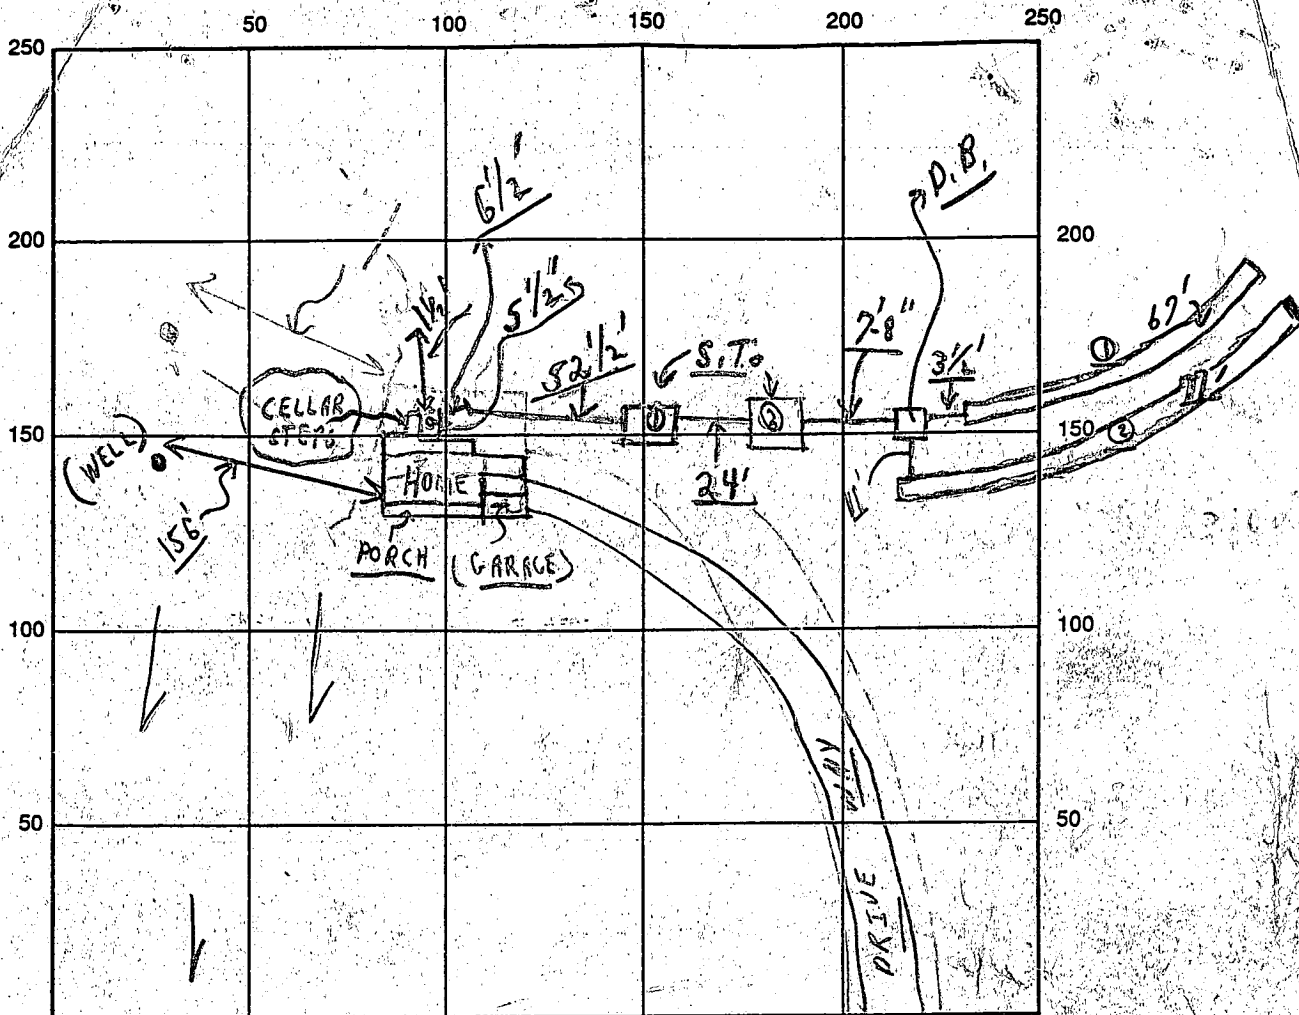

← Glenwood

INDICATE NORTH - NAME ADJOINING ROADWAY AS BASE LINE

→ DRAISY

SEPTIC TANK LEVEL ① OK ② OK Union Chapel Road S.T. ① OK / ② OK
 DISTRIBUTION BOX LEVEL OK (Baffles is in)
 DRAIN FIELD/TITLE DEPTH 7 + average FT. TRENCH WIDTH 2 FT. INLET DEPTH 3 FT.
 EFFECTIVE GRAVEL DEPTH 4 + FT. TOTAL LENGTH 067 / 079 FT. } 144 +
 NUMBER OF TRENCHES 2 ONE SIDEWALL AREA 570 SQ. FT.
 DRYWALL INSIDE DIAMETER — FT. EFFECTIVE DEPTH BELOW INLET — FT.
 ABSORBENT AREA 576 + SQ. FT.

REMARKS: 8/30/91 Partial, ok for stone in #1 Trench only;
ok to cover from house to 1' of distribution box;
8/30/91 Final - OK TO COVER ALL WORK. #2 trench complete
7' deep per Fogler man. c.B.D.

8/30 No W.P.I.

DATE SYSTEM APPROVED 8/30/91 INSPECTOR Charles Bryan Strecker

APPLICATION

1-10-91

PERCOLATION TESTING

A 46667
P _____

HOWARD COUNTY HEALTH DEPARTMENT
BUREAU OF ENVIRONMENTAL HEALTH
P.O. BOX 476 ELLICOTT CITY, MARYLAND 21043
TELEPHONE: 461-9933

12490 Preview etc.
May have wet soils
at lower end. 300ft
buffer to streams JEN

DISTRICT _____
DATE 12/6/90

TO: THE COUNTY HEALTH OFFICER
ELLICOTT CITY, MARYLAND

I, HEREBY, APPLY FOR THE NECESSARY TEST IN ORDER TO CONSTRUCT (OR RECONSTRUCT) A SEWAGE DISPOSAL SYSTEM.

PROPERTY OWNER Adelaide Close Riggs

ADDRESS 3104 MacNEILLE Rd (McNEAL) PHONE 301-442-2685
WOODBINE MD 21297

PROSPECTIVE BUYER (MR. MICHAEL G. BARRY)

ADDRESS 75 Shelton Circle Reisterstown PHONE 301-526-4043
MD 21136

PROPERTY LOCATION:

SUBDIVISION Riggs Property LOT NO. PARCEL A

ROAD AND DESCRIPTION CORNER of Union Chapel Rd & McNEAL (MacNEILLE) Rd
15675 Union Chapel Rd

TAX MAP 14 PARCEL # A

SIZE OF LOT 3.1337 Ac

BLDG. PERMIT SIGNED
AND RETURNED 5-21-91
Sub # 37782
TYPE BLDG. SINGLE FAMILY - 3Bm
(SINGLE FAMILY DWELLING OR COMMERCIAL)

THE SYSTEM INSTALLED UNDER THIS APPLICATION IS ACCEPTABLE ONLY UNTIL PUBLIC FACILITIES BECOME AVAILABLE. I FULLY UNDERSTAND THE FEE CONNECTED WITH THE FILING OF THIS PERC TEST APPLICATION IS NON-REFUNDABLE UNDER ANY CIRCUMSTANCES. I ALSO AGREE TO COMPLY WITH ALL M.O.S.H.A. REQUIREMENTS IN TESTING THIS LOT.

DM Covey DM
(SIGNATURE OF APPLICANT)

APPROVED BY _____ FOR _____ DATE _____

REJECTED BY _____ FOR _____ DATE _____

HOLD PENDING FURTHER TESTS _____ DATE _____




REASONS FOR REJECTION OR HOLDING 1/10/91 - CHECK WITH CRAIG TO SEE IF PUMP
SYSTEM OK

HD-216



THIS IS NOT A PERMIT

A 46667

(B) SOIL PROFILE

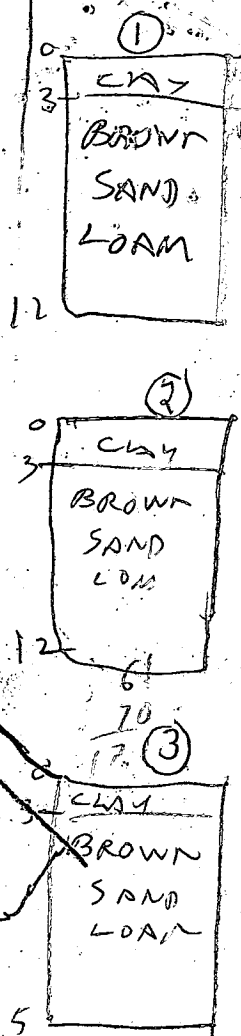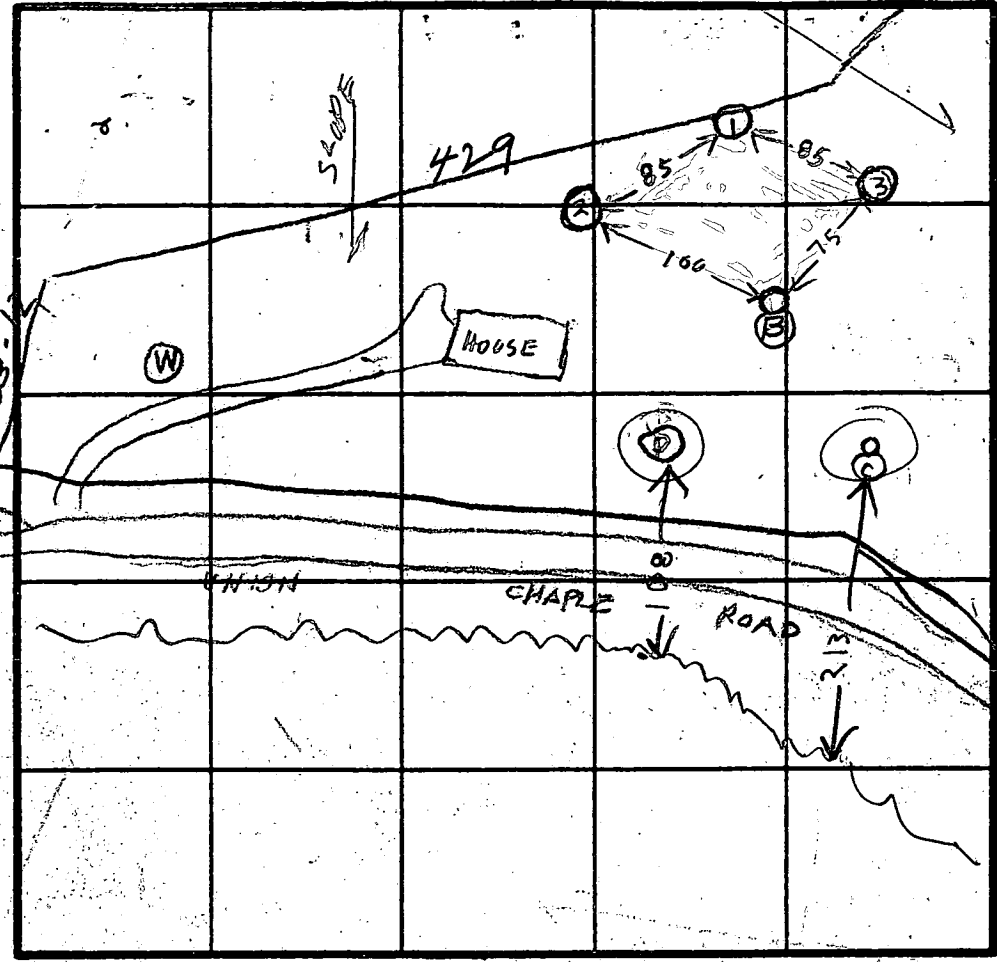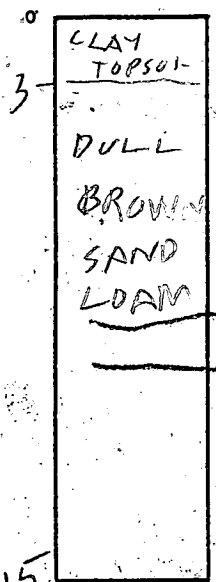

INDICATE NORTH - NAME ADJOINING ROADWAY AS BASE LINE

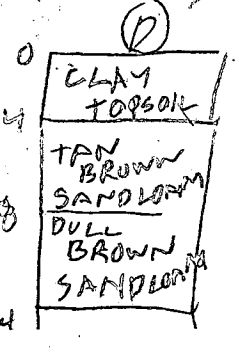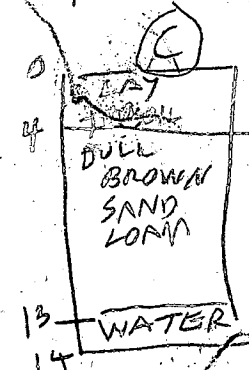

DATE	TEST NO.	DEPTH	PRE-WET		TEST - 1' DROP		TIME	
			START	STOP	START	STOP		
11/10/90	B.S. B.V.	4 15	1131 OK	1137	1137	1144	7	
11/10/91	(E.V.)	14	WATER 13 FT TOO CLOSE TO STREAM					
11/10/91	(D.V.)	14	TOO CLOSE TO STREAM					
	I.S. I.D.	4 8	1202 1213	1205 1216	1205 1216	1209 1220	4 4	
	IV	12	OK					
	2.S. 2.V.	4 12	155 OK	208	208	221	13	
	3.S. 3.V.	14.5 15	159 OK	203	203	206	3	

REMARKS: Holes (B)(C)(D) dug per survey on Plat Hole (D)(E) dug Differently R11

TYPE OF SOIL _____


TESTED BY R. HODGES

ALSO PRESENT PACTUGLE H. MCKIMME MR. CAVEY

63
45

PERC. TEST RESULTS ○ = APPROVED TEST ● = NO TEST


LOT #	PERC. I.D.	TYPE TEST	TIME	COMMENTS	DATE
1	C		—	TOO CLOSE TO STREAM	1-10-91
	1	TILE FIELD	7 MIN.	APPROVED	1-10-91
	2	TILE FIELD	7 MIN.	APPROVED	1-10-91
	3	TILE FIELD	3 MIN.	APPROVED	1-10-91
	B	TILE FIELD	7 MIN.	APPROVED	1-10-91
	D		—	TOO CLOSE TO STREAM	1-10-91

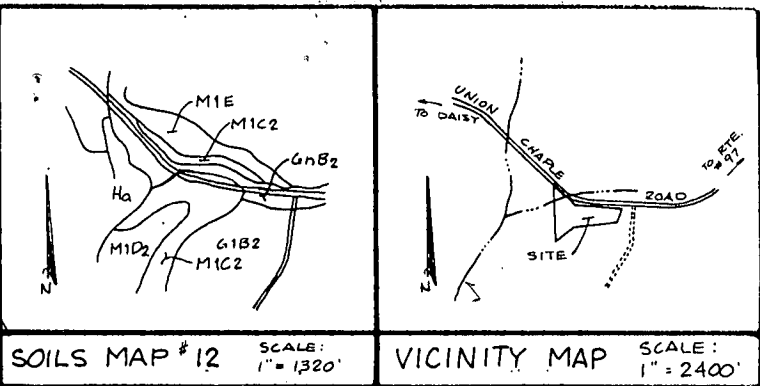

This is to certify that the percolation tests are accurately shown as performed in the field.

Daniel R. Staley 2-8-91
 DANIEL R. STALEY * 10735 DATE

SOILS MAP #12 SCALE: 1" = 1320'
 VICINITY MAP SCALE: 1" = 2400'

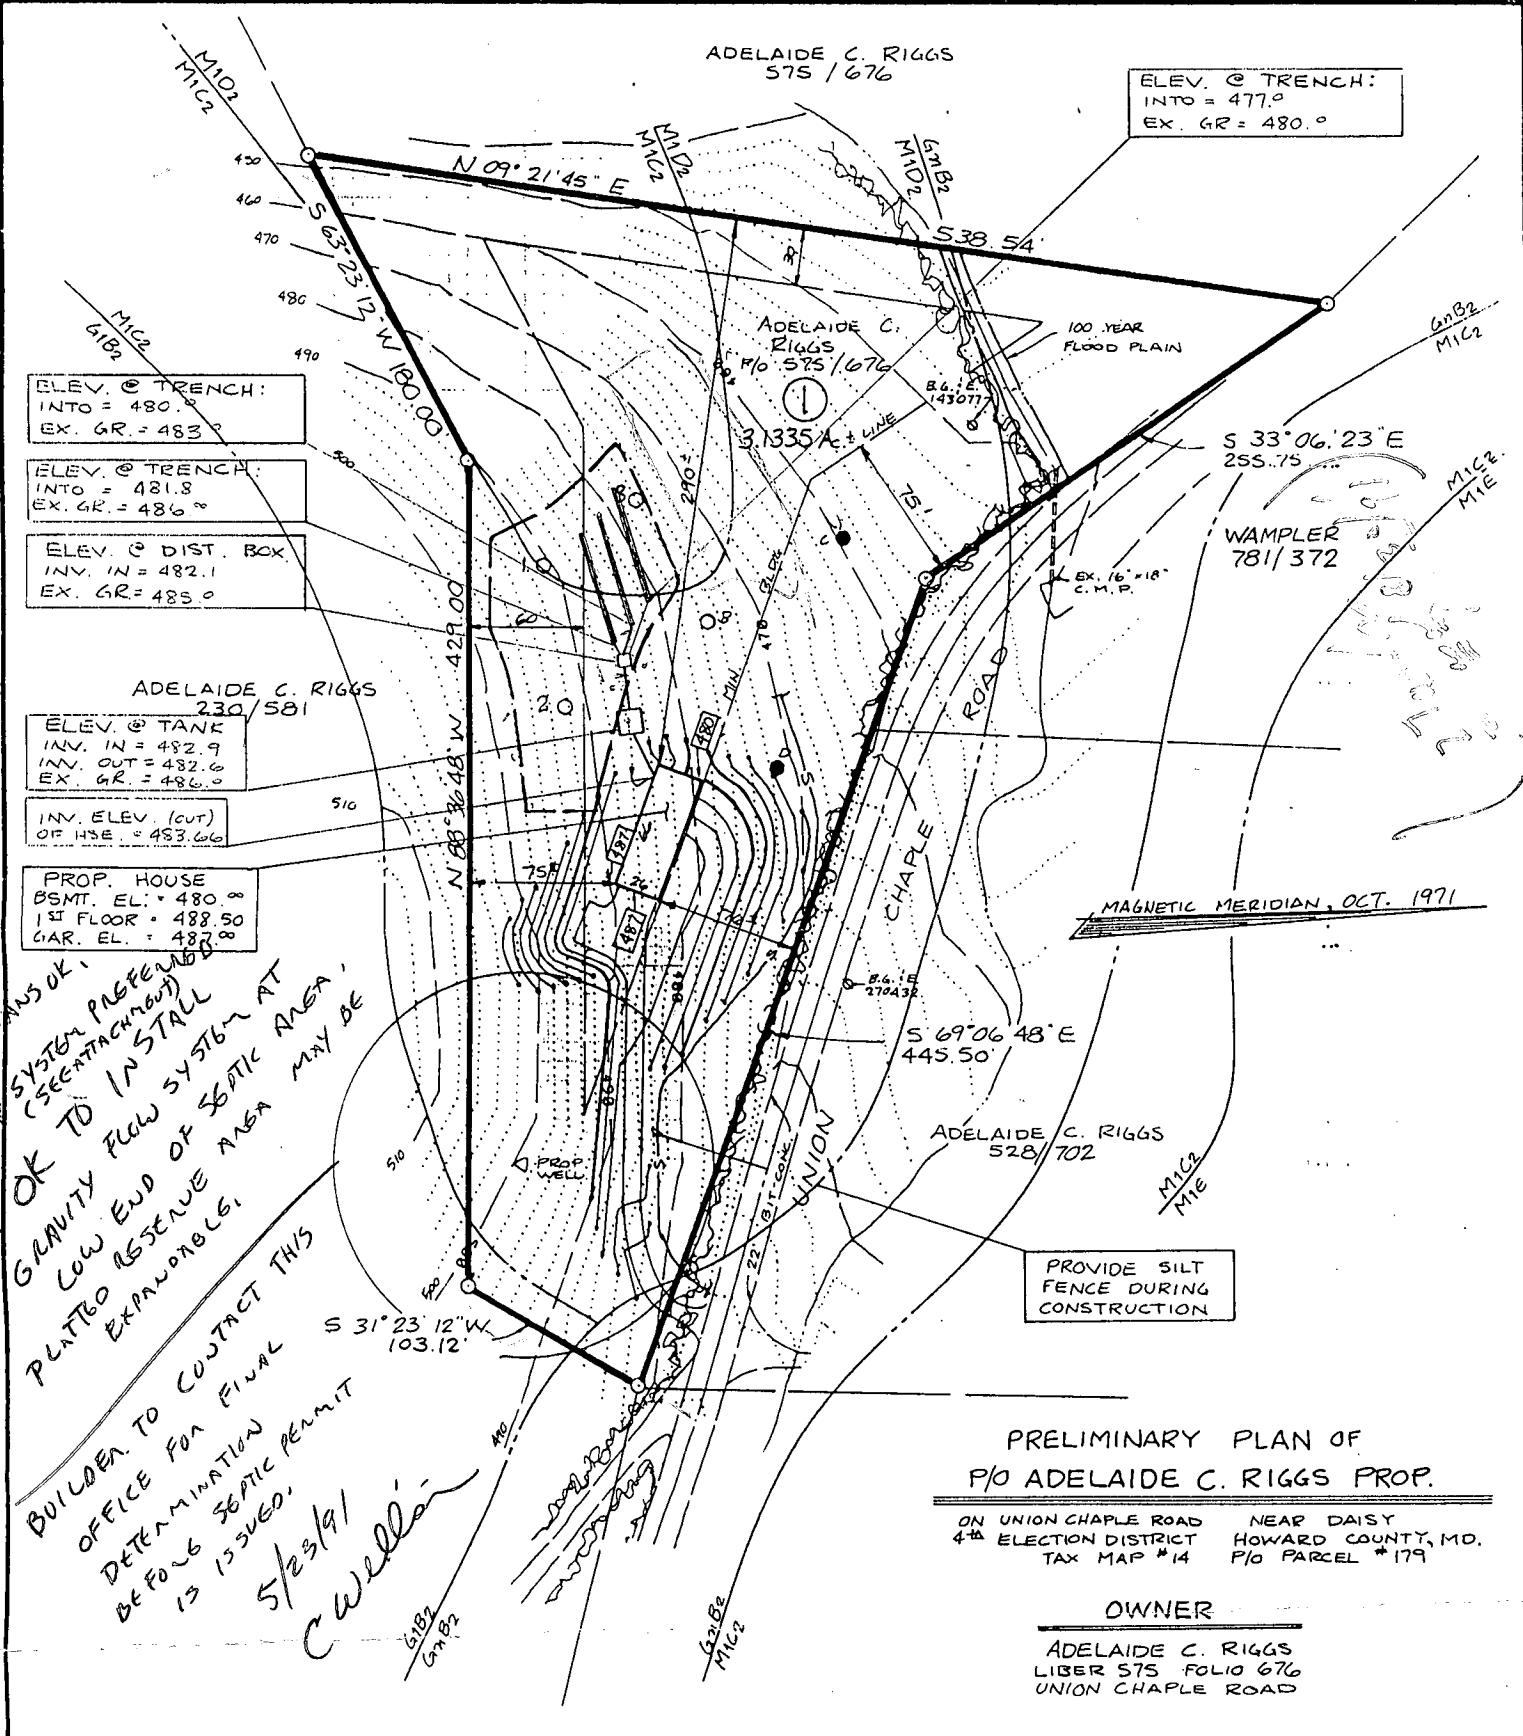

ELEV. @ TRENCH:
 INTO = 480.0
 EX. GR. = 483.0

ELEV. @ TRENCH:
 INTO = 481.8
 EX. GR. = 486.0

ELEV. @ DIST. BOX
 INV. IN = 482.1
 EX. GR. = 485.0

ADELAIDE C. RIGGS
 230/581
 ELEV. @ TANK
 INV. IN = 482.9
 INV. OUT = 482.6
 EX. GR. = 486.0

INV. ELEV. (OUT)
 OF HSE. = 483.66

PROP. HOUSE
 BSMT. EL. = 480.00
 1ST FLOOR = 488.50
 GAR. EL. = 488.00

*BP PLANS OK,
 PUMP SYSTEM PATTERNED
 (SEE ATTACHMENT)
 BUT OK TO INSTALL
 GRAVITY FLOW SYSTEM AT
 LOW END OF SEPTIC AREA,
 PLATTO RESERVE AREA MAY BE
 EXPANDED.
 BUILDER TO CONTACT THIS
 OFFICE FOR FINAL
 DETERMINATION
 BEFORE SEPTIC PERMIT
 IS ISSUED.
 5/23/91
*C. Wells**

PROVIDE SILT FENCE DURING CONSTRUCTION

PRELIMINARY PLAN OF
 P/O ADELAIDE C. RIGGS PROP.

ON UNION CHAPLE ROAD NEAR DAISY
 4th ELECTION DISTRICT HOWARD COUNTY, MD.
 TAX MAP #14 P/O PARCEL #179

OWNER

ADELAIDE C. RIGGS
 LIBER 575 FOLIO 676
 UNION CHAPLE ROAD

NOTE
 There are no existing wells or septic within 100' of this property, unless otherwise shown hereon.



D.R.S. & ASSOCIATES
 LAND DESIGN CONSULTANTS
 52 WINTERS STREET
 WESTMINSTER, MARYLAND 21157
 848-4060 876-6040



Daniel R. Staley
 DATE: NOV. 27, 1990 SCALE: 1" = 100'

DATE	REVISION
1/29/91	Revol. Septic Area / Additional Percs.
2/8/91	PERC. TEST RESULTS
4/25/91	GRADING
5/15/91	SEPTIC SYSTEM

SHEET NO. 1 OF 1
 DWG. NO. C-183

PERC TEST RESULTS

LOT #	PERC. I.D.	TYPE TEST	TIME	COMMENTS	DATE
1.	A				
	B				
	C				
	D				

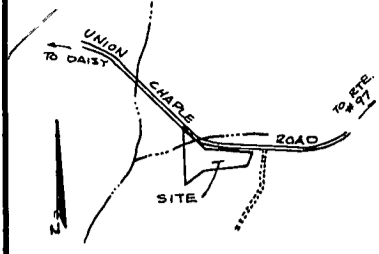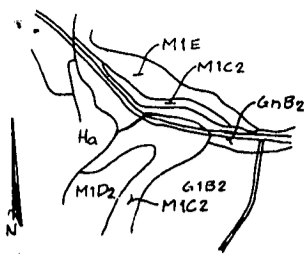


This is to certify that the percolation tests are accurately shown as performed in the field.


SOILS MAP # 12 SCALE: 1" = 1320'

VICINITY MAP SCALE: 1" = 2400'

DANIEL R. STALEY * 10735

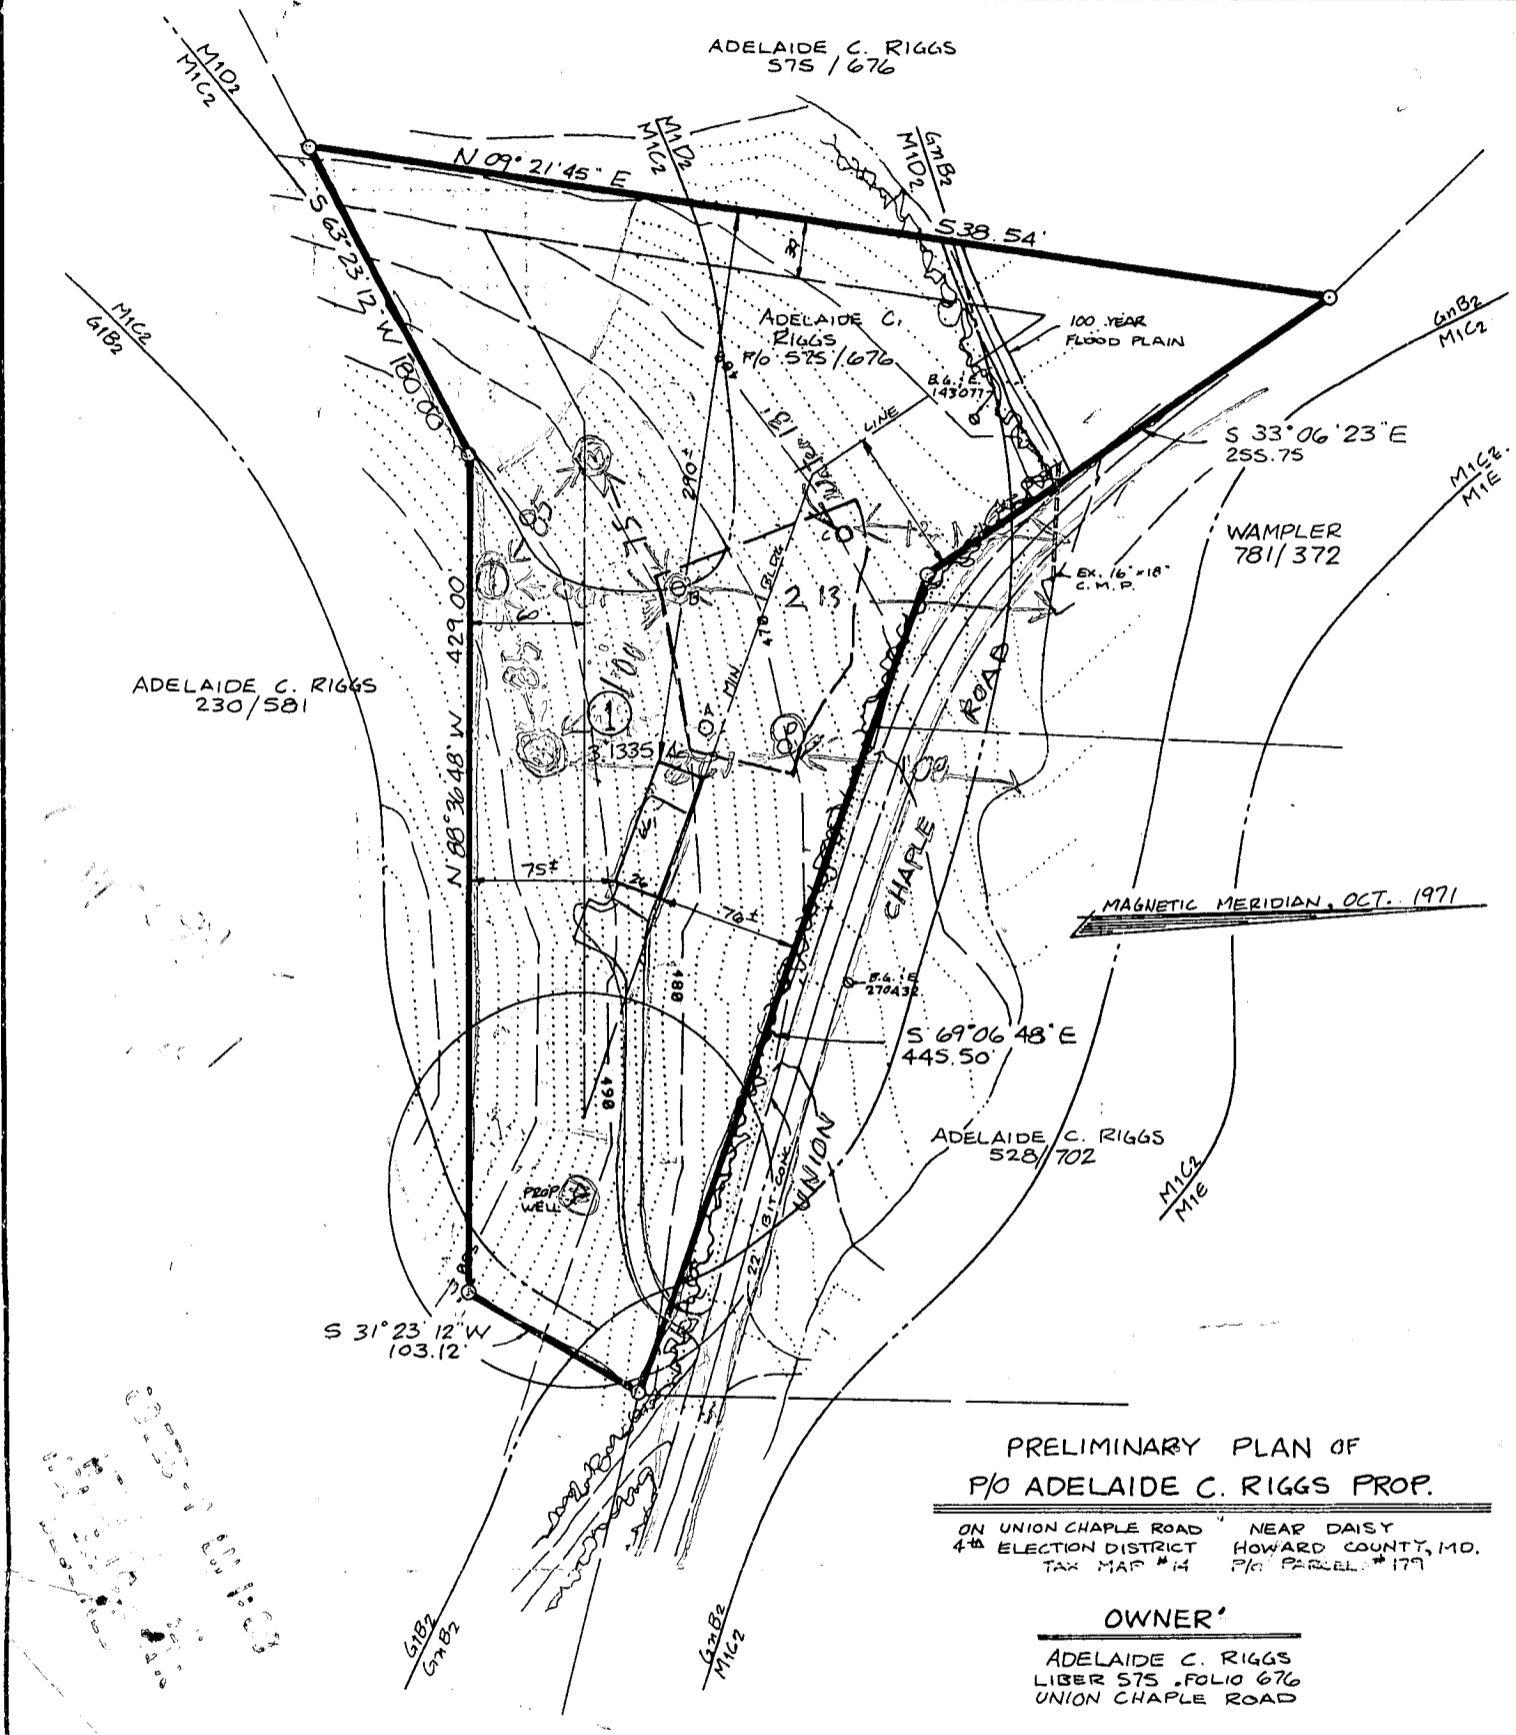

NOTE
There are no existing wells or septic within 100' of this property, unless otherwise shown hereon.

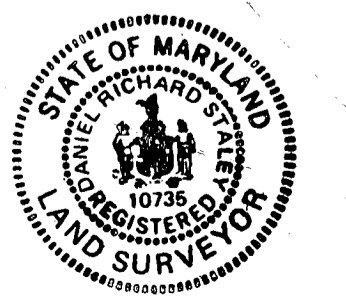

D.R.S. & ASSOCIATES
LAND DESIGN CONSULTANTS
52 WINTERS STREET
WESTMINSTER, MARYLAND 21157
848-4060 876-6040

Daniel R. Staley


DATE: NOV. 27, 1990 SCALE: 1" = 100'

DATE	REVISION

SHEET NO. 1 OF 1
DWG. NO.

CASE No. 1677-24 F

NOTE: This location for title purposes only - not to be used for determining property lines. Property corner Markers Not guaranteed by this location

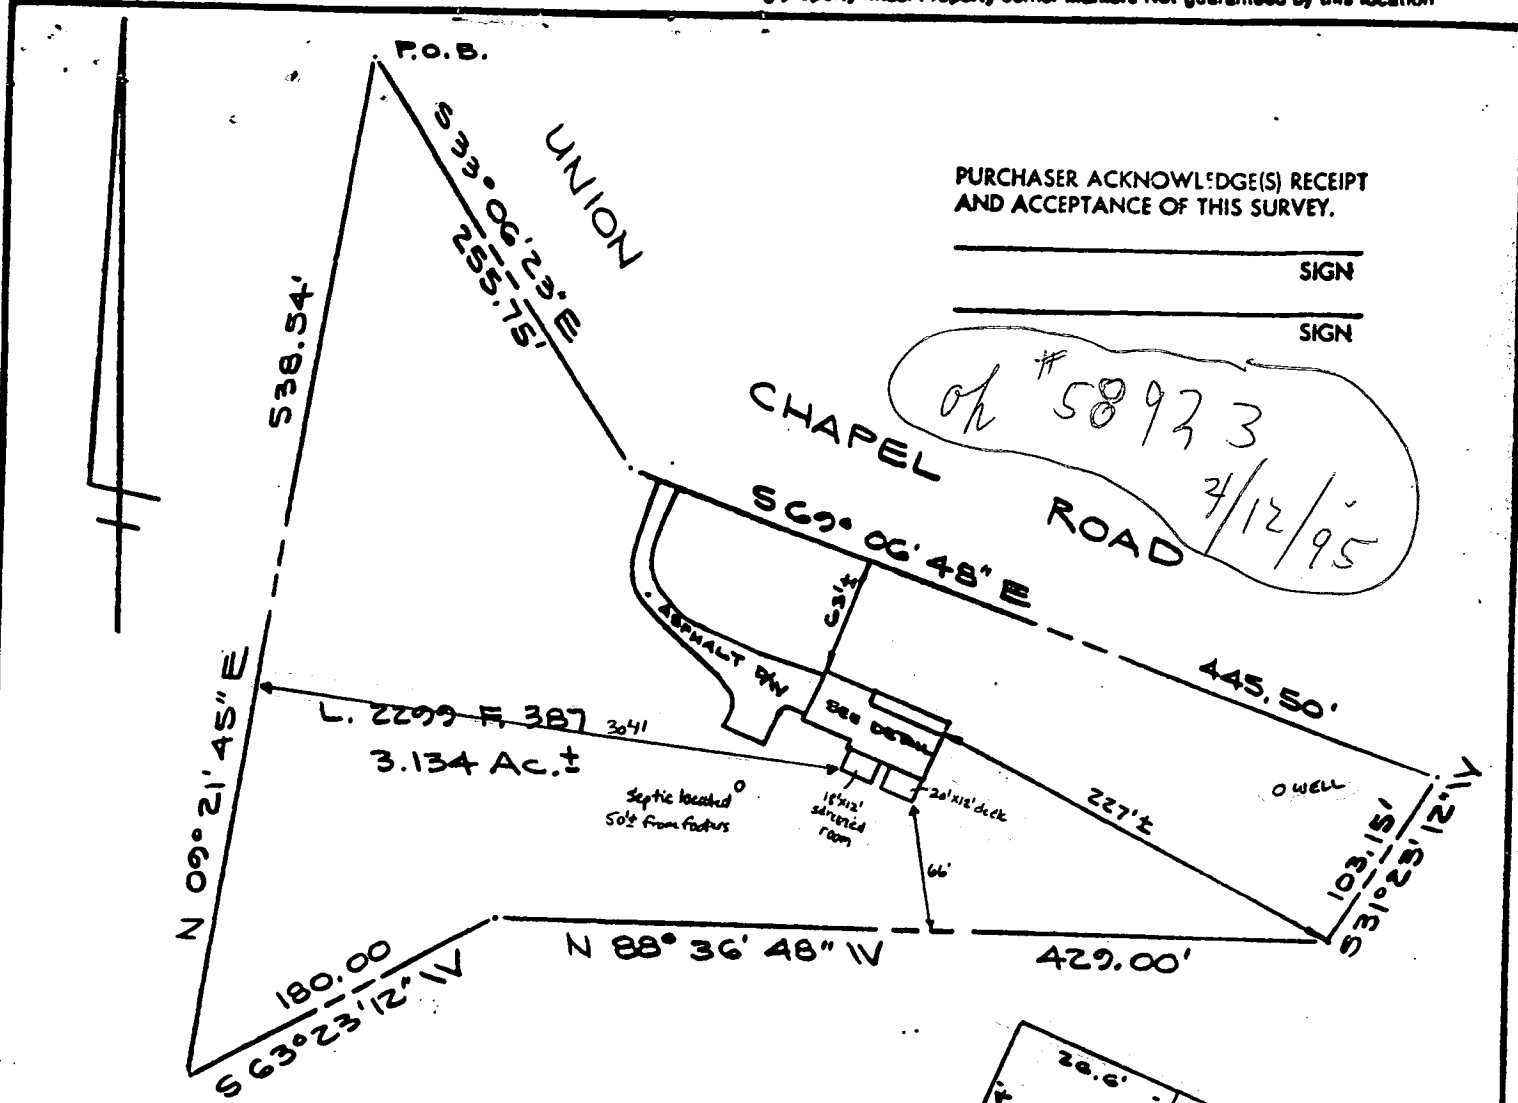


PURCHASER ACKNOWLEDGE(S) RECEIPT AND ACCEPTANCE OF THIS SURVEY.

SIGN

SIGN

LOCATION OF HOUSE
PROPERTY OF
M.G. & M.M. BARRY
LIBER 2299 FOLIO 387
HOWARD COUNTY, MD.

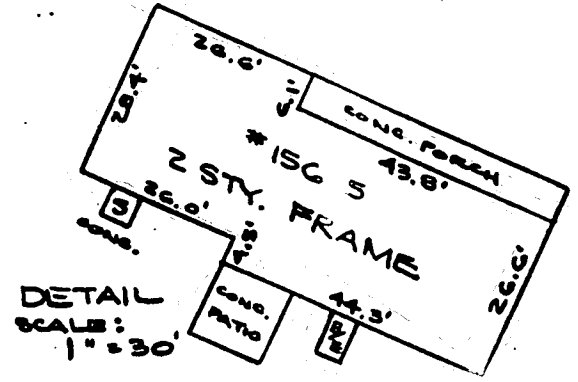

HUD FLOOD PANEL NO.: 240044-0014B

ZONE: C

CERTIFICATE

I HEREBY CERTIFY THAT THE LOCATION OF ALL THE EXISTING IMPROVEMENTS ON THE ABOVE DESCRIBED PROPERTY HAS BEEN CORRECTLY ESTABLISHED BY A TRANSIT-TAPE SURVEY AND UNLESS OTHERWISE SHOWN, THERE ARE NO ENCROACHMENTS.

[Signature]
 HALLER ASSOCIATES
 SURVEYING ENGINEERING PLANNING
 MARYLAND PROFESSIONAL SURVEYOR

REFERENCES	
PLAT BK.	
PLAT NO.	
LIBER	2299
FOLIO	387

HALLER ASSOCIATES
 SURVEYING • ENGINEERING • PLANNING

(301) 863-1843 822 TRAIL AVENUE, FREDERICK, MARYLAND 21701

DATE OF SURVEYS	SCALE: 1" = 100'
WALL CHECK	DRAWN BY: HLR
INS. LOC: 03-10-24	JOB NO: 24-9428
BOUNDARY:	

C1 4542 SEQUENCE NO. (DENV USE ONLY)

STATE OF MARYLAND WELL COMPLETION REPORT

THIS REPORT MUST BE SUBMITTED WITHIN 45 DAYS AFTER WELL IS COMPLETED.

(THIS NUMBER IS TO BE PUNCHED IN COLS. 3-6 ON ALL CARDS)

COUNTY NUMBER A46667

ST/CO USE ONLY DATE Received

DATE WELL COMPLETED 0410391

Depth of Well 100 (TO NEAREST FOOT)

PERMIT NO. FROM "PERMIT TO DRILL WELL" 110-28-1620

OWNER: BARRI MICHAEL STREET OR RFD: UNION CHAPEL RD TOWN: UNION CHAPEL SUBDIVISION: RIGGS PROP SECTION: LOT: 1

WELL LOG Not required for driven wells STATE THE KIND OF FORMATIONS PENETRATED; THEIR COLOR, DEPTH, THICKNESS AND IF WATER BEARING

Table with columns: DESCRIPTION (Use additional sheets if needed), FEET (FROM, TO), Check if water bearing. Rows include Brown shale, Gray shale, Brown sandstone, Gray rock, Limestone.

GROUTING RECORD WELL HAS BEEN GROUTED (Y) (N) TYPE OF GROUTING MATERIAL CEMENT (CM) BENTONITE CLAY (BC)

CEMENT (CM) BENTONITE CLAY (BC) NO. OF BAGS 13 NO. OF POUNDS 222 GALLONS OF WATER 78 DEPTH OF GROUT SEAL (to nearest foot) from 0 to 20 ft.

CASING RECORD casing types insert appropriate code below (ST) (CO) (PL) (OT) STEEL CONCRETE PLASTIC OTHER

MAIN CASING TYPE (ST) Nominal diameter top (main) casing (nearest inch) 6 (63-64) Total depth of main casing (nearest foot) 23 (66-70)

OTHER CASING (if used) diameter inch depth (feet) from to

SCREEN RECORD screen type or open hole insert appropriate code below (ST) (BR) (HO) (PL) (OT) STEEL BRASS OPEN HOLE PLASTIC OTHER

DEPTH (nearest ft.) (HO) 21 (100) SLOT SIZE 1 2 3 DIAMETER OF SCREEN (NEAREST INCH) from to

GRAVEL PACK IF WELL DRILLED WAS FLOWING WELL INSERT F IN BOX 68

OEP USE ONLY (NOT TO BE FILLED IN BY DRILLER) TELESCOPE CASING LOG INDICATOR OTHER DATA

PUMPING TEST C3


HOURS PUMPED (nearest hour) 3 PUMPING RATE (gal. per min. to nearest gal.) 15 MEASURE PUMPING RATE 1 GAL WATER LEVEL (distance from land surface) BEFORE PUMPING 22 WHEN PUMPING 22 TYPE OF PUMP USED (for test) (A) air (P) piston (T) turbine (C) centrifugal (R) rotary (O) other (J) jet (S) submersible

PUMP INSTALLED DRILLER WILL INSTALL PUMP (YES) (NO) IF DRILLER INSTALLS PUMP, THIS SECTION MUST BE COMPLETED FOR ALL WELLS EXCEPT HOME USE TYPE OF PUMP INSTALLED PLACE (A,C,J,P,R,S,T,O) IN BOX - SEE ABOVE: CAPACITY: GALLONS PER MINUTE (to nearest gallon) PUMP HORSE POWER PUMP COLUMN LENGTH (nearest ft.) CASING HEIGHT (circle appropriate box and enter casing height) (+) above (below) LAND SURFACE 2 (nearest foot)

CIRCLE APPROPRIATE LETTER. A A WELL WAS ABANDONED AND SEALED WHEN THIS WELL WAS COMPLETED E ELECTRIC LOG OBTAINED P TEST WELL CONVERTED TO PRODUCTION WELL

I HEREBY CERTIFY THAT THIS WELL HAS BEEN CONSTRUCTED IN ACCORDANCE WITH COMAR 26.04.04 "WELL CONSTRUCTION" AND IN CONFORMANCE WITH ALL CONDITIONS STATED IN THE ABOVE CAPTIONED PERMIT, AND THAT THE INFORMATION PRESENTED HEREIN IS ACCURATE AND COMPLETE TO THE BEST OF MY KNOWLEDGE.

DRILLERS IDENT. NO. DRILLERS SIGNATURE (MUST MATCH SIGNATURE ON APPLICATION) SITE SUPERVISOR (sign of driller or journeyman responsible for sitework if different from permittee)

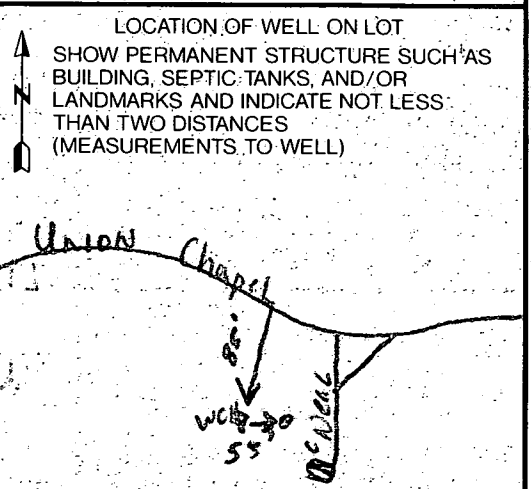

2:30 PM

SITE INSPECTION SHEET

OWNER: OSCAR STREAKER JR

DATE REQUESTED: 11/29/90

PHONE #: HOME 489 4906
WORK 795 1200

CONTRACTOR: EASTER DAY


ADDRESS: 1350 ROUTE 32 # ON MAILBOX

WELL TAG #: _____

OPPOSITE INDIAN HILL DR
WHITE GAPE CDD

COUNTY #: _____

PROPOSAL: O. STREAKER JR WANTS TO DRILL A REPLACEMENT
WELL BECAUSE HE IS UNHAPPY WITH THE WATER FROM EXISTING WELL
WELL MET WITH SANITARIAN & SET WELL SITE STAKE

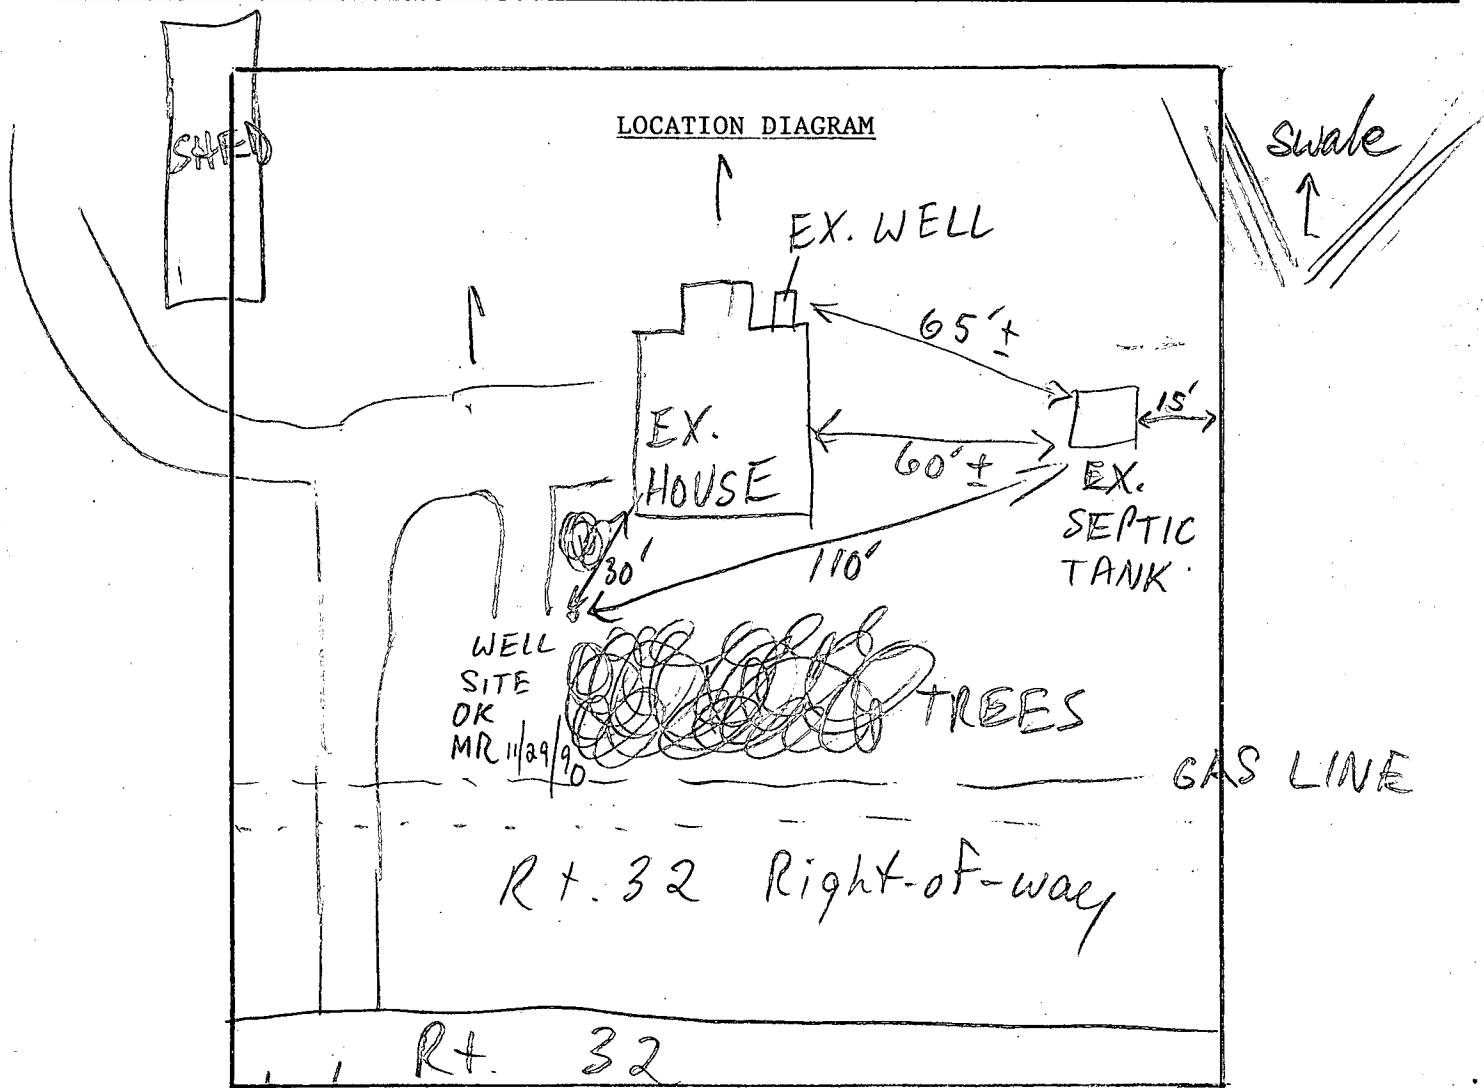

COMMENTS: 11/29/90 WELL SITE STAKED, EX. WELL
CONTAMINATED MR

DATE:

11/29/90

INSPECTOR:

M. Ritzkin

B 1 9919

SEQUENCE NO. (DP USE ONLY)

STATE OF MARYLAND APPLICATION FOR PERMIT TO DRILL WELL

STATE PERMIT NUMBER

110-88-1649

please print or type

Date Received (APA)

12/07/90

OWNER INFORMATION

STREAFER OSCAR

1250 RT 32

SYKESVILLE MD 21784

B 3

LOCATION OF WELL

HOWARD

8 COUNTY 21

SECTION 44 46 LOT 48 50

SYKESVILLE

52 NEAREST TOWN 71

MILES FROM TOWN (enter 0 if in town) 2 M. 1

DRILLER INFORMATION

George F. Basterday

40

Driller's Name

77 License No. 80

L. Franklin Basterday, Inc.

Firm Name

9265 Brown Church Rd., Mt. Airy, Md. 21771

Address


George F. Basterday 12-3-90

Signature

Date

B 4


DIRECTION OF WELL FROM TOWN (CIRCLE BOX)

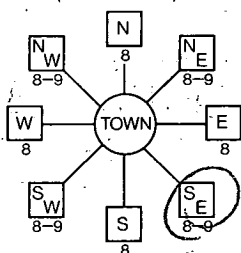

1350 RT 32

11 NEAR WHAT ROAD 30

ON WHICH SIDE OF ROAD (CIRCLE APPROPRIATE BOX)

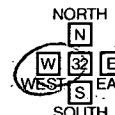

34 200 37 DISTANCE FROM ROAD

ENTER FT OR MI FT

WELL INFORMATION

APPROX. PUMPING RATE (GAL. PER MIN.) 5

AVERAGE DAILY QUANTITY NEEDED (GAL. PER DAY) 500

USE FOR WATER (CIRCLE APPROPRIATE BOX)

- Home (single or double household unit only)
Farming (livestock watering & agricultural irrigation)
Industrial, commercial, state and federal gov. other (requires appropriation permit)
Public or private water company (requires appropriation permit and state health department approval)
Test, observation, monitoring (may require appropriation permit)

NOT TO BE FILLED IN BY DRILLER HEALTH DEPARTMENT APPROVAL

Howard

RW-46670

COUNTY NAME

COUNTY NO.

STATE SIGNATURE

DATE ISSUED

INSERT S

112990 Mark E. Pallen 5/29/91

NORTH GRID 546000

EAST GRID 0814000

APPROXIMATE DEPTH OF WELL 300 FEET

APPROXIMATE DIAMETER OF WELL 6 INCH

METHOD OF DRILLING (circle one)

- Bored (or Augered) JETTED Jetted & DRIVEN
AIR-ROTARY AIR-PERCussion ROTARY (Hydraulic Rotary)
CABLE REVerse-ROTARY Drive-POINT

REPLACEMENT OR DEEPEMED WELLS (CIRCLE APPROPRIATE BOX)

- N THIS WELL WILL NOT REPLACE AN EXISTING WELL
Y THIS WELL WILL REPLACE A WELL THAT WILL BE ABANDONED AND SEALED
S THIS WELL WILL REPLACE A WELL THAT WILL BE USED AS A STANDBY
D THIS WELL WILL DEEPEN AN EXISTING WELL

PERMIT NUMBER OF WELL TO BE REPLACED OR DEEPEMED (IF AVAILABLE)

Not to be filled in by driller (OEP USE ONLY)

APPROX. PERMIT NUMBER GAP

FORCE MD PERMIT No. 110-88-1649


SPECIAL CONDITIONS

SHOW MAJOR FEATURES OF BOX & LOCATE WELL WITH AN X


SOURCES OF DRILLING WATER

- 1 well
2.
3.

WRITE THE BOX NUMBER FROM THE MAP HERE

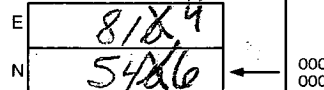

DRAW A SKETCH BELOW SHOWING LOCATION OF WELL IN RELATION TO NEARBY TOWNS AND ROADS AND GIVE DISTANCE FROM WELL TO NEAREST ROAD JUNCTION.

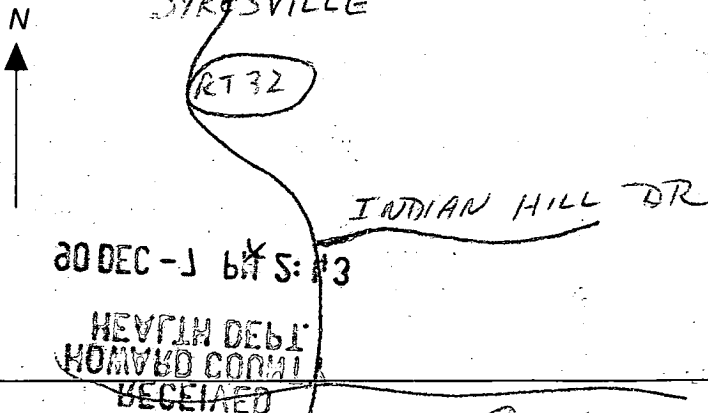

C1 3400 SEQUENCE NO. (DENV USE ONLY)

STATE OF MARYLAND WELL COMPLETION REPORT

THIS REPORT MUST BE SUBMITTED WITHIN 45 DAYS AFTER WELL IS COMPLETED.

(THIS NUMBER IS TO BE PUNCHED IN COLS. 3-6 ON ALL CARDS)

COUNTY NUMBER

ST/CO USE ONLY DATE Received

DATE WELL COMPLETED

Depth of Well

OK MR 1/2/91

PERMIT NO. FROM "PERMIT TO DRILL WELL"

Grid for ST/CO USE ONLY DATE Received

Grid for DATE WELL COMPLETED

Grid for Depth of Well

Grid for PERMIT NO.

OWNER STREET OR RFD SUBDIVISION SECTION LOT

WELL LOG table with columns: DESCRIPTION, FEET FROM, FEET TO, Check if water bearing

GROUTING RECORD form: WELL HAS BEEN GROUTED, TYPE OF GROUTING MATERIAL, CEMENT, BENTONITE CLAY, NO. OF BAGS, NO. OF POUNDS, GALLONS OF WATER, DEPTH OF GROUT SEAL

CASING RECORD form: casing types insert appropriate code below, ST CO STEEL CONCRETE, PL OT PLASTIC OTHER

MAIN CASING TYPE form: Nominal diameter top (main) casing, Total depth of main casing

OTHER CASING (if used) form: diameter inch, depth (feet) from to

SCREEN RECORD form: screen type or open hole, insert appropriate code below, ST BR HO STEEL BRASS OPEN HOLE, PL OT PLASTIC OTHER


DEPTH (nearest ft.) form: grid for depth measurements

GRAVEL PACK form: IF WELL DRILLED WAS FLOWING WELL INSERT F IN BOX 68

OEP USE ONLY (NOT TO BE FILLED IN BY DRILLER) form: T (E.R.O.S.), TELESCOPE CASING, LOG INDICATOR, OTHER DATA

PUMPING TEST form: HOURS PUMPED, PUMPING RATE, METHOD USED TO MEASURE PUMPING RATE, WATER LEVEL, BEFORE PUMPING, WHEN PUMPING, TYPE OF PUMP USED

PUMP INSTALLED form: DRILLER WILL INSTALL PUMP, IF DRILLER INSTALLS PUMP, THIS SECTION MUST BE COMPLETED FOR ALL WELLS EXCEPT HOME USE

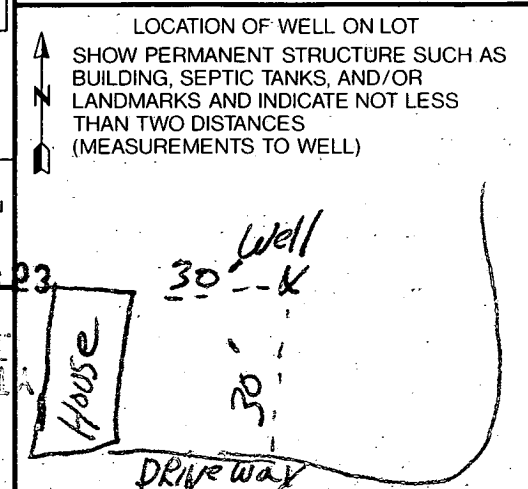

- CIRCLE APPROPRIATE LETTER: A A WELL WAS ABANDONED AND SEALED WHEN THIS WELL WAS COMPLETED, E ELECTRIC LOG OBTAINED, P TEST WELL CONVERTED TO PRODUCTION WELL

I HEREBY CERTIFY THAT THIS WELL HAS BEEN CONSTRUCTED IN ACCORDANCE WITH COMAR 26.04.04 "WELL CONSTRUCTION" AND IN CONFORMANCE WITH ALL CONDITIONS STATED IN THE ABOVE CAPTIONED PERMIT, AND THAT THE INFORMATION PRESENTED HEREIN IS ACCURATE AND COMPLETE TO THE BEST OF MY KNOWLEDGE.

DRILLERS IDENT. NO. 40, DRILLERS SIGNATURE, SITE SUPERVISOR (sign of driller or journeyman responsible for sitework if different from permittee)