




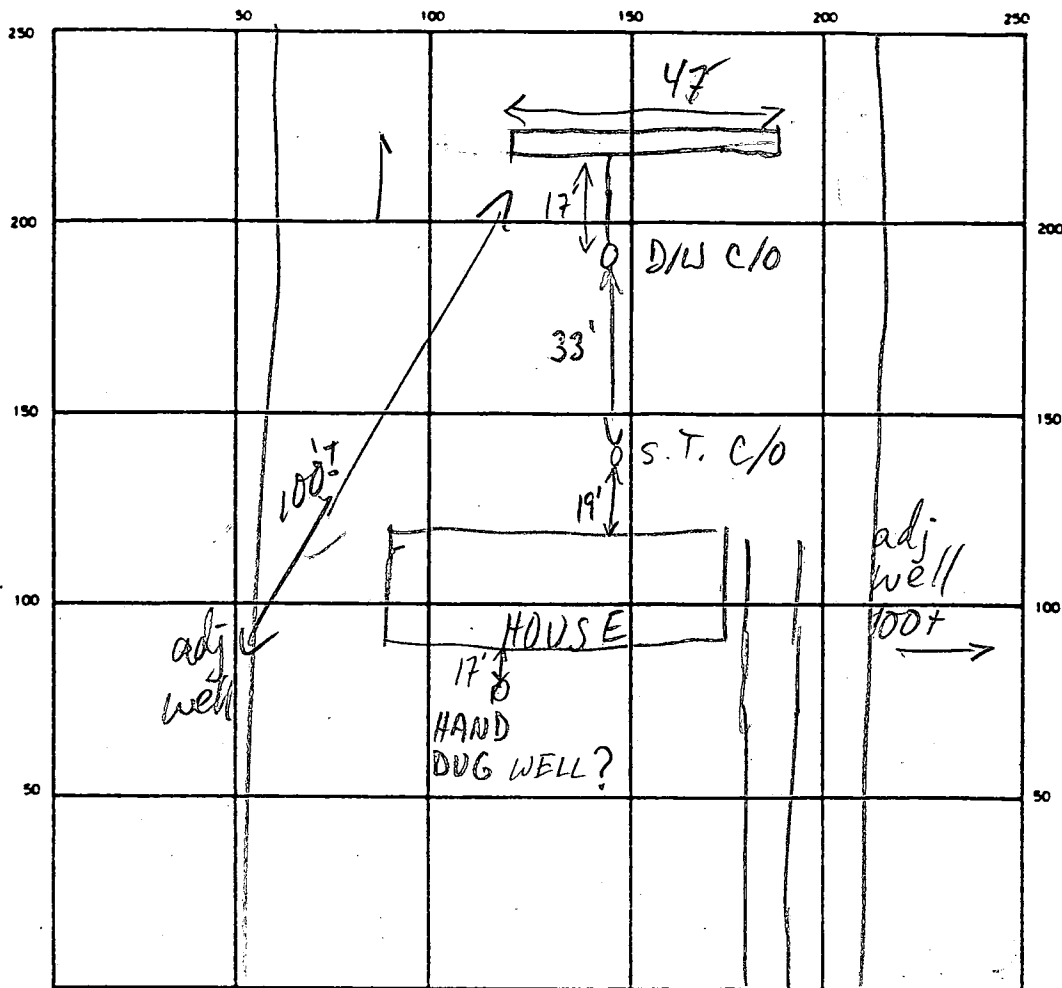

INDICATE NORTH NAME ADJOINING ROADWAY AS BASE LINE  
TRIA. RD

SEPTIC TANK. LEVEL OK CLEANOUTS OK

DISTRIBUTION BOX. LEVEL —

DRAIN FIELD/TILE FIELD. DEPTH 11 FT TRENCH WIDTH 2 FT INLET DEPTH 3 FT

EFFECTIVE GRAVEL DEPTH 8 FT TOTAL LENGTH 47' FT

NUMBER OF TRENCHES 1 ONE SIDEWALL/BOTTOM AREA 376 SQ FT

DRYWELL INSIDE DIAMETER — FT EFFECTIVE DEPTH BELOW INLET — FT

ABSORBENT AREA 376 SQ. FT.

REMARKS 6/5/90 OK TO COVER ALL MR

DATE SYSTEM APPROVED

6/5/90

INSPECTOR

M. Rifkin

*afternoon*

SEWAGE DISPOSAL SYSTEM

MARYLAND STATE DEPARTMENT OF HEALTH

HOWARD COUNTY

ELLCOTT CITY

DISTRICT 3

DATE 5/3/69

INDEXED

Calvin Wilson IS PERMITTED TO INSTALL ALTER X

ADDRESS Rt. 216, Fulton, Md. PHONE 725-5311

A SEWAGE DISPOSAL SYSTEM LOCATED AT \_\_\_\_\_

SUBDIVISION \_\_\_\_\_ ROAD 13533 Triadelphia - 1st LOT \_\_\_\_\_

PROPERTY OWNER G. P. Phelps Gerald S & Mary Jo Mess house next to Phelps Store

ADDRESS \_\_\_\_\_

SPECIFICATIONS

DRAIN FIELD \_\_\_\_\_ DEPTH \_\_\_\_\_ FEET, BOTTOM AREA \_\_\_\_\_ SQ. FT.

SEEPAGE PITS \_\_\_\_\_ ABSORBENT SIDE-WALL AREA \_\_\_\_\_ SQ. FT.

SEPTIC TANK CAPACITY \_\_\_\_\_ GALLONS

FOR GARBAGE GRINDER, INCREASE DISPOSAL AREA 22% & TANK CAPACITY 50%.

OTHER ~~REPAIR~~ Call for inspection when excavation is completed and before installing any block or gravel.

Dry Well - 300 sq. ft. absorbent sidewall area to begin below the inlet pipe, outlet pipe to be 4 ft. below original grade. R. Torre.

PLANS APPROVED BY Palmer F. Wine DATE 5/8/69


FILL SEPTIC TANK AND DISTRIBUTION BOX WITH WATER BEFORE CALLING FOR AN INSPECTION. COVER NO WORK UNTIL INSPECTED AND APPROVED.

NEITHER THE HOWARD COUNTY COMMISSIONERS NOR THE HEALTH DEPARTMENT IS RESPONSIBLE FOR THE SUCCESSFUL OPERATION OF ANY SYSTEM.

BMDG. PERMIT SIGNED AND RETURNED

*Serial # 285-75 check*

NOTIFY THE HEALTH DEPARTMENT 48 HOURS BEFORE EXCAVATIONS ARE TO BE BACK FILLED.

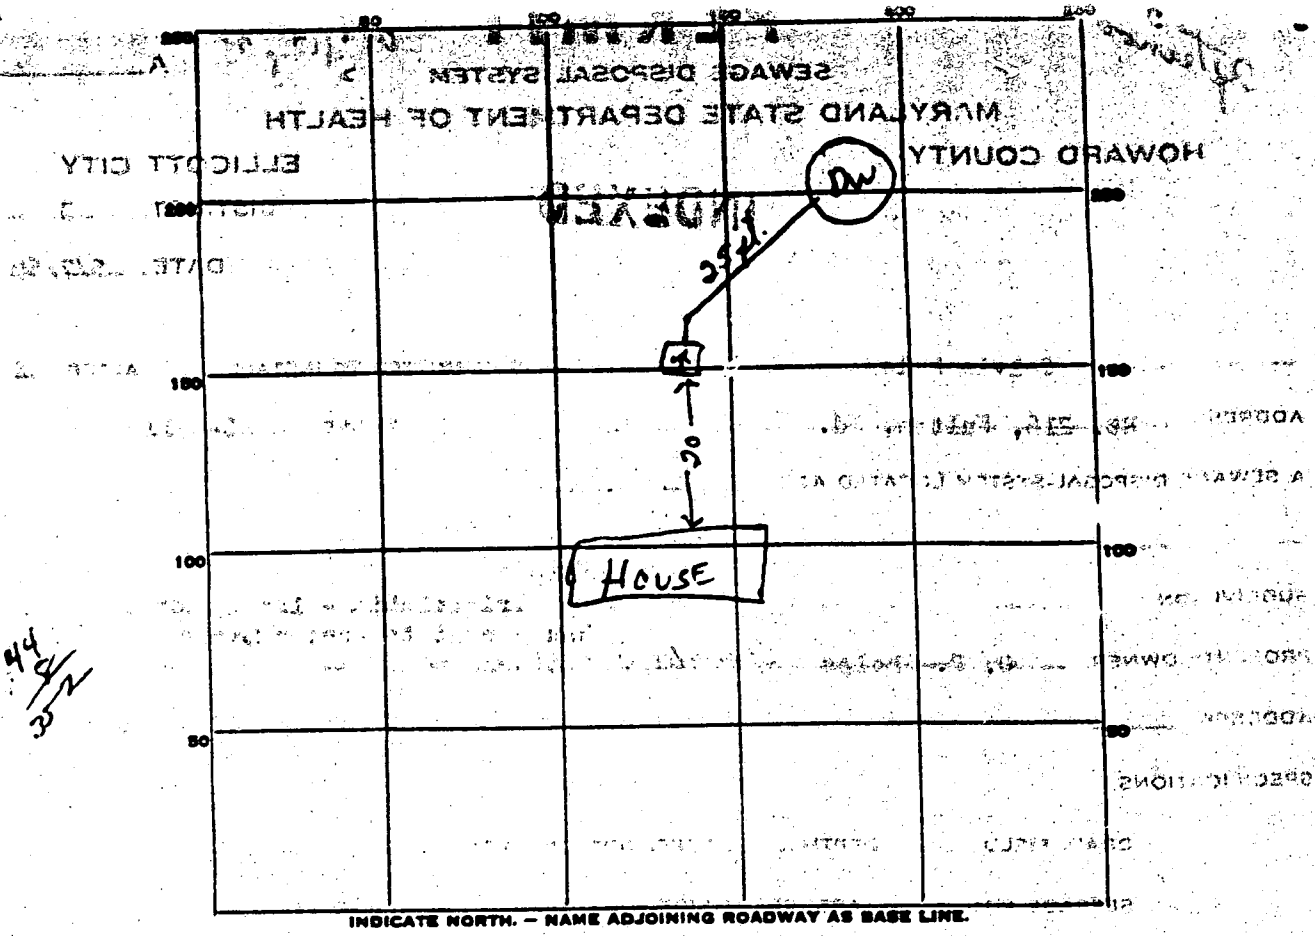

PERMIT CARD \_\_\_\_\_  
 SEPTIC TANK, LEVEL \_\_\_\_\_ CLEANOUTS \_\_\_\_\_  
 DISTRIBUTION BOX, LEVEL \_\_\_\_\_  
 TILE FIELD, DEPTH \_\_\_\_\_ FT. TRENCH WIDTH \_\_\_\_\_ FT.  
 GRAVEL DEPTH \_\_\_\_\_ IN. TOTAL LENGTH \_\_\_\_\_  
 NUMBER OF TRENCHES \_\_\_\_\_ TOTAL BOTTOM AREA \_\_\_\_\_  
 OUTSIDE PERIMETER \_\_\_\_\_  
 SEEPAGE PITS, INSIDE DIAMETER 10x12 FT. DEPTH BELOW INLET 8 FT.  
 ABSORBENT AREA 352 SQ. FT.

RECEIVED  
 HOWARD COUNTY  
 HEALTH DEPT.  
 MAY 13 9 32 AM '65  
 DIVISION OF  
 ENVIRONMENTAL  
 HEALTH

REMARKS \_\_\_\_\_

\_\_\_\_\_

\_\_\_\_\_

BEFORE EXCAVATIONS ARE TO BE MADE  
 NOTIFY THE HEALTH DEPARTMENT

DATE SYSTEM APPROVED 5/14/65 INSPECTOR R. T. [Signature]

44  
 8  
 32

TRINIDAD PHIL

60' 5" W

587' 00" 24' W

152' 20"

117' 00" 24' W

117' 00"

PIPE SOUND

DECK

64'

264' 00"

well

#18555

1 STORY DECK

(window)

septic

original

Revised  
Deck to be moved  
13' from septic

OK AS REVISED  
8/21/89  
Craig Walker

L. 582 F. 120

S 00° 50' 50" W


76' 20"

N 02° 27' 20" E

L. 240 F. 258

34, 615  $\phi$  +  
0.79 AC +


100' 00"

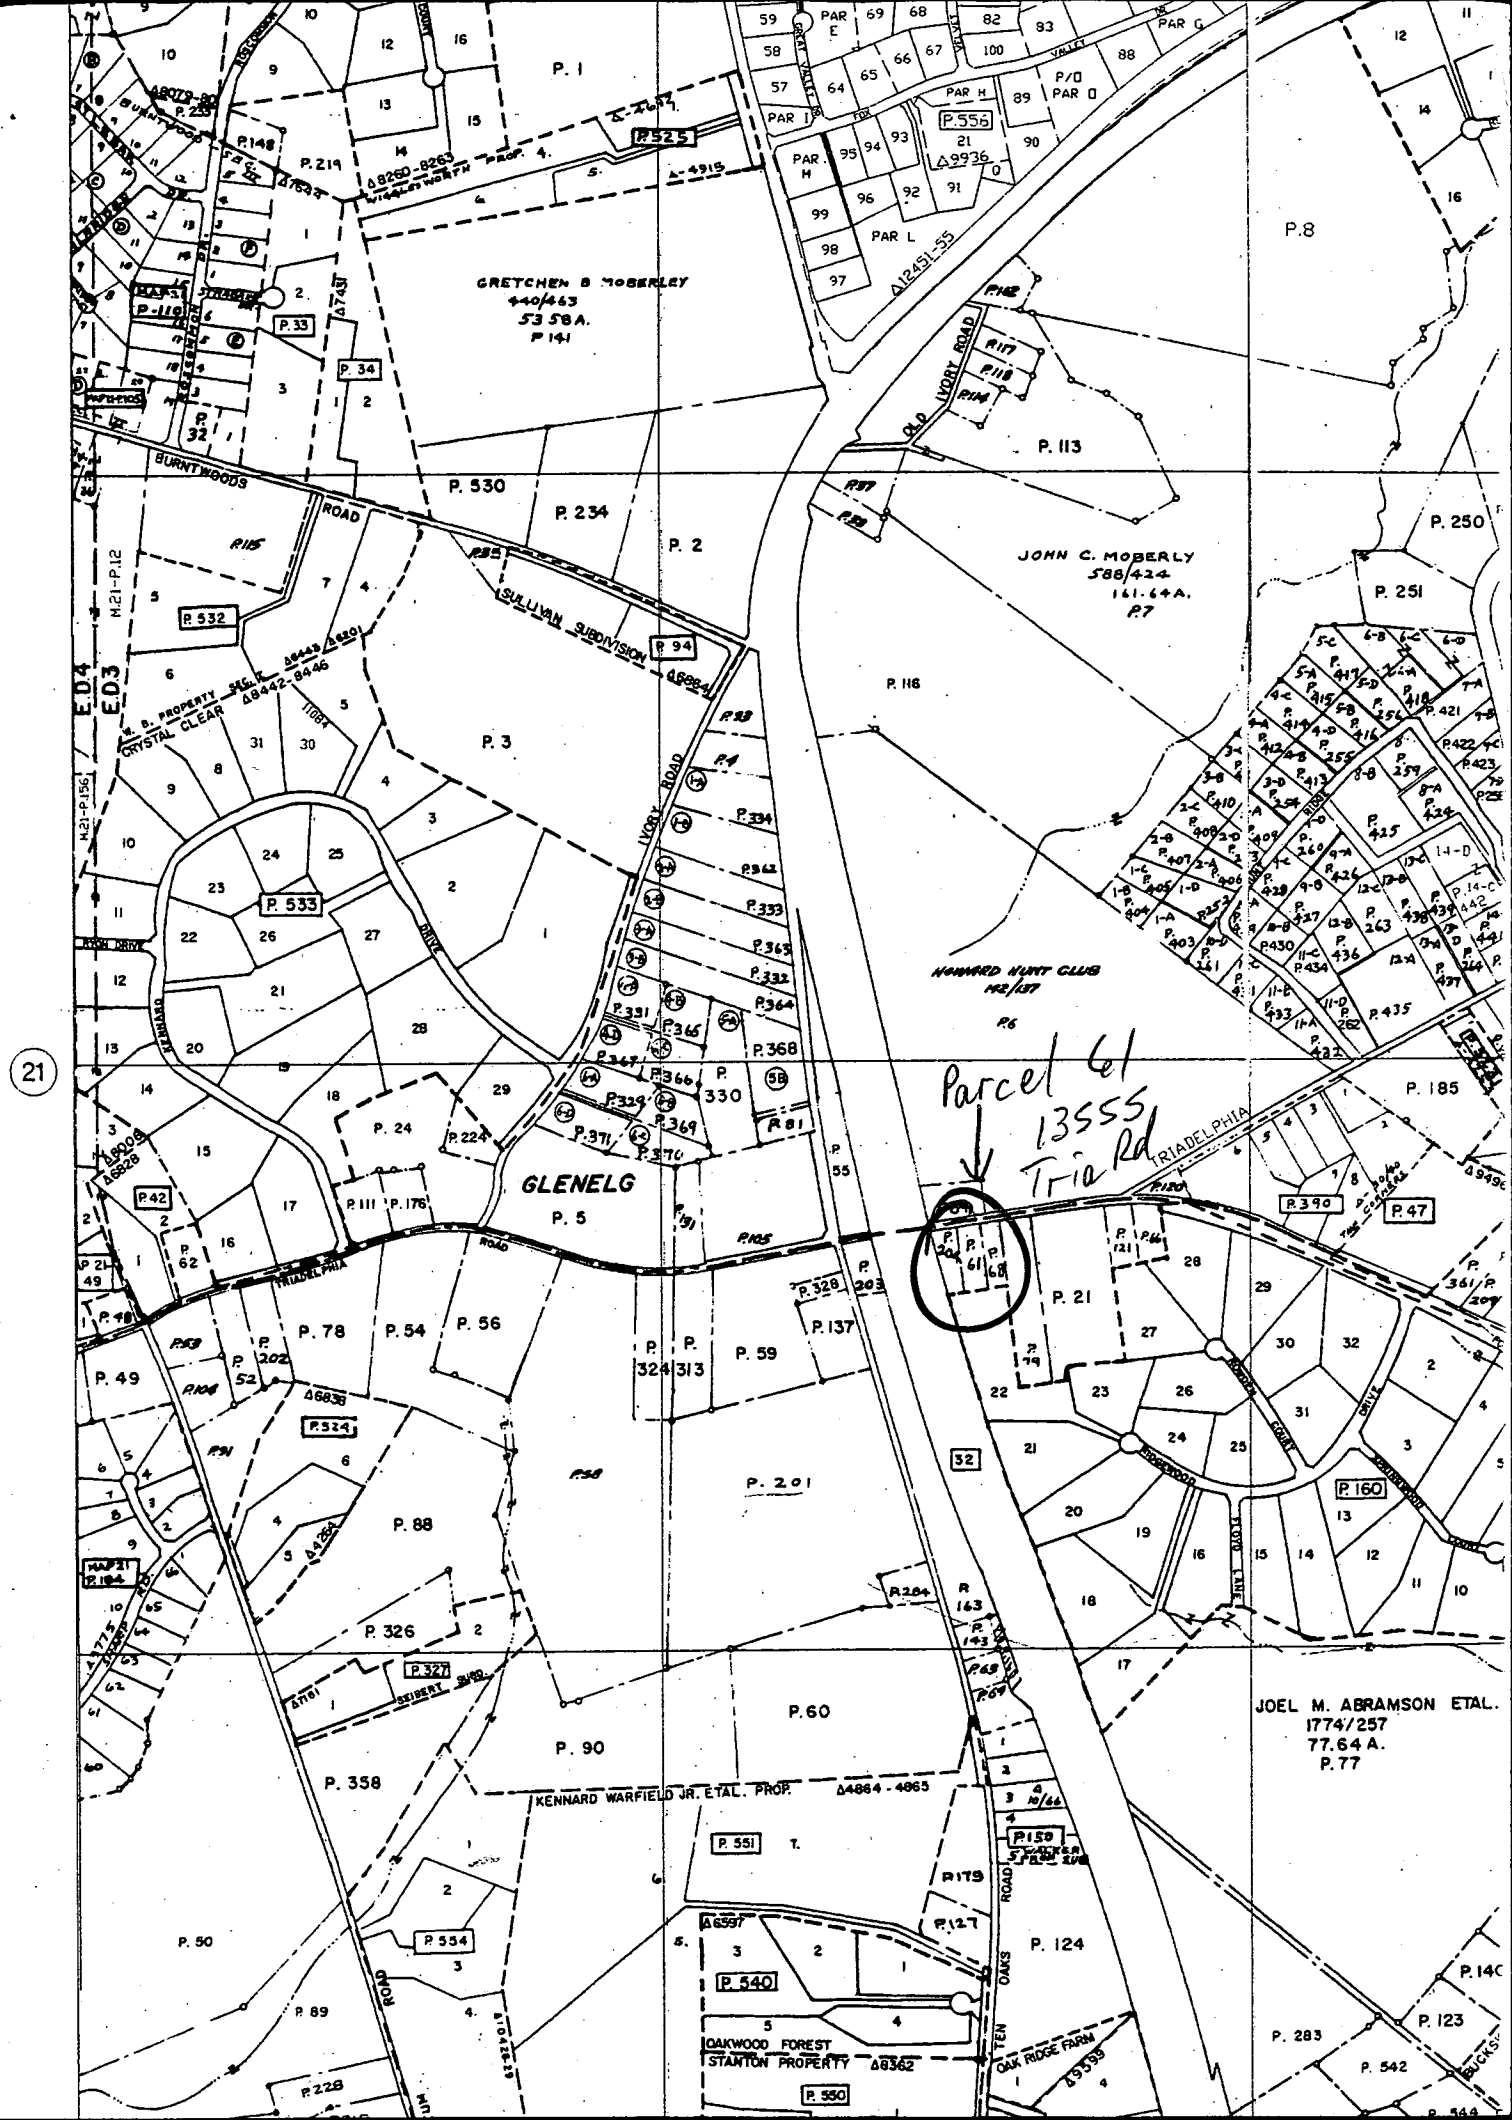

HOWARD COUNTY, MD

TRIAD DELPHIN

42-7

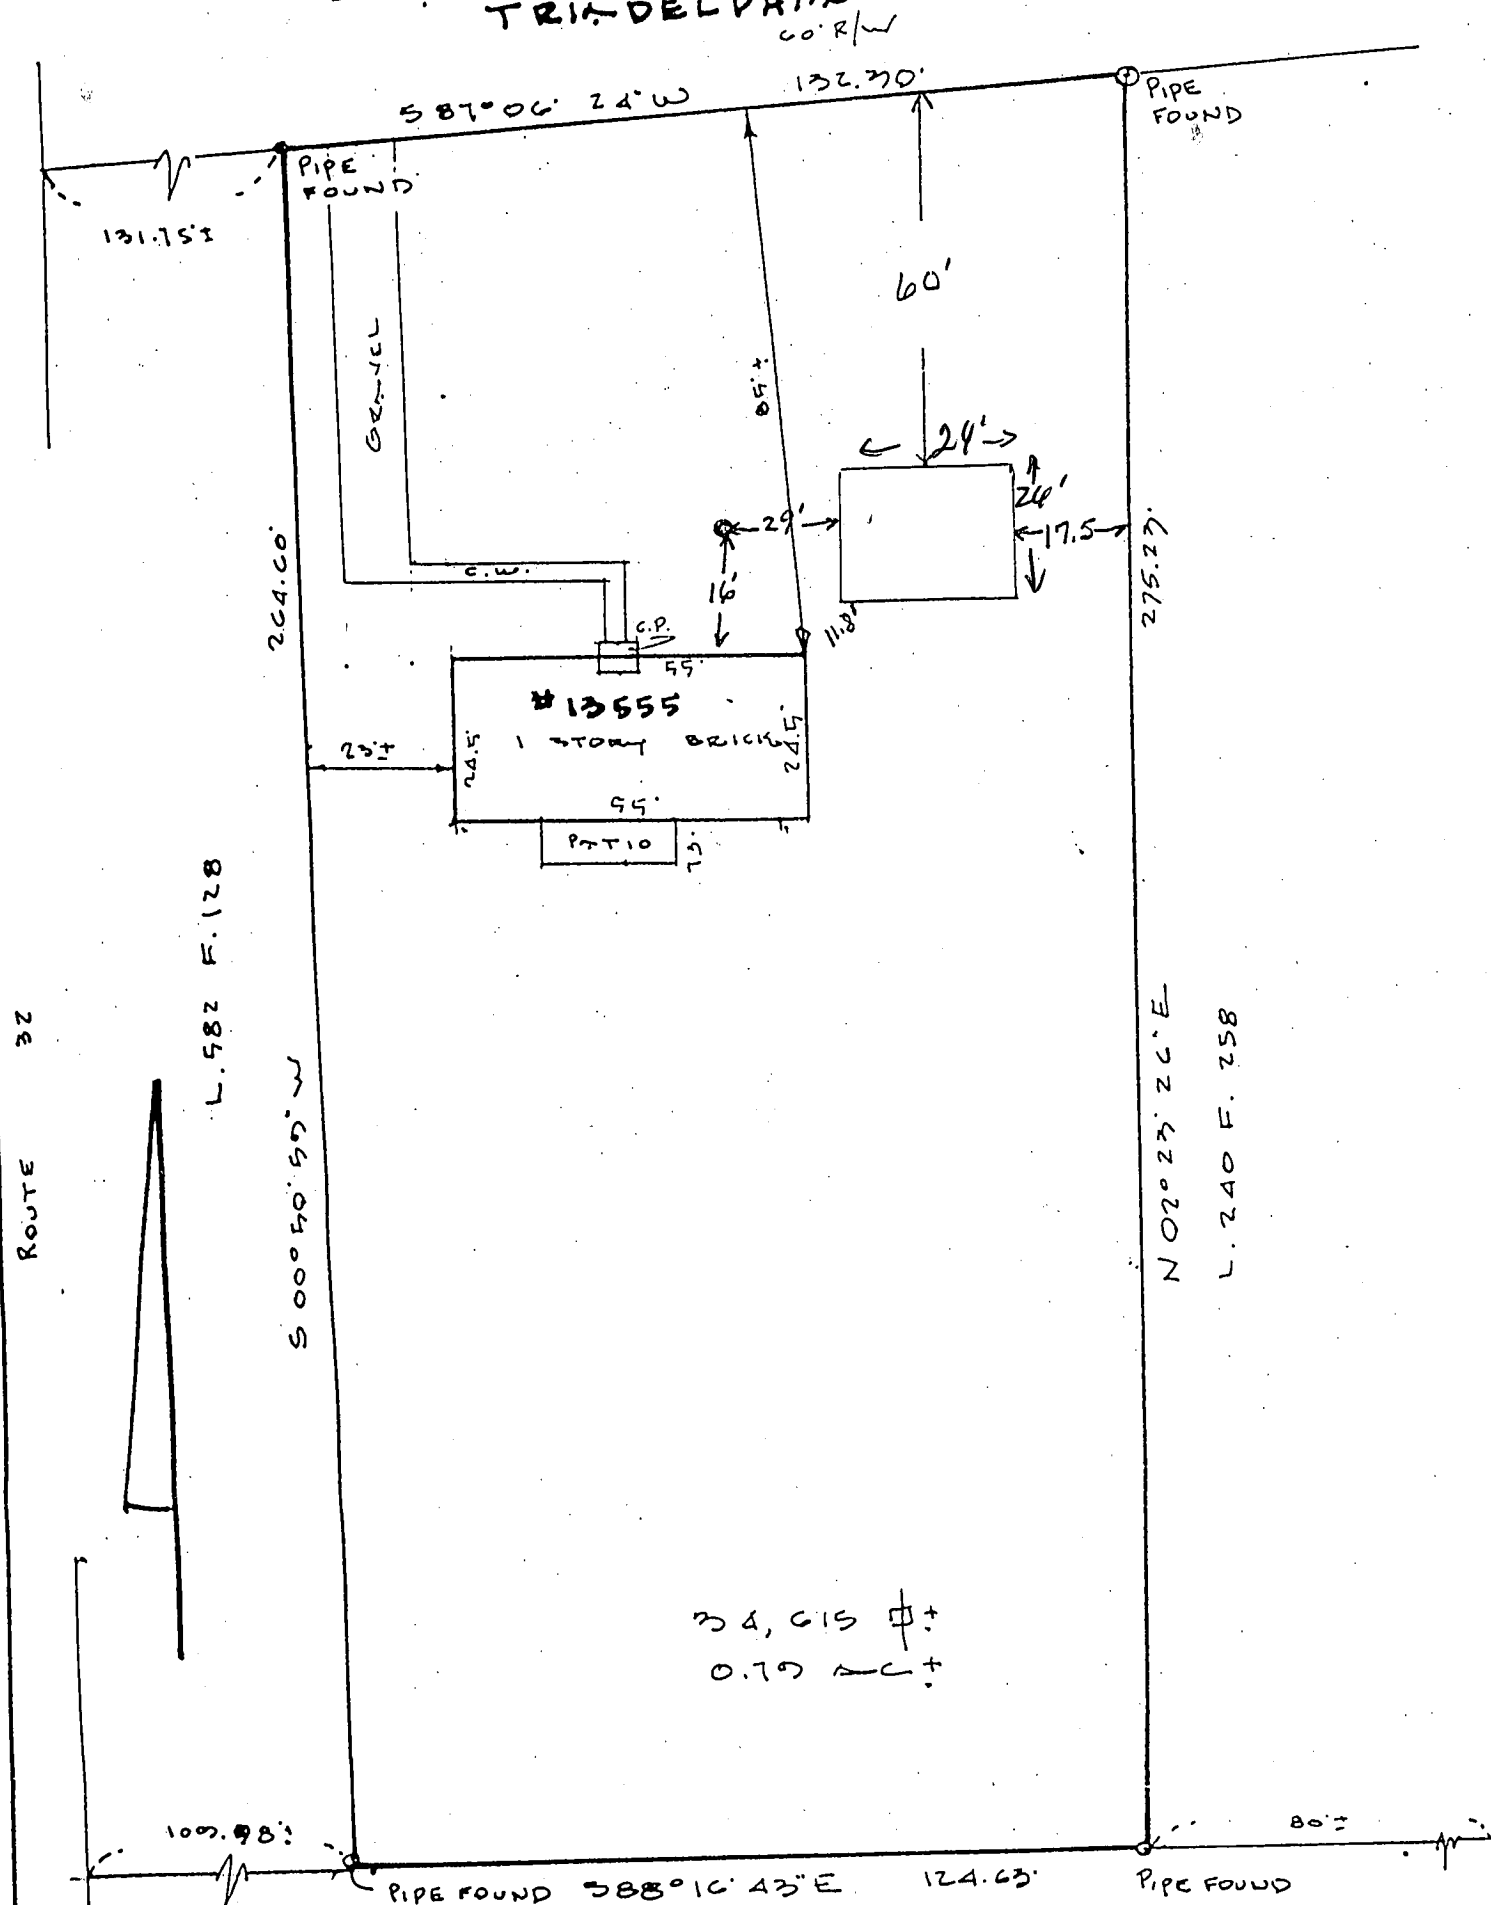

LOCATION SURVEY PLAT  
SUBJECT PROPERTY NOT LOCATED IN A FLOOD PLAIN AREA UNLESS OTHERWISE NOTED

SCALE 1" = 30' DATE 07/27/1987

TRIADDELPHIA ROAD

A circular seal for a professional land surveyor. The outer ring contains the text "STATE OF MARYLAND" at the top and "REGISTERED PROFESSIONAL LAND SURVEYOR" at the bottom. Inside the ring, the name "WALTER PARK" is written in an arc. In the center is the coat of arms of the State of Maryland, featuring a shield with a ship and a figure, flanked by two figures. Below the coat of arms is the number "5539".

Walter Park

231 Harpers Choice Village Center  
5485 Harpers Farm Road  
Columbia, Md. 21044

REG. L.S. 5539