

LAYOUT 6/4/08 INSP 4 _____
 INSP 2 _____ INSP 5 _____
 INSP 3 _____ INSP 6 _____

ISSUE DATE: 4/21/2008

APPROVAL DATE: 6/10/08

PERMIT (LUSTED)

P 528901

A 523729

TAX ID # ~~04384272~~ 04-313941

**ON-SITE SEWAGE DISPOSAL SYSTEM
 HOWARD COUNTY HEALTH DEPARTMENT
 BUREAU OF ENVIRONMENTAL HEALTH**

W R Becker, LLC IS PERMITTED TO INSTALL ALTER

ADDRESS: 15300 Carrs Mill Road, Woodbine PHONE NUMBER: 443-829-6036

SUBDIVISION: Dowd Property LOT NUMBER: _____

ADDRESS: 15545 Carrs Mill Rd PROPERTY OWNER: Robert Dowd

SEPTIC TANK CAPACITY (GALLONS): 2000 OUTLET BAFFLE FILTER REQUIRED

PUMP CHAMBER CAPACITY (GALLONS): 1500 COMPARTMENTED TANK REQUIRED

NUMBER OF BEDROOMS: 4

SQUARE FEET PER BEDROOM: _____

LINEAR FEET OF TRENCH REQUIRED: 300 207'

*3' wide
 Inlet @ 4'
 Bottom @ 6'*

TRENCHES:	Trench to be 2.0 feet wide. Inlet 3.0 feet below original grade. Bottom maximum depth 6.0 feet below original grade. Effective area begins at 5.0 feet below original grade. 3.0 feet of stone below distribution pipe.
LOCATION:	
NOTES:	Ensure adequate fall between tanks and tanks to be no deeper than 3' below grade. Layout required prior to installation of system. Install per plan location unless directed by HCHD.

PLANS APPROVED: Sara Sappington DATE: 12/27/07

- NOTE: PERMIT VOID AFTER 2 YEARS
- NOTE: CONTRACTOR RESPONSIBLE FOR SCHEDULING A PRE-CONSTRUCTION INSPECTION FOR ALL INSTALLATIONS
- NOTE: WATERTIGHT SEPTIC TANKS REQUIRED
- NOTE: ALL PARTS OF SEPTIC SYSTEM SHALL BE 100 FEET FROM ANY WATER WELL
- NOTE: MANHOLE RISERS REQUIRED ON ALL SEPTIC TANKS AND PUMP CHAMBERS UNLESS SPECIFICALLY AUTHORIZED

NEITHER THE HOWARD COUNTY COUNCIL NOR THE HEALTH DEPARTMENT IS RESPONSIBLE FOR THE SUCCESSFUL OPERATION OF ANY SYSTEM PERMITTEE RESPONSIBLE FOR OBTAINING FINAL APPROVAL ON THIS PERMIT CALL 410-313-1771 FOR INSPECTION OF SEPTIC SYSTEM

NOT TO SCALE

See As-Built Drawing On Separate Sheet

TRENCH/DRAINFIELD DATA

WIDTH	INLET	BOTTOM
3'	4'	6'
NUMBER OF TRENCHES		4'
TOTAL LENGTH _____		
ABSORPTION AREA _____		
DISTRIBUTION BOX LEVEL <u>tenders.</u>		
DISTRIBUTION BOX BAFFLE <u>Yes</u>		
DISTRIBUTION BOX PORT <u>Yes</u>		

SEPTIC TANK DATA

SEPTIC TANK 1 LEVEL	<u>Yes</u>
CAPACITY	<u>2000</u> GAL
SEAM LOC	<u>Top</u>
TANK LID DEPTH	<u>2'</u>
BAFFLES	<u>Yes</u>
BAFFLE FILTER	<u>—</u>
MANHOLE LOC	<u>Front</u>
6" PORT LOC	<u>Back</u>
WATERTIGHT TEST	<u>—</u>
SEPTIC TANK 2 LEVEL	_____
CAPACITY	_____ GAL
SEAM LOC	_____
TANK LID DEPTH	_____
BAFFLES	_____
BAFFLE FILTER	_____
MANHOLE LOC	_____
6" PORT LOC	_____
WATERTIGHT TEST	_____


Byblon
2 comp
slotted

ROAD


PRE-CONSTRUCTION 6/4/08 should be able to make gravity to Trenches. Pump Tanks not required. Trenches to be 3' wide, inlet 4' below grade and bottom 6'. Install 3x5x2' trenches starting deep center of SDA running laterally on center. OK to cover house connection to Tank when finished (RW) 6/10/08 System complete OK to backfill (RW)

FINAL INSPECTOR J. Wally DATE OF APPROVAL 6/10/08

88140-56-011

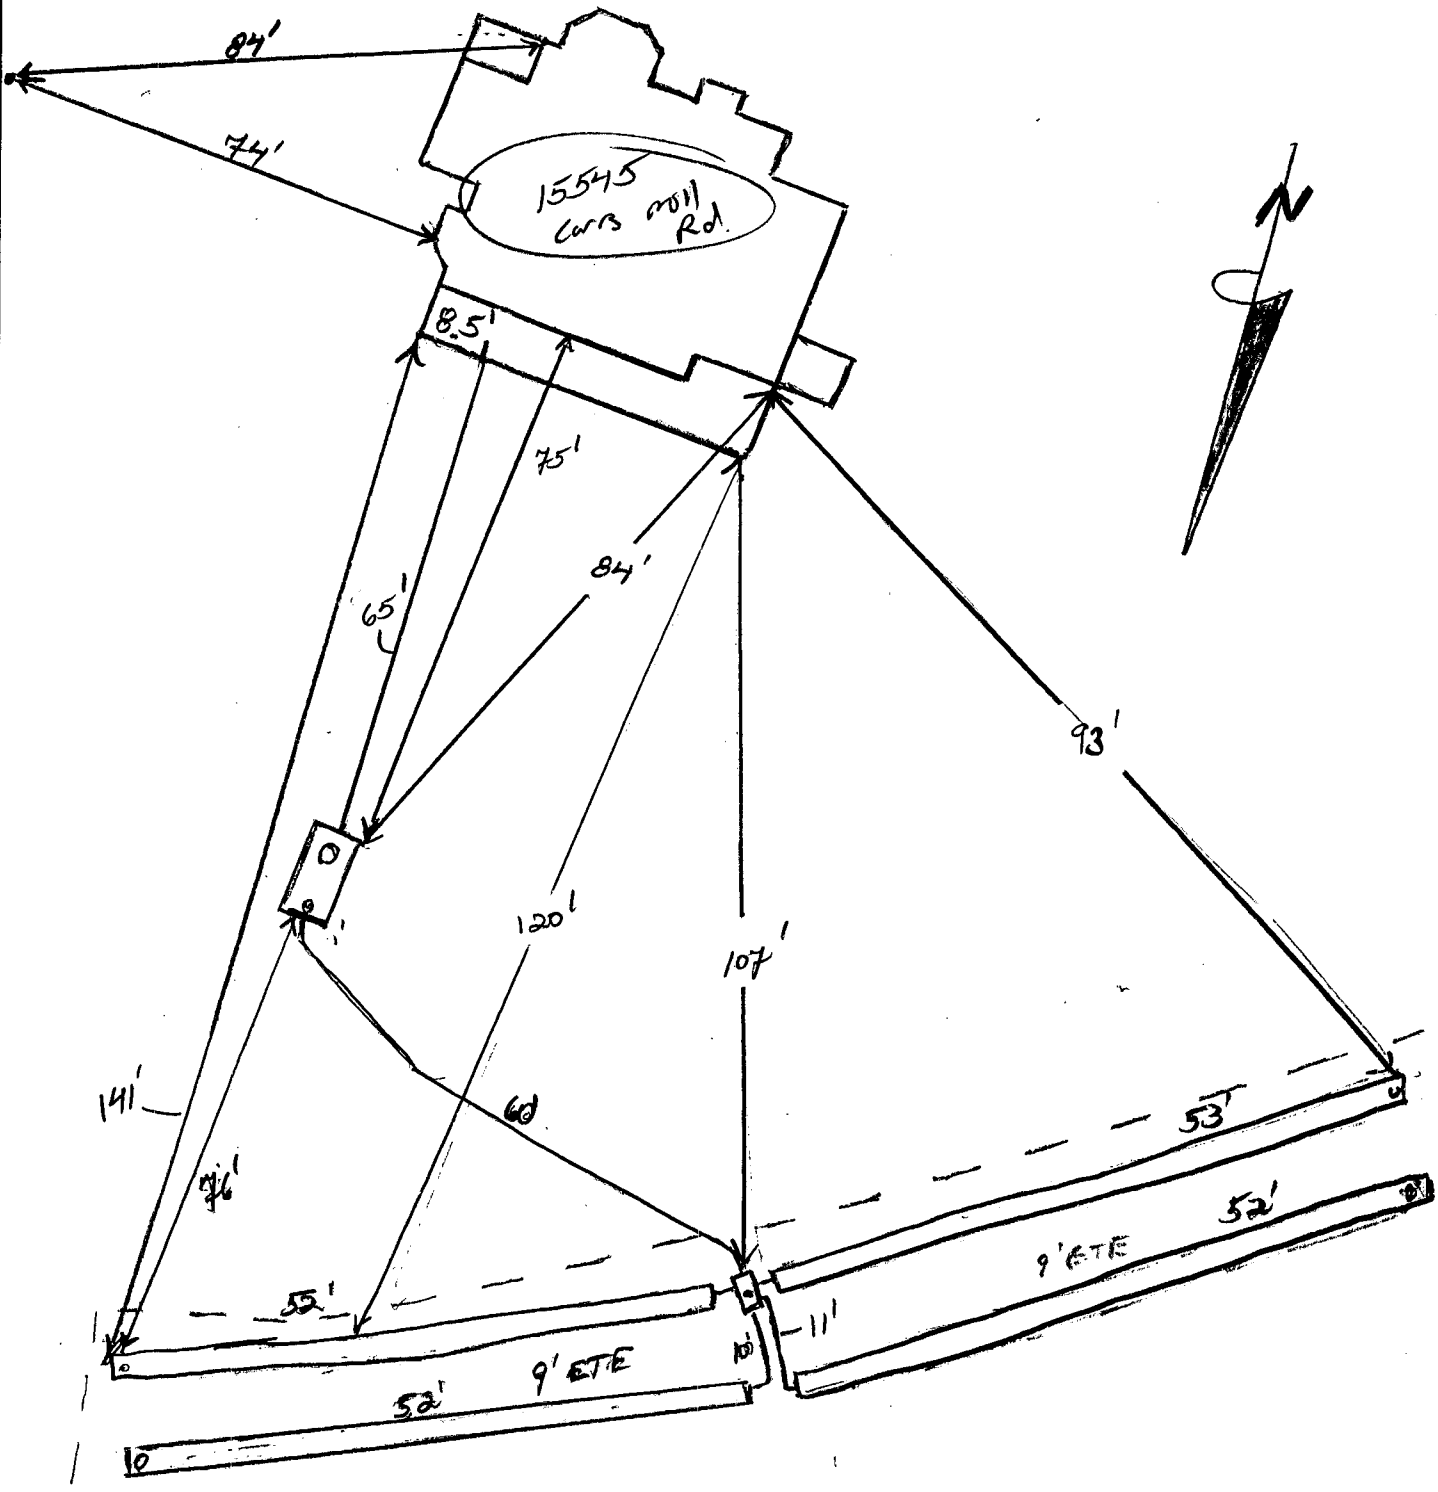

NOT TO SCALE

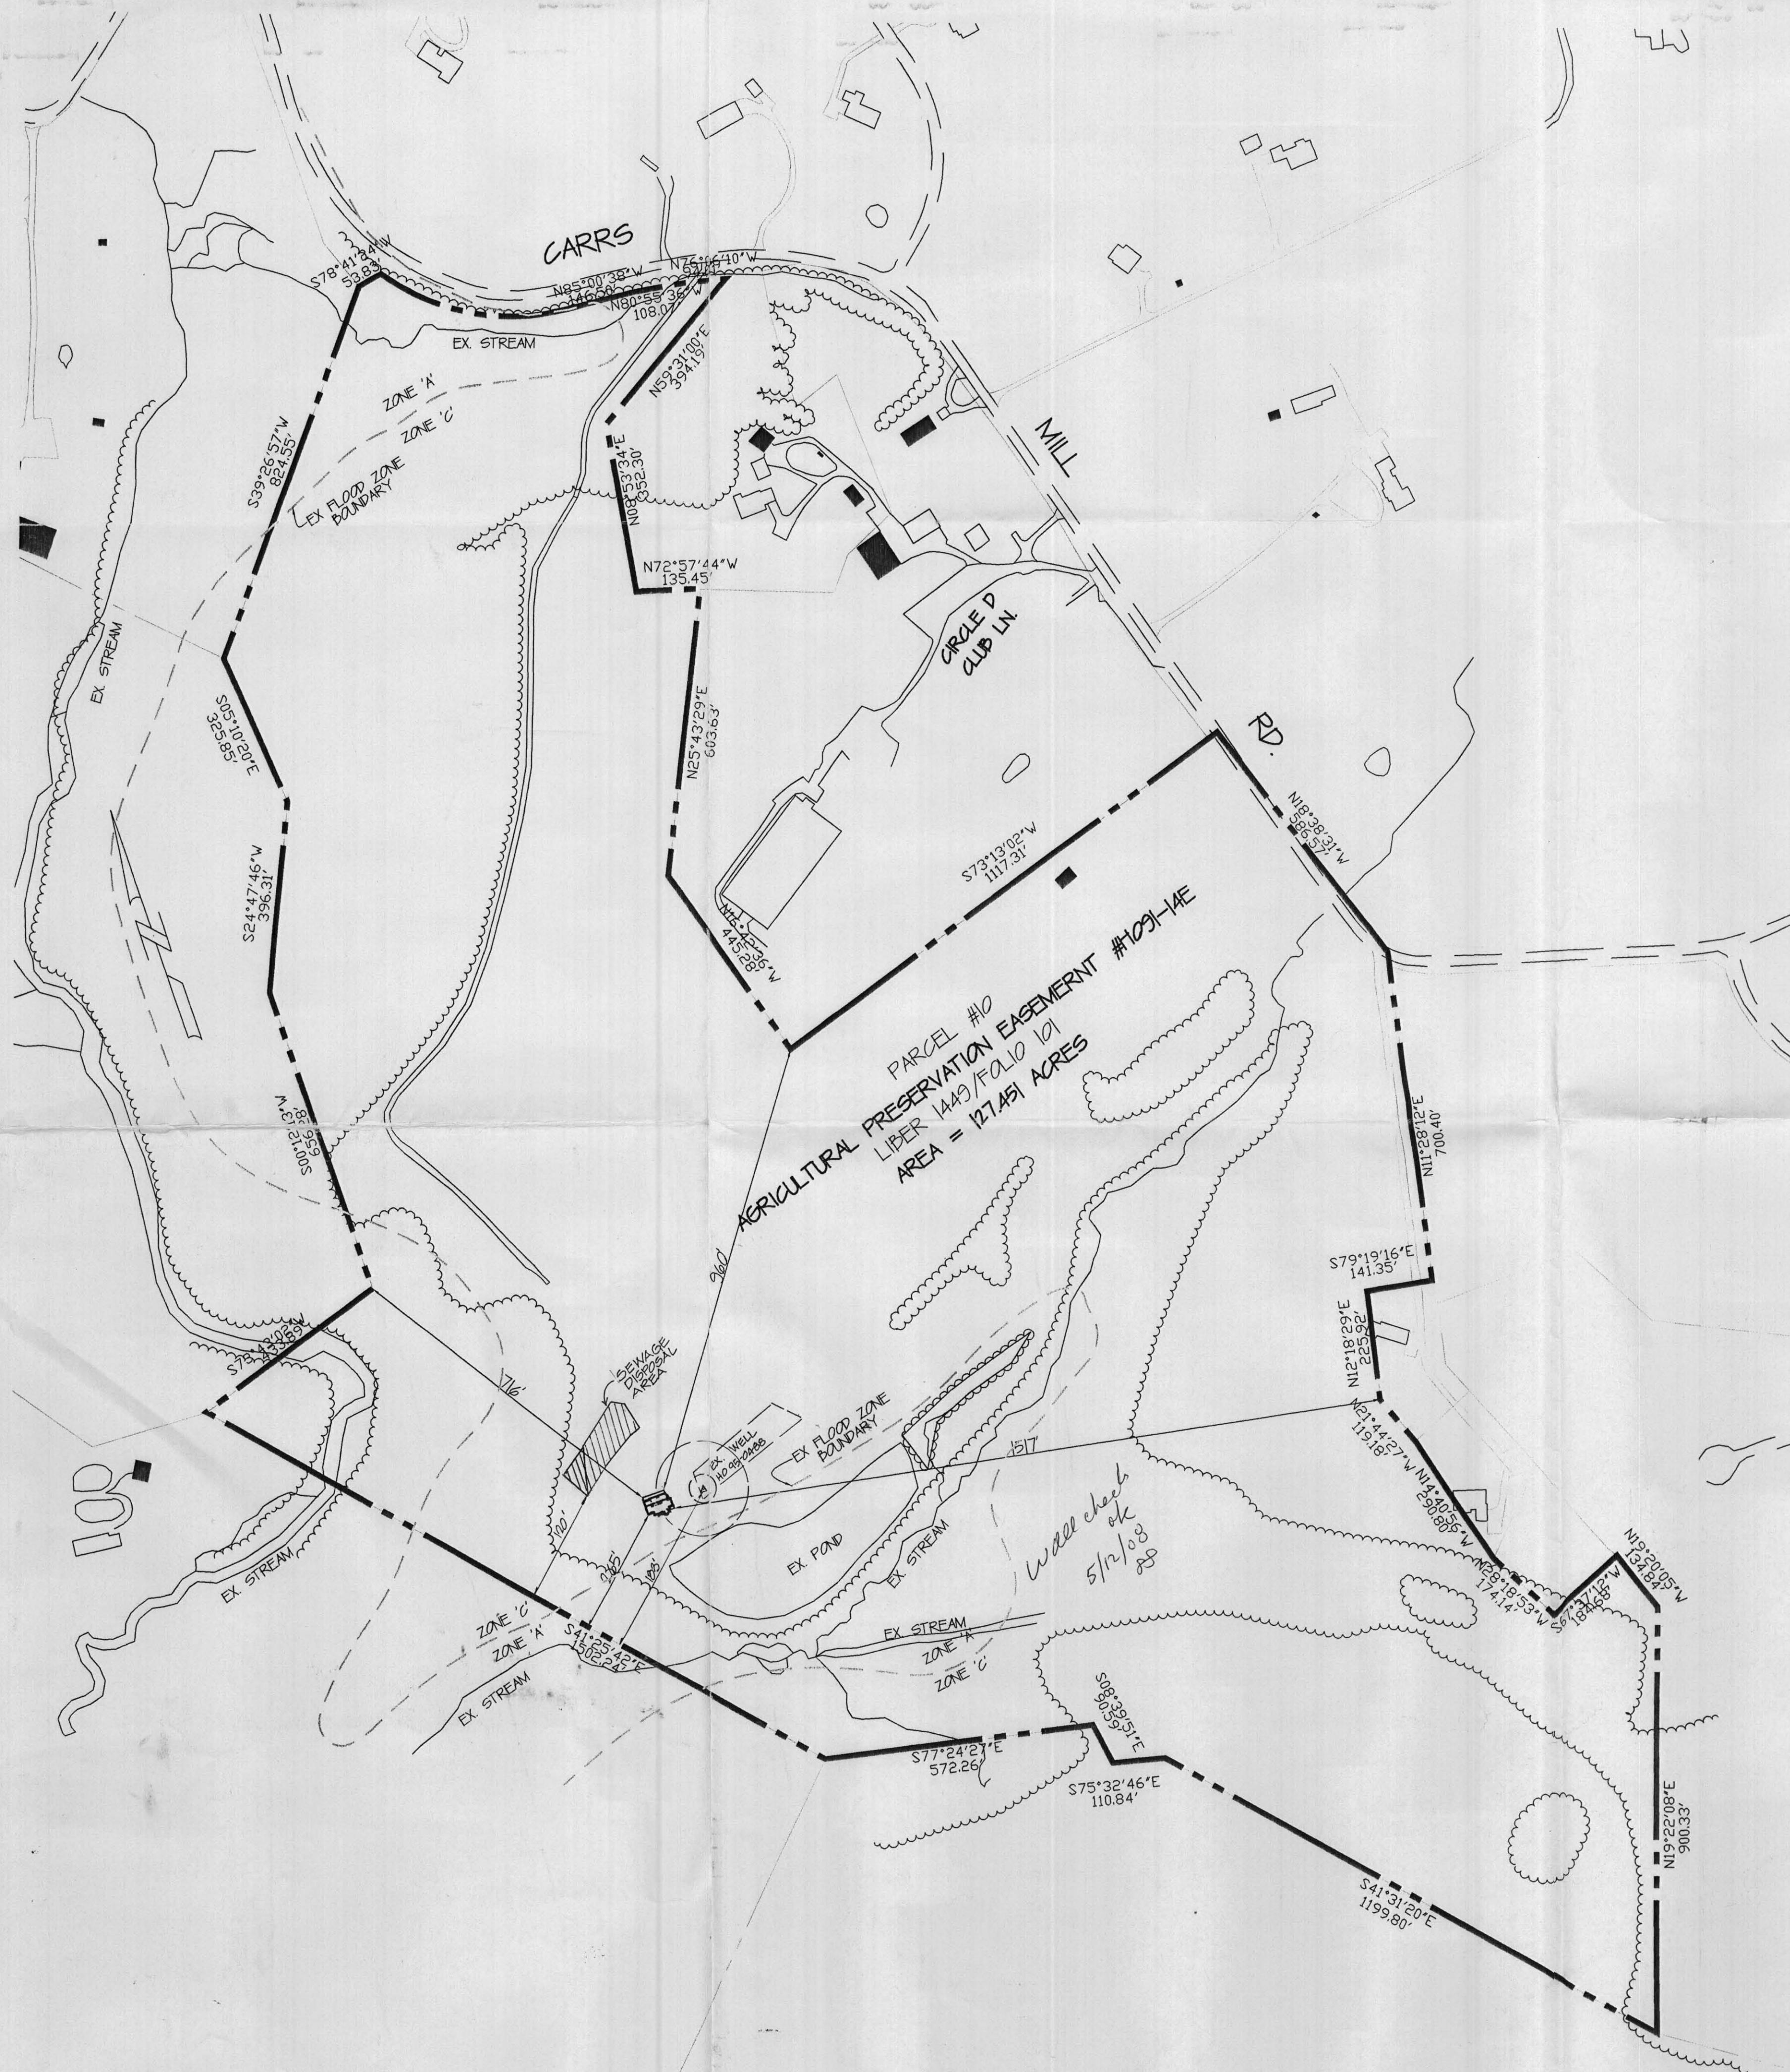

FLOOD PLAIN NOTE

1. THE CONCRETE FOUNDATION IS LOCATED IN ZONE "C" AS SHOWN HEREON
2. THE LOT SHOWN HEREON IS IN FLOOD ZONES "C" AND "A" PER FEMA FLOOD INSURANCE RATE MAP #14000A001AD


NOTE: ACCURACY OF APPARENT SETBACK DISTANCES ARE 1 FT. +/-



- NOTE:
- (A) THIS PLAT IS NOT INTENDED FOR USE IN ESTABLISHING PROPERTY LINES AND DOES NOT CONSTITUTE A BOUNDARY SURVEY.
 - (B) THIS PLAT IS OF THE BENEFIT TO THE CONSUMER ONLY INsofar AS IT IS REQUIRED BY A LENDER OR TITLE INSURANCE COMPANY OR ITS AGENT IN CONNECTION WITH CONTEMPLATED TRANSFER, FINANCING OR REFINANCING.
 - (C) THIS PLAT SHOULD NOT BE RELIED UPON FOR THE LOCATION OR ESTABLISHMENT OF FENCES, GARAGES, BUILDINGS OR OTHER EXISTING OR FUTURE IMPROVEMENTS

THIS IS TO CERTIFY THAT WE HAVE LOCATED THE IMPROVEMENTS AS SHOWN ACCORDING TO THE REGULATIONS GOVERNING THE MARYLAND STANDARDS OF PRACTICE FOR PROFESSIONAL LAND SURVEYORS EFFECTIVE DATE AUGUST, 2005

Leonard T. Dohager
 MR. LEONARD T. DOHAGER MD REG. NO. 10859 DATE 4-18-08

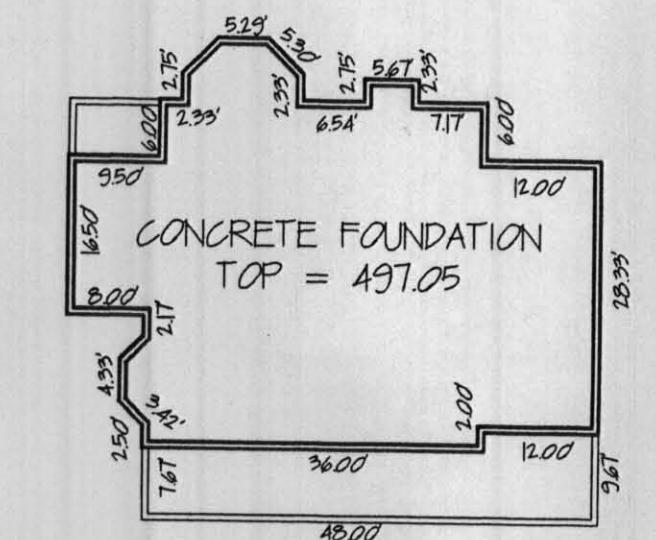

FOUNDATION DETAIL
 SCALE: 1" = 20'

NO.		DATE	REVISION
			FOUNDATION CERTIFICATION PLAN FOR CIRCLE D FARMS
			15523 CARRS MILL ROAD SINGLE FAMILY DETACHED LIBER 1449 / F.O. 101 TAX MAP 14, GRID 08, PARCEL #10
FIRST ELECTION DISTRICT		DATE: 01/23/08	HOWARD COUNTY, MARYLAND
DES.	C.R.C.	OWNER/DEVELOPER TIMOTHY R. BOND JR. 15523 CARRS MILL ROAD WOODPINE, MD. 21797-8025	
CHK.	C.H.C.		
DRW.	C.H.C.		
PREPARED BY: CHARLES R. CROCKEN & ASSOCIATES, INC. C.R.C. LICENSED - LAND PLANNER P.O. BOX 107 WESTMINSTER, MARYLAND 21157-0107 TEL: 410-336-1234 FAX: 410-336-1235		SCALE: 1" = 200'	SHEET 1 OF 1



HOWARD COUNTY HEALTH DEPARTMENT

P5 28901

DATE
4 / 21 / 08

Received From WR. Becker, LLC

PHONE # 443-829-6036

15300 Carrs Mill Rd, Woodhome MD 21797

CASH
 CHECK
NO.
4021

For Septic Permit

Down Property - 15545 Carrs Mill Rd.

DILPV
FAXV
CLAREV
LOGV

Three hundred ninety six and 00/100 Dollars

\$ 396 00

Received By Mary F. Beyer