

File

A REPAIR

DISTRICT 3rd

DATE 9/28/91

DATE SYSTEM APPROVED 07/19/01

INSPECTOR C. P. O.

BUREAU OF ENVIRONMENTAL HEALTH

461-9933

INDEXED

Jack Fyock Septic Service

IS PERMITTED TO INSTALL ALTER X

ADDRESS 13775 Triadelphia Road, Glenelg, Maryland 21737 PHONE 988-9270

SUBDIVISION Shepherds Glen LOT 16 ROAD 3826 Walt Ann Drive

PROPERTY OWNER Mr. Jeffrey T. Goetz

ADDRESS

SEPTIC TANK CAPACITY	GALLONS
1500	1500
2000	2000
2500	2500
3000	3000
3500	3500
4000	4000
4500	4500
5000	5000
5500	5500
6000	6000
6500	6500
7000	7000
7500	7500
8000	8000
8500	8500
9000	9000
9500	9500
10000	10000

NUMBER OF BEDROOMS 3

SQUARE FEET PER BEDROOM

LINEAR FEET OF TRENCH REQUIRED

REPAIR - Call for inspection when ground is opened so sanitarian can recommend repair.

1/91 Trench - 2' wide; 55' long; 11' deep; 2' stone
under pipes coming off existing dry well
at inlet 4' below O. Grade.
(1 stop)

PLANS APPROVED BY Craig Williams cm DATE 07/24/91

COVER NO WORK UNTIL INSPECTED AND APPROVED

NEITHER THE HOWARD COUNTY COUNCIL NOR THE HEALTH DEPARTMENT IS RESPONSIBLE FOR THE SUCCESSFUL OPERATION OF ANY SYSTEM

NOTE: CLEANOUT REQUIRED EVERY 70 FEET OF SEWER LINE AND/OR AT 90° SWEEPS IN LINES FROM HOUSE TO DRAIN FIELDS, 90° ELBOWS NOT ACCEPTABLE.

NOTE: ALL PARTS OF SEPTIC SYSTEMS (I.E. TANK, DISTRIBUTION BOX TRENCHES) TO BE 100 FEET FROM WELL (UNLESS OTHERWISE SPECIFICALLY AUTHORIZED)

NOTE: IF DEEP TRENCH(ES) ARE USED CALL FOR INSPECTION BEFORE AND AFTER PLACING GRAVEL IN TRENCH(ES)

NOTE: NO DRY WELL SHALL EXCEED 15 FOOT IN DIAMETER NO ABSORPTION TRENCH TO EXCEED 100 FEET IN LENGTH

NOTE: ALL PIPE FROM HOUSE TO SEPTIC TANK MUST BE CAST IRON OR SCHEDULE 35/40 PVC OR ABS

PERMIT VOID AFTER TWO YEARS

NOTE: INSTALL STAND PIPE ON SEPTIC TANK AND DRY WELL STAND PIPES MUST BE 6 INCHES IN DIAMETER CAST IRON. CONCRETE OR TERRA COTTA OR PVA OR ABS ACCEPTED. IF TOP OF SEPTIC TANK IS DEEPER THAN 3 FEET, MANHOLE TO GRADE REQUIRED.


NOTE: DISTRIBUTION BOXES MUST HAVE BAFFLES

***INSTALLER IS RESPONSIBLE FOR OBTAINING FINAL APPROVAL ON THIS PERMIT**

HD-260(6-90)

***CALL 461-9933 FOR INSPECTION OF SEPTIC SYSTEM.**

47935
A

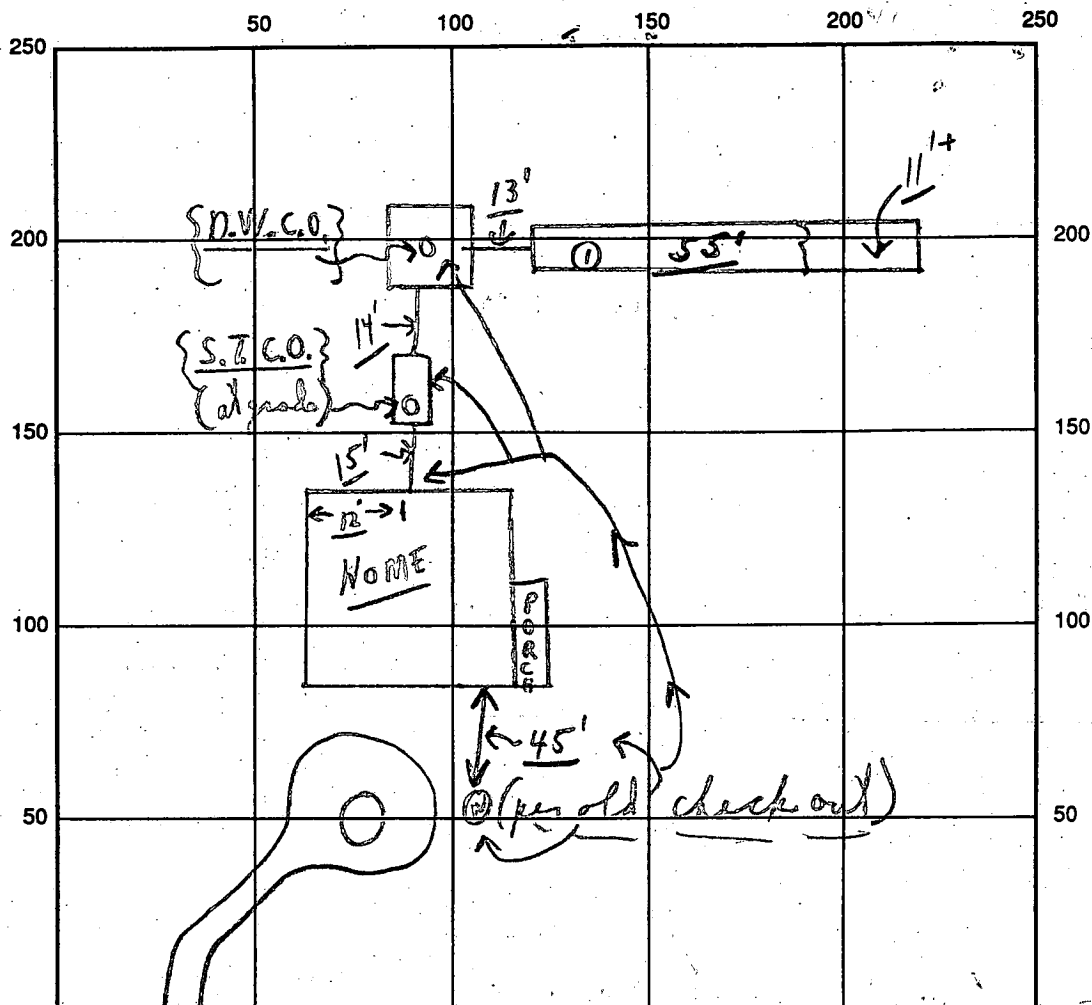

INDICATE NORTH - NAME ADJOINING ROADWAY AS BASE LINE
WALT ANN DRIVE

SEPTIC TANK LEVEL Existing CLEANOUTS Existing
DISTRIBUTION BOX LEVEL 5" Coming off drywell
DRAIN FIELD/TITLE DEPTH 11' FT. TRENCH WIDTH 2 FT. INLET DEPTH 4 FT.
EFFECTIVE GRAVEL DEPTH 7' FT. TOTAL LENGTH 55' FT.
NUMBER OF TRENCHES 1 ONE SIDEWALL/BOTTOM AREA 385 SQ. FT.
DRYWALL INSIDE DIAMETER — FT. EFFECTIVE DEPTH BELOW INLET — FT.
ABSORBENT AREA 385 SQ. FT.

REMARKS: 8/1/91 Repair - trench almost finished ok
to cover as finished - Final - Material on site
Repair in wooded area at right side - rear of home.

DATE SYSTEM APPROVED 8/1/91 INSPECTOR Charles Bryan & Thacker

2/23/68 R/7

PERMIT

SEWAGE DISPOSAL SYSTEM

P 13294

A 09617

MARYLAND STATE DEPARTMENT OF HEALTH

HOWARD COUNTY

INDEXED

ELLICOTT CITY

DISTRICT 3

DATE 12/12/67

Walter A. Shank

IS PERMITTED TO INSTALL ☒ ALTER

ADDRESS Walt-Ann Drive, Ellicott City, Md. PHONE 531-5631

A SEWAGE DISPOSAL SYSTEM LOCATED AT

SUBDIVISION Shepherds Glen ROAD 3826 Walt-Ann Drive LOT 16

PROPERTY OWNER same as above

ADDRESS

SPECIFICATIONS - 3 or 4 bedrooms

DRAIN FIELD DEPTH FEET, BOTTOM AREA SQ. FT.

SEEPAGE PITS ABSORBENT SIDE-WALL AREA SQ. FT.

SEPTIC TANK CAPACITY 750 GALLONS for 3 bedrooms
1,000 " " 4 bedrooms

FOR GARBAGE GRINDER, INCREASE DISPOSAL AREA 22% & TANK CAPACITY 50%.

3 bedrooms

OTHER Dry well 12 ft. in dia. by 10 ft. deep below the inlet located 245 ft. from the front property line and 89 ft. from the left side property line as seen when facing the lot from Folly Quarter Drive. Locate inlet 4 ft. below original grade.

4 bedrooms - Dry well 13 ft. in dia. by 12 ft. deep below the inlet. Located 245 ft. from the front property line and 89 ft. from the left side property line as seen when facing the lot from Folly Quarter Drive. Locate inlet 4 ft. below original grade.

MAXIMUM DEPTH PERMITTED 14' below original grade.

PERMIT VOID AFTER THREE YEARS.

PLANS APPROVED BY J. Hennigan DATE 5/27/65

FILL SEPTIC TANK AND DISTRIBUTION BOX WITH WATER BEFORE CALLING FOR AN INSPECTION. COVER NO WORK UNTIL INSPECTED AND APPROVED.

NEITHER THE HOWARD COUNTY COMMISSIONERS NOR THE HEALTH DEPARTMENT IS RESPONSIBLE FOR THE SUCCESSFUL OPERATION OF ANY SYSTEM.

NOTIFY THE HEALTH DEPARTMENT 48 HOURS
BEFORE EXCAVATIONS ARE TO BE BACK FILLED.

09617

APPLICATION

A 09617

SEWAGE DISPOSAL TESTING

P 1

MARYLAND STATE DEPARTMENT OF HEALTH

HOWARD COUNTY

ELLICOTT CITY

DISTRICT 3

DATE 2/8/65

3 bedrooms

Dry well 12 ft. in dia. by 10 ft. deep below the inlet located 245 ft. from the front property line and 89 ft. from the left side property line as seen when facing the lot from Valley Quarter Drive. Inlet 4 ft. below original grade.

4 bedrooms

TO: THE COUNTY HEALTH OFFICER
ELLICOTT CITY, MARYLAND

Same as above with these exceptions: Dry well 13 ft. in dia. by 12 ft. deep below the inlet. 1000 gal. sept. tank.

I, HEREBY, APPLY FOR THE NECESSARY TESTS IN ORDER TO CONSTRUCT (OR RECONSTRUCT) A SEWAGE DISPOSAL SYSTEM.

PROPERTY OWNER Walter A. Shank

ADDRESS Avoca Ave., Ellicott City, Md. PHONE HO 5-3464

PROPERTY LOCATION:

SUBDIVISION ~~Ellicott City~~ Shepherds Glen LOT NO. 16

ROAD AND DESCRIPTION ~~Ellicott City Drive~~ Walt-Ann Drive

OCCUPANT _____ PHONE _____

PERSON TO CONSTRUCT SYSTEM _____

ADDRESS _____ PHONE _____

SIZE OF LOT 1.89 acres TYPE BLDG. 3 or 4
NUMBER OF BEDROOMS

IF NOT SINGLE RESIDENCE DESCRIBE _____

SIGNATURE OF APPLICANT /s/ Walter A. Shank


APPROVED BY J. Hennigan FOR Dry Well DATE 5-27-65
(KIND OF SYSTEM)

REJECTED BY _____ FOR _____ DATE _____
(KIND OF SYSTEM)

HOLD PENDING FURTHER TESTS _____ DATE _____

REASONS FOR REJECTION OR HOLDING _____

THIS IS NOT A PERMIT

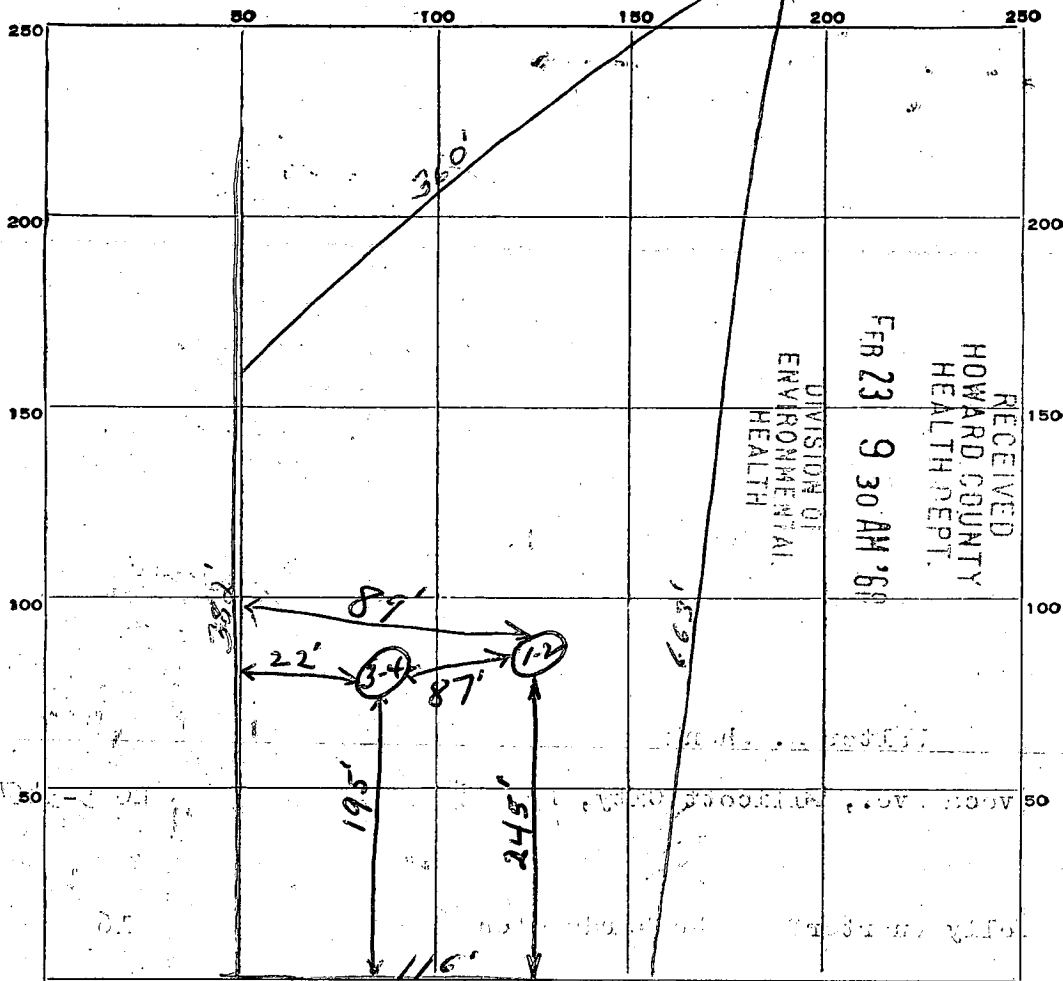

INDICATE NORTH. - NAME ADJOINING ROADWAY AS BASE LINE.

FOLLY QUARTER DR.

DATE	TEST NO.	DEPTH	PRE-WET		TEST - 1" DROP		TIME
			START	STOP	START	STOP	
2/24/65	1 - Some	11'	11:04	11:08	11:08	11:14	6
	2 - P.A.	5 1/2'	11:04	11:07	11:07	11:12	5
	3 - Some	10'	11:10	11:26	11:26	11:43	17
	4 - P.A.	5'	11:11	11:23	11:23	11:37	14

av. perc.
Time 10.5 min

SOIL AUGER FINDING

TESTED BY JH & JK

REMARKS

ALSO PRESENT Daniel Muller

LOT NO. 16

DEPARTMENT OF
WATER RESOURCESAPPLICATION MUST BE SUBMIT-
TED AND PERMIT RECEIVED BE-
FORE DRILLING IS STARTED.

APPLICATION FOR PERMIT TO DRILL WELL

20. 1085

Owner alter Shank

Street or R. F. D. _____

Post Office Dayton MD,Quantity of Water to be Produced 8Gallons Per
MinuteTotal Quantity Needed For Use 250Gallons Per
DayUse for Water HouseApproximate Depth of Well (feet) 90 ftMethod of Drilling to be used SpudderIs this a Replacement Well? Yes - ☒ No

If YES, indicate date abandoned well is to be

sealed: _____

and by whom: _____

PERMIT TO DRILL WELL
(Not To Be Filled In By Driller)Well Permit No. H0-68-W-105Samples of Cuttings Required by Department: ☒ Yes ☐ NoOwner Requires Permit to Appropriate Water: ☒ Yes ☐ NoOwner Has Permit to Appropriate Water: ☒ Yes ☐ No

Appropriation Permit No. _____

The applicant is herewith granted a permit to drill this well
subject to the conditions stipulated.Paul W. McKee

Director

Date

11-28-67THIS PERMIT IS NOT TRANSFERABLE
WITHOUT WRITTEN PERMISSION FROM THE DEPARTMENT
Special conditions that must be observed: _____

Health Department Approval of Application

Howard

County Department of Health

or ☐ State Department of HealthApproved by Palmer F. WhineTitle Director, Environmental HealthDate 11/27/67Driller Arthur P. Edmonds License Number 317Street or R. F. D. _____
Post Office Finksburg, MD, #2Date Nov, 21, 1967

Location of Well _____

County _____

Subdivision Shepherds GlenSection _____ Lot 16County HowardNearest Town Dayton MD,Distance from Town 2 MIDirection from Town south east


Description of Location of Well

(This information MUST BE ACCURATE, and should be definite
enough to permit locating well on a county map).Near what road RT 32On which side of road south east

(North, East, South, West)

Distance from road 2 MIDraw a sketch below showing location of well in relation to nearby
towns, roads and streams with north in the direction of the arrow,
and give distance from well to nearest road junction or stream
crossing shown on the sketch. Distances may be approximate, but
must be indicated.

NORTH

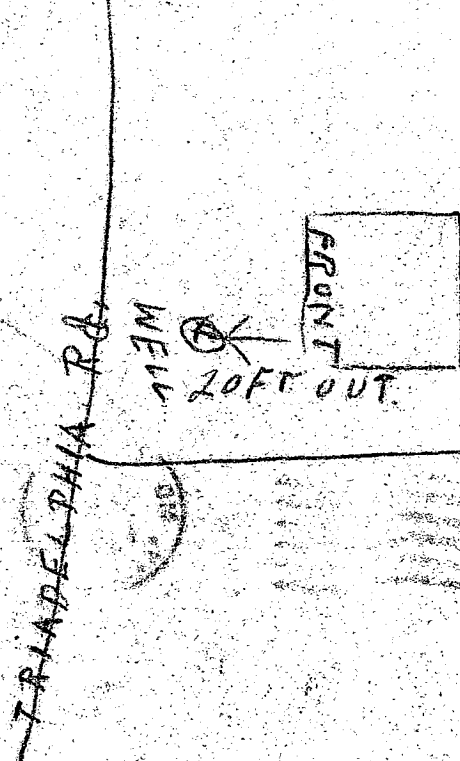

50 JUN 5 AM 8:47

THIS REPORT
MUST BE SUBMITTED
WITHIN 30 DAYS
AFTER COMPLETION
OF THE WELL

WELL COMPLETION REPORT

DEPARTMENT OF
WATER RESOURCES

WELL DESCRIPTION

WELL LOG

State the kind of formations penetrated, their color, their depth, their thickness, and if water-bearing

60 ft of sand and 30
of sand rock

FEET
from ___ to ___

CASING AND SCREEN RECORD

State the kind and size and position of casing, liner, shoe, screen, and other accessories (if no casing used, give diameter of well)

DIAM.
(inches)
6

FEET
from ___ to ___
60

Permit Number Ho 68 # 105
Owner Walter Shank
Address Dayton MD,
Subdivision Carphers Glen
Section _____ Lot 16

PUMPING TEST

Hours Pumped 4
Type of Pump Used Sand
Pumping Rate 8
Gallons per Minute 10

WATER LEVEL

(Distance from land surface to water)
Before Pumping 30 ft Ft.
When Pumping 35 Ft.

APPEARANCE OF WATER

Clear X Cloudy _____
Taste ok
Odor non


Height of Casing Above Land
Surface 1 ft Ft.

PUMP INSTALLED

Type non
Capacity
Gallons per Minute _____
Gallons per Hour _____
Pump Column Length _____ Ft.

LOCATION OF WELL ON LOT

Show permanent structures such as building(s), septic tank, and/or other landmarks and indicate not less than 2 distances (measurements) to well.

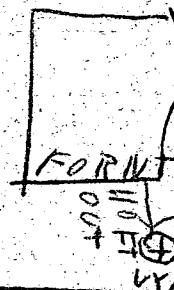

TRIA DELPHIA, RL

DATE
WELL WAS
COMPLETED

I hereby affirm that this report contains no willful misrepresentations or falsifications and that information given in this report is true, accurate and complete to the best of my knowledge and belief.

Nov, 25, 1967

Arthur P. Edmondson, Well Driller

Well Driller License No.: 317