

PERMIT

SEWAGE DISPOSAL SYSTEM

DEPARTMENT OF HEALTH AND MENTAL HYGIENE

HOWARD COUNTY HEALTH DEPARTMENT

BUREAU OF ENVIRONMENTAL HEALTH

461-9933

INDEXED

12/9/91(2) P.C.O.
C.B.J.

P 47670

A REPAIR

DISTRICT 3rd

DATE 12/11/91

DATE SYSTEM APPROVED 12/9/91

INSPECTOR C.B.J.

Jenkins Brothers

IS PERMITTED TO INSTALL ALTER ☒

ADDRESS Route 144, Ellicott City, Maryland 21043 PHONE 465-6646

SUBDIVISION LOT 11 ROAD 11880 Triadelphia Road

PROPERTY OWNER Gebhart, Arthur

ADDRESS

SEPTIC TANK CAPACITY GALLONS

NUMBER OF BEDROOMS

SQUARE FEET PER BEDROOM

LINEAR FEET OF TRENCH REQUIRED

REPAIR - PURPOSE - Drywells are full.

Call for inspection when ground is opened so sanitarian can recommend repair.

12/9/91-OK FOR (1) TRENCH - 85' Long, 2' wide, 10' deep
6' of stones under pipe; inlet 4' below original grade and
11' off exterior - Dry Well closest to home. (1) riser hole
show soil good (4' to 10') → 12/9/91 C.B.J.

PLANS APPROVED BY Mark Rifkin DATE 12/06/91

COVER NO WORK UNTIL INSPECTED AND APPROVED

NEITHER THE HOWARD COUNTY COUNCIL NOR THE HEALTH DEPARTMENT IS RESPONSIBLE FOR THE SUCCESSFUL OPERATION OF ANY SYSTEM

NOTE: CLEANOUT REQUIRED EVERY 70 FEET OF SEWER LINE AND/OR AT 90° SWEEPS IN LINES FROM HOUSE TO DRAIN FIELDS, 90° ELBOWS NOT ACCEPTABLE.

NOTE: ALL PARTS OF SEPTIC SYSTEMS (I.E. TANK, DISTRIBUTION BOX TRENCHES) TO BE 100 FEET FROM WELL (UNLESS OTHERWISE SPECIFICALLY AUTHORIZED)

NOTE: IF DEEP TRENCH(ES) ARE USED CALL FOR INSPECTION BEFORE AND AFTER PLACING GRAVEL IN TRENCH(ES)

NOTE: NO DRY WELL SHALL EXCEED 15 FOOT IN DIAMETER NO ABSORPTION TRENCH TO EXCEED 100 FEET IN LENGTH

NOTE: ALL PIPE FROM HOUSE TO SEPTIC TANK MUST BE CAST IRON OR SCHEDULE 35/40 PVC OR ABS

PERMIT VOID AFTER TWO YEARS

NOTE: INSTALL STAND PIPE ON SEPTIC TANK AND DRY WELL STAND PIPES MUST BE 6 INCHES IN DIAMETER CAST IRON. CONCRETE OR TERRA COTTA OR PVA OR ABS ACCEPTED. IF TOP OF SEPTIC TANK IS DEEPER THAN 3 FEET. MANHOLE TO GRADE REQUIRED.

NOTE: DISTRIBUTION BOXES MUST HAVE BAFFLES

*INSTALLER IS RESPONSIBLE FOR OBTAINING FINAL APPROVAL ON THIS PERMIT

HD-260(6-90)

*CALL 461-9933 FOR INSPECTION OF SEPTIC SYSTEM.

Note 7/19/74
↳ 6 bdrm house

P 47670

Arthur Gebhart approved 8/1/83

8/1/83 plus
a.m.

PERMIT

P 32880
A Repair

SEWAGE DISPOSAL SYSTEM

MARYLAND STATE DEPARTMENT OF HEALTH

HOWARD COUNTY

BUREAU OF ENVIRONMENTAL HEALTH
992-2330

ELLICOTT CITY

DISTRICT 3rd

INDEX

DATE 6/21/83

Joseph Neubauer IS PERMITTED TO INSTALL ALTER X

ADDRESS 4982 Landing Road, Elkridge, Md. 21227 PHONE 744-4158

SUBDIVISION ROAD 11880 Triadelphia Road LOT 11

PROPERTY OWNER Carroll Sill Gebhart, Arthur 482

ADDRESS 11880 Triadelphia Road, Ellicott City, Md. 21043 Phone: 988-9686 or 9281

IF GARBAGE GRINDER IS USED INCREASE SEPTIC TANK CAPACITY BY 50% AND ABSORPTION AREA BY 22%.

GARBAGE GRINDER? YES NO

SEPTIC TANK CAPACITY GALLONS NUMBER OF BEDROOMS

REPAIR - Call for an appointment when ground is opened up and Sanitarian will recommend the repair system.

DISTRIBUTION BOX BROKEN - REPAIR OR REPLACE.
LINES TO DRYWELL CLOGGED - UNCLOG OR REPLACE.
ADD CLEANOUTS TO ABOVE GRADE ON BOTH DRYWELLS.
SWITCHING DEVICE RECOMMENDED BUT NOT REQUIRED.
CALL WHEN ALL IS READY. 7-26-83 C. Williams

PLANS APPROVED BY Frank A. Skinner DATE 6/21/83

COVER NO WORK UNTIL INSPECTED AND APPROVED.

NEITHER THE HOWARD COUNTY COUNCIL NOR THE HEALTH DEPARTMENT IS RESPONSIBLE FOR THE SUCCESSFUL OPERATION OF ANY SYSTEM.

NOTE: IF TRENCH IS USED CALL FOR INSPECTION BEFORE AND AFTER PLACING GRAVEL IN TRENCH.

NOTE: NO DRY WELL SHALL EXCEED 15 FOOT IN DIAMETER. NO ABSORPTION TRENCH TO EXCEED 100 FEET IN LENGTH.

NOTE: ALL PIPE FROM HOUSE TO SEPTIC TANK MUST BE CAST IRON OR SCHEDULE 40 PVC OR ABS.

PERMIT VOID AFTER THREE YEARS.

NOTE: INSTALL STAND PIPE ON SEPTIC TANK AND DRY WELL. STAND PIPES MUST BE 6 INCHES IN DIAMETER. CAST IRON, CONCRETE OR TERRA COTTA, OR PVC OR ABS ACCEPTED. IF TOP OF SEPTIC TANK IS DEEPER THAN 3 FEET MANHOLE TO GRADE REQUIRED.


BLDG. PERMIT SIGNED
AND RETURNED 6/28/83
Qual # 58729
Portico

*INSTALLER IS RESPONSIBLE FOR OBTAINING FINAL APPROVAL ON THIS PERMIT

*CALL 992-2330 FOR INSPECTION OF SEPTIC SYSTEMS.

EH - 2-1082

A 32880

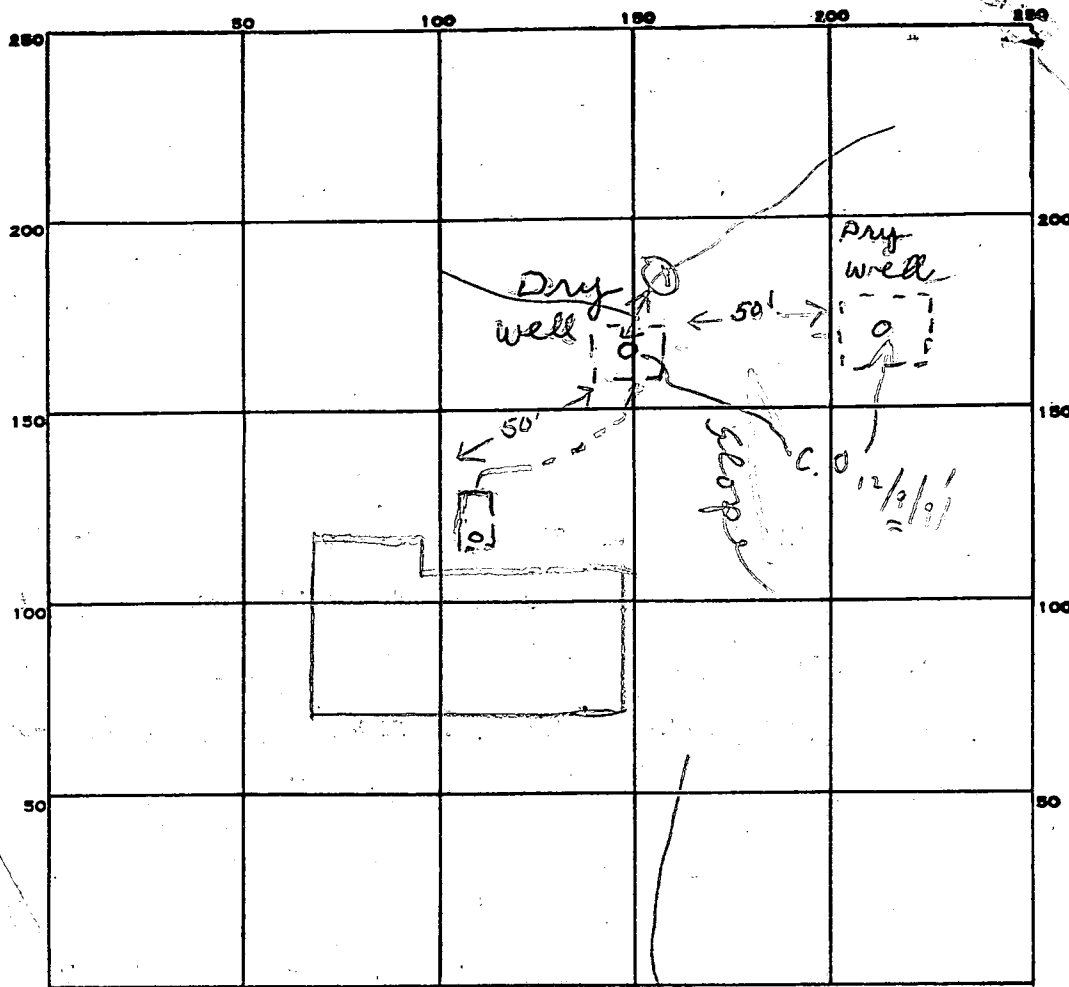

10' deep
 2' in
 80

9:30 to
 10:30

INDICATE NORTH. - NAME ADJOINING ROADWAY AS BASE LINE.

PERMIT CARD

SEPTIC TANK, LEVEL

CLEANOUTS

DISTRIBUTION BOX, LEVEL

TILE FIELD, DEPTH FT. TRENCH WIDTH FT.

GRAVEL DEPTH IN. TOTAL LENGTH FT.

NUMBER OF TRENCHES TOTAL BOTTOM AREA

SEEPAGE PITS, INSIDE DIAMETER FT. DEPTH BELOW INLET FT.

ABSORBENT AREA SQ. FT.

REMARKS 8/1/83 Work OK - OK to cover. Switching
 device on dry wells not used.

DATE SYSTEM APPROVED

8/1/83

INSPECTOR

Stanger

APPLICATION

A 18209

P _____

SEWAGE DISPOSAL TESTING

STATE OF MARYLAND - DEPARTMENT OF HEALTH AND MENTAL HYGIENE

HOWARD COUNTY HEALTH DEPARTMENT
ENVIRONMENTAL HEALTH SERVICESP. O. BOX 476, ELLICOTT CITY, MARYLAND 21043
TELEPHONE: 465-5000, EXT. 356DISTRICT 3DATE 4/2/73

*Septic Tank - 1000 gal
Dry Well - 360 sq ft*

*absorbent sidewalk area to begin below the solid
clay to start at 3 1/2 ft. maximum depth permitted
for dry well is 12 ft below original grade. To be
dry well 65 ft off of property line that is 468.15 ft.
and 150 ft. off of property line that is 522.15 ft. long*

TO: THE COUNTY HEALTH OFFICER
ELLICOTT CITY, MARYLAND

I, HEREBY, APPLY FOR THE NECESSARY TEST IN ORDER TO CONSTRUCT (OR RECONSTRUCT) A SEWAGE DISPOSAL SYSTEM.

PROPERTY OWNER Ferdinand Kelly (Contract purchaser - Stevenson Carroll Sill)
4678 South Leisure Court, Ellicott City, Md.
ADDRESS _____ PHONE 465-6333

PROPERTY LOCATION:

SUBDIVISION _____ LOT NO. Parcel 11ROAD AND DESCRIPTION Triadelphia Rd. - 2nd open field from Rt. 144 on rightSIZE OF LOT 5.377 acres TYPE BLDG. 3NUMBER OF BEDROOMS
(Single Family Dwellg.)

IF NOT SINGLE RESIDENCE DESCRIBE _____

THE SYSTEM INSTALLED UNDER THIS APPLICATION IS ACCEPTABLE ONLY UNTIL PUBLIC FACILITIES BECOME AVAILABLE.

SIGNATURE OF APPLICANT De LeeAPPROVED BY Robert V. Toner FOR Dry Well DATE 4/1/73
(KIND OF SYSTEM)REJECTED BY _____ FOR _____ DATE _____
(KIND OF SYSTEM)

HOLD PENDING FURTHER TESTS _____ DATE _____

REASONS FOR REJECTION OR HOLDING _____

THIS IS NOT A PERMIT


A 18209

428
8
386

10

48
72
33
386
72

50
7
350

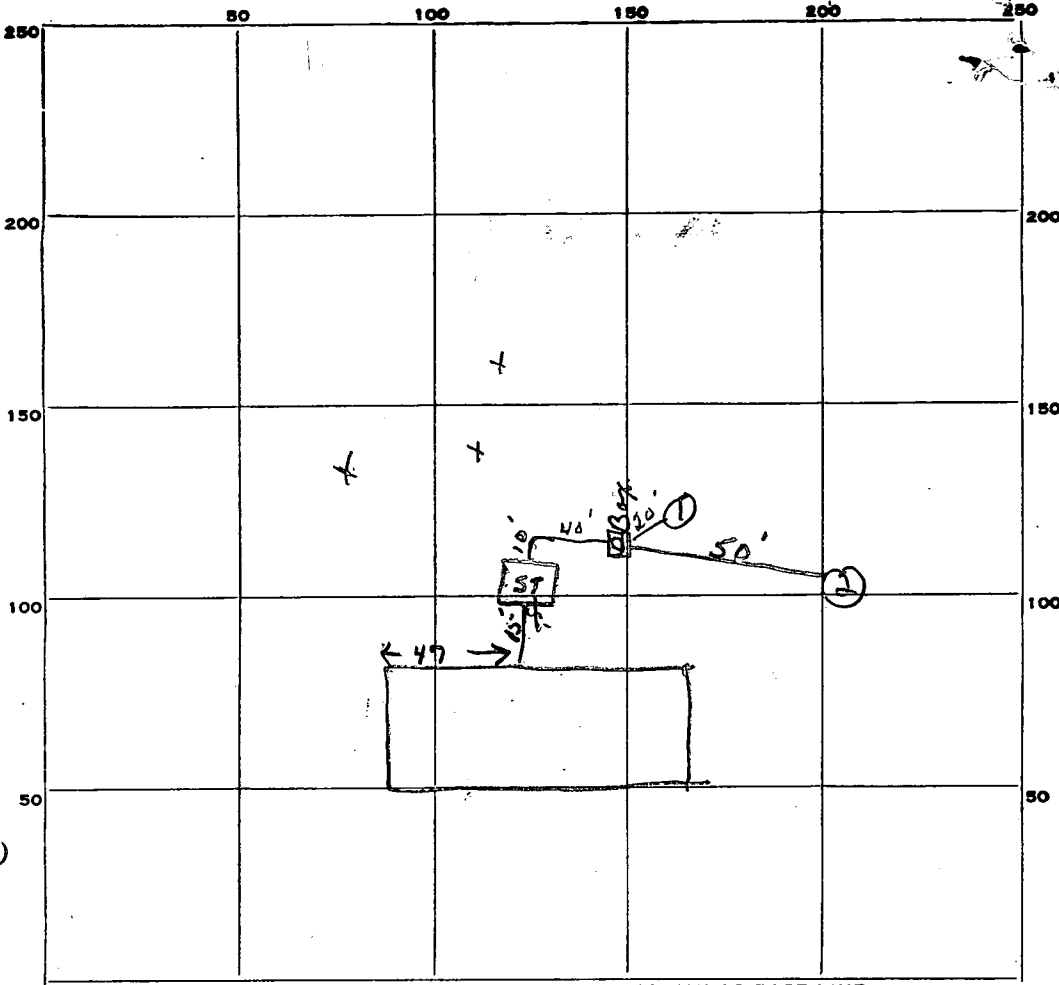

4,100

INDICATE NORTH. - NAME ADJOINING ROADWAY AS BASE LINE.

PERMIT CARD Signed

SEPTIC TANK, LEVEL OK

CLEANOUTS None

DISTRIBUTION BOX, LEVEL OK

TILE FIELD, DEPTH - FT. TRENCH WIDTH - FT.

GRAVEL DEPTH - IN. TOTAL LENGTH - FT.

NUMBER OF TRENCHES outside perimeter #1 12x13 TOTAL BOTTOM AREA #1 7ft


SEEPAGE PITS, INSIDE DIAMETER #2 12x12 FT. DEPTH BELOW INLET # 8ft FT.

ABSORBENT AREA #2 400 SQ. FT.

REMARKS 7/26/74 Hole one (1) dug to 10 ft - Hole (2) dug to 11 1/2 ft. Sandy soil
OK to complete dry wells. Septic tank to be
kept shallow so repairs can be made in higher area, (XXX)
by coming off septic tank.
7/31/74 - Give OK to backfill when cleanouts are installed,
call when line from house to tank is installed.

DATE SYSTEM APPROVED 8/7/74

INSPECTOR Robert V. Tonn

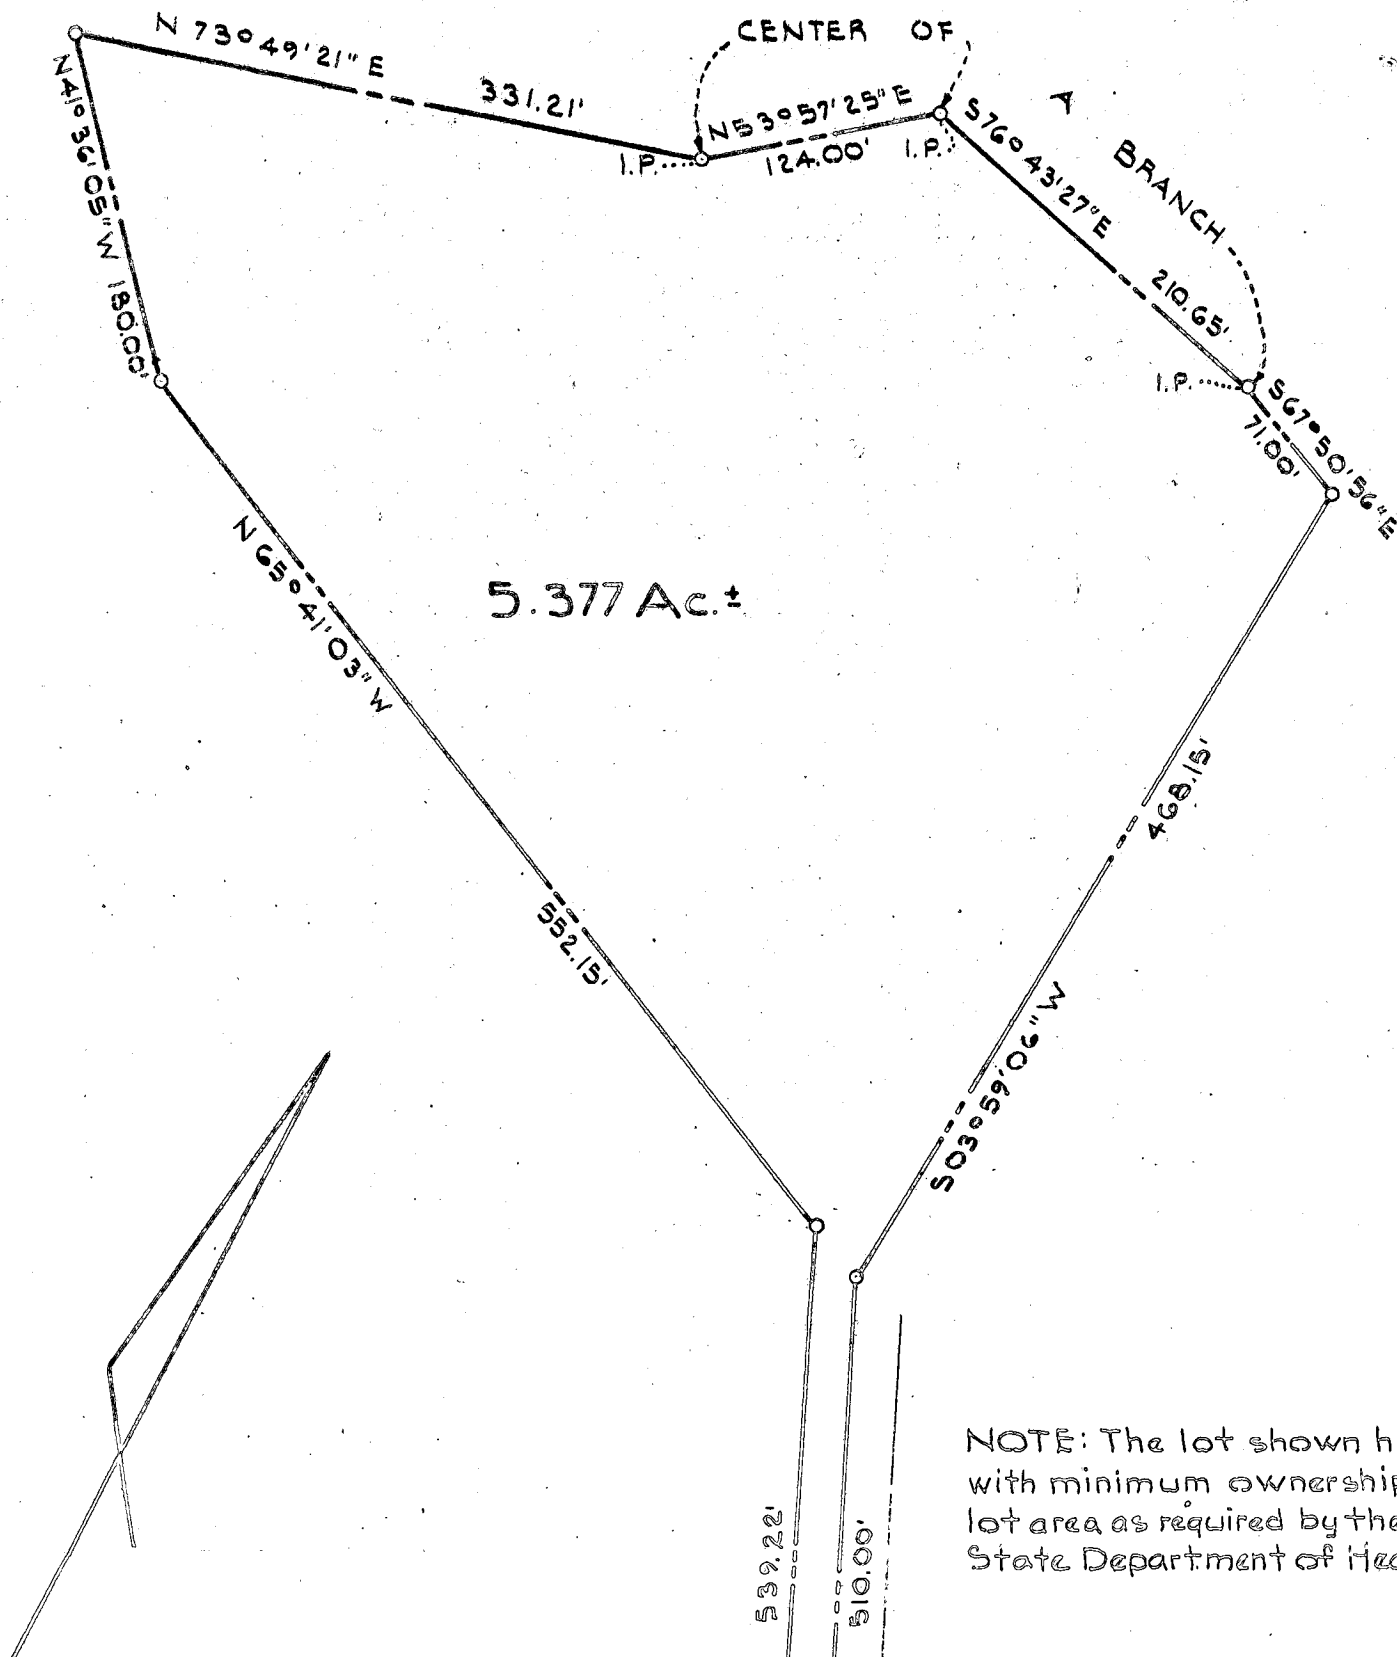

NOTE: The lot shown hereon complies with minimum ownership width and lot area as required by the Maryland State Department of Health Regulations

PROPERTY OF
 STEVENSON CARROLL SILL, JR. & WIFE
 3rd ELECTION DIST. HOWARD COUNTY, MD.
 JULY 24, 1973 SCALE: 1"=100'


WILLIAM G. RASCH II
 REG. NO. 4375

DATE

APPROVED: For private water and private sewerage systems, Howard County Health Department.


County Health Officer

Date

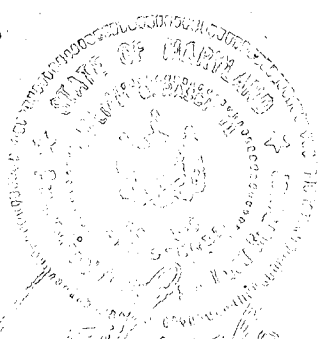

TRIADELPHIA ROAD

PURDUM & JESCHKE
 ENGINEERS AND LAND SURVEYORS
 3697 PARK AVE.
 ELICOTT CITY, MARYLAND 21043

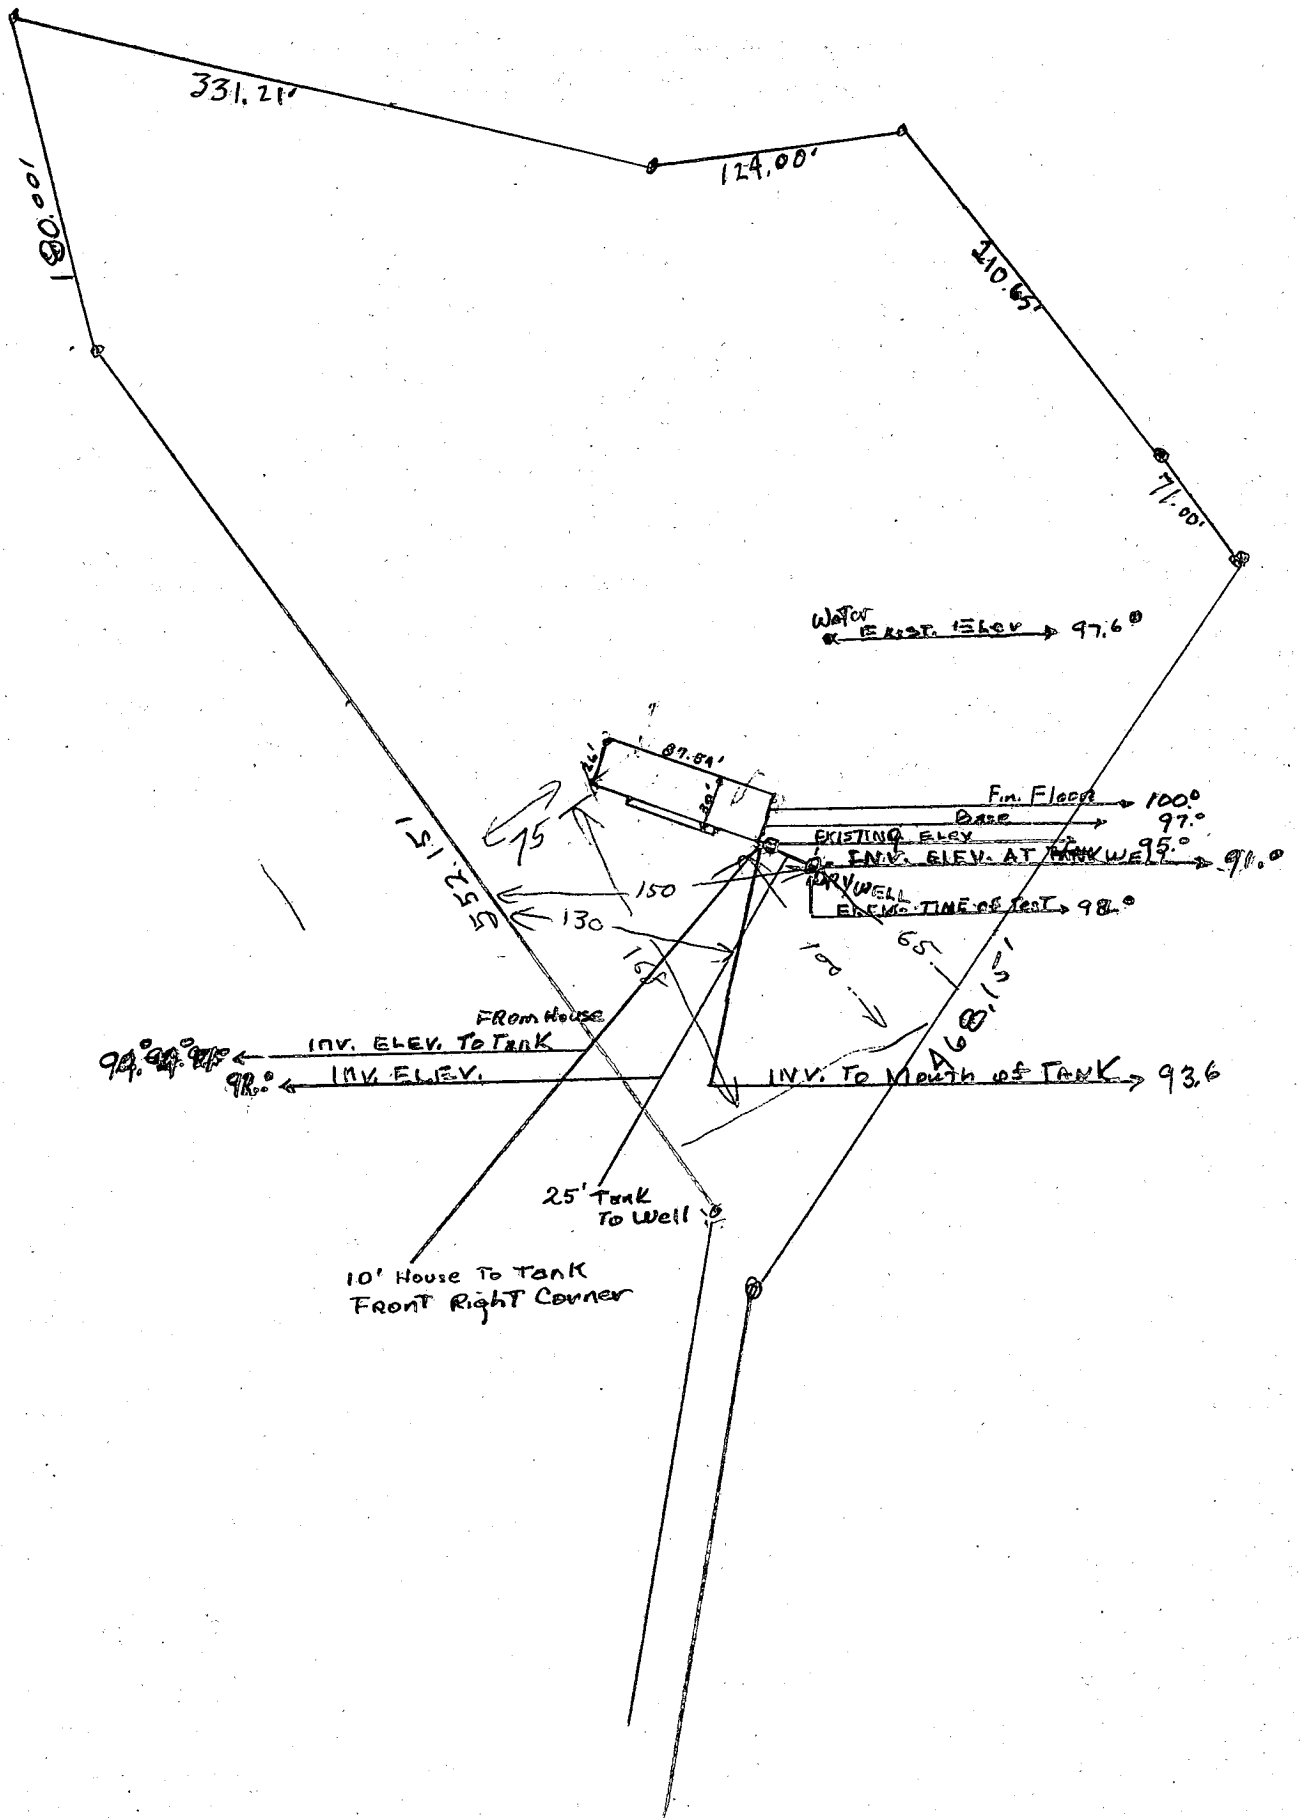

Arthur W. Day

SCALE 1" = 100'

Top of Well 2'-3' Below Grade

Top of Footing - grade where well is located is the same

INV. to Augwell 88'

Outlet from Tank 91'

INV. Mouth of Tank 92'

INV. to Tank 23'


Finish Floor 100'

Base Conc Slab 91'

House to Tank - 10'

Tank to Well - 40'

Elev. Top of Tank 93'

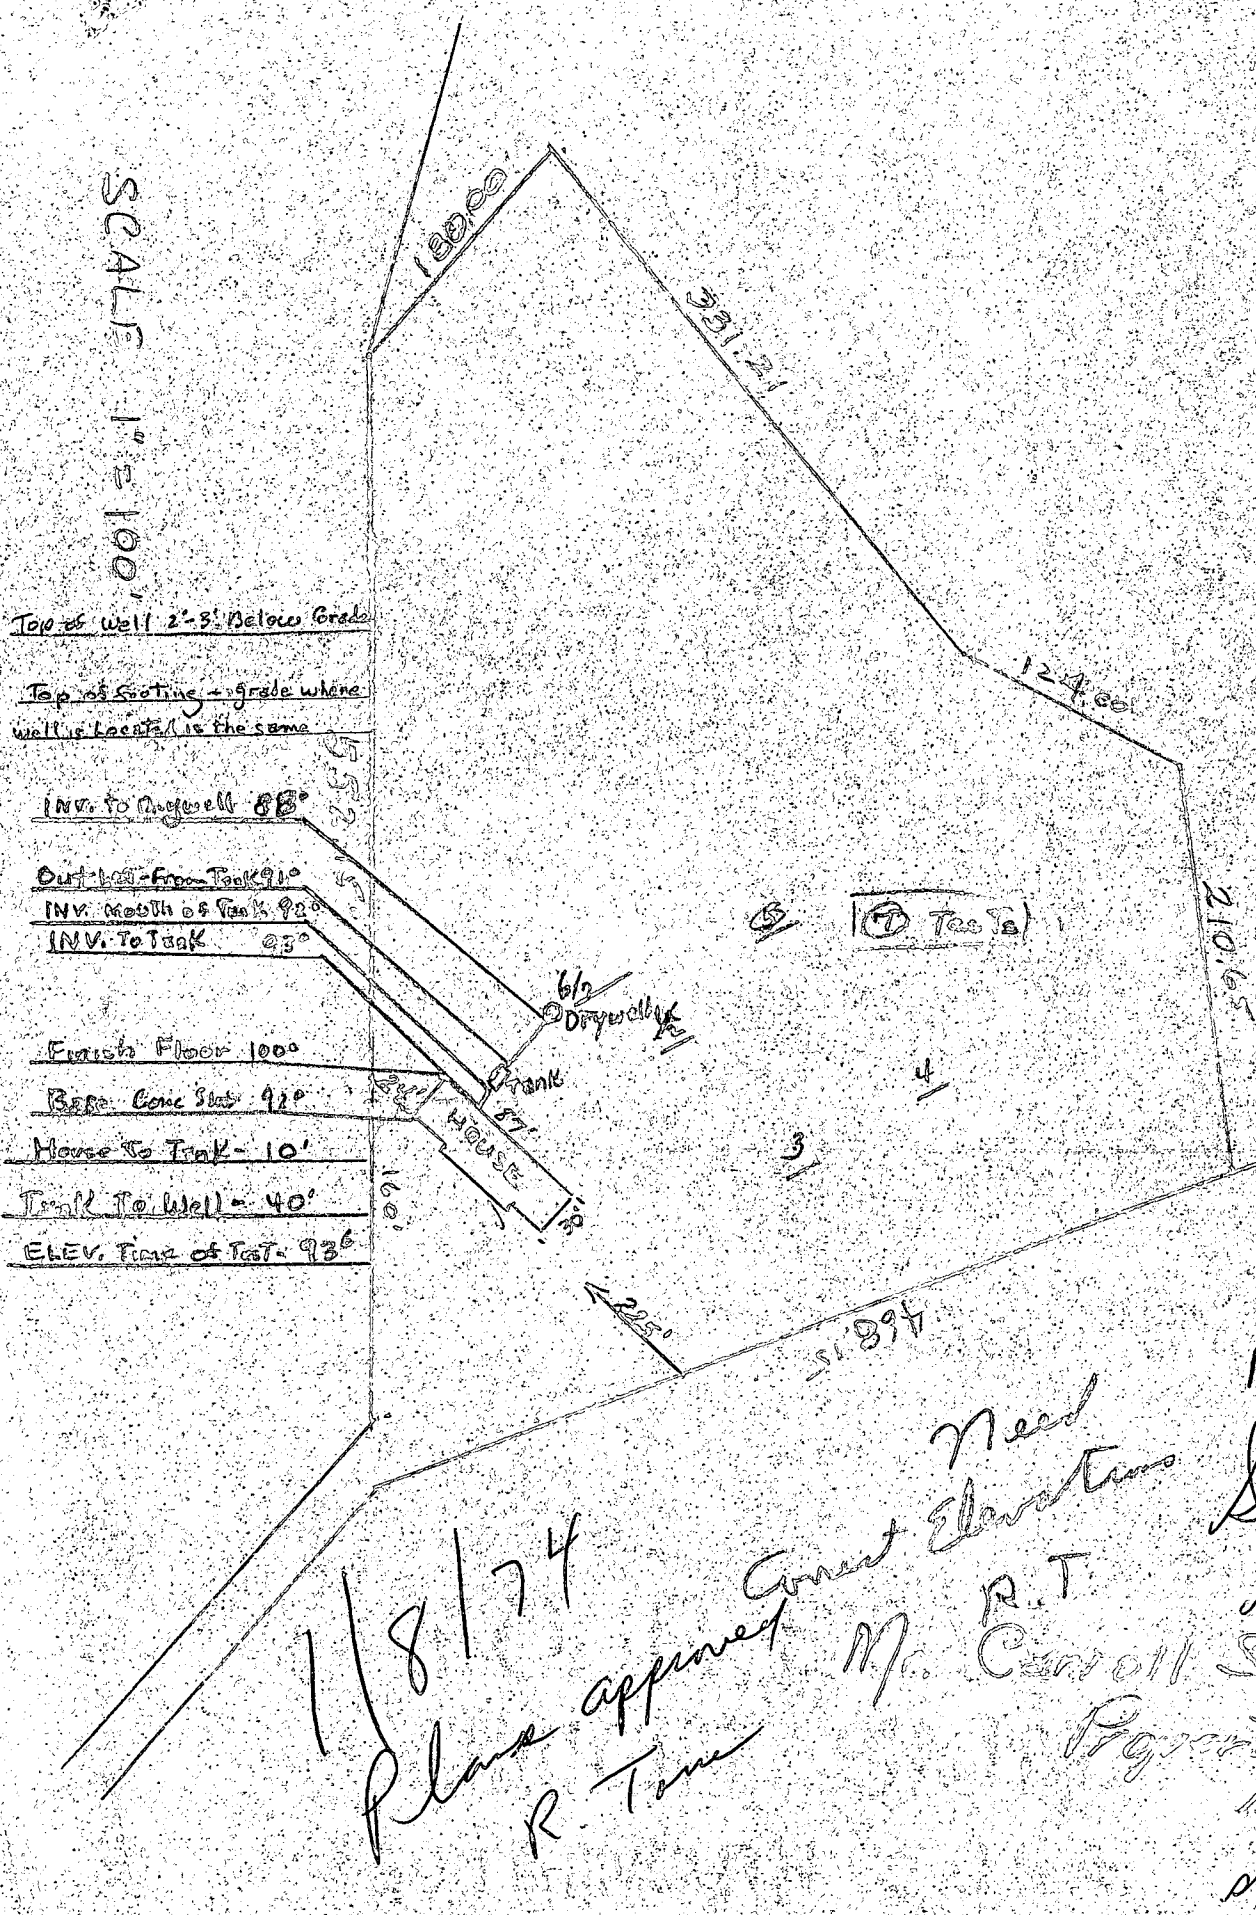

Bldg permit signed 1/8/74


1/8/74
Plans approved
R. T. Carr

Need correct Elevation
R.T.
M. Carroll S. H.

1/8/74
Show that location of dry well is at point specified on plat
R.T.

LOT No. 11
5.377 Ac. ±

Proposed Dwelling

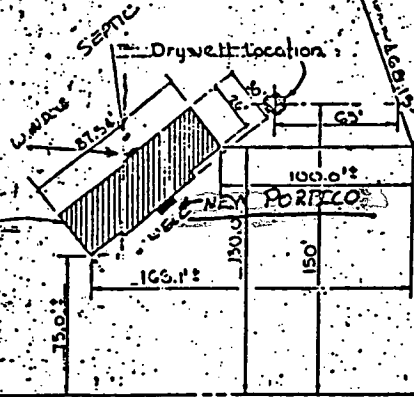

PLAT OF LOT No. 11 SUBDIVISION OF
FERDINAND P. KELLY PROPERTY
3rd Election District, Howard County, Maryland.

6/22/91
PLANS OF
LOT 11
R.P.

SPECIALTY TRIM CO., INC.
P.O. BOX 50
CLARKSVILLE, MD 21029
(301) 531-2368

C 1	4956	SEQUENCE NO. (WRA USE ONLY)	STATE OF MARYLAND WATER RESOURCES ADMINISTRATION TAWES STATE OFFICE BLDG., ANNAPOLIS, MD. 21401		THIS REPORT MUST BE SUBMITTED WITHIN 30 DAYS AFTER WELL COMPLETION
(THIS NUMBER IS TO BE PUNCHED IN COLUMNS 3-6 ON ALL CARDS)			WELL COMPLETION REPORT		FILL IN THIS FORM COMPLETELY
DATE RECEIVED (WRA USE ONLY) <u>7-19-74</u>			DEPTH OF WELL <u>400</u>		PERMIT NO. FROM "PERMIT TO DRILL WELL" <u>40-73-0716</u>
DATE WELL COMPLETED <u>7-19-74</u>			22 (TO NEAREST FOOT) 26		28 29 30 31 32 33 34 35 36 37
OWNER <u>W. J. Stevenson</u>			FIRST NAME <u>W. J.</u>		DRILLERS IDENTIFICATION NO. <u>42</u>
STREET OR RFD <u>5604 Balto. Rd.</u>			POST OFFICE <u>Balto. Md.</u>		

WELL LOG			GROUTING RECORD			PUMPING TEST		
STATE THE KIND OF FORMATIONS PENETRATED, THEIR COLOR, DEPTH, THICKNESS AND IF WATER BEARING			WELL HAS BEEN GROUTED (CIRCLE APPROPRIATE BOX) ☒ YES ☐ NO			1 2 3 (SEQ. NO.) 6		
DESCRIPTION (USE ADDITIONAL SHEETS IF NECESSARY)			TYPE OF GROUTING MATERIAL (CIRCLE BOX) CEMENT ☒ BENTONITE CLAY ☐			PUMPING TEST		
FEET FROM TO			NO. OF BAGS <u>6</u> NO. OF POUNDS <u>600</u>			HOURS PUMPED (TO NEAREST HOUR) <u>0</u>		
CHECK IF WATER BEARING			GALLONS OF WATER <u>30</u>			PUMPING RATE (GALLONS PER MINUTE TO NEAREST GALLON) <u>5</u>		
Top soil sandy granite			DEPTH OF GROUT SEAL (TO NEAREST FOOT) FROM <u>0</u> FT. TO <u>22</u> FT. (ENTER 0 IF FROM SURFACE)			METHOD USED TO MEASURE PUMPING RATE <u>bucket</u>		
0 2 2 20 20 400 ✓			CASING RECORD Casing Type: ☒ STEEL ☐ CONCRETE ☐ PLASTIC ☐ OTHER			WATER LEVEL: (DISTANCE FROM LAND SURFACE) BEFORE PUMPING <u>40</u> (NEAREST FOOT) WHEN PUMPING <u>400</u> (NEAREST FOOT)		
MAIN CASING TYPE <u>ST</u>			NOMINAL DIAMETER TOP (MAIN) CASING (NEAREST INCH) <u>6</u>			TYPE OF PUMP USED (CIRCLE APPROPRIATE BOX) (FOR PUMPING TEST) ☒ AIR ☐ PISTON ☐ TURBINE ☐ CENTRIFUGAL ☐ ROTARY ☐ OTHER (DESCRIBE BELOW) ☐ JET ☐ SUBMERSIBLE		
TOTAL DEPTH OF MAIN CASING (NEAREST FOOT) <u>24</u>			OTHER CASING (IF USED) DIAMETER (INCH) FROM TO			PUMP INSTALLED TYPE OF PUMP (WRITE APPROPRIATE LETTER IN BOX - SEE ABOVE: A, C, J, P, R, S, T, O)		
SCREEN TYPE OR OPEN HOLE ☒ STEEL ☐ BRASS ☐ OPEN HOLE ☐ PLASTIC ☐ OTHER			SCREEN RECORD DEPTH (NEAREST WHOLE FOOT) FROM TO <u>22</u> <u>400</u>			DRILLER WILL INSTALL PUMP (CIRCLE APPROPRIATE BOX) YES ☒ NO ☐		
C 2			C 3			CAPACITY GALLONS PER MINUTE (TO NEAREST GALLON) <u>31</u> <u>35</u>		
C 3			C 4			PUMP HORSE POWER <u>37</u> <u>41</u>		
C 4			C 5			PUMP COLUMN LENGTH (NEAREST FOOT) <u>43</u> <u>47</u>		
C 5			C 6			CASING HEIGHT (CIRCLE APPROPRIATE BOX AND ENTER CASING HEIGHT) ☒ ABOVE ☐ BELOW		
C 6			C 7			LAND SURFACE (NEAREST FOOT) <u>0</u>		
C 7			C 8			LOCATION OF WELL ON LOT SHOW PERMANENT STRUCTURE SUCH AS BUILDINGS, SEPTIC TANKS, AND/OR OTHER LAND MARKS AND INDICATE NOT LESS THAN TWO DISTANCES (MEASUREMENTS TO WELL).		
C 8			C 9			HOUSE 40' well Pd.		

CIRCLE APPROPRIATE BOXES		
☐ A WELL WAS ABANDONED AND SEALED WHEN THIS WELL WAS COMPLETED	☐ E ELECTRIC LOG OBTAINED	☐ P TEST WELL CONVERTED TO PRODUCTION WELL
I HEREBY CERTIFY THAT I HAVE COMPLIED WITH ALL CONDITIONS STATED ON THE ABOVE-CAPTIONED "PERMIT TO DRILL WELL", AND THAT INFORMATION CONTAINED IN THIS REPORT IS TRUE, ACCURATE, AND COMPLETE TO THE BEST OF MY KNOWLEDGE, INFORMATION AND BELIEF.		
DRILLERS NAME (PLEASE PRINT) <u>L. F. Easterday</u>		
SIGNATURE <u>L. F. Easterday</u>		
WRA USE ONLY (NOT TO BE FILLED IN BY DRILLER) T ☐ (E.R.O.S.) ☐ W ☐ 70 ☐ 72 ☐ 74 75 76 OTHER DATA AVAILABLE		