

12/9/93
C/O 12:00
12:30 B
1:00 C

Lagged
PERMIT

SEWAGE DISPOSAL SYSTEM

DEPARTMENT OF HEALTH AND MENTAL HYGIENE

03-289036

HOWARD COUNTY HEALTH DEPARTMENT

BUREAU OF ENVIRONMENTAL HEALTH

~~461-9933~~ 313-2640

INDEXED

P 49779

A 48353

DISTRICT 3rd

DATE 12/2/93

DATE SYSTEM APPROVED 12/9/93

INSPECTOR C.B.A.

Fogle's Septic Clean, Inc. IS PERMITTED TO INSTALL ☒ ALTER

ADDRESS 558 Obrecht Road, Sykesville, Maryland 21784 PHONE 795-5674

SUBDIVISION Kiser Property LOT *DI* I ROAD 12720 Triadelphia Road

PROPERTY OWNER Mr. and Mrs. Kip Goans

ADDRESS

SEPTIC TANK CAPACITY 1000 GALLONS

NUMBER OF BEDROOMS 3

180 SQUARE FEET PER BEDROOM *108*

LINEAR FEET OF TRENCH REQUIRED 180 *(1)*

TRENCHES - Trench to be 2 feet wide. Inlet 3 feet below original grade. Bottom maximum depth 8 feet below original grade. Effective area begins at 3 feet below original grade. 5 feet of stone below distribution pipe.

LOCATION - Place the distribution box 230 feet from the right (950') lot line and 150 feet from the rear (477') lot line. Run trenches along contour toward right (North) side of property.

NOTES - No trench to exceed 100 feet in length. Provide 6" - 8" diameter cleanout and cap to grade or above on septic tank. *OK MR 12/1/93*

PLANS APPROVED BY C. Williams/Mark Rifkin REVISED DATE 11/20/93

COVER NO WORK UNTIL INSPECTED AND APPROVED

NEITHER THE HOWARD COUNTY COUNCIL NOR THE HEALTH DEPARTMENT IS RESPONSIBLE FOR THE SUCCESSFUL OPERATION OF ANY SYSTEM

NOTE: CLEANOUT REQUIRED EVERY 70 FEET OF SEWER LINE AND/OR AT 90° SWEEPS IN LINES FROM HOUSE TO DRAIN FIELDS, 90° ELBOWS NOT ACCEPTABLE.

NOTE: ALL PARTS OF SEPTIC SYSTEMS (I.E. TANK, DISTRIBUTION BOX TRENCHES) TO BE 100 FEET FROM WELL (UNLESS OTHERWISE SPECIFICALLY AUTHORIZED)

NOTE: IF DEEP TRENCH(ES) ARE USED CALL FOR INSPECTION BEFORE AND AFTER PLACING GRAVEL IN TRENCH(ES)

NOTE: NO DRY WELL SHALL EXCEED 15 FOOT IN DIAMETER NO ABSORPTION TRENCH TO EXCEED 100 FEET IN LENGTH

NOTE: ALL PIPE FROM HOUSE TO SEPTIC TANK MUST BE CAST IRON OR SCHEDULE 35/40 PVC OR ABS

PERMIT VOID AFTER TWO YEARS

NOTE: INSTALL STAND PIPE ON SEPTIC TANK AND DRY WELL STAND PIPES MUST BE 6 INCHES IN DIAMETER CAST IRON. CONCRETE OR TERRA COTTA OR PVA OR ABS ACCEPTED. IF TOP OF SEPTIC TANK IS DEEPER THAN 3 FEET. MANHOLE TO GRADE REQUIRED.

NOTE: DISTRIBUTION BOXES MUST HAVE BAFFLES

***INSTALLER IS RESPONSIBLE FOR OBTAINING FINAL APPROVAL ON THIS PERMIT**

HD-260(6-90)

*CALL 461-9933 FOR INSPECTION OF SEPTIC SYSTEM.


BLDG. PERMITS SIGNED

AND RETURNED 7/12/00

800125396

DECK W/STEPS

A 48353

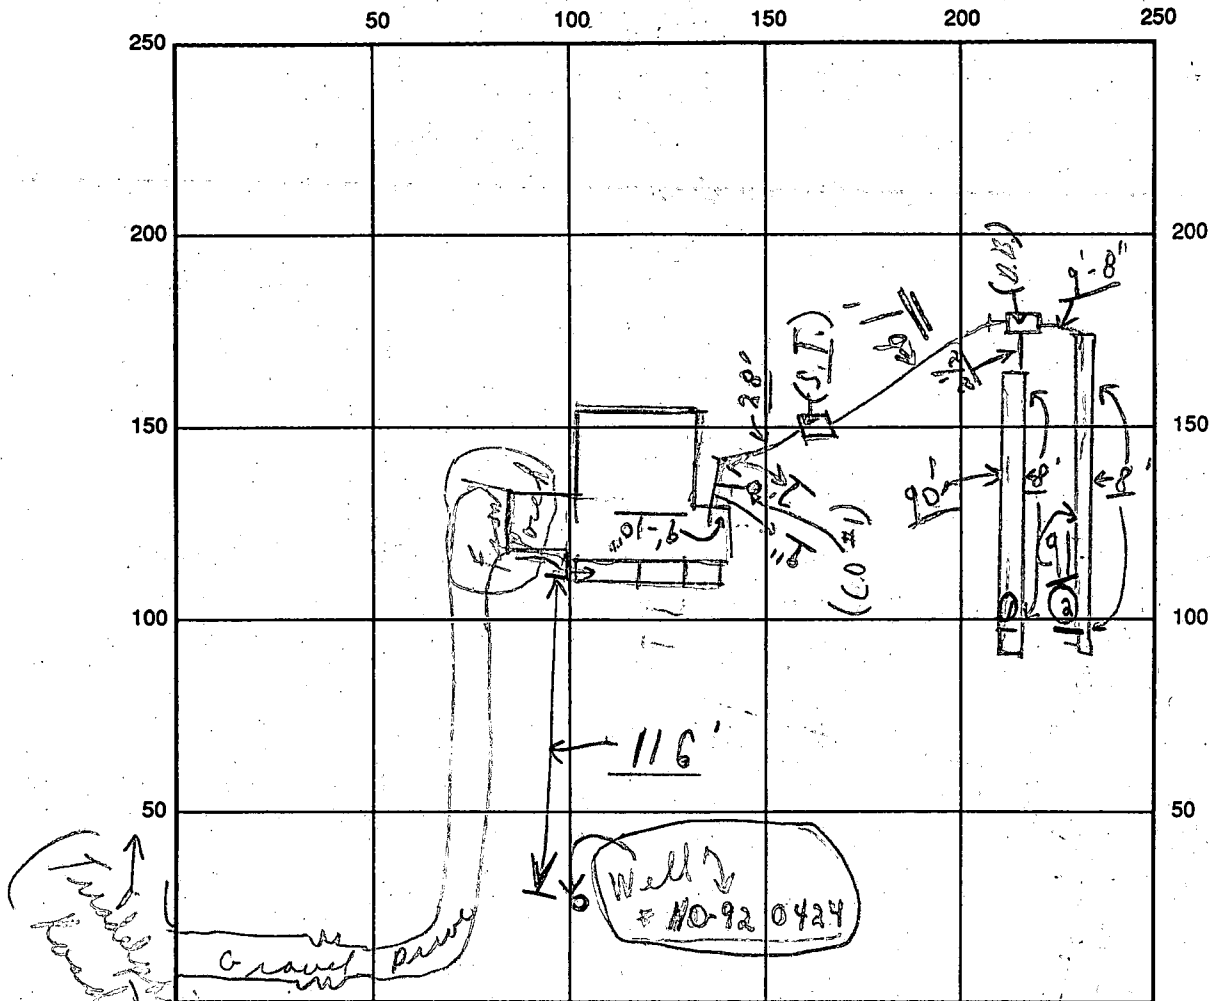

INDICATE NORTH - NAME ADJOINING ROADWAY AS BASE LINE

(see left of drawing for road)

SEPTIC TANK LEVEL OK CLEANOUTS OK OK
 DISTRIBUTION BOX LEVEL OK (Baffle is in) S.T.C.O. C.O.#1
 DRAIN FIELD/TITLE DEPTH 8 FT. TRENCH WIDTH 2 FT. INLET DEPTH 3 FT.
 EFFECTIVE GRAVEL DEPTH 5 FT. TOTAL LENGTH 181 FT. 180
 NUMBER OF TRENCHES 2 ONE SIDEWALL/BOTTOM AREA 905 SQ. FT.
 DRYWALL INSIDE DIAMETER — FT. EFFECTIVE DEPTH BELOW INLET — FT.
 ABSORBENT AREA 905 SQ. FT.


REMARKS: Partial 12/9/93. ok to cover from house to D. Box & water. #1 Trench
Partial B. ok to stone #2 Trench; 12/9/93 (Final, later pm.)
all done.

12/9/93 W.P.I.

DATE SYSTEM APPROVED 12/9/93 INSPECTOR Charles Bryan Stueker

INVERT FROM HOUSE - 548'
INVERT INTO TANK - 547.70'
INVERT OUT TANK - 547.45'
INVERT INTO BOX - 547.10'
INVERT INTO TRENCH - 547'

INVERT INTO TRENCH - 54' MR
elevations OK 10/26/93
trench length
determined by H.D. N4

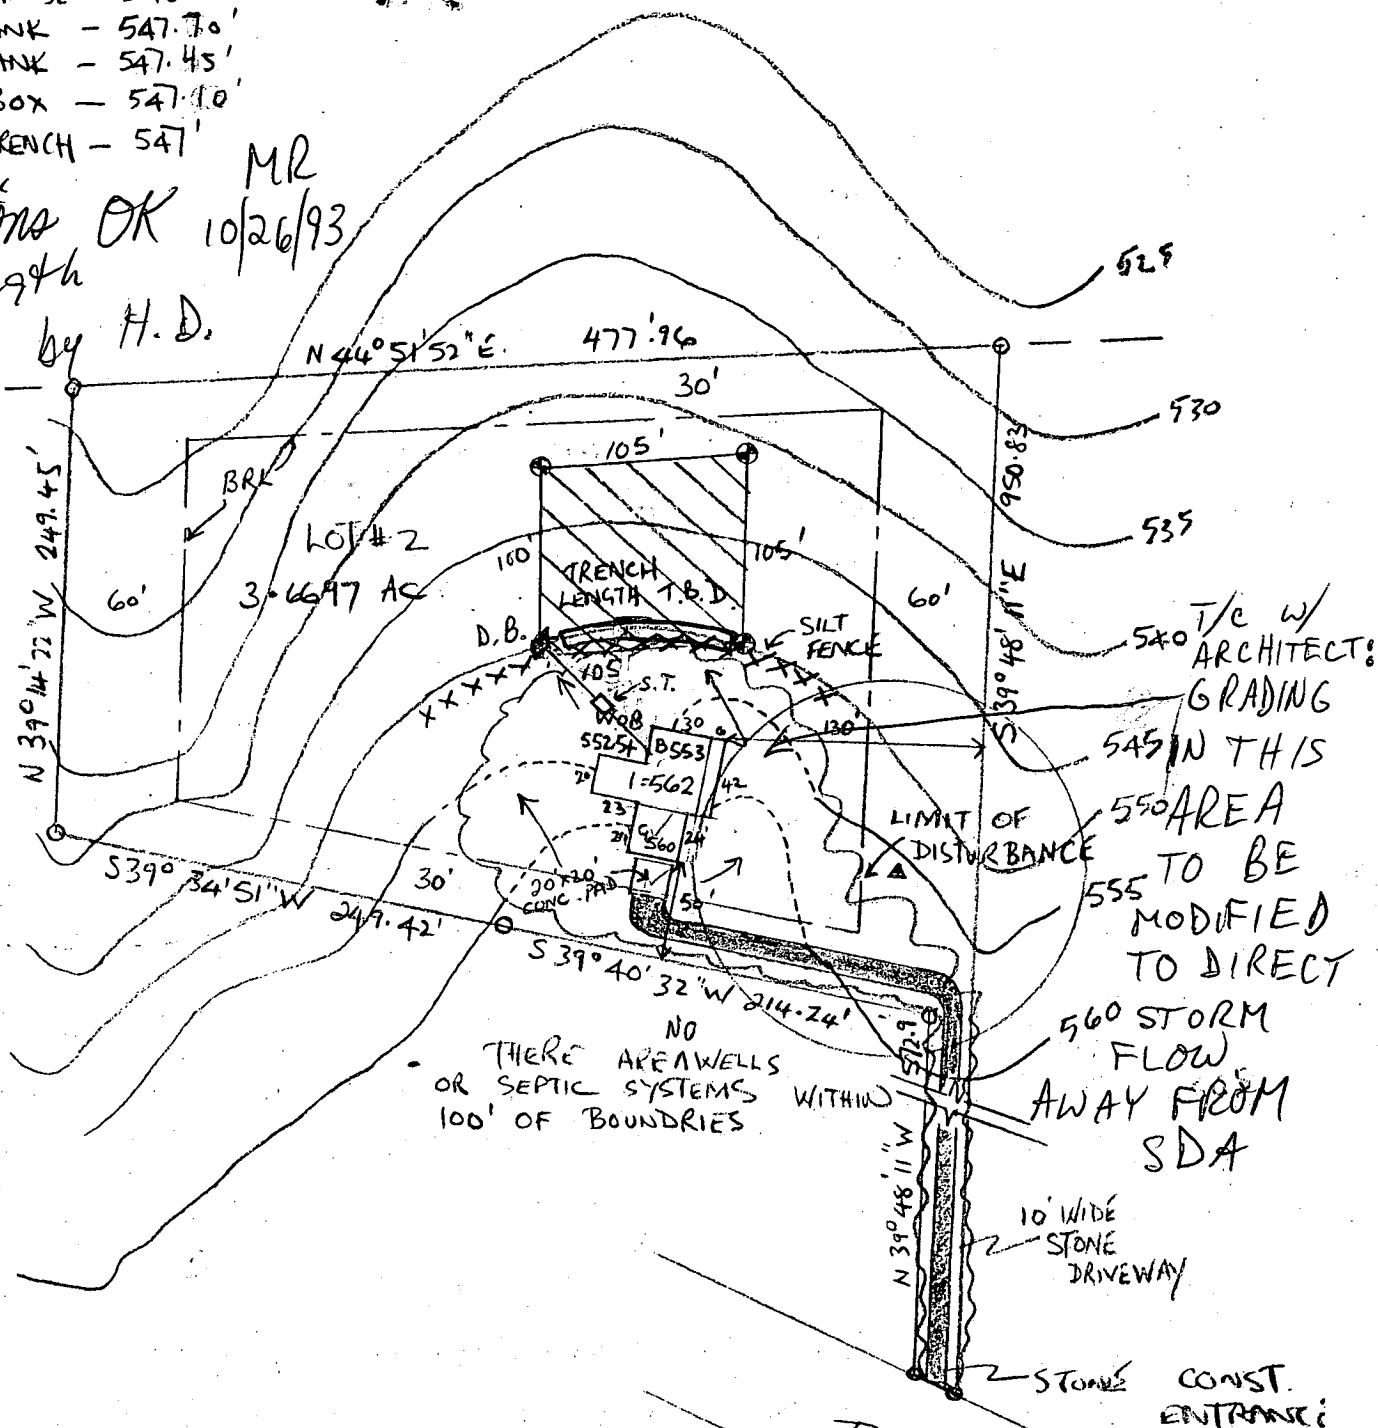

SCALE 1" = 100'

GOANS RESIDENCE

12720 TRIADELPHIA RD
~~CUMMINGS~~ ELLCOTT CITY
 MD. 21042

LOT # 2,
SUBDIVISION OF
KISER PRO

REVISED PARCEL 1
TAX MAP 22 BLOCK 5.

2ND DISTRICT

APPLICATION

PERCOLATION TESTING

HOWARD COUNTY HEALTH DEPARTMENT
BUREAU OF ENVIRONMENTAL HEALTH
3525-H ELLICOTT MILLS DRIVE/ELLICOTT CITY, MARYLAND 21043
TELEPHONE: 313-2640

DISTRICT 3 RD.
DATE 15 JULY 92

TO: THE COUNTY HEALTH OFFICER
ELLICOTT CITY, MARYLAND

I HEREBY APPLY FOR THE NECESSARY TEST PRIOR TO APPLICATION FOR PERMIT TO CONSTRUCT (OR RECONSTRUCT) A SEWAGE DISPOSAL SYSTEM.

PROPERTY OWNER TYREE D. & BETTY JO KISER

ADDRESS 12710 TRIADELPHIA ROAD PHONE 410 531-2906

AGENT OR PROSPECTIVE BUYER _____

ADDRESS _____ PHONE _____

PROPERTY LOCATION:

SUBDIVISION SYCAMORE SPRINGS AREA LOT NO. ORIGINALLY WAS 1990

ROAD AND DESCRIPTION 12710 TRIADELPHIA ROAD - ROLLING ACRES / NON WOODED
LIBER 579 / FOLIO 407

TAX MAP 22 Block 5 PARCEL # REVISED PARCEL 1 (NEW DESCRIPTION)

SIZE OF LOT 3.6697 ACRES TYPE BLDG. SINGLE FAMILY DWELLING
(SINGLE FAMILY DWELLING OR COMMERCIAL)

THE SYSTEM INSTALLED UNDER THIS APPLICATION IS ACCEPTABLE ONLY UNTIL PUBLIC FACILITIES BECOME AVAILABLE. I FULLY UNDERSTAND THE
FEE CONNECTED WITH THE FILING OF THIS PERC TEST APPLICATION IS NON-REFUNDABLE UNDER ANY CIRCUMSTANCES. I ALSO AGREE TO
COMPLY WITH ALL M.O.S.H.A. REQUIREMENTS IN TESTING THIS LOT.

Tyree D. Kiser
(SIGNATURE OF APPLICANT)

APPROVED BY _____ FOR _____ DATE _____

DISAPPROVED BY _____ FOR _____ DATE _____

HOLD PENDING FURTHER TESTS Hold for Perk Plat Review.

BLDG. PERMIT SIGNED

AND RETURNED 10/26/93

REASONS FOR REJECTION OR HOLDING _____

Sub # 5792

SFD-3 Bmw

PERCOLATION TEST PLAT/PRELIMINARY PLAT - TITLE OR I.D. # _____ DATE _____

SITE DEVELOPMENT PLAN/FINAL PLAT - TITLE OR I.D. # _____ DATE _____

THIS IS NOT A PERMIT

A 48353

COUNTY #

Hole A SOIL PROFILE

0' Topsoil
Red-orange
CL-HL

2' 1/2' yel. Red. HL-CL
E yel streaks

3' V. mica
tan - yel. brn
2 bad brn
mica pebbles
inlt Mica loam

15' V. mica
Mica pebbles

Hole C

8" 0.5 yel. brn
brown

2' 1/2' lt. yel. Red-brn
loam - h. loam

5' yel. / lt. red
iron mottled
C3D SL
Transition

Mix tan +
lt. red
becomes all tan
lt SL


14 1/2' Hole D

8" Brown loam

2' light yel. Red
HL - Red brn

3' yel. - yel. Red
mica loam

Tan (E mottled)
lt. mica loam
(FSI Texture)

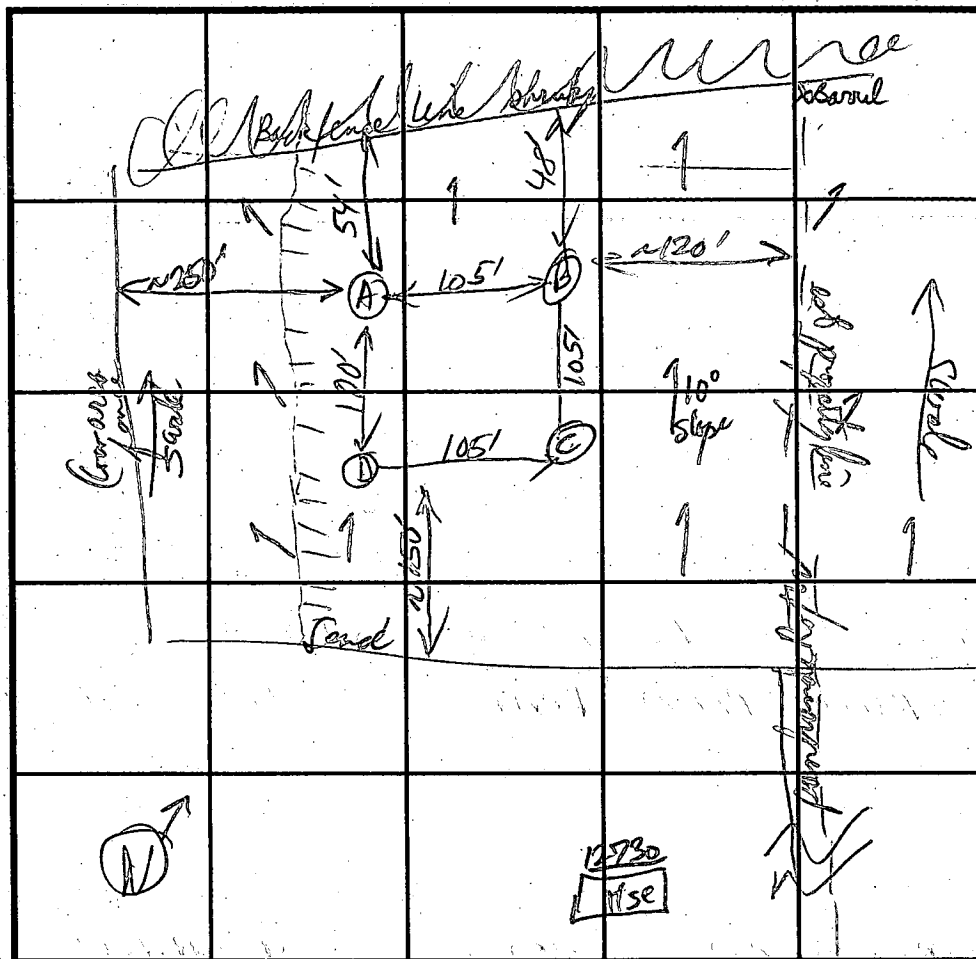

SOIL PROFILE

0' Red Brn
70 Red yel
loam - h. L

2 1/2' gray to lt. brn
SL v. mica
str. separate
disseminated
v. foliated
but overall
v. sandy, to
SL L-mud

14 1/2' depth
Hsc
12710

DATE	TEST NO.	DEPTH	PRE-WET		TEST - 1" DROP		TIME
			START	STOP	START	STOP	
6/4/92	A	@ 3 1/2'	10:17:34	10:18:50	10:18:50	10:20:50	2 min
		@ 7 1/2'	10:26:00	10:38:12	10:38:12	10:40:12	2 min
	B	@ 3'	9:53:40	9:54:56	9:54:56	10:00:58	
		@ 3'	9:43:12	9:43:41	9:43:41	9:44:29	
		14 1/2'	10:00:13	10:02:25	10:02:25	10:04:30	2 min
	C	@ 4'	9:50:50	10:02:25	10:02:25	10:04:30	2 min
		14 1/2'	10:05:57	10:07:35	10:07:35	10:10:34	3 min
	D	@ 4'	10:05:57	10:07:35	10:07:35	10:10:34	3 min
		14 1/2'					

REMARKS Great soils uniform from 3'-15' in all 4 holes -

TYPE OF SOIL Chester (ChD + ChC3)

TESTED BY RP

ALSO PRESENT

Jed York & Kevin

TRENCH DESIGN DATA: AVERAGE PERCOLATION TIME 2 min


TRENCH WIDTH 2

INLET DEPTH 3'

MAXIMUM BOTTOM DEPTH 10'

SQ. FT./BEDROOM 180'

G. RINK
477/677

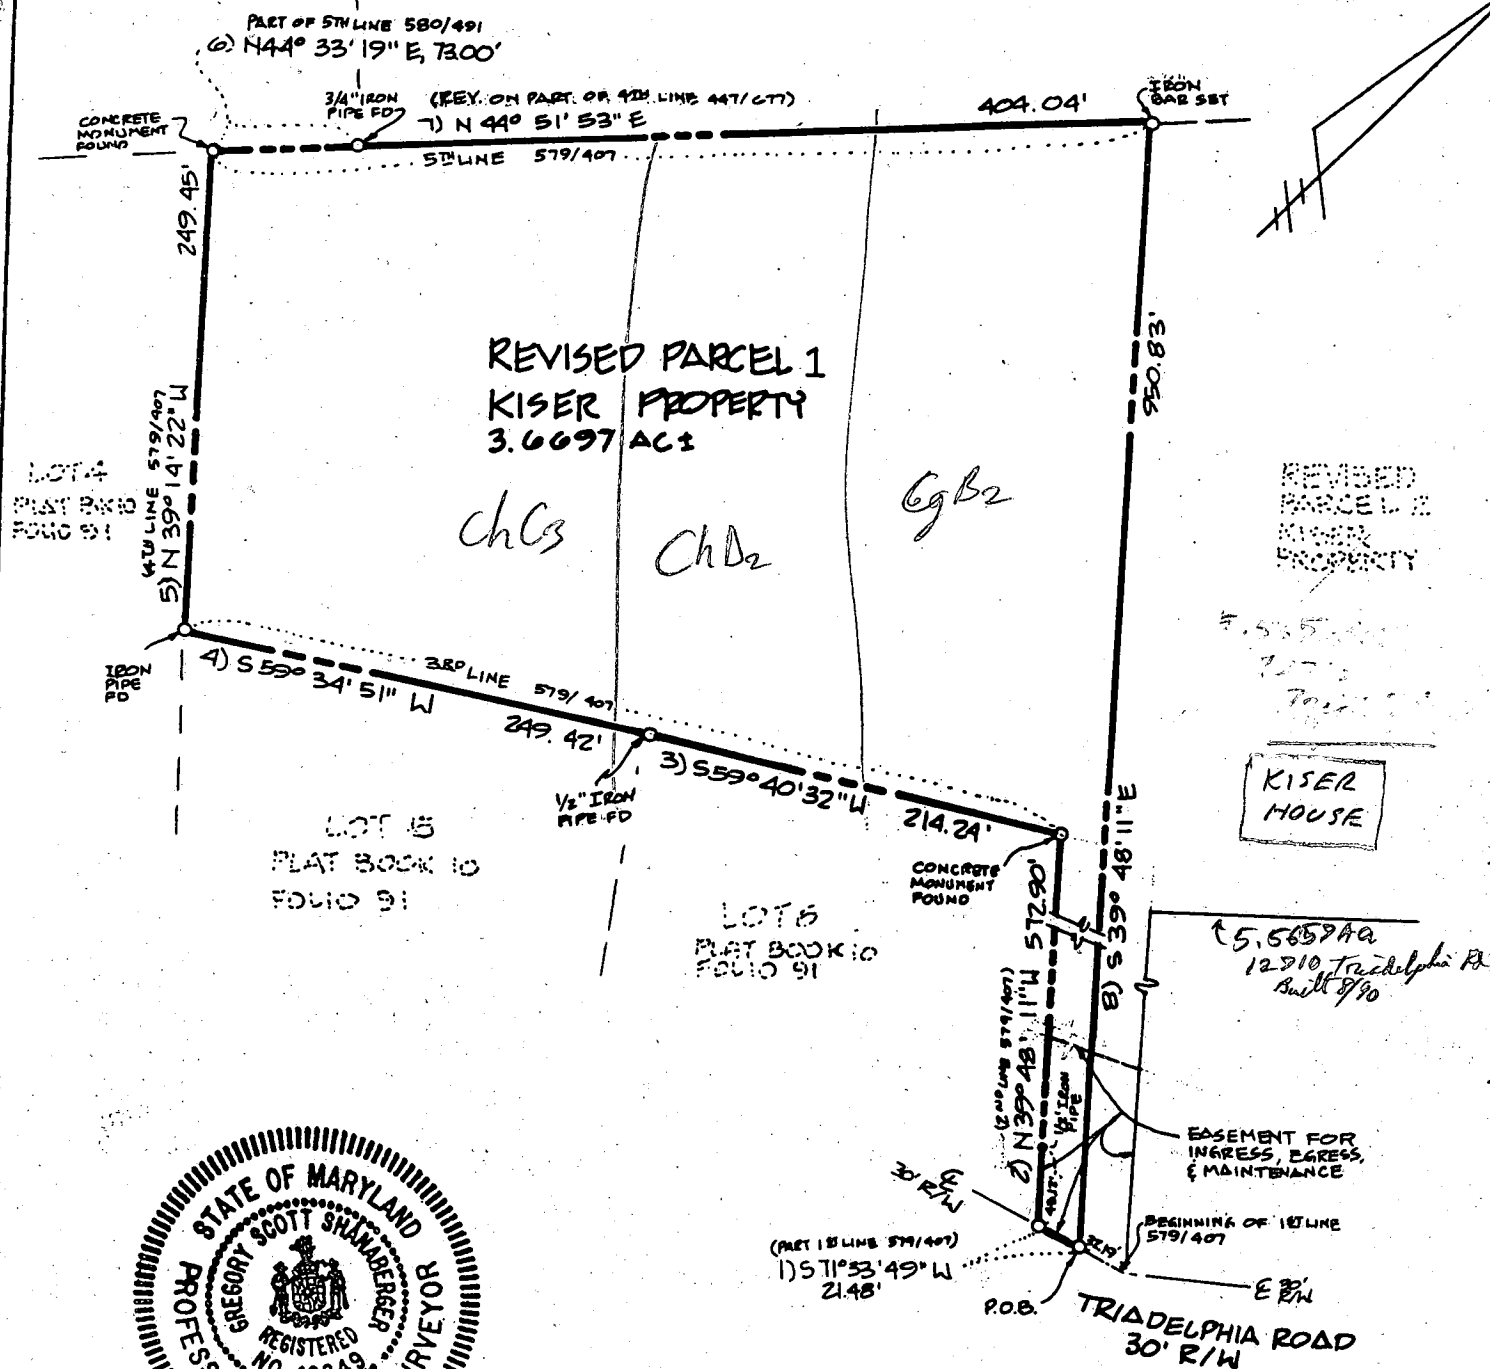

SHANABERGER & LANE

8726 TOWN & COUNTRY BLVD.
SUITES 106 & 107
ELLCOTT CITY, MD. 21043
461-9563


PLAT TO ACCOMPANY DESCRIPTION
OF
REVISED PARCEL 1, KISER
PROPERTY

DEED REFERENCE: 579/407
COUNTY: HOWARD
ELECTION DISTRICT: 3~~RD~~
SCALE: 1"=100' DATE: 06/15/90

TM 22 p199
and adjacent TM 22 p157

RC HOLES

HOUSE ROSEMARY LN. APPROX. WELL LOCATION

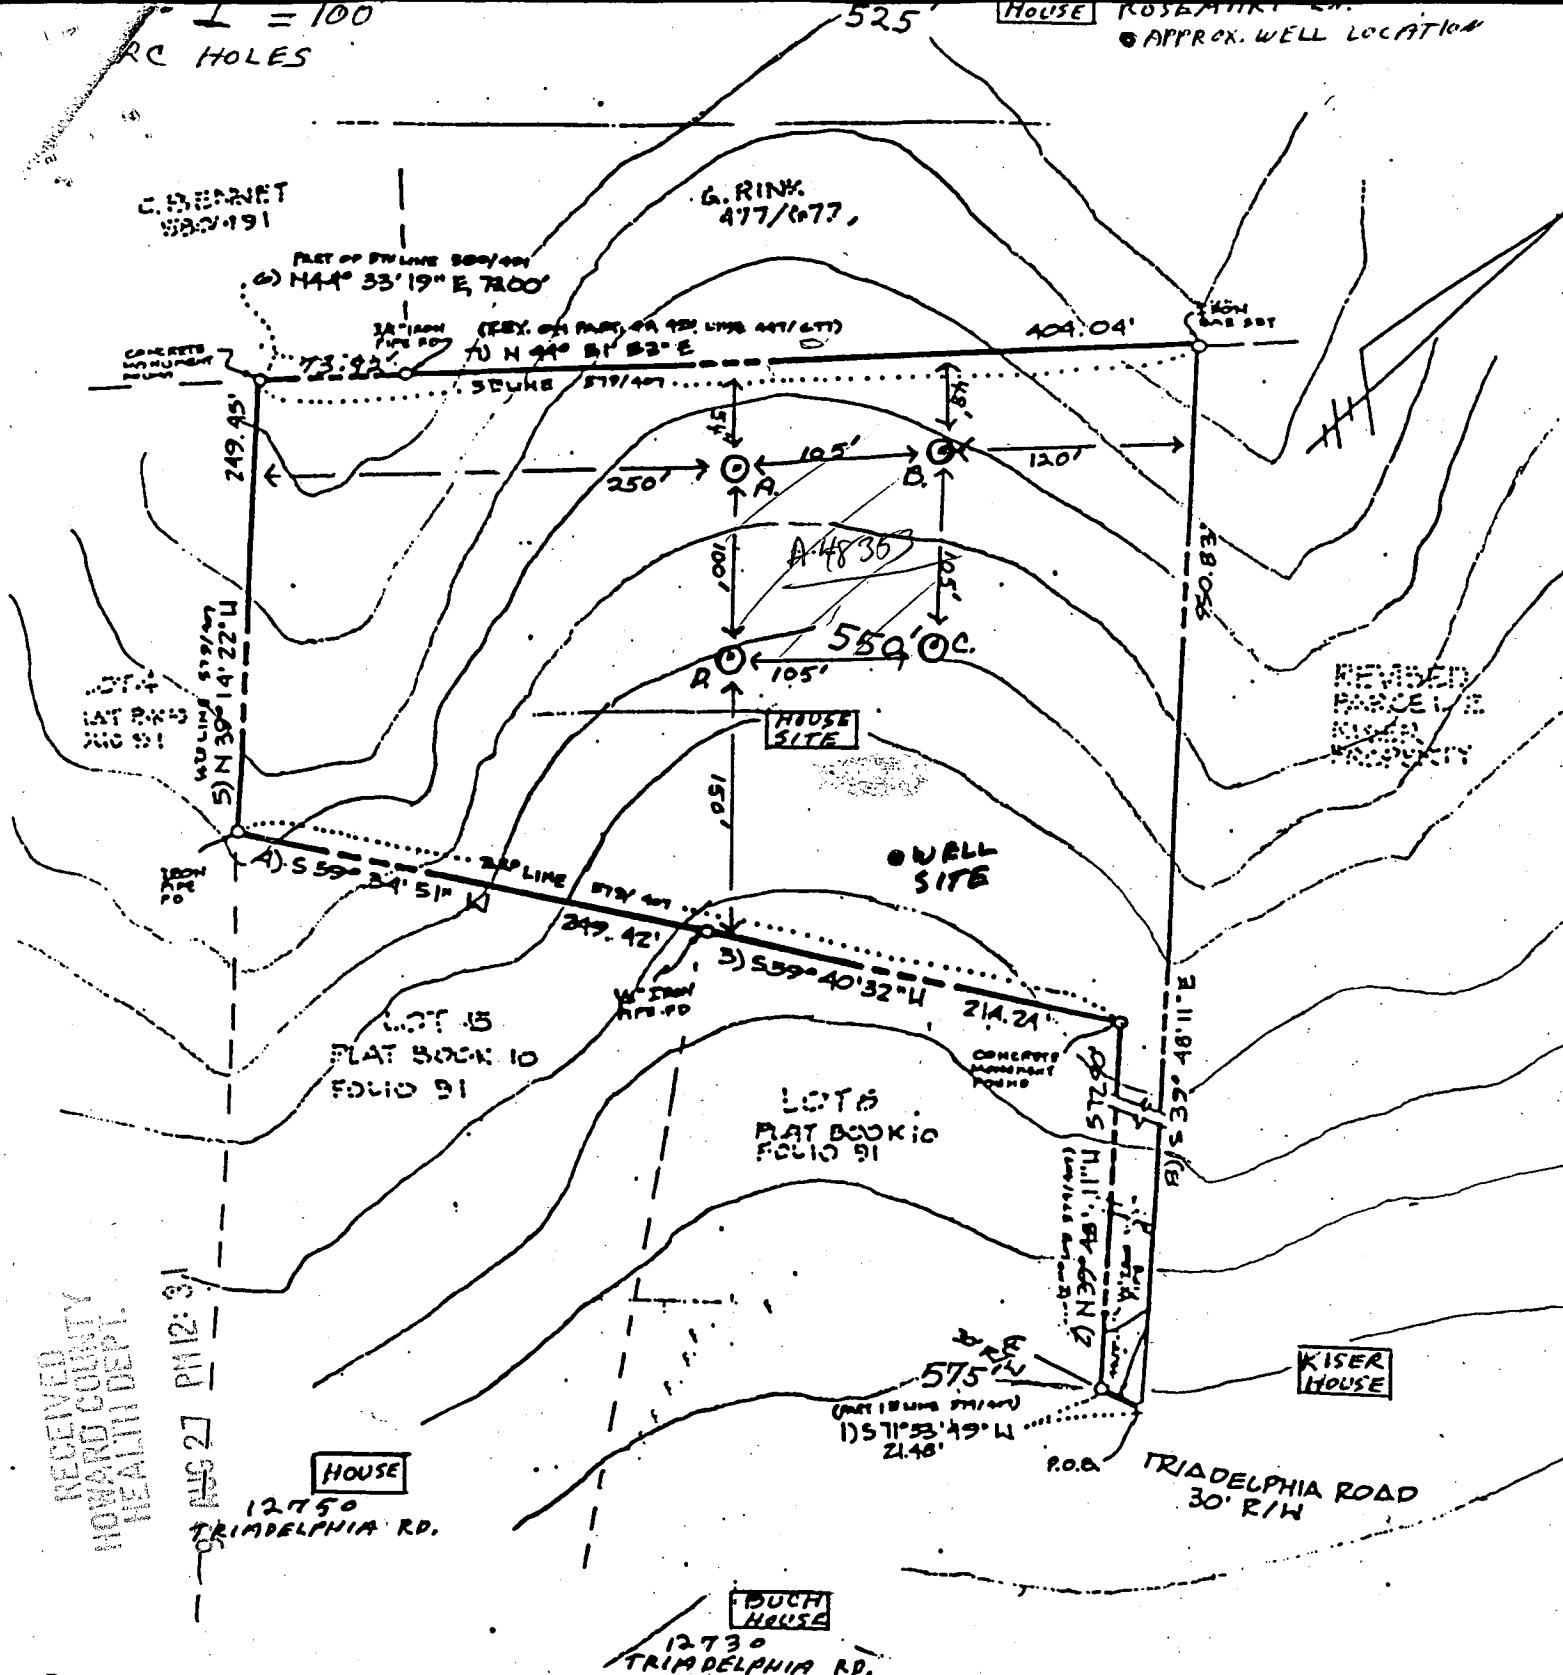


PERCOLATION CERTIFICATION PLAT
APPLICATION # A48353
PROPOSED USE: RECORDED LOT
PROPERTY ID: KISER PROPERTY
REVISED PARCEL 1
TAX MAP 22 - BLOCK 5
(originally lot 199 D)

There are no wells or septic systems
within 100' of boundaries.
I agree D. Kiser

Joyce M. Boyd M.D. p.c. J.C.
APPROVED (EW) 8/27/92
Howard County Health Officer

G.H. RIAR A10937
3385 ROSEMARY LANE

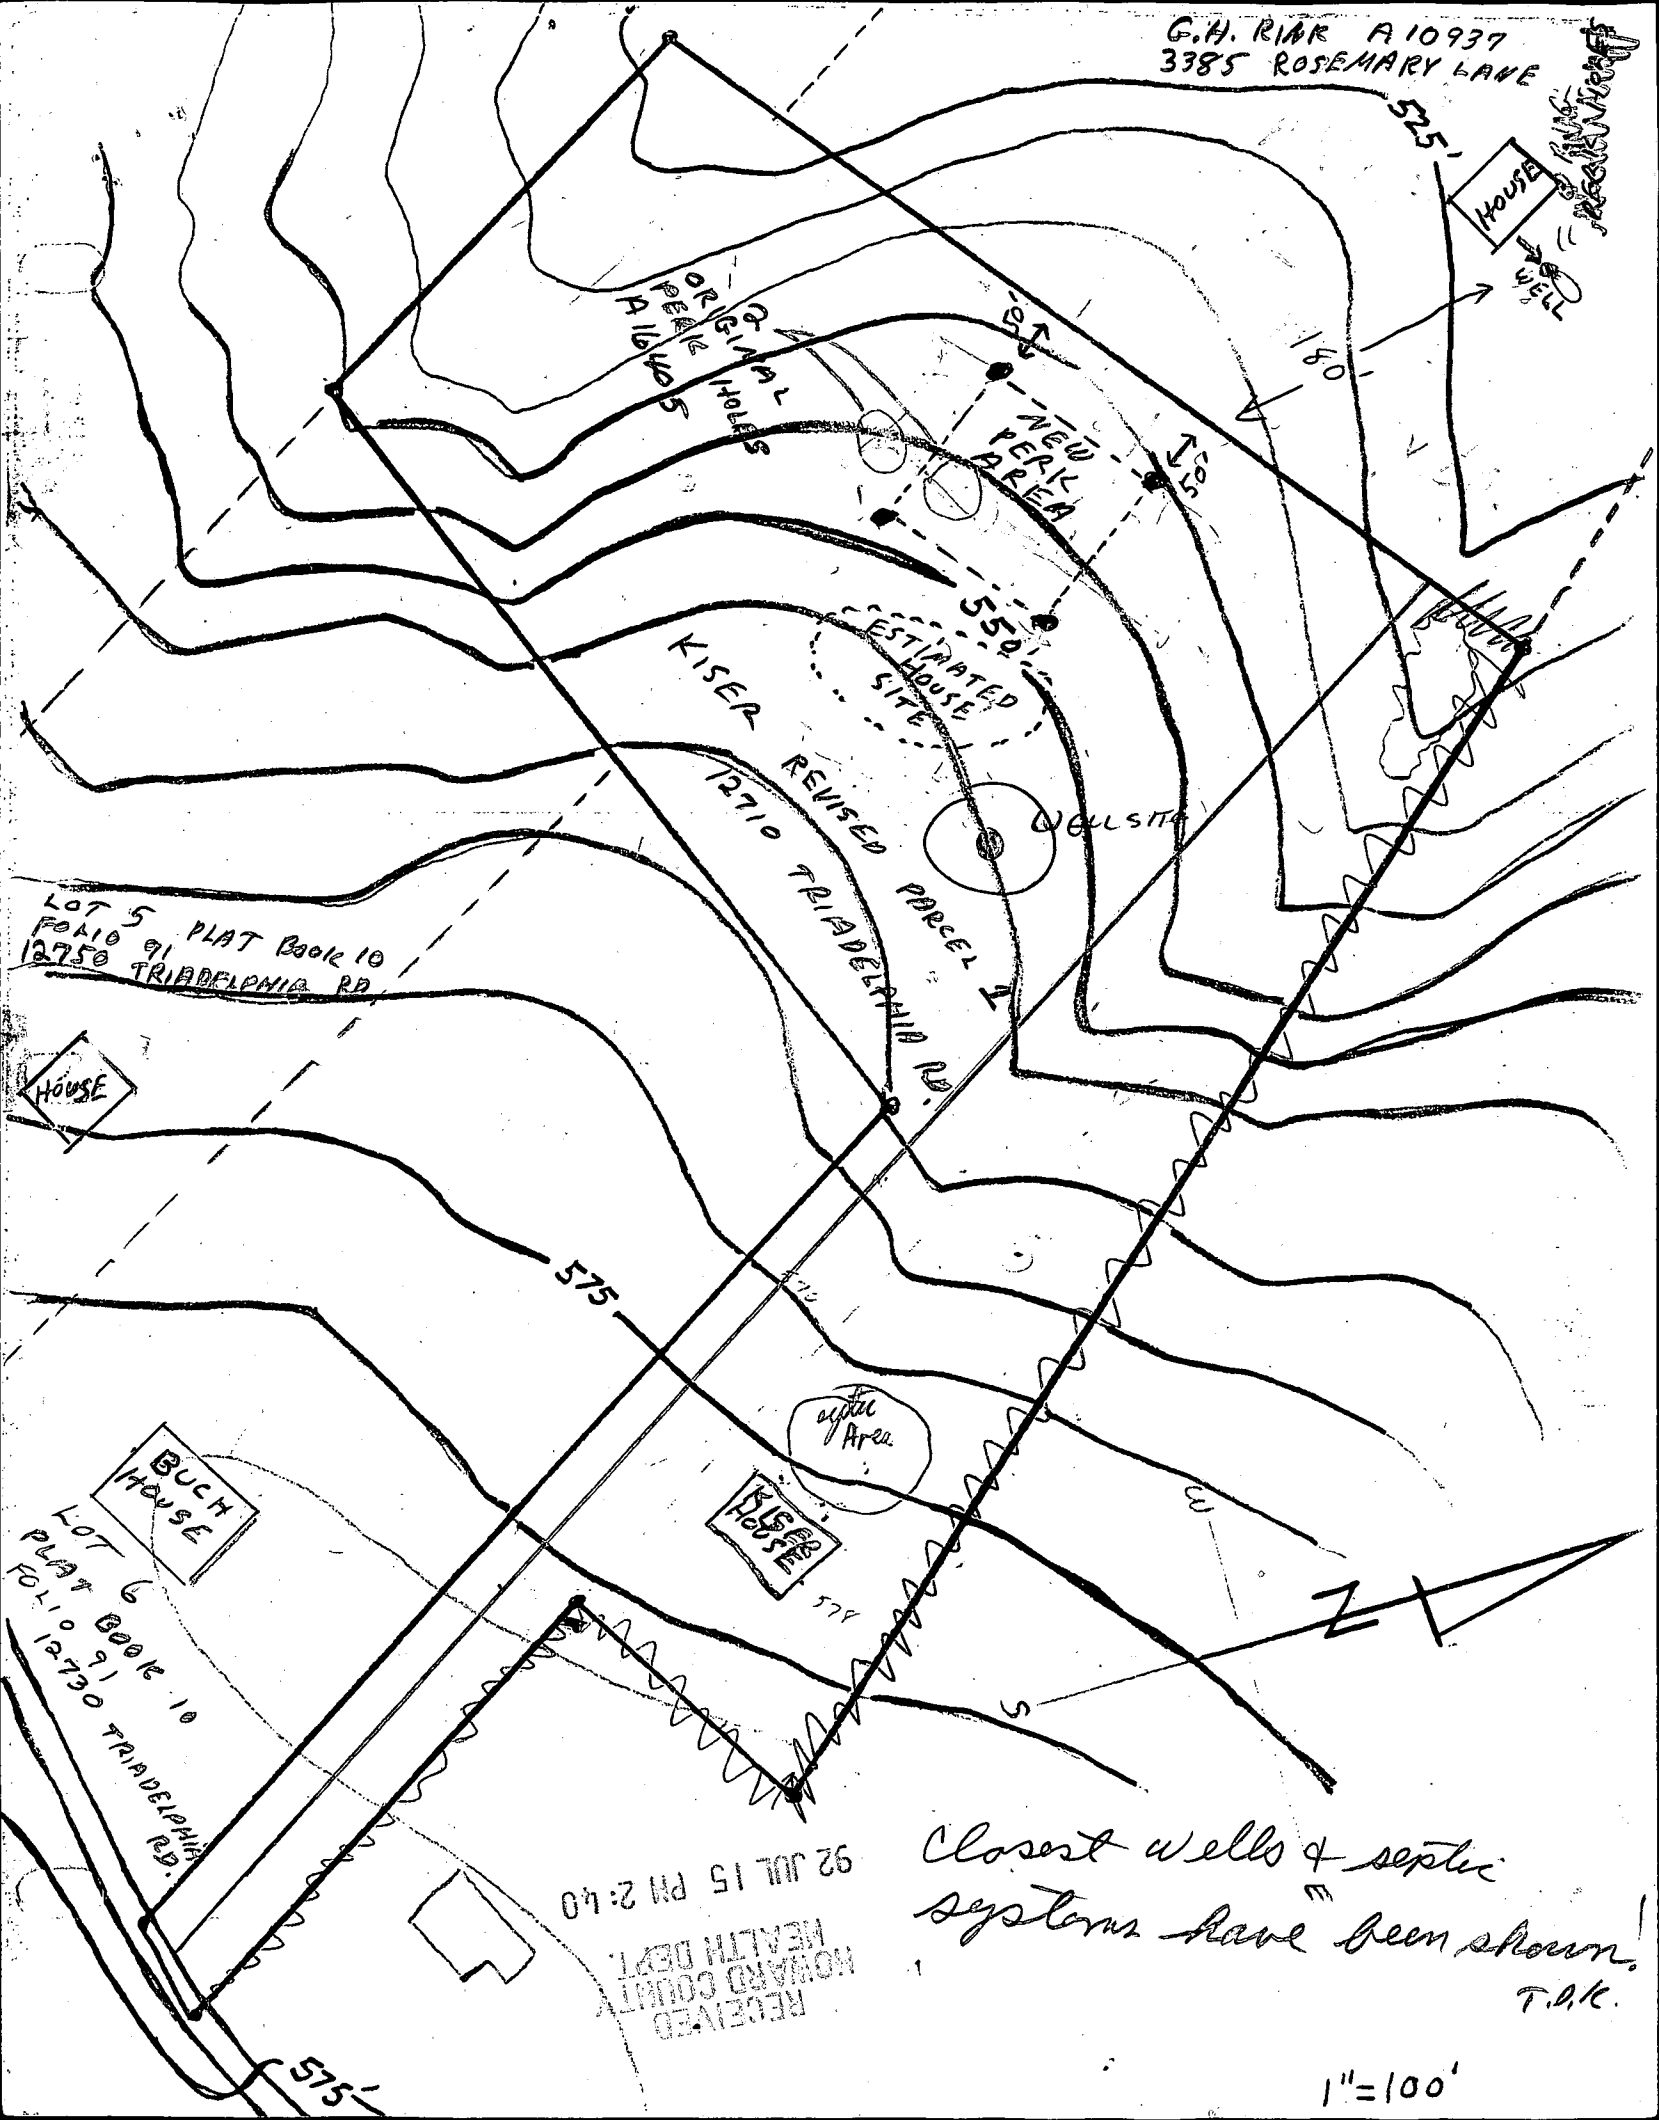


Closest wells & septic systems have been shown!
T.O.K.

1"=100'

⊙ = PERC HOLES

● APPROX. WELL LOCATION

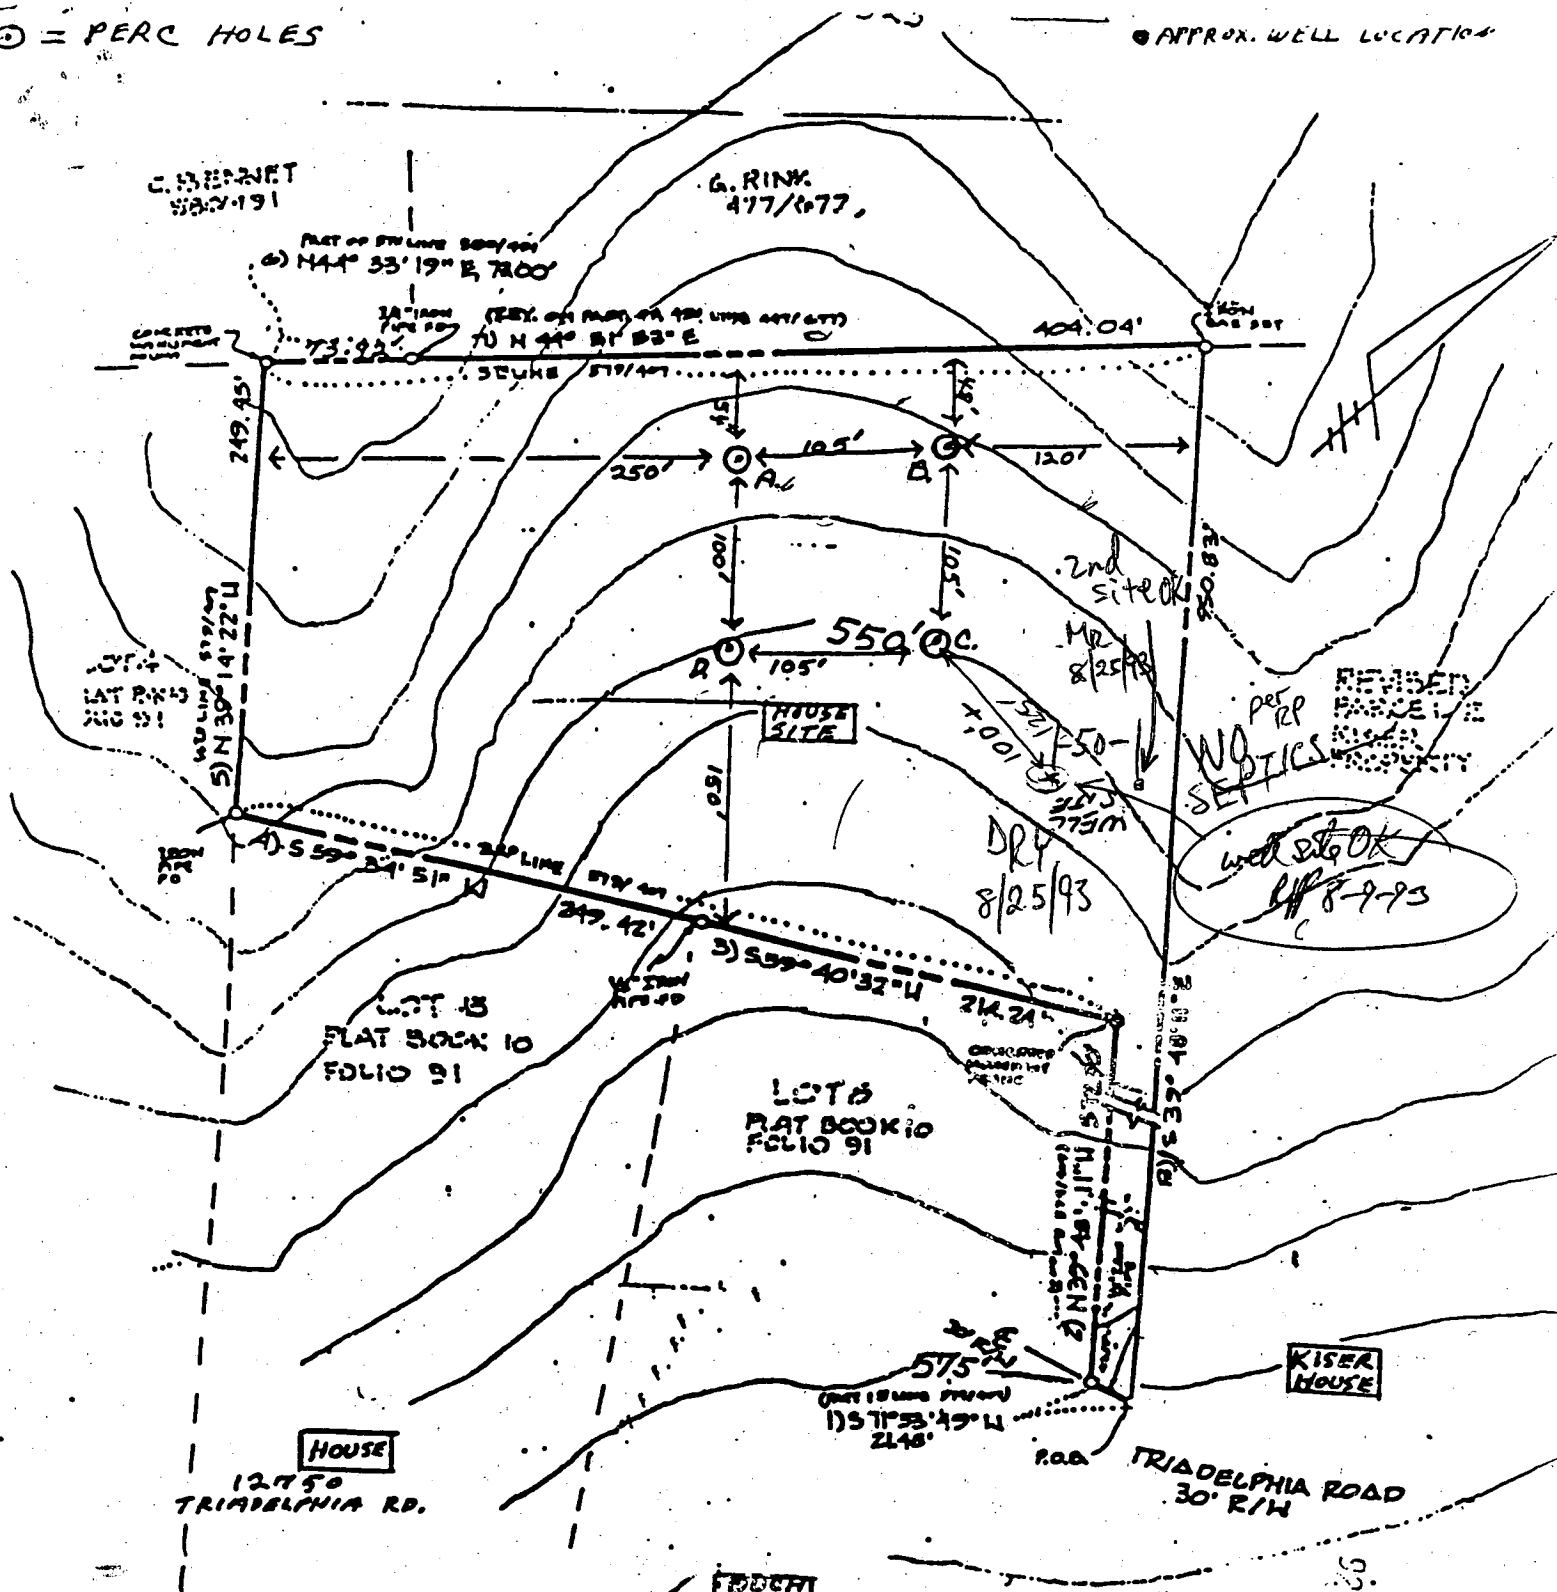

PERCOLATION CERTIFICATION PLAT
APPLICATION # A48353
PROPOSED USE: RECORDED LOT
PROPERTY ID: KISER PROPERTY
REVISED PARCEL 1
TAX MAP 22 - BLOCK 5
(originally lot 199 D)

There are no wells or septic systems
within 100' of boundaries.

Lyree L. Kiser

Joyce M. Boyd M.P. per T.C.
APPROVED (EW) 2/27/92
HOWARD COUNTY HEALTH OFFICER

C1 0478 SEQUENCE NO. (DENV USE ONLY)
(THIS NUMBER IS TO BE PUNCHED IN COLS. 3-6 ON ALL CARDS)

STATE OF MARYLAND
WELL COMPLETION REPORT
FILL IN THIS FORM COMPLETELY
PLEASE PRINT OR TYPE

THIS REPORT MUST BE SUBMITTED WITHIN
45 DAYS AFTER WELL IS COMPLETED.

COUNTY
NUMBER

A48353

ST/CO USE ONLY
DATE Received

DATE WELL COMPLETED

Depth of Well

PERMIT NO.
FROM "PERMIT TO DRILL WELL"

8 13

082793

22 170 26
(TO NEAREST FOOT)

28 29 30 31 32 33 34 35 36 37
H0-92-0424

OWNER Coons last name Kin first name
STREET OR RFD Triadelphia Rd. TOWN Glendora
SUBDIVISION River Property SECTION 1 LOT 1

WELL LOG

Not required for driven wells

STATE THE KIND OF FORMATIONS
PENETRATED, THEIR COLOR, DEPTH,
THICKNESS AND IF WATER BEARING

DESCRIPTION (Use additional sheets if needed) FEET Check if water bearing
FROM TO

Top Soil	0	2	
Sandy	2	30	✓
SAND STONE	30	35	
MICKA	35	50	
Sand Stone	50	55	✓
MICKA	55	120	

GROUTING RECORD

WELL HAS BEEN GROUTED (Circle Appropriate Box) YES ☒ NO ☐

TYPE OF GROUTING MATERIAL

CEMENT ☒ BENTONITE CLAY ☒

NO. OF BAGS 10 NO. OF POUNDS 100

GALLONS OF WATER 60

DEPTH OF GROUT SEAL (to nearest foot)
from 0 ft. to 32 ft.
(enter 0 if from surface)

CASING RECORD
casing types insert appropriate code below
ST CO
STEEL CONCRETE
PL OT
PLASTIC OTHER

MAIN CASING TYPE Nominal diameter top (main) casing (nearest inch) Total depth of main casing (nearest foot)
PL 6 40

OTHER CASING (if used) diameter depth (feet) from to
inch

SCREEN RECORD
screen type or open hole insert appropriate code below
ST BR HO
STEEL BRASS OPEN HOLE
PL OT
PLASTIC OTHER

DEPTH (nearest ft.)
1 H0 38 120
2
3
EACH SCREEN

SLOT SIZE 1 2 3
DIAMETER OF SCREEN (NEAREST INCH)
56 60

GRAVEL PACK
IF WELL DRILLED WAS FLOWING WELL INSERT F-IN BOX 68

OEP USE ONLY (NOT TO BE FILLED IN BY DRILLER)
T (E.R.O.S.) W Q
70 72 74 75 76

TELESCOPE CASING LOG INDICATOR OTHER DATA

C 3

PUMPING TEST

HOURS PUMPED (nearest hour) 3

PUMPING RATE (gal. per min. to nearest gal.) 10

METHOD USED TO MEASURE PUMPING RATE Bucket

WATER LEVEL (distance from land surface)

BEFORE PUMPING 29

WHEN PUMPING 32

TYPE OF PUMP USED (for test)

A air P piston T turbine

C centrifugal R rotary O other (describe below)

J jet S submersible

PUMP INSTALLED

DRILLER WILL INSTALL PUMP YES NO

IF DRILLER INSTALLS PUMP, THIS SECTION MUST BE COMPLETED FOR ALL WELLS EXCEPT HOME USE

TYPE OF PUMP INSTALLED PLACE (A,C,J,P,R,S,T,O) IN BOX - SEE ABOVE:

CAPACITY: GALLONS PER MINUTE (to nearest gallon)

PUMP HORSE POWER

PUMP COLUMN LENGTH (nearest ft.)

CASING HEIGHT (circle appropriate box and enter casing height)

LAND SURFACE (nearest foot)

LOCATION OF WELL ON LOT

SHOW PERMANENT STRUCTURE SUCH AS BUILDING, SEPTIC TANKS, AND/OR LANDMARKS AND INDICATE NOT LESS THAN TWO DISTANCES (MEASUREMENTS TO WELL)

225' DRYS HOLE

WELL

Prop Line

Approx 80'

Approx 80'

Prop Line

CIRCLE APPROPRIATE LETTER
A A WELL WAS ABANDONED AND SEALED WHEN THIS WELL WAS COMPLETED

E ELECTRIC LOG OBTAINED

P TEST WELL CONVERTED TO PRODUCTION WELL

I HEREBY CERTIFY THAT THIS WELL HAS BEEN CONSTRUCTED IN ACCORDANCE WITH COMAR 26.04.04 "WELL CONSTRUCTION" AND IN CONFORMANCE WITH ALL CONDITIONS STATED IN THE ABOVE CAPTIONED PERMIT, AND THAT THE INFORMATION PRESENTED HEREIN IS ACCURATE AND COMPLETE TO THE BEST OF MY KNOWLEDGE.

DRILLERS IDENT. NO. 116

DRILLERS SIGNATURE Nash Mays

(MUST MATCH SIGNATURE ON APPLICATION)

SITE SUPERVISOR (sign. of driller or journeyman responsible for sitework if different from permittee)

COUNTY

DEPARTMENT OF INSPECTIONS, LICENSES AND PERMITS
3430 COURT HOUSE DRIVE
ELLICOTT CITY, MD 21043
PERMITS (410)313-2455 INSPECTIONS (410)313-1810
AUTOMATED INFORMATION (410) 313-3800

HOWARD COUNTY PERMIT APPLICATION

PERMIT NUMBER

300125396

Building Address 12720 Tawadelphe Road
Ellieville City MD 21042
Suite/Apt. #: _____ SDP/WP/Petition #: _____
Census Tract 6030 Subdivision Kiger
Section _____ Area _____ Lot 1
Tax Map 22 Parcel 199 Grid 5
Zoning PK Map Coordinates 10C8 Lot size _____

Property Owner's Name GOANS, KIP and Jera
Address 12720 Tawadelphe Road
City Ellieville City State MD Zip Code 21042
Home Phone 410-531-1344 Work Phone N/A
Applicant's Name & Mailing Address, (if other than stated hereon): _____

Existing Use Single Family Home
Proposed Use SF 15x12 Deck w/Steps
Estimated Construction Cost \$ 3000
Description of Work install 8x8, 15x12 Deck w/Steps

Contractor Company Matjesdew Inc
Contact Person Tom Roscavage
Address 12755 Tawadelphe RD
City Ellieville City State MD Zip Code 21042
License No. 10728
Phone 410-988-9792 Fax N/A

Occupant or Tenant Owner
Contact Name _____
Address _____
City _____ State _____ Zip Code _____
Phone _____ Fax _____

Engineer or Architect Company Contractor
Contact Person _____
Address _____
City _____ State _____ Zip Code _____
Phone _____ Fax _____

BUILDING DESCRIPTION - COMMERCIAL

Building Characteristics	Utilities
Height: _____	Water Supply: _____ Public _____ Private _____
No. of stories: _____	Sewage Disposal: _____ Public _____ Private _____
Gross area, sq. ft. per floor: _____	Electric Yes ☐ No ☐ Gas Yes ☐ No ☐
Use group: _____	Heating System: _____ Electric ☐ Oil ☐ Natural Gas ☐ Propane Gas ☐
Construction type: _____ Reinforced Concrete _____ Structural Steel _____ Masonry _____ Wood Frame _____ State Certified Modular _____	Sprinkler system: N/A ☐ Full _____ Partial _____ Other Suppression _____ # of Heads _____

BUILDING DESCRIPTION - RESIDENTIAL

Building Characteristics	Utilities
SF Dwelling ☒ SF Townhouse ☐ Depth _____ Width _____	Water Supply: _____ Public _____ Private ☒
1st floor: _____	Sewage Disposal: _____ Public _____ Private ☒
2nd floor: _____	Electric Yes ☒ No ☐ Gas Yes ☐ No ☒
Basement: _____	Heating System: _____ Electric ☒ Oil ☐ Natural Gas ☐ Propane Gas ☐
Finished Basement ☐ Unfinished Basement ☒ Crawl space ☐ Slab on Grade ☐ No. of Bedrooms _____	Sprinkler system: N/A ☐ NFA #13D _____ NFA #13R _____ Other: _____
Multi-family dwellings: No. of efficiency units: _____ No. of 1 BR units: _____ No. of 2 BR units: _____ No. of 3 BR units: _____	
Other Structure: _____ Dimensions: _____ Footings: _____ Roof: _____	
State Certified Modular _____ Manufactured Home _____	

THE UNDERSIGNED HEREBY CERTIFIES AND AGREES AS FOLLOWS: (1) THAT HE/SHE IS AUTHORIZED TO MAKE THIS APPLICATION; (2) THAT THE INFORMATION IS CORRECT; (3) THAT HE/SHE WILL COMPLY WITH ALL REGULATIONS OF HOWARD COUNTY WHICH ARE APPLICABLE THERETO; (4) THAT HE/SHE WILL PERFORM NO WORK ON THE ABOVE REFERENCED PROPERTY NOT SPECIFICALLY DESCRIBED IN THIS APPLICATION; (5) THAT HE/SHE GRANTS COUNTY OFFICIALS THE RIGHT TO ENTER ONTO THIS PROPERTY FOR THE PURPOSE OF INSPECTING THE WORK PERMITTED AND POSTING NOTICES.

Applicant's Signature

Title/Company

Print Name

Date

Checks payable to: DIRECTOR OF FINANCE OF HOWARD COUNTY

** PLEASE WRITE NEATLY AND LEGIBLY. **

- FOR OFFICE USE ONLY -

AGENCY	DATE	SIGNATURE APPROVAL
Land Development, DPZ		
State Highways		
Building Official		
Dev. Engineering, DPZ		
Health		
Fire Protection		

Is Sediment Control approval required prior to issuance?
YES ☐ NO ☐

CONTINGENCY CONSTRUCTION START: ☐
ONE STOP SHOP: ☐

DPZ SETBACK INFORMATION
Front: _____
Rear: _____
Side: _____
Side St.: _____
All minimum setbacks met? YES ☐ NO ☐
Is Entrance Permit required? YES ☐ NO ☐
Historic District? YES ☐ NO ☐
Lot Coverage for NewTown Zone _____
SDP/Red-line approval date _____

PROPERTY ID# 20871
Filing fee \$ _____
Permit fee \$ _____
Excise tax \$ _____
Sub-total paid \$ _____
Add'l permit fee \$ _____
TOTAL FEES \$ 1035
Balance due \$ _____
Check # 51771
Validation # _____

Accepted by

Distribution of Copies-


White: Building Official

Green: LDD, DPZ

Yellow: DED, DPZ

Pink: Health

Gold: SHA

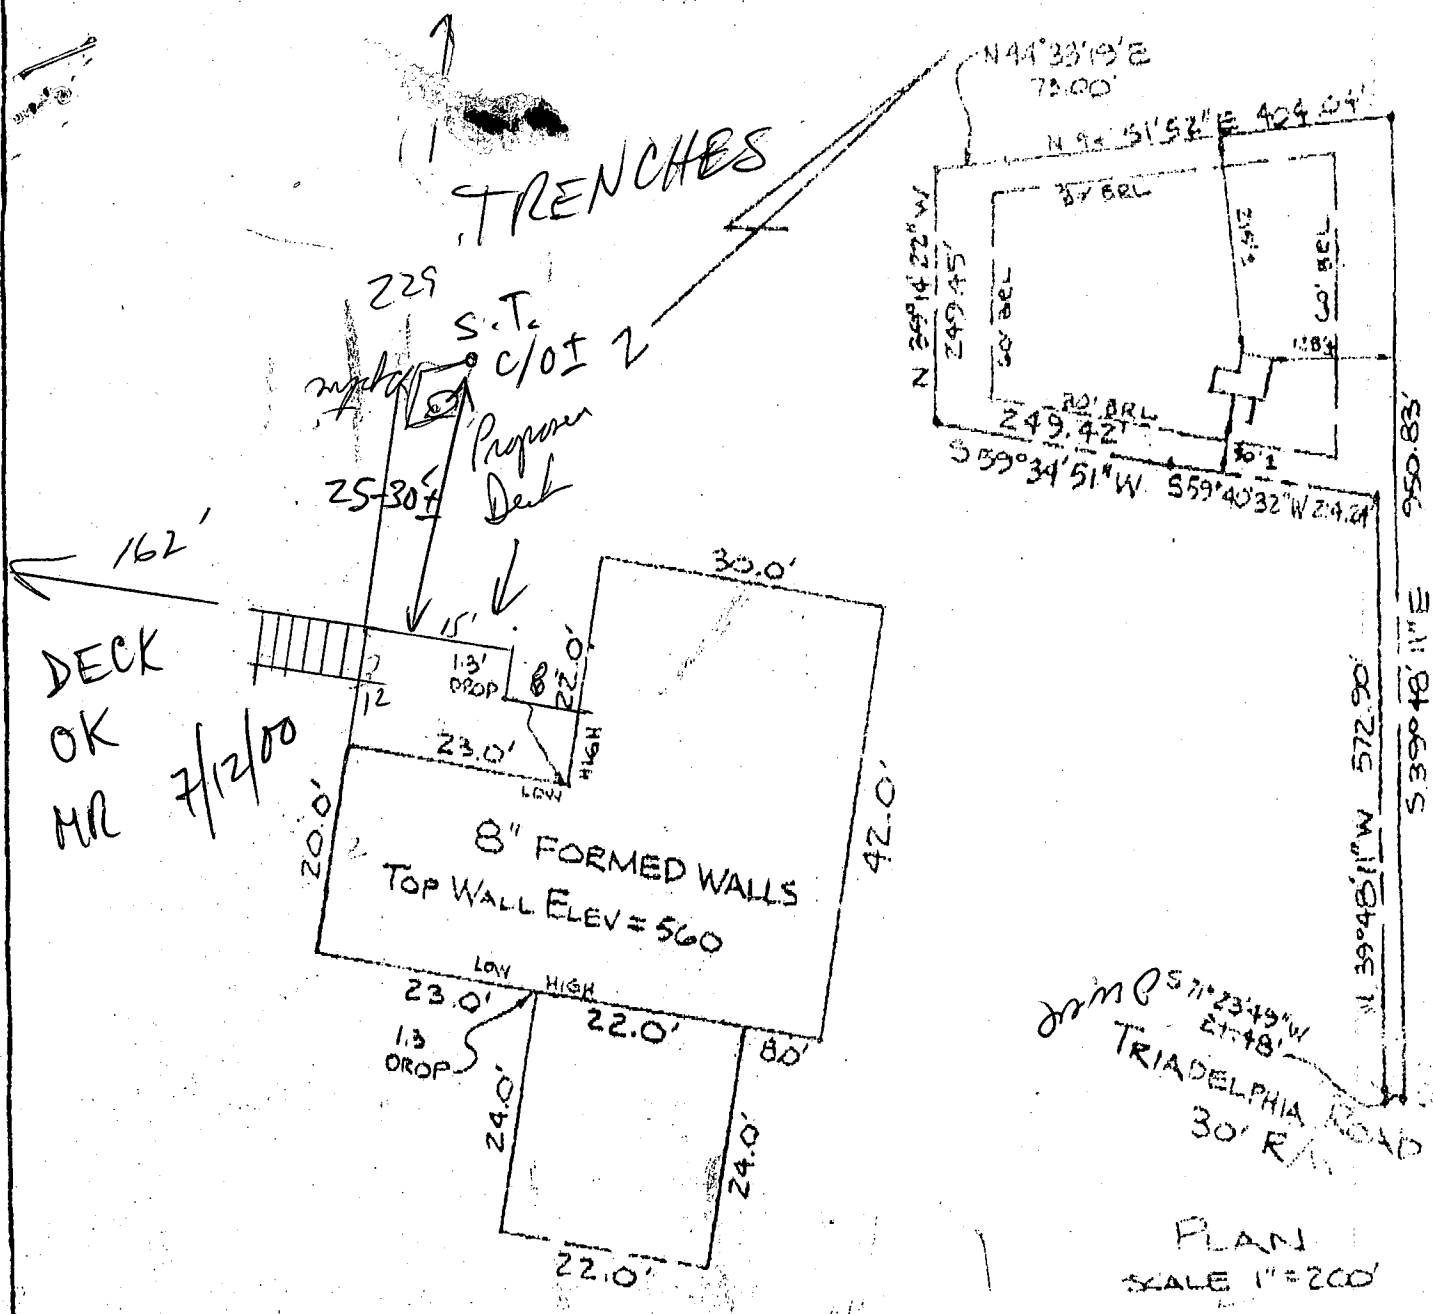

HOUSE DETAIL

SCALE 1" = 20'



FLOOD CERTIFICATION

SUBJECT PROPERTY IS SHOWN IN ZONE S-1 AS SHOWN ON THE FLOOD INSURANCE RATE MAP OF HOWARD COUNTY, PANEL 16 COMMUNITY PANEL 240044 2016B EFFECTIVE DATE DECEMBER 4, 1980

I hereby certify that a site inspection (based upon field observations and surveys as necessary) was made under my direction on 7/12/00 at 12720 TRIADELPHIA ROAD. To the best of my knowledge, information and belief, this lot has been final graded in compliance with the approved Site Development Plan or, if none, the approved Erosion and Sediment Control Plan and Grading Plan. In addition to general compliance with the applicable, this inspection was made with the following items being checked for compliance with Section 3.101, Subsection 3008.3 of the Howard County Code, as a minimum:

- a. Drainage Courses correct direction of flow; (if applicable) located within drainage easements; constructed with a positive and uniform grade; and
- b. Lot Grading positive drainage away from the structure; fine graded with no local low spots.

This plot is not intended to be used for the purpose of establishing property lines or points and was prepared without the benefit of a title report.

RECORD REFERENCES LIBER/FOLIO <u>579</u> PLAT BOOK _____ PLAT NO./FOLIO <u>407</u> SCALE <u>AS SHOWN</u> DATE <u>Nov. 18, 1993</u>	LOCATION SURVEY of <u>WALL CHECK</u> <u>12720 TRIADELPHIA ROAD</u> <u>HOWARD COUNTY, MARYLAND</u>	MARKS-VOGEL ASSOCIATES, INC. CONSULTING ENGINEERS-SURVEYORS-PLANNERS 4704 YORKSHIRE DRIVE ELLICOTT CITY, MD 21043 TELEPHONE and FAX (410) 461-5028 I HEREBY CERTIFY THAT THE IMPROVEMENTS ARE LOCATED AS SHOWN HEREON AND TO THE BEST OF MY KNOWLEDGE AND BELIEF, THERE ARE NO ENCROACHMENTS EXCEPT AS SHOWN. ERIC C. MARKS R.P.L.S. # 607
--	--	--