

# PERMIT

SEWAGE DISPOSAL SYSTEM

DEPARTMENT OF HEALTH AND MENTAL HYGIENE

HOWARD COUNTY HEALTH DEPARTMENT

BUREAU OF ENVIRONMENTAL HEALTH

~~XXXXXX~~

410-313-2640

INDEXED

P 512043

A 48737

DISTRICT

DATE

DATE SYSTEM APPROVED

INSPECTOR

WTC III Plumbing & Heating

IS PERMITTED TO INSTALL ☒ ALTER

ADDRESS 1820 Gillis Falls Road, Sykesville, Maryland 21784 PHONE 410-489-4457

SUBDIVISION W. Friendship Estates, II LOT 74 ROAD 3329 Velvet Valley Drive

PROPERTY OWNER Nantucket Homes/Dorsey, Inc.

ADDRESS

SEPTIC TANK CAPACITY 1250 GALLONS

NUMBER OF BEDROOMS 4

210 SQUARE FEET PER BEDROOM

LINEAR FEET OF TRENCH REQUIRED 280

TRENCHES - Trench to be 3 feet wide. Inlet 4.0 feet below original grade. Bottom maximum depth 6.0 feet below original grade. Effective area begins at 4.0 feet below original grade. 2.0 feet of stone below distribution pipe.

LOCATION - Begin trenches 145 feet up the right (305.21') lot line and 125 feet off that same lot line as seen when facing the lot from Velvet Valley Drive. Run trenches on contour toward the right lot line.

NOTES - No trench to exceed 100 feet in length. Provide 6" - 8" diameter cleanout and cap to grade or above on septic tank. OK/MR

PLANS APPROVED BY Amy McMillen DATE 5-19-1999

COVER NO WORK UNTIL INSPECTED AND APPROVED

NEITHER THE HOWARD COUNTY COUNCIL NOR THE HEALTH DEPARTMENT IS RESPONSIBLE FOR THE SUCCESSFUL OPERATION OF ANY SYSTEM

NOTE: CLEANOUT REQUIRED EVERY 70 FEET OF SEWER LINE AND/OR AT 90° SWEEPS IN LINES FROM HOUSE TO DRAIN FIELDS, 90° ELBOWS NOT ACCEPTABLE.

NOTE: ALL PARTS OF SEPTIC SYSTEMS (I.E. TANK, DISTRIBUTION BOX TRENCHES) TO BE 100 FEET FROM WELL (UNLESS OTHERWISE SPECIFICALLY AUTHORIZED)

NOTE: IF DEEP TRENCH(ES) ARE USED CALL FOR INSPECTION BEFORE AND AFTER PLACING GRAVEL IN TRENCH(ES)

NOTE: NO DRY WELL SHALL EXCEED 15 FOOT IN DIAMETER NO ABSORPTION TRENCH TO EXCEED 100 FEET IN LENGTH

NOTE: ALL PIPE FROM HOUSE TO SEPTIC TANK MUST BE CAST IRON OR SCHEDULE 35/40 PVC OR A2S

PERMIT VOID AFTER TWO YEARS

NOTE: INSTALL STAND PIPE ON SEPTIC TANK AND DRY WELL STAND PIPES MUST BE 6 INCHES IN DIAMETER CAST IRON, CONCRETE OR TERRA COTTA OR PVA OR ABS ACCEPTED. IF TOP OF SEPTIC TANK IS DEEPER THAN 3 FEET, MANHOLE TO GRADE REQUIRED.

NOTE: DISTRIBUTION BOXES MUST HAVE BAFFLES


\*INSTALLER IS RESPONSIBLE FOR OBTAINING FINAL APPROVAL ON THIS PERMIT

\*CALL 461-9933 FOR INSPECTION OF SEPTIC SYSTEM.

800123316 - 4/6/00  
DECK

48737

NOT TO SCALE

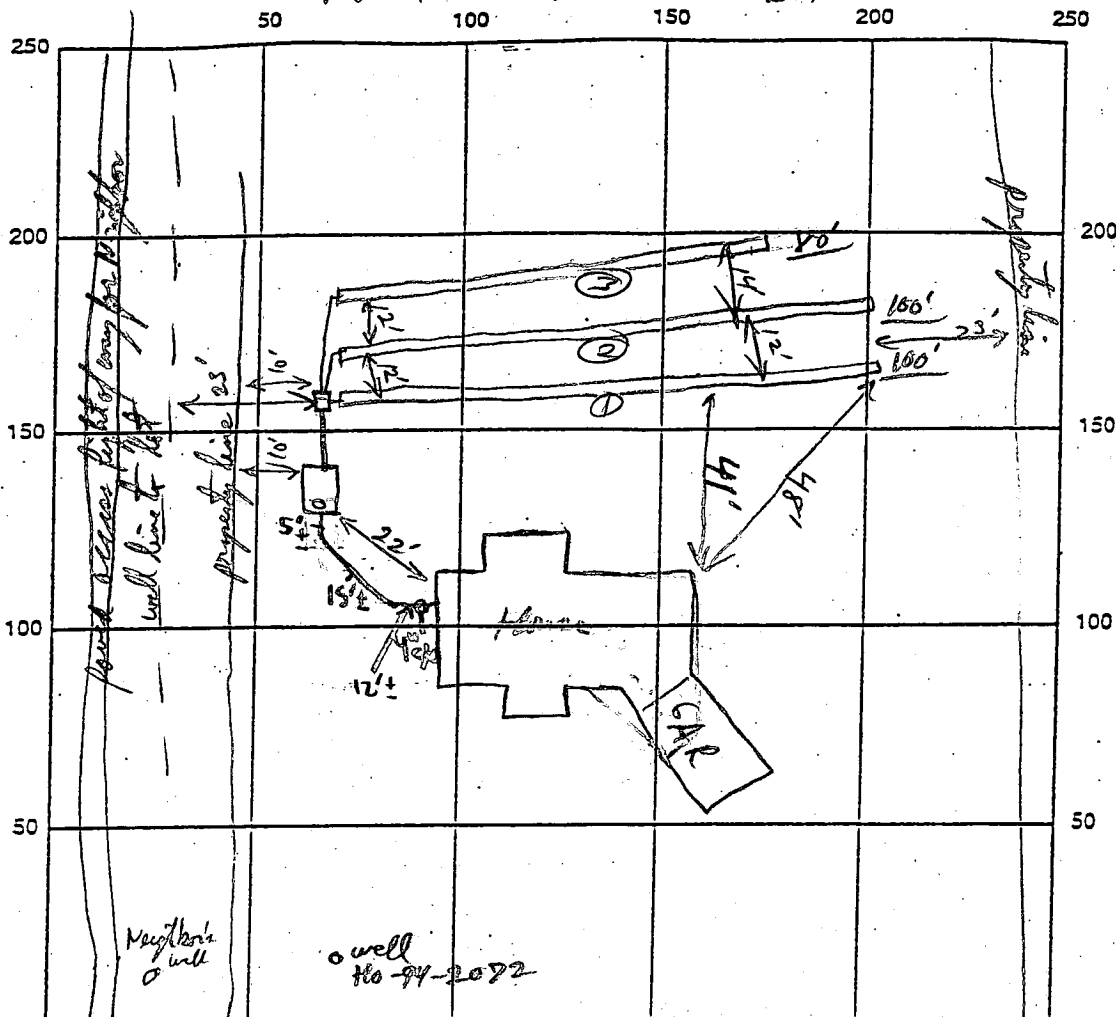

Velvet Valley Dr INDICATE NORTH - NAME ADJOINING ROADWAY AS BASE LINE

SEPTIC TANK LEVEL 1250 gal Mid Season

CLEANOUTS 4" @ House (find grading to reduce to less than 3 ft cover)

DISTRIBUTION BOX LEVEL ✓

DRAIN FIELD/TILE DEPTH 6 FT.

TRENCH WIDTH 3 FT.

INLET DEPTH 4 FT.

EFFECTIVE GRAVEL DEPTH 2 FT.

TOTAL LENGTH 100/100/100 FT. = 280 LF

NUMBER OF TRENCHES 3

ONE-SIDEWALL/BOTTOM AREA 840 SQ. FT.

DRYWELL INSIDE DIAMETER N/A FT.

EFFECTIVE DEPTH BELOW INLET N/A FT.

ABSORBENT AREA N/A SQ. FT.

REMARKS: All 3 trenches OK to cover, S.T. + db OK to cover. Needs House Connection R/P 8/3/99

8/4/99 - HOUSE CONNECTION MADE, OK TO COVER ALL WORK - SPK

DATE SYSTEM APPROVED

8/4/99

INSPECTOR

Steven R. Krieg

# APPLICATION

PERCOLATION TESTING

A 48737

P \_\_\_\_\_

HOWARD COUNTY HEALTH DEPARTMENT  
BUREAU OF ENVIRONMENTAL HEALTH  
P.O. BOX 476 ELLICOTT CITY, MARYLAND 21043  
TELEPHONE 461-9933

DISTRICT \_\_\_\_\_

DATE 12/9/92

TO: THE COUNTY HEALTH OFFICER  
ELLICOTT CITY, MARYLAND

I, HEREBY, APPLY FOR THE NECESSARY TEST IN ORDER TO CONSTRUCT (OR RECONSTRUCT) A SEWAGE DISPOSAL SYSTEM.

PROPERTY OWNER West Friendship New Town Co. NANTUCKET HOMES/DORSEY

ADDRESS c/o Land Design & Development PHONE (410) 740-2100  
10805 Hickory Ridge Road, Columbia, MD 21044

PROSPECTIVE BUYER N/A

ADDRESS \_\_\_\_\_ PHONE \_\_\_\_\_

PROPERTY LOCATION:

SUBDIVISION West Friendship Estates LOT NO 74

ROAD AND DESCRIPTION Pfefferkorn Road & Route 32 (3329 Velvet Valley Drive)

TAX MAP 15 PARCEL # 32 & 42, 533

SIZE OF LOT 1 + acres TYPE BLDG single family dwelling  
(SINGLE FAMILY DWELLING OR COMMERCIAL)

~~ORIGINAL PERMIT SIGNED~~

~~AND RETURNED~~ 5-19-1999  
Serial # BRO 117953-45m

THE SYSTEM INSTALLED UNDER THIS APPLICATION IS ACCEPTABLE ONLY UNTIL PUBLIC FACILITIES BECOME AVAILABLE. I FULLY UNDERSTAND THE

FEE CONNECTED WITH THE FILING OF THIS PERC TEST APPLICATION IS NON-REFUNDABLE UNDER ANY CIRCUMSTANCES. I ALSO AGREE TO COMPLY

WITH ALL M.O.S.H.A. REQUIREMENTS IN TESTING THIS LOT. Mark S. Reich  
(SIGNATURE OF APPLICANT)

APPROVED BY \_\_\_\_\_ FOR \_\_\_\_\_ DATE \_\_\_\_\_

REJECTED BY \_\_\_\_\_ FOR \_\_\_\_\_ DATE \_\_\_\_\_

HOLD PENDING FURTHER TESTS \_\_\_\_\_ DATE \_\_\_\_\_

REASONS FOR REJECTION OR HOLDING \_\_\_\_\_

THIS IS NOT A PERMIT

HD-216

SOIL PROFILE


INDICATE NORTH - NAME ADJOINING ROADWAY AS BASE LINE.

DATE	TEST NO.	DEPTH	PRE-WET		TEST - 1" DROP		TIME
			START	STOP	START	STOP	

REMARKS \_\_\_\_\_

TYPE OF SOIL \_\_\_\_\_

TESTED BY \_\_\_\_\_ ALSO PRESENT \_\_\_\_\_

# APPLICATION

PERCOLATION TESTING

A \_\_\_\_\_

P \_\_\_\_\_

HOWARD COUNTY HEALTH DEPARTMENT

BUREAU OF ENVIRONMENTAL HEALTH

3525-H ELLICOTT MILLS DRIVE/ELLICOTT CITY, MARYLAND 21043  
TELEPHONE: 313-2640

DISTRICT \_\_\_\_\_

DATE \_\_\_\_\_

TO: THE COUNTY HEALTH OFFICER  
ELLICOTT CITY, MARYLAND

I HEREBY APPLY FOR THE NECESSARY TEST PRIOR TO APPLICATION FOR PERMIT TO CONSTRUCT (OR RECONSTRUCT) A SEWAGE DISPOSAL SYSTEM.

PROPERTY OWNER \_\_\_\_\_

ADDRESS \_\_\_\_\_ PHONE \_\_\_\_\_

AGENT OR PROSPECTIVE BUYER \_\_\_\_\_

ADDRESS \_\_\_\_\_ PHONE \_\_\_\_\_

PROPERTY LOCATION:

SUBDIVISION \_\_\_\_\_ LOT NO. \_\_\_\_\_

ROAD AND DESCRIPTION \_\_\_\_\_

TAX MAP \_\_\_\_\_ PARCEL # \_\_\_\_\_

SIZE OF LOT \_\_\_\_\_ TYPE BLDG. \_\_\_\_\_  
(SINGLE FAMILY DWELLING OR COMMERCIAL)

THE SYSTEM INSTALLED UNDER THIS APPLICATION IS ACCEPTABLE ONLY UNTIL PUBLIC FACILITIES BECOME AVAILABLE. I FULLY UNDERSTAND THE  
FEE CONNECTED WITH THE FILING OF THIS PERC TEST APPLICATION IS NON-REFUNDABLE UNDER ANY CIRCUMSTANCES. I ALSO AGREE TO  
COMPLY WITH ALL M.O.S.H.A. REQUIREMENTS IN TESTING THIS LOT. \_\_\_\_\_

(SIGNATURE OF APPLICANT)

APPROVED BY \_\_\_\_\_ FOR \_\_\_\_\_ DATE \_\_\_\_\_

DISAPPROVED BY \_\_\_\_\_ FOR \_\_\_\_\_ DATE \_\_\_\_\_

HOLD PENDING FURTHER TESTS \_\_\_\_\_

REASONS FOR REJECTION OR HOLDING \_\_\_\_\_

PERCOLATION TEST PLAT/PRELIMINARY PLAT - TITLE OR I.D. # \_\_\_\_\_ DATE \_\_\_\_\_

SITE DEVELOPMENT PLAN/FINAL PLAT - TITLE OR I.D. # \_\_\_\_\_ DATE \_\_\_\_\_

# THIS IS NOT A PERMIT

48737

#22

Tree Lane

4 1/2

Von LOT 10

COUNTY #

SOIL PROFILE

0'

New  
# 69

①

LOT 22/23

SOIL PROFILE

1378

1381  
Gr  
Per  
LOT 22

②

1382  
Corners  
Per  
22

③

#1379  
Stake  
on #3  
hole  
for Rees  
22/23

INDICATE NORTH - NAME ADJOINING ROADWAY AS BASE LINE.

DATE	TEST NO.	DEPTH	PRE-WET		TEST - 1" DROP		TIME
			START	STOP	START	STOP	
12/14/92	#1378	5'	3:12	3:14	3:14	3:16	2 min
Monday	#1	10'-10"	Dry	- no	Too	Loam below	clay
P.M.	#1381	5'	3:10	3:13	3:13	3:25	12 min
	#2	11'	Dry	no	Loam	below	clay
	#1379	4'	3:30	3:32	3:32	3:37	5 min
	#3	8' 1/2'	3:36	3:39	3:39	3:45	6 min
	#1382	'	i reddish in color				
	#4	10' 10"	Similar to (#2)		Dry	10'	some rock

REMARKS

Tests in open around tree line

TYPE OF SOIL

(Loam below clay)

TESTED BY

C. B. J.

ALSO PRESENT

O. K. J.

TRENCH DESIGN DATA: AVERAGE PERCOLATION TIME

9 min

TRENCH WIDTH

3'

INLET DEPTH

4'

MAXIMUM BOTTOM DEPTH

6'

SQ. FT./BEDROOM


210 ft<sup>2</sup>



**ENVIRONMENTAL  
PRESERVATION  
PARCEL 'F'**

AREA THIS SHEET=1.478 Ac.  
FOR TOTAL AREA SEE SHEET 4

**PUBLIC FOREST  
CONSERVATION  
EASEMENT  
(2.064 Ac.)**

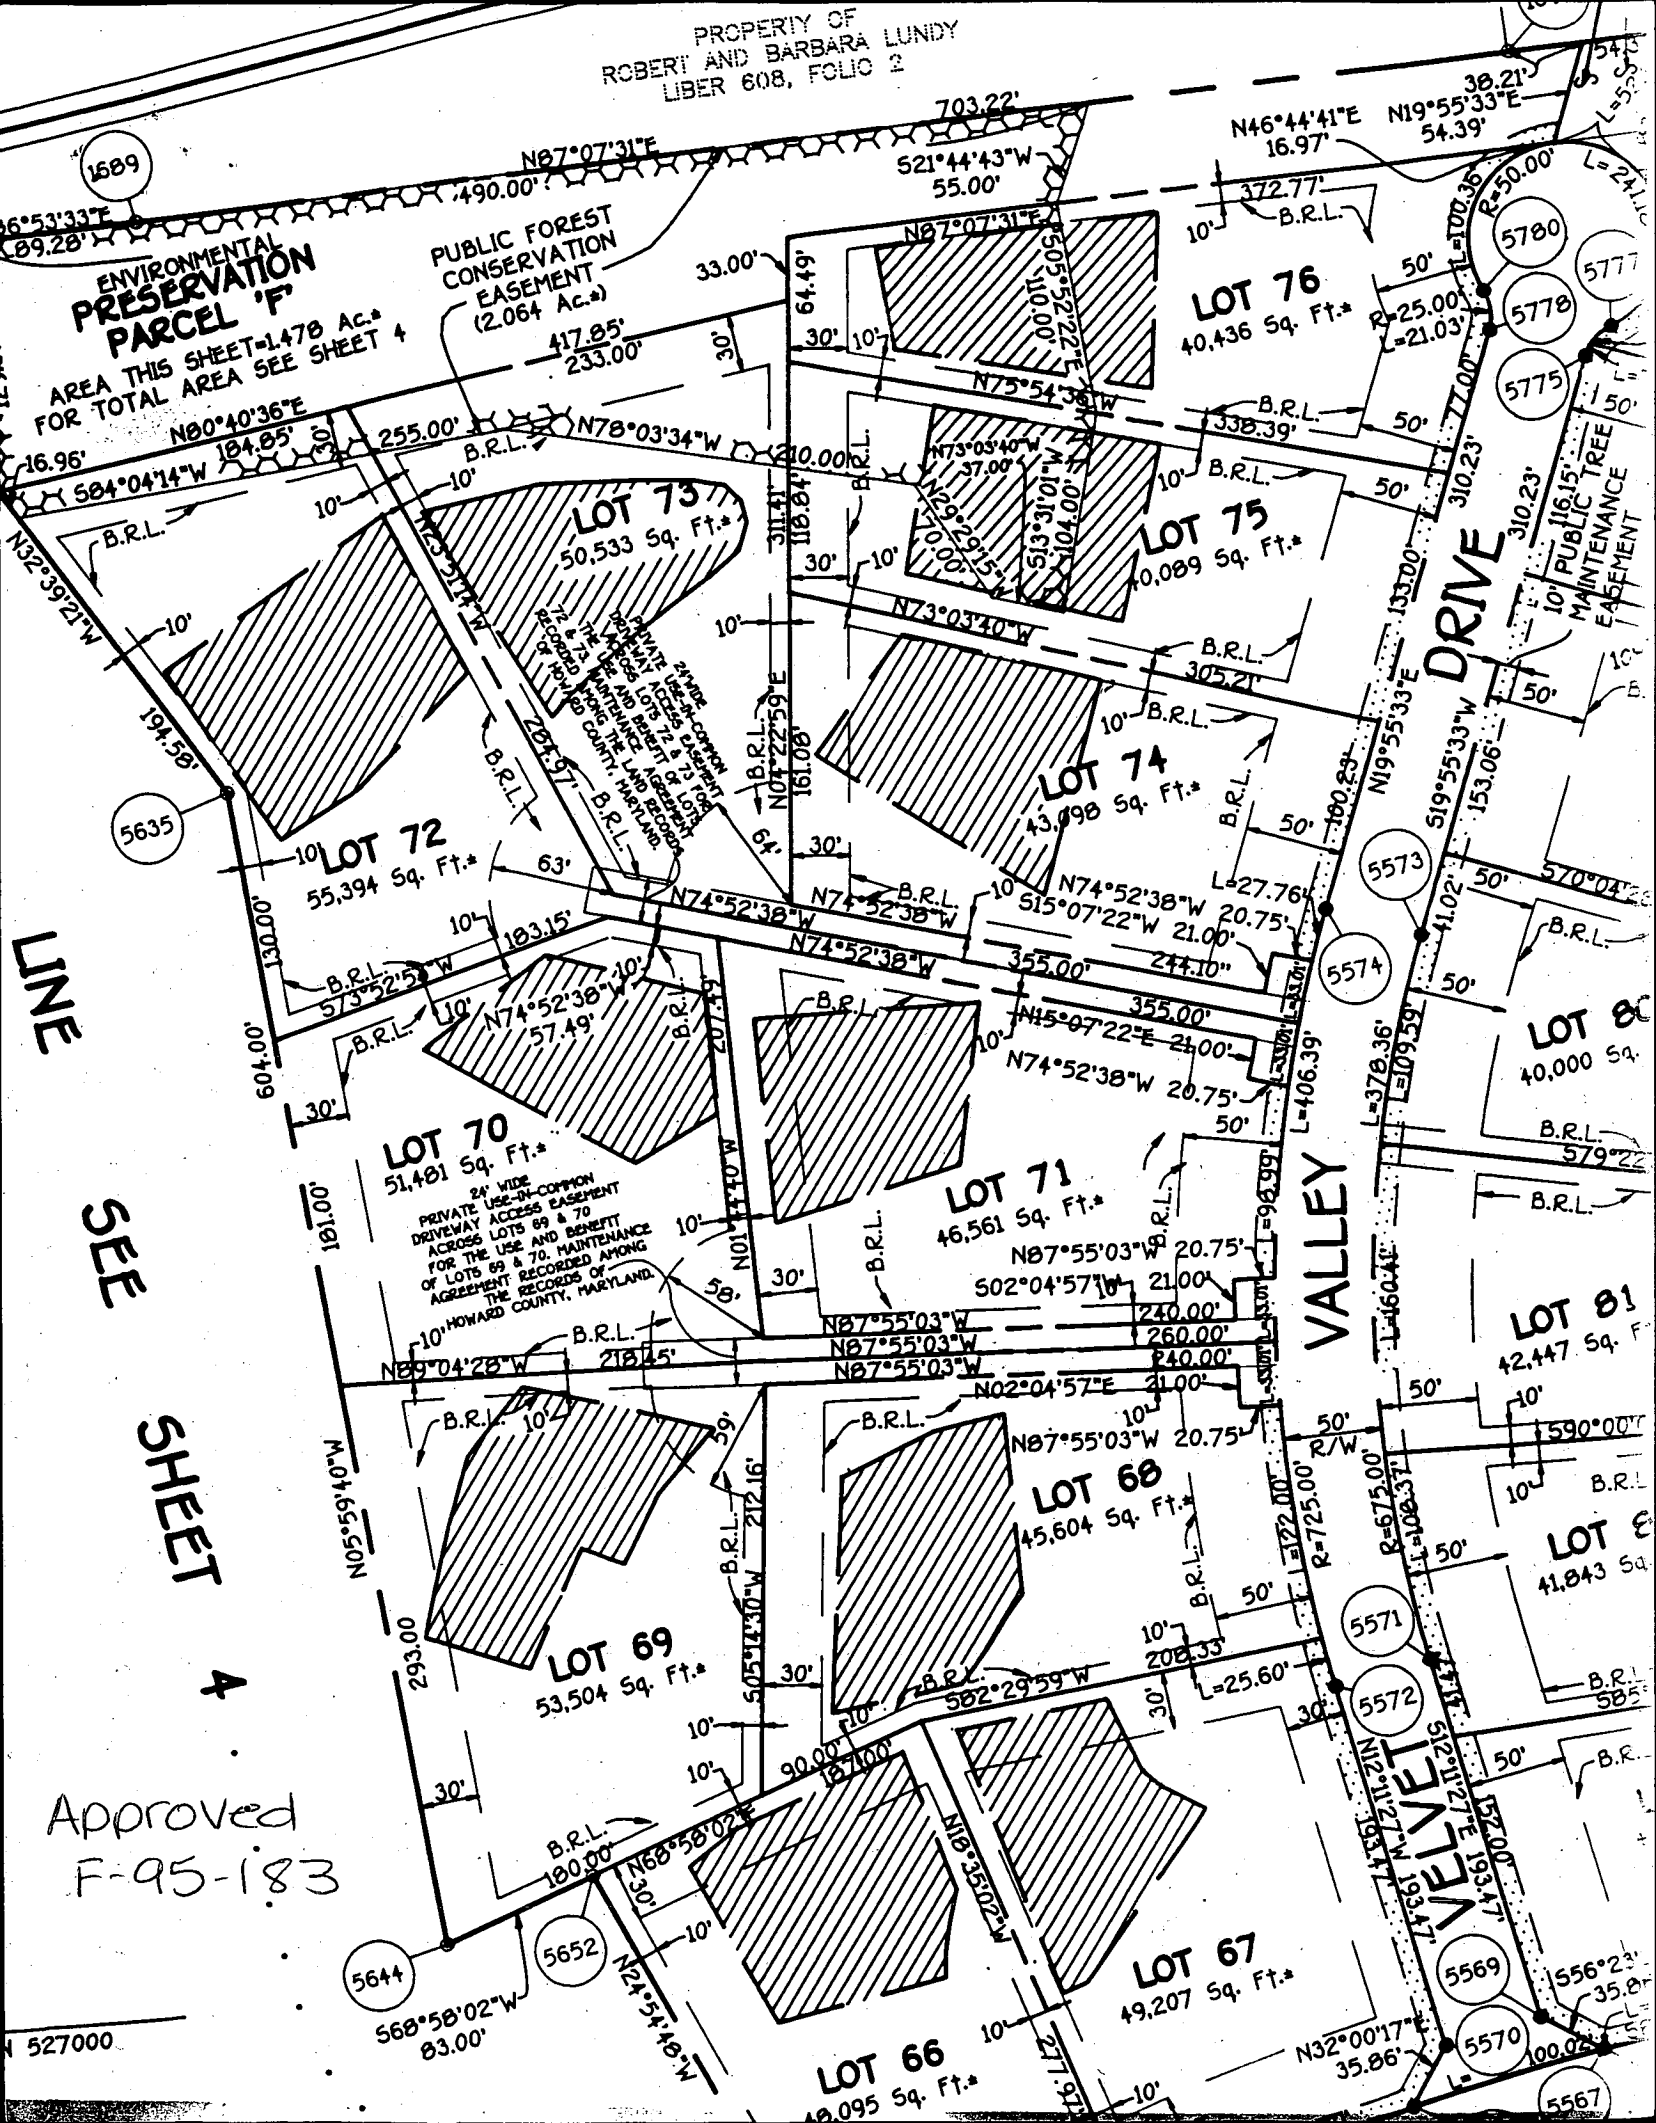

LINE  
SEE  
SHEET  
4

Approved  
F-95-183



Apr-23-99 09:38A cfs

4/2/00  
Deck is 20' wide at widest  
point closest trench is  
41' from house - No impact to  
septic OR to continue  
OK

END

P.01


97-01


4-23-99

ATTN PHIL DORSEY


PLEASE REVIEW PRIOR  
TO FINAL DRAFTING

THANKS  
JOEY

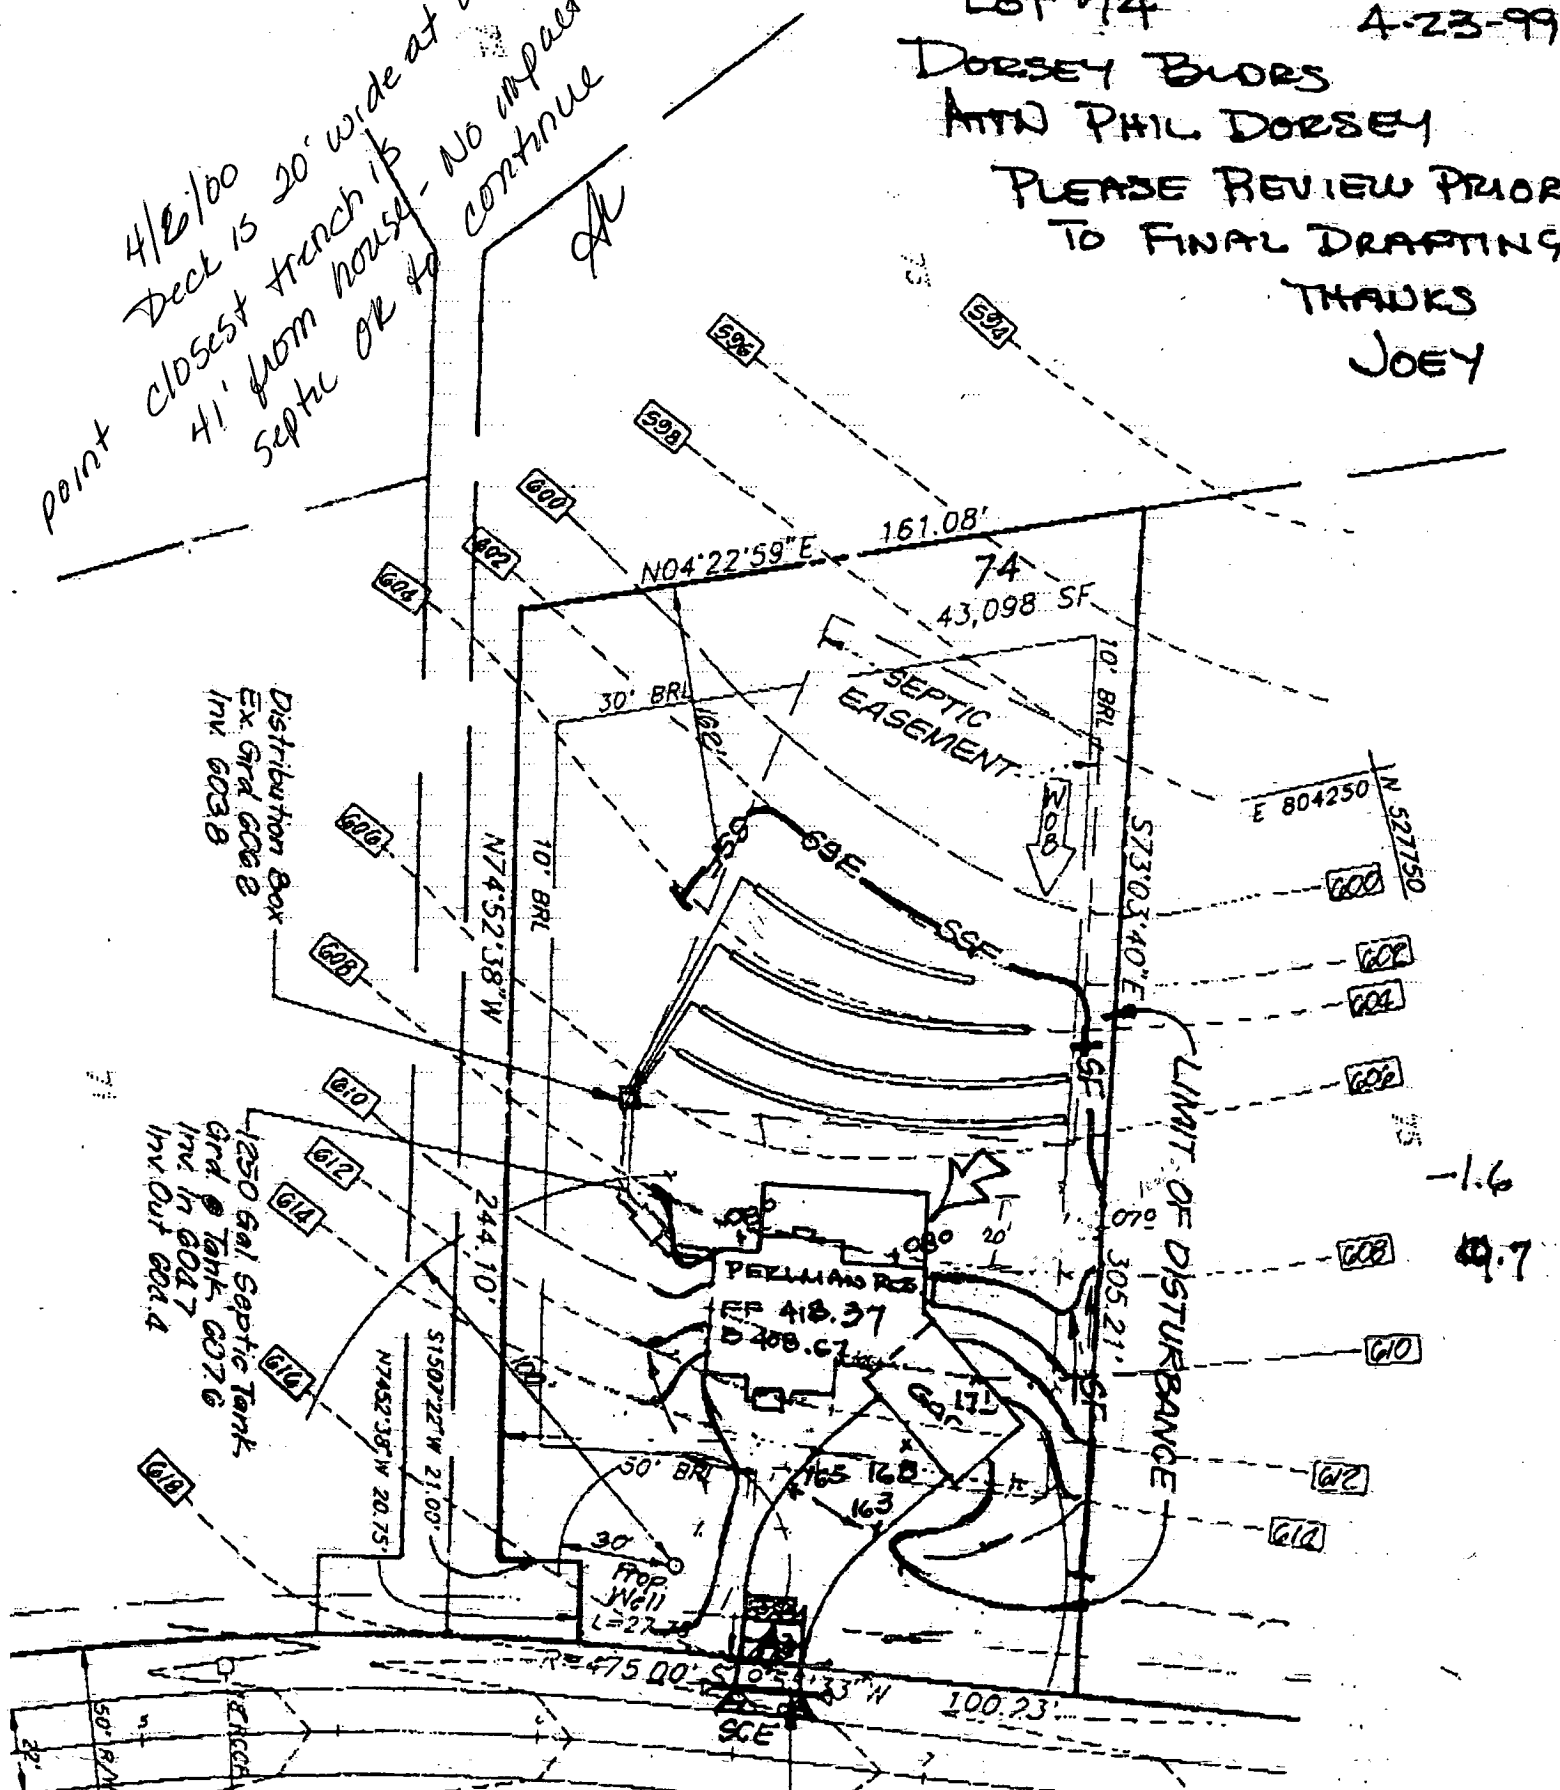
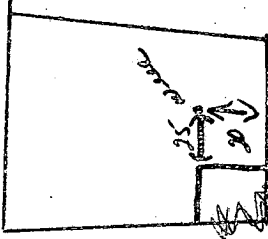
<b>C 1</b> <b>9776</b>		SEQUENCE NO. (MDE USE ONLY)		<b>STATE OF MARYLAND</b> <b>WELL COMPLETION REPORT</b> FILL IN THIS FORM COMPLETELY PLEASE PRINT OR TYPE		THIS REPORT MUST BE SUBMITTED WITHIN 45 DAYS AFTER WELL IS COMPLETED.	
1 2 3 6 (THIS NUMBER IS TO BE PUNCHED IN COLS. 3-6 ON ALL CARDS)						COUNTY NUMBER <b>A 48737</b>	
ST/CO USE ONLY DATE Received MM DD YY 8 13		DATE WELL COMPLETED MM DD YY 15 8 99		Depth of Well 22 200 26 (TO NEAREST FOOT)		PERMIT NO. FROM "PERMIT TO DRILL WELL" <b>HO-94-2072</b> 28 29 30 31 32 33 34 35 36 37	
OWNER STREET OR RFD SUBDIVISION		Builder last name first name <b>Velvet Valley Dr.</b>		TOWN <b>West Friendship</b>		LOT <b>44</b>	
<b>WELL LOG</b> Not required for driven wells		<b>GROUTING RECORD</b> WELL HAS BEEN GROUTED (Circle Appropriate Box) <b>Y</b> <b>N</b> TYPE OF GROUTING MATERIAL (Circle one) CEMENT <b>CM</b> BENTONITE CLAY <b>BC</b> NO. OF BAGS <b>20</b> NO. OF POUNDS <b>1800</b> GALLONS OF WATER <b>120</b> DEPTH OF GROUT SEAL (to nearest foot) from <b>0</b> TOP <b>20</b> ft. to <b>20</b> BOTTOM <b>58</b> ft. (enter 0 if from surface)		<b>C 3</b> 1 2 <b>PUMPING TEST</b> HOURS PUMPED (nearest hour) <b>3</b> PUMPING RATE (gal. per min.) <b>15</b> METHOD USED TO MEASURE PUMPING RATE <b>Bucket</b> WATER LEVEL (distance from land surface) BEFORE PUMPING <b>64</b> ft. WHEN PUMPING <b>66</b> ft. TYPE OF PUMP USED (for test) <b>A</b> air <b>P</b> piston <b>T</b> turbine <b>C</b> centrifugal <b>R</b> rotary <b>O</b> other (describe below) <b>J</b> jet <b>S</b> submersible			
STATE THE KIND OF FORMATIONS PENETRATED, THEIR COLOR, DEPTH, THICKNESS AND IF WATER BEARING		<b>CASING RECORD</b> casing types insert appropriate code below <b>ST</b> STEEL <b>CO</b> CONCRETE <b>PL</b> PLASTIC <b>OT</b> OTHER MAIN CASING TYPE <b>ST</b> Nominal diameter top (main) casing (nearest inch) <b>6</b> Total depth of main casing (nearest foot) <b>85</b> 60 61 63 64 66 70 OTHER CASING (if used) diameter depth (feet) inch from to EACH CASING		<b>SCREEN RECORD</b> screen type or open hole (insert appropriate code below) <b>ST</b> STEEL <b>BR</b> BRASS <b>HO</b> OPEN HOLE <b>PL</b> PLASTIC <b>OT</b> OTHER DEPTH (nearest ft.) <b>HO</b> <b>83</b> <b>200</b> 1 2 8 9 11 15 17 21 23 24 26 30 32 36 38 39 41 45 47 51 SLOT SIZE 1 2 3 DIAMETER OF SCREEN (NEAREST INCH) <b>56</b> <b>60</b> from to GRAVEL PACK IF WELL DRILLED WAS FLOWING WELL INSERT F IN BOX 68 <b>68</b>			
NUMBER OF UNSUCCESSFUL WELLS: <b>0</b>		<b>C 2</b>		<b>PUMP INSTALLED</b> DRILLER WILL INSTALL PUMP (CIRCLE) (YES or NO) <b>YES</b> <b>NO</b> IF DRILLER INSTALLS PUMP, THIS SECTION MUST BE COMPLETED FOR ALL WELLS. TYPE OF PUMP INSTALLED PLACE (A,C,J,P,R,S,T,O) IN BOX 29 <b>29</b> CAPACITY: GALLONS PER MINUTE (to nearest gallon) <b>31</b> <b>35</b> PUMP HORSE POWER <b>37</b> <b>41</b> PUMP COLUMN LENGTH (nearest ft.) <b>43</b> <b>47</b> CASING HEIGHT (circle appropriate box and enter casing height) <b>+</b> above <b>LAND SURFACE</b> <b>-</b> below <b>2</b> (nearest foot) 49 50 51			
WELL HYDROFRACTURED <b>Y</b> <b>N</b>		CIRCLE APPROPRIATE LETTER <b>A</b> A WELL WAS ABANDONED AND SEALED WHEN THIS WELL WAS COMPLETED <b>E</b> ELECTRIC LOG OBTAINED <b>P</b> TEST WELL CONVERTED TO PRODUCTION WELL I HEREBY CERTIFY THAT THIS WELL HAS BEEN CONSTRUCTED IN ACCORDANCE WITH COMAR 26.04.04 "WELL CONSTRUCTION" AND IN CONFORMANCE WITH ALL CONDITIONS STATED IN THE ABOVE CAPTIONED PERMIT, AND THAT THE INFORMATION PRESENTED HEREIN IS ACCURATE AND COMPLETE TO THE BEST OF MY KNOWLEDGE.		<b>LOCATION OF WELL ON LOT</b> SHOW PERMANENT STRUCTURE SUCH AS BUILDING, SEPTIC TANKS, AND /OR LANDMARKS AND INDICATE NOT LESS THAN TWO DISTANCES (MEASUREMENTS TO WELL) 			
DRILLERS LIC. NO. <b>MSD024</b> DRILLERS SIGNATURE <b>Paul E. Moore</b> (MUST MATCH SIGNATURE ON APPLICATION) LIC. NO. <b>M D</b>		MDE USE ONLY (NOT TO BE FILLED IN BY DRILLER) <b>T</b> (E.R.O.S.) <b>W Q</b> 70 72 74 75 76 TELESCOPE CASING LOG INDICATOR OTHER DATA					
SITE SUPERVISOR (sign. of driller or journeyman responsible for sitework if different from permittee)							

B 1	0300	SEQUENCE NO. (MDE USE ONLY)	STATE OF MARYLAND PERMIT TO DRILL WELL please print or type	STATE PERMIT NUMBER <b>HO-94-2072</b> <small>fill in this form completely</small>
Date Received (APA) <b>01 21 99</b>		OWNER INFORMATION		
8 MM DD YY 13		15 Last Name <b>Dorsey</b> Owner First Name <b>Builders, Inc</b> 34		
36 <b>13090 Old Frederick Rd.</b> 55		Street or RFD		
57 <b>Luxesville Md</b> 70 State 72 Zip <b>21784</b> 76				
DRILLER INFORMATION				
Driller's Name <b>Joseph L. Mayne</b> 76 License No. <b>MSD024</b> 81				
Firm Name <b>Joseph L. Mayne Well Drilling</b>				
Address <b>5512 Ridge Rd. Mt. Airy 21771</b>				
Signature <b>Joseph L. Mayne</b> 1/20/99		Date		
B 2 WELL INFORMATION				
1 2		APPROX. PUMPING RATE (GAL. PER MIN.) <b>5</b>		
AVERAGE DAILY QUANTITY NEEDED (GAL. PER DAY) <b>500</b>		8 12 14 20		
USE FOR WATER (CIRCLE APPROPRIATE BOX)				
<input checked="" type="checkbox"/> DOMESTIC POTABLE SUPPLY & RESIDENTIAL IRRIGATION <input type="checkbox"/> FARMING (LIVESTOCK WATERING & AGRICULTURAL IRRIGATION) <input type="checkbox"/> INDUSTRIAL, COMMERCIAL, DEWATERING <input type="checkbox"/> PUBLIC WATER SUPPLY WELL <input type="checkbox"/> TEST, OBSERVATION, MONITORING <input type="checkbox"/> GEO-THERMAL				
APPROXIMATE DEPTH OF WELL <b>260</b> FEET 24 28				
APPROXIMATE DIAMETER OF WELL <b>6</b> INCH NEAREST INCH				
METHOD OF DRILLING (circle one)				
BORED (or Augered) <input checked="" type="checkbox"/> JETTED <input type="checkbox"/> Jetted & DRIVEN <input type="checkbox"/> 30 AIR-ROTARY <input checked="" type="checkbox"/> AIR-PERCussion <input type="checkbox"/> ROTARY (Hydraulic Rotary) <input type="checkbox"/> 37 CABLE <input type="checkbox"/> REVERSE-ROTARY <input type="checkbox"/> Drive-POINT <input type="checkbox"/> other _____				
REPLACEMENT OR DEEPEENED WELLS (CIRCLE APPROPRIATE BOX)				
<input checked="" type="checkbox"/> THIS WELL WILL NOT REPLACE AN EXISTING WELL <input type="checkbox"/> THIS WELL WILL REPLACE A WELL THAT WILL BE ABANDONED AND SEALED 39 <input type="checkbox"/> THIS WELL WILL REPLACE A WELL THAT WILL BE USED AS A STANDBY-CONTACT LOCAL APPROVING AUTHORITY FOR POLICY ON STANDBY WELLS <input type="checkbox"/> THIS WELL WILL DEEPEEN AN EXISTING WELL				
PERMIT NUMBER OF WELL TO BE REPLACED OR DEEPEENED (IF AVAILABLE) 41 _____ 52				
Not to be filled in by driller. (MDE OR COUNTY USE ONLY)				
APPROX. PERMIT NUMBER 54 _____ 63				
PERMIT No. <b>HO-94-2072</b> 70 71 72 73 74 75 76 77 78 79				
B 3		LOCATION OF WELL		
8 COUNTY <b>Howard</b> 21				
23 SUBDIVISION <b>West Friendship Est.</b> 42				
SECTION <b>74</b> 44 46		LOT <b>74</b> 48 50		
52 NEAREST TOWN <b>West Friendship</b> 71				
MILES FROM TOWN (enter 0 if in town) <b>2</b> 73 76 77 78				
B 4		DIRECTION OF WELL FROM TOWN (CIRCLE BOX)		
1 2				
ON WHICH SIDE OF ROAD (CIRCLE APPROPRIATE BOX)		11 NEAR WHAT ROAD <b>Velvet Valley Dr.</b> 30 ON WHICH SIDE OF ROAD (CIRCLE APPROPRIATE BOX) NORTH <input type="checkbox"/> WEST <input checked="" type="checkbox"/> EAST <input type="checkbox"/> SOUTH <input type="checkbox"/> 34 30 37 DISTANCE FROM ROAD <b>FT</b> ENTER FT OR MI 38 39 TAX MAP <b>22</b> BLK <b>2</b> PARCEL <b>559</b>		
NOT TO BE FILLED IN BY DRILLER HEALTH DEPARTMENT APPROVAL				
<b>Howard</b>		<b>A48737</b>		
COUNTY NAME		COUNTY NO.		
STATE SIGNATURE _____		INSERT S <b>S</b>		
DATE ISSUED <b>01 25 99</b>		EXP. DATE <b>1/25/00</b>		
43 MM DD YY 48		CO SIGNATURE <b>Mark E. Riffin</b>		
NORTH GRID <b>528 000</b>		EAST GRID <b>0804 000</b>		
50 55		57 63		
SHOW MAJOR FEATURES OF BOX & LOCATE WELL WITH AN X		2/8/99 9:30		
SOURCES OF DRILLING WATER		1. <b>Well</b> 2. <b>ground</b> 3. <b>complete @ time of well</b> <b>well</b> <b>well</b>		
WRITE THE BOX NUMBER FROM THE MAP HERE		E <b>8004</b> N <b>5208</b>		
DRAW A SKETCH BELOW SHOWING LOCATION OF WELL IN RELATION TO NEARBY TOWNS AND ROADS AND GIVE DISTANCE FROM WELL TO NEAREST ROAD JUNCTION				
SPECIAL CONDITIONS				
NOTE - APPROVING AUTHORITIES SHOULD USE SEPARATE SHEET IF NEEDED				

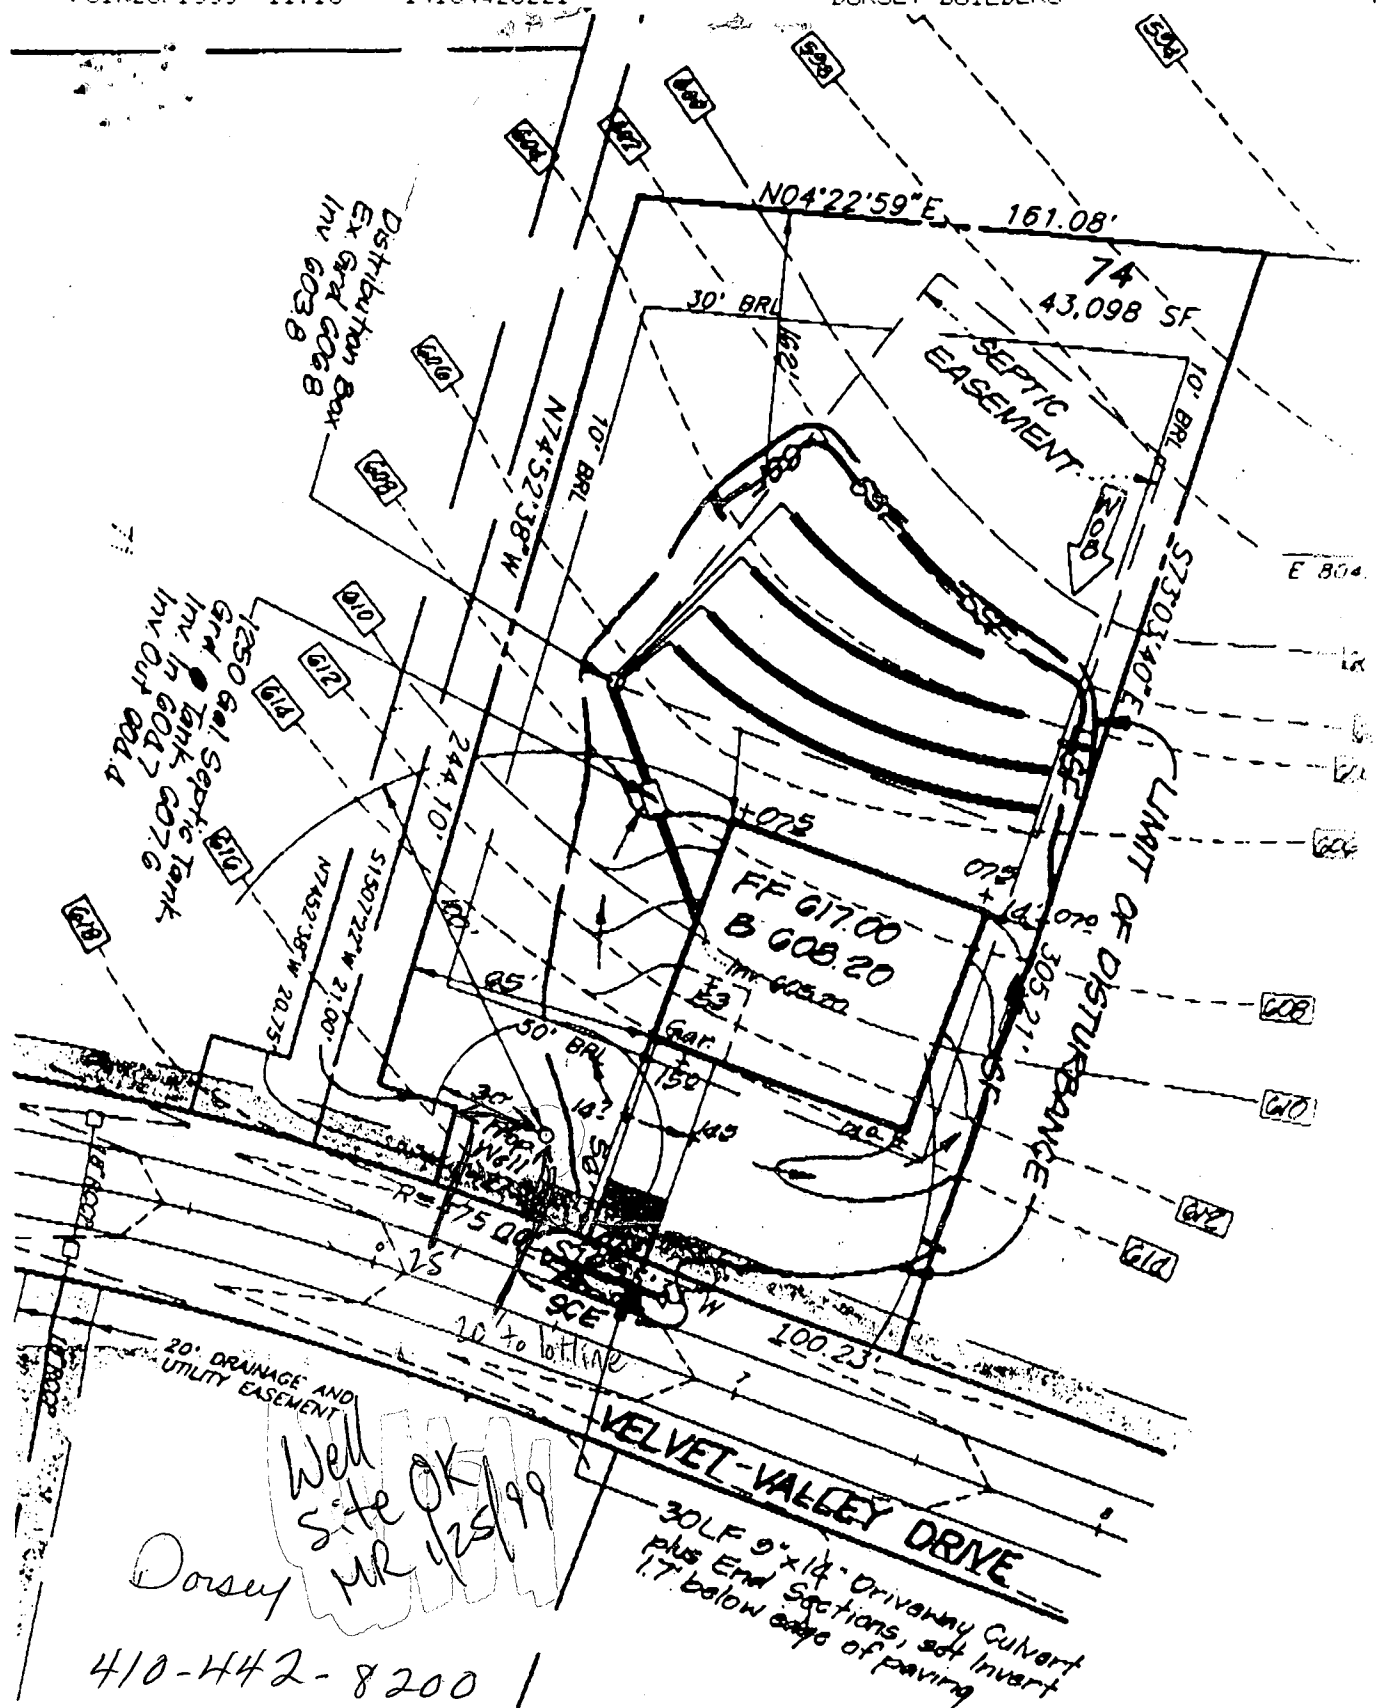

## GENERAL NOTES

1. Existing Topography prepared by Fishd
2. Length of trenches
3. Reference : Plot A