

PERMIT

SEWAGE DISPOSAL SYSTEM

MARYLAND STATE DEPARTMENT OF HEALTH

HOWARD COUNTY

ELLICOTT CITY

DISTRICT 400

DATE 6/11/73

INDEXED

Paul Greger

IS PERMITTED TO INSTALL ☒ ALTER ☐

ADDRESS Wright 24., Rt. 2, Box 47, Hanover, Md. 21076

PHONE 796-0992

A SEWAGE DISPOSAL SYSTEM LOCATED AT

SUBDIVISION

ROAD

Triadelphia Road - 1/2 mile from Embassy Road on left hand side of road

PROPERTY OWNER Ronald J. Kirtinatis

ADDRESS 14925 Triadelphia Road, Glenelg, Maryland 21737

SPECIFICATIONS 3 bedrooms - 1000 gallon tank
4 bedrooms - 1250 gallon tank

DRAIN FIELD DEPTH FEET, BOTTOM AREA SQ. FT.

SLEPAGE PITS ABSORBENT SIDE-WALL AREA SQ. FT.

SEPTIC TANK CAPACITY GALLONS

FOR GARBAGE GRINDER, INCREASE DISPOSAL AREA 25% & TANK CAPACITY 50%

OTHER DRY WELL - To have 100 sq. ft. absorbent sidewall area per bedroom, below inlet. Inlet to be 3 ft. below original grade and maximum depth 12 ft. below original grade. Location 110 ft. from first point of turn along left front property line and 100 ft. off front property line into lot when facing lot from Triadelphia Road. Note - lowest part of dry well top shall be 3 ft. below original grade of slope.

NOTE: ALL PIPE FROM HOUSE TO DRY WELL MUST BE CAST IRON.
PERMIT VOID AFTER THREE YEARS.

NOTE: INSTALL STAND PIPE ON SEPTIC TANK AND DRY WELL.

PLANS APPROVED BY Charles B. Strecker

DATE 9/26/72

FILL SEPTIC TANK AND DISTRIBUTION BOX WITH WATER BEFORE CALLING FOR AN INSPECTION. COVER NO WORK UNTIL INSPECTED AND APPROVED.

NEITHER THE HOWARD COUNTY COMMISSIONERS NOR THE HEALTH DEPARTMENT IS RESPONSIBLE FOR THE SUCCESSFUL OPERATION OF ANY SYSTEM.

BLDG. PERMIT SIGNED

AND RETURNED 7-23-97

Serial # 90106997
Master Bedroom
offensive

PERMIT SIGNED
AND RETURNED 12/29/92
Serial # 90150
2-story addition

0448891-10

18242

PERMIT

ELLICOTT CITY

DISTRICT

DATE 6/11/73

MARYLAND STATE DEPARTMENT OF HEALTH
SEWAGE DISPOSAL SYSTEM

HOWARD COUNTY

INDEXED

100-005

Address Wright Rd., Box 2, Newover, Md.

from property line on left hand side of road.

PROPERTY OWNER Ronald J. Kirtland

1 bedroom - 1000 gallon tank
2 bedrooms - 1200 gallon tank

SEWAGE PITS ABSORBENT SIDEWALL AREA

PERMIT CARD

SEPTIC TANK CAPACITY

SEPTIC TANK, LEVEL

1250 gal

CLEANOUTS

DISTRIBUTION BOX, LEVEL

TILE FIELD, DEPTH

12" TRENCH WIDTH

GRAVEL DEPTH

IN. TOTAL LENGTH

NUMBER OF TRENCHES

TOTAL BOTTOM AREA

SEWAGE PITS, INSIDE DIAMETER

12 1/2"

DEPTH BELOW GROUND

ABSORBENT AREA

425

SQ. FT.

REMARKS


DW in area called for by spec.


DATE SYSTEM APPROVED

6/22/73

INSPECTOR


W A Zeyt

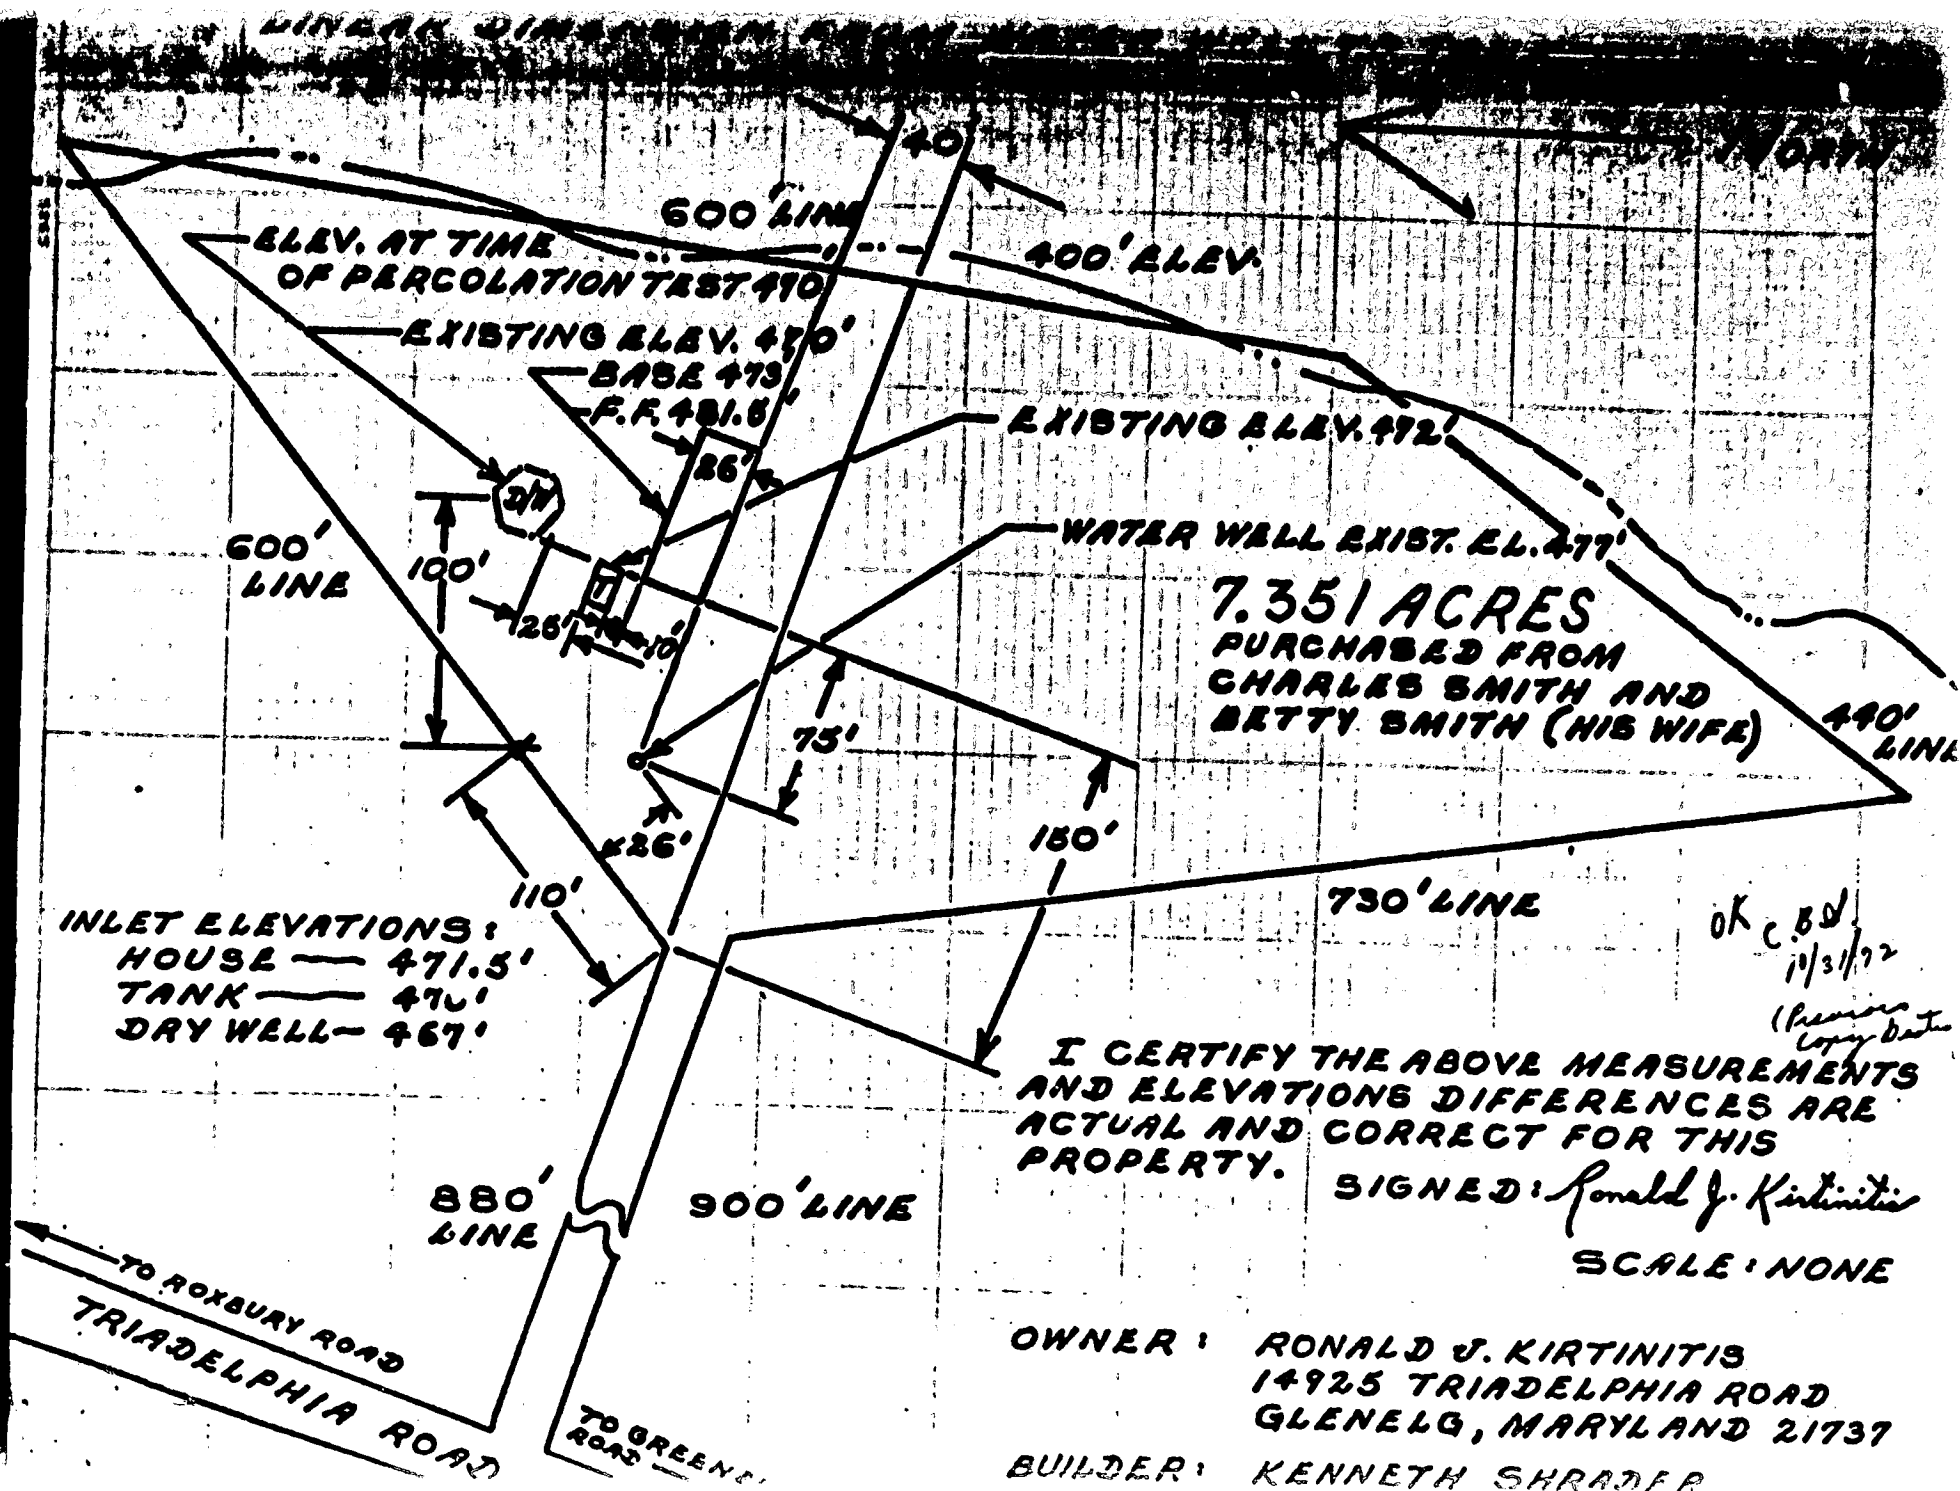

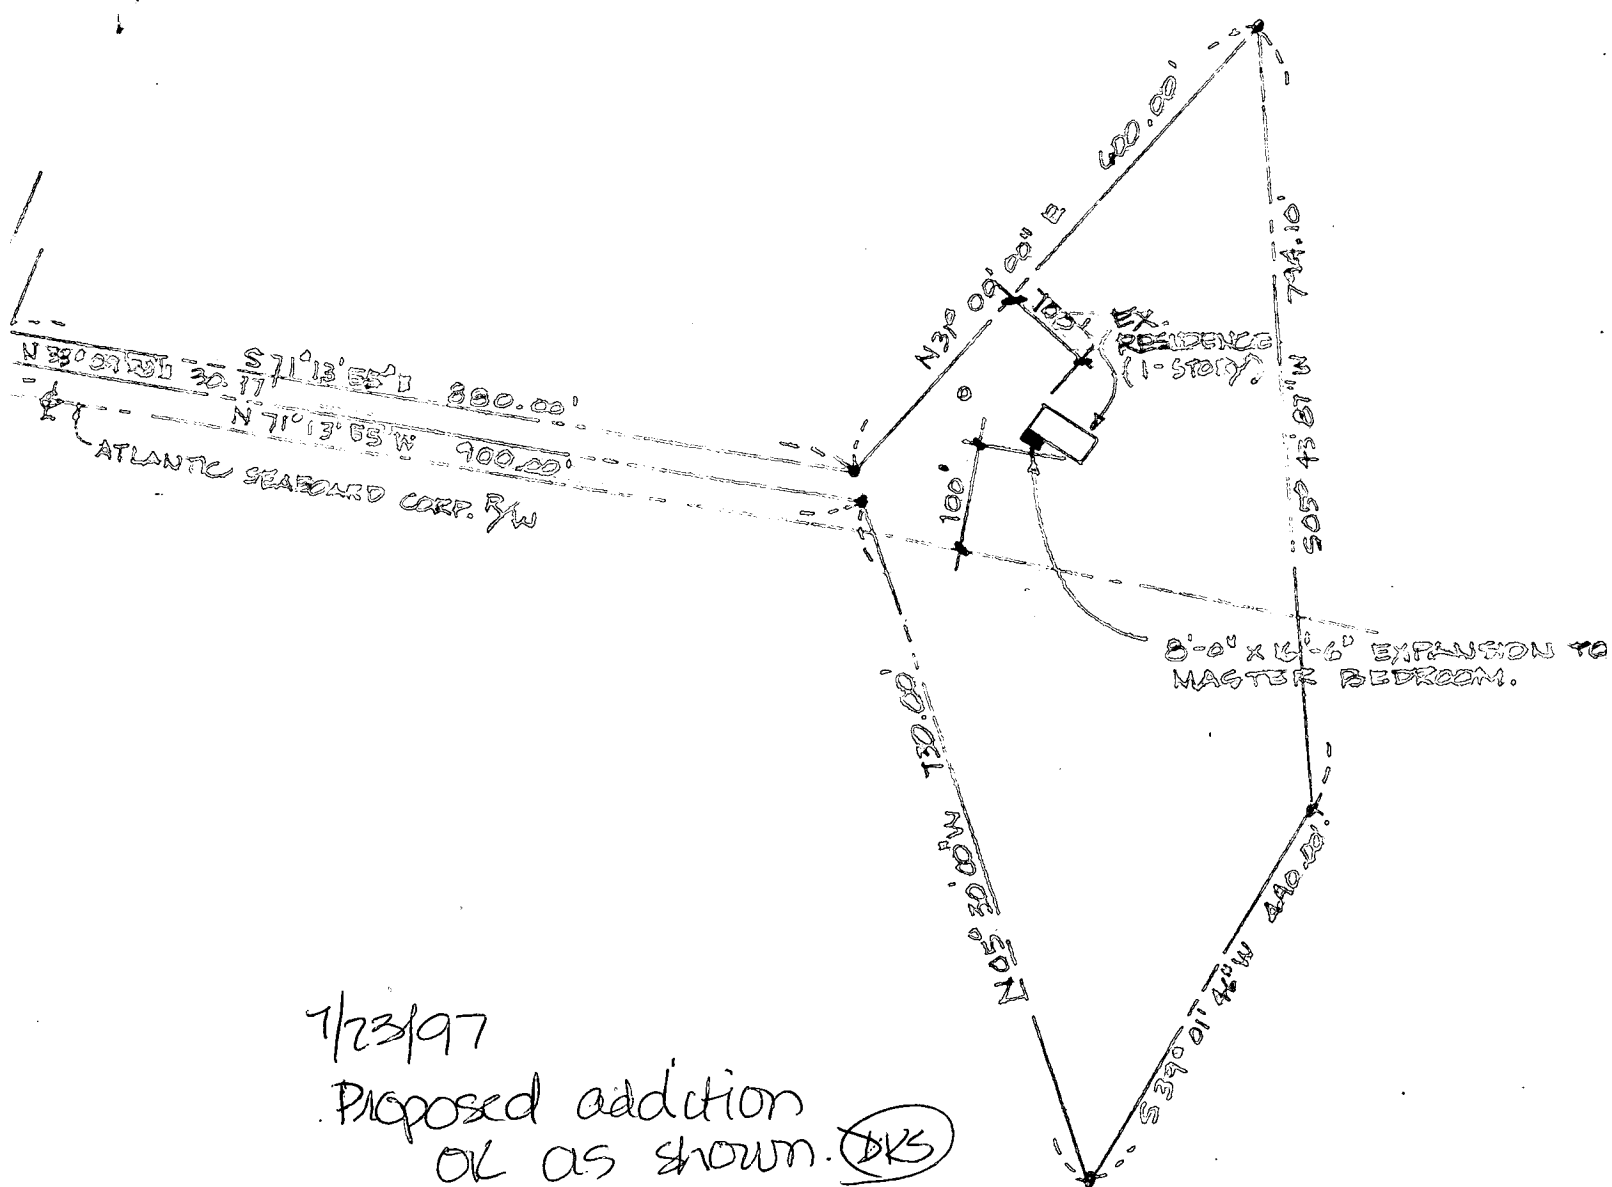

SITE PLAN

1" = 200.00'

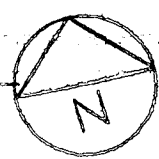

NOTE.

DATA SHOWN ABOVE IS BASED ON A "PLAT-OF-SURVEY" DATED 9/21/72 PREPARED BY CLAUDE M. SKINNER, JR., REG. PROFESSIONAL ENGINEER & LAND SURVEYOR (MD. REG. NO. 2237).

PROPERTY IS LOCATED IN FOURTH ELECTION DISTRICT, HOWARD COUNTY, GLENWOOD, MARYLAND.