

4/24/92
1:30
4/28/92 12-1 PM

Tax ID - 05-363306
PERMIT

SEWAGE DISPOSAL SYSTEM

DEPARTMENT OF HEALTH AND MENTAL HYGIENE

HOWARD COUNTY HEALTH DEPARTMENT
BUREAU OF ENVIRONMENTAL HEALTH
461-9933

INDEXED

P 48072

A _____

DISTRICT _____

DATE 5/5/92

DATE SYSTEM APPROVED 4/28/92

INSPECTOR M. Rifkin

Arnold Septic IS PERMITTED TO INSTALL _____ ALTER X

ADDRESS _____ PHONE _____

SUBDIVISION HAVILAND HILLS LOT 23 ROAD 13842 WAYSIDE CT

PROPERTY OWNER John Pisarra

ADDRESS 13842 WAYSIDE CT.

SEPTIC TANK CAPACITY — GALLONS

NUMBER OF BEDROOMS 3

125 SQUARE FEET PER BEDROOM

LINEAR FEET OF TRENCH REQUIRED 375' +

PURPOSE: TO REPAIR FAILING SEPTIC SYSTEM,
15'x15' D/W INLET 4' BOTTOM 12'.

PLANS APPROVED BY _____ DATE _____

COVER NO WORK UNTIL INSPECTED AND APPROVED

NEITHER THE HOWARD COUNTY COUNCIL NOR THE HEALTH DEPARTMENT IS RESPONSIBLE FOR THE SUCCESSFUL OPERATION OF ANY SYSTEM

NOTE: CLEANOUT REQUIRED EVERY 70 FEET OF SEWER LINE AND/OR AT 90° SWEEPS IN LINES FROM HOUSE TO DRAIN FIELDS, 90° ELBOWS NOT ACCEPTABLE.

NOTE: ALL PARTS OF SEPTIC SYSTEMS (I.E. TANK, DISTRIBUTION BOX TRENCHES) TO BE 100 FEET FROM WELL (UNLESS OTHERWISE SPECIFICALLY AUTHORIZED)

NOTE: IF DEEP TRENCH(ES) ARE USED CALL FOR INSPECTION BEFORE AND AFTER PLACING GRAVEL IN TRENCH(ES)

NOTE: NO DRY WELL SHALL EXCEED 15 FOOT IN DIAMETER NO ABSORPTION TRENCH TO EXCEED 100 FEET IN LENGTH

NOTE: ALL PIPE FROM HOUSE TO SEPTIC TANK MUST BE CAST IRON OR SCHEDULE 35/40 PVC OR ABS

PERMIT VOID AFTER TWO YEARS

NOTE: INSTALL STAND PIPE ON SEPTIC TANK AND DRY WELL STAND PIPES MUST BE 6 INCHES IN DIAMETER CAST IRON. CONCRETE OR TERRA COTTA OR PVA OR ABS ACCEPTED. IF TOP OF SEPTIC TANK IS DEEPER THAN 3 FEET. MANHOLE TO GRADE REQUIRED.

NOTE: DISTRIBUTION BOXES MUST HAVE BAFFLES

***INSTALLER IS RESPONSIBLE FOR OBTAINING FINAL APPROVAL ON THIS PERMIT**

48072

7/1/66 - Approved - J Mc

7/1/66 - 4 PM
after 2 PM

PERMIT

SEWAGE DISPOSAL SYSTEM

MARYLAND STATE DEPARTMENT OF HEALTH

HOWARD COUNTY

INDEXED

ELLICOTT CITY

DISTRICT 5

DATE 6/29/66

P 11955

A 11903

Robert Dubin IS PERMITTED TO INSTALL X ALTER

ADDRESS Clarksville, Maryland PHONE 774-6516

A SEWAGE DISPOSAL SYSTEM LOCATED AT

SUBDIVISION Haviland Hills ROAD 13842 Wayside Court LOT 23

PROPERTY OWNER John & Rita Glyn-Jones

ADDRESS

SPECIFICATIONS - 3 bedrooms

DRAIN FIELD DEPTH FEET, BOTTOM AREA SQ. FT.

SEEPAGE PITS ABSORBENT SIDE-WALL AREA SQ. FT.

SEPTIC TANK CAPACITY 750 GALLONS

FOR GARBAGE GRINDER, INCREASE DISPOSAL AREA 22% & TANK CAPACITY 50%.

OTHER Dry well - 300 sq. ft. sidewall area below the inlet. Do not put inlet deeper than 4 ft. below grade.
Place the dry well 245 ft. to 285 ft. from the front lot line and 80 ft. to 100 ft. from the right side of the lot as seen when facing the lot from Wayside Court. Sewage system must be installed and approved before building permit issued.

PLANS APPROVED BY (Raymond Hodges) DATE will be signed only after installation

FILL SEPTIC TANK AND DISTRIBUTION BOX WITH WATER BEFORE CALLING FOR AN INSPECTION. COVER NO WORK UNTIL INSPECTED AND APPROVED.

NEITHER THE HOWARD COUNTY COMMISSIONERS NOR THE HEALTH DEPARTMENT IS RESPONSIBLE FOR THE SUCCESSFUL OPERATION OF ANY SYSTEM.


BLDG. PERMIT SIGNED

AND RETURNED 7/25/66

Serial # 65995

**NOTIFY THE HEALTH DEPARTMENT 48 HOURS
BEFORE EXCAVATIONS ARE TO BE BACK FILLED.**

11903

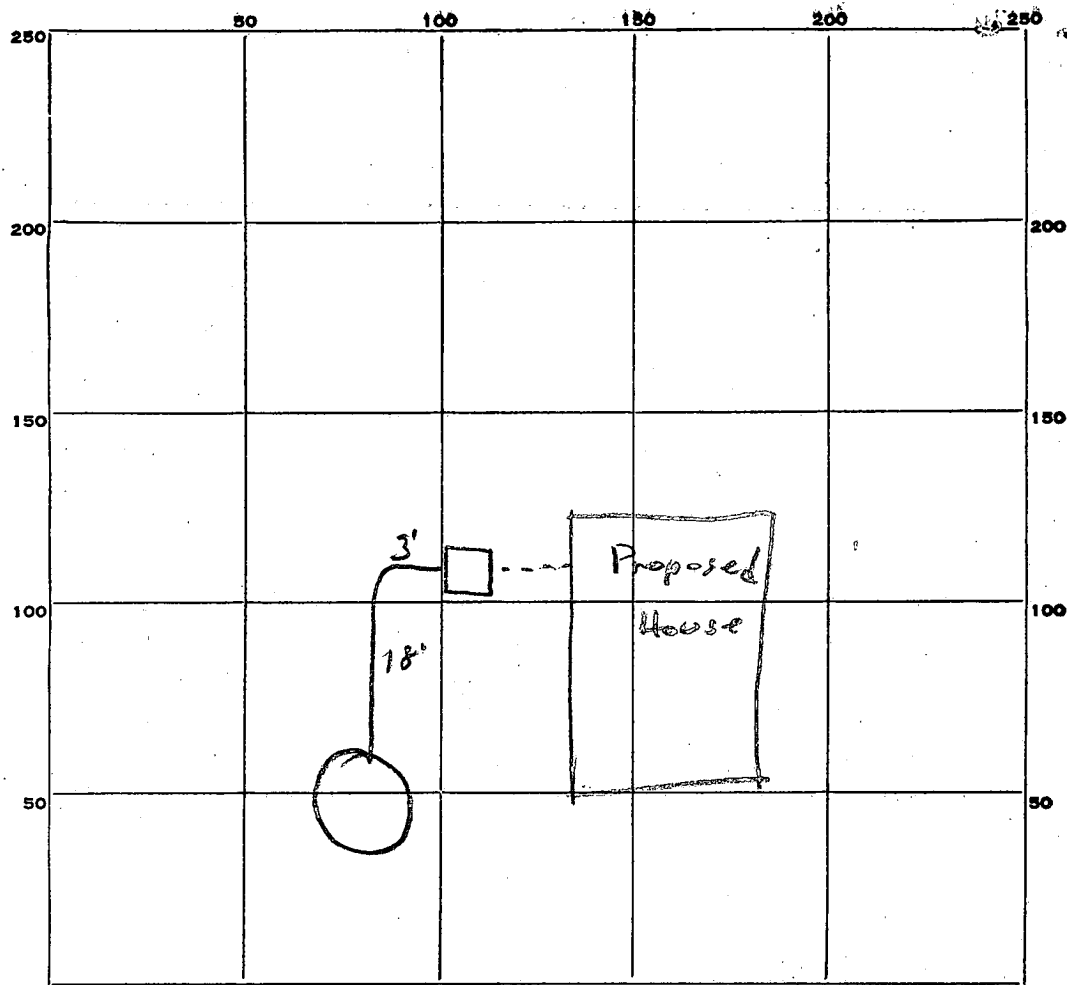

INDICATE NORTH. - NAME ADJOINING ROADWAY AS BASE LINE.

PERMIT CARD yes

SEPTIC TANK, LEVEL OK

CLEANOUTS OK

DISTRIBUTION BOX, LEVEL _____

TILE FIELD, DEPTH _____ FT. TRENCH WIDTH _____ FT.

GRAVEL DEPTH _____ IN. TOTAL LENGTH _____ FT.

NUMBER OF TRENCHES _____ TOTAL BOTTOM AREA _____

SEEPAGE PITS, INSIDE DIAMETER 13 FT. DEPTH BELOW INLET 9 FT.

ABSORBENT AREA 367 SQ. FT.

REMARKS _____

DATE SYSTEM APPROVED 7/1/66 INSPECTOR JH Kohnore

APPLICATION

SEWAGE DISPOSAL TESTING

A 11903

P

MARYLAND STATE DEPARTMENT OF HEALTH

HOWARD COUNTY 750 Gallon Tank

ELLICOTT CITY

DISTRICT 5

DATE 6/14/66

Dry Well 300 sq ft sidewall

area below the inlet. Do not put inlet deeper than 4 ft below grade

Place the dry well 245 ft to 285 ft from the front lot line and 80 ft to 100 ft from the right side of the lot as seen when facing the lot from Wayside Court

TO: THE COUNTY HEALTH OFFICER
ELLICOTT CITY, MARYLAND

I, HEREBY, APPLY FOR THE NECESSARY TESTS IN ORDER TO CONSTRUCT (OR RECONSTRUCT) A SEWAGE DISPOSAL SYSTEM.

PROPERTY OWNER

John & Rita Glyn-Jones

ADDRESS

Snyder Lane, Collesville, Md.

PHONE

439-6429

PROPERTY LOCATION:

SUBDIVISION

Haviland Hills

LOT NO.

23

ROAD AND DESCRIPTION

Wayside Court

OCCUPANT

PHONE

PERSON TO CONSTRUCT SYSTEM

ADDRESS

PHONE

SIZE OF LOT

120,205 sq. ft.

TYPE BLDG.

3
NUMBER OF BEDROOMS

IF NOT SINGLE RESIDENCE DESCRIBE

SIGNATURE OF APPLICANT

Scott M. Ferguson /et

APPROVED BY

John H. Kilmore

FOR

Dry well

DATE

7/1/66

REJECTED BY

Donald W. Monaghan

FOR

Septic System

DATE

6/21/66

HOLD PENDING FURTHER TESTS

B.H. RH

DATE

 
6/15/66 6/16/66

REASONS FOR REJECTION OR HOLDING

6/15/66 - Enough ground for initial system

but not enough for repair area 6/16/66 still not enough area for repair 6/21/66 - not enough & porous ground the much rock in area sum 6/28/66 - system must OK before building

THIS IS NOT A PERMIT

$\Delta 0.50$ 


See Attached sheet for map of test hole
& best results for the tests run on 6/28/60

REMARKS

REMARKS *for value of bridge of sand.*

500

LOT 23
HAVILAND HILLS
WAYSIDE COURT

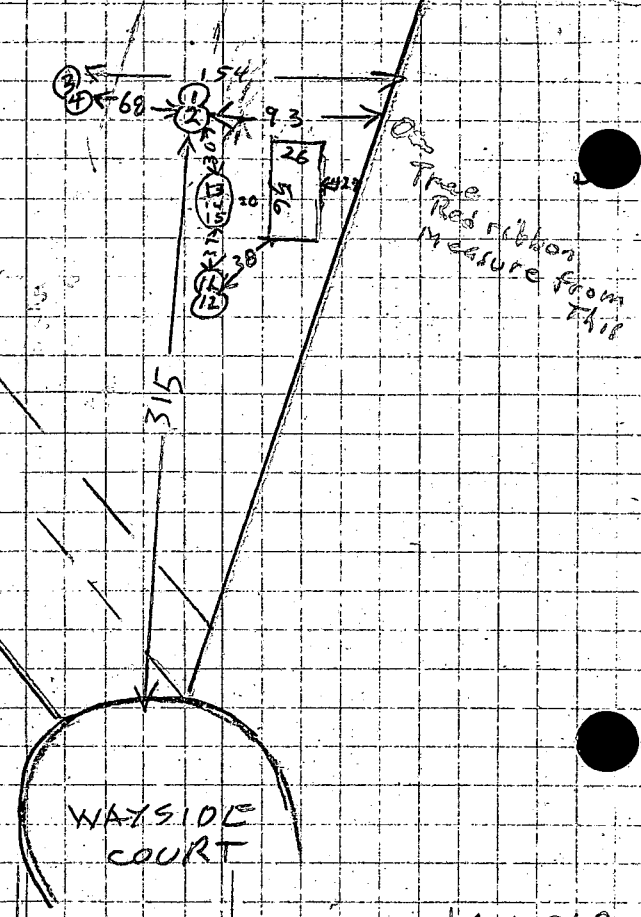

11	6/28/66	12 FT	1011	1015	1024	9
12	" "	6 1/2 FT	1012	1014	1015	2
13	" "	11 1/2 FT	1026	1027	1031	4
14	" "	7 1/2 FT	1026	1027	1030	3
15	" "	5 1/2 FT	1026	1027	1028	1

top 5' clay
Bottom

Top 3' clay
Bot 7 1/2' sand

2 25
37
2 48

131
37
2 25

THIS REPORT
MUST BE SUBMITTED
WITHIN 30 DAYS
AFTER COMPLETION
OF THE WELL

WELL COMPLETION REPORT

WELL DESCRIPTION

WELL LOG

State the kind of formations penetrated, their color, their depth, their thickness, and if water-bearing

CASING AND SCREEN RECORD

State the kind and size and position of casing, liner, shoe, screen, and other accessories (if no casing used, give diameter of well).

FEET
from to

44
clay
44
Sand
+
gravel
23
Shale
Rock
127
Mica
Rock

DIAM.
(inches)

6 1/4"

Pipe

FEET
from to

48

WELL

200

Permit Number

HO-16-W-28

Owner

Address

Subdivision

Section

Lot

23

PUMPING TEST

Hours Pumped

Type of Pump Used

Pumping Rate

Gallons per Minute

WATER LEVEL

(Distance from land surface to water)

Before Pumping

When Pumping

APPEARANCE OF WATER

Clear ☒ Cloudy ☐

Taste

Odor

Height of Casing Above Land:

Surface

PUMP INSTALLED

Type

Capacity

Gallons per Minute

Gallons per Hour

Pump Column Length

LOCATION OF WELL ON LOT

Show permanent structures such as building(s), septic tank, and/or other landmarks and indicate not less than 2 distances (measurements) to well.

NORTH



DATE
WELL WAS
COMPLETED

I hereby affirm that this report contains no willful misrepresentations or falsifications and that information given in this report is true, accurate and complete to the best of my knowledge and belief.

Ed. Brown, Well Driller

Well Driller License No.:

81

HOWARD COUNTY
MARYLAND STATE DEPARTMENT OF HEALTH
8 Church Road
ELLICOTT CITY, MARYLAND
WELL COMPLETION REPORT

This report must be submitted within 10 days after completion of the well.

This is to certify that the well which has been completed on the below property has been constructed and disinfected in compliance with the regulations and specifications of the State Board of Health.

The following construction and performance characteristics were noted:

1. Type, diameter and length of casing 1 1/4" Pipe 48 ft
 2. Total depth of well 210 ft
 3. Type, diameter and length of strainer None. Size of screen openings _____
 4. Method of sealing top and bottom of screen _____
 5. Method of grouting Cement. Quantity, cement used 188 lbs.
Gals. water 10
 6. Standing water level (depth below ground surface when not pumping) 62 ft
 7. Yield of well in gallons per minute 20; elevation of water surface when pumped at the designated rate. _____
 8. Number of hours pump operated at stipulated rate during pumping test 2
 9. Record of any other pumping performance None
 10. Log of materials encountered during drilling 4 ft. Clay 44 Shale Rock
127 ft. Mica Rock
 11. Physical appearance of water at end of final pumping test Clear
 12. Variation in vertical alignment (how much the well casing varies from a truly plumb line) throughout its depth _____
 13. Disinfected by 2 ounces of Quat % Chlorine (Brand name Clorox)
- Property Owner John & Rita Jones Address Highland
Location of property Highland Rd

Health Department Number _____ Dept. of Water Resources Permit No. HO-66-W-28

Date: 8/8/66, 19____. Ed. Brown
Signature of Well Driller

INSTRUCTIONS: This form is to be completed in duplicate and certified by the well driller upon completion of each drilled well. One copy will be forwarded to the property owner by the Health Department along with the final approval of the well.

