

PERMIT

SEWAGE DISPOSAL SYSTEM

DEPARTMENT OF HEALTH AND MENTAL HYGIENE

HOWARD COUNTY HEALTH DEPARTMENT

BUREAU OF ENVIRONMENTAL HEALTH

461-9933

INDEXED

NO INST REQUEST AS OF
8/21/95
MAINTAIN PER HISTORICAL REFERENCE
(W)

P 48284

A REPAIR

DISTRICT _____

DATE 6/24/92

DATE SYSTEM APPROVED 6/24/92

PERMIT REQUESTED

INSPECTOR _____

Jack Fyock

IS PERMITTED TO INSTALL _____ ALTER X

ADDRESS _____ PHONE 988-9270

SUBDIVISION Triadelphia Mill Farms LOT 21, Sec. 1 ROAD 13958 Triadelphia Mill Road

PROPERTY OWNER Armstrong

13958 Triadelphia Mill Road

ADDRESS _____

SEPTIC TANK CAPACITY 1250 GALLONS

NUMBER OF BEDROOMS 4

_____ SQUARE FEET PER BEDROOM

LINEAR FEET OF TRENCH REQUIRED _____

REPAIR - PURPOSE - SEPTIC SYSTEM HAS FAILED #?)%?(@

9/22/91 According to the owner, the repair was performed in '92
but she doesn't remember the installer or the exact date of the
repair. ALM

PLANS APPROVED BY _____ DATE _____

COVER NO WORK UNTIL INSPECTED AND APPROVED

NEITHER THE HOWARD COUNTY COUNCIL NOR THE HEALTH DEPARTMENT IS RESPONSIBLE FOR THE SUCCESSFUL OPERATION OF ANY SYSTEM

NOTE: CLEANOUT REQUIRED EVERY 70 FEET OF SEWER LINE AND/OR AT 90° SWEEPS IN LINES FROM HOUSE TO DRAIN FIELDS, 90° ELBOWS NOT ACCEPTABLE.

NOTE: ALL PARTS OF SEPTIC SYSTEMS (I.E. TANK, DISTRIBUTION BOX TRENCHES) TO BE 100 FEET FROM WELL (UNLESS OTHERWISE SPECIFICALLY AUTHORIZED)

NOTE: IF DEEP TRENCH(ES) ARE USED CALL FOR INSPECTION BEFORE AND AFTER PLACING GRAVEL IN TRENCH(ES)

NOTE: NO DRY WELL SHALL EXCEED 15 FOOT IN DIAMETER NO ABSORPTION TRENCH TO EXCEED 100 FEET IN LENGTH

NOTE: ALL PIPE FROM HOUSE TO SEPTIC TANK MUST BE CAST IRON OR SCHEDULE 35/40 PVC OR ABS

PERMIT VOID AFTER TWO YEARS

NOTE: INSTALL STAND PIPE ON SEPTIC TANK AND DRY WELL STAND PIPES MUST BE 6 INCHES IN DIAMETER CAST IRON. CONCRETE OR TERRA COTTA OR PVA OR ABS ACCEPTED. IF TOP OF SEPTIC TANK IS DEEPER THAN 3 FEET. MANHOLE TO GRADE REQUIRED.


NOTE: DISTRIBUTION BOXES MUST HAVE BAFFLES

*INSTALLER IS RESPONSIBLE FOR OBTAINING FINAL APPROVAL ON THIS PERMIT

HD-260(6-90)

*CALL 461-9933 FOR INSPECTION OF SEPTIC SYSTEM.

P 48286

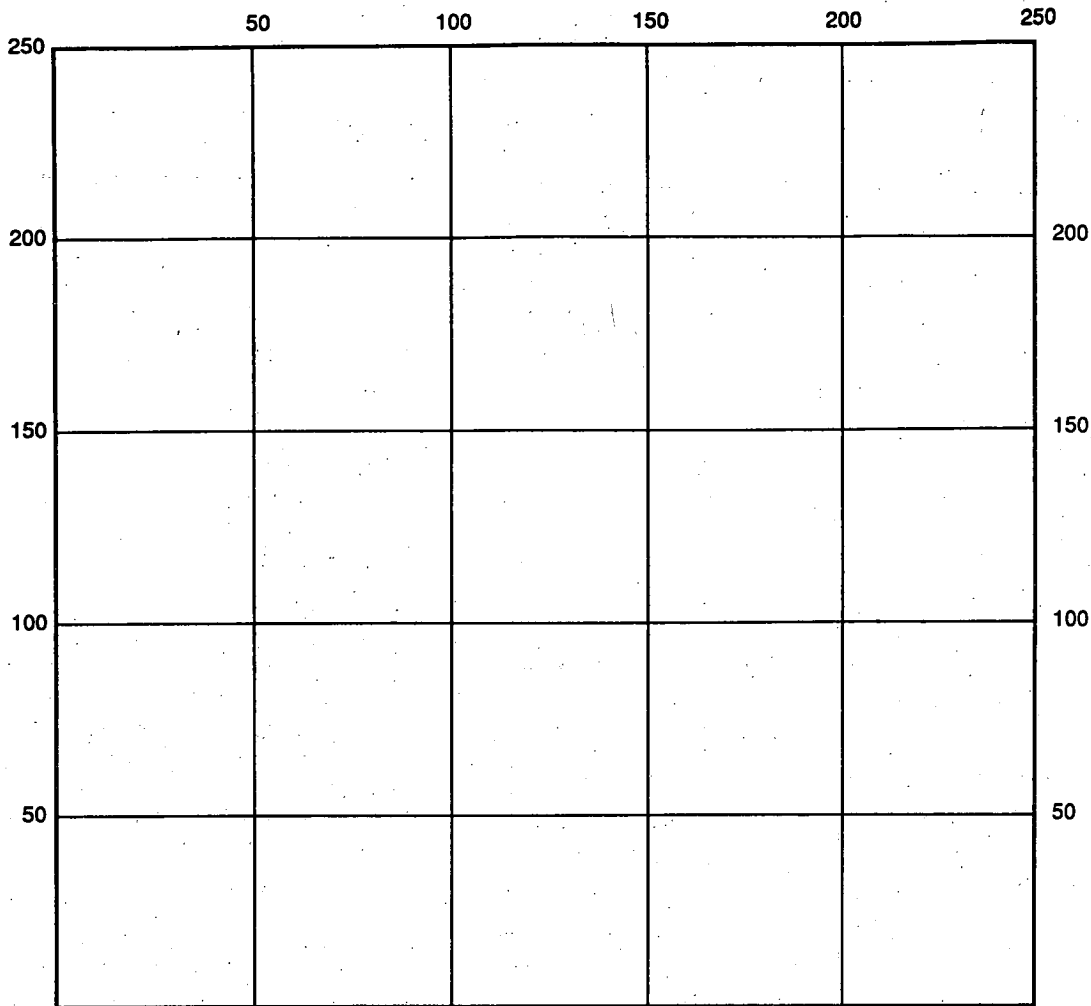

INDICATE NORTH - NAME ADJOINING ROADWAY AS BASE LINE

SEPTIC TANK LEVEL _____ CLEANOUTS _____

DISTRIBUTION BOX LEVEL _____

DRAIN FIELD/TITLE DEPTH _____ FT. TRENCH WIDTH _____ FT. INLET DEPTH _____ FT.

EFFECTIVE GRAVEL DEPTH _____ FT. TOTAL LENGTH _____ FT.

NUMBER OF TRENCHES _____ ONE SIDEWALL/BOTTOM AREA _____ SQ. FT.

DRYWALL INSIDE DIAMETER _____ FT. EFFECTIVE DEPTH BELOW INLET _____ FT.

ABSORBENT AREA _____ SQ. FT.

REMARKS: _____

DATE SYSTEM APPROVED _____ INSPECTOR _____

PERMIT

SEWAGE DISPOSAL SYSTEM

MARYLAND STATE DEPARTMENT OF HEALTH

HOWARD COUNTY

ELLICOTT CITY

DISTRICT 5th

DATE 7/30/81

INDEX

Paul Schissler

IS PERMITTED TO INSTALL ☒ ALTER

ADDRESS 7311 Brangles Road, Marriottsville, Md PHONE 795-2642

SUBDIVISION Triadelphia Mill Farms ROAD 13958 Triadelphia Mill Rd LOT 21, Sec. 1

PROPERTY OWNER Mr. Patrick Roddey

ADDRESS 13958 Triadelphia Mill Rd.

SPECIFICATIONS 4 Bedrooms

SEPTIC TANK CAPACITY 1250 GALLONS

DRAIN FIELD DEPTH FEET, BOTTOM AREA SQ. FT.

DEEP TRENCH DEPTH FEET, BOTTOM AREA SQ. FT.

SEEPAGE PITS ☒ ABSORBENT SIDE-WALL AREA 160 SQ. FT. per bedroom

INLET PIPE 3 FT. BELOW ORIGINAL GRADE, MAXIMUM DEPTH 10 FT. BELOW ORIGINAL GRADE

EFFECTIVE DEPTH AT FT. BELOW ORIGINAL GRADE.

LOCATE DISPOSAL AREA 60 FT. FROM right LOT LINE AND 130 (down right lot line) right for xxxxxxxxxx corn

point of lot when FACING LOT FROM Triadelphia Mill Rd.

NOTE: If trench used with dry well - need: 1. 5' earth buffer between trench and dry well
2. Two inspections of trench before and after stone in. 3. Run trench on contour.

DRY WELL: Okay to use trench off dry well to make up absorbent sidewall area in system
leave 5' earth buffer between trench and dry well. Trench to follow contour of the land.

PLANS APPROVED BY Mr. C. B. Streaker

DATE 12/14/79

COVER NO WORK UNTIL INSPECTED AND APPROVED.

NEITHER THE HOWARD COUNTY COUNCIL NOR THE HEALTH DEPARTMENT IS RESPONSIBLE FOR THE SUCCESSFUL OPERATION OF ANY SYSTEM.

NOTE: IF TRENCH IS USED CALL FOR INSPECTION BEFORE PLACING GRAVEL IN TRENCH.


NOTE: NO DRY WELL SHALL EXCEED 15 FOOT IN DIAMETER.

NOTE: ALL PIPE FROM HOUSE TO DISPOSAL AREA MUST BE CAST IRON.

PERMIT VOID AFTER THREE YEARS.

NOTE: INSTALL STAND PIPE ON SEPTIC TANK AND DRY WELL. STAND PIPES MUST BE 6 INCHES IN DIAMETER. CAST IRON, CONCRETE OR TERRA COTTA ACCEPTED.

*INSTALLER IS RESPONSIBLE FOR OBTAINING FINAL APPROVAL ON THIS PERMIT.

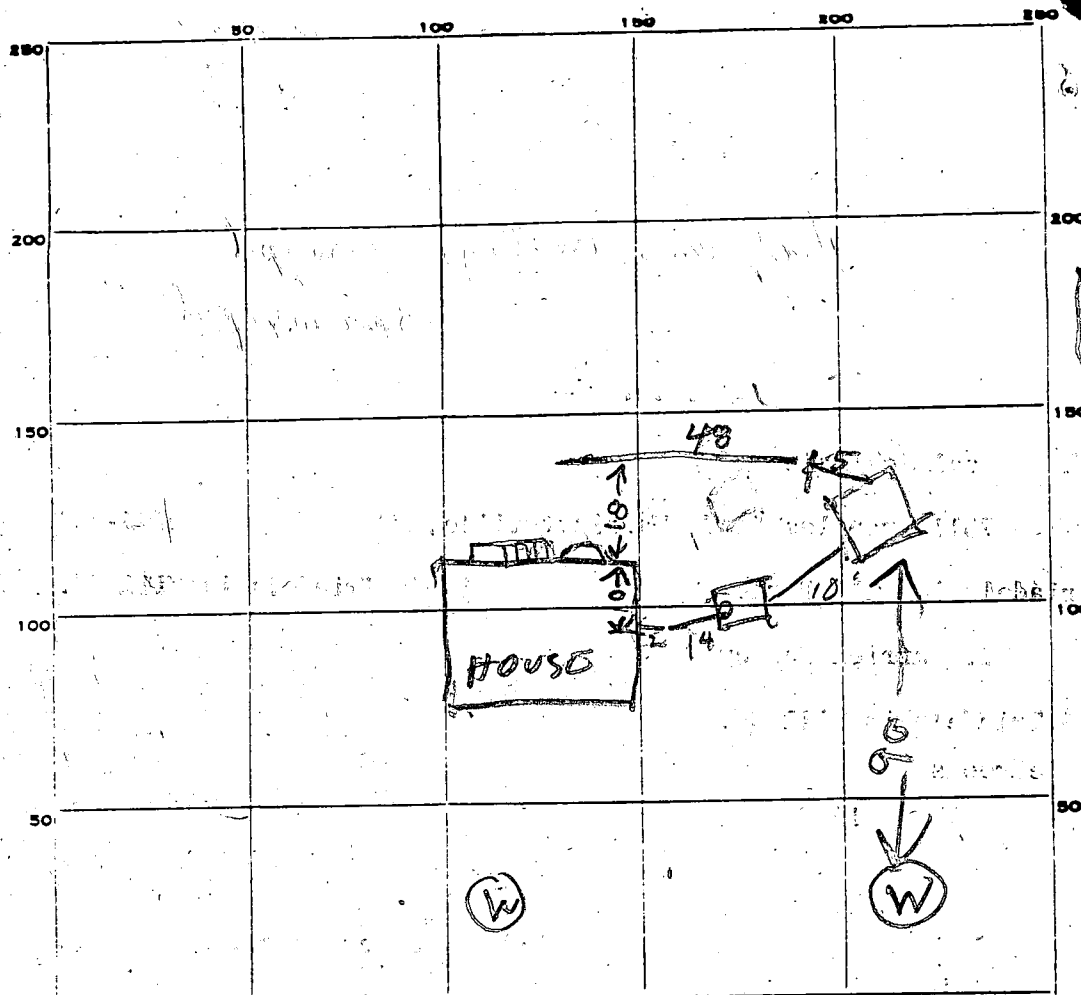

48
7
336
336
672

PERMIT CARD YES TRIPOLPHIA MILL RT

SEPTIC TANK, LEVEL OK 1500-76 CLEANOUTS OK NO

DISTRIBUTION BOX, LEVEL _____

TILE FIELD, DEPTH 10 1/2 FT. TRENCH WIDTH 2 FT.

GRAVEL DEPTH 7 IN. TOTAL LENGTH 48 FT.

NUMBER OF TRENCHES 1 TOTAL BOTTOM AREA 336

SEEPAGE PITS, INSIDE DIAMETER 48 FT. DEPTH BELOW INLET 7 FT.

ABSORBENT AREA 336 SQ. FT.

672 sq ft

REMARKS 7/31/81 DW House 11 FT B.O.C. LOCATION OK.
OK TO COVER TANK FINISH DW & DITCH & CALL R/W
8/3/81 cover and work SLC

DATE SYSTEM APPROVED 8/3/81 INSPECTOR Stephen A. Kuhl

APPLICATION

A 29068

SEWAGE DISPOSAL TESTING

P _____

STATE OF MARYLAND - DEPARTMENT OF HEALTH AND MENTAL HYGIENE

HOWARD COUNTY HEALTH DEPARTMENT
ENVIRONMENTAL HEALTH SERVICES

P. O. BOX 476, ELLICOTT CITY, MARYLAND 21043
TELEPHONE: 465-5000, EXT. 356

DISTRICT 5th

DATE 10/10/78

SEE ATTACHED SPEC SHEET

BLDG. PERMIT SIGNED
AND RETURNED 4/28/81
Serial # 46133
AND RETURNED _____

TO: THE COUNTY HEALTH OFFICER
ELLICOTT CITY, MARYLAND

I, HEREBY, APPLY FOR THE NECESSARY TEST IN ORDER TO CONSTRUCT (OR RECONSTRUCT) A SEWAGE DISPOSAL SYSTEM.

PROPERTY OWNER Tridelphia Mill Farms Partnership

@ Richard Hallowell

ADDRESS Sandy Spring, Md. 20860 PHONE 286-2988

PROPERTY LOCATION:

Tridelphia Mill Farms

SUBDIVISION

On N & S sides of Tridelphia Mill Rd 1,500' E of

ROAD AND DESCRIPTION Greenbridge Rd, 5th Dist. Dayton

SIZE OF LOT 3.19 acres

Final #21
6 - Sheet 2
LOT NO. 6
4 becm, single family dwg.

TYPE BLDG. _____
NUMBER OF BEDROOMS _____

IF NOT SINGLE RESIDENCE DESCRIBE _____

THE SYSTEM INSTALLED UNDER THIS APPLICATION IS ACCEPTABLE ONLY UNTIL PUBLIC FACILITIES BECOME AVAILABLE.

SIGNATURE OF APPLICANT Richard Hallowell

APPROVED BY C. B. Streaker

FOR

DRY WELL DATE 12/14/79

(KIND OF SYSTEM)

REJECTED BY _____

FOR

Dry Well + trench

(KIND OF SYSTEM)

DATE _____

HOLD PENDING FURTHER TESTS _____

DATE _____

REASONS FOR REJECTION OR HOLDING _____

THIS IS NOT A PERMIT

Final #21

#6 sheet 2

#2
8/10/10


Field sheet

Tests

per stake

366
depth

Circle
Stake

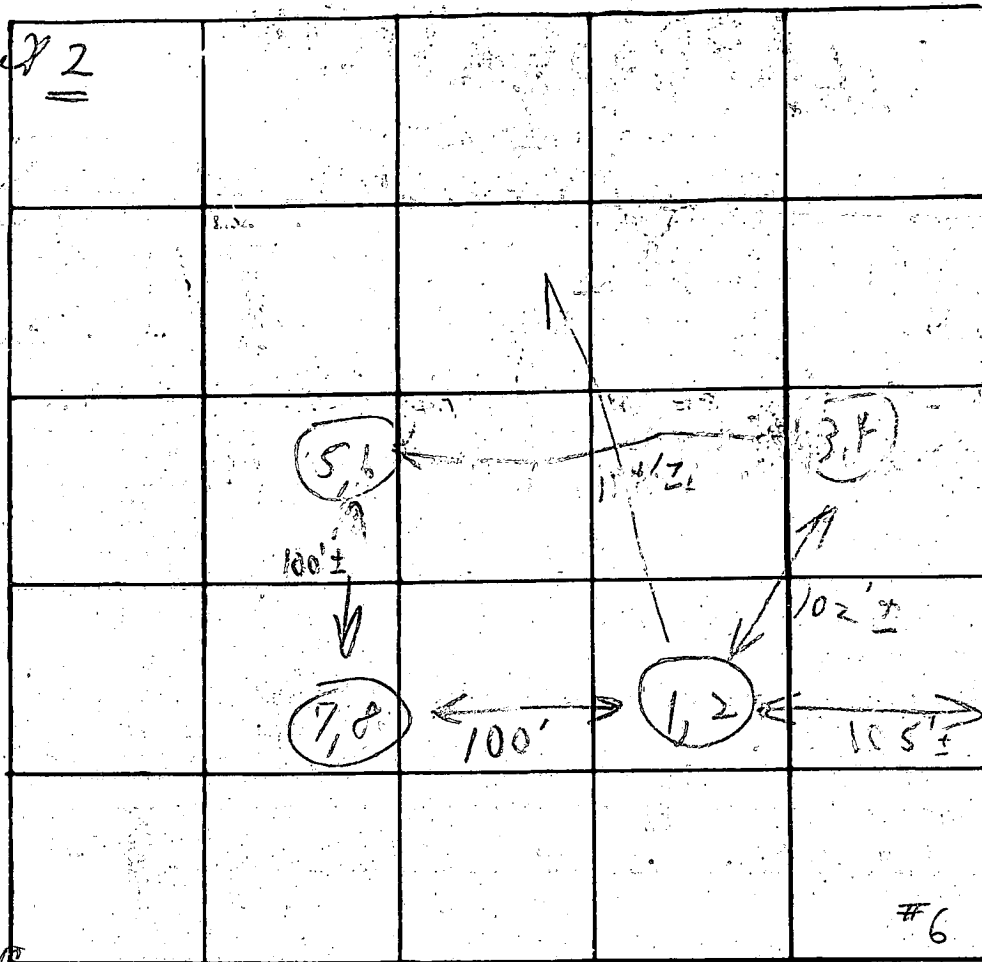

Fence
Fence

195'

#6

Edge of Rd

INDICATE NORTH - NAME ADJOINING ROADWAY AS BASE LINE

Philadelphia Rd

Soil Test

Below
floor
mud
level

DATE	TEST NO.	DEPTH	PRE-WET		TEST - 1" DROP		TIME
			START	STOP	START	STOP	
11/29/78	1	3'	4:04	4:06	4:06	4:08	2
	(H) 2	12 1/2'	4:06	4:13	4:13	4:36	23m
	3	3 1/2'	4:10	4:11	4:11	4:12	1m
	4	12 1/2'	3:51	4:09	4:09	4:31	22m
	5	3 1/2'	3:48	3:58	3:58	4:09	11m
	6	12 1/2'	3:47	4:00	4:00	4:26	26
	7	3'	3:44	3:45	3:45	3:46	1m
	8	12 1/2'	3:43	3:45	3:45	3:57	12m
						8	98

3' checked

13
avg

REMARKS

Open corn field

starting from

TYPE OF SOIL

TESTED BY

C. B. d

ALSO PRESENT:

P. Schuler & son

Date Received
(WRA use only)

4/16/81

DATE WELL COMPLETED

Depth of Well
260
(TO NEAREST FOOT)

PERMIT NO.
FROM "PERMIT TO DRILL WELL"
40-73-3865

OWNER LEBINE, RICHARD
last name first name

STREET OR RFD 2917 WOODWICK CT. TOWN FALLCOTT CITY, MD.

SUBDIVISION Triadelphia Mill Farm SECTION 1 LOT 21

WELL LOG		
Not required for driven wells		
STATE THE KIND OF FORMATIONS PENETRATED, THEIR COLOR, DEPTH, THICKNESS AND IF WATER BEARING		
DESCRIPTION (Use additional sheets if needed)	FEET	Check if water bearing
FROM	TO	
TOP SOIL	0 2	
SHALEY	2 10	
BROWN SLATE	10 65	
SANDSTONE	65 90	
FLINT	90 95	J
SHALEY	95 105	
FLINT	105 120	
BROWN SLATE	120 145	
FLINT	145 150	J
MICA	150 160	J
FLINT	160 190	
MICA	190 250	
GRAVEL BED	250 255	J
MICA	255 260	

WELL HAS BEEN GROUTED
(Circle Appropriate Box) YES ☒ NO ☐

TYPE OF GROUTING MATERIAL
CEMENT ☒ BENTONITE CLAY ☐

NO. OF BAGS 15 NO. OF POUNDS 1500

GALLONS OF WATER 45

DEPTH OF GROUT SEAL (to nearest foot)
from 0 ft. to 60 ft.
(enter 0 if from surface)

CASING RECORD

casing types
insert appropriate code below

ST

STEEL

CO

CONCRETE

PL

PLASTIC

OT

OTHER

MAIN CASING TYPE ST Nominal diameter top(main) casing (nearest inch) 6 Total depth of main casing (nearest foot) 71

OTHER CASING (if used)
diameter (inch) depth (feet) to

EACH CASING

SCREEN RECORD

screen type or open hole

insert appropriate code below

ST

STEEL

BR

BRASS

PL

PLASTIC

HO

OPEN HOLE

OT

OTHER

DEPTH (nearest ft.) 69 260

EACH SCREEN

SLOT SIZE 1 2 3

DIAMETER OF SCREEN (NEAREST INCH) from to

GRAVEL PACK

IF WELL DRILLED WAS FLOWING WELL CIRCLE BOX ☐

WRA USE ONLY (NOT TO BE FILLED IN BY DRILLER)

T (E.R.O.S.)

W Q

70 72 74 75 76

TELESCOPE CASING LOG INDICATOR OTHER DATA

C 3 (seq no)

PUMPING TEST

HOURS PUMPED (nearest hour) 3

PUMPING RATE (gal. per min. to nearest gal.) 30

METHOD USED TO MEASURE PUMPING RATE BUCKET

WATER LEVEL (distance from land surface)
BEFORE PUMPING 75
WHEN PUMPING 260

TYPE OF PUMP USED (for test)
☒ air ☐ piston ☐ turbine
☐ centrifugal ☐ rotary ☐ other (describe below)
☐ jet ☐ submersible

PUMP INSTALLED YES ☒ NO ☐

DRILLER WILL INSTALL PUMP (CIRCLE APPROPRIATE BOX) ☒

IF DRILLER INSTALLS PUMP, THIS SECTION MUST BE COMPLETED FOR ALL WELLS EXCEPT HOME USE

TYPE OF PUMP (WRITE APPROPRIATE LETTER IN BOX - SEE ABOVE: (A, C, J, P, R, S, T, O))

CAPACITY: GALLONS PER MINUTE (to nearest gallon) 31 35

PUMP HORSE POWER 37 41

PUMP COLUMN LENGTH (nearest ft.) 43 47

CASING HEIGHT (circle appropriate box and enter casing height)
☒ above ☐ below 2 (nearest foot)

LOCATION OF WELL ON LOT

SHOW PERMANENT STRUCTURE SUCH AS BUILDING, SEPTIC TANKS, AND/OR LANDMARKS AND INDICATE NOT LESS THAN TWO DISTANCES (MEASUREMENTS TO WELL)

DRIVE WAY

WELL 60'

100'

TRIDELPHIA MILL RD.

CIRCLE APPROPRIATE BOX

☐ A WELL WAS ABANDONED AND SEALED WHEN THIS WELL WAS COMPLETED

☐ ELECTRIC LOG OBTAINED

☐ TEST WELL CONVERTED TO PRODUCTION WELL

I HEREBY CERTIFY THAT I HAVE COMPLIED WITH ALL CONDITIONS STATED ON THE ABOVE-CAPTIONED "PERMIT TO DRILL WELL", AND THAT INFORMATION CONTAINED IN THIS REPORT IS TRUE, ACCURATE, AND COMPLETE TO THE BEST OF MY KNOWLEDGE, INFORMATION AND BELIEF.

DRILLERS IDENT. NO. 40

DRILLERS SIGNATURE George A. Carter

(MUST MATCH SIGNATURE ON APPLICATION)

SITE SUPERVISOR (sign of driller or journeyman responsible for sitework if different from permittee)

TRIDELPHIA MILL ROAD

N 29° 57' 00" W 153.01

N 40° 17' 32" W 103.63
L = 340.0
R = 1170.1

LOT 20

N 68° 02' 26" E

555.43'

LOT 21
3.00 AC.

S 22° 53' 23" E 245.03'

S 68° 02' 26" W

499.68

A - Primary Well

B - Secondary (Discharge) Well

HOUSE:

FIRST FLOOR ELEV. 378.50
BASEMENT ELEV. 369.50
INVERT @ HOUSE 375.24

SEPTIC TANK:

EXISTING GRADE 377.00
PROPOSED GRADE 377.00
INVERT OF TANK 374.82

DRYWELL:

15x15x7

EXISTING GRADE 377.30
PROPOSED GRADE 377.30
INVERT 374.30

TRENCH:

INVERT	GRADE	LENGTH	DEPTH
374.00	0.0%	35'	3" to 10"

I certify the above measurements and elevations are actual and true for this property.

J. Carl Hudgins


J. Carl Hudgins

4/28/81
Sketch O.N. & S.

GRADING STUDY LOT 21

TRIDELPHIA MILL FARMS
SECTION 1 AREA 1

5th Election District
Howard County, Maryland
Scale: 1" = 100'
Date: 1-26-81

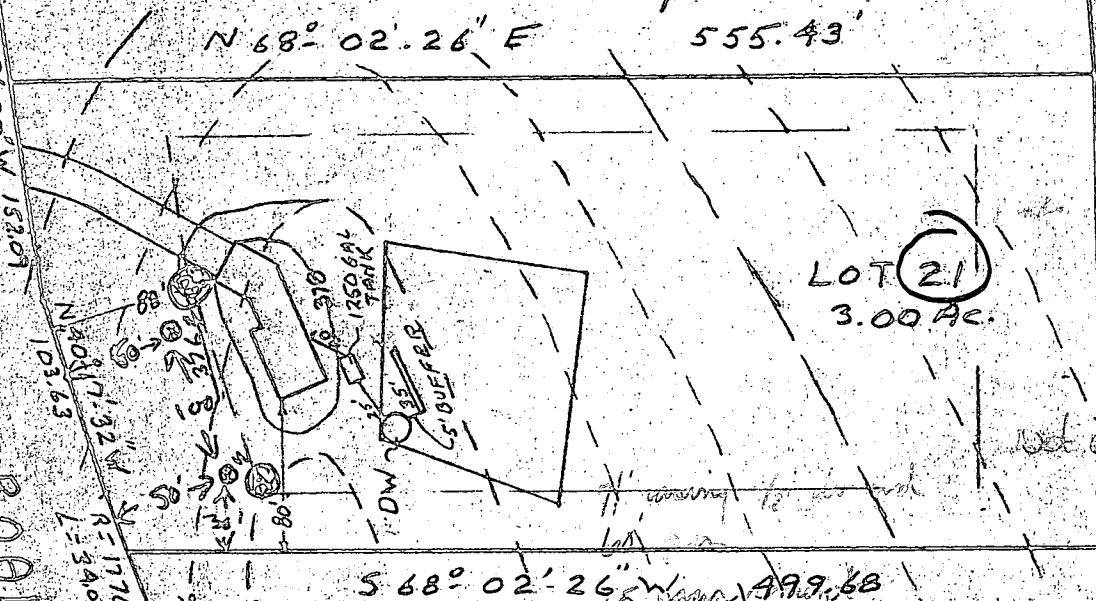

N 68° 02' 26" E

555.43

LOT 21
300 AC

5220-53-23

5 68° 02' 26" W 1499.68

A- Primary Well (HD-73-3866) ←
B- Secondary (Discharge) Well

location of S.S.
was the

45/55 *elk* OK 9.7.73/81

HOUSE:
FIRST FLOOR ELEV. 378.50
BASEMENT ELEV. 369.50
INVERT @ HOUSE 375.24

SEPTIC TANK:	
EXISTING GRADE	377.00
PROPOSED GRADE	377.00
INVERT OF TANK	374.82

DRYWELL:	15x15x7
EXISTING GRADE	377.30
PROPOSED GRADE	377.30
INVERT	374.30

INVERT	GRADE	LENGTH
374.00	0.0%	35' 3

I certify the above measurements
and elevations are actual and true
for this property.

GRADING STUDY LOT 21

TRIDELPHIA MILL FARMS
SECTION 1 AREA 1

5th Election District
Howard County, Maryland
Scale 1" = 100'
Date 1-26-81

J. Carl Hudgins

APPLICATION FOR A PERMIT TO APPROPRIATE AND USE WATERS OF THE STATE

Water Resources Administration
Water Supply Section
Tawes Office Building
Annapolis, Maryland 21401

☐ Surface Water ☒ Groundwater ☐ New Application ☐ Change in Existing Permit

Number _____

APPLICATION

Lebens Richard 461-2244
(Owner's Name) (Telephone Number)
2917 Woodwick Ct Elliott City Md 21043
(Owner's Address) (Street) (Town) (State) (Zip Code)

WITHDRAWAL

GROUNDWATER

Appropriate and use a yearly average of

1000 gallons per day,
(total annual use ÷ 365 days)
and 5,000 gallons
(highest total monthly use ÷ days in month)
for the average day of the maximum month, from

1 well(s) having a diameter of
(number)
6 inches, and a depth of
(estimate)
200 ft.
(estimate)

SURFACE WATER

Appropriate and use a yearly average of

_____ gallons per
(total annual use ÷ 365 days)
day, and a maximum use of _____
gallons in any one day, from:

_____ (name of stream)
_____ (exact location of withdrawal)

PROJECT LOCATION

Triadelphia Mill Farm lot 21 Sec 1
(Location -- be specific)

County Howard Subdivision or town Oxylon Phone number 461-2244

Name and type of business Single home

ALL APPLICATIONS MUST INCLUDE A COPY OF A U.S.G.S. TOPOGRAPHIC OR SIMILAR MAP SHOWING PROJECT

PURPOSE

- The water will be used for:
- ☐ Community Water Supply
 - ☐ Non-Potable supply (sanitary uses, not for drinking water)
 - ☒ Potable Supply (drinking water, etc.)
 - ☐ Cooling Water
 - ☐ Irrigation
 - ☐ Process Water
 - ☐ Other Heat Pump
(explain)

WASTEWATER TREATMENT AND DISPOSAL

- ☐ Public Sewer _____
(name of system)
- ☐ Groundwater
 - ☐ Subsurface (tilefield, seepage pit, etc.)
 - ☐ Spray Irrigation
 - ☐ Other, explain _____
- ☐ Surface Water _____
(name of stream)

Discharge Permit # _____
or applied for _____

SIGNATURE

Please sign here

George F. Easterday
(signature)
George F. Easterday agent
(please print name, title, and date here)

**THIS APPLICATION CANNOT BE
PROCESSED
WITHOUT SIGNATURE**

APPROVAL BY COUNTY HEALTH DEPARTMENT OR DESIGNATED AGENCY

THIS SECTION NOT TO BE COMPLETED BY APPLICANT

Is this Project consistent with the County Water and Sewerage Plan and local planning and zoning?

☒ YES ☐ NO, explain _____

Signature of county
representative

Frank Skinner Sanitarian
(signature) (title)

4/6/81
(date)

C 1 8443 (THIS NUMBER IS TO BE PUNCHED IN COLS. 3-6 ON ALL CARDS)		SEQUENCE NO. (WRA USE ONLY)		STATE OF MARYLAND WATER RESOURCES ADMINISTRATION TAWES STATE OFFICE BLDG., ANNAPOLIS, MD. 21401 WELL COMPLETION REPORT		THIS REPORT MUST BE SUBMITTED WITHIN 30 DAYS AFTER WELL COMPLETION FILL IN THIS FORM COMPLETELY																																																					
DATE RECEIVED (WRA USE ONLY)		DEPTH OF WELL DATE WELL COMPLETED <u>2/10/81</u> 22 (TO NEAREST FOOT) 26		PERMIT NO. FROM "PERMIT TO DRILL WELL" <u>44-73-3366</u> 28 29 30 31 32 33 34 35 36 37		COUNTY NUMBER <u>A29064</u>																																																					
OWNER <u>LEBLING RICHARD</u> LAST NAME		STREET OR RFD <u>2419 Woodrow Ct</u> LOT <u>21</u> , SEC. <u>1</u>		FIRST NAME <u>TRI-DELPHIA</u> POST OFFICE <u>Forest C. Md.</u>		DRILLERS IDENTIFICATION NO. <u>HO</u>																																																					
WELL LOG STATE THE KIND OF FORMATIONS PENETRATED, THEIR COLOR, DEPTH, THICKNESS AND IF WATER BEARING		GROUTING RECORD WELL HAS BEEN GROUTED (CIRCLE APPROPRIATE BOX) YES ☒ NO ☐ TYPE OF GROUTING MATERIAL (CIRCLE BOX) CEMENT ☒ BENTONITE CLAY ☐ NO. OF BAGS <u>15</u> NO. OF POUNDS <u>1500</u> GALLONS OF WATER <u>75</u> DEPTH OF GROUT SEAL (TO NEAREST FOOT) FROM <u>0</u> FT. TO <u>60</u> FT. (ENTER 0 IF FROM SURFACE)		PUMPING TEST HOURS PUMPED (TO NEAREST HOUR) <u>3</u> PUMPING RATE (GALLONS PER MINUTE TO NEAREST GALLON) <u>30</u> METHOD USED TO MEASURE PUMPING RATE <u>RUN RATE</u> WATER LEVEL: (DISTANCE FROM LAND SURFACE) BEFORE PUMPING <u>60</u> (NEAREST FOOT) WHEN PUMPING <u>2</u> (NEAREST FOOT) TYPE OF PUMP USED (CIRCLE APPROPRIATE BOX) ☒ AIR ☐ PISTON ☐ TURBINE ☐ CENTRIFUGAL ☐ ROTARY ☐ OTHER (DESCRIBE BELOW) ☐ JET ☐ SUBMERSIBLE																																																							
<table border="1" style="width:100%; border-collapse: collapse;"> <thead> <tr> <th rowspan="2">DESCRIPTION (USE ADDITIONAL SHEETS IF NECESSARY)</th> <th colspan="2">FEET</th> <th rowspan="2">CHECK IF WATER BEARING</th> </tr> <tr> <th>FROM</th> <th>TO</th> </tr> </thead> <tbody> <tr><td>TOP SOIL</td><td>0</td><td>2</td><td></td></tr> <tr><td>CLAY</td><td>2</td><td>5</td><td></td></tr> <tr><td>SHALEY</td><td>5</td><td>10</td><td></td></tr> <tr><td>BROWN SLATE</td><td>10</td><td>68</td><td></td></tr> <tr><td>SANDSTONE</td><td>68</td><td>90</td><td>✓</td></tr> <tr><td>MICA</td><td>90</td><td>185</td><td></td></tr> <tr><td>CORT.</td><td>185</td><td>200</td><td>✓</td></tr> <tr><td>MICA</td><td>200</td><td>225</td><td></td></tr> <tr><td>FLINT</td><td>225</td><td>228</td><td></td></tr> <tr><td>MICA</td><td>228</td><td>250</td><td></td></tr> <tr><td>GRAVEL BED</td><td>250</td><td>254</td><td>✓</td></tr> <tr><td>MICA</td><td>254</td><td>260</td><td></td></tr> </tbody> </table>		DESCRIPTION (USE ADDITIONAL SHEETS IF NECESSARY)	FEET		CHECK IF WATER BEARING	FROM	TO	TOP SOIL	0	2		CLAY	2	5		SHALEY	5	10		BROWN SLATE	10	68		SANDSTONE	68	90	✓	MICA	90	185		CORT.	185	200	✓	MICA	200	225		FLINT	225	228		MICA	228	250		GRAVEL BED	250	254	✓	MICA	254	260		CASING RECORD Casing Types: INSERT APPROPRIATE CODE BELOW STEEL ☐ CONCRETE ☐ PLASTIC ☐ OTHER ☐ MAIN CASING TYPE ☒ <u>ST</u> NOMINAL DIAMETER TOP (MAIN) CASING (NEAREST INCH) <u>6</u> TOTAL DEPTH OF MAIN CASING (NEAREST FOOT) <u>77</u>		PUMP INSTALLED TYPE OF PUMP (WRITE APPROPRIATE LETTER IN BOX - SEE ABOVE: A, C, J, P, R, S, T, O) DRILLER WILL INSTALL PUMP (CIRCLE APPROPRIATE BOX) YES ☒ NO ☐ CAPACITY: GALLONS PER MINUTE (TO NEAREST GALLON) <u>31</u> <u>35</u> PUMP HORSE POWER <u>37</u> <u>41</u> PUMP COLUMN LENGTH (NEAREST FOOT) <u>43</u> <u>47</u>	
DESCRIPTION (USE ADDITIONAL SHEETS IF NECESSARY)	FEET		CHECK IF WATER BEARING																																																								
	FROM	TO																																																									
TOP SOIL	0	2																																																									
CLAY	2	5																																																									
SHALEY	5	10																																																									
BROWN SLATE	10	68																																																									
SANDSTONE	68	90	✓																																																								
MICA	90	185																																																									
CORT.	185	200	✓																																																								
MICA	200	225																																																									
FLINT	225	228																																																									
MICA	228	250																																																									
GRAVEL BED	250	254	✓																																																								
MICA	254	260																																																									
SCREEN RECORD SCREEN TYPE OR OPEN HOLE INSERT APPROPRIATE CODE BELOW STEEL ☐ BRASS OR BRONZE ☐ OPEN HOLE ☐ PLASTIC ☐ OTHER ☐ C 2 DEPTH (NEAREST WHOLE FOOT) FROM <u>75</u> TO <u>260</u> SLOT SIZE 1. <u>23</u> 2. <u>24</u> 3. <u>26</u>		OTHER CASING (IF USED) DIAMETER (INCH) <u>6</u> DEPTH (FEET) FROM <u>75</u> TO <u>260</u>		CASING HEIGHT (CIRCLE APPROPRIATE BOX AND ENTER CASING HEIGHT) ☒ ABOVE ☐ BELOW LAND SURFACE <u>2</u> (NEAREST FOOT)																																																							
CIRCLE APPROPRIATE BOXES ☐ A WELL WAS ABANDONED AND SEALED WHEN THIS WELL WAS COMPLETED ☐ E ELECTRIC LOG OBTAINED ☐ P TEST WELL CONVERTED TO PRODUCTION WELL I HEREBY CERTIFY THAT I HAVE COMPLIED WITH ALL CONDITIONS STATED ON THE ABOVE-CAPTIONED "PERMIT TO DRILL WELL", AND THAT INFORMATION CONTAINED IN THIS REPORT IS TRUE, ACCURATE, AND COMPLETE TO THE BEST OF MY KNOWLEDGE, INFORMATION AND BELIEF. DRILLERS NAME <u>George T. Eastwood</u> (PLEASE PRINT) <u>George T. Eastwood</u> SIGNATURE <u>George T. Eastwood</u>		DETERMINED BY DRILLER WRA USE ONLY (NOT TO BE FILLED IN BY DRILLER) T ☐ (E.R.O.S.) ☐ W Q ☐ TELESCOPE CASING ☐ LOG INDICATOR ☐ OTHER DATA AVAILABLE ☐		LOCATION OF WELL ON LOT SHOW PERMANENT STRUCTURE SUCH AS BUILDINGS, SEPTIC TANKS, AND/OR OTHER LAND MARKS AND INDICATE NOT LESS THAN TWO DISTANCES (MEASUREMENTS TO WELL). WELL 100'																																																							