

PERMIT

SEWAGE DISPOSAL SYSTEM

DEPARTMENT OF HEALTH AND MENTAL HYGIENE

P 511589

A 49027

DISTRICT _____

HOWARD COUNTY HEALTH DEPARTMENT
BUREAU OF ENVIRONMENTAL HEALTH

DATE 5-17-1999

~~410-313-2640~~ 410-313-2640

DATE SYSTEM APPROVED 5/25/99

INDEXED

INSPECTOR S.R.K

Covey Construction Co. Inc. IS PERMITTED TO INSTALL ALTER _____

ADDRESS P.O. Box 254, Woodstock, Maryland 21163 PHONE _____

SUBDIVISION Daisy Road Property LOT 2 ROAD 1623 Daisy Road

PROPERTY OWNER NU-Homes, Inc.

ADDRESS _____

SEPTIC TANK CAPACITY 1250 GALLONS

NUMBER OF BEDROOMS 4

210 SQUARE FEET PER BEDROOM

LINEAR FEET OF TRENCH REQUIRED 280

TRENCHES - Trench to be 3 feet wide. Inlet 3.5 feet below original grade. Bottom maximum depth 5 feet below original grade. Effective area begins at 4 feet below original grade. 1.5 feet of stone below distribution pipe.

LOCATION - Place the distribution box 145 feet off the 165.00' lot line and 60 feet off the 862.33' lot line as seen when facing the lot from daisy Road. Trenches to follow contour towards the 862.33' lot line.

NOTES - No trench to exceed 100 feet in length. Provide 6" - 8" diameter cleanout and cap to grade or above on septic tank. 3/25/99 OK AU

PLANS APPROVED BY Glen Savage/Donna K. Soe DATE 03-23-99

COVER NO WORK UNTIL INSPECTED AND APPROVED

NEITHER THE HOWARD COUNTY COUNCIL NOR THE HEALTH DEPARTMENT IS RESPONSIBLE FOR THE SUCCESSFUL OPERATION OF ANY SYSTEM

NOTE: CLEANOUT REQUIRED EVERY 70 FEET OF SEWER LINE AND/OR AT 90° SWEEPS IN LINES FROM HOUSE TO DRAIN FIELDS, 90° ELBOWS NOT ACCEPTABLE.

NOTE: ALL PARTS OF SEPTIC SYSTEMS (I.E. TANK, DISTRIBUTION BOX TRENCHES) TO BE 100 FEET FROM WELL (UNLESS OTHERWISE AUTHORIZED)

NOTE: IF DEEP TRENCH(ES) ARE USED CALL FOR INSPECTION BEFORE AND AFTER PLACING GRAVEL IN TRENCH(ES)

NOTE: NO DRY WELL SHALL EXCEED 15 FOOT IN DIAMETER NO ABSORPTION TRENCH TO EXCEED 100 FEET IN LENGTH.

NOTE: ALL PIPE FROM HOUSE TO SEPTIC TANK MUST BE CAST IRON OR SCHEDULE 35/40 PVC OR ABS

PERMIT VOID AFTER TWO YEARS

NOTE: INSTALL STAND PIPE ON SEPTIC TANK AND DRY WELL STAND PIPES MUST BE 6 INCHES IN DIAMETER CAST IRON, CONCRETE OR TERRA COTTA OR PVA OR ABS ACCEPTED. IF TOP OF SEPTIC TANK IS DEEPER THAN 3 FEET, MANHOLE TO GRADE REQUIRED.

NOTE: DISTRIBUTION BOXES MUST HAVE BAFFLES


*INSTALLER IS RESPONSIBLE FOR OBTAINING FINAL APPROVAL ON THIS PERMIT

*CALL 461-9933 FOR INSPECTION OF SEPTIC SYSTEM.

BUILDING PERMIT SIGNED AND RETURNED

12204 800/51416-DECK SUNRM


49027

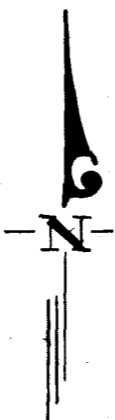

RICHARD TALLEY L. 195 F. 149
ZONE RC DEO

LEGEND

CONTOUR INTERVAL	2 FT.
EXISTING CONTOUR	340
PROPOSED CONTOUR	340
DIRECTION OF DRAINAGE	
WALK OUT BASEMENT	NOB
SPOT ELEVATION	+78.4
L.O.D.	L.O.D. — 17975.00 SF

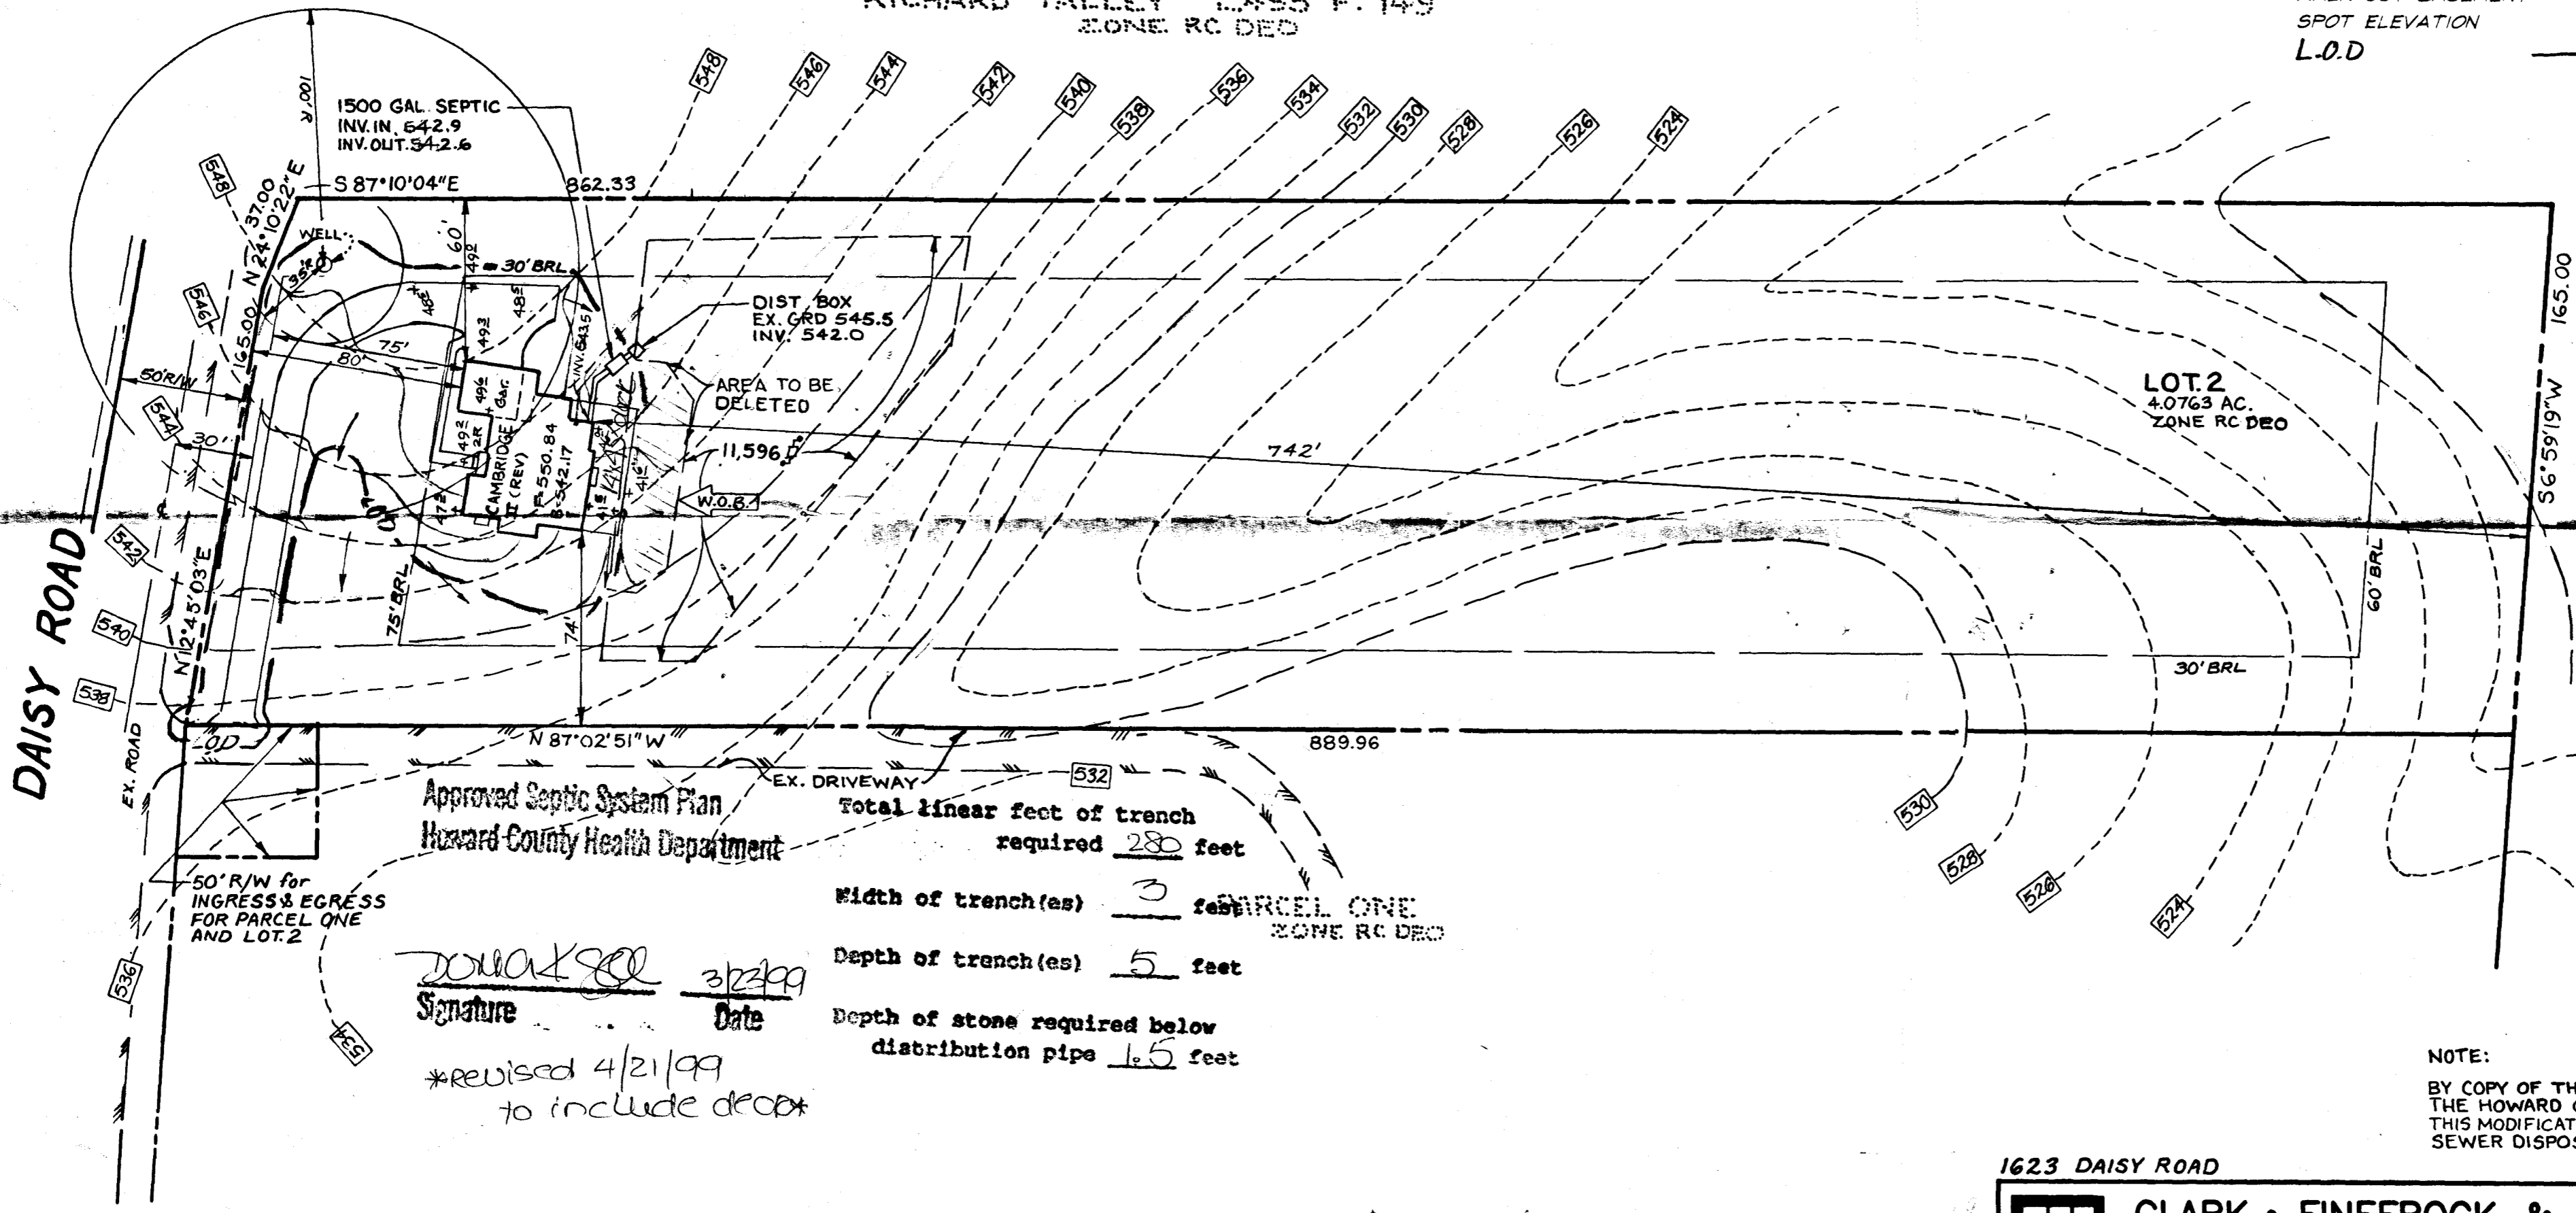

Approved Septic System Plan
Howard County Health Department

Total linear feet of trench
required 280 feet

Width of trench(es) 3 feet

Depth of trench(es) 5 feet

Depth of stone required below
distribution pipe 1.5 feet

Donna K. [Signature]
Signature


3/23/99
Date

*revised 4/21/99
to include decot

NOTE:
BY COPY OF THIS PLAN,
THE HOWARD COUNTY HEALTH DEPT. ACCEPTS
THIS MODIFICATION TO THE PLATTED
SEWER DISPOSAL EASEMENT.

1623 DAISY ROAD

CLARK • FINEFROCK & SACKETT, INC. ENGINEERS • PLANNERS • SURVEYORS 7135 MINSTREL WAY • COLUMBIA, MD 21045 • (410) 381-7500 BALT. • (301) 621-8100 WASH.		
DESIGNED	SITE DEVELOPMENT, TAX MAP 8 GRID 13 PAR. 345 LOT. 2 DAISY ROAD PROPERTY LIBER 3102 FOLIO 0009 FOURTH (4TH) ELECTION DISTRICT HOWARD COUNTY, MARYLAND	SCALE
JME		1" = 50'
DRAWN		DRAWING
KB		1 of 1
CHECKED		JOB NO.
JME		99-015
DATE		FILE NO.
3-5-99	FOR NLI-HOMES, INC. 10630 LITTLE PATUXENT PARKWAY, SUITE 146 COLUMBIA, MD 21044	99-015-X

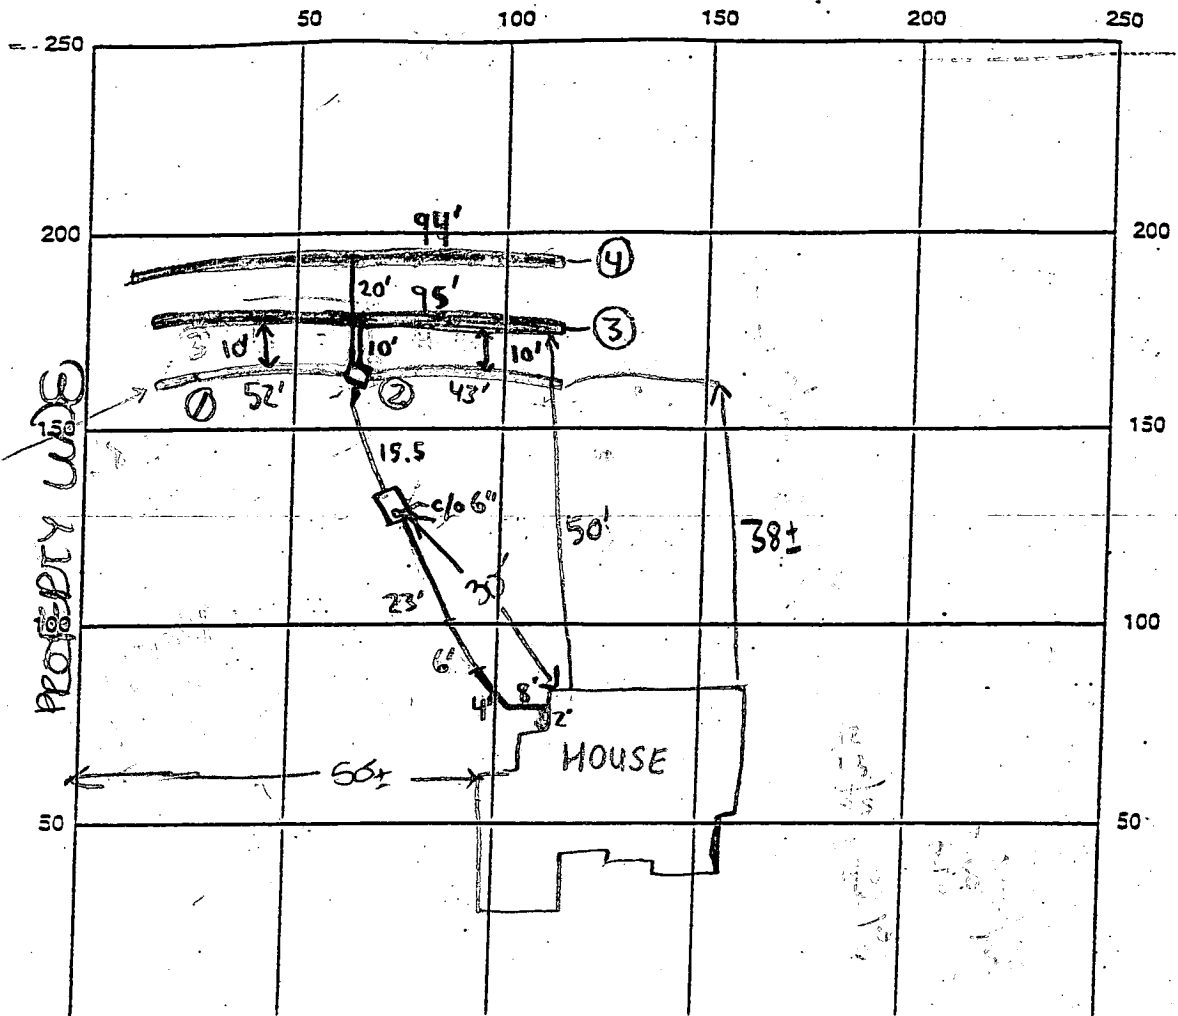

SEPTIC TANK LEVEL 1500 gallon midseam CLEANOUTS 1-6" @ tank

DISTRIBUTION BOX LEVEL

DRAIN FIELD/TITLE DEPTH 5 FT. TRENCH WIDTH 3 FT. INLET DEPTH 3.5 FT.

EFFECTIVE GRAVEL DEPTH 2 FT. ^{Told Contractor} TOTAL LENGTH 284 FT. ^{112/314} _{52/43/95/98}

NUMBER OF TRENCHES 4 ONE SIDEWALL/BOTTOM AREA 852 SQ. FT.

DRYWALL INSIDE DIAMETER N/A FT. EFFECTIVE DEPTH BELOW INLET N/A FT.

ABSORBENT AREA N/A SQ. FT.

REMARKS: 5/25/99 - ON TO COVER FROM HOUSE TO TANK, ON TO CONTINUE WORK - SRK

5/25/99 - ON TO COVER WORK - SRK
AND RETURN

DATE SYSTEM APPROVED 5/25/99 INSPECTOR Steven R. Krieg

APPLICATION

PERCOLATION TESTING

A 49029

previous ok cw

P _____

HOWARD COUNTY HEALTH DEPARTMENT
BUREAU OF ENVIRONMENTAL HEALTH
3525-H ELLICOTT MILLS DRIVE/ELLICOTT CITY, MARYLAND 21043
TELEPHONE: 313-2640

DISTRICT _____

DATE 3/5/93

TO: THE COUNTY HEALTH OFFICER
ELLICOTT CITY, MARYLAND

I HEREBY APPLY FOR THE NECESSARY TEST PRIOR TO APPLICATION FOR PERMIT TO CONSTRUCT (OR RECONSTRUCT) A SEWAGE DISPOSAL SYSTEM.

PROPERTY OWNER WU-HOMES, INC
DAVID C. JORDAN, JR. & SUZANNE SELBY JORDAN

ADDRESS 1627 DAISY RD PHONE 301-854-6789

AGENT OR PROSPECTIVE BUYER LIBERTY SURVEY, INC RAYMOND DAY

ADDRESS 4140 RIDGE RD TAYLORSVILLE MD PHONE 1-410-875-0722

PROPERTY LOCATION:

SUBDIVISION _____

ROAD AND DESCRIPTION _____

(1625 Daisy Road)

TAX MAP 8 PARCEL # 42

SIZE OF LOT 11.3 Ac. ±

TYPE BLDG. _____

(SINGLE FAMILY DWELLING OR COMMERCIAL)

PLAT BEING SHOWN

AND RETURNED

323 Shaded
Serial # BTD 116649

S.F.D. - 4Bom

THE SYSTEM INSTALLED UNDER THIS APPLICATION IS ACCEPTABLE ONLY UNTIL PUBLIC FACILITIES BECOME AVAILABLE. I FULLY UNDERSTAND THE

FEE CONNECTED WITH THE FILING OF THIS PERC TEST APPLICATION IS NON-REFUNDABLE UNDER ANY CIRCUMSTANCES. I ALSO AGREE TO

COMPLY WITH ALL M.O.S.H.A. REQUIREMENTS IN TESTING THIS LOT.

Raymond Day
(SIGNATURE OF APPLICANT)

* APPROVED BY C. Bl. Traker FOR Shallow systems only DATE 3/26/93

DISAPPROVED BY _____ FOR _____ DATE _____

HOLD PENDING FURTHER TESTS _____

REASONS FOR REJECTION OR HOLDING

3/26 * Need certified holes only - etc.
CBD


PERCOLATION TEST PLAT/PRELIMINARY PLAT - TITLE OR I.D. # _____

DATE _____

SITE DEVELOPMENT PLAN/FINAL PLAT - TITLE OR I.D. # _____

DATE _____

THIS IS NOT A PERMIT

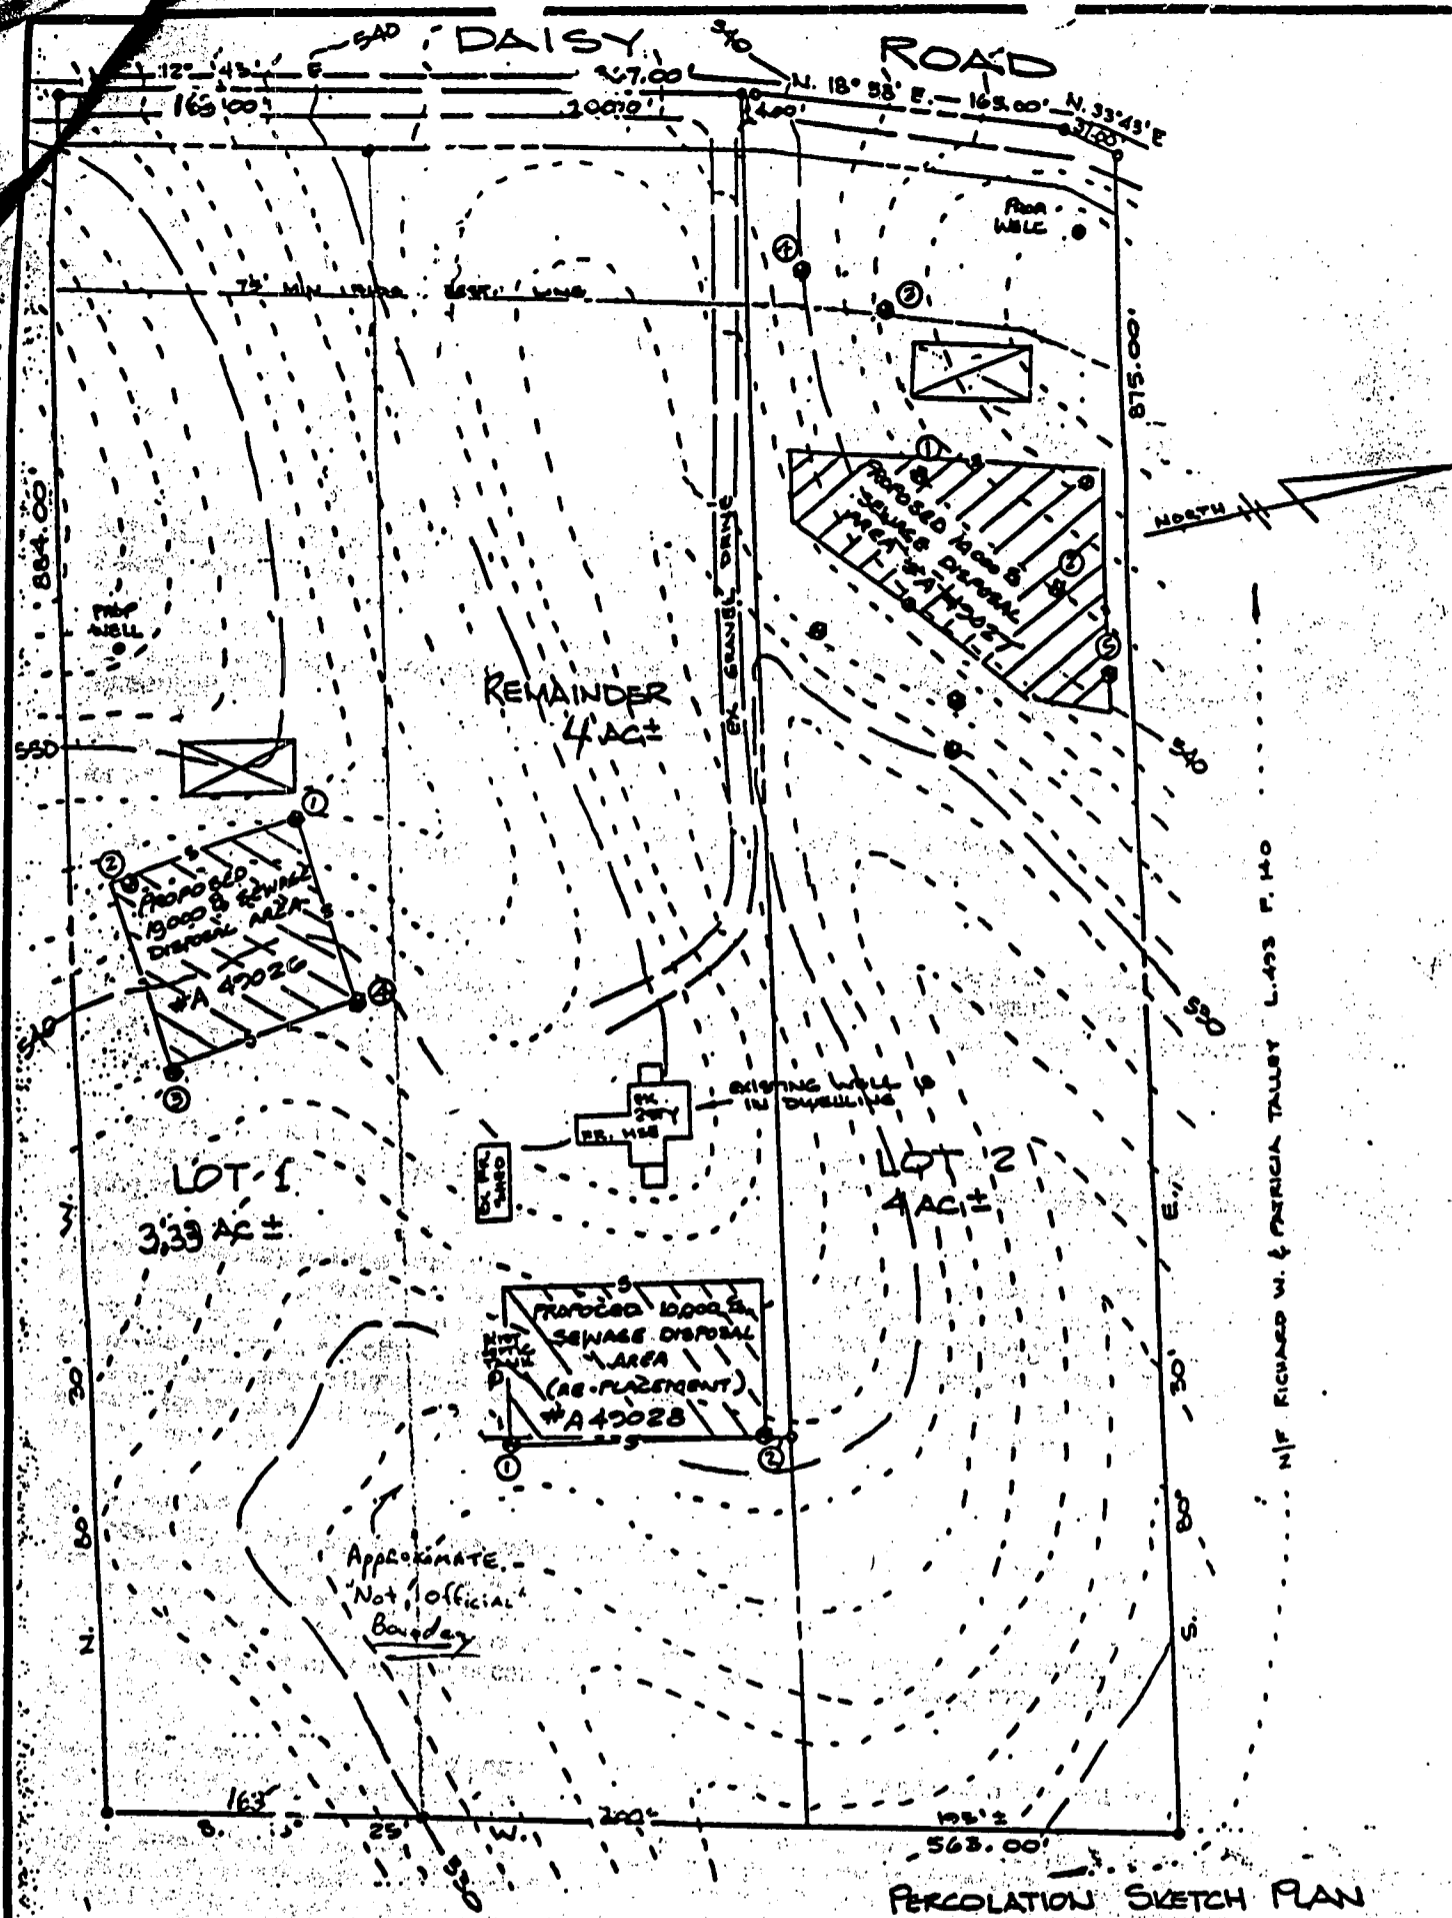

N/F RICHARD W. & PATRICIA TALLEY L. 93 P. 140

SURVEYORS STATEMENT:
 ALL WELLS AND SEPTICS WITHIN 100'
 OF THIS BOUNDARY ARE SHOWN

PERCOLATION SKETCH PLAN
 OF
DAVID C. & SUZANNE JORDAN PROPERTY
 1627 DAISY ROAD
 FOURTH ELECTION DISTRICT
 HOWARD COUNTY, MARYLAND

SCALE: 1" = 100' MARCH, 1993



APPROVED:
 HOWARD COUNTY HEALTH DEPT.
[Signature] 10-21-93
 DATE

REVISED: APRIL 22, 1993
 JUNE 8, 1993
 JUNE 23, 1993

I CERTIFY THIS PLAN TO BE CORRECT; IT IS THE RESULT
 OF AN ACTUAL FIELD SURVEY, BASED ON DATA FOUND AMONG
 THE LAND RECORDS OF HOWARD COUNTY,
 MARYLAND, AS REFERENCED HEREON.

LIBERTY SURVEY, INC.
 4140 RIDGE ROAD
 TAYLORSVILLE, MARYLAND

REFERENCE	JOB NO.
1214/591	93-60

410-875-0722 21157
 301 824 2295

EMERGENCY/TEMP NO. IF ANY

B 1 **7093**
(THIS NUMBER IS TO BE PUNCHED
IN COLS. 3-6 ON ALL CARDS)

SEQUENCE NO.
(DP USE ONLY)


STATE OF MARYLAND
APPLICATION FOR PERMIT TO DRILL WELL
please print or type

STATE PERMIT NUMBER
40-94-1037
70 fill in this form completely 79

Date Received (APA)
010697
OWNER INFORMATION
Last Name: **WICKENBARGER** Owner: **STUART** First Name: **STUART**
Street or RFD: **1127 DAINY ROAD**
Town: **LISBON** State: **MD** Zip: **21158**

B 3 LOCATION OF WELL
County: **HOWARD**
Subdivision: **DARREL 2**
Section: **44** Lot: **46**
Nearest Town: **LISBON**
Miles from Town: **0** M I

DRILLER INFORMATION
MSD/MGD/MWD
Driller's Name: **Ronald Ryker** License No. **2916**
Company Name: **Best Management Well Drilling**
Address: **PO Box 861, Westminister, Md, 21158**
Signature: **Ronald Ryker** Date: **1/3/97**

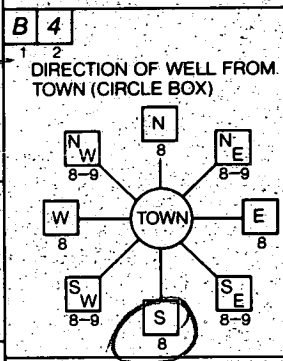

B 4 DIRECTION OF WELL FROM TOWN (CIRCLE BOX)
NEAR WHAT ROAD: **1127 DAINY ROAD**
ON WHICH SIDE OF ROAD (CIRCLE APPROPRIATE BOX): **50**
DISTANCE FROM ROAD: **71** FT OR MI
TAX MAP: _____ BLK: _____ PARCEL: _____

B 2 WELL INFORMATION
APPROX. PUMPING RATE (GAL. PER MIN.): **5**
AVERAGE DAILY QUANTITY NEEDED (GAL. PER DAY): **450**

NOT TO BE FILLED IN BY DRILLER
HEALTH DEPARTMENT APPROVAL
County Name: **Howard Co.** County No.: **A 49027**
State Signature: _____ DATE ISSUED: **010897**
CO SIGNATURE: **A. McMillen** EXP. DATE: **1-8-98**
NORTH GRID: **540000** EAST GRID: **182000**

USE FOR WATER (CIRCLE APPROPRIATE BOX)
 HOME (SINGLE OR DOUBLE HOUSEHOLD UNIT ONLY)
 FARMING (LIVESTOCK WATERING & AGRICULTURAL IRRIGATION)
 INDUSTRIAL, COMMERCIAL, STATE AND FEDERAL GOV. OTHER (REQUIRES APPROPRIATION PERMIT)
 PUBLIC OR PRIVATE WATER COMPANY (REQUIRES APPROPRIATION PERMIT AND STATE HEALTH DEPARTMENT APPROVAL)
 TEST, OBSERVATION, MONITORING (MAY REQUIRE APPROPRIATION PERMIT)


APPROXIMATE DEPTH OF WELL: **2000** FEET
APPROXIMATE DIAMETER OF WELL: **6** INCH NEAREST

SHOW MAJOR FEATURES OF BOX & LOCATE WELL WITH AN X
SOURCES OF DRILLING WATER
1. **City**
2.
3.
WRITE THE BOX NUMBER FROM THE MAP HERE
7802
5404

11/4/97
8:00 GROUT
Well

METHOD OF DRILLING (circle one)
Bored (or Augered) JETTED Jetted & Driven
AIR-ROTARY AIR-PERCussion ROTARY (Hydraulic Rotary)
CABLE REVerse-ROTary Drive-POINT
other _____

REPLACEMENT OR DEEPEMED WELLS (CIRCLE APPROPRIATE BOX)
 THIS WELL WILL NOT REPLACE AN EXISTING WELL
 THIS WELL WILL REPLACE A WELL THAT WILL BE ABANDONED AND SEALED
 THIS WELL WILL REPLACE A WELL THAT WILL BE USED AS A STANDBY - CONTACT LOCAL APPROVING AUTHORITY FOR POLICY ON STANDBY WELLS
 THIS WELL WILL DEEPEM AN EXISTING WELL
PERMIT NUMBER OF WELL TO BE REPLACED OR DEEPEMED (IF AVAILABLE): _____

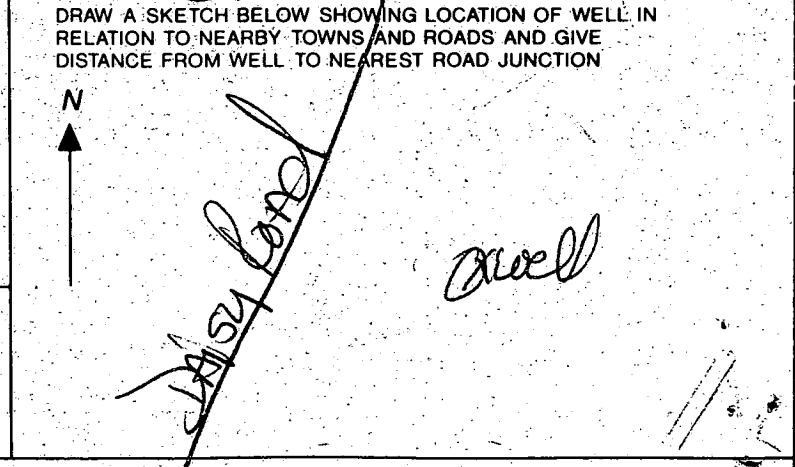

Not to be filled in by driller (OEP USE ONLY)
APPROX. PERMIT NUMBER: **GAP**
FORCE **AM** WRITE INITIALS IN BOX PERMIT No. **40-94-1037**


SPECIAL CONDITIONS
NOTE = APPROVING AUTHORITIES SHOULD USE SEPARATE SHEET. IF NEEDED =
COUNTY

MALONE

Septic easement was modified and approved by County. Area [hatched] was deleted from septic easement. See attached approval

RICHARD TALLEY LASS F. 149
ZONE RC DED

14x14 conservatory

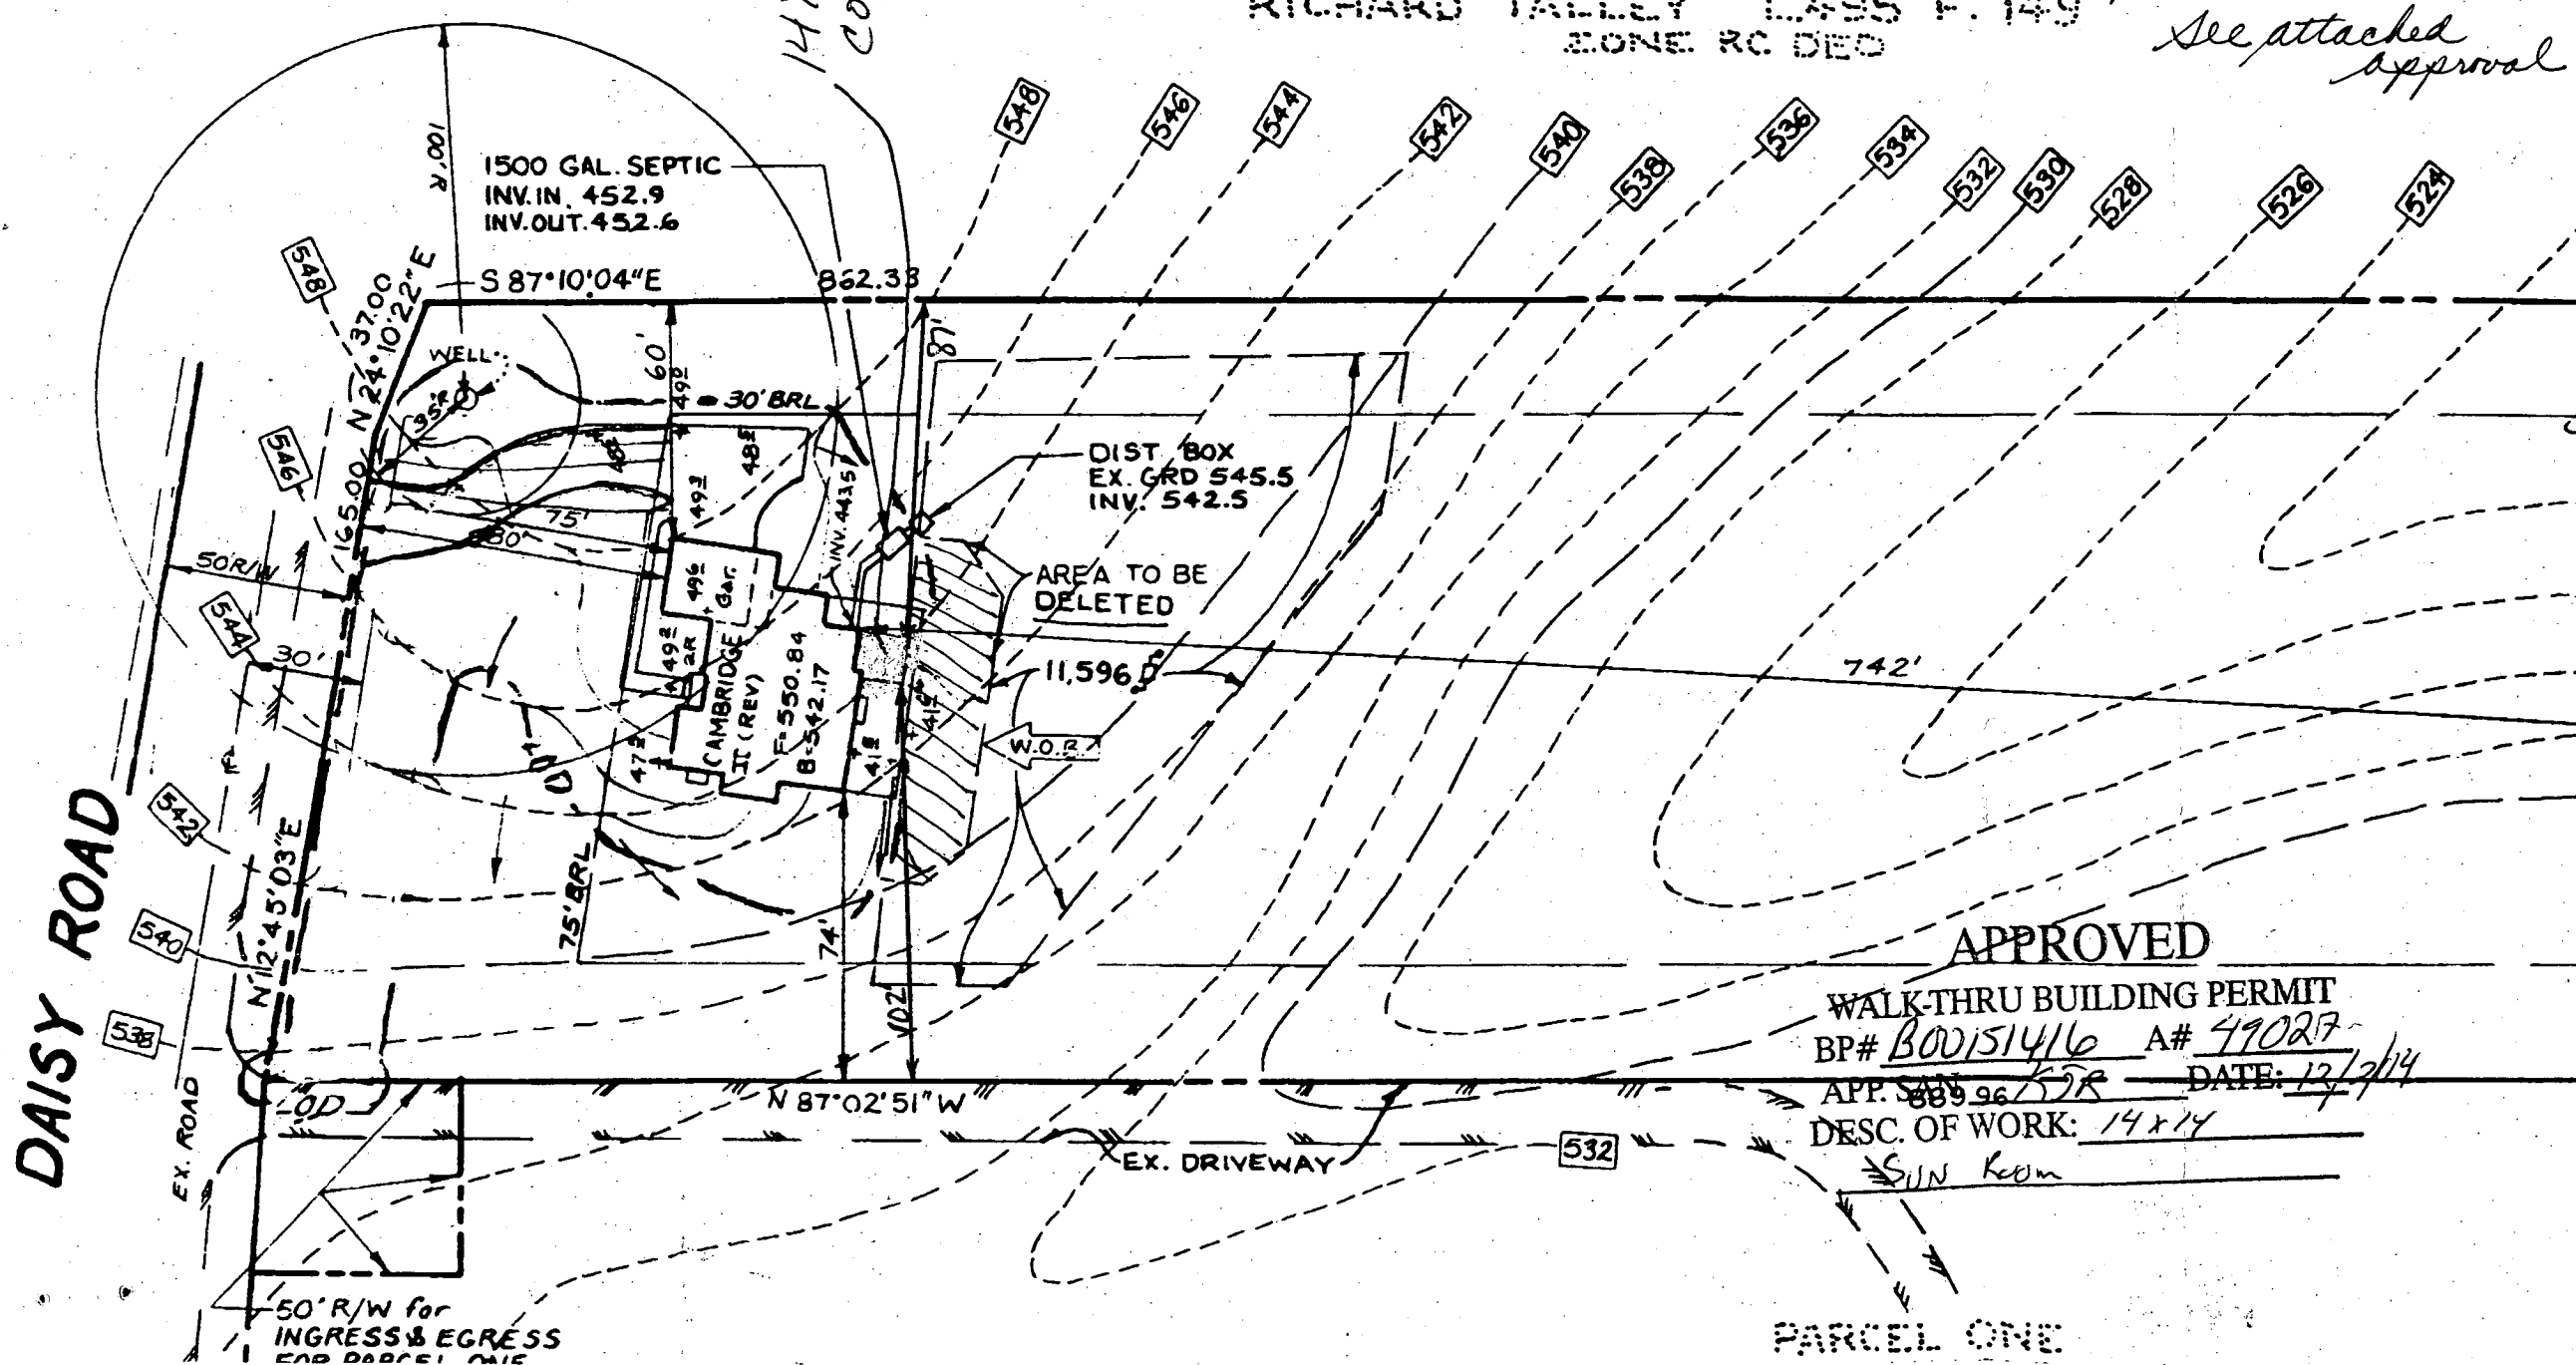

APPROVED

WALK-THRU BUILDING PERMIT
BP# B00151416 A# 49027

APP. 889 96/57R DATE: 12/2/14

DESC. OF WORK: 14x14

SUN Room

PARCEL ONE