

# PERMIT

## SEWAGE DISPOSAL SYSTEM

### DEPARTMENT OF HEALTH AND MENTAL HYGIENE

INDEXED

#### HOWARD COUNTY HEALTH DEPARTMENT

##### BUREAU OF ENVIRONMENTAL HEALTH

~~XX4510913XX~~ 313-2640

P 57260E

A 49914L

DISTRICT 3rd

DATE 09/05/96

DATE SYSTEM APPROVED 12/27/96

INSPECTOR ACW

03-319792

South Carroll Backhoe, Inc.

IS PERMITTED TO INSTALL ☒ ALTER

ADDRESS 4410 Salem Bottom Road, Westminster, Maryland 21157 PHONE 875-4197

SUBDIVISION Sobus Farms LOT 12 ROAD 2830 Wynfield Road

PROPERTY OWNER Altieri Homes, Inc.

ADDRESS

SEPTIC TANK CAPACITY 1250 GALLONS

\*\*\*MANHOLE CLEANOUT REQUIRED\*\*\*

NUMBER OF BEDROOMS 4

180 SQUARE FEET PER BEDROOM

LINEAR FEET OF TRENCH REQUIRED 240

TRENCHES - Trench to be 3 feet wide. Inlet 2 feet below original grade. Bottom maximum depth 4 feet below original grade. Effective area begins at 2 feet below grade. 2 feet of stone below distribution pipe.

LOCATION - Beginning from the intersection of the 300.69' and 454.76' lot lines, place distribution box 170 feet up the 454.76' lot line and 240 feet off that same lot line. Run trenches on contour toward the right lot line.

NOTES - No trench to exceed 100 feet in length. Provide 6" - 8" diameter cleanout and cap to grade or above on septic tank. OK 8/9/96 DKS

PLANS APPROVED BY Amy McMillen

DATE 08/06/96

COVER NO WORK UNTIL INSPECTED AND APPROVED

NEITHER THE HOWARD COUNTY COUNCIL NOR THE HEALTH DEPARTMENT IS RESPONSIBLE FOR THE SUCCESSFUL OPERATION OF ANY SYSTEM

NOTE: CLEANOUT REQUIRED EVERY 70 FEET OF SEWER LINE AND/OR AT 90° SWEEPS IN LINES FROM HOUSE TO DRAIN FIELDS, 90° ELBOWS NOT ACCEPTABLE.

NOTE: ALL PARTS OF SEPTIC SYSTEMS (I.E. TANK, DISTRIBUTION BOX TRENCHES) TO BE 100 FEET FROM WELL (UNLESS OTHERWISE SPECIFICALLY AUTHORIZED)

NOTE: IF DEEP TRENCH(ES) ARE USED CALL FOR INSPECTION BEFORE AND AFTER PLACING GRAVEL IN TRENCH(ES)

NOTE: NO DRY WELL SHALL EXCEED 15 FOOT IN DIAMETER NO ABSORPTION TRENCH TO EXCEED 100 FEET IN LENGTH

NOTE: ALL PIPE FROM HOUSE TO SEPTIC TANK MUST BE CAST IRON OR SCHEDULE 35/40 PVC OR ABS


PERMIT VOID AFTER TWO YEARS

NOTE: INSTALL STAND PIPE ON SEPTIC TANK AND DRY WELL STAND PIPES MUST BE 6 INCHES IN DIAMETER CAST IRON. CONCRETE OR TERRA COTTA OR PVA OR ABS ACCEPTED. IF TOP OF SEPTIC TANK IS DEEPER THAN 3 FEET. MANHOLE TO GRADE REQUIRED.

NOTE: DISTRIBUTION BOXES MUST HAVE BAFFLES

\*INSTALLER IS RESPONSIBLE FOR OBTAINING FINAL APPROVAL ON THIS PERMIT

A 49914L

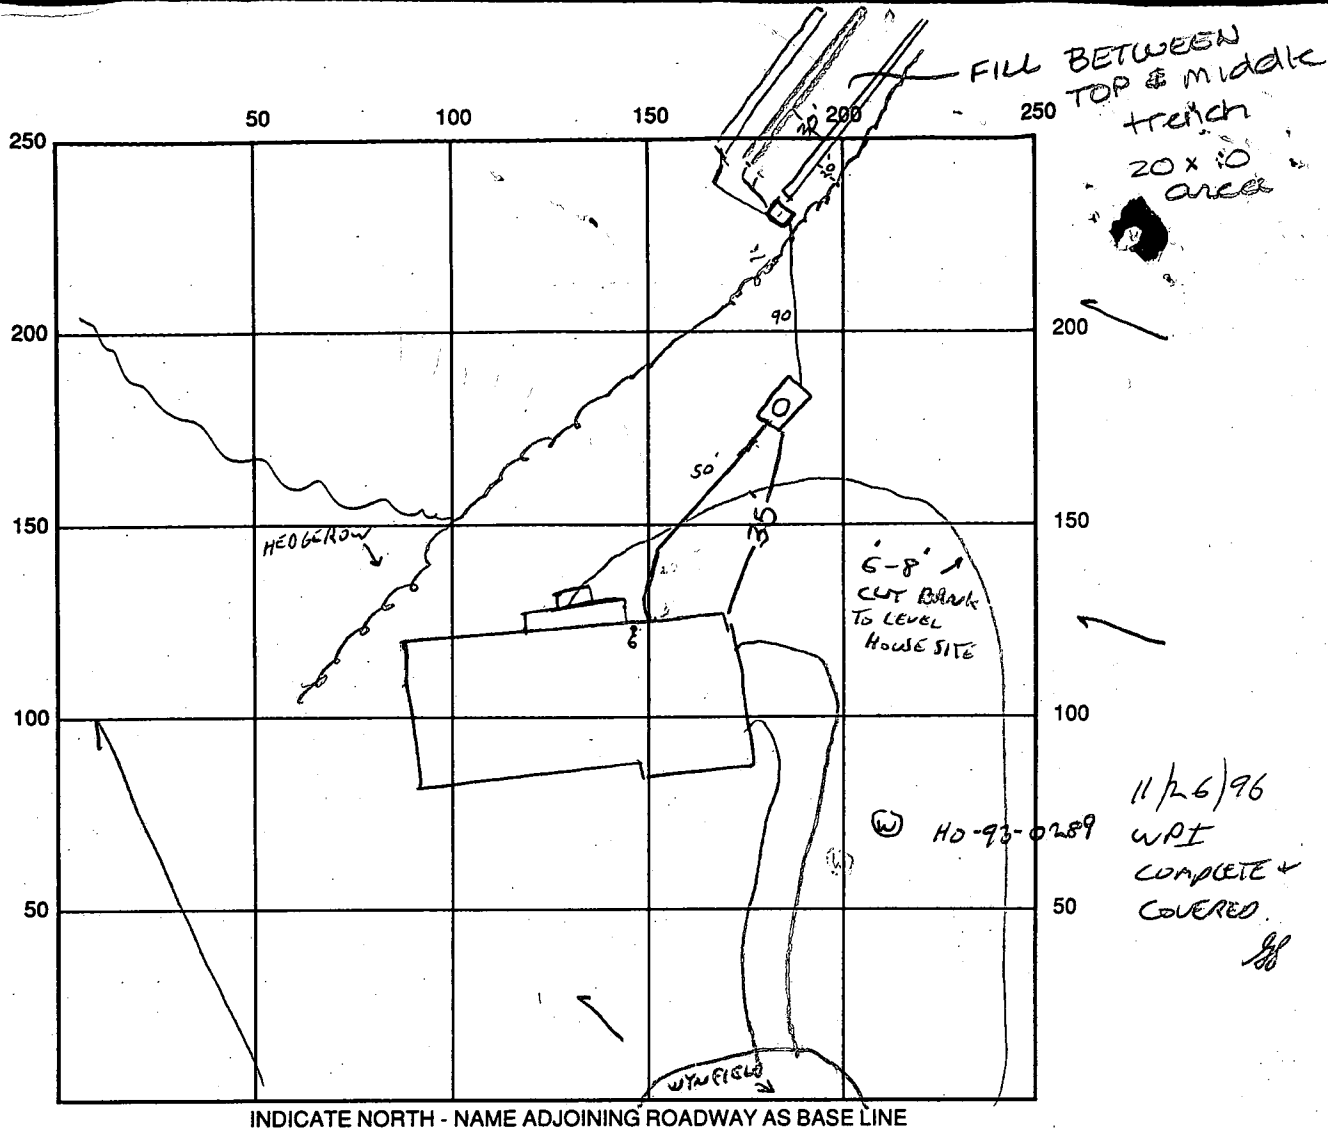

SEPTIC TANK LEVEL OK, NEEDS MANHOLE

CLEANOUTS one on S.T.

DISTRIBUTION BOX LEVEL OK

DRAIN FIELD/TITLE DEPTH 4 FT.

TRENCH WIDTH 3 FT.

INLET DEPTH 2 FT.

EFFECTIVE GRAVEL DEPTH 2 FT.

TOTAL LENGTH 80/80/80 FT. = 240 total

240  
80  
170

NUMBER OF TRENCHES 3

ONE SIDEWALL/BOTTOM AREA 720 SQ. FT.

DRYWALL INSIDE DIAMETER — FT.

EFFECTIVE DEPTH BELOW INLET — FT.

ABSORBENT AREA — SQ. FT.

REMARKS: 11/25/96 WELL CASING 6.5' ABOVE GRADE DUE TO GRADING, CASING IS DAMAGED

3/4 x 3" HOLE IN SIDE OF STEEL CASING 2' ABOVE GROUND. TANK SET, NOT CONNECTED  
TOP OF TANK 6' DEEP, GRAVITY SERVICE OUTLET w/ RAINING TANK, DUE TO CONTOUR  
AND GRADING. CONTRACTOR IS AWARE OF THE SITUATION. 11/26/96 1ST  
TRENCH OUT, OK TO STONE + CONTINUE.

11/27/96 1st trench completed - OK. At start of 2nd trench, buried

DATE SYSTEM APPROVED 12/27/96 INSPECTOR A McMillen

trees encountered in septic area. Work stopped. OKS  
11/28/96 Install 2nd & 3rd trench 30' below 1st - 12/29/96 OK to cover  
all work final - adjustment to SDA necessary for final approval AU

# APPLICATION

PERCOLATION TESTING

A 499/4L

P \_\_\_\_\_

HOWARD COUNTY HEALTH DEPARTMENT

BUREAU OF ENVIRONMENTAL HEALTH

3525-H ELLICOTT MILLS DRIVE/ELLICOTT CITY, MARYLAND 21043  
TELEPHONE: 313-2640

DISTRICT 3

DATE 3/9/94

TO: THE COUNTY HEALTH OFFICER  
ELLICOTT CITY, MARYLAND

I HEREBY APPLY FOR THE NECESSARY TEST PRIOR TO APPLICATION FOR PERMIT TO CONSTRUCT (OR RECONSTRUCT) A SEWAGE DISPOSAL SYSTEM.

PROPERTY OWNER Milltop ~~AITKEN HOMES, INC.~~ Development Corporation

ADDRESS P.O. Box 208, Clarksville, Md. 21029 PHONE 410-531-5539

AGENT OR PROSPECTIVE BUYER Richard Demmitt

ADDRESS P.O. Box 208, Clarksville, Md. 21029 PHONE 410-531-5539

PROPERTY LOCATION:

SUBDIVISION Sabus Farms LOT NO. 12 ~~11~~ (eleven)

ROAD AND DESCRIPTION at the end of Winfield Rd.  
(2830 Winfield Road)

TAX MAP 15 PARCEL # 26 & 154

SIZE OF LOT 3 acres + TYPE BLDG. S.F.D. - 4Bam  
(SINGLE FAMILY DWELLING OR COMMERCIAL)

THE SYSTEM INSTALLED UNDER THIS APPLICATION IS ACCEPTABLE ONLY UNTIL PUBLIC FACILITIES BECOME AVAILABLE. I FULLY UNDERSTAND THE  
FEE CONNECTED WITH THE FILING OF THIS PERC TEST APPLICATION IS NON-REFUNDABLE UNDER ANY CIRCUMSTANCES. I ALSO AGREE TO  
COMPLY WITH ALL M.O.S.H.A. REQUIREMENTS IN TESTING THIS LOT. Richard Demmitt  
(SIGNATURE OF APPLICANT)

APPROVED BY \_\_\_\_\_ FOR \_\_\_\_\_ DATE \_\_\_\_\_

DISAPPROVED BY \_\_\_\_\_ FOR \_\_\_\_\_ DATE \_\_\_\_\_

HOLD PENDING FURTHER TESTS \_\_\_\_\_

REASONS FOR REJECTION OR HOLDING \_\_\_\_\_

PERCOLATION TEST PLAT/PRELIMINARY PLAT - TITLE OR I.D. # \_\_\_\_\_ DATE \_\_\_\_\_

SITE DEVELOPMENT PLAN/FINAL PLAT - TITLE OR I.D. # \_\_\_\_\_ DATE \_\_\_\_\_

## THIS IS NOT A PERMIT

A-19914L

COUNTY #

## SOIL PROFILE

0' D  
red/brn  
CL

2 1/2' orange/brn  
SSIL  
small  
amt of  
mica  
white  
quartz like  
4" spot of  
saprolite

12'

C

3 1/2' red/brn  
SCL

brn/tan  
SL  
some  
mica

2' vein  
of quartz  
at 7 1/2'

2' dia  
chunks;  
smaller  
soil good  
underneath


11'

B

brn  
SCL

brn  
SL  
some  
mica  
almost  
all  
sand

1'

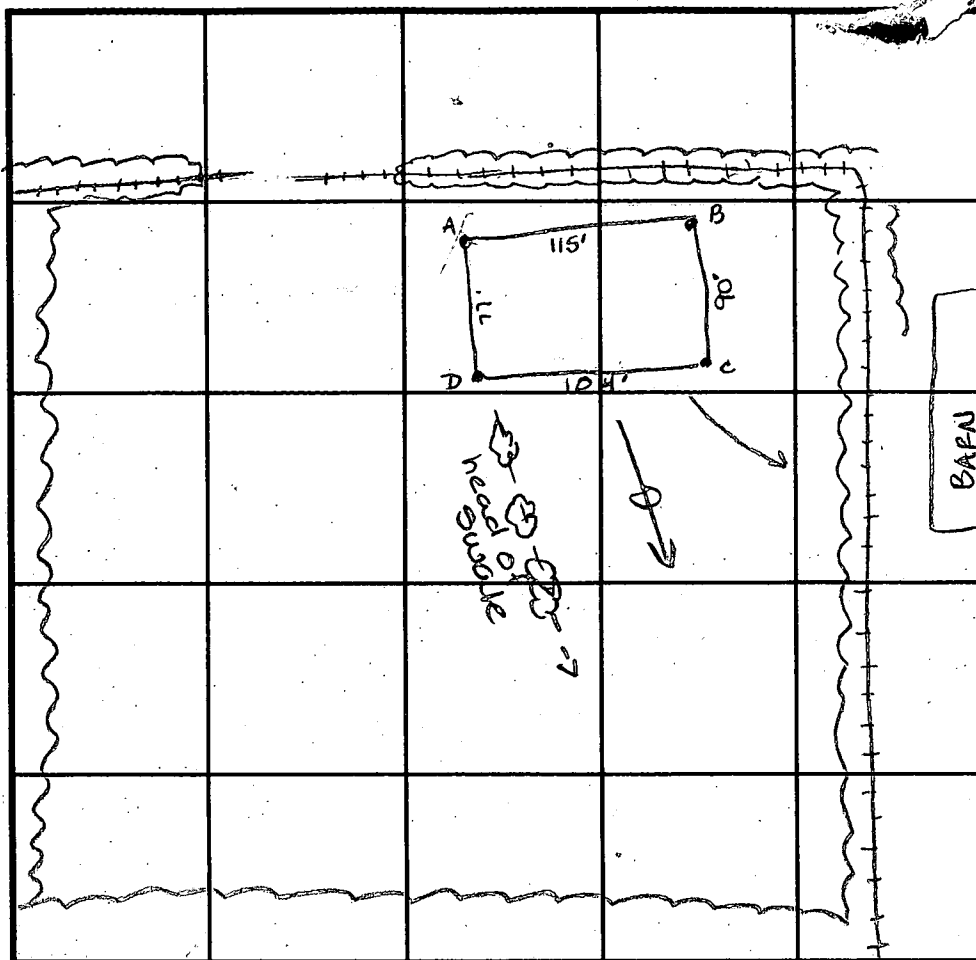

INDICATE NORTH - NAME ADJOINING ROADWAY AS BASE LINE.

## SOIL PROFILE

0' A  
distinct  
c-layer  
brn/red  
mix  
SL  
mica  
throughout  
Top 2'  
on inside  
portion of  
hole has  
6"-1' dia  
rock chunks  
none below  
that

11 1/2'

| DATE     | TEST NO. | DEPTH               | PRE-WET             |                     | TEST - 1" DROP      |                     | TIME      |
|----------|----------|---------------------|---------------------|---------------------|---------------------|---------------------|-----------|
|          |          |                     | START               | STOP                | START               | STOP                |           |
| 11/23/94 | D        | 5' V12'             | 10:35 <sup>15</sup> | 10:35 <sup>45</sup> | 10:35 <sup>45</sup> | 10:36 <sup>40</sup> | 55 sec    |
|          |          | 3 1/2' V12'         | 10:36 <sup>30</sup> | 10:38 <sup>45</sup> | 10:38 <sup>45</sup> | 10:43 <sup>30</sup> | 4 3/4 min |
|          | C        | 3 1/2' V11'         | 10:41 <sup>15</sup> | 10:43 <sup>15</sup> | 10:43 <sup>15</sup> | 10:45 <sup>30</sup> | 2 1/4 min |
|          | B        | 3' V11'             | 10:51 <sup>15</sup> | 10:51 <sup>30</sup> | 10:51 <sup>30</sup> | 10:52 <sup>30</sup> | 30 sec    |
|          |          | repour              | 10:54 <sup>15</sup> | 10:54 <sup>30</sup> | 10:54 <sup>30</sup> | 10:55 <sup>30</sup> | 30 sec    |
|          |          | repour              | 10:56 <sup>15</sup> | 10:57 <sup>30</sup> | 10:57 <sup>30</sup> | 10:58 <sup>30</sup> | 1 min     |
|          | A        | 3 1/2 - 4' V11 1/2' | 11:03 <sup>15</sup> | 11:04 <sup>30</sup> | 11:04 <sup>30</sup> | 11:06 <sup>30</sup> | 2 min     |
|          |          | 6 1/2' V11 1/2'     | 11:00 <sup>15</sup> | 11:00 <sup>45</sup> | 11:00 <sup>45</sup> | 11:01 <sup>30</sup> | 45 sec    |
|          |          |                     | 11:02 <sup>15</sup> | 11:03 <sup>15</sup> | 11:03 <sup>15</sup> | 11:04 <sup>15</sup> | 1 1/4 min |
|          |          |                     |                     |                     |                     |                     |           |
|          |          |                     |                     |                     |                     |                     |           |

dirt fell in

REMARKS shallow system only (all holes almost pure sand)

TYPE OF SOIL ChD<sub>2</sub> Chester Silt Loam

TESTED BY A McMillen/M. Rifkin ALSO PRESENT R. Dewitt

TRENCH DESIGN DATA: AVERAGE PERCOLATION TIME 2 min TRENCH WIDTH 3'

INLET DEPTH 2 1/2' MAXIMUM BOTTOM DEPTH 4' SQ. FT/BEDROOM 180 ft<sup>2</sup>

C1 0150

SEQUENCE NO.  
(MDE USE ONLY)STATE OF MARYLAND  
WELL COMPLETION REPORT  
FILL IN THIS FORM COMPLETELY  
PLEASE PRINT OR TYPETHIS REPORT MUST BE SUBMITTED WITHIN  
45 DAYS AFTER WELL IS COMPLETED.COUNTY  
NUMBER A 49914-LST/CO USE ONLY  
DATE Received

112795

DATE WELL COMPLETED

012696

Depth of Well

185  
(TO NEAREST FOOT)PERMIT NO.  
FROM "PERMIT TO DRILL WELL"

H0-93-0209

OWNER

Demmitt

Richard

STREET OR RFD

Wynfield Road

TOWN

West Friendship

SUBDIVISION

Sabus Farms

SECTION

LOT 12

## WELL LOG

Not required for driven wells

STATE THE KIND OF FORMATIONS  
PENETRATED, THEIR COLOR, DEPTH,  
THICKNESS AND IF WATER BEARINGDESCRIPTION (Use  
additional sheets if needed)

FEET

FROM

TO

check  
if water  
bearing

Sand

0 22

Gray mica

22 185

## GROUTING RECORD

WELL HAS BEEN GROUTED  
(Circle Appropriate Box)yes no  
Y N

TYPE OF GROUTING MATERIAL (Circle one)

CEMENT CM

BENTONITE CLAY BC

NO. OF BAGS 7

NO. OF POUNDS 658

GALLONS OF WATER 42

DEPTH OF GROUT SEAL (to nearest foot)

from 0 ft. to 23 ft.  
(enter 0 if from surface)

## CASING RECORD

casing  
types  
insert  
appropriate  
code  
below

ST

STEEL

CO

CONCRETE

PL

PLASTIC

OT

OTHER

MAIN  
CASING  
TYPENominal diameter  
top (main) casing  
(nearest inch)Total depth  
of main casing  
(nearest foot)

S+

6

26

## OTHER CASING (if used)

E  
A  
C  
H  
C  
A  
S  
I  
N  
G

diameter

depth (feet)

inch

from to

screen type  
or open hole  
insert  
appropriate  
code  
below

## SCREEN RECORD

ST

STEEL

BR

BRASS

HO

OPEN

BRONZE

HOLE

PL

PLASTIC

OT

OTHER

NUMBER OF UNSUCCESSFUL WELLS: 0

WELL HYDROFRACTURED

yes  
Yno  
N

## CIRCLE APPROPRIATE LETTER

- A A WELL WAS ABANDONED AND SEALED  
WHEN THIS WELL WAS COMPLETED
- E ELECTRIC LOG OBTAINED
- P TEST WELL CONVERTED TO PRODUCTION  
WELL

I HEREBY CERTIFY THAT THIS WELL HAS BEEN CONSTRUCTED IN  
ACCORDANCE WITH COMAR 26.04.04 "WELL CONSTRUCTION" AND  
IN CONFORMANCE WITH ALL CONDITIONS STATED IN THE ABOVE  
CAPTIONED PERMIT, AND THAT THE INFORMATION PRESENTED  
HEREIN IS ACCURATE AND COMPLETE TO THE BEST OF MY  
KNOWLEDGE.

TYPE: MWD/MSD/MGD

DRILLERS LIC. NO. 24

DRILLERS SIGNATURE

(MUST MATCH SIGNATURE ON APPLICATION)

LIC. NO.

SITE SUPERVISOR (sign. of driller or journeyman  
responsible for sitework if different from permittee)

## GRAVEL PACK

IF WELL DRILLED WAS  
FLOWING WELL INSERT  
F IN BOX 68MDE USE ONLY  
(NOT TO BE FILLED IN BY DRILLER).

T

(E.R.O.S.)

W Q

70

72

74 75 76

TELESCOPE  
CASINGLOG  
INDICATOR

OTHER DATA

## PUMPING TEST

HOURS PUMPED (nearest hour)

3

PUMPING RATE (gal. per min.)

20

METHOD USED TO  
MEASURE PUMPING RATE

Bucket

WATER LEVEL (distance from land surface)

BEFORE PUMPING

33 ft.

WHEN PUMPING

39 ft.

TYPE OF PUMP USED (for test)

A air

P piston

T turbine

C centrifugal

R rotary

O other  
(describe  
below)

J jet

S submersible

## PUMP INSTALLED

DRILLER WILL INSTALL PUMP  
(CIRCLE) (YES or NO)

YES

NO

IF DRILLER INSTALLS PUMP, THIS SECTION  
MUST BE COMPLETED FOR ALL WELLS.TYPE OF PUMP INSTALLED  
PLACE (A,C,J,P,R,S,T,O)  
IN BOX 29CAPACITY:  
GALLONS PER MINUTE  
(to nearest gallon)

PUMP HORSE POWER

PUMP COLUMN LENGTH  
(nearest ft.)CASING HEIGHT (circle appropriate box  
and enter casing height)


+ above

- below

LAND SURFACE

2 (nearest  
foot)

## LOCATION OF WELL ON LOT

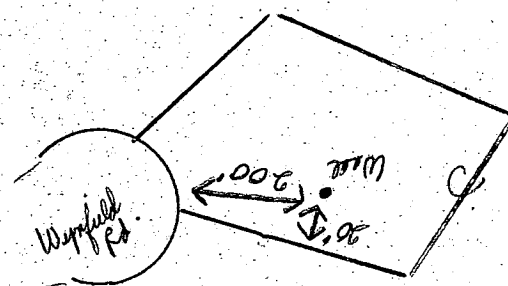SHOW PERMANENT STRUCTURE SUCH AS  
BUILDING, SEPTIC TANKS, AND /OR  
LANDMARKS AND INDICATE NOT LESS  
THAN TWO DISTANCES  
(MEASUREMENTS TO WELL)

COUNTY

HOWARD COUNTY HEALTH DEPARTMENT  
Bureau of Environmental Health  
3525-H Ellicott Mills Drive  
Ellicott City, MD 21043

Fax 313-2648 313-2640

APPLICATION FOR PITLESS ADAPTER, WELL PUMP AND PRESSURE TANK INSTALLATION

New Installation ☒  
Replacement ☐

Receipt #  
Date 12/4/96

Name of Installer Robert L. Feezer Co.

Telephone 781-4653

License Number 2122

Certified Well Pump Installer ☒ Well Driller ☐ Registered Plumber ☒

Name of Property Owner Alticia Homes

Telephone 795-1405

Subdivision SOBUS Farms Lot # 12

Well Tag # HO-93-0209

Site Address WYNFORD ROAD

Pump

1. Type

- a. Deep well jet ☐  
b. Shallow well jet ☐  
c. Submersible ☒

2. Make Grundfos

3. Model # 705054122

4. Capacity 7 GPM

5. Pump exceeds well capacity Yes ☐ No ☒

6. If Yes, is low pressure cutoff switch installed? Yes ☐ No ☒

7. What methods are used to protect the pump and electrical wiring from vibrations? Torque arrestors ☐ Cable guards ☒ Other ☐

Motor

1. Horsepower 1/2

2. RPM 3450

3. Voltage ☐

a. 110 ☐

b. 220 ☒

Pitless Adapter

1. Make Hammer

2. Model # 77800

3. Depth 42"

Tank

1. Capacity 340 Gals

2. Pressure relief valve? YES

Piping

1. Type 704

2. Size 1"

3. NSF and/or BOCA Code approved YES

4. Depth of supply line 42"

Well data

1. Depth 120 ft.

2. Yield ☐ GPM

3. Static water level ☐ ft.

4. Will water supply be disinfected by installer? YES

I understand that it is my responsibility to notify the Howard County Health Department when the installation is ready for inspection (otherwise this permit is null and void).

All information given above is true to the best of my knowledge.

Signature of Applicant Robert L. Feezer


Date: 12/4/96

Note: A sticker indicating approval/status of the installation will be placed on the well casing at the time of the inspection.









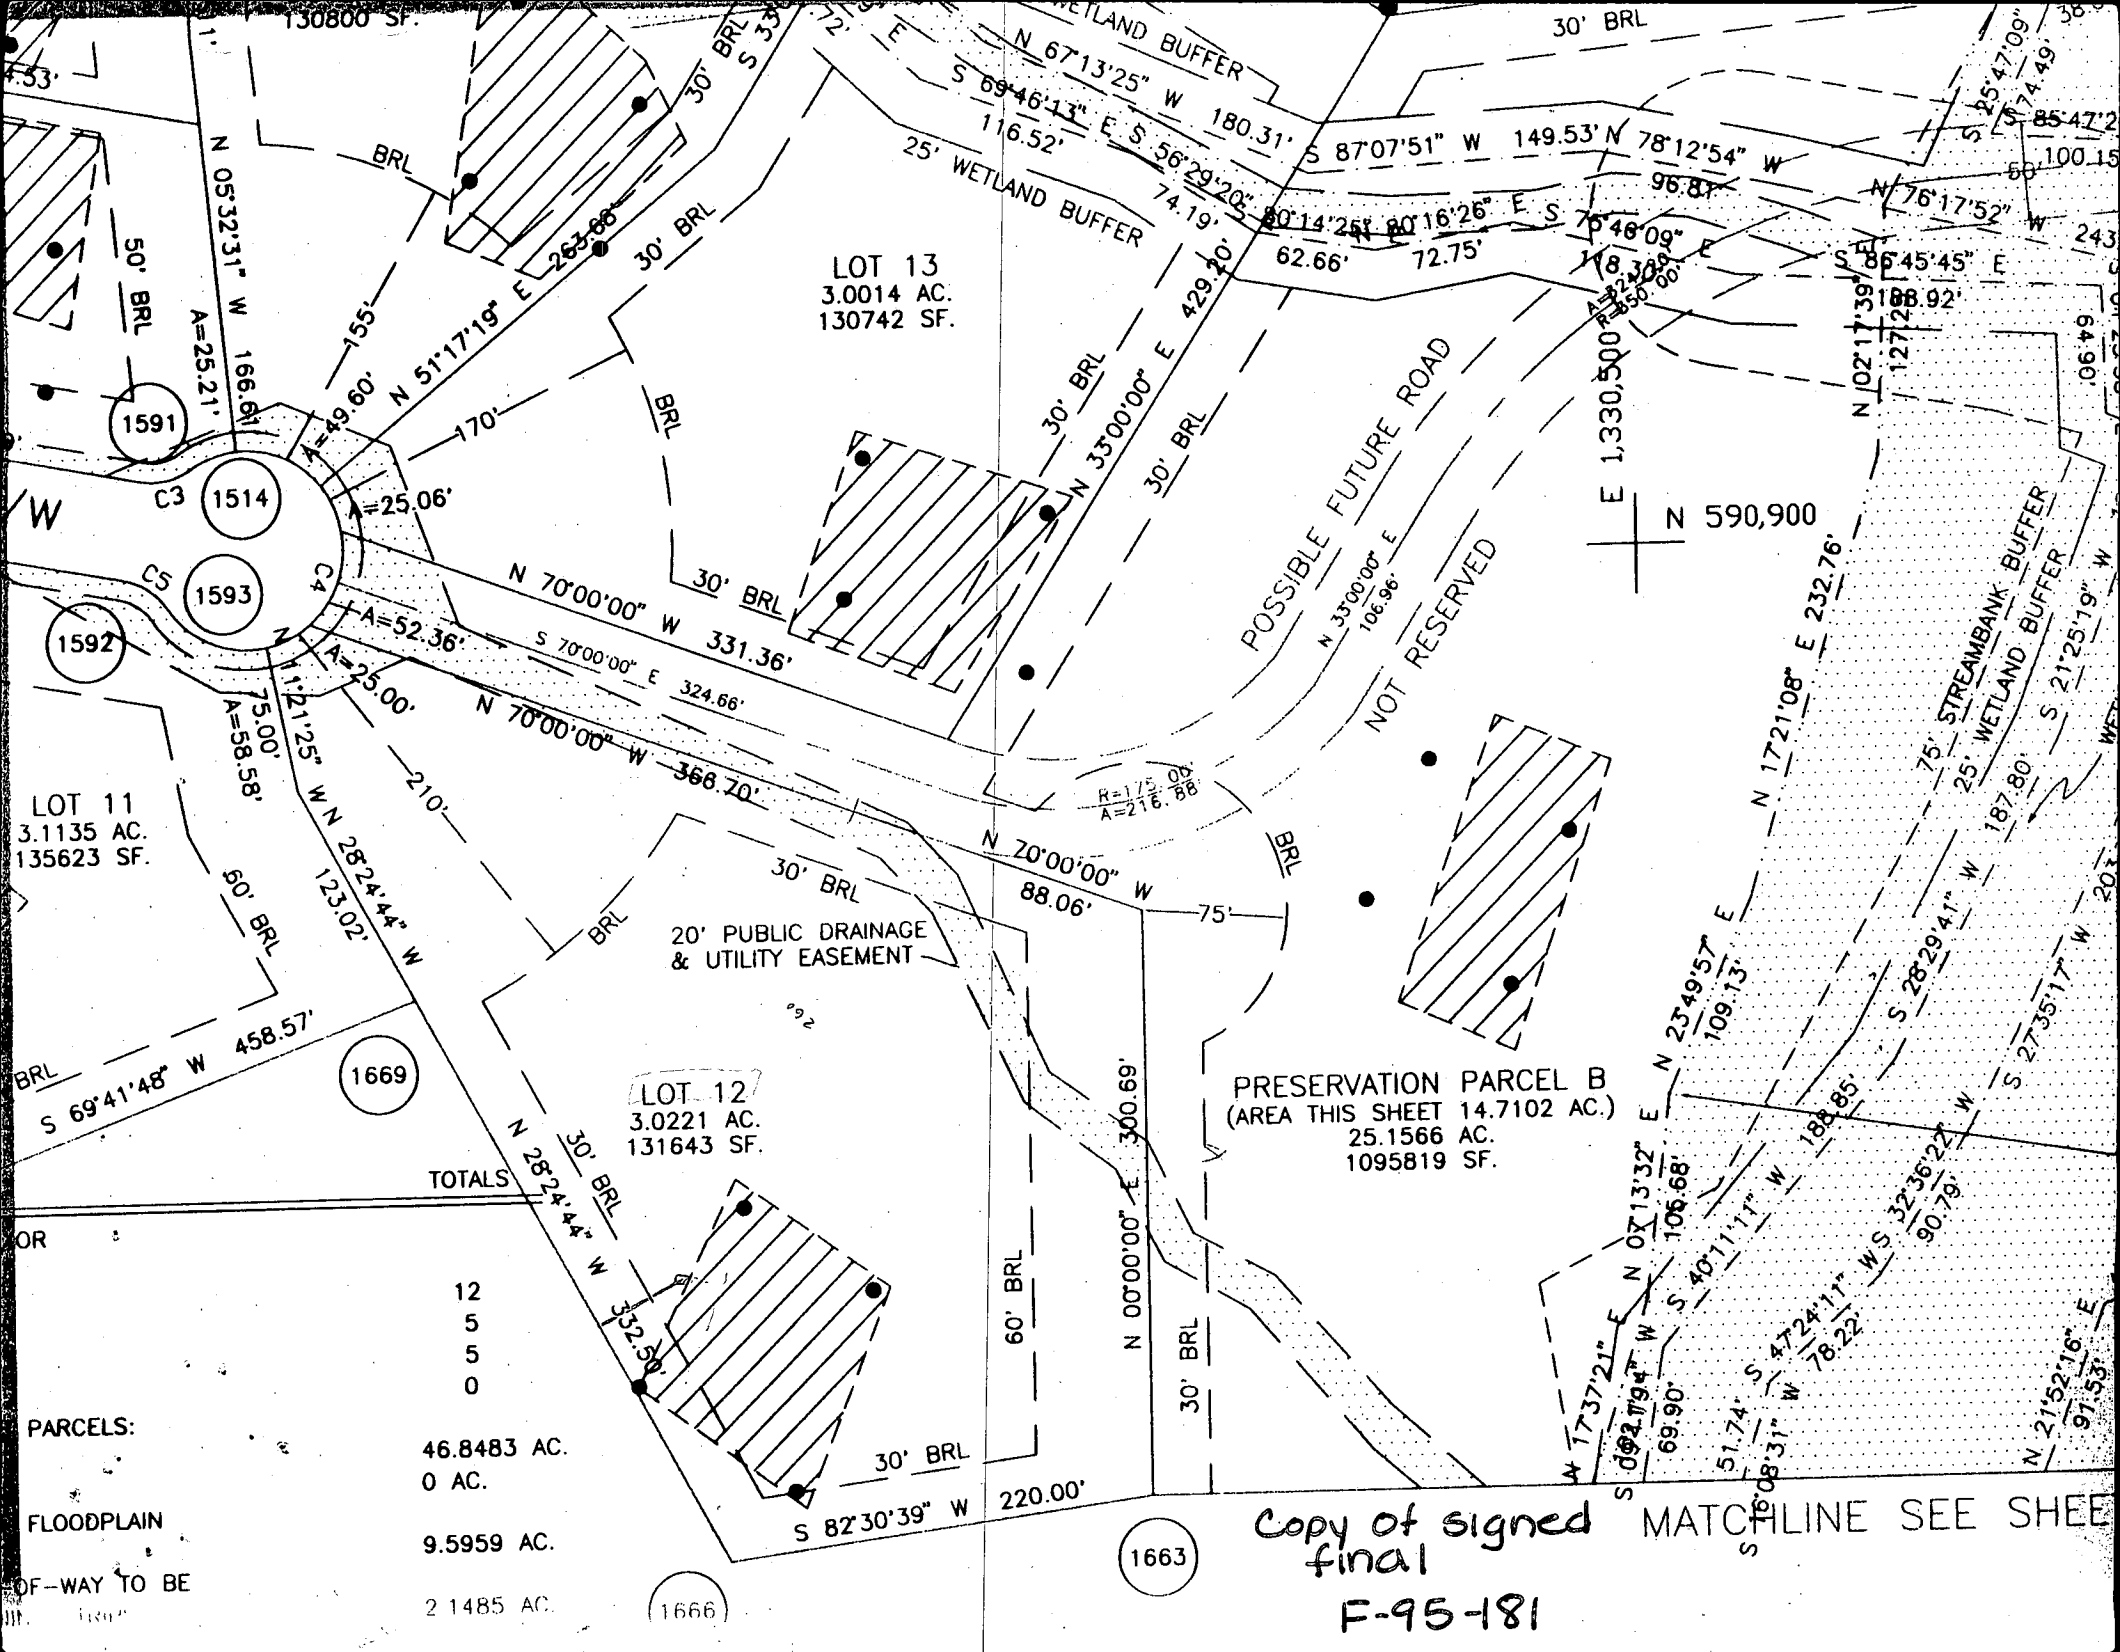

NOTE: This Lot appears to lie in an area classified as Zone C, area of minimal flooding as shown on FIRM MAP of Howard County, Maryland, Community Panel Number 240044 0016B, Panel 16 of 45 dated December 4, 1986.

Wall Check: 8-21-86  
Top of Wall Elev.: 479.0

NOTE:  
10' Wide Public Tree  
Maintenance Easement

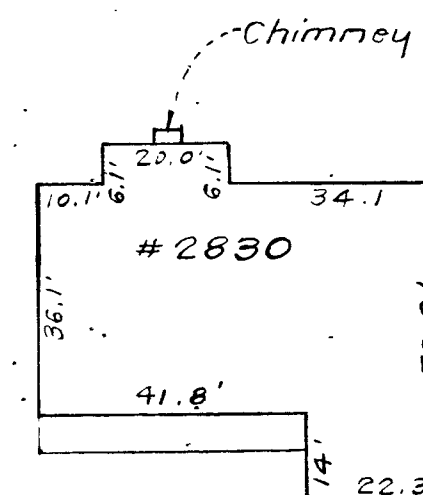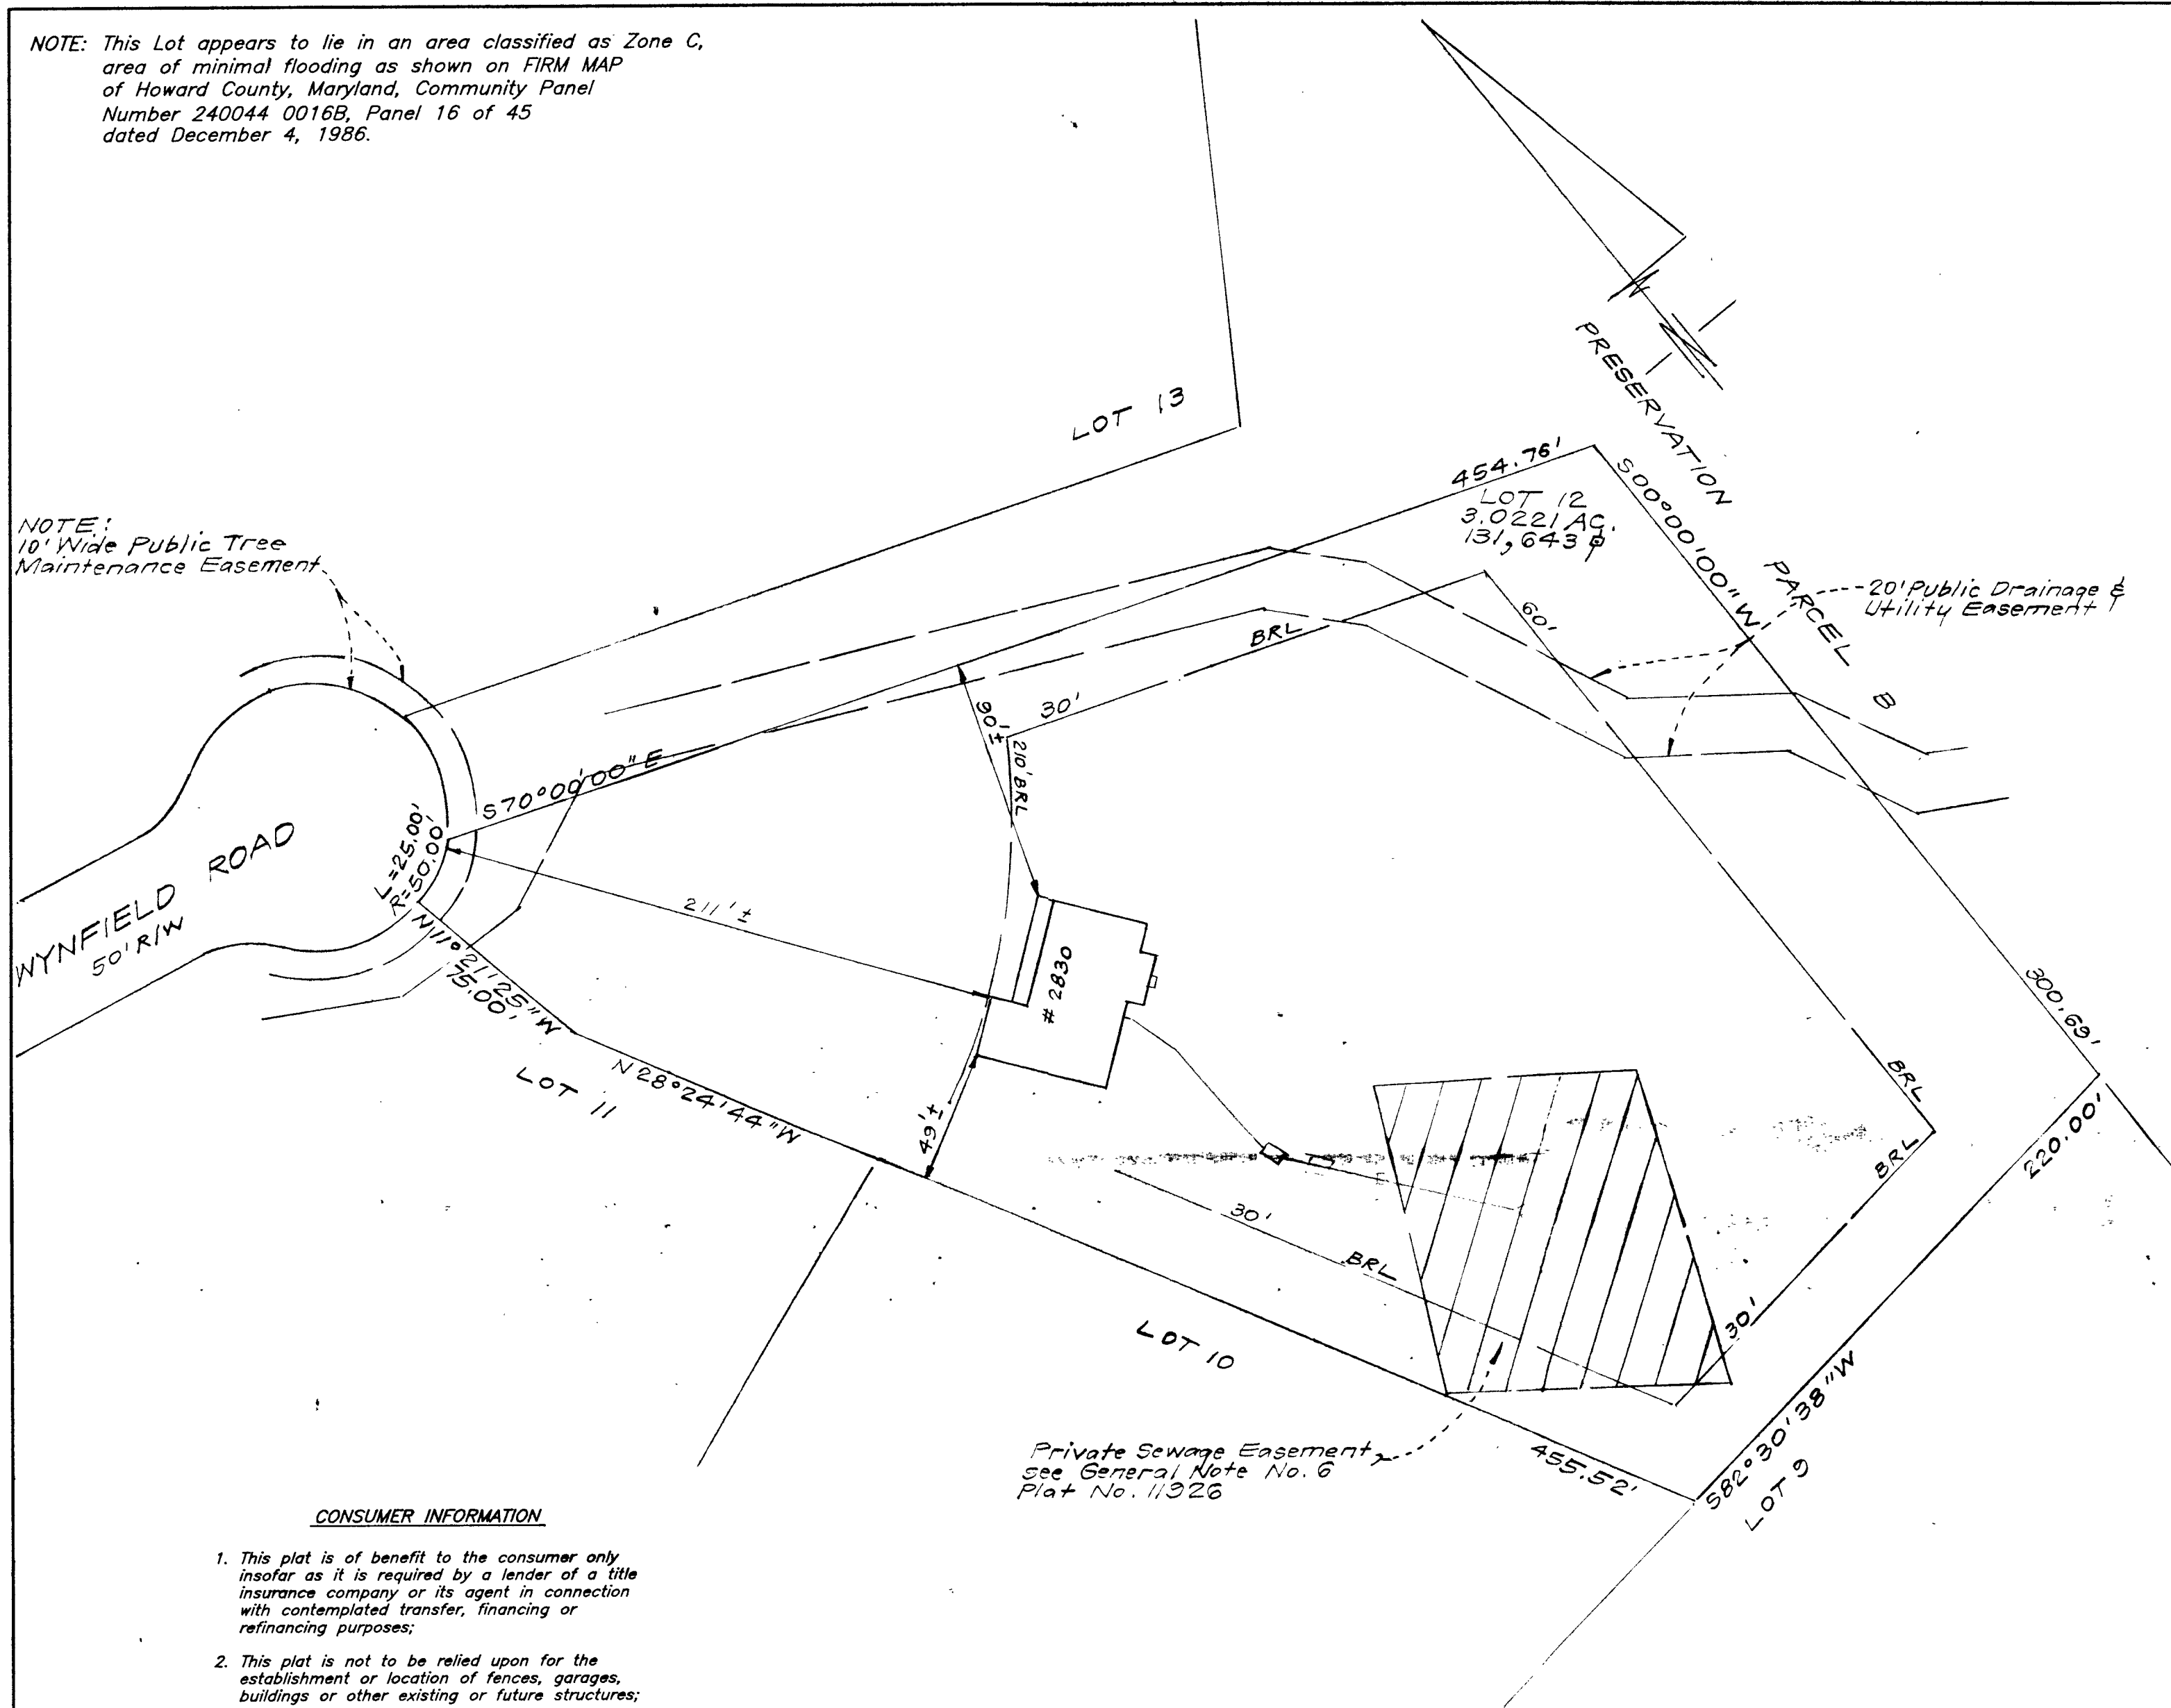

SCALE: 1" = 30'

CONSUMER INFORMATION


1. This plat is of benefit to the consumer only insofar as it is required by a lender of a title insurance company or its agent in connection with contemplated transfer, financing or refinancing purposes;
2. This plat is not to be relied upon for the establishment or location of fences, garages, buildings or other existing or future structures;
3. This plat does not provide for the accurate identification of property boundary lines, but such identification may not be required for the transfer of title or for securing financing or refinancing.

SURVEYOR'S CERTIFICATE

I hereby certify that a field survey of this property has been made under my supervision for the purpose of locating the improvements shown hereon, they are located as shown.

8-22-86  
DATE

PAIGE A. SEE, JR.  
Property Line Surveyor  
Maryland No. 304

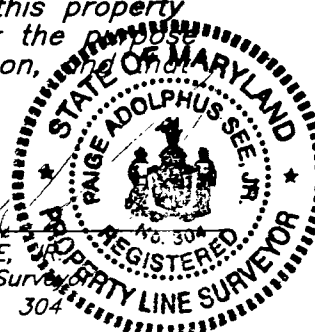

- NOTES:
1. Setback Distance Accuracy = 1'±

Plat Reference: PLAT NO. 11328

|                                                                                                                                                                        |                                                                                                                                                                                |                                            |
|------------------------------------------------------------------------------------------------------------------------------------------------------------------------|--------------------------------------------------------------------------------------------------------------------------------------------------------------------------------|--------------------------------------------|
| <b>CLARK · FINEFROCK &amp; SACKETT, INC.</b><br>ENGINEERS · PLANNERS · SURVEYORS<br>7135 M'NSTREL WAY • COLUMBIA, MD 21045 • (410)381-7500 BALT. • (301)621-8100 WASH. |                                                                                                                                                                                |                                            |
| DESIGNED:                                                                                                                                                              | LOCATION DRAWING<br>2830 WYNFIELD ROAD<br>LOT 12<br><b>SOBUS FARMS</b><br>LOTS 1-33 AND PRESERVATION PARCELS A & B<br>Third (3rd) Election District<br>Howard County, Maryland | SCALE:<br>1"=50'<br>DRAWING NO.<br>JOB NO. |
| DRAWN:<br>KWC                                                                                                                                                          |                                                                                                                                                                                |                                            |
| CHECKED:<br>PAS                                                                                                                                                        |                                                                                                                                                                                |                                            |
| DATE:<br>8-22-86                                                                                                                                                       | FOR: ALTIERI HOMES, INC.,<br>7349 Gardenvue Drive<br>Elkridge, MD. 21227                                                                                                       | FILE NO.<br>95-209-0                       |

NOTE: This Lot appears to lie in an area classified as Zone C, area of minimal flooding as shown on FIRM MAP of Howard County, Maryland, Community Panel Number 240044 0016B, Panel 16 of 45 dated December 4, 1986.

Wall Check: 8-21-96  
Top of Wall Elev.: 479.0

NOTE:  
10' Wide Public Tree  
Maintenance Easement

WYNFIELD ROAD  
50' R/W

LOT 13

LOT 12  
3.022 AC.  
131,643 sq ft


PRESERVATION  
500'00"100'11" W

PARCEL B

20' Public Drainage &  
Utility Easement

Revised Private Sewer Easement  
Ho. Co. Health Dept. 8-6-96

Private Sewage Easement  
See General Note No. 6  
Plat No. 11926

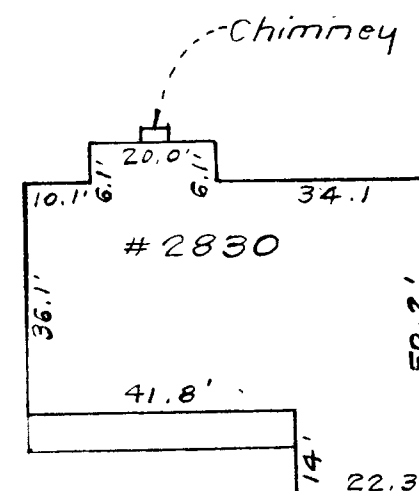

SCALE: 1" = 30'

#### CONSUMER INFORMATION

1. This plat is of benefit to the consumer only insofar as it is required by a lender of a title insurance company or its agent in connection with contemplated transfer, financing or refinancing purposes;
2. This plat is not to be relied upon for the establishment or location of fences, garages, buildings or other existing or future structures;
3. This plat does not provide for the accurate identification of property boundary lines, but such identification may not be required for the transfer of title or for securing financing or refinancing.

#### SURVEYOR'S CERTIFICATE

I hereby certify that a field survey of this property has been made under my supervision for the purpose of locating the improvements shown hereon, and that they are located as shown.

DATE

PAIGE A. SEE, JR.  
Property Line Surveyor  
Maryland No. 304

12/27/96  
NOTE: By Copy of this plan, the Howard County Health Dept. accepts this modification to the platted sewer disposal easement. OK

Amy M. Mullen

Plat Reference: PLAT NO. 11928

#### NOTES:

1. Setback Distance Accuracy = 1'±



CLARK • FINEFROCK & SACKETT, INC.  
ENGINEERS • PLANNERS • SURVEYORS

7135 MINSTREL WAY • COLUMBIA, MD 21045 • (410)381-7500 BALT. • (301)621-8100 WASH.

|                  |                                                                                                      |                      |
|------------------|------------------------------------------------------------------------------------------------------|----------------------|
| DESIGNED:        | LOCATION DRAWING<br>2830 WYNFIELD ROAD                                                               | SCALE:<br>1"=50'     |
| DRAWN:<br>KWC    | LOT 12<br>SOBUS FARMS                                                                                | DRAWING NO.          |
| CHECKED:<br>PAS  | LOTS 1-33 AND PRESERVATION PARCELS A & B<br>Third (3rd) Election District<br>Howard County, Maryland | JOB NO.              |
| DATE:<br>8-22-96 | FOR: ALTIERI HOMES, INC.<br>7349 Gardenview Drive<br>Elkridge, MD. 21227                             | FILE NO.<br>95-209-0 |

RECEIVED  
DEC 27 1996  
HOWARD COUNTY HEALTH DEPARTMENT  
BUREAU OF ENVIRONMENTAL HEALTH

A49914L

WALK THRU

H

|                                                                                                                                                                                                 |                                                   |                                   |
|-------------------------------------------------------------------------------------------------------------------------------------------------------------------------------------------------|---------------------------------------------------|-----------------------------------|
| DEPARTMENT OF INSPECTIONS, LICENSES AND PERMITS<br>3430 COURT HOUSE DRIVE<br>ELLICOTT CITY, MD 21043<br>PERMITS (410)313-2455 INSPECTIONS (410)313-1810<br>AUTOMATED INFORMATION (410) 313-3800 | <b>HOWARD COUNTY</b><br><b>PERMIT APPLICATION</b> | <b>PERMIT NUMBER</b><br>B00123343 |
|-------------------------------------------------------------------------------------------------------------------------------------------------------------------------------------------------|---------------------------------------------------|-----------------------------------|

|                                                                                                                                                                                                                                                                                                                                              |                                                                                                                                                                                                                                                                                                                                               |
|----------------------------------------------------------------------------------------------------------------------------------------------------------------------------------------------------------------------------------------------------------------------------------------------------------------------------------------------|-----------------------------------------------------------------------------------------------------------------------------------------------------------------------------------------------------------------------------------------------------------------------------------------------------------------------------------------------|
| Building Address <u>2830 WYNFIELD ROAD</u><br><u>WEST FRIENDSHIP, MARYLAND 21794</u><br>Suite/Apt. #: _____ SDP/WP/Petition #: _____<br>Census Tract _____ Subdivision <u>SOBUS FARMS</u><br>Section _____ Area _____ Lot <u>12</u><br>Tax Map _____ Parcel _____ Grid _____<br>Zoning _____ Map Coordinates _____ Lot size _____            | Property Owner's Name <u>DONALD &amp; PATRICIA MACKAY</u><br>Address <u>2830 WYNFIELD ROAD</u><br>City <u>WEST FRIENDSHIP</u> State <u>MD</u> Zip Code <u>21794</u><br>Home Phone <u>(410) 489-5656</u> Work Phone <u>(410) 489-3690</u><br>Applicant's Name & Mailing Address, (if other than stated hereon): _____<br>Phone _____ Fax _____ |
| Existing Use <u>SINGLE FAMILY DWELLING</u><br>Proposed Use <u>SAME, WITH POOL</u><br>Estimated Construction Cost \$ <u>21,200.00</u><br>Description of Work <u>CONCRETE INGROUND POOL, WITH DE. FILTER</u><br><u>POOL TO BE FILLED BY TRUCK,</u><br><u>26' WIDE BY 45' LONG, 3' TO 8' DEEP,</u><br><u>NO DIVING BOARD, TOTAL SQ FT = 808</u> | Contractor Company <u>ANTHONY &amp; SYLVAN POOLS, INC.</u><br>Contact Person <u>GEORGE A. SCHWEICH - CONTRACTOR</u><br>Address <u>10840 GUILFORD ROAD, SUITE 407</u><br>City <u>ANNAPOLIS</u> State <u>MD</u> Zip Code <u>20701</u><br>License No. <u>19347</u><br>Phone <u>(301) 490-1930</u> Fax <u>(410) 792-2818</u>                      |
| Occupant or Tenant <u>SAME AS OWNER</u><br>Contact Name _____<br>Address _____<br>City _____ State _____ Zip Code _____<br>Phone _____ Fax _____                                                                                                                                                                                             | Engineer or Architect Company <u>N/A</u><br>Contact Person <u>A</u><br>Address _____<br>City _____ State _____ Zip Code _____<br>Phone _____ Fax _____                                                                                                                                                                                        |

| BUILDING DESCRIPTION - <u>COMMERCIAL</u>                                                                                                                                                                                                                                                                                                                                                |                                                                                                                                                                                                                                                                                                                                                                                                                                                                                                                                                                                                                                                                                                                                                    | BUILDING DESCRIPTION - <u>RESIDENTIAL</u>                                                                                                                                                                                                                                                                                                                                                                                                                                                                                                                                                                                                                                                                                                     |                                                                                                                                                                                                                                                                                                                                                                                                                                                                                                                                                                                                                                                                                                                               |
|-----------------------------------------------------------------------------------------------------------------------------------------------------------------------------------------------------------------------------------------------------------------------------------------------------------------------------------------------------------------------------------------|----------------------------------------------------------------------------------------------------------------------------------------------------------------------------------------------------------------------------------------------------------------------------------------------------------------------------------------------------------------------------------------------------------------------------------------------------------------------------------------------------------------------------------------------------------------------------------------------------------------------------------------------------------------------------------------------------------------------------------------------------|-----------------------------------------------------------------------------------------------------------------------------------------------------------------------------------------------------------------------------------------------------------------------------------------------------------------------------------------------------------------------------------------------------------------------------------------------------------------------------------------------------------------------------------------------------------------------------------------------------------------------------------------------------------------------------------------------------------------------------------------------|-------------------------------------------------------------------------------------------------------------------------------------------------------------------------------------------------------------------------------------------------------------------------------------------------------------------------------------------------------------------------------------------------------------------------------------------------------------------------------------------------------------------------------------------------------------------------------------------------------------------------------------------------------------------------------------------------------------------------------|
| <b>Building Characteristics</b><br>Height: _____<br>No. of stories: _____<br>Gross area, sq. ft. per floor: _____<br>Use group: _____<br>Construction type:<br><input type="checkbox"/> Reinforced Concrete<br><input type="checkbox"/> Structural Steel<br><input type="checkbox"/> Masonry<br><input type="checkbox"/> Wood Frame<br><input type="checkbox"/> State Certified Modular | <b>Utilities</b><br>Water Supply:<br><input type="checkbox"/> Public<br><input type="checkbox"/> Private<br>Sewage Disposal:<br><input type="checkbox"/> Public<br><input type="checkbox"/> Private<br>Electric Yes <input type="checkbox"/> No <input type="checkbox"/><br>Gas Yes <input type="checkbox"/> No <input type="checkbox"/><br>Heating System:<br>Electric <input type="checkbox"/> Oil <input type="checkbox"/><br>Natural Gas <input type="checkbox"/><br>Propane Gas <input type="checkbox"/><br>Sprinkler system: <input type="checkbox"/> N/A <input type="checkbox"/><br><input type="checkbox"/> Full<br><input type="checkbox"/> Partial<br><input type="checkbox"/> Other Suppression<br><input type="checkbox"/> # of Heads | <b>Building Characteristics</b><br>SF Dwelling <input type="checkbox"/> SF Townhouse <input type="checkbox"/><br>Depth Width<br>1st floor: _____<br>2nd floor: _____<br>Basement: _____<br>Finished Basement <input type="checkbox"/> Unfinished Basement <input type="checkbox"/><br>Crawl space <input type="checkbox"/> Slab on Grade <input type="checkbox"/><br>No. of Bedrooms _____<br>Multi-family dwellings:<br>No. of efficiency units: _____<br>No. of 1 BR units: _____<br>No. of 2 BR units: _____<br>No. of 3 BR units: _____<br>Other Structure: <u>INGROUND POOL</u><br>Dimensions: _____<br>Footings: _____<br>Roof: _____<br><input type="checkbox"/> State Certified Modular<br><input type="checkbox"/> Manufactured Home | <b>Utilities</b><br>Water Supply:<br><input type="checkbox"/> Public<br><input checked="" type="checkbox"/> Private<br>Sewage Disposal:<br><input type="checkbox"/> Public<br><input checked="" type="checkbox"/> Private<br>Electric Yes <input type="checkbox"/> No <input type="checkbox"/><br>Gas Yes <input type="checkbox"/> No <input type="checkbox"/><br>Heating System:<br>Electric <input type="checkbox"/> Oil <input type="checkbox"/><br>Natural Gas <input type="checkbox"/><br>Propane Gas <input type="checkbox"/><br>Sprinkler system: <input type="checkbox"/> N/A <input type="checkbox"/><br><input type="checkbox"/> NFPA #13D<br><input type="checkbox"/> NFPA #13R<br><input type="checkbox"/> Other: |

THE UNDERSIGNED HEREBY CERTIFIES AND AGREES AS FOLLOWS: (1) THAT HE/SHE IS AUTHORIZED TO MAKE THIS APPLICATION; (2) THAT THE INFORMATION IS CORRECT; (3) THAT HE/SHE WILL COMPLY WITH ALL REGULATIONS OF HOWARD COUNTY WHICH ARE APPLICABLE THERETO; (4) THAT HE/SHE WILL PERFORM NO WORK ON THE ABOVE REFERENCED PROPERTY NOT SPECIFICALLY DESCRIBED IN THIS APPLICATION; (5) THAT HE/SHE GRANTS COUNTY OFFICIALS THE RIGHT TO ENTER ONTO THIS PROPERTY FOR THE PURPOSE OF INSPECTING THE WORK PERMITTED AND POSTING NOTICES.

George A. Schweich  
Applicant's Signature  
AGENT FOR CONTRACTOR  
Title/Company

GEORGE A. SCHWEICH  
Print Name  
MARCH 23, 2000  
Date

Checks payable to: **DIRECTOR OF FINANCE OF HOWARD COUNTY**  
\*\* PLEASE WRITE NEATLY AND LEGIBLY. \*\*  
- FOR OFFICE USE ONLY -

| AGENCY                | DATE           | SIGNATURE APPROVAL |
|-----------------------|----------------|--------------------|
| Land Development, DPZ |                |                    |
| State Highways        |                |                    |
| Building Official     |                |                    |
| Dev. Engineering, DPZ |                |                    |
| Health                | <u>3/23/00</u> | <u>A. Wall</u>     |
| Fire Protection       |                |                    |

Is Sediment Control approval required prior to issuance?  
YES ☐ NO ☐

CONTINGENCY CONSTRUCTION START: ☐  
ONE STOP SHOP: ☐

**DPZ SETBACK INFORMATION**

Front: \_\_\_\_\_  
Rear: \_\_\_\_\_  
Side: \_\_\_\_\_  
Side St.: \_\_\_\_\_  
All minimum setbacks met?  
YES ☐ NO ☐  
Is Entrance Permit required?  
YES ☐ NO ☐  
Historic District?  
YES ☐ NO ☐  
Lot Coverage for NewTown Zone \_\_\_\_\_  
SDP/Red-line approval date \_\_\_\_\_

**PROPERTY ID#:**

|                  |    |
|------------------|----|
| Filing fee       | \$ |
| Permit fee       | \$ |
| Excise tax       | \$ |
| Sub-total paid   | \$ |
| Add'l permit fee | \$ |
| TOTAL FEES       | \$ |
| Balance due      | \$ |
| Check            | #  |
| Validation       | #  |

Accepted by \_\_\_\_\_

Distribution of Copies- White: Building Official Green: LDD, DPZ Yellow: DED, DPZ Pink: Health Gold: SHA