

3/23/66
4/4/66

PERMIT

SEWAGE DISPOSAL SYSTEM

MARYLAND STATE DEPARTMENT OF HEALTH

HOWARD COUNTY

INDEXED

ELLICOTT CITY

DISTRICT 6

DATE 3/22/66

P 11609

A 40077K
68362

Jesse Bradford

IS PERMITTED TO INSTALL ☒ ALTER

ADDRESS Rt. 1 - Box 1450 - Mitchellville, Md.

PHONE

577-6464
677-6464

A SEWAGE DISPOSAL SYSTEM LOCATED AT

727-0868 (Pardonick)
(Boulder - Balto)

SUBDIVISION

ROAD

Kindler Rd. near LOT B
Gorman Rd. - Hammond Park

PROPERTY OWNER

Aladdin Construction Corp.

ADDRESS

SPECIFICATIONS - 3 bedrooms

DRAIN FIELD DEPTH FEET, BOTTOM AREA SQ. FT.

SEEPAGE PITS ABSORBENT SIDE-WALL AREA SQ. FT.

SEPTIC TANK CAPACITY 750 GALLONS

FOR GARBAGE GRINDER, INCREASE DISPOSAL AREA 22% & TANK CAPACITY 50%.

OTHER Dry well - 300 sq. ft. sidewall area below inlet pipe.

Inlet pipe must be 4 ft. below grade.

Place dry well about 120 ft. from front lot line and about 50 ft. from
right side line as seen when facing lot from Kindler Rd.


PLANS APPROVED BY D. W. Monaghan

DATE 5/12/64

FILL SEPTIC TANK AND DISTRIBUTION BOX WITH WATER BEFORE CALLING FOR AN INSPECTION. COVER NO WORK
UNTIL INSPECTED AND APPROVED.

NEITHER THE HOWARD COUNTY COMMISSIONERS NOR THE HEALTH DEPARTMENT IS RESPONSIBLE FOR THE
SUCCESSFUL OPERATION OF ANY SYSTEM.

40077K
68362

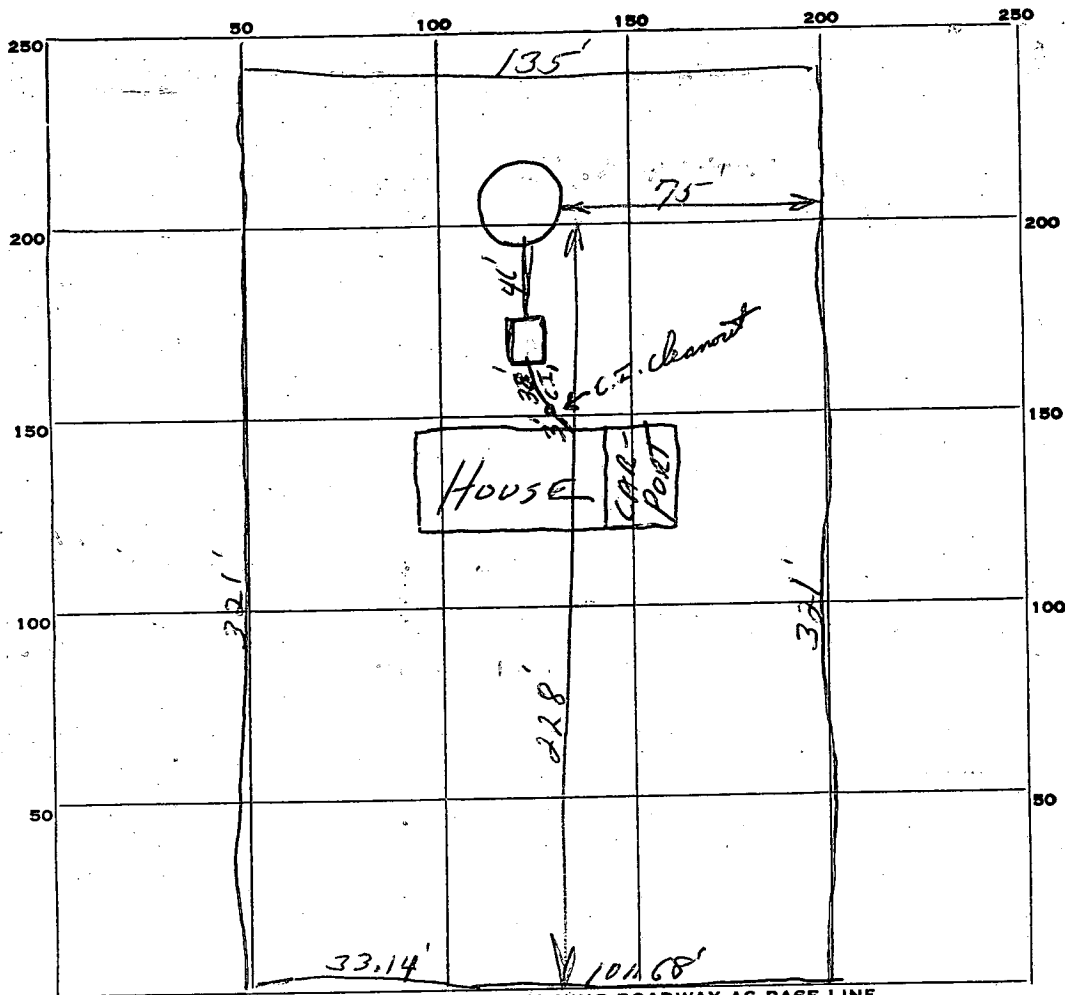

INDICATE NORTH - NAME ADJOINING ROADWAY AS BASE LINE.

KINDLER ROAD

PERMIT CARD None Seen

SEPTIC TANK, LEVEL 1000 gal. concrete CLEANOUTS _____

DISTRIBUTION BOX, LEVEL _____

TILE FIELD, DEPTH _____ FT. TRENCH WIDTH _____ FT.

GRAVEL DEPTH _____ IN. TOTAL LENGTH _____ FT.

NUMBER OF TRENCHES _____ TOTAL BOTTOM AREA _____

SEEPAGE PITS, INSIDE DIAMETER 9 FT. DEPTH BELOW INLET 13 1/2 FT.

ABSORBENT AREA _____ SQ. FT.

REMARKS 3-23-66 No pipe home to tank. No standpipe.

Not in area tested - need retest. JH.

3-28-66 Retested where dry well installed - present dry well

OK - 8 min per. Test. To phone when pipe in from house to

tank + standpipe installed. JH. 4-4-66 Nothing done since 3-28-66 JH.

4-15-66 Sewer House to tank installed. Standpipes not in. Tank 1 1/2 to 2 ft

below grade. No test

DATE SYSTEM APPROVED 4-15-66 INSPECTOR J. S. Hemminger

APPLICATION

SEWAGE DISPOSAL TESTING

MARYLAND STATE DEPARTMENT OF HEALTH

A 08361

P

HOWARD COUNTY

ELLICOTT CITY

Septic Tank - 750 gal.

DISTRICT 6

Dry Well - 300 sq ft sidewall area below inlet
Pipe. Inlet pipe must be 4 ft below grade.

DATE 5/7/64

Place Dry Well about 120 ft from front lot line and about
50 ft from right sidewalk as shown when facing lot from
Kindler Rd.

TO: THE COUNTY HEALTH OFFICER
ELLICOTT CITY, MARYLAND

I, HEREBY, APPLY FOR THE NECESSARY TESTS IN ORDER TO CONSTRUCT (OR RECONSTRUCT) A SEWAGE
DISPOSAL SYSTEM.

PROPERTY OWNER Aladdin Construction Corp.

ADDRESS RFD 1 Montgomery Road, Ellicott City, Md. PHONE 796-2055

PROPERTY LOCATION:

SUBDIVISION LOT NO. B

ROAD AND DESCRIPTION Kindler Road near Gorman Road - Hammond Park

OCCUPANT PHONE

PERSON TO CONSTRUCT SYSTEM

ADDRESS PHONE

SIZE OF LOT 43,200 TYPE BLDG. 3
NUMBER OF BEDROOMS

IF NOT SINGLE RESIDENCE DESCRIBE

SIGNATURE OF APPLICANT Joseph Martellini


APPROVED BY Du Monaghan FOR Dry Well DATE 5/12/64
(KIND OF SYSTEM)

REJECTED BY FOR DATE
(KIND OF SYSTEM)

HOLD PENDING FURTHER TESTS DATE

REASONS FOR REJECTION OR HOLDING

THIS IS NOT A PERMIT

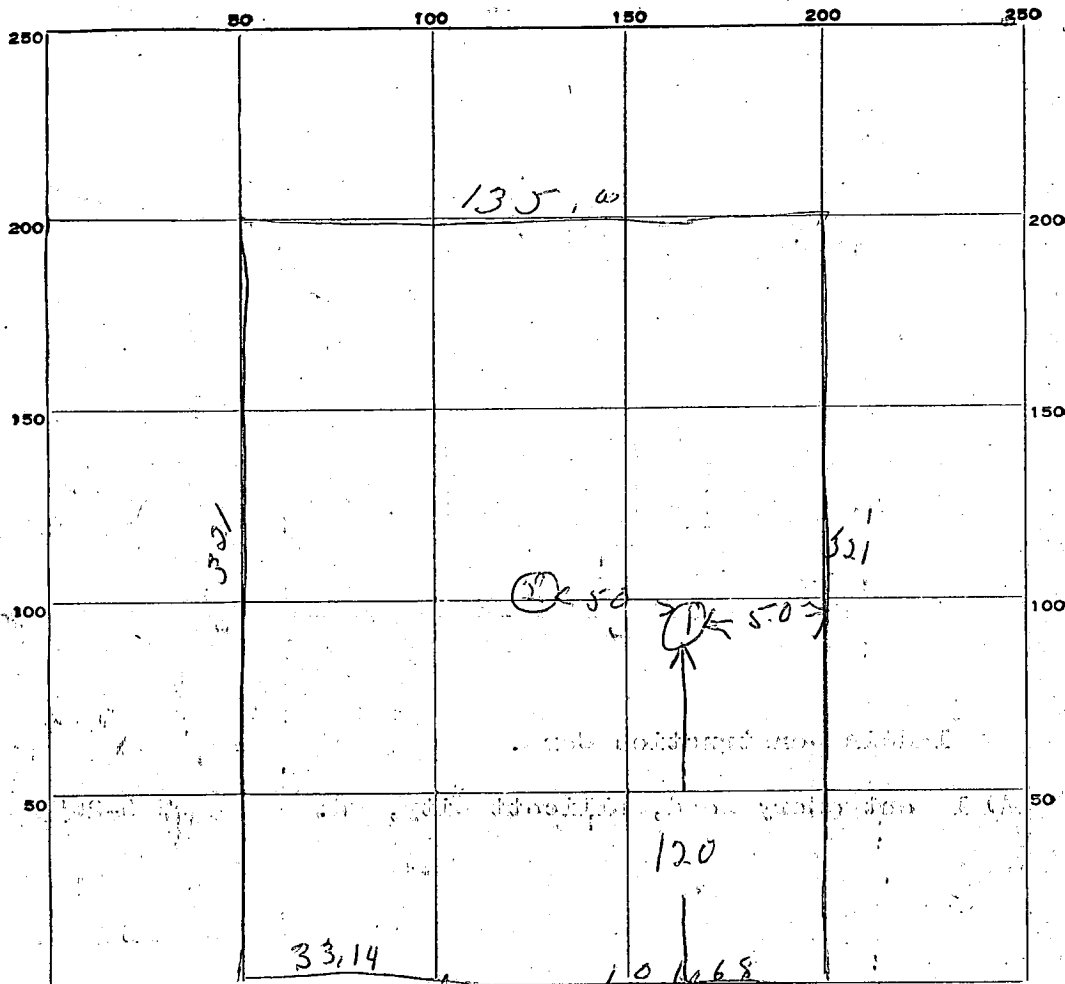

INDICATE NORTH. NAME ADJOINING ROADWAY AS BASE LINE.

Kneller Rd

DATE	TEST NO.	DEPTH	PRE-WET		TEST - 1" DROP		TIME
			START	STOP	START	STOP	
5/12/64	1	9 ft	1038	1040	1040	1048	8 min
	2	9 ft	1053	1058	1058	1106	8 min

SOIL AUGER FINDING

TESTED BY *Dean 5/12/64*

REMARKS

ALSO PRESENT *Joseph Mauter* LOT NO. *B*