

PERMIT

SEWAGE DISPOSAL SYSTEM

MARYLAND STATE DEPARTMENT OF HEALTH

HOWARD COUNTY

BUREAU OF ENVIRONMENTAL HEALTH

461-9933

P 43592

A REPAIR

DISTRICT 5th

DATE 2/6/89

DATE SYSTEM APPROVED 12/12/88

INSPECTOR AK/CW

12 INDEXED

Jack Fyock

IS PERMITTED TO INSTALL ALTER X

ADDRESS PHONE 988-9270

SUBDIVISION Holiday Hills ROAD Vista LOT 38, Sec. 1

PROPERTY OWNER

ADDRESS

IF GARBAGE GRINDER IS USED INCREASE SEPTIC TANK CAPACITY BY 50% AND ABSORPTION AREA BY 22%.

GARBAGE GRINDER? YES NO

SEPTIC TANK CAPACITY GALLONS NUMBER OF BEDROOMS

REPAIR - CALL FOR INSPECTION WHEN GROUND IS OPENED UP SO SANITARIAN CAN RECOMMEND REPAIR.

LEACHIN BED 8'X5'0" OK TO BE WITH IN
15 FT OF HOUSE 12/12/88 CW
HOUSE HAS WALK OUT BASEMENT

PLANS APPROVED BY Craig Williams DATE 12/09/88

COVER NO WORK UNTIL INSPECTED AND APPROVED

NEITHER THE HOWARD COUNTY COUNCIL NOR THE HEALTH DEPARTMENT IS RESPONSIBLE FOR THE SUCCESSFUL OPERATION OF ANY SYSTEM

NOTE: CLEANOUT REQUIRED EVERY 70 FEET OF SEWER LINE AND/OR AT 90° SWEEPS IN LINES FROM HOUSE TO DRAIN FIELDS

NOTE: ALL PARTS OF SEPTIC SYSTEMS (I.E. TANK, DISTRIBUTION BOX, TRENCHES) TO BE 100 FEET FROM WELL (UNLESS OTHERWISE SPECIFICALLY AUTHORIZED)

NOTE: IF DEEP TRENCH(ES) ARE USED CALL FOR INSPECTION BEFORE AND AFTER PLACING GRAVEL IN TRENCH(ES)

NOTE: NO DRY WELL SHALL EXCEED 15 FOOT IN DIAMETER NO ABSORPTION TRENCH TO EXCEED 100 FEET IN LENGTH.

NOTE: ALL PIPE FROM HOUSE TO SEPTIC TANK MUST BE CAST IRON OR SCHEDULE 40 PVC OR ABS

PERMIT VOID AFTER TWO YEARS


NOTE: INSTALL STAND PIPE ON SEPTIC TANK AND DRY WELL. STAND PIPES MUST BE 6 INCHES IN DIAMETER. CAST IRON, CONCRETE OR TERRA COTTA OR PVC OR ABS ACCEPTED. IF TOP OF SEPTIC TANK IS DEEPER THAN 3 FEET, MANHOLE TO GRADE REQUIRED

NOTE: DISTRIBUTION BOXES MUST HAVE BAFFLES

*INSTALLER IS RESPONSIBLE FOR OBTAINING FINAL APROVAL ON THIS PERMIT

*CALL 461-9933 FOR INSPECTION OF SEPTIC SYSTEMS.

P43592

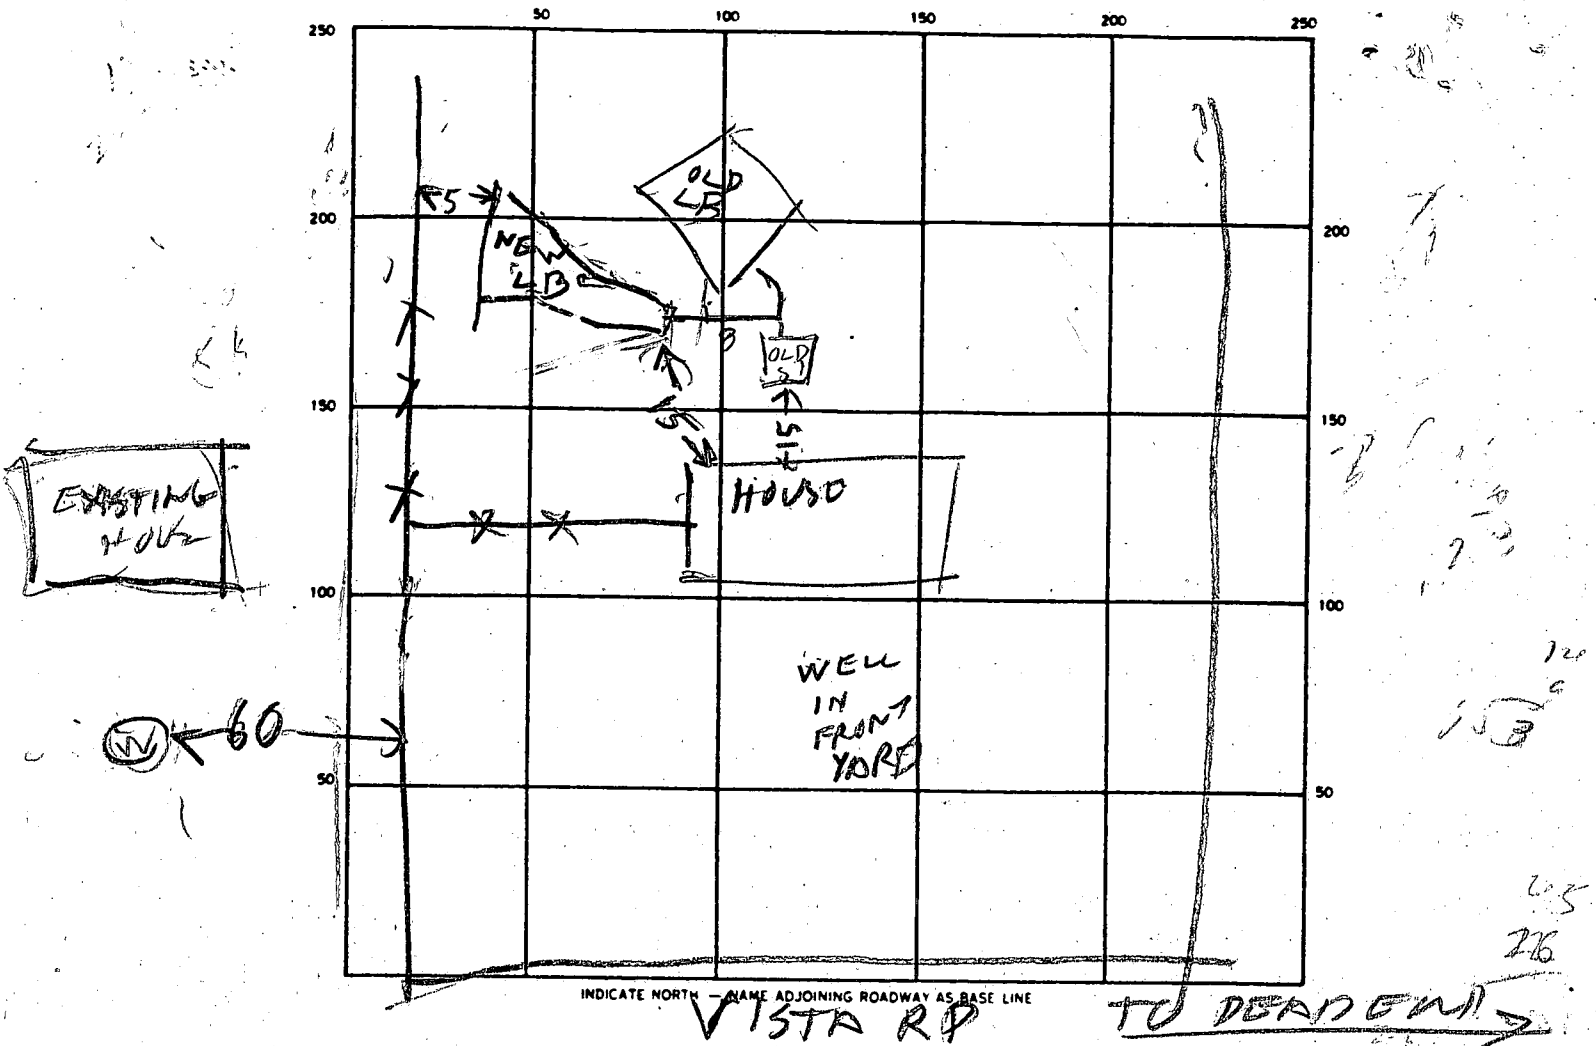

SEPTIC TANK. LEVEL _____ CLEANOUTS _____

DISTRIBUTION BOX. LEVEL _____

DRAIN FIELD/TILE FIELD. DEPTH 5 FT. TRENCH WIDTH 7-12 FT. INLET DEPTH _____ FT.

EFFECTIVE GRAVEL DEPTH 2 FT. TOTAL LENGTH 45 FT.

NUMBER OF TRENCHES 1 ONE SIDEWALL/BOTTOM AREA 430 SQ. FT.

DRYWELL INSIDE DIAMETER _____ FT. EFFECTIVE DEPTH BELOW INLET _____ FT.

ABSORBENT AREA _____ SQ. FT.

REMARKS 12/12/88 AM BED PARTLY DUG & SOME STONE
ADDED. RH 12/12/88 PM BED FINISHED &
CONNECTED TO TANK RH

DATE SYSTEM APPROVED

12/12/88

INSPECTOR

R. HOGGESS / C. W. L. L.

ch out. 11/20/61 approved JH

PERMIT

SEWAGE DISPOSAL SYSTEM

P 04251

A 04127

INDEXED

MARYLAND STATE DEPARTMENT OF HEALTH

HOWARD COUNTY

ELLICOTT CITY

DISTRICT 5

DATE 9-14-61

INDEXED

Tattrie and Levy Construction Co.

IS PERMITTED TO INSTALL ☒ ALTER

ADDRESS Simpsonville PHONE

A SEWAGE DISPOSAL SYSTEM LOCATED AT

SUBDIVISION Holiday Hills ROAD Vista LOT 38 sec. 1

PROPERTY OWNER Lewis E. Maul

ADDRESS Kensington, Md.

SPECIFICATIONS

DRAIN FIELD DEPTH FEET, BOTTOM AREA SQ. FT.

SEEPAGE PITS ABSORBENT SIDE-WALL AREA SQ. FT.

SEPTIC TANK CAPACITY 750 GALLONS

FOR GARBAGE GRINDER, INCREASE DISPOSAL AREA 22% & TANK CAPACITY 50%.

OTHER Leaching Bed 360 sq. ft. of bottom area. Depth of bed 11 ft. from original
original grade and 5 ft. from the finished grade. Locate bed 120 ft. from the front
property line and 25 ft. from the left side property line. Left side property line
determined when facing lot from Vista Road


PLANS APPROVED BY James E. Hennigan DATE 8-16-61

FILL SEPTIC TANK AND DISTRIBUTION BOX WITH WATER BEFORE CALLING FOR AN INSPECTION. COVER NO WORK
UNTIL INSPECTED AND APPROVED.

NEITHER THE HOWARD COUNTY COMMISSIONERS NOR THE HEALTH DEPARTMENT IS RESPONSIBLE FOR THE
SUCCESSFUL OPERATION OF ANY SYSTEM.

BLDG. PERMIT SIGNED
AND RETURNED 9/2/64
Serial # 57327
Pool.

A 04127

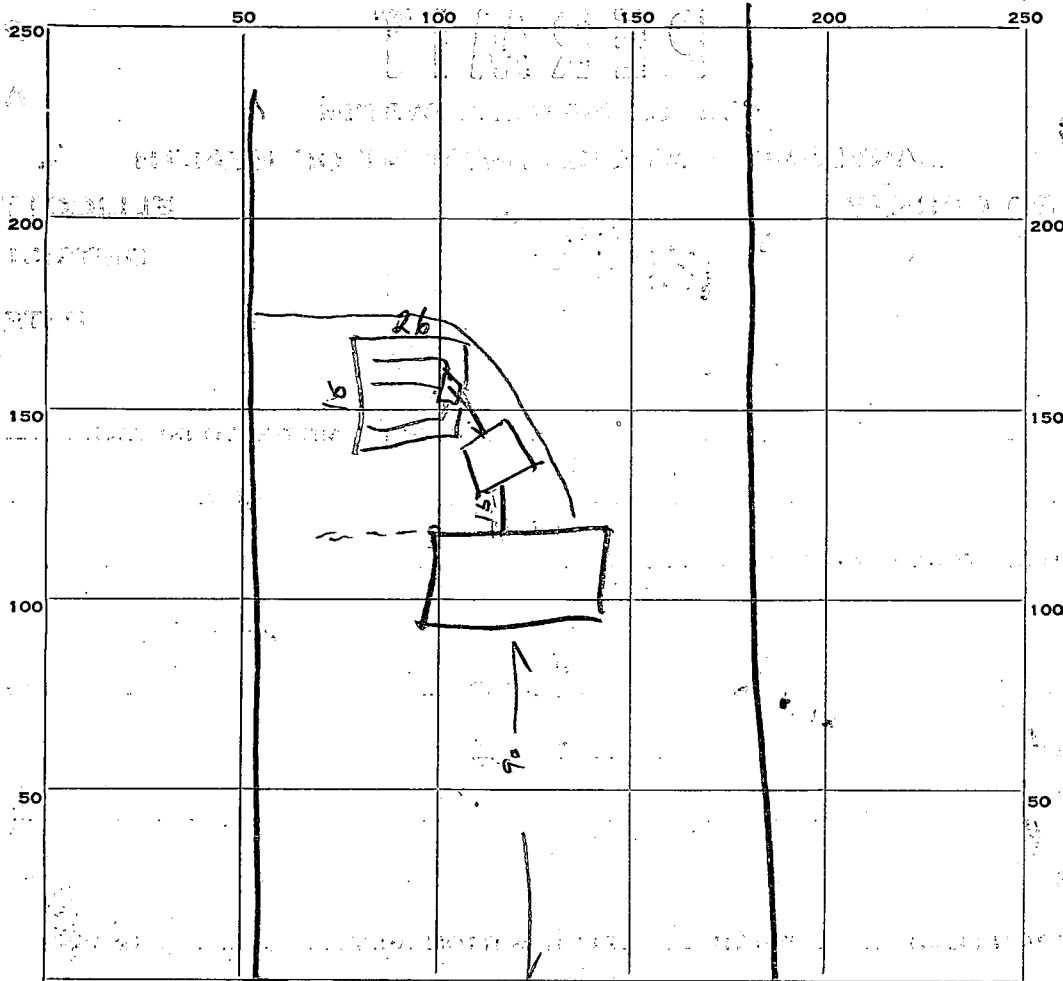

INDICATE NORTH. - NAME ADJOINING ROADWAY AS BASE LINE.

PERMIT CARD OR

SEPTIC TANK, LEVEL OK 750 CLEANOUTS OK 811

DISTRIBUTION BOX, LEVEL OK

TILE FIELD, DEPTH _____ FT. TRENCH WIDTH _____ FT.

GRAVEL DEPTH _____ IN. TOTAL LENGTH _____ FT.

NUMBER OF TRENCHES _____ TOTAL BOTTOM AREA _____

SEEPAGE PITS, INSIDE DIAMETER _____ FT. DEPTH BELOW INLET _____ FT.

ABSORBENT AREA _____ SQ. FT.

REMARKS: Leaching Bed 7 ft to 8 ft 16 ft x 26 ft
= 416 sq ft bottom area
Lot was cut in area of Leaching Bed

DATE SYSTEM APPROVED 20 NOV 61 INSPECTOR Raymond H. Hays

APPLICATION

SEWAGE DISPOSAL TESTING

MARYLAND STATE DEPARTMENT OF HEALTH

HOWARD COUNTY

ELLICOTT CITY

DISTRICT 5

DATE 8-14-61

Leaching bed 360 sq. FT. of bottom area. Depth of bed 11 ft. from original grade and 5 ft. from the finished grade. For a bed 120 ft. from the front property line and 25 ft. from the left side property line. Left side property line determined when facing lot from Vista road.

TO: THE COUNTY HEALTH OFFICER
ELLICOTT CITY, MARYLAND

750 gal. septic Tank

I, HEREBY, APPLY FOR THE NECESSARY TESTS IN ORDER TO CONSTRUCT (OR RECONSTRUCT) A SEWAGE DISPOSAL SYSTEM.

PROPERTY OWNER Lewis E. Paul

ADDRESS 5011 Avroca Drive, Kensington, Md PHONE WA 2-5344

PROPERTY LOCATION:

SUBDIVISION Hood Hoilday Hills LOT NO. 38 Sec. 1

ROAD AND DESCRIPTION Vista Rd. Vista

OCCUPANT _____ PHONE _____

PERSON TO CONSTRUCT SYSTEM _____

ADDRESS _____ PHONE _____

SIZE OF LOT 1 acre TYPE BLDG. 3 NUMBER OF BEDROOMS _____

IF NOT SINGLE RESIDENCE DESCRIBE _____

SIGNATURE OF APPLICANT *L. E. Paul*


APPROVED BY *Hennigan* FOR *Leaching bed* DATE 8-16-61

REJECTED BY _____ FOR _____ DATE _____

HOLD PENDING FURTHER TESTS _____ DATE _____

REASONS FOR REJECTION OR HOLDING _____

THIS IS NOT A PERMIT

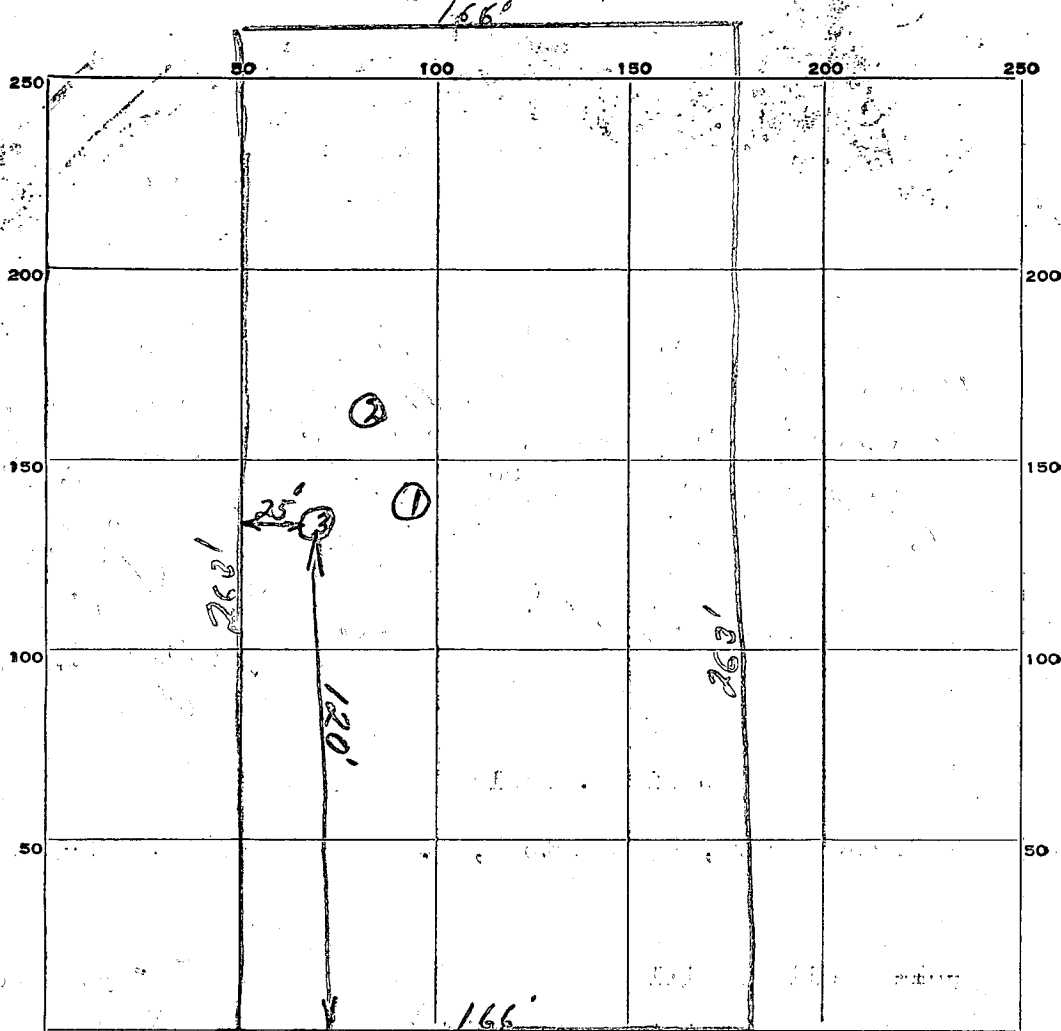

INDICATE NORTH. - NAME ADJOINING ROADWAY AS BASE LINE.

VISTA ROAD

DATE	TEST NO.	DEPTH	PRE-WET		TEST - 1" DROP		TIME
			START	STOP	START	STOP	
8-16-61	1	11'	10:24	10:36	10:36	10:49	13 Minutes
	2	9'	10:27	10:31	10:31	10:37	6 Minutes
	3	11'	10:30	10:42	10:42	10:57	15 Minutes

SOIL AUGER FINDING

TESTED BY

REMARKS

ALSO PRESENT

LOT NO.

38- Sec 1

To cut 6 FT off original grade - lot high on hill.

A hand-drawn sketch on a grid map. The grid has horizontal and vertical lines with numerical labels (50, 100, 150, 200, 250) along the top and right edges. The sketch shows a route starting at a point labeled '26' and proceeding through points labeled '16', '15', and '90'. The route is marked with a solid line and a dashed line. There are also some other markings, including a small square and a line segment labeled '15'.

DATE SYSTEM APPROVED

INSPECTOR