

PERMIT

SEWAGE DISPOSAL SYSTEM

DEPARTMENT OF HEALTH AND MENTAL HYGIENE

HOWARD COUNTY HEALTH DEPARTMENT

BUREAU OF ENVIRONMENTAL HEALTH

~~XXXXXXXX~~ 313-2640

P 49190

A REPAIR

DISTRICT _____

DATE 4/23/93

DATE SYSTEM APPROVED 5/18/93

INSPECTOR RH

Fogle's Septic Clean

IS PERMITTED TO INSTALL _____ ALTER X

ADDRESS 558R Obrecht Road, Sykesville, Maryland 21784 PHONE 795-5674

SUBDIVISION River Park Estates LOT 39 ROAD 1019 Taylor Park Road

PROPERTY OWNER Nancy Shulski Frank J + Ann Marie Richimelli

1019 Taylor Park Road

ADDRESS _____

SEPTIC TANK CAPACITY 1250 GALLONS

NUMBER OF BEDROOMS 4

125 SQUARE FEET PER BEDROOM 500 SQ FT

LINEAR FEET OF TRENCH REQUIRED 166

REPAIR - PURPOSE - SEPTIC SYSTEM HAS FAILED.

Call for inspection when ground is opened so sanitarian can recommend repair. 4/22/93

5/21/93

SHALLOW TRENCHES - 3 FT 7 WIDE 6-7 FT DEEP 2 FT
STONE & RUN TRENCHES OVER TANK USE
DRY WELL AS AN OVERFLOW AFTER DRAIN
FIELD IS FULL RH

PLANS APPROVED BY _____ DATE _____

COVER NO WORK UNTIL INSPECTED AND APPROVED

NEITHER THE HOWARD COUNTY COUNCIL NOR THE HEALTH DEPARTMENT IS RESPONSIBLE FOR THE SUCCESSFUL OPERATION OF ANY SYSTEM

NOTE: CLEANOUT REQUIRED EVERY 70 FEET OF SEWER LINE AND/OR AT 90° SWEEPS IN LINES FROM HOUSE TO DRAIN FIELDS, 90° ELBOWS NOT ACCEPTABLE.

NOTE: ALL PARTS OF SEPTIC SYSTEMS (I.E. TANK, DISTRIBUTION BOX TRENCHES) TO BE 100 FEET FROM WELL (UNLESS OTHERWISE SPECIFICALLY AUTHORIZED)

NOTE: IF DEEP TRENCH(ES) ARE USED CALL FOR INSPECTION BEFORE AND AFTER PLACING GRAVEL IN TRENCH(ES)

NOTE: NO DRY WELL SHALL EXCEED 15 FOOT IN DIAMETER NO ABSORPTION TRENCH TO EXCEED 100 FEET IN LENGTH

NOTE: ALL PIPE FROM HOUSE TO SEPTIC TANK MUST BE CAST IRON OR SCHEDULE 35/40 PVC OR ABS

PERMIT VOID AFTER TWO YEARS

NOTE: INSTALL STAND PIPE ON SEPTIC TANK AND DRY WELL STAND PIPES MUST BE 6 INCHES IN DIAMETER CAST IRON, CONCRETE OR TERRA COTTA OR PVA OR ABS ACCEPTED. IF TOP OF SEPTIC TANK IS DEEPER THAN 3 FEET. MANHOLE TO GRADE REQUIRED.

NOTE: DISTRIBUTION BOXES MUST HAVE BAFFLES

*INSTALLER IS RESPONSIBLE FOR OBTAINING FINAL APPROVAL ON THIS PERMIT


BLDG. PERMIT SIGNED

AND RETURNED 7/18/94

Serial # 55368

Abnerquend prd

P 49190

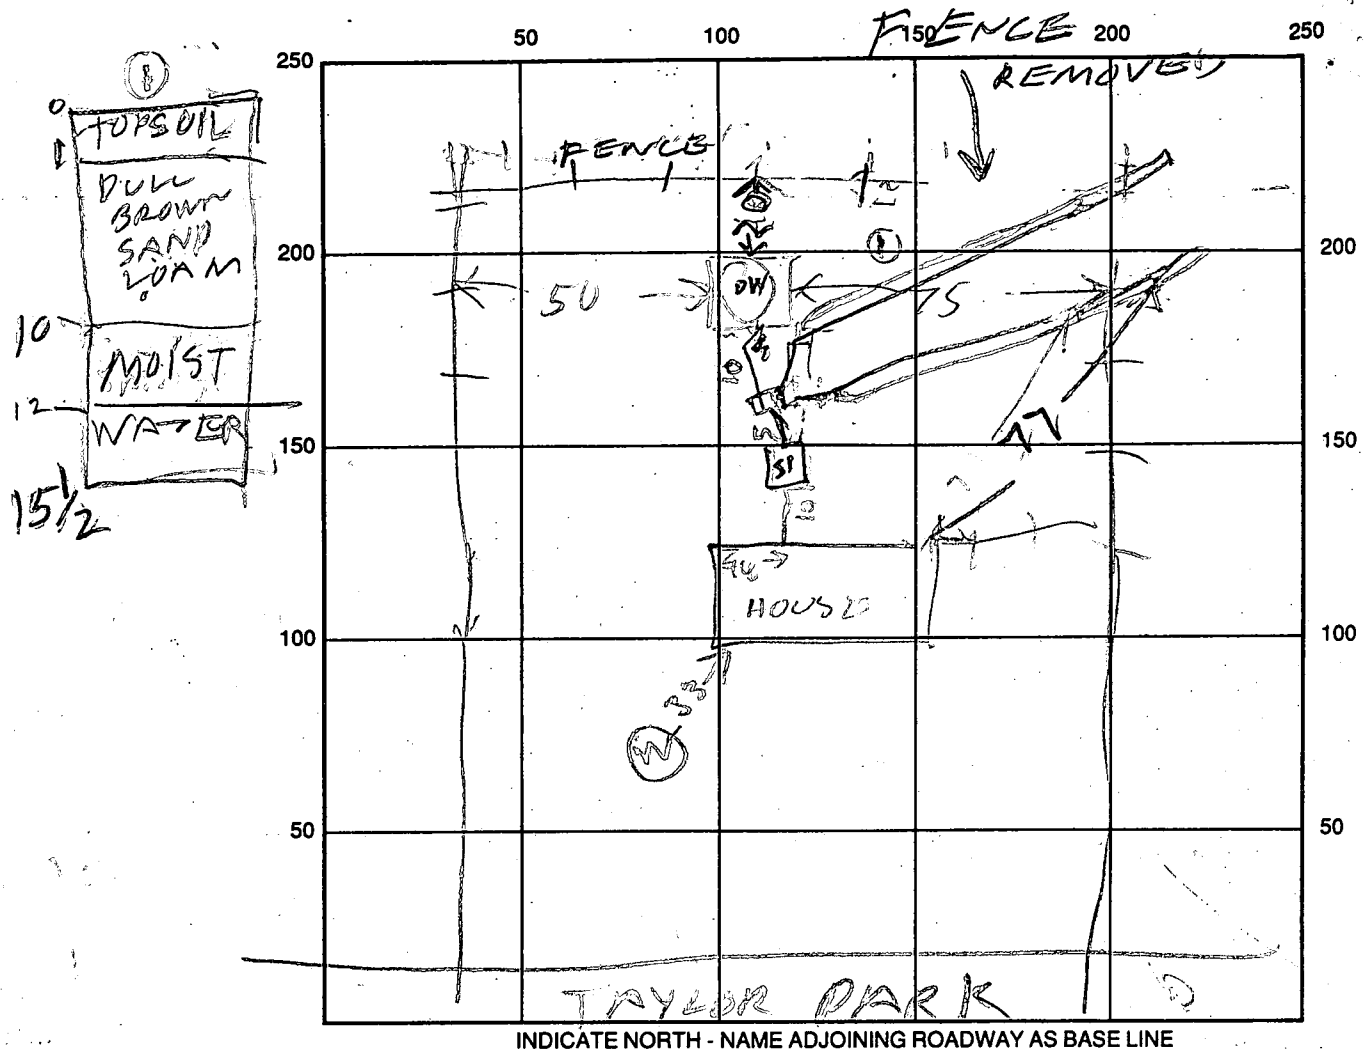

SEPTIC TANK LEVEL _____ CLEANOUTS _____

DISTRIBUTION BOX LEVEL _____

DRAIN FIELD/TITLE DEPTH 6-7 FT. TRENCH WIDTH 3 FT. INLET DEPTH 4 FT.

EFFECTIVE GRAVEL DEPTH 2-1 FT. TOTAL LENGTH 23/24 FT.

NUMBER OF TRENCHES 2 ONE SIDEWALL/BOTTOM AREA _____ SQ. FT.

DRYWALL INSIDE DIAMETER _____ FT. EFFECTIVE DEPTH BELOW INLET _____ FT.

WOLD	DATE	ABSORBENT AREA	PERMIT	START	STOP	SQ. FT.	START	STOP	TIME	REMARKS
1	5/21/93	51	945	947	947	953	6			PERCOK SHALLOW
1	5/21/93	3	958	1000	1000	1002	2			SYSTEM
	5/193									TRENCHES OK. IIR TRENCHES RILL UP, OVERFLOW WILL GO TO OLD DRY WELL R/H

DATE SYSTEM APPROVED

5/25/93

INSPECTOR

Raymond Stodger

PERMIT

SEWAGE DISPOSAL SYSTEM

MARYLAND STATE DEPARTMENT OF HEALTH

HOWARD COUNTY

ELLICOTT CITY

DISTRICT 3

DATE 12/5/72

INDEXED

Roland Barth

IS PERMITTED TO INSTALL X ALTER

ADDRESS Clarksville Pike, Ellicott City, Md.

PHONE 730-8495

A SEWAGE DISPOSAL SYSTEM LOCATED AT

SUBDIVISION River Park Estates

ROAD Taylor Park

LOT 39

PROPERTY OWNER Ben Catchings & wife

ADDRESS

SPECIFICATIONS - 3 bedrooms

DRAIN FIELD DEPTH FEET, BOTTOM AREA SQ. FT.

SEEPAGE PITS ABSORBENT SIDE-WALL AREA SQ. FT.

SEPTIC TANK CAPACITY 1,000 GALLONS

FOR GARBAGE GRINDER, INCREASE DISPOSAL AREA 22% & TANK CAPACITY 50%.

OTHER Dry well - 360 sq. ft. sidewall area below the inlet with maximum depth of

10 ft. Place the dry well 110 ft. to 130 ft. from the front lot line and 30 ft. to 50 ft.

from the left side of the lot as seen when facing the lot from Taylor Park Road.

NOTE: ALL PIPE FROM HOUSE TO SEPTIC TANK MUST BE CAST IRON.

PERMIT VOID AFTER THREE YEARS.

NOTE:: INSTALL STAND PIPE ON SEPTIC TANK AND DRY WELL.

NOTE: CALL FOR INSPECTION WHEN DRY WELL IS EXCAVATED BEFORE ANY CONSTRUCTION IS BEGUN.

PLANS APPROVED BY Raymond Hodges

DATE 4/11/67


FILL SEPTIC TANK AND DISTRIBUTION BOX WITH WATER BEFORE CALLING FOR AN INSPECTION. COVER NO WORK UNTIL INSPECTED AND APPROVED.

NEITHER THE HOWARD COUNTY COMMISSIONERS NOR THE HEALTH DEPARTMENT IS RESPONSIBLE FOR THE SUCCESSFUL OPERATION OF ANY SYSTEM.

12-13-72. 11 ft. hole ok good for 3 ft.

permit released L.

A 11924

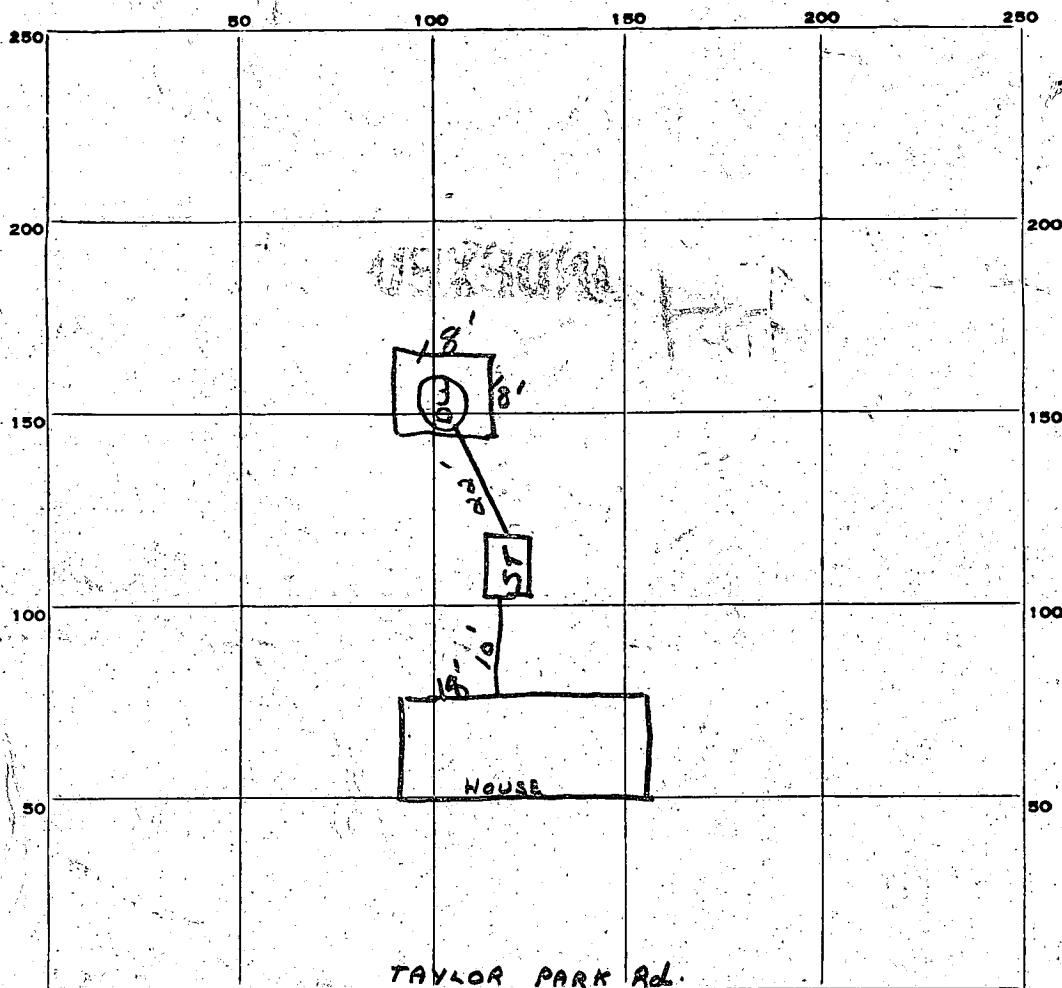

INDICATE NORTH. - NAME ADJOINING ROADWAY AS BASE LINE.

PERMIT CARD

SEPTIC TANK, LEVEL 1000 gal.

CLEANOUTS OK

DISTRIBUTION BOX, LEVEL -

TILE FIELD, DEPTH - FT. TRENCH WIDTH - FT.

GRAVEL DEPTH - IN. TOTAL LENGTH - FT.

NUMBER OF TRENCHES -

TOTAL BOTTOM AREA -

SEEPAGE PITS, outside perimeter 18 x 18 FT. DEPTH BELOW INLET 5 FT.

ABSORBENT AREA 360 SQ. FT.

REMARKS

3/14/73 - Left note to install removable cap
in cleanout on S.T. Bath has been
told several times. Dave OK to
backfill but will not approve until
this is done. Cap installed.

DATE SYSTEM APPROVED 3/17/73

INSPECTOR R. Tove

APPLICATION

SEWAGE DISPOSAL TESTING

MARYLAND STATE DEPARTMENT OF HEALTH

A 11924

P _____

HOWARD COUNTY

3 BEDROOMS

ELLICOTT CITY

DISTRICT Third

Dry Well - 360 sqft

Dry Well - 480 sqft

DATE June 20, 196

sidewall area below
the inlet with maximum
depth of 12 ft

sidewall area with below
the inlet with maximum
depth of 12 ft

Place the dry well 110 ft to 130 ft from the
front lot line and 30 ft to 50 ft from the
left side of the lot as seen
when facing the lot from

TO: THE COUNTY HEALTH OFFICER

ELLICOTT CITY, MARYLAND

I, HEREBY, APPLY FOR THE NECESSARY TESTS IN ORDER TO CONSTRUCT (OR RECONSTRUCT) A SEWAGE DISPOSAL SYSTEM. Taylor Park Road.

PROPERTY OWNER Ben Catchings & Loris S. Catchings his wife

ADDRESS 1411 Winston Ave., Baltimore, Md. 21212

PHONE ID. 5-8417

PROPERTY LOCATION:

SUBDIVISION River Park Estates

LOT NO. 39

ROAD AND DESCRIPTION East side of Taylor Park Road, per plat

OCCUPANT _____

PHONE _____

PERSON TO CONSTRUCT SYSTEM _____

ADDRESS _____

PHONE _____

SIZE OF LOT 125' front by 140' on southern line &
410' on northern line

TYPE BLDG. (3) or 4

NUMBER OF BEDROOMS

IF NOT SINGLE RESIDENCE DESCRIBE _____

SIGNATURE OF APPLICANT

APPROVED BY

FOR

(KIND OF SYSTEM)

DATE

REJECTED BY

FOR

(KIND OF SYSTEM)

DATE

HOLD PENDING FURTHER TESTS

DATE 6/23/66


REASONS FOR REJECTION OR HOLDING

6/23/66 - Hold for (1) Final Plat & (2) Special
plans showing location & elevation of house, house sewer
tank & dry well. Also building setback. Be changed
17 OCT 66. Corollaries changed so Special Plans Not necessary

THIS IS NOT A PERMIT

11 APR 67
Final Plat OK


#16224 del Ray ~~Stair~~
12/13/72

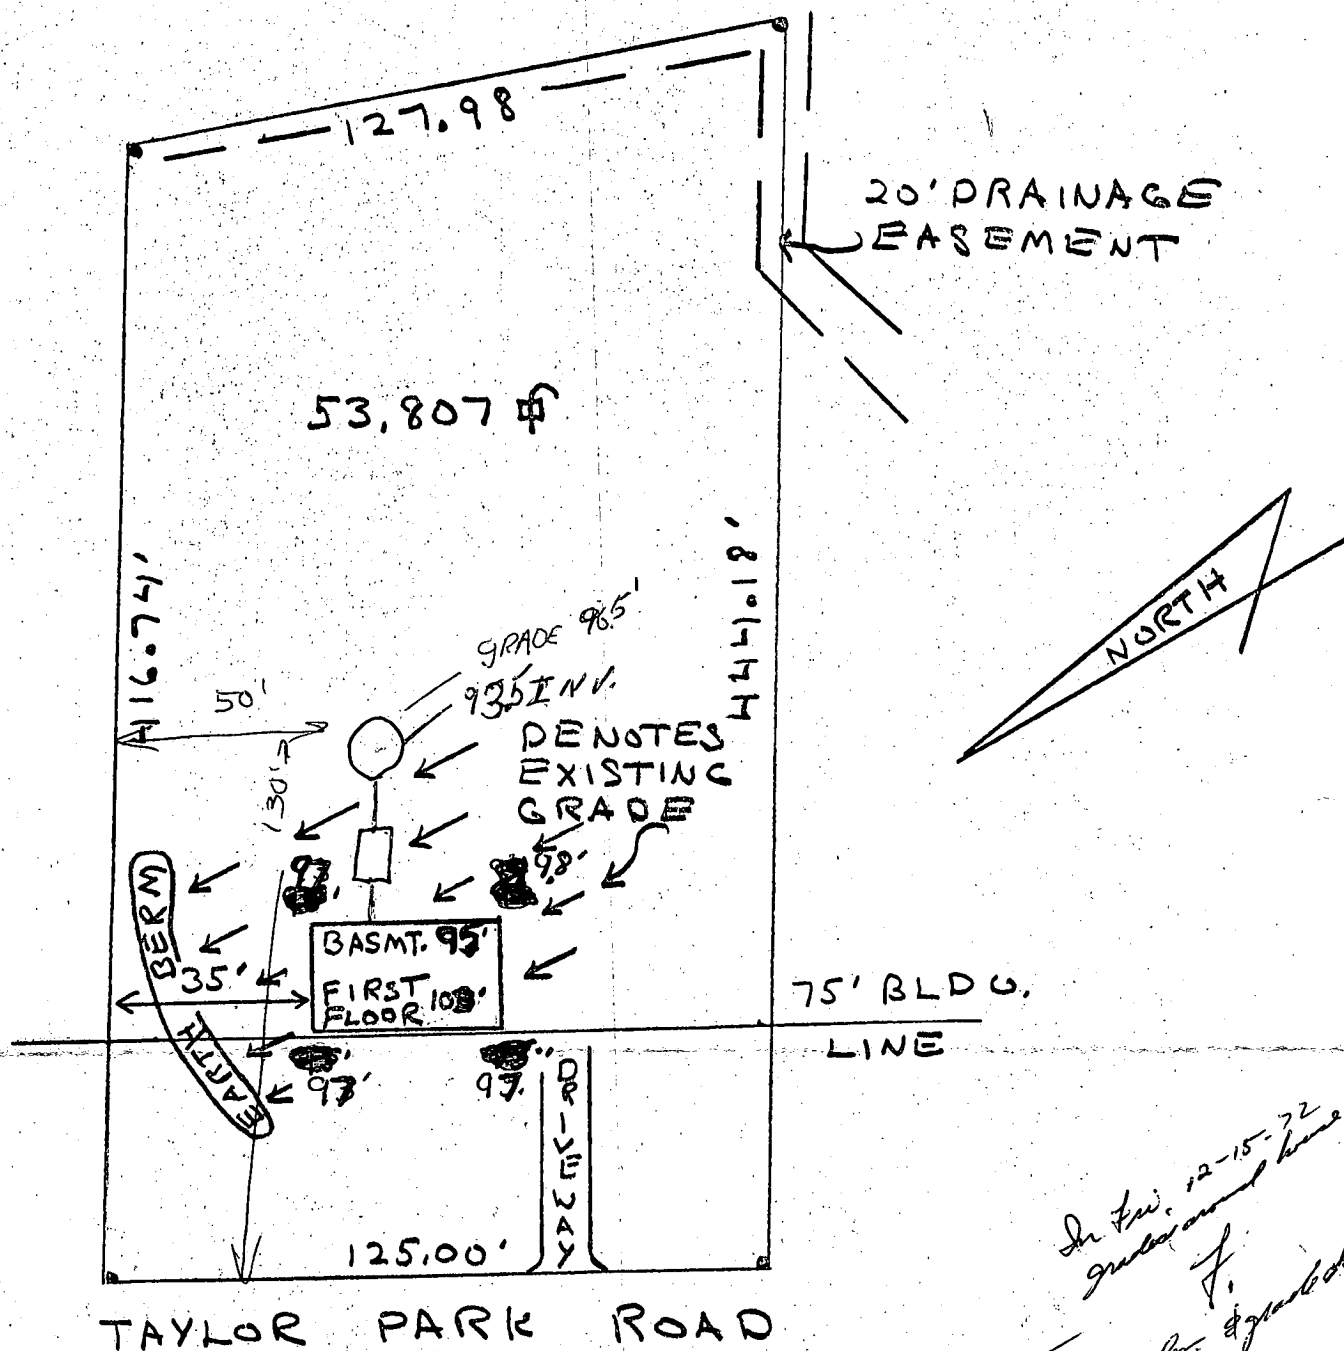

In Feb. 12-15-72
gravel around house dg.
F.
better, sbr. & gravel dg.

12/18/72 - 2:40 PM
bringing house
up at least 4 ft.
Stair


LOT 39 SECTION 4 RIVER PARK ESTATE
3RD DISTRICT R40 ZONING

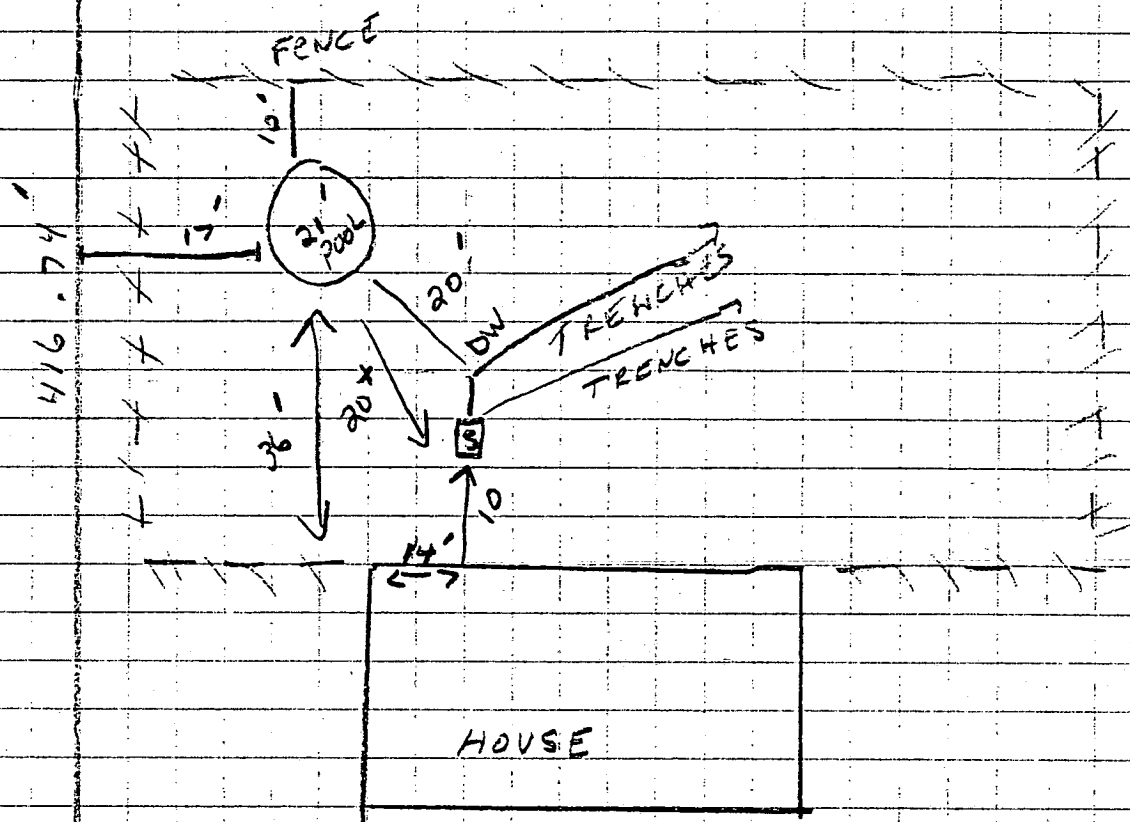

21' POOL WOULD BE PLACED 36' FROM HOUSE
 17' FROM FENCE
 20' FROM TRENCHES
 20+ FEET FROM SEPTIC TANK
 DEPTH 48 inches
 ROUND

7/18/94
 Proposed pool location. OK, no impact to
 existing well or septic OK to proceed
 Amy McMullen
 LOT 39

125'
 Taylor Park Road

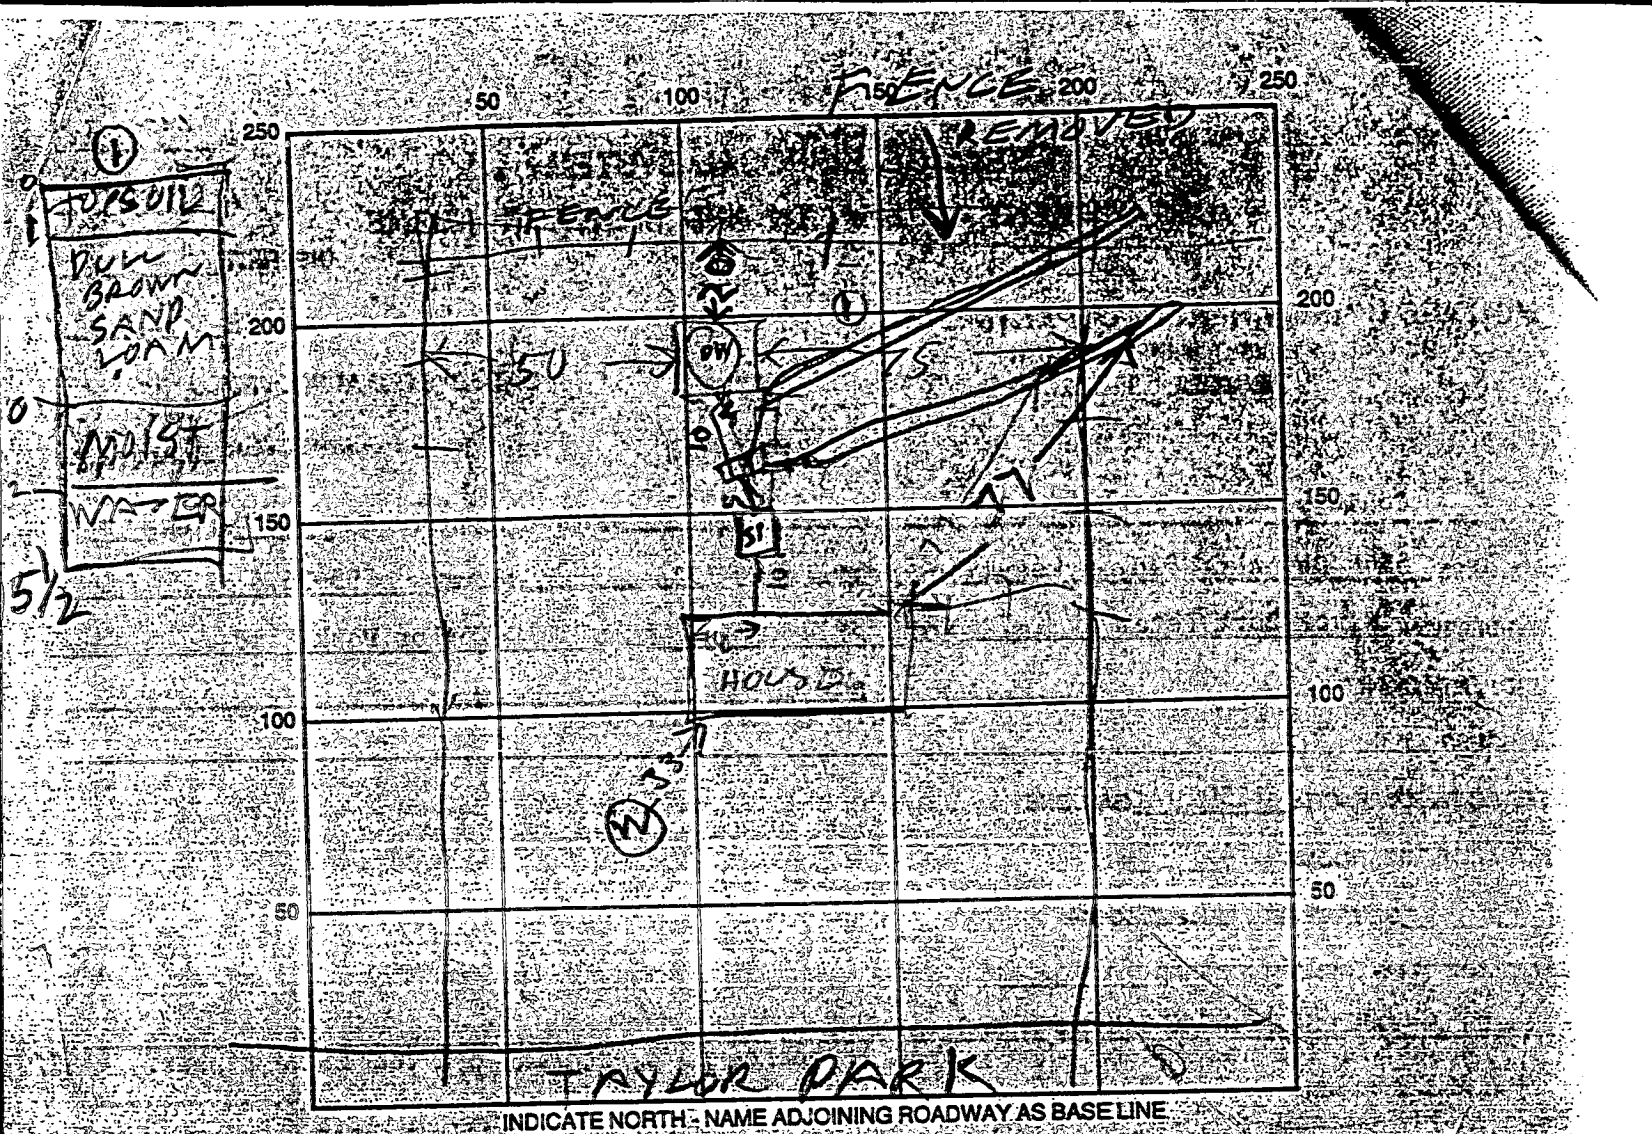

SEPTIC TANK LEVEL _____ CLEANOUTS _____

DISTRIBUTION BOX LEVEL _____

DRAIN FIELD/TITLE DEPTH 6-7 FT. TRENCH WIDTH 3 FT. INLET DEPTH 24 IN.

EFFECTIVE GRAVEL DEPTH 27 FT. TOTAL LENGTH 23 FT.

NUMBER OF TRENCHES 2 ONE SIDEWALL/BOTTOM AREA _____ SQ. FT.


DRYWALL INSIDE DIAMETER _____ FT. EFFECTIVE DEPTH BELOW INLET _____ FT.

DATE	TIME	ABSORBENT AREA	START	STOP	SO. FT.	START	STOP	TIME	REMARKS
5/15/93	19:45	947	947	953	6	PERC OK - SHALLOW			
5/15/93	19:58	1000	1000	1002	2	SYSTEM			
5/15/93 TRENCHES OK. FOR TRENCHES RILL UP, OVERFLOW WILL GO TO OLD DRY WELL R/W									

REMARKS: _____

#100244 Lee Ray

12/3/10

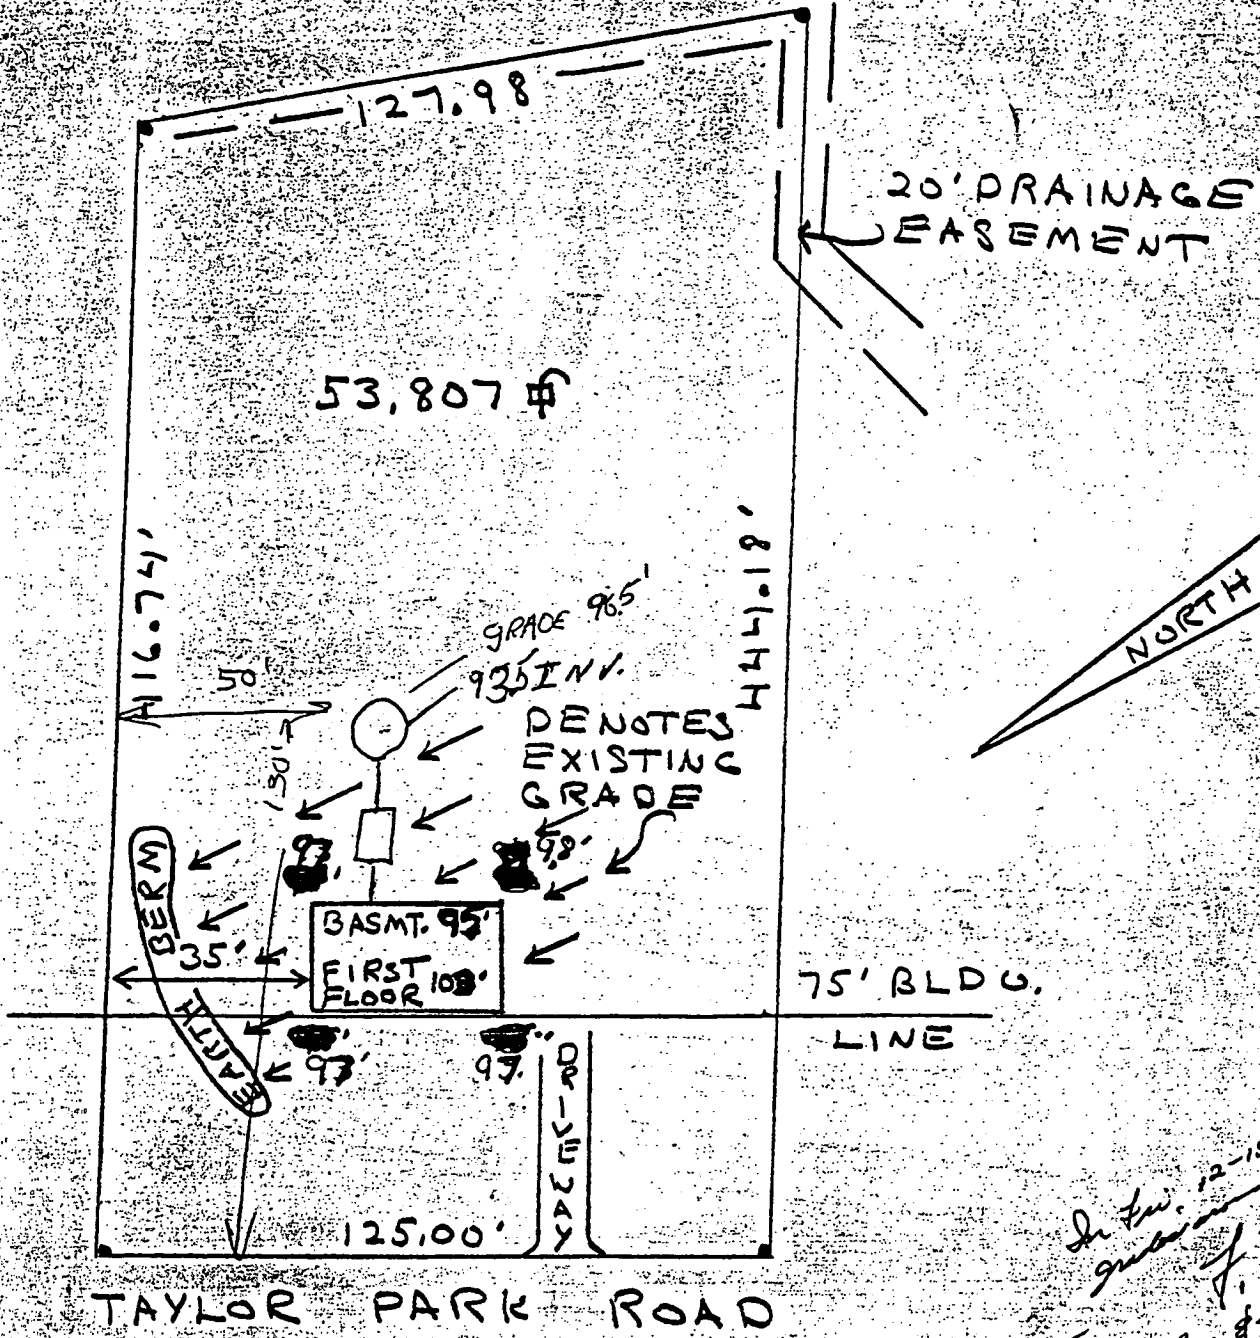

In the 12-15-72
gravel and house at
F.
better, elev. & ground




TDL, LIMITED

16220 FREDERICK AVENUE
GAITHERSBURG, MARYLAND 20877
(301) 840-9747


Frank J. Richinelli, Jr.
FRANK J. RICHINELLI, JR.

Ann Marie Richinelli
ANN MARIE RICHINELLI

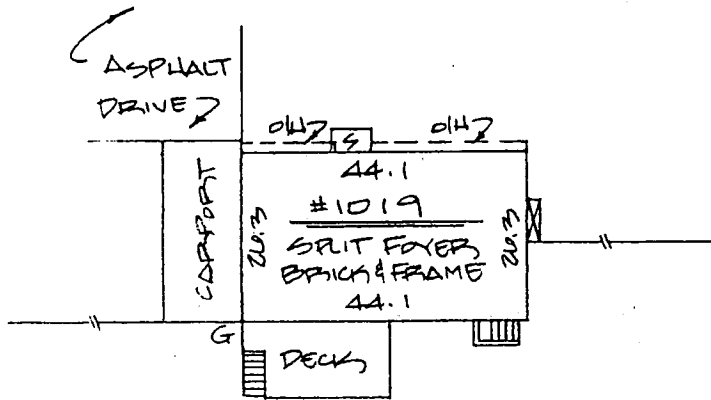

SCALE

1" = 30'

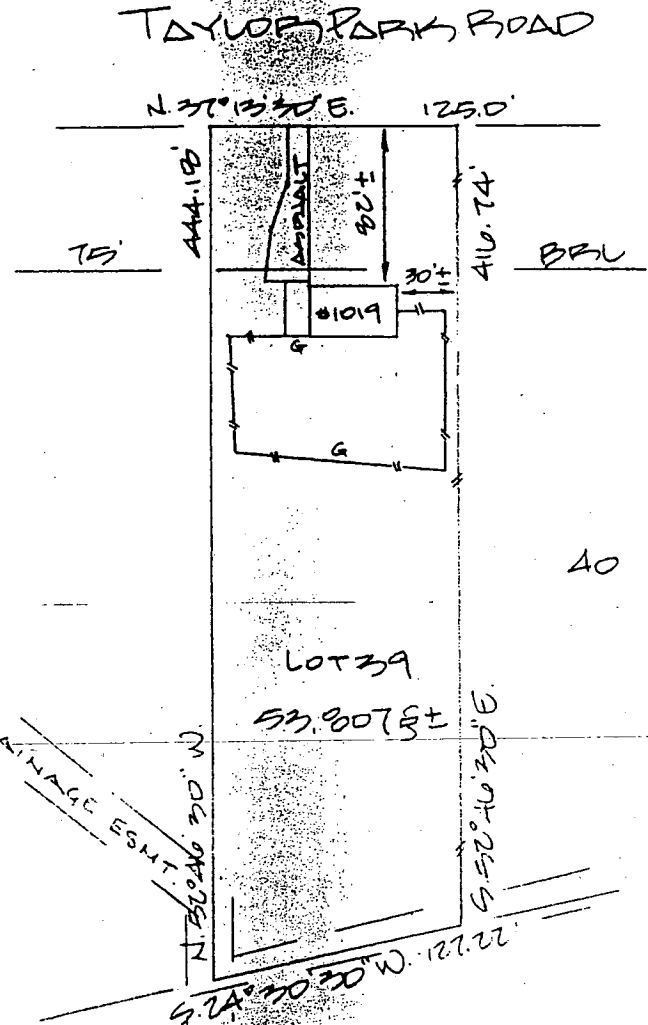

931645

Property shown hereon is not in a flood plain per existing records unless otherwise noted.

SCALE: 1" = 100'
RECORDED IN:
PLAT BOOK: 10
PLAT: 99

HOUSE LOCATION

LOT 39
SECTION 4
RIVER PARK ESTATES
HOWARD COUNTY, MD


NOTE: This drawing is not intended to establish property lines nor are the existence of corner markers guaranteed. All information shown hereon taken from the land records of the county in which the property is located. Do not attempt to erect fences from information contained on this drawing.

I hereby certify that to the best of my knowledge and belief, the position of all the existing improvements on the above described property has been established by accepted field practices.

Date: June 23, 1993

Jefferson D. Lawrence
JEFFERSON D. LAWRENCE,
PROFESSIONAL LAND SURVEYOR #5216

THIS DRAWING TO BE USED FOR TITLE PURPOSES ONLY

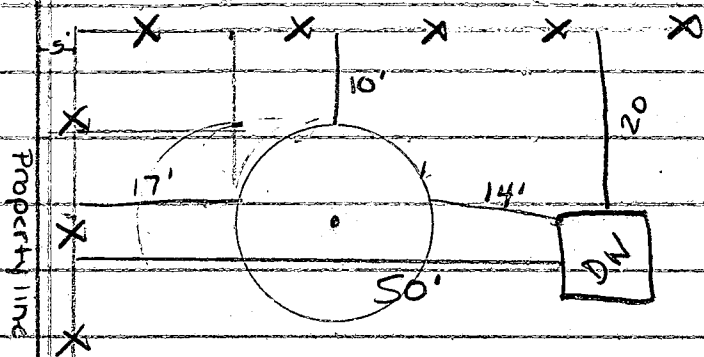

If they put pool where they say -
they will only be 14' off the
drywell.

Must move to left 6' - (make the
left side of the pool 11' off
the fence)

7/18/94 call owner

- Pool will be 17' off the property
line, not the fence. This will
make the pool 19' off the
DW.

- Recommend approval

Ann