

PERMIT

SEWAGE DISPOSAL SYSTEM

DEPARTMENT OF HEALTH AND MENTAL HYGIENE

HOWARD COUNTY HEALTH DEPARTMENT

BUREAU OF ENVIRONMENTAL HEALTH
~~XXXX-XXXX~~ 313-2640

INDEXED

P 49770
A 09772
A REPAIR

DISTRICT _____

DATE 4/30/93

DATE SYSTEM APPROVED 12-6-93

INSPECTOR JEN

Jack Fyock Septic Service

IS PERMITTED TO INSTALL _____ ALTER X

ADDRESS _____ PHONE 988-9270

SUBDIVISION Riverside Park Estates LOT 24 ROAD 1109 Taylor Park Road

PROPERTY OWNER Davella

ADDRESS 1109 Taylor Park Road
Sykesville, Maryland 21784

SEPTIC TANK CAPACITY 1000 GALLONS

NUMBER OF BEDROOMS 3

SQUARE FEET PER BEDROOM _____

LINEAR FEET OF TRENCH REQUIRED _____

REPAIR - PURPOSE - SEPTIC SYS TEM HAS FAILED.

Call for inspection when ground is opened so sanitarian can recommend repair. 11/23/93

BLDG. PERMIT SER# _____

AND RETURNED 6-17-98

Serial # B00112445
Sumner

12-6-93 180 sq ft/bdrm. Inlet 4.0 ft, Bottom 11.0 ft. 77 linear
feet of trench required, 540 sq ft total disposal area. JEN

PLANS APPROVED BY _____ DATE _____

COVER NO WORK UNTIL INSPECTED AND APPROVED

NEITHER THE HOWARD COUNTY COUNCIL NOR THE HEALTH DEPARTMENT IS RESPONSIBLE FOR THE SUCCESSFUL OPERATION OF ANY SYSTEM

NOTE: CLEANOUT REQUIRED EVERY 70 FEET OF SEWER LINE AND/OR AT 90° SWEEPS IN LINES FROM HOUSE TO DRAIN FIELDS, 90° ELBOWS NOT ACCEPTABLE.

NOTE: ALL PARTS OF SEPTIC SYSTEMS (I.E. TANK, DISTRIBUTION BOX TRENCHES) TO BE 100 FEET FROM WELL (UNLESS OTHERWISE SPECIFICALLY AUTHORIZED)

NOTE: IF DEEP TRENCH(ES) ARE USED CALL FOR INSPECTION BEFORE AND AFTER PLACING GRAVEL IN TRENCH(ES)

NOTE: NO DRY WELL SHALL EXCEED 15 FOOT IN DIAMETER NO ABSORPTION TRENCH TO EXCEED 100 FEET IN LENGTH

NOTE: ALL PIPE FROM HOUSE TO SEPTIC TANK MUST BE CAST IRON OR SCHEDULE 35/40 PVC OR ABS

PERMIT VOID AFTER TWO YEARS

NOTE: INSTALL STAND PIPE ON SEPTIC TANK AND DRY WELL STAND PIPES MUST BE 6 INCHES IN DIAMETER CAST IRON. CONCRETE OR TERRA COTTA OR PVA OR ABS ACCEPTED. IF TOP OF SEPTIC TANK IS DEEPER THAN 3 FEET. MANHOLE TO GRADE REQUIRED.


NOTE: DISTRIBUTION BOXES MUST HAVE BAFFLES

***INSTALLER IS RESPONSIBLE FOR OBTAINING FINAL APPROVAL ON THIS PERMIT**

49770

① Trench open to bottom

0-4.0 Br sil m
4.0-11.0 Br sil m
(trace of mottles in spoil pile)
11.0 Bottom Dry

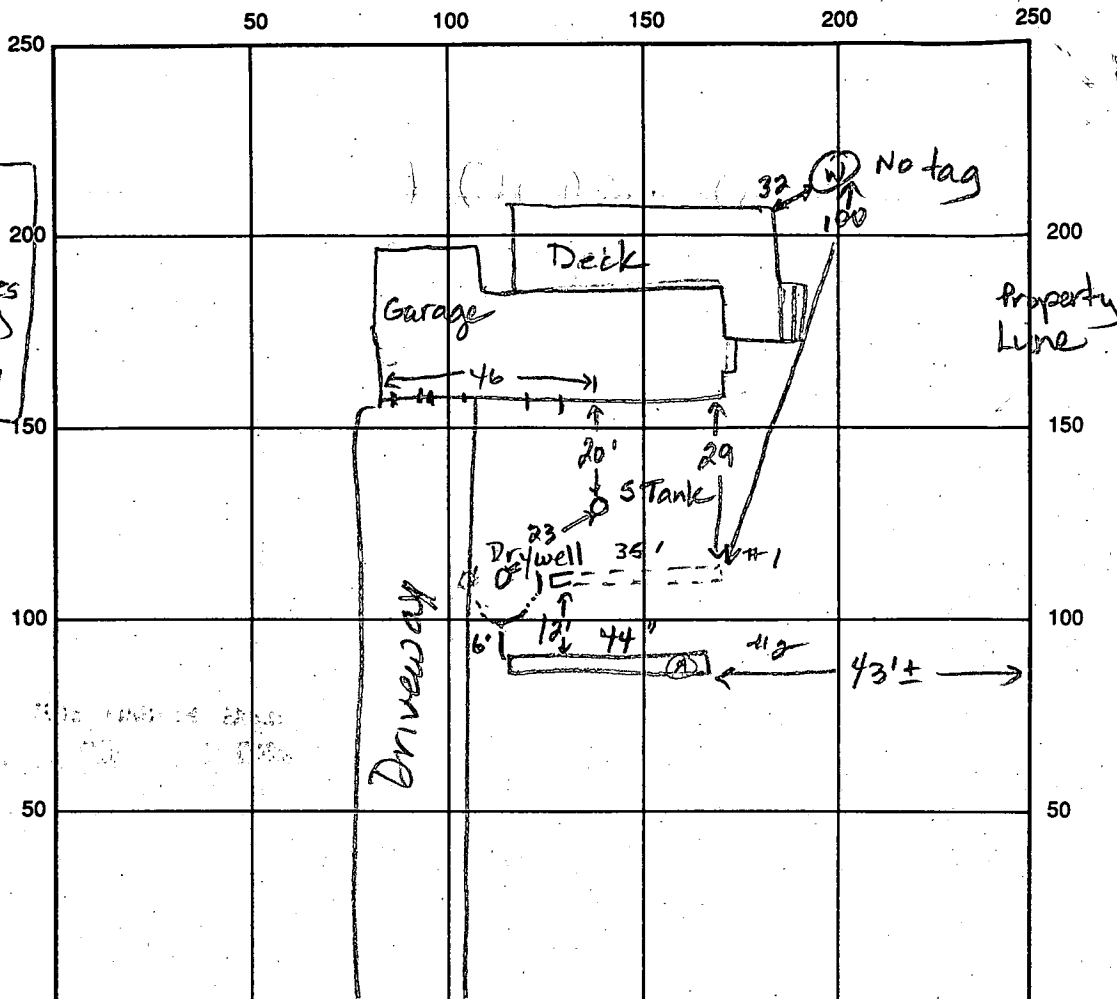

INDICATE NORTH - NAME ADJOINING ROADWAY AS BASE LINE

Taylor Park Road

SEPTIC TANK LEVEL existing 750 to 1000g CLEANOUTS 1 on ST, 1 on DW

DISTRIBUTION BOX LEVEL N/A

DRAIN FIELD TITLE DEPTH 11 FT.

TRENCH WIDTH 2-5 FT. ^{Trench #1 caved}

INLET DEPTH 3.5 3.5 FT. ① ②

EFFECTIVE GRAVEL DEPTH 7.5 7.5 FT. ① ②

TOTAL LENGTH 35 44 FT. ① ②

NUMBER OF TRENCHES 2

ONE SIDEWALL BOTTOM AREA 262.5 330 SQ. FT. ① ②

DRYWELL INSIDE DIAMETER 11' x 11' FT.

EFFECTIVE DEPTH BELOW INLET 6 FT. ^{Drywell}

ABSORBENT AREA 592.5 SQ. FT. + 552

REMARKS: 12-6-93 Trench #1 collapsed during installation, covered prior to inspection. Trench #2, stone placed except for last 10 feet. JEN

DATE SYSTEM APPROVED 12-6-93

INSPECTOR Jane E. Haden

PERMIT

SEWAGE DISPOSAL SYSTEM

MARYLAND STATE DEPARTMENT OF HEALTH

HOWARD COUNTY

INDEXED

ELLICOTT CITY

DISTRICT 3

DATE 3/9/66

John E. Ruth Co.

IS PERMITTED TO INSTALL ☒ ALTER

ADDRESS 400 Overbrook Rd. Baltimore 28, Md.

PHONE _____

A SEWAGE DISPOSAL-SYSTEM LOCATED AT _____

SUBDIVISION River Park Estates

ROAD Taylor Park

LOT 24, Sec. 3

PROPERTY OWNER The Debra Corporation

ADDRESS _____

SPECIFICATIONS - 3 bedroom dwelling

DRAIN FIELD _____ DEPTH _____ FEET, BOTTOM AREA _____ SQ. FT.

SEEPAGE PITS _____ ABSORBENT SIDE-WALL AREA _____ SQ. FT.

SEPTIC TANK CAPACITY 750 GALLONS

FOR GARBAGE GRINDER, INCREASE DISPOSAL AREA 22% & TANK CAPACITY 50%.

OTHER Dry well - 11 ft. in dia. by 12 ft. deep below the inlet located 52 ft. from the front property line and 49 ft. off the left side property line as seen when facing the lot from Taylor Park Road. Locate the inlet at 3 ft. below original grade.

WILL NOT APPROVE A STORE.


PLANS APPROVED BY J. Hennigan

DATE 3/30/65

FILL SEPTIC TANK AND DISTRIBUTION BOX WITH WATER BEFORE CALLING FOR AN INSPECTION. COVER NO WORK UNTIL INSPECTED AND APPROVED.

NEITHER THE HOWARD COUNTY COMMISSIONERS NOR THE HEALTH DEPARTMENT IS RESPONSIBLE FOR THE SUCCESSFUL OPERATION OF ANY SYSTEM.

A 09772

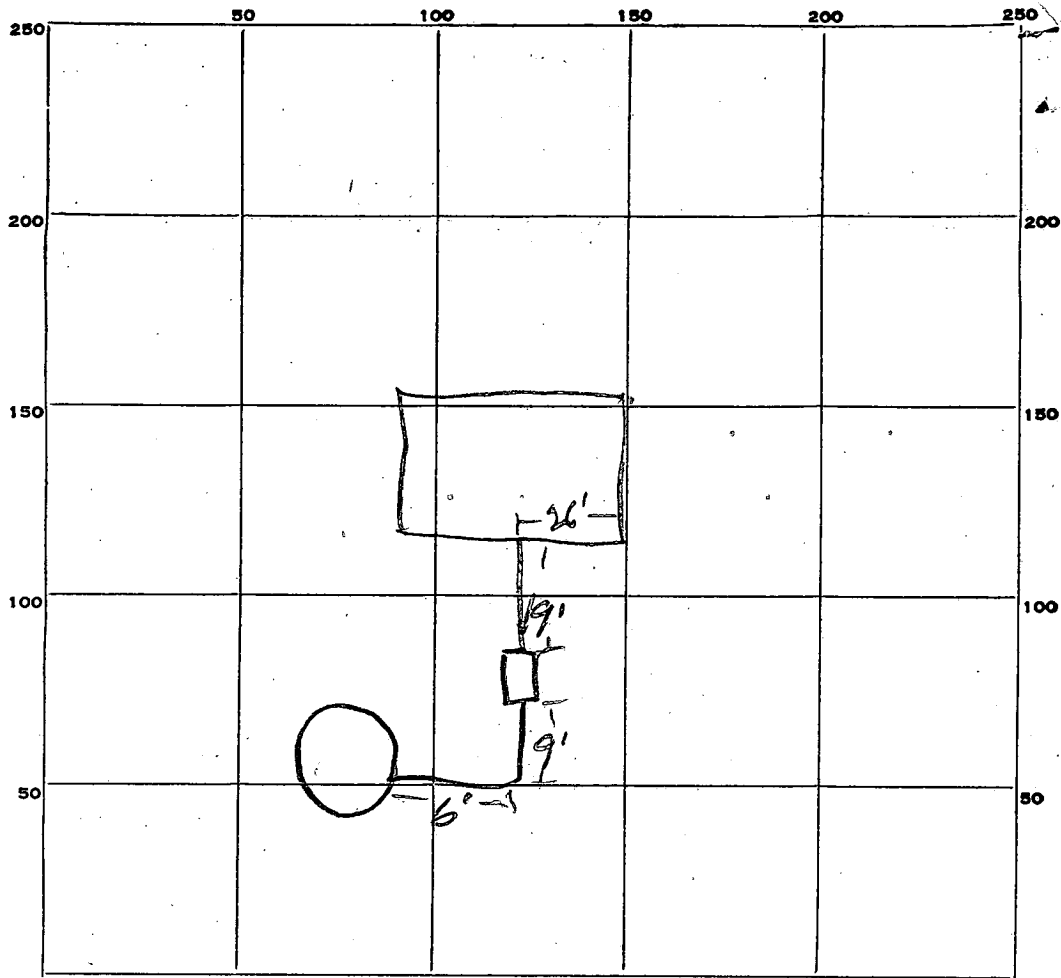

INDICATE NORTH. - NAME ADJOINING ROADWAY AS BASE LINE.

PERMIT CARD OK

Taylor Park Rd

SEPTIC TANK, LEVEL OK

CLEANOUTS OK

DISTRIBUTION BOX, LEVEL _____

TILE FIELD, DEPTH _____ FT. TRENCH WIDTH _____ FT.

GRAVEL DEPTH _____ IN. TOTAL LENGTH _____ FT.

NUMBER OF TRENCHES _____ TOTAL BOTTOM AREA _____

SEEPAGE PITS, INSIDE DIAMETER 16 FT. DEPTH BELOW INLET 01 FT.

ABSORBENT AREA 55 SQ. FT.

REMARKS _____

DATE SYSTEM APPROVED 5/6/66

INSPECTOR JH Palmer

APPLICATION

SEWAGE DISPOSAL TESTING

MARYLAND STATE DEPARTMENT OF HEALTH

A 09772

P

HOWARD COUNTY

ELLICOTT CITY

Septic Tank - 750 gallons.

DISTRICT 3

Dry well - 11 ft in dia. by 12 ft. deep below the DATE 3/16/65
inlet located 52 ft. from the front property line and
49 ft. off the left side property line as seen when
facing the lot from Taylor Park Rd. Locate the
inlet at 3 ft. below original grade.

Will not approve a store. P.J.W. 3/9/66

TO: THE COUNTY HEALTH OFFICER
ELLICOTT CITY, MARYLAND

I, HEREBY, APPLY FOR THE NECESSARY TESTS IN ORDER TO CONSTRUCT (OR RECONSTRUCT) A SEWAGE DISPOSAL SYSTEM.

PROPERTY OWNER The Debra Corporation

ADDRESS 122 Dunloggin Rd., Ellicott City, Md. PHONE HO 5-2224

PROPERTY LOCATION:

SUBDIVISION River Park Estates LOT NO. 24, Sec. 3

ROAD AND DESCRIPTION Taylor Park Road

OCCUPANT PHONE

PERSON TO CONSTRUCT SYSTEM

ADDRESS PHONE

SIZE OF LOT 44,020 sq. ft. TYPE BLDG 3

NUMBER OF BEDROOMS

IF NOT SINGLE RESIDENCE DESCRIBE

SIGNATURE OF APPLICANT /s/ R. W. Griffith


APPROVED BY J. Harrigan FOR Dry Well DATE 3-30-65

REJECTED BY FOR (KIND OF SYSTEM) DATE

HOLD PENDING FURTHER TESTS DATE

REASONS FOR REJECTION OR HOLDING

THIS IS NOT A PERMIT

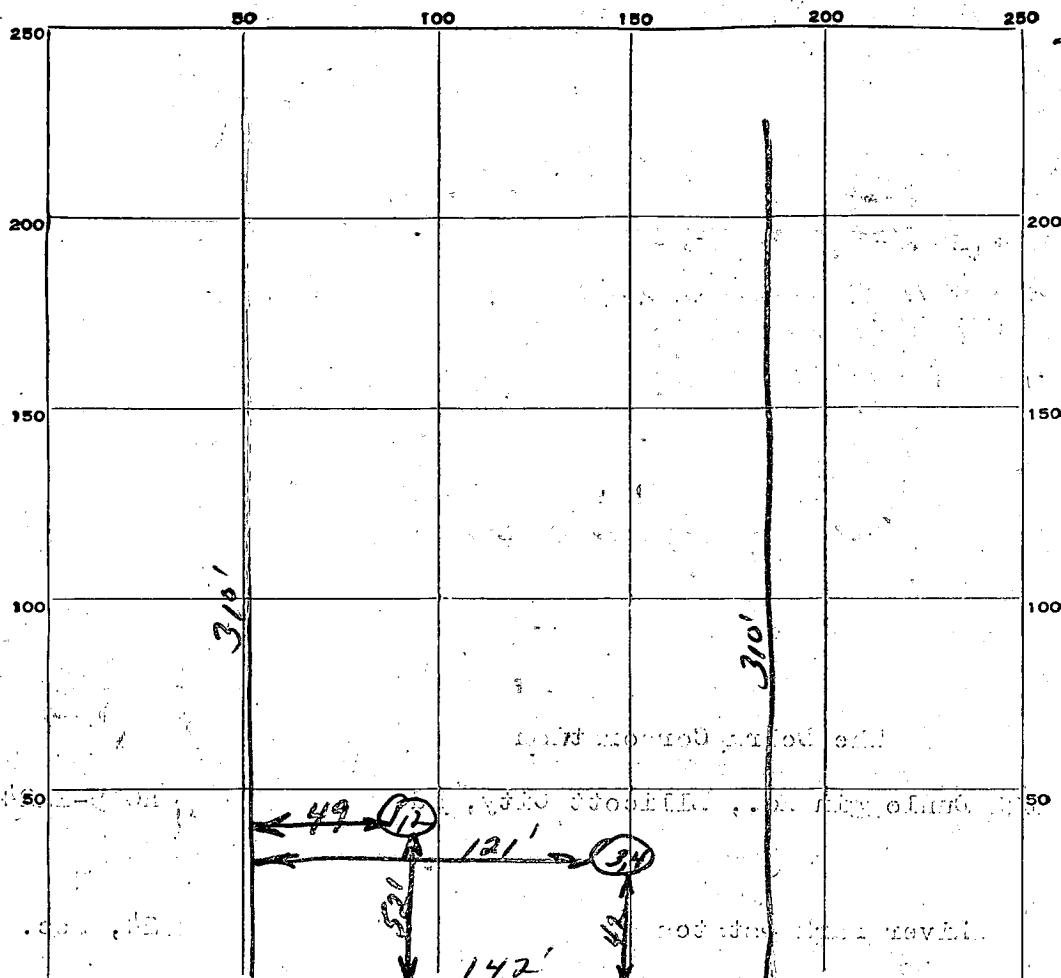

INDICATE NORTH. NAME ADJOINING ROADWAY AS BASE LINE.

Taylor Park Road

DATE	TEST NO.	DEPTH	PRE-WET		TEST - 1" DROP		TIME
			START	STOP	START	STOP	
3-30-65	1 <i>Same</i>	8 1/2'	11:22	11:29	11:29	11:48	19 min
	2 <i>Pit</i>	4 1/2'	11:23	11:25	11:25	11:27	2 min
	3 <i>Same</i>	5'	11:36	11:40	11:40	11:48	8 min
	4 <i>Pit</i>	9'	11:35	11:49	11:49	12:07	18 min

447 11

SOIL AUGER FINDING

TESTED BY

JH

REMARKS

Good soil after top 4 FT. - both pits

ALSO PRESENT

See Rose

LOT NO.

24 Sec. 3

State Office Building
ANNAPOLIS, MARYLAND 21401DEPARTMENT OF
WATER RESOURCESAPPLICATION MUST BE SUBMIT-
TED AND PERMIT RECEIVED BE-
FORE DRILLING IS STARTEDAPPLICATION FOR PERMIT TO DRILL WELL
WATER RESOURCES

No. 914

Owner Chesapeake HomesStreet or R. F. D. Southwestern Blvd.Post Office SykesvilleQuantity of Water to be Produced 5 Gallons Per MinuteTotal Quantity Needed For Use 250 Gallons Per DayUse for Water DomesticApproximate Depth of Well (feet) 90'Method of Drilling to be used CableIs this a Replacement Well? Yes ☐ No ☒

If YES, indicate date abandoned well is to be

sealed:

and by whom:

Driller George Hart License Number 176Street or R. F. D. Owings Mills, Md.Post Office SykesvilleDate 4/7/67Location of Well County HowardSubdivision Indian MillsSection 24Nearest Town SykesvilleDistance from Town 2 milesDirection from Town South east

Description of Location of Well

(This information MUST BE ACCURATE, and should be definite enough to permit locating well on a county map).


Near what road Taylor Park Rd.On which side of road East

(North, East, South, West)

Distance from road 150'

Draw a sketch below showing location of well in relation to nearby towns, roads and streams with north in the direction of the arrow, and give distance from well to nearest road junction or stream crossing shown on the sketch. Distances may be approximate, but must be indicated.

NORTH

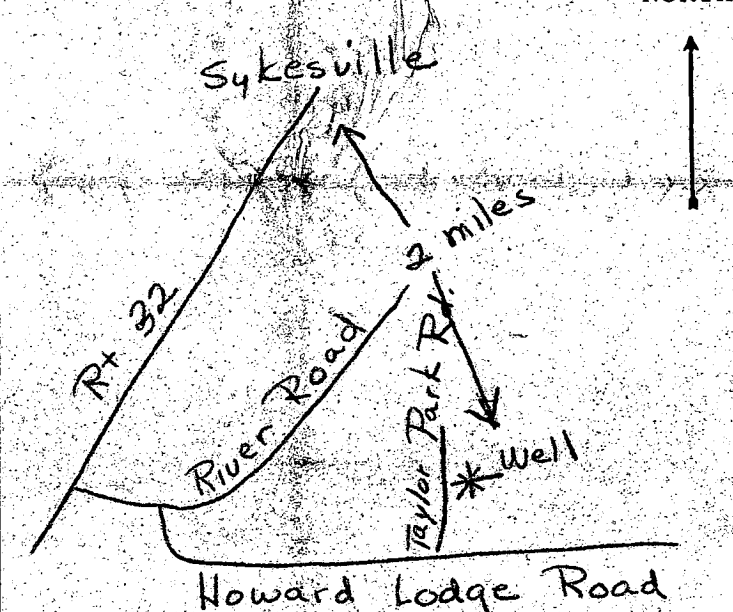PERMIT TO DRILL WELL
(Not To Be Filled In By Driller)Well Permit No. HO-67-W-222Samples of Cuttings Required by Department: Yes ☒ No ☐Owner Requires Permit to Appropriate Water: Yes ☒ No ☐Owner Has Permit to Appropriate Water: Yes ☒ No ☐

Appropriation Permit No.

The applicant is herewith granted a permit to drill this well subject to the conditions stipulated.

Paul W. McKee Dec. 4-11-67

Director

Date

THIS PERMIT IS NOT TRANSFERRABLE
WITHOUT WRITTEN PERMISSION FROM THE DEPARTMENT
Special conditions that must be observed:

Health Department Approval of Application

Howard

County Department of Health

or ☐ State Department of HealthApproved by Palmer F. WineTitle Director, Environmental HealthDate 4/10/67

State Office Building
ANNAPOLIS, MARYLAND 21401DEPARTMENT OF
WATER RESOURCES

9 AM 11:15

THIS REPORT
MUST BE SUBMITTED
WITHIN 30 DAYS
AFTER COMPLETION
OF THE WELL

WELL COMPLETION REPORT

DEPARTMENT OF
WATER RESOURCES

WELL DESCRIPTION

WELL LOG

State the kind of formations penetrated, their color, their depth, their thickness, and if water-bearing

Dirt
Rock
Sand
RockSand was
water bearingAlso water
in rockFEET
from 0 to 14'
14'-24'
24'-55'
55'-100'

CASING AND SCREEN RECORD

State the kind and size and position of casing, liner, shoe, screen, and other accessories (if no casing used, give diameter of well).

Casing

DIAM.
(inches)

6 1/4"

FEET
from to

0'-57'

PUMPING TEST

Hours Pumped 2
Type of Pump Used Bailer
Pumping Rate 20
Gallons per Minute 20

WATER LEVEL

(Distance from land surface to water)

Before Pumping 48' Ft.

When Pumping 95' Ft.

APPEARANCE OF WATER

Clear ☒ Cloudy ☐

Taste NO

Odor NO

Height of Casing Above Land

Surface 3' Ft.

PUMP INSTALLED

Type

Capacity


Gallons per Minute

Gallons per Hour

Pump Column Length Ft.

LOCATION OF WELL ON LOT

Show permanent structures such as building(s), septic tank, and/or other landmarks and indicate not less than 2 distances (measurements) to well.

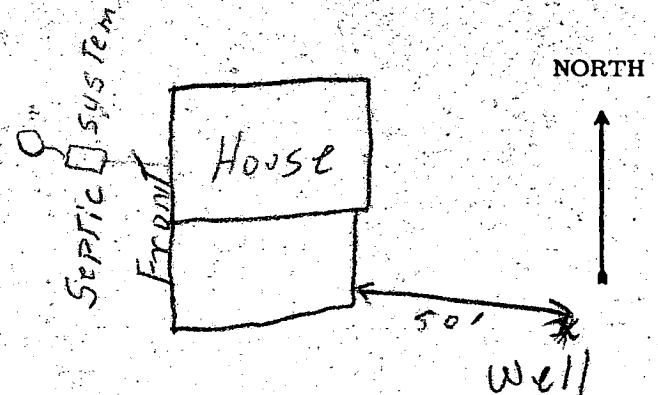DATE
WELL WAS
COMPLETED

I hereby affirm that this report contains no willful misrepresentations or falsifications and that information given in this report is true, accurate and complete to the best of my knowledge and belief.

George E. Hart, Well Driller

Well Driller License No.: 279

April 28

State Office Building
ANNAPOLIS, MARYLAND 21401DEPARTMENT OF
WATER RESOURCESAPPLICATION
NOTED AND PERMIT RECEIVED BEFORE
DRILLING IS STARTED.

APPLICATION FOR PERMIT TO DRILL WELL

No. 2173

Owner John W BackerStreet or R. F. D. WoodbinePost Office MDQuantity of Water to be Produced 5 Gallons Per MinuteTotal Quantity Needed For Use 700 Gallons Per DayUse for Water HouseApproximate Depth of Well (feet) 100Method of Drilling to be used RotaryIs this a Replacement Well? Yes - NoIf YES, indicate date abandoned well is to be

sealed: _____

and by whom: _____

Driller Harry GreenLicense
Number 235Street or R. F. D. DamascusPost Office DamascusDate MD

Location of Well

County HowardSubdivision River Farm DelSection 2Lot 21Nearest Town DaisyDistance from Town 1 1/2 mileDirection from Town North West

Description of Location of Well


(This information MUST BE ACCURATE, and should be definite enough to permit locating well on a county map).

Near what road Dewald RDOn which side of road East

(North, East, South, West)

Distance from road 50

Draw a sketch below showing location of well in relation to nearby towns, roads and streams with north in the direction of the arrow, and give distance from well to nearest road junction or stream crossing shown on the sketch. Distances may be approximate, but must be indicated.

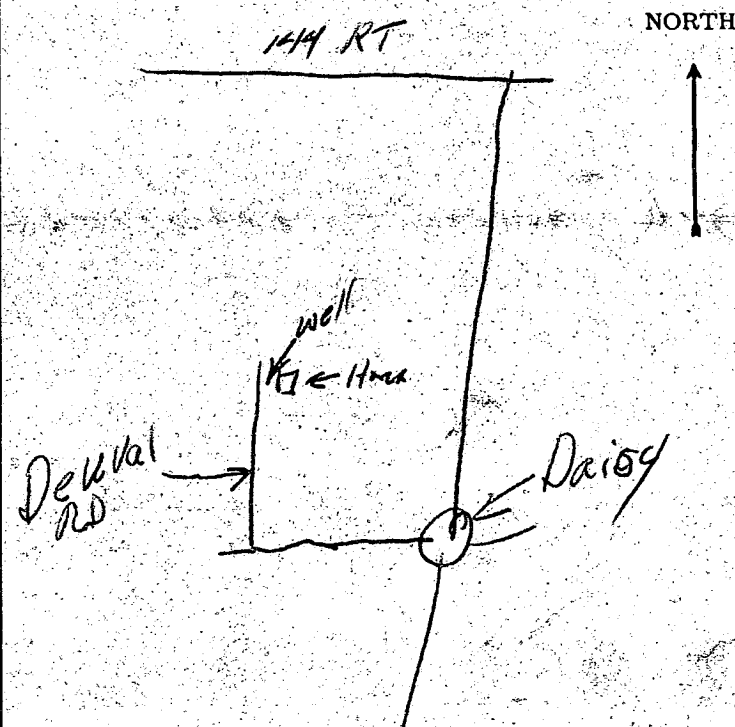PERMIT TO DRILL WELL
(Not To Be Filled In By Driller)Well Permit No. HO-68-W-246Samples of Cuttings Required by Department: ☒ Yes ☐ NoOwner Requires Permit to Appropriate Water: ☒ Yes ☐ NoOwner Has Permit to Appropriate Water: ☒ Yes ☐ No

Appropriation Permit No. _____

The applicant is herewith granted a permit to drill this well subject to the conditions stipulated.

Basil W. McKee

Director

May 6-12-68

Date

THIS PERMIT IS NOT TRANSFERRABLE
WITHOUT WRITTEN PERMISSION FROM THE DEPARTMENT
Special conditions that must be observed:

Health Department Approval of Application


Howard

County Department of Health

or ☐ State Department of HealthApproved by T. FrommeltTitle Sanitarian IIIDate 6/10/68

1109 TAYLOR PARK RD
SYKESVILLE MD 21784
RIVER PARK ESTATES
LOT 24 PARCEL 97 SEC 3 BLOCK 11

P11542 A09792
File Not Located in Microfilm
Reopen 49880

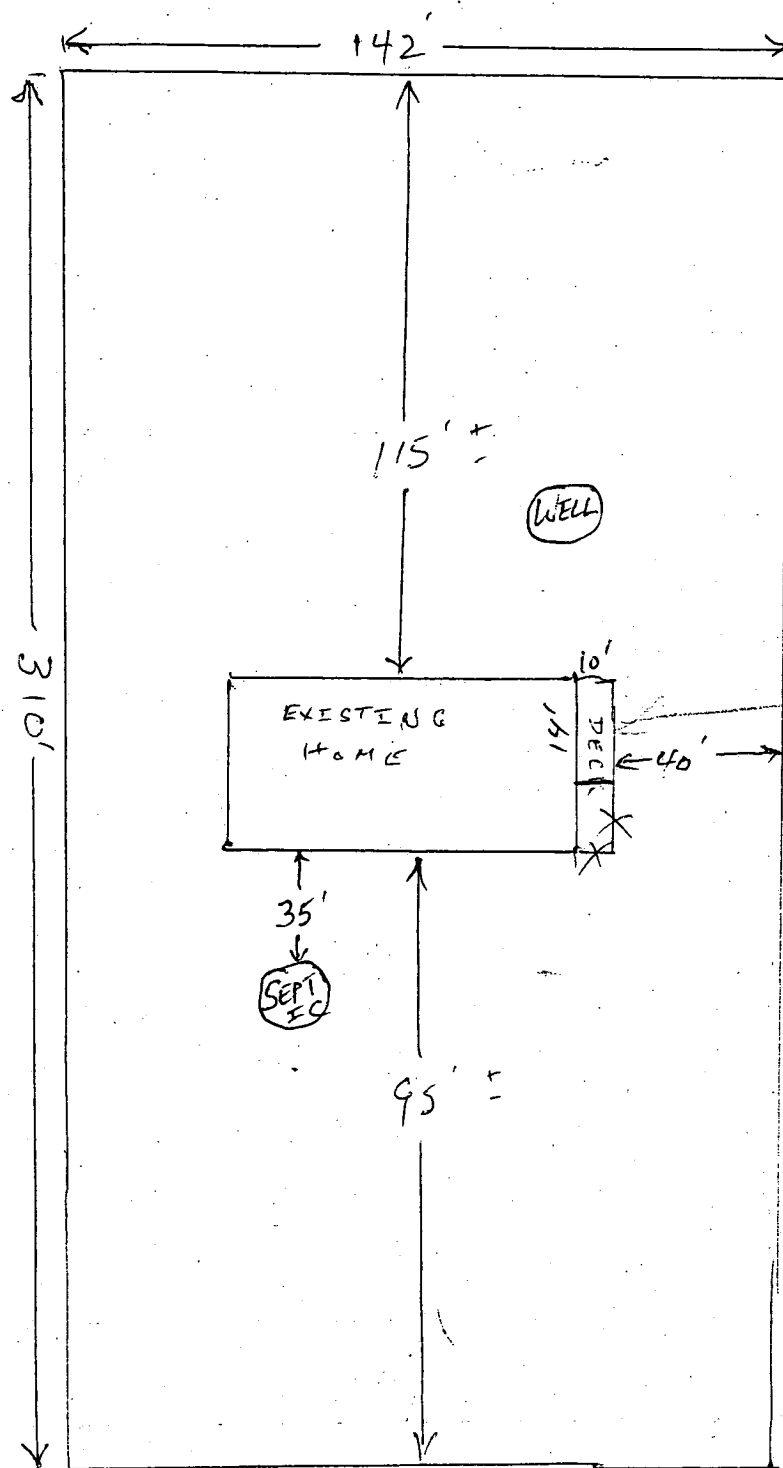

Note
Deck 32 ft from well
per Health Dept records
OK to approve B.P. Application
6/17/98

Sun Room addition
on top of existing Deck
(same dimensions)