

12/30/93

PERMIT

SEWAGE DISPOSAL SYSTEM

DEPARTMENT OF HEALTH AND MENTAL HYGIENE

HOWARD COUNTY HEALTH DEPARTMENT

BUREAU OF ENVIRONMENTAL HEALTH

~~XXXXXXX~~ 313-2640

03-291898
INDEXED

P 49814

A REPAIR

DISTRICT 3rd

DATE 1/5/94

DATE SYSTEM APPROVED 12/30/93

INSPECTOR [Signature]

Jenkins Brothers

IS PERMITTED TO INSTALL ALTER X

ADDRESS 7670 Smith's Private Road, Sykesville, Maryland 21784 PHONE 461-9282

SUBDIVISION Evergreen Valley Estates LOT 78, Sec. 3 ROAD 11801 Triadelphia Road

PROPERTY OWNER Judy Bull

11801 Triadelphia Road

ADDRESS _____

SEPTIC TANK CAPACITY Existing 750 GALLONS

NUMBER OF BEDROOMS 3

125 SQUARE FEET PER BEDROOM

LINEAR FEET OF TRENCH REQUIRED 65

REPAIR - PURPOSE - SEPTIC SYSTEM HAS FAILED.

Call for inspection when ground is opened so sanitarian can recommend repair. 12/18/93

Install one Trench 65' long, 2' wide, Total depth 9 Ft, 6' stone fill, 3' inlet off
existing dry well. P/Pmbley 12/30/93

PLANS APPROVED BY _____ DATE _____

COVER NO WORK UNTIL INSPECTED AND APPROVED

NEITHER THE HOWARD COUNTY COUNCIL NOR THE HEALTH DEPARTMENT IS RESPONSIBLE FOR THE SUCCESSFUL OPERATION OF ANY SYSTEM

NOTE: CLEANOUT REQUIRED EVERY 70 FEET OF SEWER LINE AND/OR AT 90° SWEEPS IN LINES FROM HOUSE TO DRAIN FIELDS, 90° ELBOWS NOT ACCEPTABLE.

NOTE: ALL PARTS OF SEPTIC SYSTEMS (I.E. TANK, DISTRIBUTION BOX TRENCHES) TO BE 100 FEET FROM WELL (UNLESS OTHERWISE SPECIFICALLY AUTHORIZED)

NOTE: IF DEEP TRENCH(ES) ARE USED CALL FOR INSPECTION BEFORE AND AFTER PLACING GRAVEL IN TRENCH(ES)

NOTE: NO DRY WELL SHALL EXCEED 15 FOOT IN DIAMETER NO ABSORPTION TRENCH TO EXCEED 100 FEET IN LENGTH

NOTE: ALL PIPE FROM HOUSE TO SEPTIC TANK MUST BE CAST IRON OR SCHEDULE 35/40 PVC OR ABS


PERMIT VOID AFTER TWO YEARS

NOTE: INSTALL STAND PIPE ON SEPTIC TANK AND DRY WELL STAND PIPES MUST BE 6 INCHES IN DIAMETER CAST IRON. CONCRETE OR TERRA COTTA OR PVA OR ABS ACCEPTED. IF TOP OF SEPTIC TANK IS DEEPER THAN 3 FEET. MANHOLE TO GRADE REQUIRED.

NOTE: DISTRIBUTION BOXES MUST HAVE BAFFLES

***INSTALLER IS RESPONSIBLE FOR OBTAINING FINAL APPROVAL ON THIS PERMIT**

49814

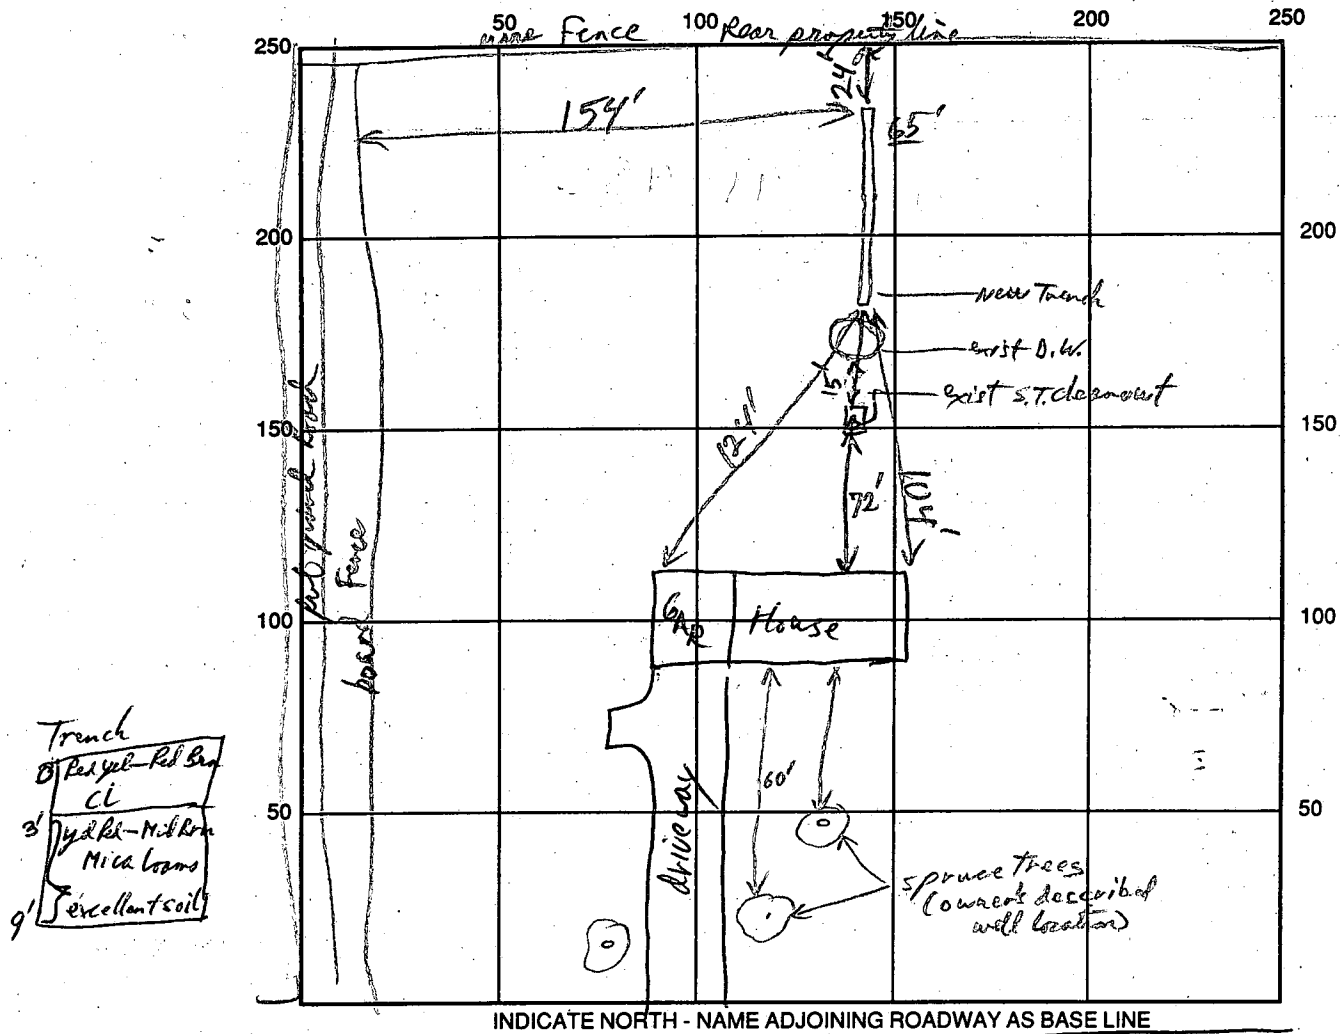

Trench
 3' Red soil - Rd Bar
 Cl
 3' Yellow-Milken
 Mica loams
 9' Excellent soil

old # A/0175

SEPTIC TANK LEVEL exist S.T. 750gal (per P12304)

CLEANOUTS exist ST

DISTRIBUTION BOX LEVEL NA

DRAIN FIELD/TITLE DEPTH 10 1/2 FT.

TRENCH WIDTH 2 FT.

INLET DEPTH 3 1/2 FT.

EFFECTIVE GRAVEL DEPTH 7 FT.

TOTAL LENGTH 65 FT.

NUMBER OF TRENCHES 1

ONE SIDEWALL/BOTTOM AREA 455 SQ. FT.

DRYWALL INSIDE DIAMETER _____ FT.

EFFECTIVE DEPTH BELOW INLET _____ FT.

ABSORBENT AREA _____ SQ. FT.

REMARKS: Beginning of Trench OK - OK to continue + gravel fill when ready 12/30/93 RJP

Trench OK to cover 12/30/93 Discovered pipe between S.T. + Drywell was plugged, replaced to Sch 40 PVC color 12/30/93

DATE SYSTEM APPROVED

12/30/93

INSPECTOR

RJP/LL

app - 11-22-66
Darn

11/22/66
Ready

PERMIT

SEWAGE DISPOSAL SYSTEM

MARYLAND STATE DEPARTMENT OF HEALTH

HOWARD COUNTY

ELLICOTT CITY

DISTRICT 3

DATE 11/2/66

INDEXED

Bollinger Brothers

IS PERMITTED TO INSTALL X ALTER

ADDRESS Westminster, Maryland

PHONE

A SEWAGE DISPOSAL SYSTEM LOCATED AT

SUBDIVISION Evergreen Valley Estates ROAD Triadelphia Rd. LOT 78, Sec. 3

PROPERTY OWNER Hudson Construction Co.

ADDRESS

SPECIFICATIONS - 3 bedrooms

DRAIN FIELD DEPTH FEET, BOTTOM AREA SQ. FT.

SEEPAGE PITS ABSORBENT SIDE-WALL AREA SQ. FT.

SEPTIC TANK CAPACITY 750 GALLONS

FOR GARBAGE GRINDER, INCREASE DISPOSAL AREA 22% & TANK CAPACITY 50%.

OTHER Dry well - 300 sq. ft. sidewall area below the top 6 ft. of clay.

Place the dry well 40 to 90 ft. from the back lot lines and 40 to 60 ft.

from the right side of the lot as seen when facing the lot from Triadelphia Rd.

MAXIMUM DEPTH PERMITTED 14' below original grade.


PLANS APPROVED BY Raymond Hodges DATE 5/14/65

FILL SEPTIC TANK AND DISTRIBUTION BOX WITH WATER BEFORE CALLING FOR AN INSPECTION. COVER NO WORK UNTIL INSPECTED AND APPROVED.

NEITHER THE HOWARD COUNTY COMMISSIONERS NOR THE HEALTH DEPARTMENT IS RESPONSIBLE FOR THE SUCCESSFUL OPERATION OF ANY SYSTEM.

**NOTIFY THE HEALTH DEPARTMENT 48 HOURS
BEFORE EXCAVATIONS ARE TO BE BACK FILLED.**

10175

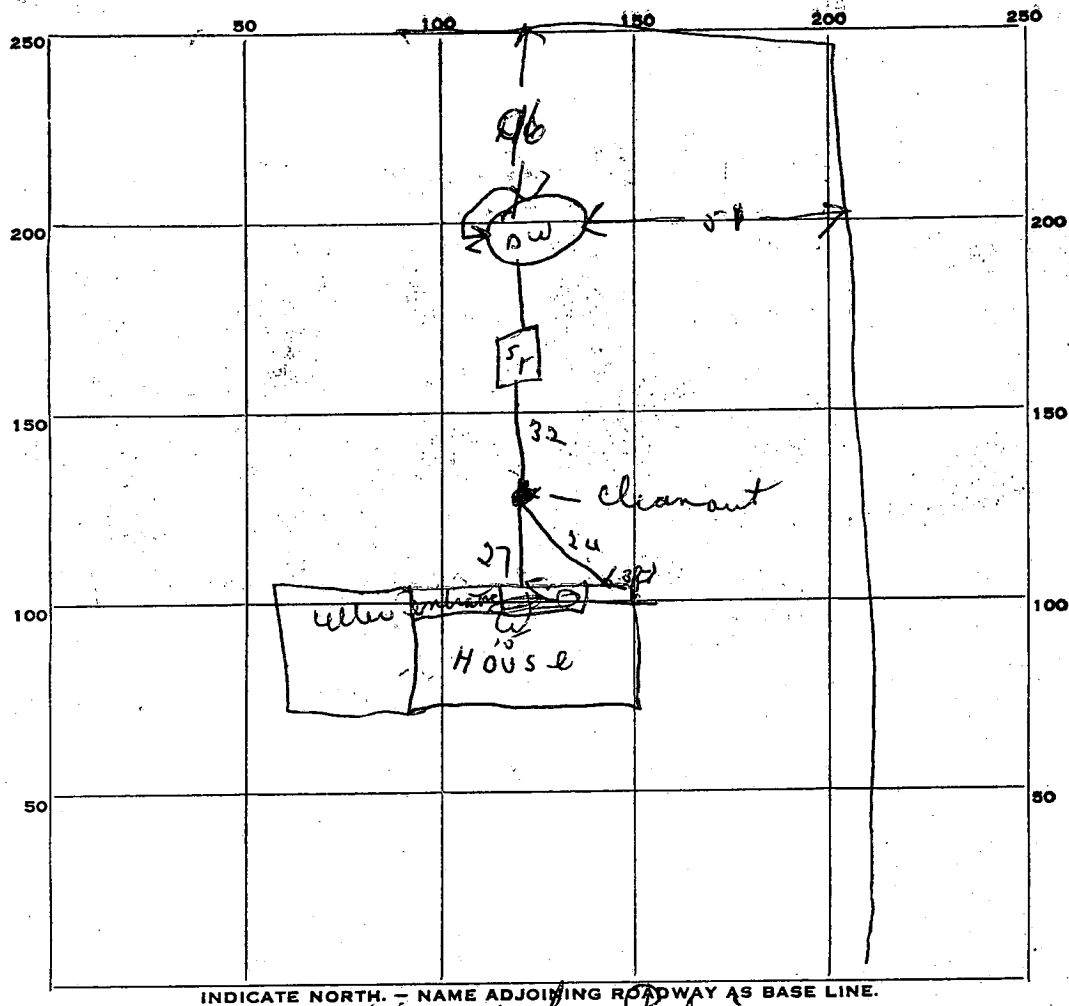

ORTH. - NAME ADJOINING ROAD
Triadelphia Rd

DW. Monaghan

APPLICATION

A 101-75

P _____

— SEWAGE DISPOSAL TESTING —

MARYLAND STATE DEPARTMENT OF HEALTH

HOWARD COUNTY 7506 Colton Park

ELLICOTT CITY

DISTRICT 3

DATE 5/13/65

Dry Well — 300 sq ft sidewall

Area below the top 6 FT of clay
Place the dry well 40 to 90 ft from
the back lot line 40 to 60 ft
from the right side of the lot as seen
when facing the lot
from Tindelford Rd

TO: THE COUNTY HEALTH OFFICER
ELLICOTT CITY, MARYLAND

I, HEREBY, APPLY FOR THE NECESSARY TESTS IN ORDER TO CONSTRUCT (OR RECONSTRUCT) A SEWAGE DISPOSAL SYSTEM.

PROPERTY OWNER Hudson Construction Co.

ADDRESS 363 Chapel Avenue, Ellicott City, Md. PHONE HO 5-2205

PROPERTY LOCATION:

SUBDIVISION Evergreen Valley Estates LOT NO. 78, Sec. 3

ROAD AND DESCRIPTION Triadelphia Rd.

OCCUPANT _____ PHONE _____

PERSON TO CONSTRUCT SYSTEM _____

ADDRESS _____ PHONE _____

SIZE OF LOT 1.000 acre TYPE BLDG. 3 NUMBER OF BEDROOMS

IF NOT SINGLE RESIDENCE DESCRIBE _____

SIGNATURE OF APPLICANT /s/ Madeline Leonard


APPROVED BY Raymond Dodge FOR Dry Well DATE 14 MAY 65

REJECTED BY _____ FOR _____ DATE _____

HOLD PENDING FURTHER TESTS _____ DATE _____

REASONS FOR REJECTION OR HOLDING _____

THIS IS NOT A PERMIT

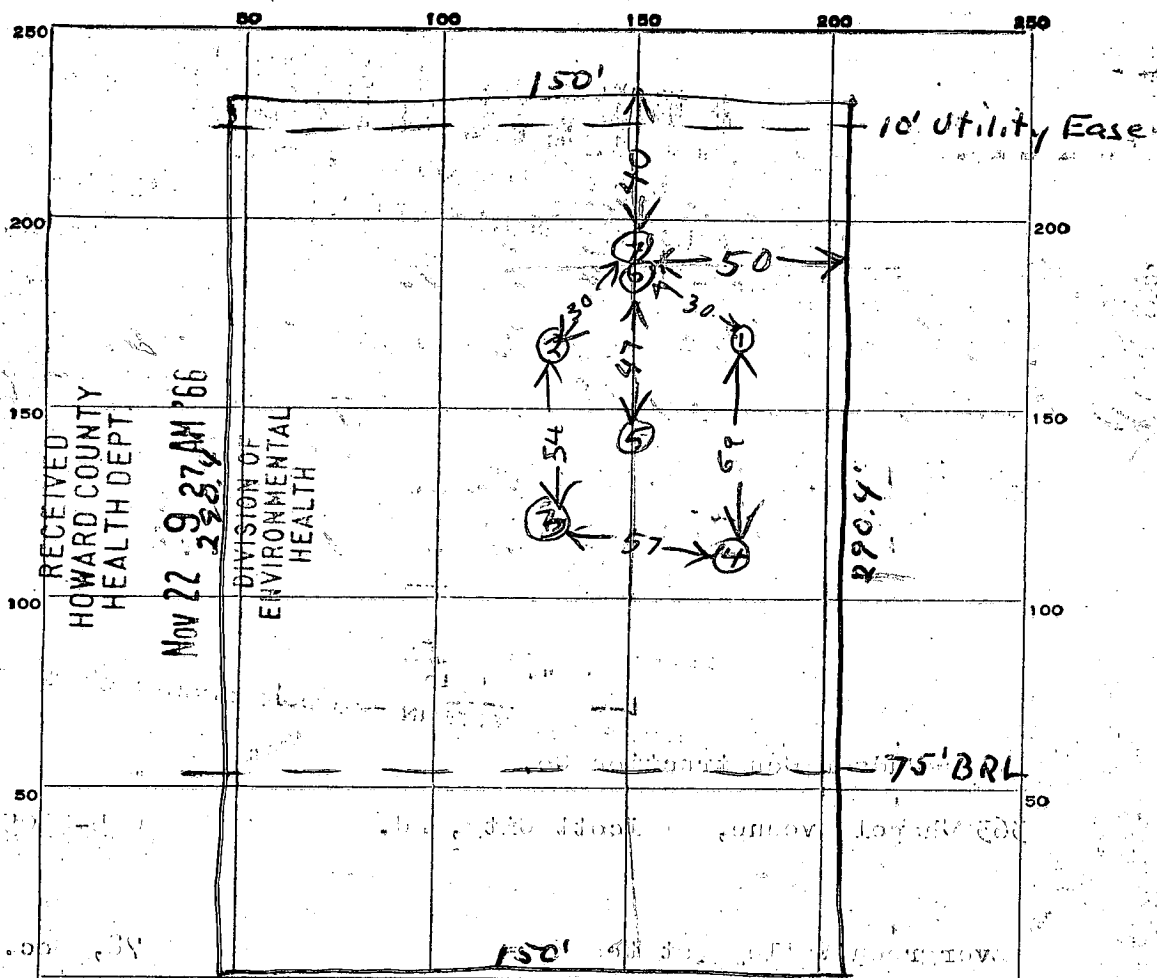

INDICATE NORTH. - NAME ADJOINING ROADWAY AS BASE LINE.

TRIADELPHIA ROAD

DATE	TEST NO.	DEPTH	PRE-WET		TEST - 1" DROP		TIME
			START	STOP	START	STOP	
14 MAY 65	1	4 1/2	1143	1215	little pore		
" "	2	4 1/2	1145	" "	"		
" "	3	5	1152	" "	"		
" "	4	5	1156	" "	"		
TOP 6 FT CLAY BOTTOM 4 1/2" SAND	5	10 1/2	1207	1209	1209	1212	3
TOP 6 FT CLAY BOTTOM 3" SAND	6	9	142	143	143	148	5
	7	4	143	225	little pore		

SOIL AUGER FINDING

TESTED BY

REMARKS

Raymond Hodges
Herbert Green

Lot 78 - Sec 3