

PERMIT

SEWAGE DISPOSAL SYSTEM

DEPARTMENT OF HEALTH AND MENTAL HYGIENE

HOWARD COUNTY HEALTH DEPARTMENT

BUREAU OF ENVIRONMENTAL HEALTH

~~XXXXXX~~ 313-2640

INDEXED

P 49973D

3

A REPAIR

DISTRICT

DATE

DATE SYSTEM APPROVED

INSPECTOR

Jack Tyock Septic Service

IS PERMITTED TO INSTALL

ALTER X

ADDRESS

PHONE 988-9270

SUBDIVISION Woodpoint

LOT 1

ROAD 14910 Triadelphia Road

PROPERTY OWNER

Kevin O'Grady

ADDRESS

14910 Triadelphia Road
Glenelg, Maryland 21737

SEPTIC TANK CAPACITY GALLONS

NUMBER OF BEDROOMS

SQUARE FEET PER BEDROOM

LINEAR FEET OF TRENCH REQUIRED

MODIFICATION OF
SEPTIC AREA RE: PROPOSED POOL.
NO WORK ON SEPTIC SYSTEM AT
THIS TIME. (CW)

REPAIR - PURPOSE -- FOR PERCOLATION TESTING TO DETERMINE IF SEPTIC AREA CAN BE EXTENDED TO

MAKE-UP FOR AREA LOST TO PROPOSED POOL LOCATION (BUILDING PERMIT No. 53341)

Call for inspection ground is opened so sanitarian can recommend repair. - 04/11/94

PLANS APPROVED BY

DATE

COVER NO WORK UNTIL INSPECTED AND APPROVED

NEITHER THE HOWARD COUNTY COUNCIL NOR THE HEALTH DEPARTMENT IS RESPONSIBLE FOR THE SUCCESSFUL OPERATION OF ANY SYSTEM

NOTE: CLEANOUT REQUIRED EVERY 70 FEET OF SEWER LINE AND/OR AT 90° SWEEPS IN LINES FROM HOUSE TO DRAIN FIELDS, 90° ELBOWS NOT ACCEPTABLE.

NOTE: ALL PARTS OF SEPTIC SYSTEMS (I.E. TANK, DISTRIBUTION BOX TRENCHES) TO BE 100 FEET FROM WELL (UNLESS OTHERWISE SPECIFICALLY AUTHORIZED)

NOTE: IF DEEP TRENCH(ES) ARE USED CALL FOR INSPECTION BEFORE AND AFTER PLACING GRAVEL IN TRENCH(ES)

NOTE: NO DRY WELL SHALL EXCEED 15 FOOT IN DIAMETER NO ABSORPTION TRENCH TO EXCEED 100 FEET IN LENGTH

NOTE: ALL PIPE FROM HOUSE TO SEPTIC TANK MUST BE CAST IRON OR SCHEDULE 35/40 PVC OR ABS

PERMIT VOID AFTER TWO YEARS

NOTE: INSTALL STAND PIPE ON SEPTIC TANK AND DRY WELL STAND PIPES MUST BE 6 INCHES IN DIAMETER CAST IRON, CONCRETE OR TERRA COTTA OR PVA OR ABS ACCEPTED. IF TOP OF SEPTIC TANK IS DEEPER THAN 3 FEET, MANHOLE TO GRADE REQUIRED.

NOTE: DISTRIBUTION BOXES MUST HAVE BAFFLES

*INSTALLER IS RESPONSIBLE FOR OBTAINING FINAL APPROVAL ON THIS PERMIT


BLDG. PERMIT SIGNED
AND RETURNED

4/18/94
Serial # 53311-PRR

49973D

T-1
T-2
CLAY
3
MICA
LOAM
12
WATER
AT 12'
HOLE T-2 ONLY

T-3
VISUAL
TO 8'
TO CONFIRM
NO DISPOSAL
TRENCH IN
VICINITY
OF POOL.

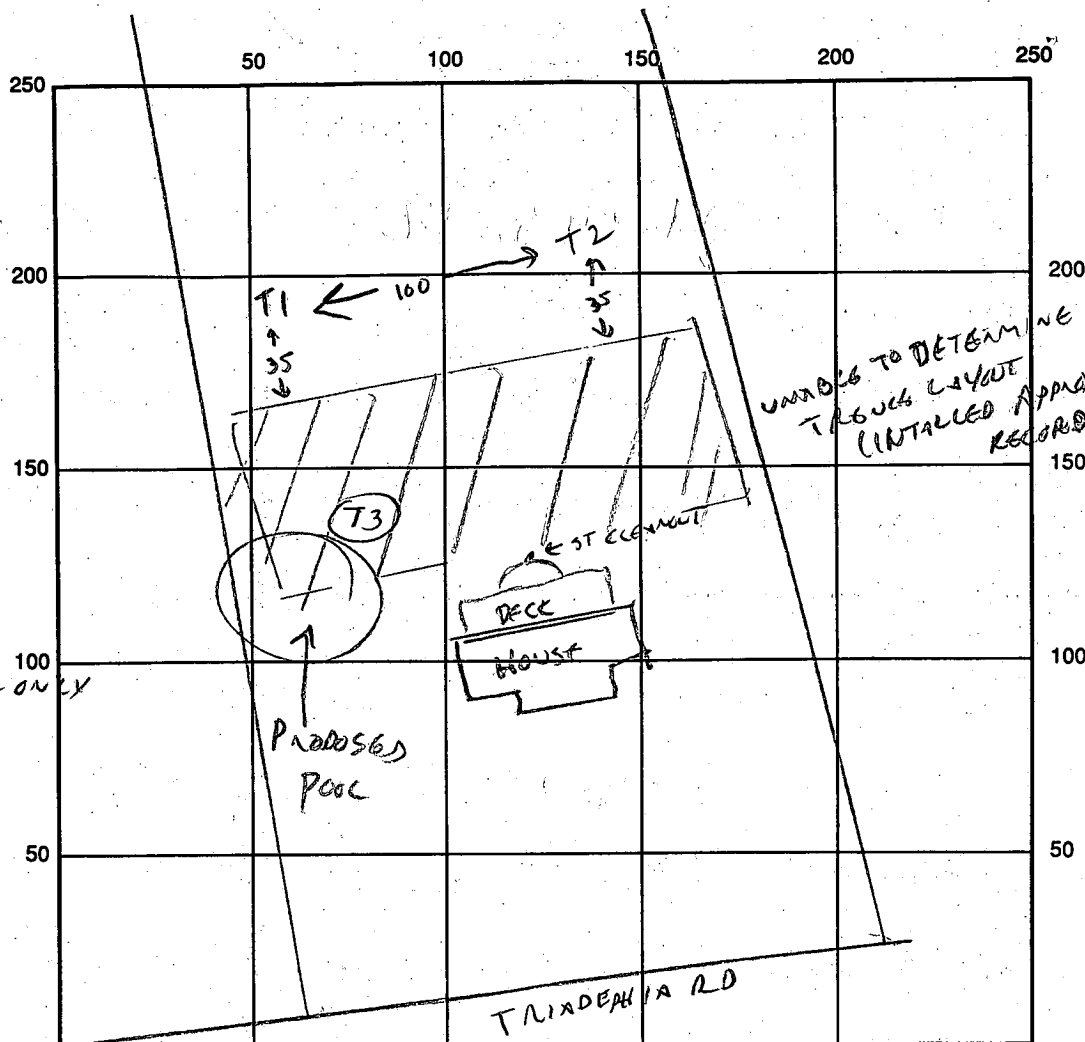

SEPTIC TANK LEVEL EXISTING CLEANOUTS _____

DISTRIBUTION BOX LEVEL _____

DRAIN FIELD/TITLE DEPTH _____ FT. TRENCH WIDTH _____ FT. INLET DEPTH _____ FT.

EFFECTIVE GRAVEL DEPTH _____ FT. TOTAL LENGTH _____ FT.

NUMBER OF TRENCHES EXISTING ONE SIDEWALL/BOTTOM AREA _____ SQ. FT.

DRYWALL INSIDE DIAMETER _____ FT. EFFECTIVE DEPTH BELOW INLET _____ FT.

ABSORBENT AREA _____ SQ. FT.

REMARKS: 4/13/94 PROPOSED POOL - BP 53341 INTAUSES ON CORNER OF SEWAGE DISPOSAL EXHIBIT
MAY INTAUSE ON INSTALLED TRENCH LOCATION.

PERC TEST T-1 & T-2 VIS OK TO 11-12'

OK TO ALLOW ADJUSTMENT OF SEPTIC AREA RE: POOL INTAUSION
(PLAT NOT REQ'D)

PERC TEST T-3 DUE TO 20' FROM EDGE OF PROPOSED POOL - NO DISPOSAL TRENCH IN AREA.

DATE SYSTEM APPROVED OK TO PROCEED WITH POOL AS PROPOSED,
INSPECTOR _____

4/18/94 CW

Revised
4/18/94
OK
Revision
4/21/94
CW

94 APR 21 PM 12:15


LICENSES & PERMITS
DIVISION

APR 18 1994

RECEIVED

REF NO:

Apr 19, 94 16:24 No.003 P.02

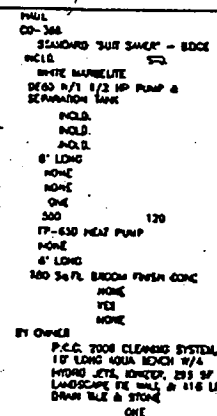

21-10 a 36 CUSTOM
600
600
110
30,000

ALVIN C. CRADY & JUDAN B. BLOOM

14018 TRADEPAC 2240

ALBANY, NEW YORK 21737

301-884-8150

3/15-17-08	
------------	--

1990

RECEIVED
HOWARD COUNTY
HEALTH DEPT.

94 APR 21 PM 12:16

LAYOUT

1/8" =

REVISION TO
4/21/94 BP 53341 OK
Gwilliam

FURTHER FROM SEPTIC
TAN ORIGINAL PROPOSAL
(CW)

