

10/8/92 3:00 PM
10/9/92 11-12
10/14/92
10/15/92 ASAP

05 404851

PERMIT

SEWAGE DISPOSAL SYSTEM

DEPARTMENT OF HEALTH AND MENTAL HYGIENE

HOWARD COUNTY HEALTH DEPARTMENT
BUREAU OF ENVIRONMENTAL HEALTH
461-9933

INDEX - TIME EXPIRED

FOR F.C.O.P. COMPLIANCE

5/6/92 C. Williams / C.B.

INDEXED

DATE SYSTEM APPROVED 10/15/92

INSPECTOR M. R. Allen

Richard A. Cook

Plumbing & Heating, Inc.

IS PERMITTED TO INSTALL ☒ ALTER

ADDRESS 9449 Decatur Road, Laurel, Maryland 20723 PHONE 301-490-4224

SUBDIVISION Thistledown LOT 10 ROAD 7209 Tall Pine Way

PROPERTY OWNER The Ryland Group Inc.

ADDRESS

SEPTIC TANK CAPACITY 1250 GALLONS 9.5 FT

NUMBER OF BEDROOMS 4

180 SQUARE FEET PER BEDROOM

LINEAR FEET OF TRENCH REQUIRED 144

4.5 FT

Add On - Deck

LOG. PERMIT SIGNED
AND RETURNED 11-9-95
Serial # 62596

TRENCHES - Trench to be 2 feet wide. Inlet 3.5 feet below original grade. Bottom maximum depth 8.5 feet below original grade. Effective area begins at 3.5 feet below original grade. 5 feet of stone below distribution pipe. 180 JEN

LOCATION - Place the distribution box 270 feet down the right (390') lot line and 145 feet off the right lot line as seen when facing the lot from Right-of-way of Tall Pine Way. Run trenches on contour toward the left lot line. 8692

NOTE - No trench to exceed 100 feet in length. Provide 6" - 8" diameter cleanout and cap to grade or above on septic tank. OK 3/24/92 R/H

10/8/92 REVISED DEPTH TO ACCOMMODATE GRADE

PLANS APPROVED BY G. R. Abel DATE 1/09/87

COVER NO WORK UNTIL INSPECTED AND APPROVED

NEITHER THE HOWARD COUNTY COUNCIL NOR THE HEALTH DEPARTMENT IS RESPONSIBLE FOR THE SUCCESSFUL OPERATION OF ANY SYSTEM

NOTE: CLEANOUT REQUIRED EVERY 70 FEET OF SEWER LINE AND/OR AT 90° SWEEPS IN LINES FROM HOUSE TO DRAIN FIELDS, 90° ELBOWS NOT ACCEPTABLE.

NOTE: ALL PARTS OF SEPTIC SYSTEMS (I.E. TANK, DISTRIBUTION BOX TRENCHES) TO BE 100 FEET FROM WELL (UNLESS OTHERWISE SPECIFICALLY AUTHORIZED)

NOTE: IF DEEP TRENCH(ES) ARE USED CALL FOR INSPECTION BEFORE AND AFTER PLACING GRAVEL IN TRENCH(ES)

NOTE: NO DRY WELL SHALL EXCEED 15 FOOT IN DIAMETER NO ABSORPTION TRENCH TO EXCEED 100 FEET IN LENGTH

NOTE: ALL PIPE FROM HOUSE TO SEPTIC TANK MUST BE CAST IRON OR SCHEDULE 35/40 PVC OR ABS

PERMIT VOID AFTER TWO YEARS

NOTE: INSTALL STAND PIPE ON SEPTIC TANK AND DRY WELL STAND PIPES MUST BE 6 INCHES IN DIAMETER CAST IRON. CONCRETE OR TERRA COTTA OR PVA OR ABS ACCEPTED. IF TOP OF SEPTIC TANK IS DEEPER THAN 3 FEET. MANHOLE TO GRADE REQUIRED.

NOTE: DISTRIBUTION BOXES MUST HAVE BAFFLES

*INSTALLER IS RESPONSIBLE FOR OBTAINING FINAL APPROVAL ON THIS PERMIT

A 37251

TANK FLOATING
10/9/92 RH

10/9/92 RH


GRAPE
LEVEL

PIPE

MUR

NOB

12" EARTH
TO COVER
PIPE

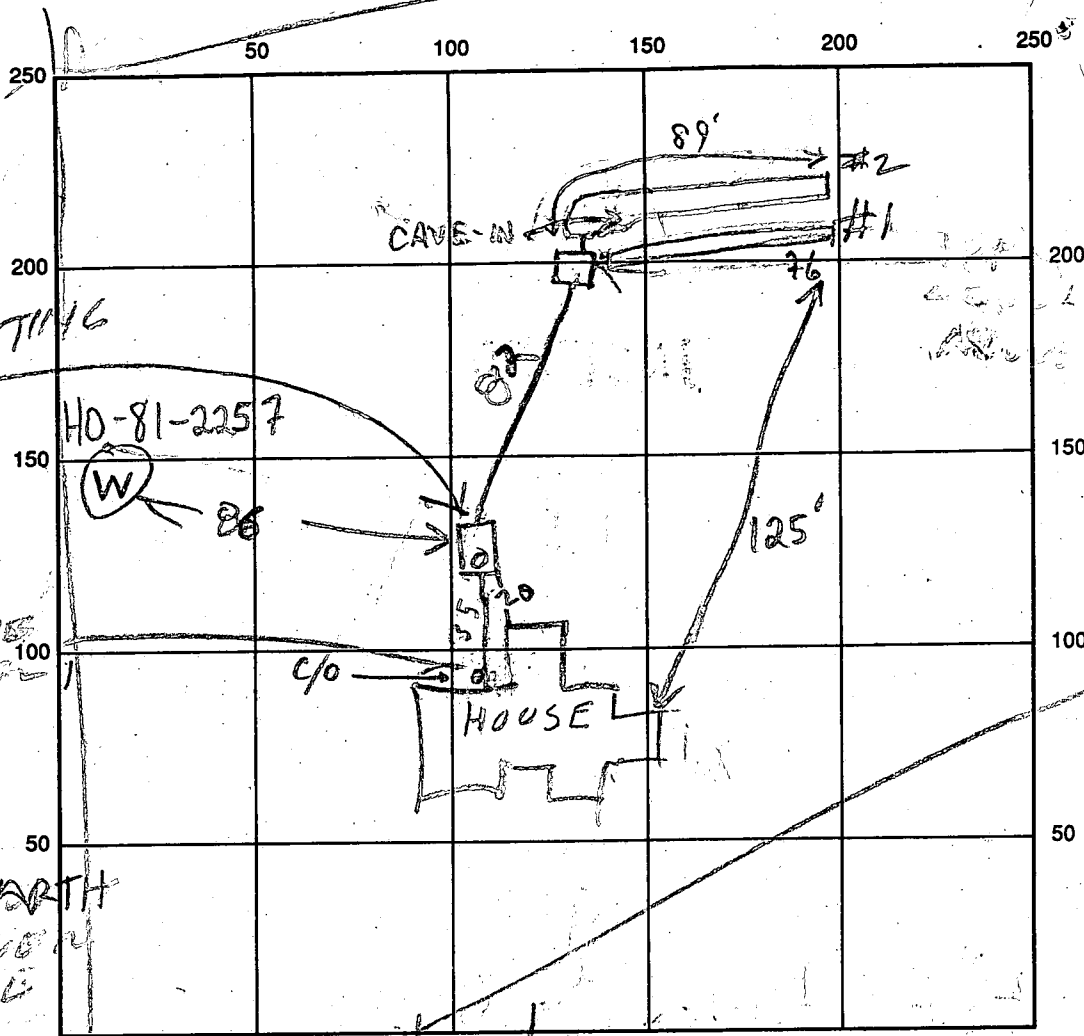

INDICATE NORTH - NAME ADJOINING ROADWAY AS BASE LINE

SEPTIC TANK LEVEL OK 1500 GAB

CLEANOUTS OK (1 @ S.T., 1 IN LINE)

DISTRIBUTION BOX LEVEL

DRAIN FIELD/TITLE DEPTH 8.5/9.5 FT.

TRENCH WIDTH 2 FT.

INLET DEPTH 4.5 FT.

EFFECTIVE GRAVEL DEPTH 4.5/5 FT.

TOTAL LENGTH 76/89 FT.

NUMBER OF TRENCHES 2

ONE SIDEWALL/BOTTOM AREA _____ SQ. FT.

DRYWALL INSIDE DIAMETER _____ FT.

EFFECTIVE DEPTH BELOW INLET _____ FT.

ABSORBENT AREA _____ SQ. FT.

REMARKS 10/8/92 - HOLD FOR REVIEW - TANK TOO CLOSE
TO WELL & TOP OF TANK ABOVE GRADE 10/9/92 NO ONE PRESENT MR
10/9/92 - TANK FLOATED. RESET TANK OK TO HAVE TANK
86 FT FROM WELL OK TO HAVE HOUSESEWER GRADE LEVEL BUT
MUST BE COVERED LATER WITH 12" EARTH & CHECKED AFTER COVERING
TRENCH #1 NOB. ADD STONE. CONTINUE WORK & CALL 10/13/92 RH

DATE SYSTEM APPROVED 10/15/92

INSPECTOR M. RIFKIN

10/14/92 #1 FINISH TRENCHES (AT IN ELEV OFF CONTOUR) & RE-SET TANK MR
10/14/92 #2 TRENCHES OK, TANK NOT SET, D.B. COULD NOT RIGHT MR

SUBDIVISION: THISTLEDOWNLOT NUMBER: 10DRY WELL OR DRY WELL AND TRENCH

	<u>Septic Tank</u>	<u>Minimum Total square Feet</u>
3 bedroom	1000 gallon	_____ sq. ft./bedroom
4 bedroom	1250 gallon	_____
5 bedroom	1500 gallon	_____

Inlet _____ feet below original grade.

Bottom maximum depth _____ feet below original grade.

Effective area begins at _____ feet below original grade.

NOTE: If trench is used to make up absorbent area, run the trench on level ground and leave a 5 foot earth buffer between dry well and trench. No trench is to exceed 100 feet in length. Trench inlet to be same as dry well, with _____ feet of stone below distribution pipe.

TRENCHES180 sq. ft./bedroomTrench to be 2 wide.36 LINEAR FT / BED ROOMInlet 3.5 feet below original grade.Bottom maximum depth 8.5 feet below original grade. 144 LINEAR FT / 4 BEDROOMSEffective area begins at 3.5 feet below original grade.5 feet of stone below distribution pipe.

- NOTE:
- (1) No trench to exceed 100 feet in length.
 - (2) If more than one trench used, a distribution box is required.
 - (3) Trenches to be installed on level ground.
 - (4) Call for inspection of trench before gravel is installed.
 - (5) Provide 6"-8" diameter cleanout and cap to grade or above on septic tank and drywell.
 - (6) If a Garbage disposal is used, increase septic tank capacity by 50% and increase absorbant sidewall area by 22%.

LOCATION: PLACE THE DISTRIBUTION BOX 270 FEET DOWN THE RIGHT (390°)384.4 ^{JEN}
86-92

LOT LINE AND 145 FEET OFF THE RIGHT LOT LINE AS SEEN WHEN
FACING THE LOT FROM R.O.W. OFF TALL PINE WAY. RUN TRENCHES
ON CONTOUR TOWARD THE LEFT LOT LINE. 1-9-87 SID AML

APPLICATION

SEWAGE DISPOSAL TESTING

STATE OF MARYLAND - DEPARTMENT OF HEALTH AND MENTAL HYGIENE

A 37251

P _____

HOWARD COUNTY HEALTH DEPARTMENT
ENVIRONMENTAL HEALTH SERVICES

P. O. BOX 473 ELLICOTT CITY, MARYLAND 21043
TELEPHONE: 992-2330

DISTRICT _____

DATE 4/25/86

TO: THE COUNTY HEALTH OFFICER
ELLICOTT CITY, MARYLAND

I, HEREBY, APPLY FOR THE NECESSARY TEST IN ORDER TO CONSTRUCT (OR RECONSTRUCT) A SEWAGE DISPOSAL SYSTEM.

PROPERTY OWNER Estate of Grace E. Lager The Ryland Group, Inc

ADDRESS c/o Tom Lloyd
Lloyd, Kane and Wieder 2716 Court Place PHONE 290-7050
Ellicott City, Maryland 21043

PROPERTY LOCATION:

SUBDIVISION Thistledown LOT NO. X 10 on Prelim

ROAD AND DESCRIPTION South Guilford Road between Hall Shop and Pindell School Road.

(7209 Tall Pine Way)

SIZE OF LOT 3.2 acres TYPE BLDG. residential
(NUMBER OF BEDROOMS) _____

THE SYSTEM INSTALLED UNDER THIS APPLICATION IS ACCEPTABLE ONLY UNTIL PUBLIC FACILITIES BECOME AVAILABLE. I FULLY UNDERSTAND THE
FEE CONNECTED WITH THE FILING OF THIS PERC TEST APPLICATION IS NON-REFUNDABLE UNDER ANY CIRCUMSTANCES. I ALSO AGREE TO COMPLY
WITH ALL M.O.S.H.A. REQUIREMENTS IN TESTING THIS LOT.

(SIGNATURE OF APPLICANT)

APPROVED BY Sidney Abel FOR Deep trenches DATE 1-9-87

REJECTED BY _____ FOR _____ DATE _____

HOLD PENDING FURTHER TESTS _____ DATE _____

REASONS FOR REJECTION OR HOLDING 7-17-86 PERC SATISFACTORY, OK FOR DEED S&SF. HOLD FOR Subdivision PERM.


S. Abel BLDG. PERMIT SIGNED
AND RETURNED 5/19/92
Serial # 91468-
SFO-4Bulldozers.

THIS IS NOT A PERMIT

SOIL PROFILE

9" 0" AP
RED BROWN
Silt loam
CLAY 12-15%
C10%
FRAGMENTS
4" YELLOW BR
w/ PINK
CASTS
SANDS silt
LOAM
C10%
FRAGMENTS
slightly
micaceous
13"

9" 0" (B) (A) AP
YELLOW BR
Silt loam
12% CLAY
C10% FRAGS
3" RED BROWN
Silt SAND
C10%
FRAGMENTS
13"

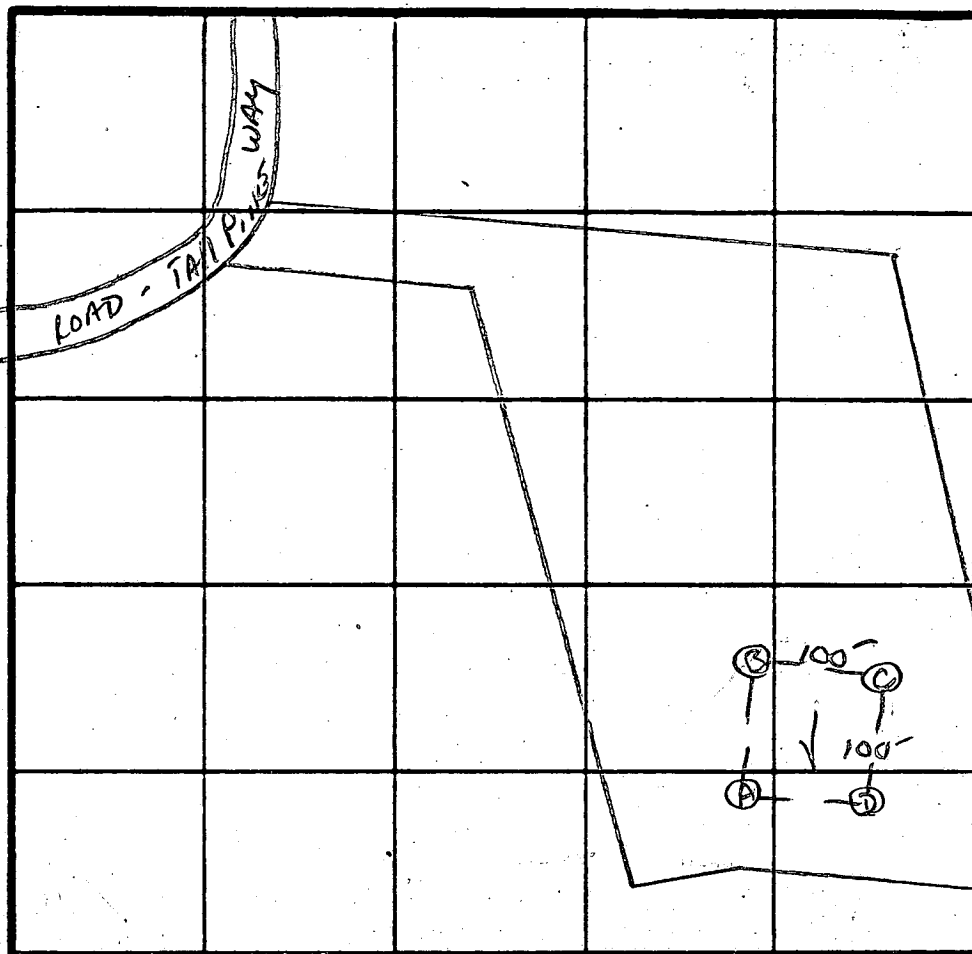

INDICATE NORTH - NAME ADJOINING ROADWAY AS BASE LINE.

Et 32

DATE	TEST NO.	DEPTH	PRE-WET		TEST - 1" DROP		TIME
			START	STOP	START	STOP	
	A S	4"	3:01	3:09	3:09	3:23	14 MIN
	A M	4"	2:58	2:59	2:59	3:02	3 MIN
	A V	13"	SAME AS HOLE A				
	B S	4"	2:40	2:41	2:41	2:43	2 MIN
	B V	13"	UNIFORM SOIL COMP below 3"				
	C S	4"	2:32	2:43	2:43	3:54	11 MIN
	C V	13"	UNIFORM SOIL COMP below 4"				
	D S	4.5"	3:10	3:13	3:13	3:17	4 MIN
	D V	12"	SAME AS HOLE C				

REMARKS HOLES PER PLAT OR PER DEEP SYST.


TYPE OF SOIL Chester

TESTED BY S. Abel

ALSO PRESENT MARK Allen
Buckhoe

B 1 5521	SEQUENCE NO. (OEP USE ONLY)	STATE OF MARYLAND PERMIT TO DRILL WELL please print or type	OEP PERMIT NUMBER HC-81-2257
Date Received 8 7 13		LOCATION OF WELL R 39846 44 40 8/13/87	
OWNER INFORMATION HOCHSTEAD TARA 6041 MISTY ARCH RUN COLUMBIA MD 21044		B 3 COUNTY HOWARD SUBDIVISION THISTLE TOWN SECTION 44 LOT 10 NEAREST TOWN GARSVILLE MILES FROM TOWN (enter 0 if in town) 3 MI	
DRILLER INFORMATION Driller's Name George F. Easterday L. Franklin Easterday, Inc. Firm Name 9265 Br. Ch. Rd., Mt. Airy, Md. 21771 Address Signature George F. Easterday Date 7/27/87		B 4 DIRECTION OF WELL FROM TOWN (CIRCLE BOX) NEAR WHAT ROAD TALL PINE WAY ON WHICH SIDE OF ROAD (CIRCLE APPROPRIATE BOX) DISTANCE FROM ROAD 230 ENTER FT or MI FT	
WELL INFORMATION APPROX. PUMPING RATE (GAL. PER MIN.) 5 AVERAGE DAILY QUANTITY NEEDED (GAL. PER DAY) 500		NOT TO BE FILLED IN BY DRILLER HEALTH DEPARTMENT APPROVAL HOWARD COUNTY NAME OEP SIGNATURE A37251 COUNTY NO. DATE ISSUED 090387 STATE HEALTH INSERT S 03/03/88 NORTH GRID 491000 EAST GRID 0821000	
USE FOR WATER (CIRCLE APPROPRIATE BOX) ☒ HOME (SINGLE OR DOUBLE HOUSEHOLD UNIT ONLY) ☐ FARMING (LIVESTOCK WATERING & AGRICULTURAL IRRIGATION) ☐ INDUSTRIAL, COMMERCIAL, STATE AND FEDERAL GOV. OTHER (REQUIRES APPROPRIATION PERMIT) ☐ PUBLIC OR PRIVATE WATER COMPANY (REQUIRES APPROPRIATION PERMIT AND STATE HEALTH DEPARTMENT APPROVAL) ☐ TEST, OBSERVATION, MONITORING (MAY REQUIRE APPROPRIATION PERMIT)		SHOW MAJOR FEATURES OF BOX & LOCATE WELL WITH AN X SOURCES OF DRILLING WATER 1. WELL 2. 3. WRITE THE BOX NUMBER FROM THE MAP HERE 828 1 498 1	
APPROXIMATE DEPTH OF WELL 200 FEET APPROXIMATE DIAMETER OF WELL 6 INCH		10-8-87 Grant 60 ft open hole 71 ft casing 2 ft above ground 18 bags cement Location ok VE Nadeau	
METHOD OF DRILLING (circle one) BORED (or Augered) ☒ JETTED ☐ Jetted & DRIVEN ☐ AIR-ROTARY ☒ AIR-PERCussion ☐ ROTARY (Hydraulic Rotary) ☐ CABLE ☐ REVERSE-ROTARY ☐ Drive-POINT ☐ other		DRAW A SKETCH BELOW SHOWING LOCATION OF WELL IN RELATION TO NEARBY TOWNS AND ROADS AND GIVE DISTANCE FROM WELL TO NEAREST ROAD JUNCTION 	
REPLACEMENT OR DEEPEINED WELLS (CIRCLE APPROPRIATE BOX) ☒ THIS WELL WILL NOT REPLACE AN EXISTING WELL ☐ THIS WELL WILL REPLACE A WELL THAT WILL BE ABANDONED AND SEALED ☐ THIS WELL WILL REPLACE A WELL THAT WILL BE USED AS A STANDBY ☐ THIS WELL WILL DEEPEIN AN EXISTING WELL PERMIT NUMBER OF WELL TO BE REPLACED OR DEEPEINED (IF AVAILABLE) HC-81-2257		Not to be filled in by driller (OEP USE ONLY) APPROP. PERMIT NUMBER GAP FORCE 1A2 INITIALS IN BOX PERMIT NO. HC-81-2257 SPECIAL CONDITIONS	

RECEIVED

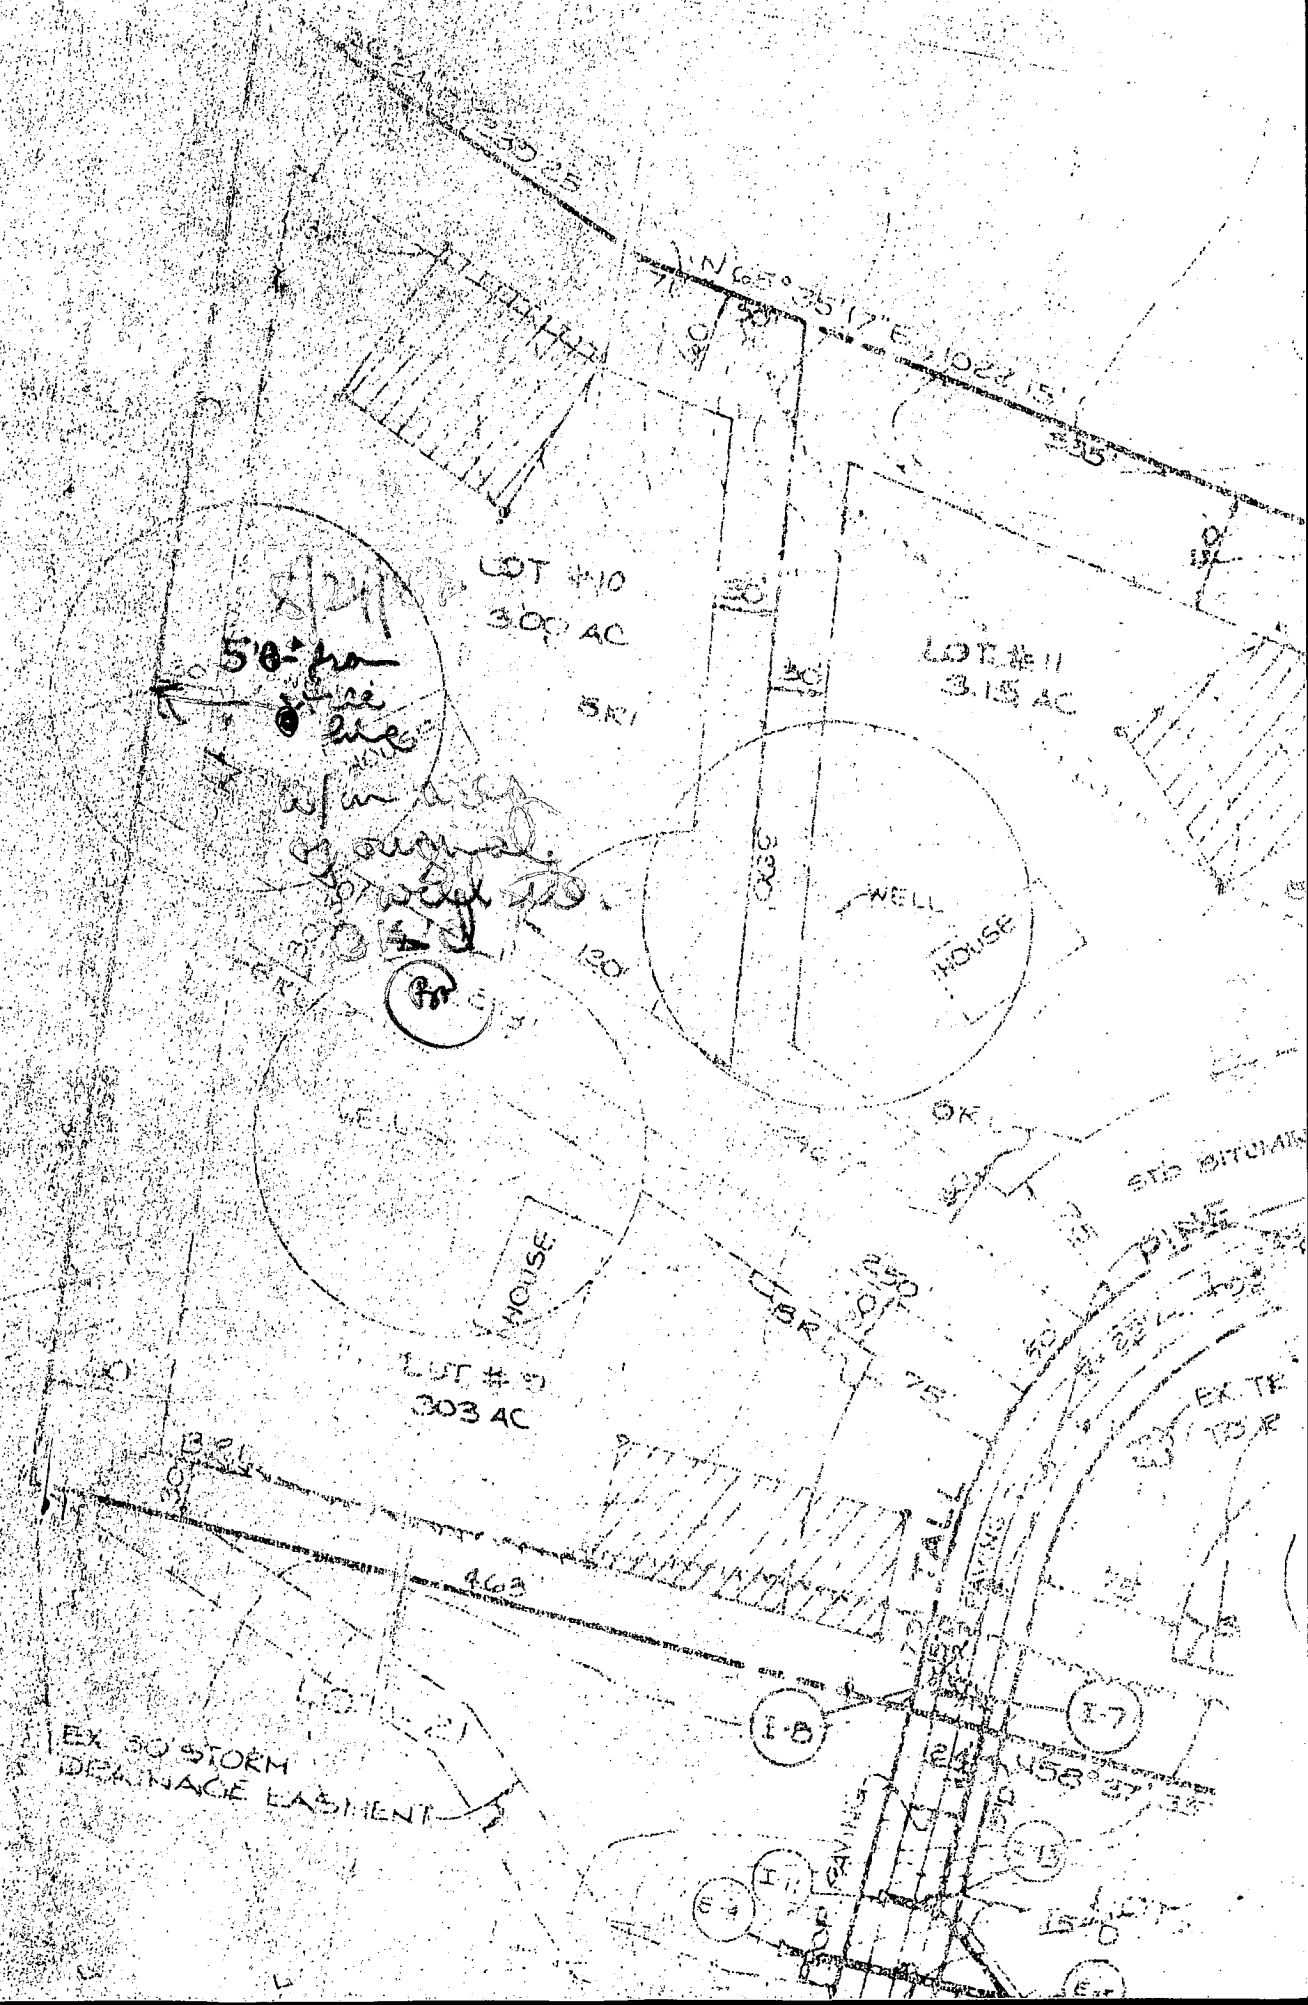

Depth of well 340 ft 5 am
Distance of measuring point (M.P.) above ground 2 ft.
Static water level (S.W.L.) below M.P. 57 ft.

Time pump started 8:00 am Pumping rate 12 gpm
Total time 30 min to reach pumping water level 143 ft. below M.P.

HD-224

C1 6062 1 2 3 6 (THIS NUMBER IS TO BE PUNCHED IN COLS. 3-6 ON ALL CARDS)		STATE OF MARYLAND WELL COMPLETION REPORT FILL IN THIS FORM COMPLETELY PLEASE PRINT OR TYPE		THIS REPORT MUST BE SUBMITTED WITHIN 45 DAYS AFTER WELL IS COMPLETED.			
DATE RECEIVED 		DATE WELL COMPLETED 		Depth of Well 22 26 (TO NEAREST FOOT)		COUNTY NUMBER A-37251	
OWNER Hochstead STREET OR RFD TALL PINE WAY SUBDIVISION THISTLE DOWNS		first name IRA TOWN CLARKSVILLE LOT 10		PERMIT NO. FROM "PERMIT TO DRILL WELL" HC-81-2257			
WELL LOG Not required for driven wells STATE THE KIND OF FORMATIONS PENETRATED, THEIR COLOR, DEPTH, THICKNESS AND IF WATER BEARING		GROUTING RECORD WELL HAS BEEN GROUTED (Circle Appropriate Box) Y N TYPE OF GROUTING MATERIAL CEMENT CM BENTONITE CLAY BC NO. OF BAGS 18 NO. OF POUNDS 1800 GALLONS OF WATER 108 DEPTH OF GROUT SEAL (to nearest foot) from ft. to ft. (enter 0 if from surface)		PUMPING TEST HOURS PUMPED (nearest hour) 3 PUMPING RATE (gal. per min. to nearest gal.) 4 METHOD USED TO MEASURE PUMPING RATE Bucket WATER LEVEL (distance from land surface) BEFORE PUMPING 57 WHEN PUMPING 141 TYPE OF PUMP USED (for test) A air P piston T turbine C centrifugal R rotary O other (describe below) J jet S submersible			
DESCRIPTION (Use additional sheets if needed)		FEET FROM TO		Check if water bearing			
Top soil		0 1					
Red mica		1 4					
Br. mica		4 65					
Gray mica		65 160					
White mica		160 165					
Gray mica		165 270					
White mica		270 273					
Gray mica		273 340					
CASING RECORD casing types insert appropriate code below ST CO PL OT STEEL CONCRETE PLASTIC OTHER MAIN CASING TYPE Nominal diameter top (main) casing (nearest inch) 4 Total depth of main casing (nearest foot) 71		OTHER CASING (if used) diameter inch from to		SCREEN RECORD screen type or open hole insert appropriate code below ST BR HO PL OT STEEL BRASS OPEN HOLE PLASTIC OTHER DEPTH (nearest ft.) H/O 71 340			
C2 EACH SCREEN 1 2 3 100		SLOT SIZE 1 2 3 100		Diameter of screen (nearest inch) 4			
GRAVEL PACK IF WELL DRILLED WAS FLOWING WELL INSERT F IN BOX 68		OEP USE ONLY (NOT TO BE FILLED IN BY DRILLER) T (E.R.O.S.) 70 72 74 75 76 WQ TELESCOPE CASING LOG INDICATOR OTHER DATA		PUMP INSTALLED DRILLER WILL INSTALL PUMP YES NO IF DRILLER INSTALLS PUMP, THIS SECTION MUST BE COMPLETED FOR ALL WELLS EXCEPT HOME USE TYPE OF PUMP INSTALLED PLACE (A,C,J,P,R,S,T,O) IN BOX - SEE ABOVE: CAPACITY: GALLONS PER MINUTE (to nearest gallon) 31 35 PUMP HORSE POWER 37 41 PUMP COLUMN LENGTH (nearest ft.) 43 47 CASING HEIGHT (circle appropriate box and enter casing height) + above - below LAND SURFACE 2 (nearest foot)			
CIRCLE APPROPRIATE LETTER A A WELL WAS ABANDONED AND SEALED WHEN THIS WELL WAS COMPLETED E ELECTRIC LOG OBTAINED P TEST WELL CONVERTED TO PRODUCTION WELL I HEREBY CERTIFY THAT THIS WELL HAS BEEN CONSTRUCTED IN ACCORDANCE WITH COMAR 10.17.13 "WELL CONSTRUCTION" AND IN CONFORMANCE WITH ALL CONDITIONS STATED IN THE ABOVE CAPTIONED PERMIT, AND THAT THE INFORMATION PRESENTED HEREIN IS ACCURATE AND COMPLETE TO THE BEST OF MY KNOWLEDGE. DRILLERS IDENT. NO. 40 DRILLERS SIGNATURE James J. Engle SITE SUPERVISOR (sign. of driller or journeyman responsible for sitework if different from permittee) Blue De Sha		LOCATION OF WELL ON LOT SHOW PERMANENT STRUCTURE SUCH AS BUILDING, SEPTIC TANKS, AND/OR LANDMARKS AND INDICATE NOT LESS THAN TWO DISTANCES (MEASUREMENTS TO WELL) Back lot line 50' 50'					

Review SA CK 12-9-82

FIELD DATA SHEET
HOWARD COUNTY WELL YIELD TEST

Well Permit No. HO - 81- 2257

Location of property (road) TALL PINE WAY

Subdivision: THISTLE DOWN

Subdivision: THISTLE DOWN Lot 10 Block Plat Sec.

No. 1 Driller GEORGE SASTERDAY Owner HOCHSTEAD, GRA

Depth of well 340 5 Gpm

Distance of measuring point (M.P.) above ground 2'

Static water level (S.W.L.) below M.P. 57

I. High rate pumping -- reservoir drawdown

Time pump started 8:00

Pumping rate 12 gpm

total time 30 min. to reach pumping water level 143' ft. below M.P.

II. Recovery pump test data - observations to be recorded every 15 minutes

[illegible]

10/14/92

SA OK 10-1-92

HOWARD COUNTY HEALTH DEPARTMENT
Bureau of Environmental Health
3525-H Ellicott Mills Drive
Ellicott City, MD 21043
461-9933

APPLICATION FOR PITLESS ADAPTER, WELL PUMP AND PRESSURE TANK INSTALLATION

New Installation ☒
Replacement ☐

Receipt # 48296
Date 10/24/92

Name of Installer Richard A. Cook
Plumbing & Heating, IncTelephone 301-490-4224

License Number _____

Certified Well Pump Installer _____ Well Driller _____ Registered Plumber ☒Name of Property Owner IRA HOCKSTADT

Telephone _____

Subdivision THISTLE DOWN Lot # 10Well Tag # HO-81-2257Site Address TALL PINE WAY

Pump

1. Type

- a. Deep well jet _____
b. Shallow well jet _____
c. Submersible _____

2. Make _____

3. Model # _____

4. Capacity _____ GPM

5. Pump exceeds well capacity Yes _____ No _____

6. If Yes, is low pressure cutoff switch installed? Yes _____ No _____

7. What methods are used to protect the pump and electrical wiring from vibrations? Torque arrestors _____ Cable guards _____ Other _____

Motor

1. Horsepower _____

2. RPM _____

3. Voltage _____

a. 110 _____

b. 220 _____

Pitless Adapter

1. Make _____

2. Model # _____

3. Depth _____

Tank

1. Capacity _____

2. Pressure relief valve? _____

Piping

1. Type _____

2. Size _____

3. NSF and/or BOCA Code approved _____

4. Depth of supply line _____

Well data

1. Depth 340 ft.2. Yield 4 GPM3. Static water level 57 ft.

4. Will water supply be disinfected by installer? _____

I understand that it is my responsibility to notify the Howard County Health Department when the installation is ready for inspection (otherwise this permit is null and void).

All information given above is true to the best of my knowledge.

Signature of Applicant: _____

Date: _____

Note: A sticker indicating approval/status of the installation will be placed on the well casing at the time of the inspection.

HOWARD COUNTY

SERIAL NUMBER

PERMIT APPLICATION

DEPARTMENT OF INSPECTIONS, LICENSES & PERMIT
3430 COURT HOUSE DRIVE, ELLICOTT CITY, MARYLAND 21043

62596

BUILDING ADDRESS (HOUSE NO., STREET, TOWN OR AREA)

7209 TALL PINE WAY
CLARKSVILLE, MD 21029

GRADING/SEDIMENT CONTROL ☐ YES ☐ NO

SDP #

DESCRIPTION OF WORK AUTHORIZED

Deck on Rear of House
12' x 12'

LOT NO.	PARCEL NO.	SEC.	AREA	BLOCK NO.	LIBER	FOLIO
10		1				

SUB DIVISION	ZONE	ZONE MAP	ELEC. DIST.	CENSUS TR.
THISTLEDOWN			5TH	

OWNER NAME AND ADDRESS	PHONE NO.
RICHARD COOK 7209 TAN PINE WAY CLARKSVILLE, MD 21031	(410) 792-0264

OCCUPANT'S NAME AND ADDRESS	PHONE NO.
-----------------------------	-----------

ARCHITECT OR ENGINEER'S NAME AND ADDRESS _____ PHONE NO. _____

CONTRACTOR'S NAME AND ADDRESS		PHONE NO.
-------------------------------	--	-----------

EXISTING USE	PROPOSED USE
8FD	Deck 12'x12'

EST. CONSTRUCTION COST \$2200.00	LICENSE NUMBER 46806	PERMIT FEE 30.00
-------------------------------------	-------------------------	---------------------

W/S CODE FOR OFFICE USE ONLY

DISTRICT IN FEET FROM R/W LINE TO FRONT BUILDING LINE _____

SIDE YARD _____
(DISTANCE IN FEET FROM SIDE BLDG. LINE TO SIDE PROPERTY LINE)

TO SIDE BUILDING LINE _____
DISTANCE IN FEET, REAR YD. REQUIRING SET _____

BACK _____ (CORNER LOT ONLY)

Check payable to: **DIRECTOR OF FINANCE OF HOWARD COUNTY**

CAUTION

To begin construction before a permit placard has been issued and displayed on the job is a violation of the law.

Use and occupancy permit must be applied for two weeks before it will be issued.

IMPORTANT: PLEASE SHOW ZIP CODES AND AREA CODES WHEREVER REQUIRED.

LP-69-591


SIZE OF BLDG.	FRONT	DEPTH	HEIGHT
TYPE OF BLDG.	AREA	VOLUME	ROOF
B. ROOMS			
ROOMS			
BATHS			
FIREPLACES			

FOOTINGS	FOUNDATION	S. WALLS

UTILITIES							
WATER	WELL	USE	SEPTIC	GAS	ELECTRICITY	TYPE OF HEAT	AC

I have carefully examined and read this application and know the same is true and correct, and that is doing this work, all provisions of Howard County Ordinances and the State Laws of Maryland will be complied with, whether specified or not; and I will notify the Department of Inspections, and Permits twenty-four hours in advance when I am ready for the inspections called for elsewhere in the application; and that no work will be covered up until such inspections have been complied with.

SIGNATURE
RESIDENT LANDSCAPE 11/9/95
TITLE DATE

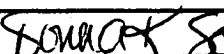FUNCTION	DATE	SIGNATURE APPROVAL
ZONING/PLANNING		
SHA		
SEDIMENT/GRADING		
BUILDING OFFICIAL	11/9/95	
WATER & SEWER		
HEALTH DEPT.	11/9/95	
FIRE PROTECTION		
STORM WATER MGM.		

APPROVED

DATE _____

Distribution of Copies:
 White - Building Official
 Green - Planning & Zoning

Yellow - Engineering
Pink - Health Dept.
Gold - S.H.A.



* WALK - THRU *

PLAN SCALE
1" = 50'

TALL PINE
50' R/W
WAY


SURVEYOR'S CERTIFICATE

by certify that the position of all the existing
is shown on the above described property has

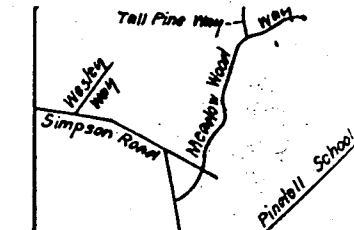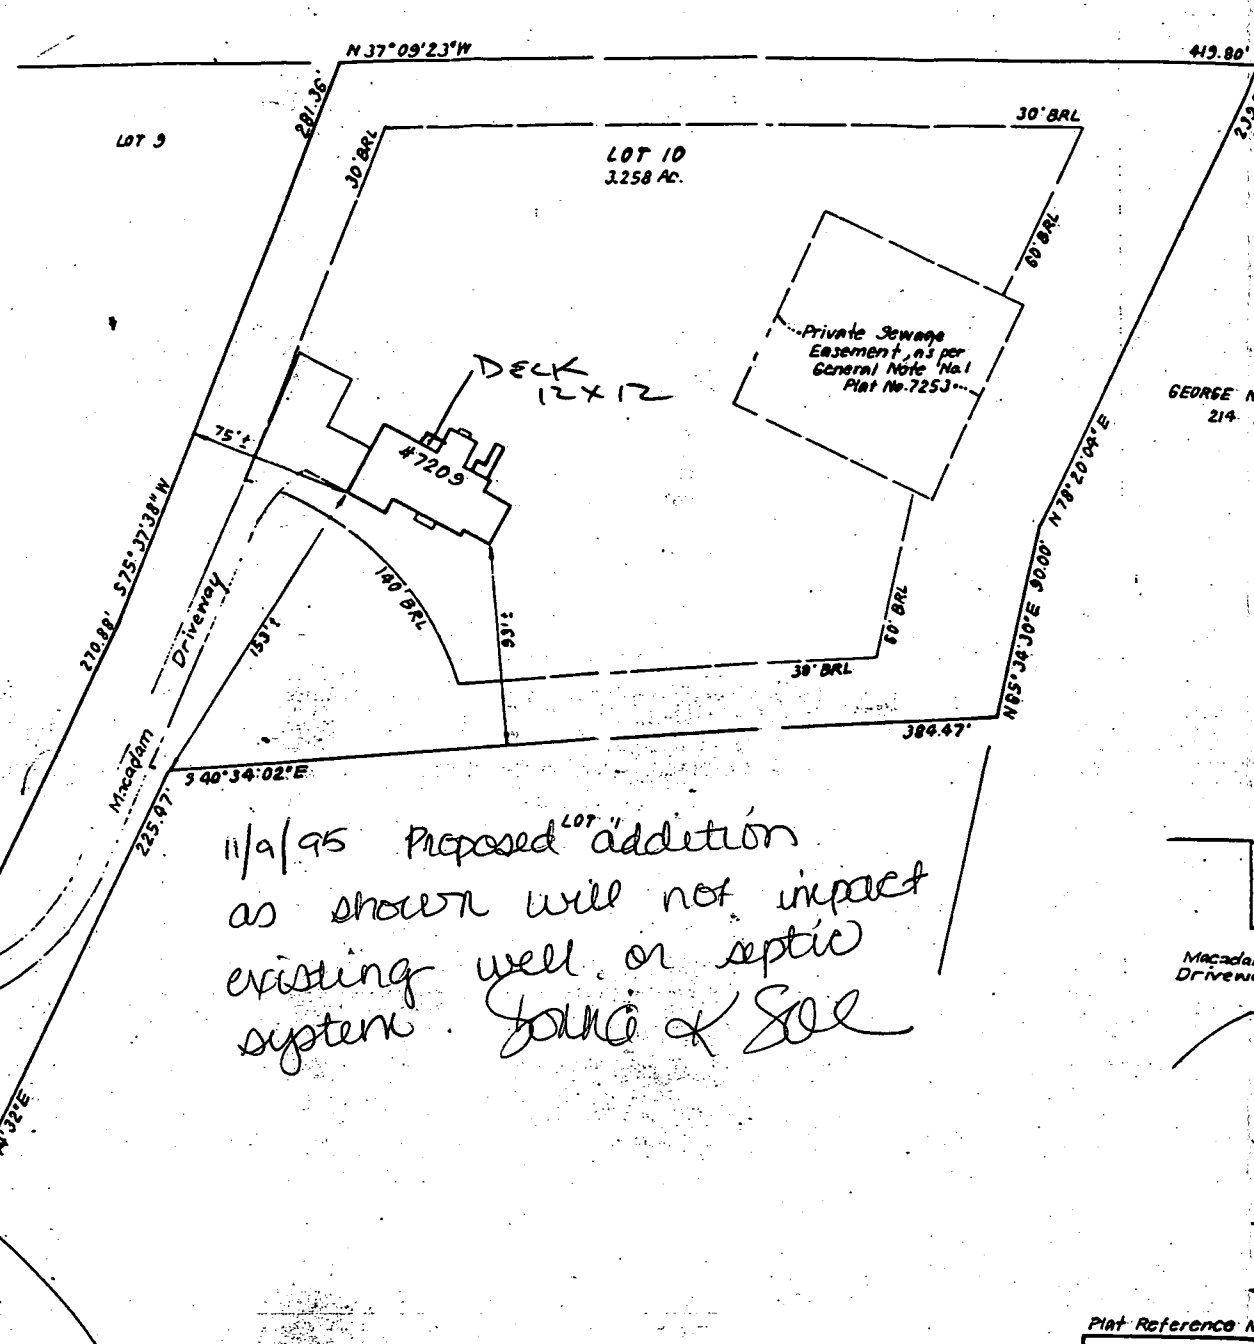

Wall Check: 7-21-92
Top of Wall Elev.: 109.9
Final: 12-7-92

GEORGE N. BROWN, et. al.
214 / 422

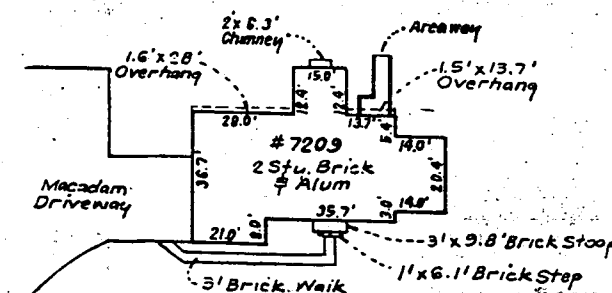

SCALE:
1" = 30'

LOT 10
SECT 1

Plat Reference Number 7256

5TH ELECTION DISTRICT



CLARK • FINEFROCK & SACKETT, INC.

ENGINEERS • PLANNERS • SURVEYORS

7135 MINSTREL WAY • COLUMBIA MD 21045 • (410) 381-7200 - BALTO • (301) 621-8100 - WASH

DESIGNED

DRAWN
JTB

LOCATION OF HOUSE
7209 TALL PINE WAY
LOT 10
THISTLEBORN

SCALE
AS SHOWN

DRAWN

N. BROWN ET AL
214-422

110.1
H.E.
92 MAR -

LEGEND


Contour Interval 2 Ft.
Existing Contour ----- 96 -----
Proposed Contour ----- 96 -----
Spot Elevation + 96 ±
Direction of Drainage →
Existing Trees to be Saved

Existing topography shown was
field run by Clark, Finefrock &
Sackett, Inc. Jan., 1992.

VICIN
Scale

NOTE: Basement will not sewer
by gravity.

AURA B SIMPSON
ET AL
749 / 296

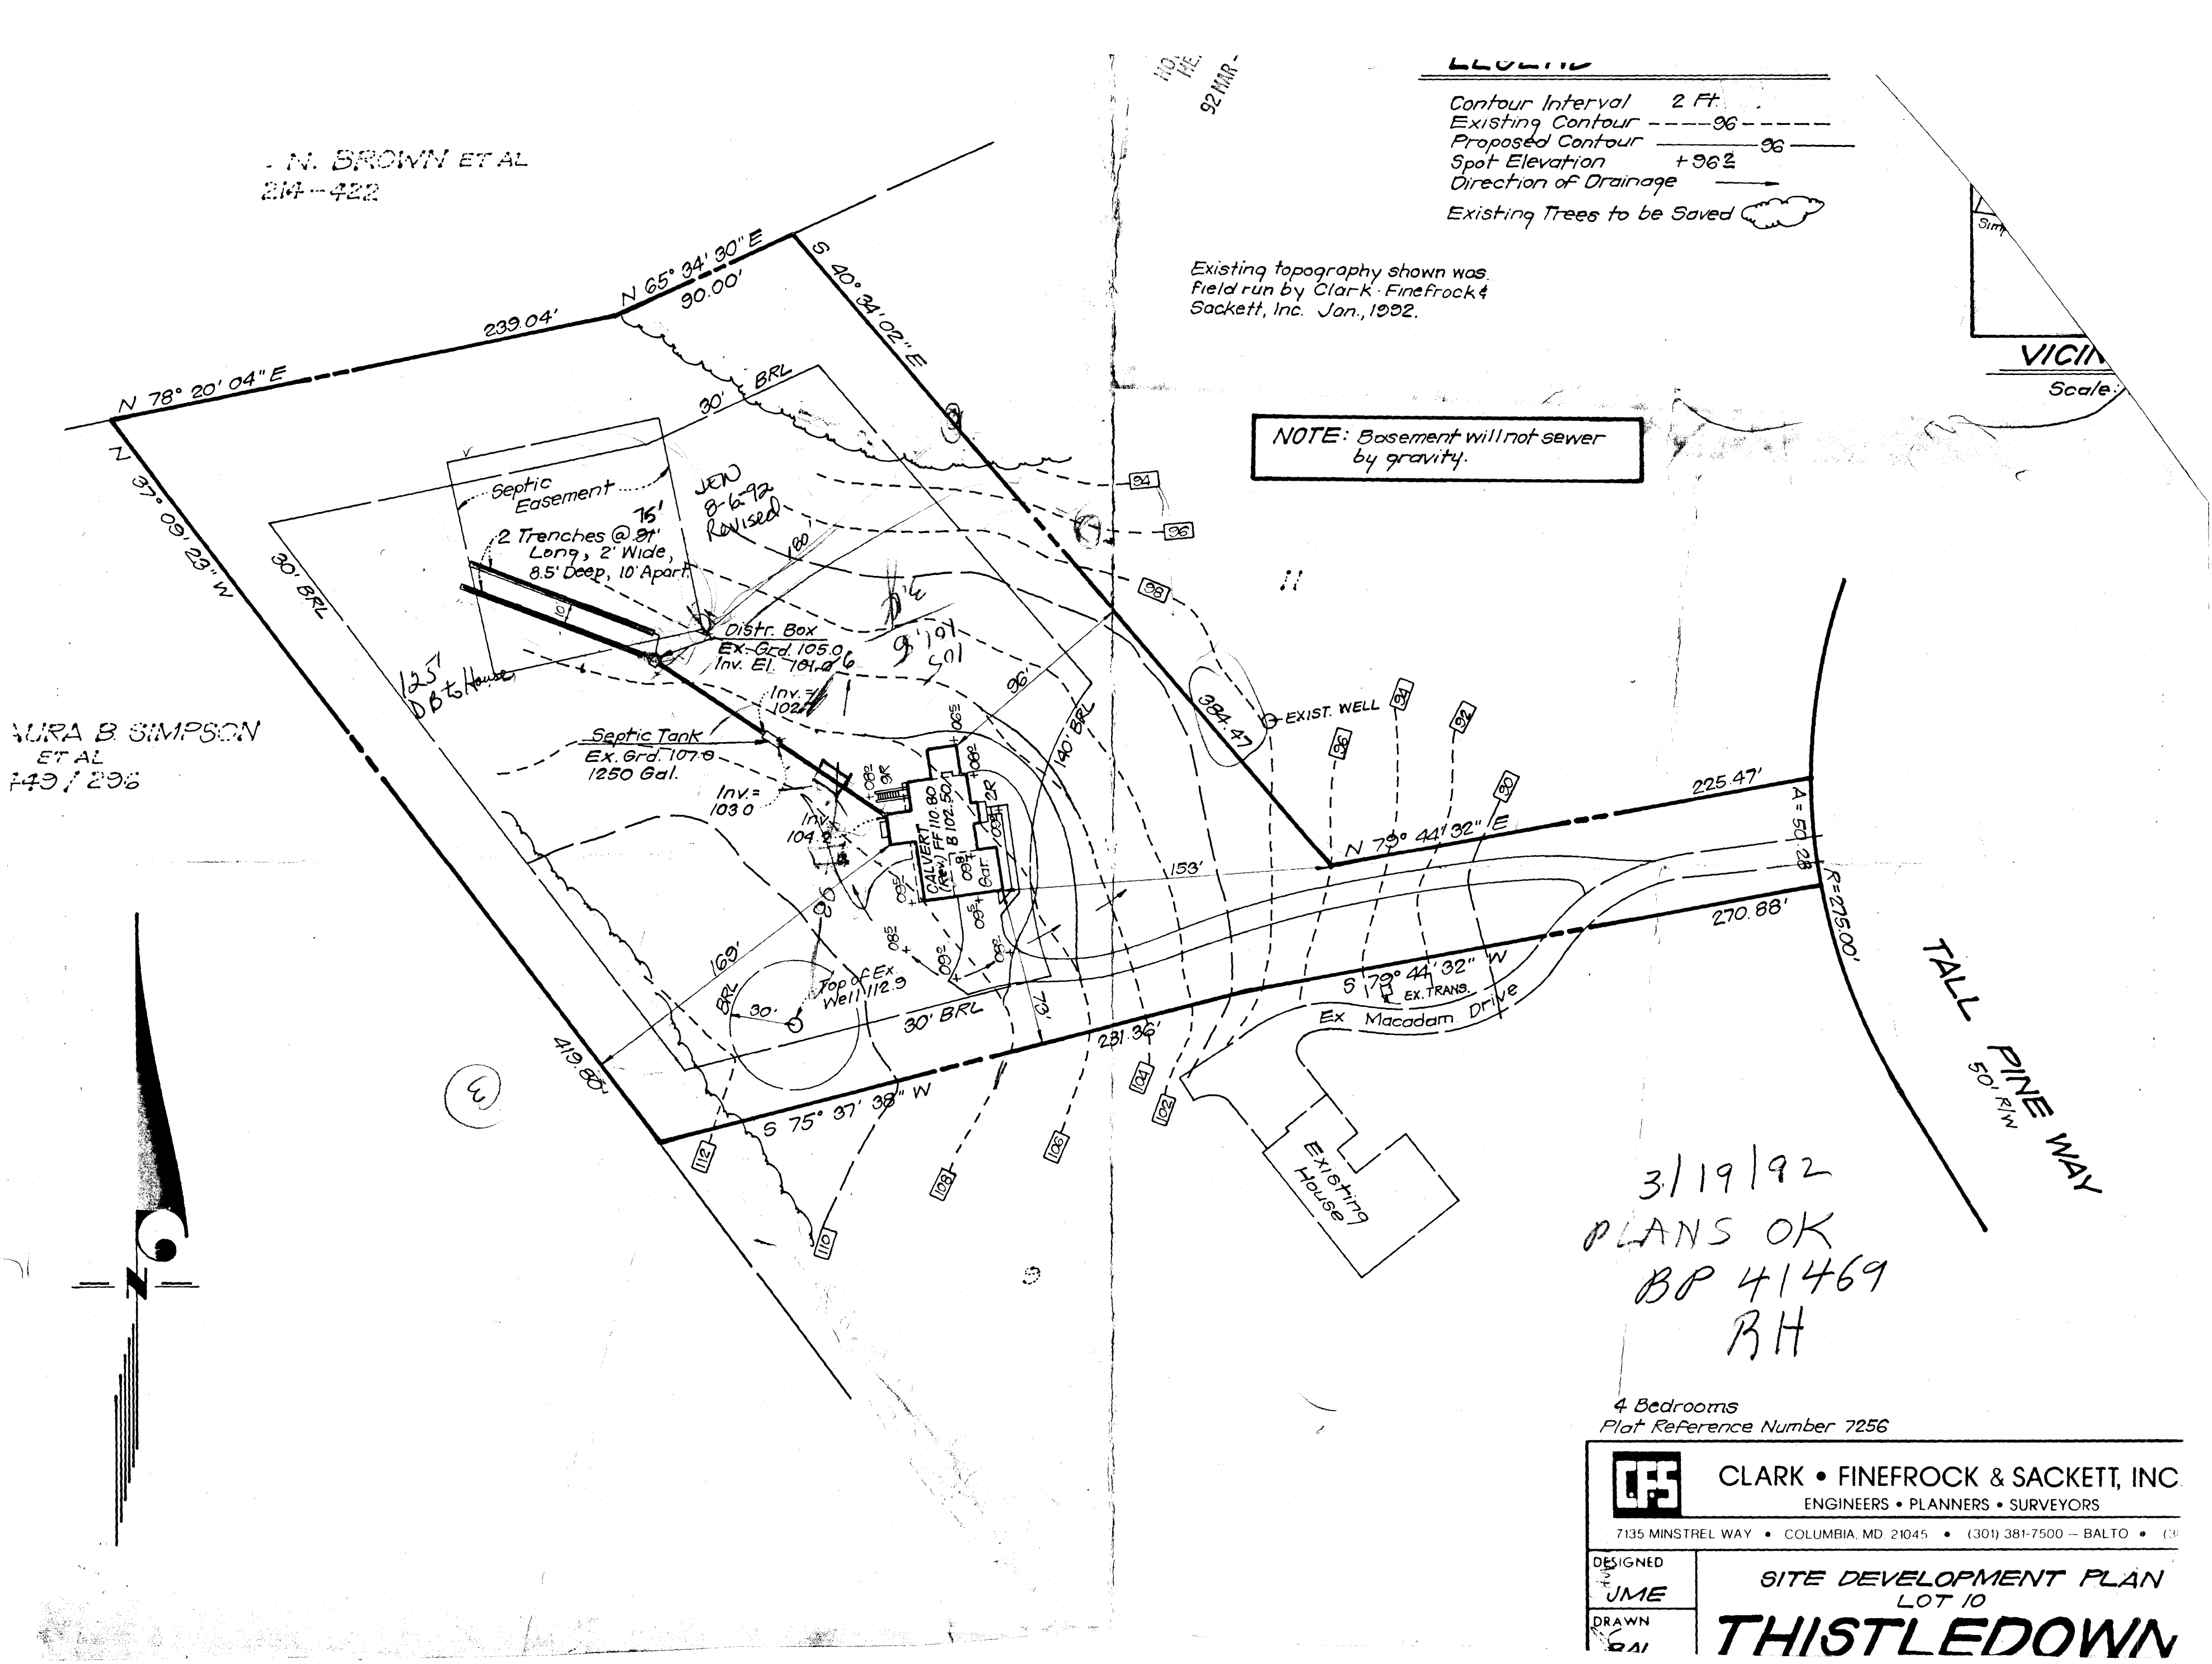

3/19/92
PLANS OK
BP 41469
BH

4 Bedrooms
Plat Reference Number 7256



CLARK • FINEFROCK & SACKETT, INC.
ENGINEERS • PLANNERS • SURVEYORS

7135 MINSTREL WAY • COLUMBIA, MD. 21045 • (301) 381-7500 - BALTO • (301) 381-7500

DESIGNED
JME
DRAWN
BAI

SITE DEVELOPMENT PLAN
LOT 10

THISTLEDOWN