

03-280306

6/27/86
septic repair
OK'd
RAN

PERMIT

SEWAGE DISPOSAL SYSTEM

MARYLAND STATE DEPARTMENT OF HEALTH

P 37184A REPAIR

HOWARD COUNTY

BUREAU OF ENVIRONMENTAL HEALTH

XXX 992-2330X

461-9933

INDEXED

ELLICOTT CITY

DISTRICT _____

DATE 6/16/86Jack FyockIS PERMITTED TO INSTALL _____ ALTER XADDRESS _____ PHONE 988-9270SUBDIVISION _____ ROAD 12700 Triadelphia Road LOT _____PROPERTY OWNER Barnett12700 Triadelphia Road

ADDRESS _____

IF GARBAGE GRINDER IS USED INCREASE SEPTIC TANK CAPACITY BY 50% AND ABSORPTION AREA BY 22%.

GARBAGE GRINDER? YES _____ NO _____

SEPTIC TANK CAPACITY 1000 GALLONS NUMBER OF BEDROOMS 3

REG. PERMIT SIGNED

AND RETURNED 1-12-270Serial # B70122058REPAIR - CALL FOR INSPECTION WHEN GROUND IS OPENED UP SO SANITARIAN CAN RECOMMENDREPAIR.Soils predominately silty mica loams.
10-15% shale 10' low

REG. PERMIT SIGNED

AND RETURNED 1-12-270Serial # B70122058Mr. Bannan Jr. Strass

REG. PERMIT SIGNED

AND RETURNED 11/1/89Serial # 30489-additionPLANS APPROVED BY C. WilliamsDATE 6/16/86

COVER NO WORK UNTIL INSPECTED AND APPROVED.

NEITHER THE HOWARD COUNTY COUNCIL NOR THE HEALTH DEPARTMENT IS RESPONSIBLE FOR THE SUCCESSFUL OPERATION OF ANY SYSTEM.

NOTE: IF TRENCH IS USED CALL FOR INSPECTION BEFORE AND AFTER PLACING GRAVEL IN TRENCH.

NOTE: NO DRY WELL SHALL EXCEED 15 FOOT IN DIAMETER. NO ABSORPTION TRENCH TO EXCEED 100 FEET IN LENGTH.

NOTE: ALL PIPE FROM HOUSE TO SEPTIC TANK MUST BE CAST IRON OR SCHEDULE 40 PVC OR ABS.

PERMIT VOID AFTER THREE YEARS.

NOTE: INSTALL STAND PIPE ON SEPTIC TANK AND DRY WELL. STAND PIPES MUST BE 6 INCHES IN DIAMETER. CAST IRON, CONCRETE OR TERRA COTTA, OR PVC OR ABS ACCEPTED. IF TOP OF SEPTIC TANK IS DEEPER THAN 3 FEET MANHOLE TO GRADE REQUIRED.

3LOG. PERMIT SIGNED


AND RETURNED 1/3/94Serial # 531041 Story Addition

*INSTALLER IS RESPONSIBLE FOR OBTAINING FINAL APPROVAL ON THIS PERMIT

*CALL 992-2330 FOR INSPECTION OF SEPTIC SYSTEMS.

EH - 2-1082

A Repair
P37184

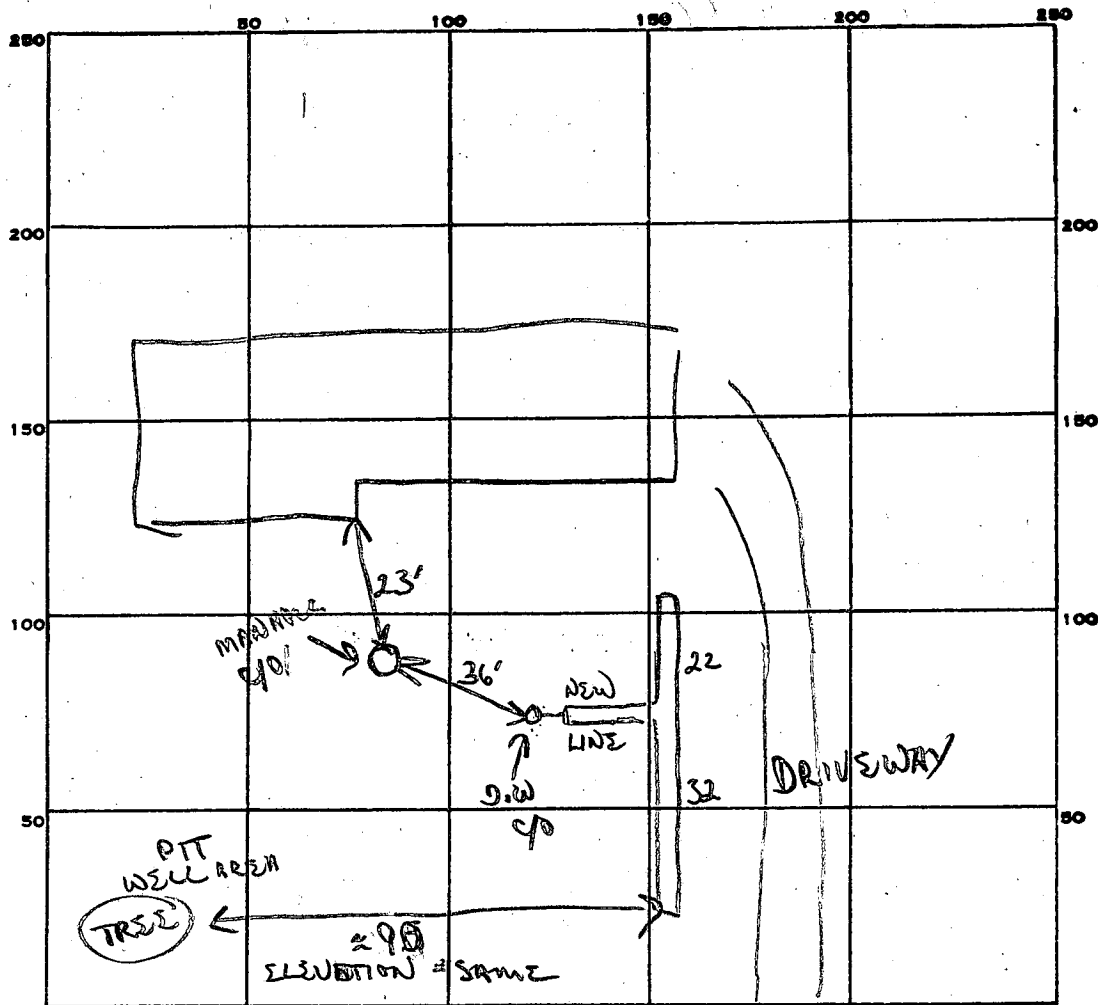

INDICATE NORTH. - NAME ADJOINING ROADWAY AS BASE LINE.


PERMIT CARD ✓ final TRIADELPHIA RD S.T. EXISTING
 SEPTIC TANK, LEVEL existing CLEANOUTS MANHOLE, 1 D.W.

DISTRIBUTION BOX, LEVEL —
 TILE FIELD, DEPTH 12 1/2 FT. TRENCH WIDTH 2 FT. 54
7
378
 GRAVEL DEPTH 7 ft IN. TOTAL LENGTH 54 FT.
 NUMBER OF TRENCHES 1 (stepped off) 1 SIDE WALL TOTAL BOTTOM AREA 378
 SEEPAGE PITS, INSIDE DIAMETER — FT. DEPTH BELOW INLET ~6-7 FT.
 ABSORBENT AREA 378 SQ. FT.

REMARKS (soils predominately silty near loams. 10-15% 2-6" shale fragments ~ 10' down) Tied into existing line at ~5' deep
OK to go 5-12' deep w/ repair. OK to add stone pipe
paper to trench. OK to cover trench & all work

DATE SYSTEM APPROVED 6/27/86 INSPECTOR B. W. Upon

Kaiser Property

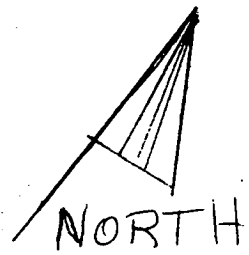

5th Election District

295.2 FEET

123.5 FEET

129' ±

EXTENSION

15'6"

18'

NEW P.R.

10'6"

10'6"

28'0"

REAR

30' ±

EXISTING

2 CAR GARAGE

NO IMPACT ON SEPTIC. OK TO PROCEED. 11/7/89 C.W.

5' ±

290.4 FEET

Ed Frank Property

Front Porch

SEPTIC

130' ±

Well

DRIVEWAY

Twigg Property

176.45 FEET

12700


PLOT PLAN

TRIADELPHIA

RD.

NOT TO SCALE

ONE ACRE MORE OR LESS

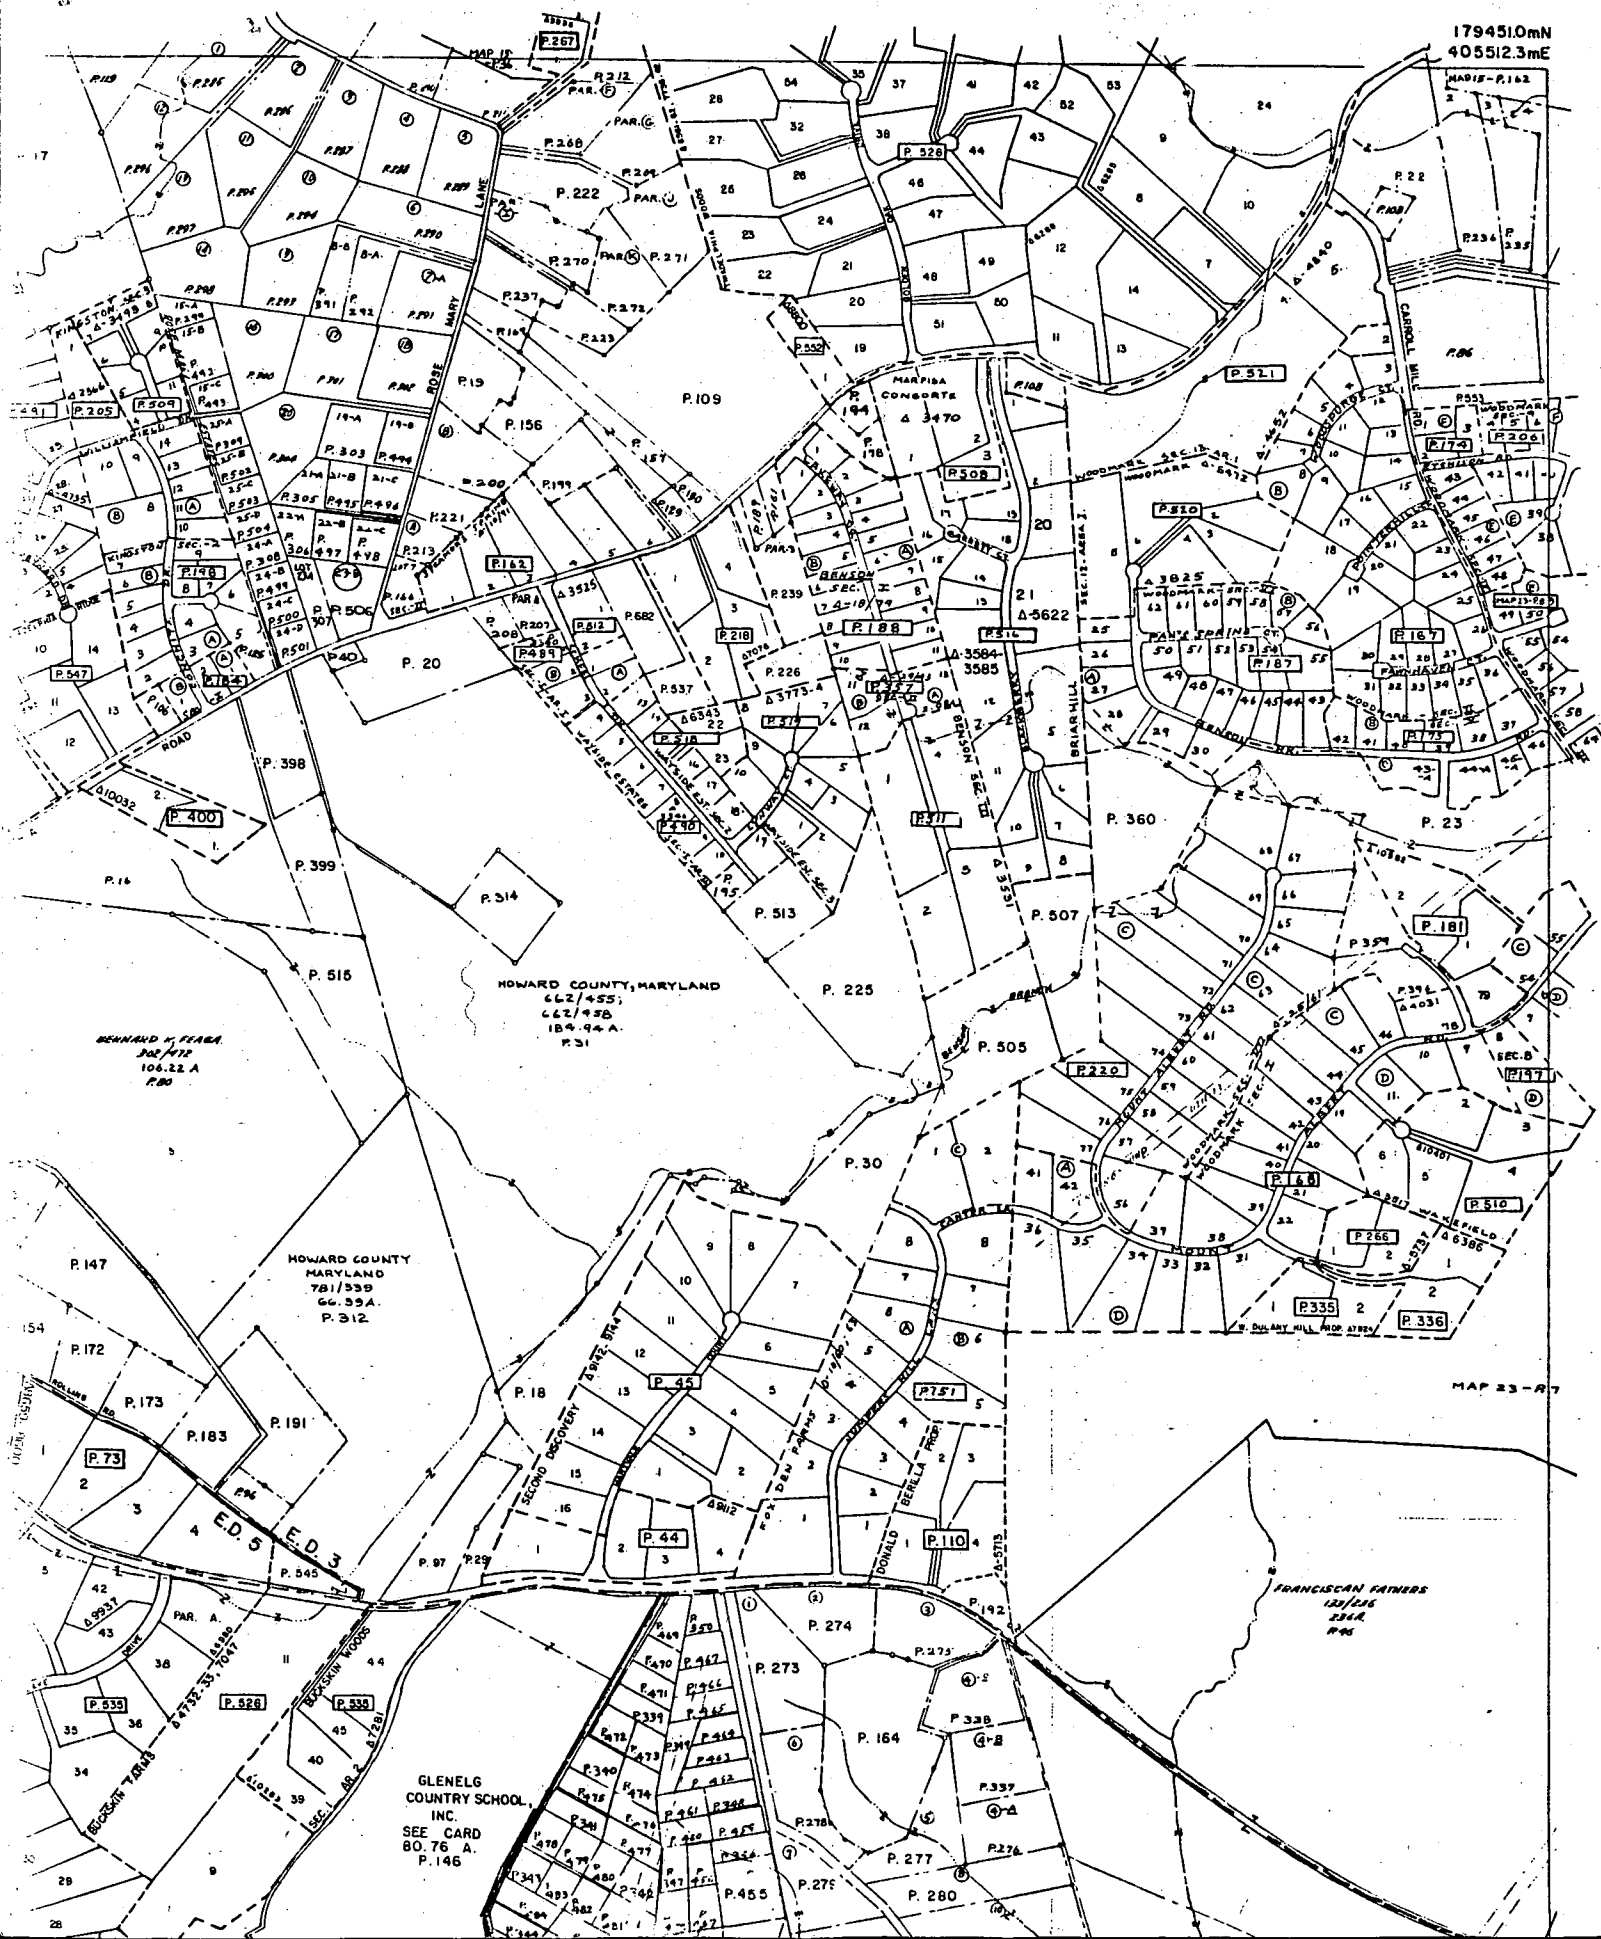

Concrete or
Block Bldg Barn
Wright Co

Qty addn will
replace existing
Deck (Now Removed)

Neighbors: 60

House

Ed FRANK
PROPERTY

REAR

EXISTING

2 Cap
Bridge

No evidence of Septic
problem, Room For
Repairs Doubtful.
Owner Says No Change
in Bedroom Number
Planned, just enlarging
existing rooms.

Recommend Approval
R/P 1/3/94 HD

Twigg

Proper

Vasantkot
Chankara

Front Porch

S.T.

sentis

well
(input)

DRIVEWAY:

12700

Plot Plan

TRIADELPHIA

R D.

NOT TO SCALE

ONE ACRE MORE OR LESS

BARNETT Property

Tm 22 BK 5 Parcel 13c

DEPARTMENT OF INSPECTIONS, LICENSES AND PERMITS 3430 COURT HOUSE DRIVE ELLICOTT CITY, MD 21043 PERMITS (410) 313-2455 INSPECTIONS (410) 313-1810 AUTOMATED INFORMATION (410) 313-3800	HOWARD COUNTY PERMIT APPLICATION	PERMIT NUMBER 300122058
---	---	-----------------------------------

Building Address: <u>12700 Tridelphia Rd.</u> <u>Ellicott City, Maryland</u>	Property Owner's Name: <u>Wm. H. & E. S. Barnett</u>
Suite/Apt. #: _____ SDP/WP/Petition #: _____	Address: <u>12700 Tridelphia Rd.</u>
Census Tract: <u>6040</u> Subdivision: <u>N/A</u>	City: <u>Ellicott City</u> State: <u>MD</u> Zip Code: <u>21042</u>
Section: <u>14</u> Area: <u>N/A</u> Lot: <u>N/A</u>	Home Phone: <u>410-531-5439</u> Work Phone: <u>SAMIE</u>
Tax Map: <u>22</u> Parcel: <u>130</u> Grid: <u>5</u>	Applicant's Name & Mailing Address, (if other than stated hereon): _____
Zoning: <u>RR DEP</u> Map Coordinates: _____ Lot size: <u>1+ Acre.</u>	Phone: _____ Fax: _____
Existing Use: <u>Single Family Home</u>	Contractor Company: <u>Pioneer Pole Building Inc.</u>
Proposed Use: <u>Storage, for same</u>	Contact Person: <u>Heidi Klock</u>
Estimated Construction Cost: \$ <u>12,000.00</u>	Address: <u>1757 West End Ave.</u>
Description of Work: <u>Pole Building</u>	City: <u>Pottsville</u> State: <u>PA</u> Zip Code: <u>17901</u>
<u>24' x 42' Storage of household</u>	License No. _____
<u>and miscellaneous</u>	Phone: <u>888-448-2505</u> Fax: <u>888-448-2515</u>
Occupant or Tenant: _____	Engineer or Architect Company: <u>SAMIE</u>
Contact Name: <u>Wm. H. Barnett Jr.</u>	Contact Person: _____
Address: <u>12700 Tridelphia Rd.</u>	Address: _____
City: <u>Ellicott City</u> State: <u>MD</u> Zip Code: <u>21042</u>	City: _____ State: _____ Zip Code: _____
Phone: <u>410-531-5439</u> Fax: _____	Phone: _____ Fax: _____

BUILDING DESCRIPTION - COMMERCIAL		BUILDING DESCRIPTION - RESIDENTIAL	
Building Characteristics	Utilities	Building Characteristics	Utilities
Height: <u>10'4"</u>	Water Supply: <u>N/A</u>	SF Dwelling ☐ SF Townhouse ☐	Water Supply: <u>N/A</u>
No. of stories: <u>1</u>	Public ☐ Private ☐	Depth: _____ Width: _____	Public ☐ Private ☐
Gross area, sq. ft. per floor: <u>1,108 sq'</u>	Sewage Disposal: <u>N/A</u>	1st floor: _____	Public ☐ Private ☐
Use group: <u>Storage</u>	Public ☐ Private ☐	2nd floor: _____	Sewage Disposal: <u>N/A</u>
Construction type:	Electric Yes ☐ No ☐	Basement: _____	Public ☐ Private ☐
☒ Reinforced Concrete	Gas Yes ☐ No ☐	Finished Basement ☐ Unfinished Basement ☐	Electric Yes ☐ No ☐
☒ Structural Steel	Heating System:	Crawl space ☐ Slab on Grade ☐	Gas Yes ☐ No ☐
☒ Masonry	Electric ☐ Oil ☐	No. of Bedrooms: _____	Heating System:
☒ Wood Frame	Natural Gas ☐	Multi-family dwellings:	Electric ☐ Oil ☐
<u>Pole Bldg 42' x 24'</u>	Propane Gas ☐	No. of efficiency units: _____	Natural Gas ☐
State Certified Modular ☐	Sprinkler system: <u>N/A</u> ☐	No. of 1 BR units: _____	Propane Gas ☐
	Full ☐ Partial ☐	No. of 2 BR units: _____	
	Other Suppression ☐	No. of 3 BR units: _____	
	# of Heads: _____	Other Structure: _____	Sprinkler system: <u>N/A</u> ☐
		Dimensions: _____	NFPA #13D ☐
		Footings: _____	NFPA #13R ☐
		Roof: _____	Other: _____
		State Certified Modular ☐	
		Manufactured Home ☐	

THE UNDERSIGNED HEREBY CERTIFIES AND AGREES AS FOLLOWS: (1) THAT HE/SHE IS AUTHORIZED TO MAKE THIS APPLICATION; (2) THAT THE INFORMATION IS CORRECT; (3) THAT HE/SHE WILL COMPLY WITH ALL REGULATIONS OF HOWARD COUNTY WHICH ARE APPLICABLE THEREON; (4) THAT HE/SHE WILL PERFORM NO WORK ON THE ABOVE REFERENCED PROPERTY NOT SPECIFICALLY DESCRIBED IN THIS APPLICATION; (5) THAT HE/SHE GRANTS COUNTY OFFICIALS THE RIGHT TO ENTER ONTO THIS PROPERTY FOR THE PURPOSE OF INSPECTING THE WORK PERMITTED AND POSTING NOTICES.


Applicant's Signature: <u>Wm. H. Barnett Jr.</u>	Print Name: <u>William H. Barnett Jr.</u>
Title/Company: <u>Owner</u>	Date: <u>107-2000</u>

Checks payable to: **DIRECTOR OF FINANCE OF HOWARD COUNTY**
** PLEASE WRITE NEATLY AND LEGIBLY **
FOR OFFICE USE ONLY


AGENCY	DATE	SIGNATURE APPROVAL	DPZ SETBACK INFORMATION	PROPERTY ID#
Land Development: DPZ			Front: <u>7.5' Min</u>	210422
State Highways			Rear: <u>1' Min (Access)</u>	Filing fee \$ <u>135</u>
Building Official			Side: <u>1' Min (Use Only)</u>	Permit fee \$ _____
Dev. Engineering: DPZ			Side St: <u>N/A</u>	Excise tax \$ _____
Health	<u>1/12/00</u>	<u>Brian Baker</u>	All minimum setbacks met? YES ☒ NO ☐	Sub-total paid \$ _____
Fire Protection			Is Entrance Permit required? YES ☐ NO ☐	Add'l permit fee \$ _____
Is Sediment Control approval required prior to issuance? YES ☐ NO ☐			Historic District? YES ☐ NO ☐	TOTAL FEES \$ _____
CONTINGENCY CONSTRUCTION START: ☐			Lot Coverage for New Town Zone _____	Balance due \$ _____
ONE STOP SHOP: ☐			SDP/Red-line approval date _____	Check <u>1349</u>
			Accepted by <u>[Signature]</u>	Validation # <u>210422</u>

Distribution of Copies: White: Building Official Green: LDD, DPZ Yellow: DED, DPZ Pink: Health Gold: SHA

Kudicke Property

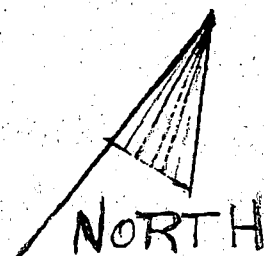

ELECTION
District

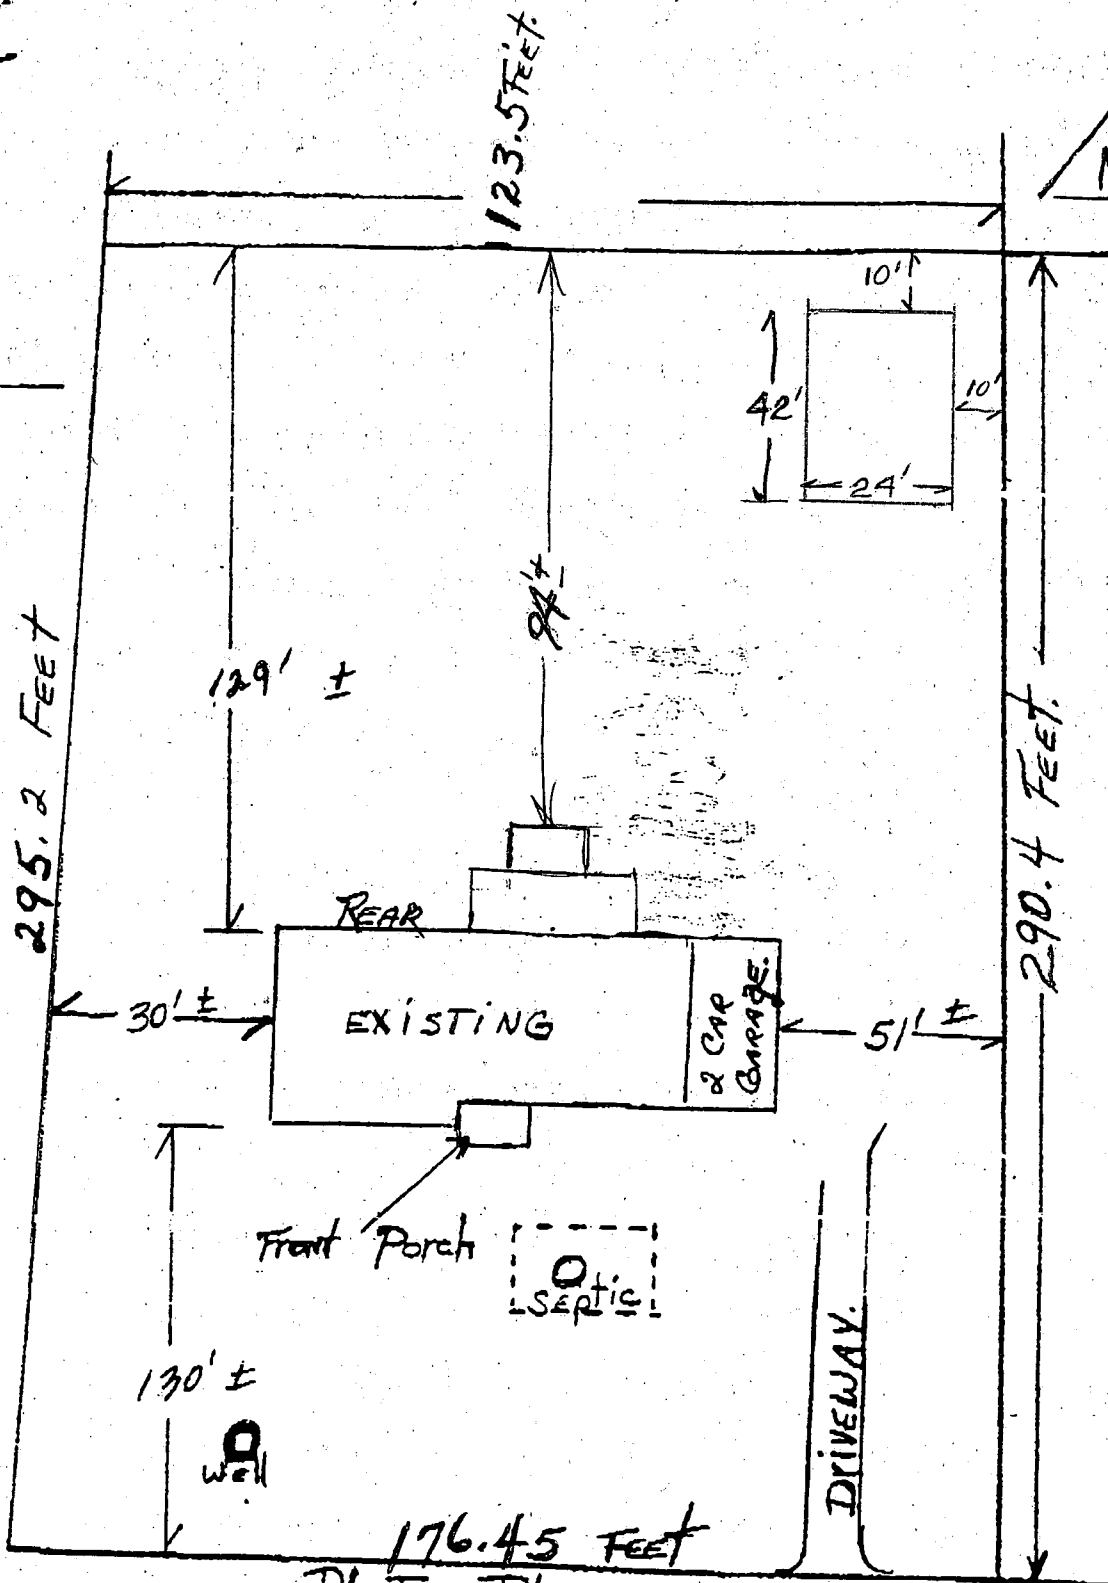

Ed FRANK
Property

Twigg
Property

12700

176.45 FEET
Plot Plan

TRIADELPHIA RD.

NOT TO SCALE

ONE ACRE more or less

BARNETT Property

T 22 BK 5 P 12