

6/3/86
ASAP

03-242630

Approved
6/3/86
RH P 37/85

PERMIT

SEWAGE DISPOSAL SYSTEM

MARYLAND STATE DEPARTMENT OF HEALTH

A REPAIR

HOWARD COUNTY
BUREAU OF ENVIRONMENTAL HEALTH
461-9933

ELLICOTT CITY

DISTRICT

DATE 6/16/86

INDEXED

Jack Fyock IS PERMITTED TO INSTALL ALTER X

ADDRESS PHONE 988-9270

SUBDIVISION ROAD 12225 Triadelphia Road LOT

PROPERTY OWNER Omer

ADDRESS 1225 Triadelphia Road between Engers Valley & Woodmark

IF GARBAGE GRINDER IS USED INCREASE SEPTIC TANK CAPACITY BY 50% AND ABSORPTION AREA BY 22%.

GARBAGE GRINDER? YES NO X

SEPTIC TANK CAPACITY GALLONS NUMBER OF BEDROOMS 3

REPAIR - CALL FOR INSPECTION WHEN GROUND IS OPENED UP SO SANITARIAN CAN RECOMMEND

REPAIR. TRENCH OFF OLD DW
2 FT WIDE 63 FT LONG 6 FT STONE
11 1/2 FT DEEP INLET 5 FT DEEP RIT
12 SQ FT PER BR

PLANS APPROVED BY C. Williams DATE 5/23/86

COVER NO WORK UNTIL INSPECTED AND APPROVED.

NEITHER THE HOWARD COUNTY COUNCIL NOR THE HEALTH DEPARTMENT IS RESPONSIBLE FOR THE SUCCESSFUL OPERATION OF ANY SYSTEM.

NOTE: IF TRENCH IS USED CALL FOR INSPECTION BEFORE AND AFTER PLACING GRAVEL IN TRENCH.

NOTE: NO DRY WELL SHALL EXCEED 15 FOOT IN DIAMETER. NO ABSORPTION TRENCH TO EXCEED 100 FEET IN LENGTH.

NOTE: ALL PIPE FROM HOUSE TO SEPTIC TANK MUST BE CAST IRON OR SCHEDULE 40 PVC OR ABS.

PERMIT VOID AFTER THREE YEARS.

NOTE: INSTALL STAND PIPE ON SEPTIC TANK AND DRY WELL. STAND PIPES MUST BE 6 INCHES IN DIAMETER. CAST IRON, CONCRETE OR TERRA COTTA, OR PVC OR ABS ACCEPTED. IF TOP OF SEPTIC TANK IS DEEPER THAN 3 FEET MANHOLE TO GRADE REQUIRED.


*INSTALLER IS RESPONSIBLE FOR OBTAINING FINAL APROVAL ON THIS PERMIT

*CALL 992-2330 FOR INSPECTION OF SEPTIC SYSTEMS.

EH - 2-1082

P 37/85
A Repair

①
RED BROWN CLAY
3-
LIGHT BROWN SAND LOAM
11.5

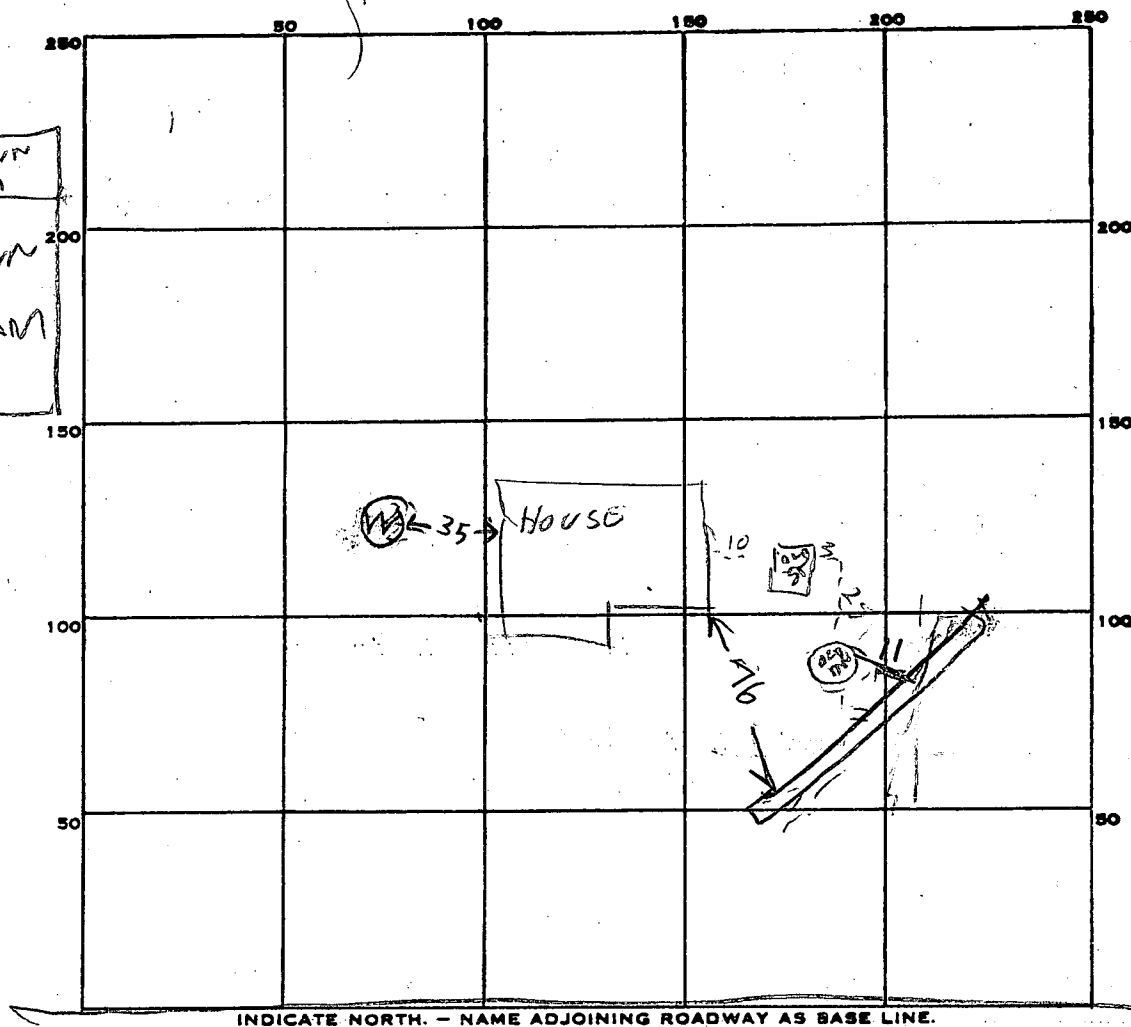

PERMIT CARD _____

SEPTIC TANK, LEVEL _____

CLEANOUTS _____

DISTRIBUTION BOX, LEVEL _____

TILE FIELD, DEPTH 1 1/2 FT. TRENCH WIDTH 2 FT.

GRAVEL DEPTH 7 FT IN. TOTAL LENGTH 50 73 FT.

NUMBER OF TRENCHES 1 TOTAL BOTTOM AREA 511

SEEPAGE PITS, INSIDE DIAMETER _____ FT. DEPTH BELOW INLET _____ FT.

ABSORBENT AREA _____ SQ. FT.

REMARKS 5/3/86^{am} OLD DW WORK FOR 14 YEARS SKIP
SAID HE DUG 15 FT VISUAL HOLE & IT WAS OK
INLET MUST BE EXTRA DEEP TO PICK UP FILL
FROM DW. PART OF TRENCH DUG & SOME STONE ADDED
6/3/86^{pm} TRENCH FINISHED

DATE SYSTEM APPROVED 6/3/86 INSPECTOR Raymond Hodge