

9/2/86

03-286908

9-3-86
approved
S. Abel

PERMIT

P 37643

A REPAIR

SEWAGE DISPOSAL SYSTEM

MARYLAND STATE DEPARTMENT OF HEALTH

HOWARD COUNTY
BUREAU OF ENVIRONMENTAL HEALTH
~~992-2330X~~
461-9933

ELLICOTT CITY
DISTRICT _____
DATE 9/15/86

INDEXED

Olen Ketterman IS PERMITTED TO INSTALL _____ ALTER X

ADDRESS _____ PHONE 442-1336

SUBDIVISION _____ ROAD 13554 Triadelphia Road LOT _____

PROPERTY OWNER Rusty & Pat Sellers - 622-3500

ADDRESS 13554 Triadelphia Road
Ellicott City, Maryland 21043 Lot 224 or 225

IF GARBAGE GRINDER IS USED INCREASE SEPTIC TANK CAPACITY BY 50% AND ABSORPTION AREA BY 22%.

GARBAGE GRINDER? YES _____ NO _____

SEPTIC TANK CAPACITY _____ GALLONS NUMBER OF BEDROOMS _____

REPAIR - CALL FOR INSPECTION WHEN GROUND IS OPENED UP SO SANITARIAN CAN RECOMMEND REPAIR.

RECOMMENDED REPAIR: REPLACE ALL CAST IRON PIPE FROM LIVING QUARTERS TO EXISTING LINE OUT OF CHURCH WHICH IS NEW; SET NEW 1500 GALLON SEPTIC TANK; RUN 100 FEET OF TRENCH INLET 4' BOTTOM 11' 7' STONE. Building 3BR SIZED FOR 4BR+; COMPASSE AND FILL EXISTING METAL SEPTIC TANK + DRYWELL; WELL CAN BE SALVAGE BY NEW PIPE TO GRADE SET NEW SUBMERSIBLE PUMP AND SEAL AROUND WELL CASING.

PLANS APPROVED BY C. Williams DATE 9/02/86

COVER NO WORK UNTIL INSPECTED AND APPROVED.

NEITHER THE HOWARD COUNTY COUNCIL NOR THE HEALTH DEPARTMENT IS RESPONSIBLE FOR THE SUCCESSFUL OPERATION OF ANY SYSTEM.

NOTE: IF TRENCH IS USED CALL FOR INSPECTION BEFORE AND AFTER PLACING GRAVEL IN TRENCH.

NOTE: NO DRY WELL SHALL EXCEED 15 FOOT IN DIAMETER. NO ABSORPTION TRENCH TO EXCEED 100 FEET IN LENGTH.

NOTE: ALL PIPE FROM HOUSE TO SEPTIC TANK MUST BE CAST IRON OR SCHEDULE 40 PVC OR ABS.

PERMIT VOID AFTER THREE YEARS.


NOTE: INSTALL STAND PIPE ON SEPTIC TANK AND DRY WELL. STAND PIPES MUST BE 6 INCHES IN DIAMETER. CAST IRON, CONCRETE OR TERRA COTTA, OR PVC OR ABS ACCEPTED. IF TOP OF SEPTIC TANK IS DEEPER THAN 3 FEET MANHOLE TO GRADE REQUIRED.

***INSTALLER IS RESPONSIBLE FOR OBTAINING FINAL APPROVAL ON THIS PERMIT**

*CALL 992-2330 FOR INSPECTION OF SEPTIC SYSTEMS.

EH - 2-1082

37643
A REPAIR

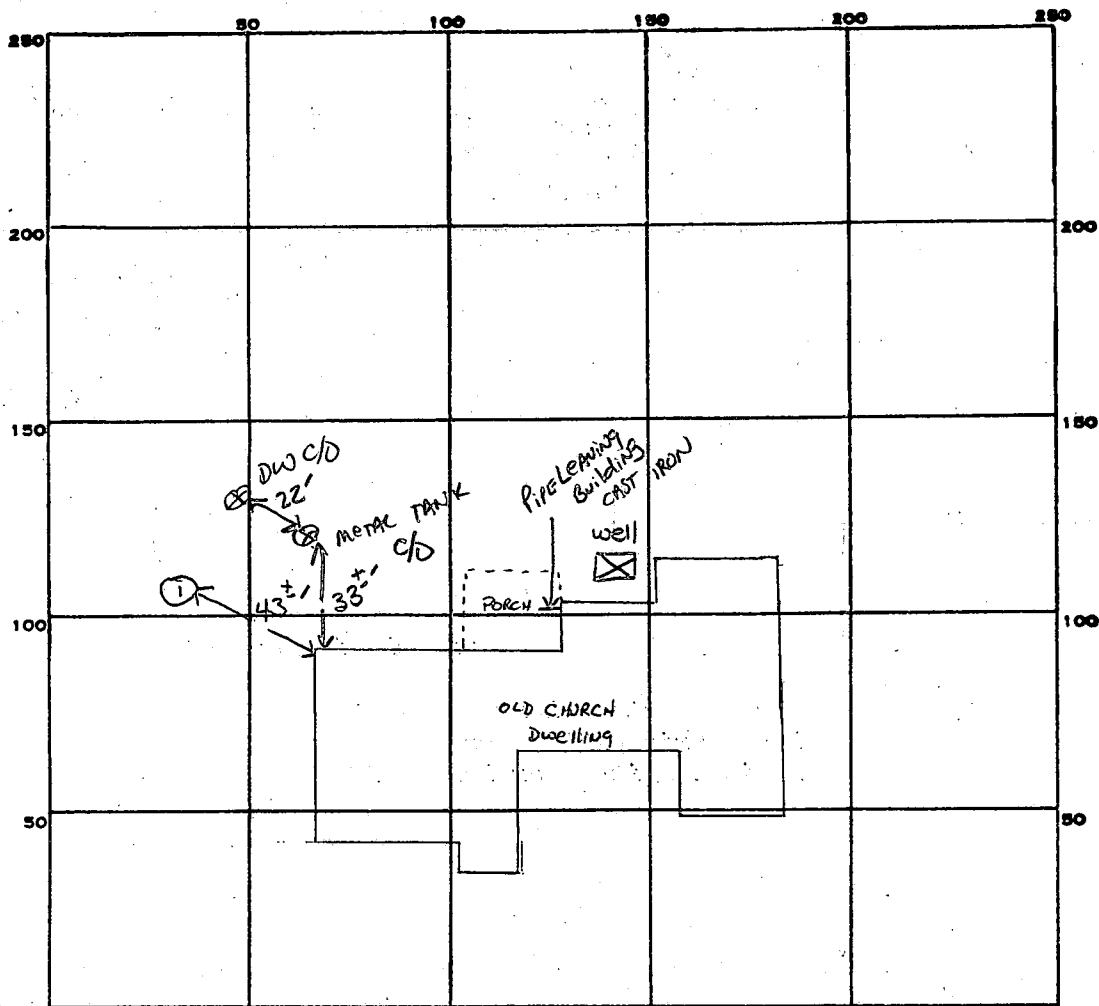

①
 4'-
 15'-
 #1-3
 YELLOW RED
 SILT LOAM
 12% CLAY
 <10% FRAGS
 YELLOW BR
 SILTY SAND
 LOAM
 20-25%
 COARSE
 FRAGMENTS

PERMIT CARD _____

SEPTIC TANK, LEVEL _____ CLEANOUTS _____

DISTRIBUTION BOX, LEVEL _____

TILE FIELD, DEPTH _____ FT. TRENCH WIDTH _____ FT.

GRAVEL DEPTH _____ IN. TOTAL LENGTH _____ FT.

NUMBER OF TRENCHES _____ TOTAL BOTTOM AREA _____

SEEPAGE PITS, INSIDE DIAMETER _____ FT. DEPTH BELOW INLET _____ FT.

ABSORBENT AREA _____ SQ. FT.

REMARKS _____

DATE SYSTEM APPROVED 9/3/86 INSPECTOR SID ABEL

9-3-86
approved
S. Abel

P 37643
A REPAIR

PERMIT

SEWAGE DISPOSAL SYSTEM

MARYLAND STATE DEPARTMENT OF HEALTH

HOWARD COUNTY
BUREAU OF ENVIRONMENTAL HEALTH
~~X992X2330X~~
461-9933

ELLICOTT CITY
DISTRICT _____
DATE 9/15/86

Olen Ketterman IS PERMITTED TO INSTALL _____ ALTER

ADDRESS _____ PHONE 442-1336

SUBDIVISION _____ ROAD 13554 Triadelphia Road LOT _____

PROPERTY OWNER Rusty & Pat Sellers

ADDRESS 13554 Triadelphia Road
Ellicott City, Maryland 21043

IF GARBAGE GRINDER IS USED INCREASE SEPTIC TANK CAPACITY BY 50% AND ABSORPTION AREA BY 22%.

GARBAGE GRINDER? YES _____ NO _____

SEPTIC TANK CAPACITY _____ GALLONS NUMBER OF BEDROOMS _____

REPAIR - CALL FOR INSPECTION WHEN GROUND IS OPENED UP SO SANITARIAN CAN RECOMMEND REPAIR.

PLANS APPROVED BY C. Williams DATE 9/02/86

COVER NO WORK UNTIL INSPECTED AND APPROVED.

NEITHER THE HOWARD COUNTY COUNCIL NOR THE HEALTH DEPARTMENT IS RESPONSIBLE FOR THE SUCCESSFUL OPERATION OF ANY SYSTEM.

NOTE: IF TRENCH IS USED CALL FOR INSPECTION BEFORE AND AFTER PLACING GRAVEL IN TRENCH.

NOTE: NO DRY WELL SHALL EXCEED 15 FOOT IN DIAMETER. NO ABSORPTION TRENCH TO EXCEED 100 FEET IN LENGTH.


NOTE: ALL PIPE FROM HOUSE TO SEPTIC TANK MUST BE CAST IRON OR SCHEDULE 40 PVC OR ABS.

PERMIT VOID AFTER THREE YEARS.

NOTE: INSTALL STAND PIPE ON SEPTIC TANK AND DRY WELL. STAND PIPES MUST BE 6 INCHES IN DIAMETER. CAST IRON, CONCRETE OR TERRA COTTA, OR PVC OR ABS ACCEPTED. IF TOP OF SEPTIC TANK IS DEEPER THAN 3 FEET MANHOLE TO GRADE REQUIRED.

***INSTALLER IS RESPONSIBLE FOR OBTAINING FINAL APPROVAL ON THIS PERMIT**

*CALL 992-2330 FOR INSPECTION OF SEPTIC SYSTEMS.

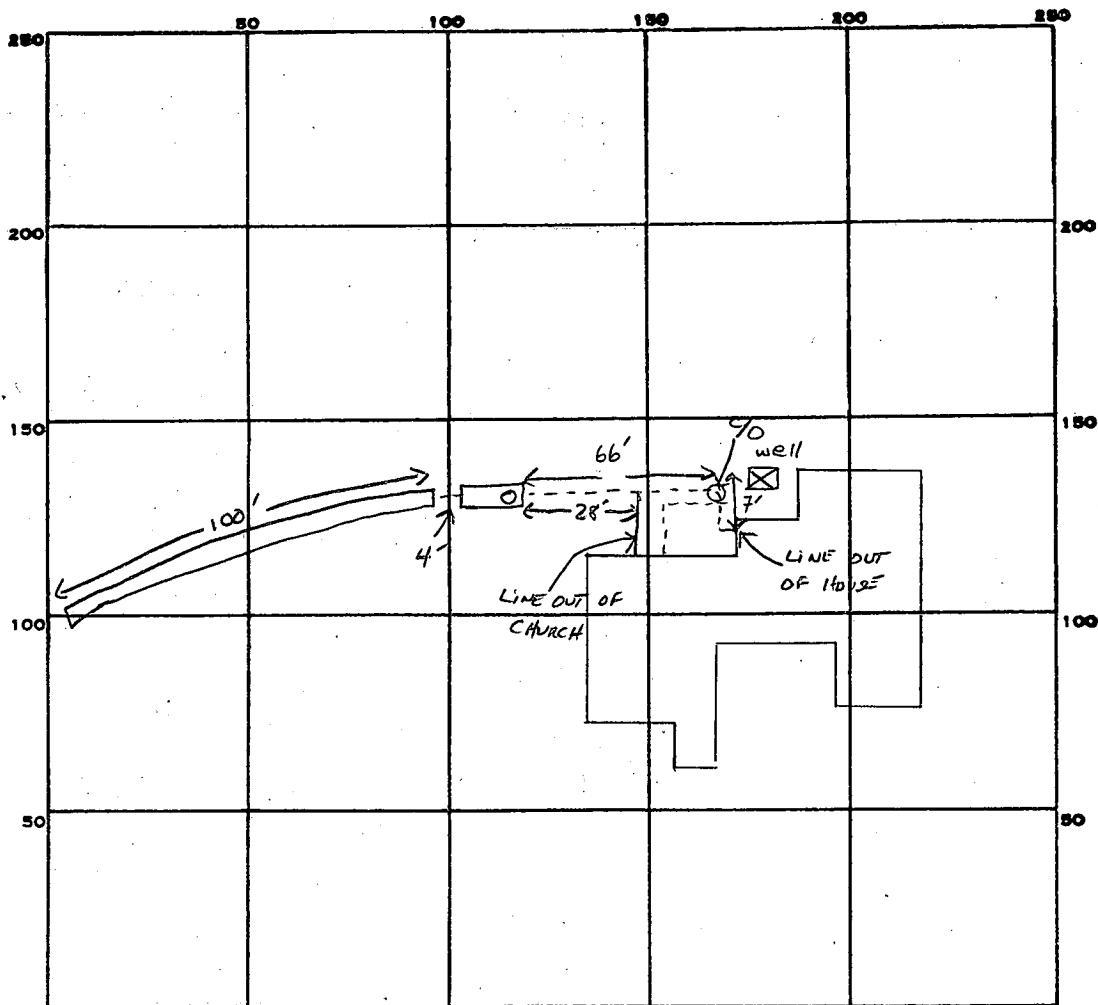

INDICATE NORTH. - NAME ADJOINING ROADWAY AS BASE LINE.

PERMIT CARD ✓

SEPTIC TANK, LEVEL ✓ 1500 GAL

CLEANOUTS ST & INLINE

DISTRIBUTION BOX, LEVEL N/A

TILE FIELD, DEPTH 11 FT. TRENCH WIDTH 2 FT. INLET 4

GRAVEL DEPTH 7 FT IN. TOTAL LENGTH 100 FT.

NUMBER OF TRENCHES 1 ONE SIDE WALL TOTAL BOTTOM AREA 700 sq

SEEPAGE PITS, INSIDE DIAMETER — FT. DEPTH BELOW INLET — FT.

ABSORBENT AREA 700 SQ. FT.

REMARKS 9-3-86 OK TO ADD STONE. S. Abel

DATE SYSTEM APPROVED 9-3-86

INSPECTOR S. Abel

Department of Planning and Zoning
Howard County, Maryland
Recommendations/Comments

Date: 4/23/97

Planning Board 6/5/97 Board of Appeals 7/8/97 Zoning Board _____

Petition No. BA 97-23E Map No. 22 Block 14 Parcel 844 Lot _____

Return comments by 5/19/97 to Comprehensive Planning and Zoning Administration.

Location of Property: N side of Triadelphia Rd, adjacent to E side of bridge over MD 32.

Applicant: Ingrid Helber, t/a Westwood Antiques

Applicant's Address: 13554 Triadelphia Rd, Ellicott City, MD 21042

Owner: (if other than applicant) same as above

Owner's Address: _____

Petition: Special exception for an antique shop.

- TO:
- Department of Education
 - Bureau of Environmental Health
 - Development Engineering Division
 - Department of Inspections, Licenses and Permits
 - Department of Recreation and Parks
 - Department of Fire and Rescue Services
 - State Highway Administration
 - Mark Patemi, Howard County Police Department
 - James Irvin, Department of Public Works
 - MD Depart. of Human Resources, Fran Sterner (child day care)
 - Office on Aging, Debra Lewis (senior assisted living)
 - Police Department, Animal Control, Brenda Purvis (kennels)

COMMENTS: No Objection To Proposed Zoning Exception.

Approval of any applicable SDP or Building Permit would require demonstration of adequate well and septic capacity for the intended use.

Health Department property file reference: No. P37643

[Signature]
(Signature)