

9/9/86

Tax ID -05-365902

APPROVED
9/9/86
RH
P. 37752
A REPAIR

PERMIT

SEWAGE DISPOSAL SYSTEM

MARYLAND STATE DEPARTMENT OF HEALTH*

HOWARD COUNTY

ELLICOTT CITY

BUREAU OF ENVIRONMENTAL HEALTH

DISTRICT _____

X992X2330

461-9933

INDEXED

DATE 10/1/86

Jack Fuock

IS PERMITTED TO INSTALL _____ ALTER X

ADDRESS Fongst Hillis PHONE _____

SUBDIVISION _____ ROAD 5770 Trotter Road LOT 14

PROPERTY OWNER Schoenian
ADDRESS 5770 Trotter Road

IF GARBAGE GRINDER IS USED INCREASE SEPTIC TANK CAPACITY BY 50% AND ABSORPTION AREA BY 22%.

GARBAGE GRINDER? YES _____ NO X

SEPTIC TANK CAPACITY 1000 GALLONS NUMBER OF BEDROOMS 3

125
3
375

62
6
372

REPAIR - CALL FOR INSPECTION WHEN GROUND IS OPENED UP SO SANITARIAN CAN RECOMMEND REPAIR.

9/9/86 TRENCH OFF OLD DRY WELL
IN FRONT YARD 375 SQ FT SIDE
WALL AREA ONE SIDE 9 FT DEEP 2 FT
WIDE INLET 3 FT DEEP 6 FT STONE R/O

PLANS APPROVED BY R. Hodges DATE 9/09/86

COVER NO WORK UNTIL INSPECTED AND APPROVED.

NEITHER THE HOWARD COUNTY COUNCIL NOR THE HEALTH DEPARTMENT IS RESPONSIBLE FOR THE SUCCESSFUL OPERATION OF ANY SYSTEM.

NOTE: IF TRENCH IS USED CALL FOR INSPECTION BEFORE AND AFTER PLACING GRAVEL IN TRENCH.

NOTE: NO DRY WELL SHALL EXCEED 15 FOOT IN DIAMETER. NO ABSORPTION TRENCH TO EXCEED 100 FEET IN LENGTH.

NOTE: ALL PIPE FROM HOUSE TO SEPTIC TANK MUST BE CAST IRON OR SCHEDULE 40 PVC OR ABS.

PERMIT VOID AFTER THREE YEARS.

NOTE: INSTALL STAND PIPE ON SEPTIC TANK AND DRY WELL. STAND PIPES MUST BE 6 INCHES IN DIAMETER. CAST IRON, CONCRETE OR TERRA COTTA, OR PVC OR ABS ACCEPTED. IF TOP OF SEPTIC TANK IS DEEPER THAN 3 FEET MANHOLE TO GRADE REQUIRED.


*INSTALLER IS RESPONSIBLE FOR OBTAINING FINAL APROVAL ON THIS PERMIT

*CALL 992-2330 FOR INSPECTION OF SEPTIC SYSTEMS.

EH - 2-1082

37752
A REPAIR

①
BROWN CLAY
BROWN SAND LOAM

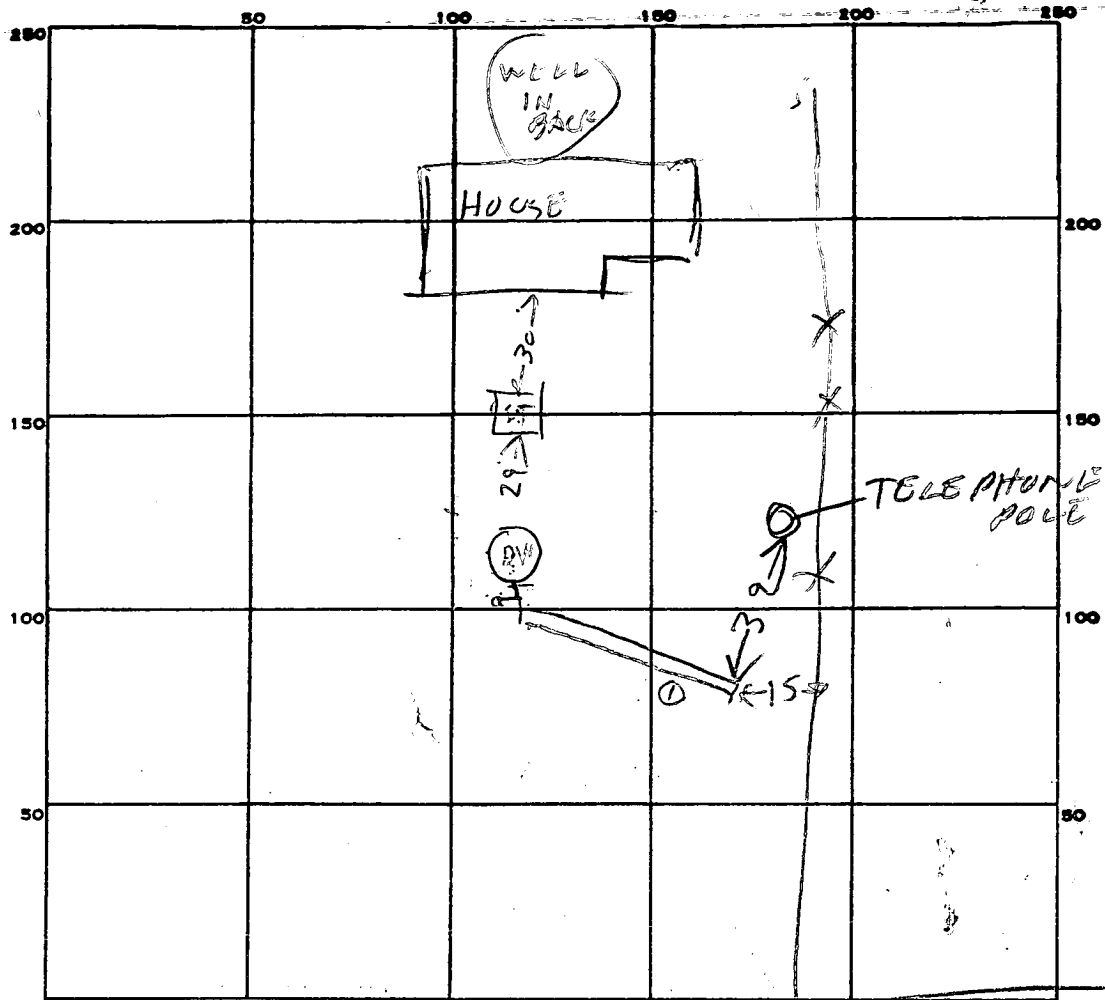

INDICATE NORTH. - NAME ADJOINING ROADWAY AS BASE LINE.

TROTTER RD

PERMIT CARD _____

SEPTIC TANK, LEVEL _____

CLEANOUTS _____

DISTRIBUTION BOX, LEVEL _____

TILE FIELD, DEPTH 9 FT. TRENCH WIDTH 2 FT.

GRAVEL DEPTH 6 FT 7 IN. TOTAL LENGTH 62 FT.

NUMBER OF TRENCHES 1 TOTAL BOTTOM AREA _____

SEEPAGE PITS, INSIDE DIAMETER _____ FT. DEPTH BELOW INLET _____ FT.

ABSORBENT AREA _____ SQ. FT.

REMARKS 9/9/86 SOIL OK OLD SYSTEM 14 FT DEEP & IN USE SINCE
1958 FRENCH OK STONE ADDED AT THIS
TIME BIT

DATE SYSTEM APPROVED 9/9/86

INSPECTOR Raymond Hodges

TO: FILE

5770 Trotter Rd

Advised Ken Hatfield

OK: S.T. OK to maintain
if concrete + intact

add 1 trench identical
to existing

for IBR addition