

Tax ID-

10/1/86  
Repair Order  
(P)

10-1-86  
BAP

# PERMIT

P 57758  
A REPAIR

SEWAGE DISPOSAL SYSTEM

MARYLAND STATE DEPARTMENT OF HEALTH

HOWARD COUNTY  
BUREAU OF ENVIRONMENTAL HEALTH  
~~992-2330~~

ELLICOTT CITY  
DISTRICT \_\_\_\_\_  
DATE 10/3/86

INDEXED

Jack Fyock IS PERMITTED TO INSTALL \_\_\_\_\_ ALTER X

ADDRESS \_\_\_\_\_ PHONE 988-9270

SUBDIVISION \_\_\_\_\_ ROAD 6491 Haviland Mill Rd LOT \_\_\_\_\_

PROPERTY OWNER Wotring  
6491 Haviland Mill Road

ADDRESS \_\_\_\_\_

IF GARBAGE GRINDER IS USED INCREASE SEPTIC TANK CAPACITY BY 50% AND ABSORPTION AREA BY 22%.

GARBAGE GRINDER? YES \_\_\_\_\_ NO \_\_\_\_\_

SEPTIC TANK CAPACITY 1000 GALLONS NUMBER OF BEDROOMS 3

REPAIR: CALL FOR INSPECTION WHEN GROUND IS OPENED UP SO SANITARIAN CAN RECOMMEND REPAIR.

10/1/86 See over for soil info.

PLANS APPROVED BY C. Williams DATE 9/19/86

COVER NO WORK UNTIL INSPECTED AND APPROVED.

NEITHER THE HOWARD COUNTY COUNCIL NOR THE HEALTH DEPARTMENT IS RESPONSIBLE FOR THE SUCCESSFUL OPERATION OF ANY SYSTEM.

NOTE: IF TRENCH IS USED CALL FOR INSPECTION BEFORE AND AFTER PLACING GRAVEL IN TRENCH.

NOTE: NO DRY WELL SHALL EXCEED 15 FOOT IN DIAMETER. NO ABSORPTION TRENCH TO EXCEED 100 FEET IN LENGTH.

NOTE: ALL PIPE FROM HOUSE TO SEPTIC TANK MUST BE CAST IRON OR SCHEDULE 40 PVC OR ABS.

PERMIT VOID AFTER THREE YEARS.


NOTE: INSTALL STAND PIPE ON SEPTIC TANK AND DRY WELL. STAND PIPES MUST BE 6 INCHES IN DIAMETER. CAST IRON, CONCRETE OR TERRA COTTA, OR PVC OR ABS ACCEPTED. IF TOP OF SEPTIC TANK IS DEEPER THAN 3 FEET MANHOLE TO GRADE REQUIRED.

**\*INSTALLER IS RESPONSIBLE FOR OBTAINING FINAL APPROVAL ON THIS PERMIT**

\*CALL 992-2330 FOR INSPECTION OF SEPTIC SYSTEMS.

EH - 2-1082

37758  
A  
Repair

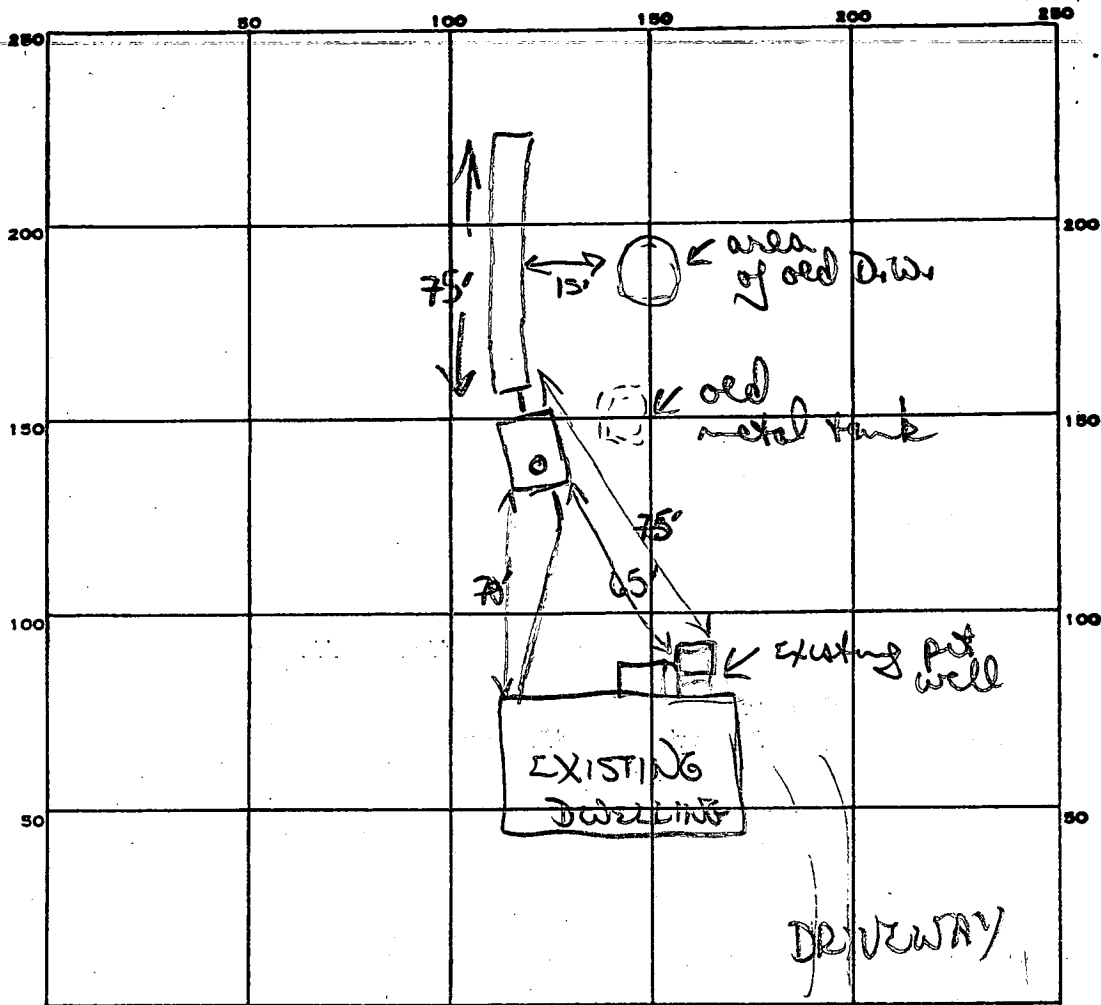

INDICATE NORTH - NAME ADJOINING ROADWAY AS BASE LINE.

✓ final HAVILAND MILL RD

PERMIT CARD \_\_\_\_\_

SEPTIC TANK, LEVEL 1000 gal (new) CLEANOUTS 1 S.T.

DISTRIBUTION BOX, LEVEL \_\_\_\_\_

TILE FIELD, DEPTH = 3 1/2 - 10 1/2 FT. TRENCH WIDTH 2 FT.

GRAVEL DEPTH 7' TOTAL LENGTH 75 FT.

NUMBER OF TRENCHES 1 TOTAL BOTTOM AREA 525

SEEPAGE PITS, INSIDE DIAMETER \_\_\_\_\_ FT. DEPTH BELOW INLET \_\_\_\_\_ FT.

ABSORBENT AREA 525 SQ. FT.

REMARKS 10/11/86 OLD metal tank collapsed in, D.W. also collapsed in  
soils (mix of orange/pink silty clay loam 3"; below silty  
loam w/ patches of small fine saprolite.  
OK to go = 3 1/2 - 10 1/2', OK to finish adding stone pipe  
paper to trench, OK cover trench with work

125  
3  
375 sq ft

75  
7  
525

DATE SYSTEM APPROVED 10/11/86 INSPECTOR B Nyfon