

6/4/86
17A

6-4-86
Approved
S. Abel

PERMIT

P 37055
A 36440

SEWAGE DISPOSAL SYSTEM

MARYLAND STATE DEPARTMENT OF HEALTH

HOWARD COUNTY
BUREAU OF ENVIRONMENTAL HEALTH
~~XXXXXXXXXX~~
461-9933

05-352916
INDEXED

ELLICOTT CITY
DISTRICT 5th
DATE 5/24/86

WES MAR CORP

IS PERMITTED TO INSTALL X ALTER

ADDRESS 13990 TRIAD. MILL RD PHONE 531-2166

SUBDIVISION Russell Coleman Property ROAD 14570 Triadelphia Rd LOT 17

PROPERTY OWNER Robert Long

ADDRESS _____

IF GARBAGE GRINDER IS USED INCREASE SEPTIC TANK CAPACITY BY 50% AND ABSORPTION AREA BY 22%.

GARBAGE GRINDER? YES _____ NO ✓

BLDG. PERMIT SIGNED
AND RETURNED 5-20-86
Serial # B10117731
N.W.M.

SEPTIC TANK CAPACITY 1250 GALLONS NUMBER OF BEDROOMS 4

TRENCHES - 168 sq. ft. per bedroom. Trench to be 2 feet wide. Inlet 3½ feet below original grade. Bottom maximum depth 8½ feet below original grade. Effective area begins at 3½ feet below original grade. 5 feet of stone below distribution pipe.

LOCATION - Place distribution box 270 feet from the front and 65 feet from left (881.22) lot line as seen when facing property from Triadelphia Mill Road. Run trenches along contour towards the left (881.22') lot line.

NOTE - No trench to exceed 100 feet in length. If more than one trench used, a distribution box is required. Call for inspection of trench before and after gravel is installed. Provide 6" - 8" diameter cleanout and cap to grade or above on septic tank.

BLDG. PERMIT SIGNED
AND RETURNED 11-19-01
600133200
INSTALL 1500 GAL UB
RODAVE TANK

BLDG. PERMIT SIGNED
AND RETURNED 2/14/86
Serial # 71743
1/23/86 / Bedroom
new
Bath
family
rm

PLANS APPROVED BY B. Nixon

COVER NO WORK UNTIL INSPECTED AND APPROVED.

NEITHER THE HOWARD COUNTY COUNCIL NOR THE HEALTH DEPARTMENT IS RESPONSIBLE FOR THE SUCCESSFUL OPERATION OF ANY SYSTEM.

NOTE: IF TRENCH IS USED CALL FOR INSPECTION BEFORE AND AFTER PLACING GRAVEL IN TRENCH.

NOTE: NO DRY WELL SHALL EXCEED 15 FOOT IN DIAMETER. NO ABSORPTION TRENCH TO EXCEED 100 FEET IN LENGTH.

NOTE: ALL PIPE FROM HOUSE TO SEPTIC TANK MUST BE CAST IRON OR SCHEDULE 40 PVC OR ABS.

PERMIT VOID AFTER THREE YEARS.


NOTE: INSTALL STAND PIPE ON SEPTIC TANK AND DRY WELL. STAND PIPES MUST BE 6 INCHES IN DIAMETER. CAST IRON, CONCRETE OR TERRA COTTA, OR PVC OR ABS ACCEPTED. IF TOP OF SEPTIC TANK IS DEEPER THAN 3 FEET MANHOLE TO GRADE REQUIRED.

BLDG. PERMIT SIGNED
AND RETURNED 5-20-86
Serial # B10117731

*INSTALLER IS RESPONSIBLE FOR OBTAINING FINAL APPROVAL ON THIS PERMIT

*CALL 992-2330 FOR INSPECTION OF SEPTIC SYSTEMS.

A 36440

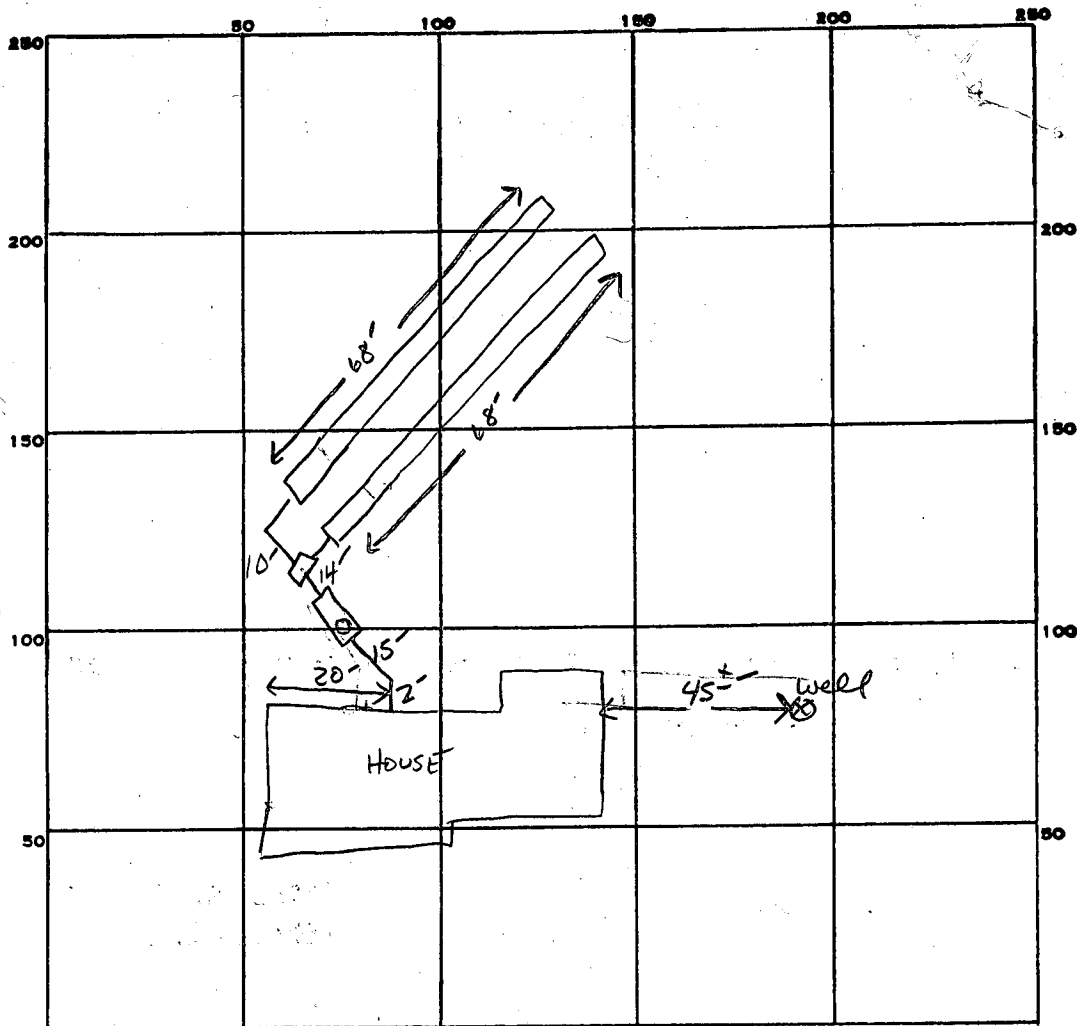

INDICATE NORTH. - NAME ADJOINING ROADWAY AS BASE LINE.

TRIADELPHIA Mill Rd.

PERMIT CARD ☒

SEPTIC TANK, LEVEL ☒ 1500 GAI

CLEANOUTS ☒ 5T

DISTRIBUTION BOX, LEVEL ☒

TILE FIELD, DEPTH 8.5 FT. TRENCH WIDTH 2 FT. INLET 35

GRAVEL DEPTH 5 ft TOTAL LENGTH 68 ^① 68 ^② FT.

NUMBER OF TRENCHES 2 ^{ONE SIDE WALL} TOTAL BOTTOM AREA 680 ^φ

SEEPAGE PITS, INSIDE DIAMETER FT. DEPTH BELOW INLET FT.

ABSORBENT AREA 680 SQ. FT.

REMARKS 6-4-86 OK TO ADD STONE TO TRENCHES. S. Abel

DATE SYSTEM APPROVED 6-4-86

INSPECTOR S. Abel

APPLICATION

SEWAGE DISPOSAL TESTING

17576

A _____

P _____

MARYLAND STATE DEPARTMENT OF HEALTH

HOWARD COUNTY Septic Tank - 400 sq. ft.

ELLICOTT CITY

DISTRICT 5th

DATE 10-24-72

Dry well - 432 sq. ft. absorbent area to be
below the inlet. Max. depth permitted
for dry well is 11 ft. below original grade.
Max. depth for inlet is 3 ft. Locate dry well
192 ft. from front lot line and 3 ft. from right
side line as seen from Tradelphia Rd.

TO: THE COUNTY HEALTH OFFICER
ELLICOTT CITY, MARYLAND

I, HEREBY, APPLY FOR THE NECESSARY TESTS IN ORDER TO CONSTRUCT (OR RECONSTRUCT) A SEWAGE DISPOSAL SYSTEM.

Robert & Leslie Long

PROPERTY OWNER Russell Coleman Go M. Best

ADDRESS 10412 Montrose Avenue PHONE 493-5790
Bethesda, Maryland 20014

PROPERTY LOCATION:

SUBDIVISION _____ LOT NO. 17

14570
ROAD AND DESCRIPTION Tradelphia Mill Road, Dayton, Md. 21036

OCCUPANT Undeveloped land PHONE _____

PERSON TO CONSTRUCT SYSTEM To be determined

ADDRESS _____ PHONE _____

SIZE OF LOT 5 acres (#17) TYPE BLDG. Four (4)
NUMBER OF BEDROOMS _____

IF NOT SINGLE RESIDENCE DESCRIBE _____

SIGNATURE OF APPLICANT Russell Coleman

✓ APPROVED BY Robert V. Tom By Mary Hossie Biente
FOR Dry Well DATE 6/1/73
(KIND OF SYSTEM)

REJECTED BY _____ FOR _____ DATE _____
(KIND OF SYSTEM)


HOLD PENDING FURTHER TESTS _____ DATE B.P. # 70021 exp 5/8/86

REASONS FOR REJECTION OR HOLDING _____

RETEST

GREEN BR - RT ON TR MILL & RIGHT TOP OF HILL -

THIS IS NOT A PERMIT

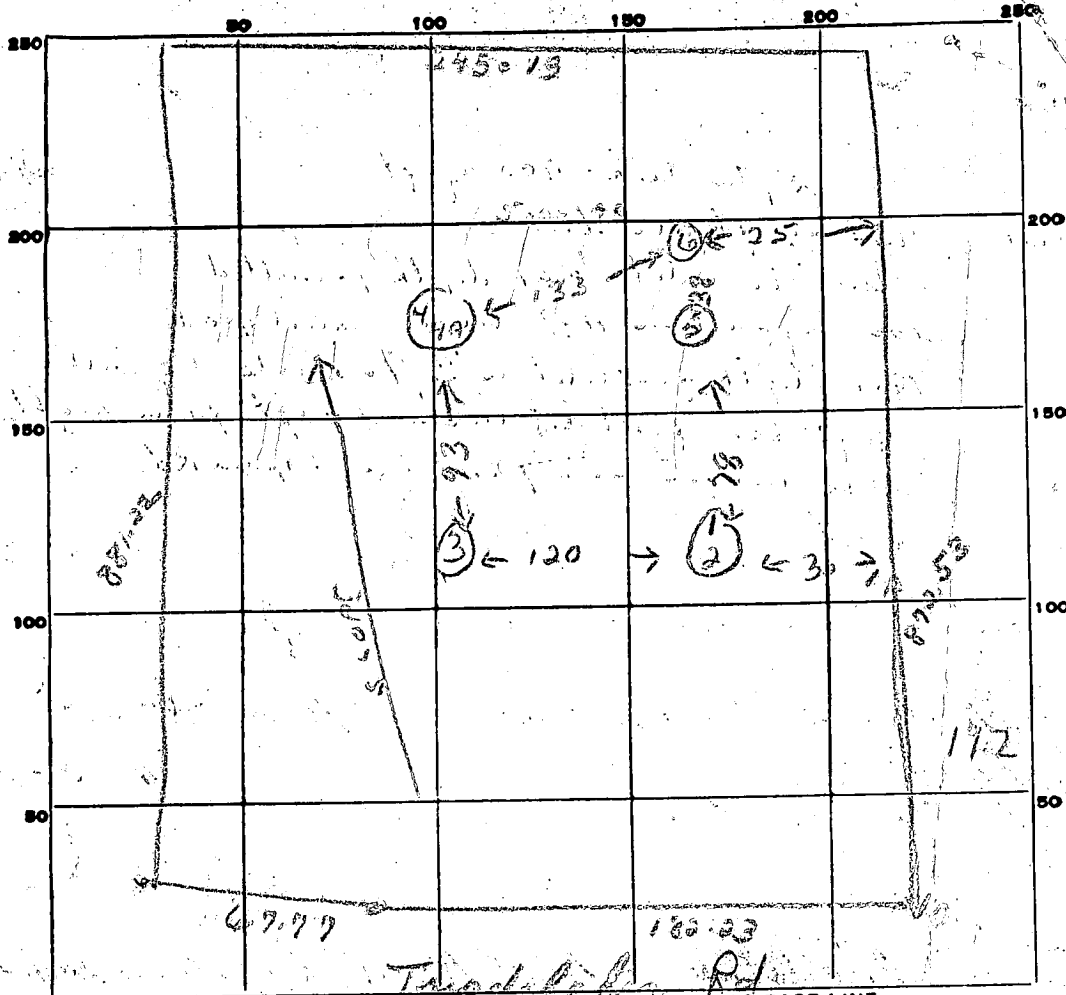

DATE	TEST NO.	DEPTH	PRE-WET		TEST - 1" DROP		TIME
			START	STOP	START	STOP	
11/9/73	1	11 ft	11:23	11:30	11:36	11:44	6 min
	2	3 ft	11:23	11:25	11:28	11:38	3 min
	3	10 ft	Same	End			
	4	3 ft	11:43			11:48	5 min
	4A	11 ft	11:47		12:00	12:21	21 min
	5 ft	9 ft					
	6 ft	9 ft					

SOIL AUGER FINDING

TESTED BY R. Turner

REMARKS

RECEIVED
1/14/86
1:30 PM

APPLICATION

RA 1/14/86 hold for plan for owner

SEWAGE DISPOSAL TESTING

STATE OF MARYLAND - DEPARTMENT OF HEALTH AND MENTAL HYGIENE

HOWARD COUNTY HEALTH DEPARTMENT
ENVIRONMENTAL HEALTH SERVICES

P. O. BOX 476 ELLICOTT CITY, MARYLAND 21043
TELEPHONE: 992-2330

DISTRICT _____

DATE 1/14/86
1/20/86

TO: THE COUNTY HEALTH OFFICER
ELLICOTT CITY, MARYLAND

I, HEREBY, APPLY FOR THE NECESSARY TEST IN ORDER TO CONSTRUCT (OR RECONSTRUCT) A SEWAGE DISPOSAL SYSTEM.

PROPERTY OWNER Russell Coleman

ADDRESS _____ PHONE _____

PROPERTY LOCATION:

SUBDIVISION COLEMAN-LEACH

LOT NO. 17

ROAD AND DESCRIPTION Triadelphia Mill Road

SIZE OF LOT 5 Acres TYPE BLDG. 3 or 4 Bedrooms
(NUMBER OF BEDROOMS)

THE SYSTEM INSTALLED UNDER THIS APPLICATION IS ACCEPTABLE ONLY UNTIL PUBLIC FACILITIES BECOME AVAILABLE. I FULLY UNDERSTAND THE FEE CONNECTED WITH THE FILING OF THIS PERC TEST APPLICATION IS NON-REFUNDABLE UNDER ANY CIRCUMSTANCES. I ALSO AGREE TO COMPLY WITH ALL M.O.S.H.A. REQUIREMENTS IN TESTING THIS LOT. /s/ Jack Fyock

(SIGNATURE OF APPLICANT)

APPROVED BY _____ FOR _____ DATE _____

REJECTED BY _____ FOR _____ DATE _____

HOLD PENDING FURTHER TESTS _____ DATE _____

REASONS FOR REJECTION OR HOLDING _____

THIS IS NOT A PERMIT


SOIL PROFILE

0' Red/brown clay loam

4 1/2' med coarse grain sandy clay loam

10' 10% silt weathered material

13'

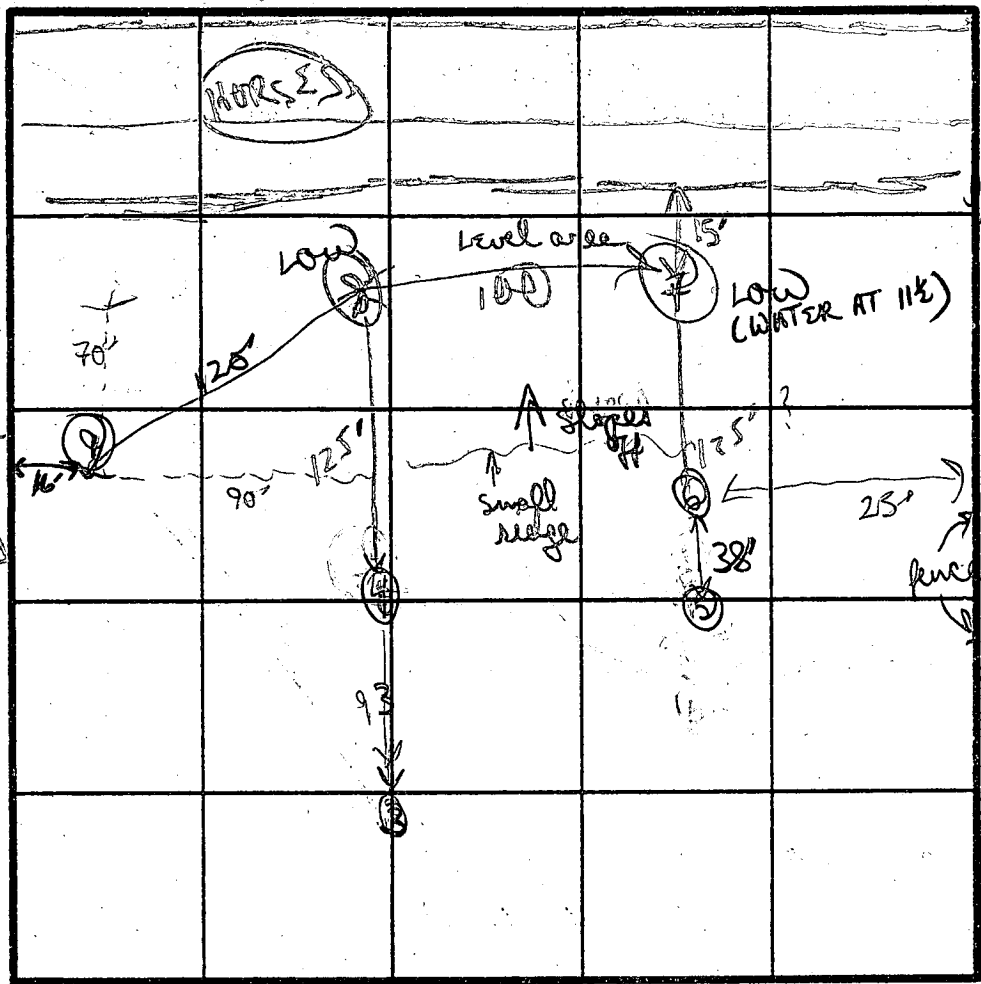

Back PROTECT FENCE

fence

7' Red/brown sandy clay loam

3 1/2' fine coarse grain sandy loam soil with 10% structure silt/clay to bottom

13'

traces of H₂O 11 1/2' + lower

INDICATE NORTH - NAME ADJOINING ROADWAY AS BASE LINE

~~TRIMBLE RD~~ RD

Retest

DATE	TEST NO.	DEPTH	PRE-WET		TEST - 1" DROP		TIME
			START	STOP	START	STOP	
1/14/86	8	5 ft	1129	1133	1133	1139	4 min
		13 ft	bottom (see profile)				
	7	3 ft	1136	1139	1139	1146	7 min
		13 ft	bottom				
			water at 11 1/2 ft				
	9	visual					
		12 1/2'	profile similar to #8				

1 new low hole (#7) had H₂O as did holes 6+5 (all in same line)

REMARKS All other holes tested out OK so suggest switching pore fields

TYPE OF SOIL top 3 1/2 - 4 1/2 clay, below mostly sandy loams w/ 10% weathered material

TESTED BY B. Nixon

ALSO PRESENT skip, Jay

APPLICATION

SEWAGE DISPOSAL TESTING

A 17576

P

MARYLAND STATE DEPARTMENT OF HEALTH

HOWARD COUNTY *Septic Tank - 400 sq ft*

ELLICOTT CITY

DISTRICT *5th*

DATE *10-24-72*

*dry well - 432 sq ft independent from the septic tank
below the inlet. Max. depth permitted
for dry well is 11 ft below original grade.
Max. depth for inlet is 3 ft to bottom dry well
10 ft from front lot line and 30 ft from right
side line as seen from Triadelphia Rd*

TO: THE COUNTY HEALTH OFFICER
ELLICOTT CITY, MARYLAND

I, HEREBY, APPLY FOR THE NECESSARY TESTS IN ORDER TO CONSTRUCT (OR RECONSTRUCT) A SEWAGE DISPOSAL SYSTEM.

PROPERTY OWNER *Russell Coleman* *Go Mr. Best*

ADDRESS *10412 Montrose Avenue* PHONE *493-5790*
Bethesda, Maryland 20014

PROPERTY LOCATION:

SUBDIVISION _____ LOT NO. _____

ROAD AND DESCRIPTION *Triadelphia Mill Road, Dayton, Md. 21036*

OCCUPANT *Undeveloped land* PHONE _____

PERSON TO CONSTRUCT SYSTEM *To be determined*

ADDRESS _____ PHONE _____

SIZE OF LOT *5 acres (#17)* TYPE BLDG. *Four (4)*
NUMBER OF BEDROOMS _____

IF NOT SINGLE RESIDENCE DESCRIBE _____

SIGNATURE OF APPLICANT *Russell Coleman*


APPROVED BY *Robert V. Turner* FOR *By Mary Louise Blunt* DATE *6/1/73*
(KIND OF SYSTEM) _____

REJECTED BY _____ FOR _____ DATE _____
(KIND OF SYSTEM) _____

HOLD PENDING FURTHER TESTS _____ DATE _____

REASONS FOR REJECTION OR HOLDING _____

THIS IS NOT A PERMIT

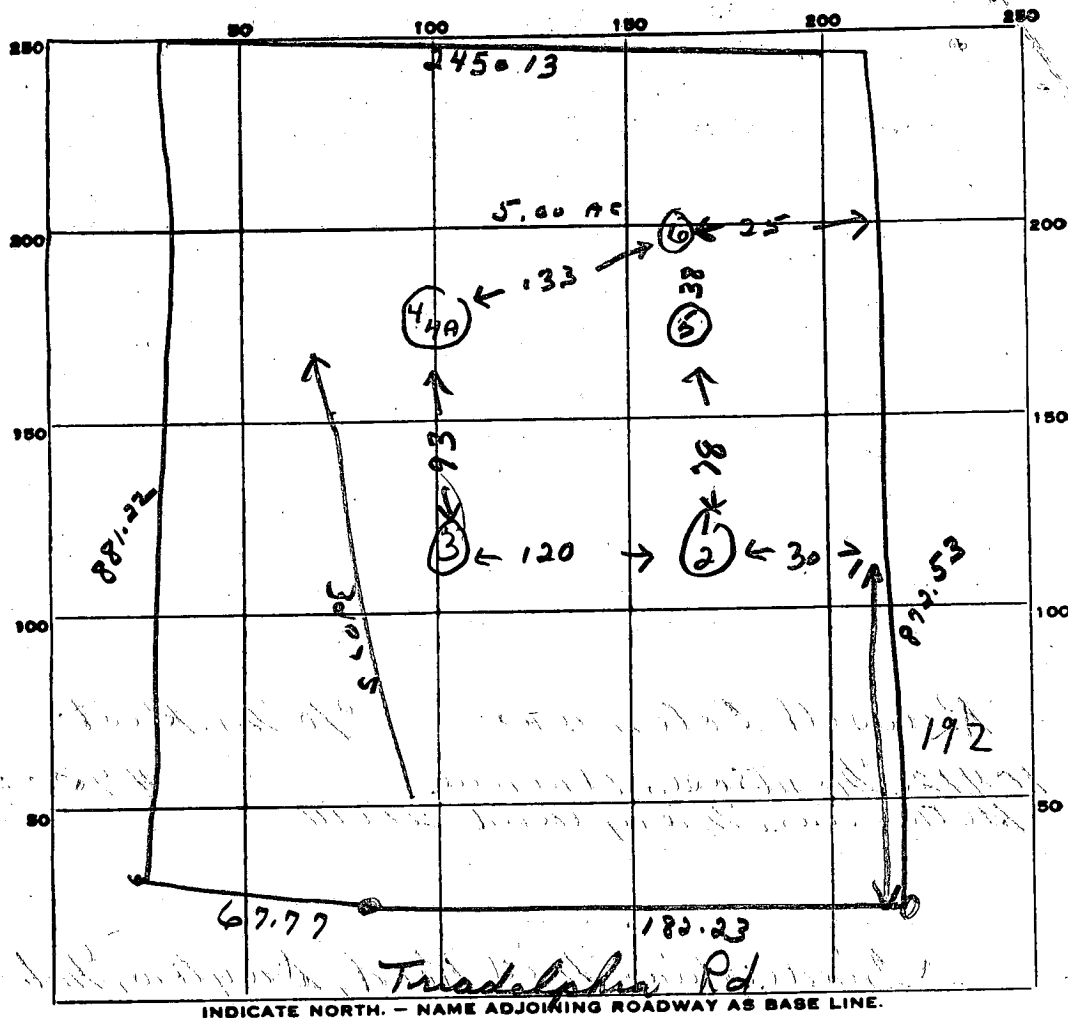

DATE	TEST NO.	DEPTH	PRE-WET		TEST - 1" DROP		TIME
			START	STOP	START	STOP	
11/9/75	1	11 ft	11:23	11:36	11:36	11:48	5 min
	2	3 ft	11:23	11:35	11:38	11:38	3 min
	3	10 1/2 ft	Same	End			
	4	3 ft	11:43			11:48	5 min
	4A	11 ft	11:43	12:00	12:00	12:21	21 min
	5 ft	9 1/2 ft					
	6 ft	9 ft	Water				

SOIL AUGER FINDING

TESTED BY R. Torne

REMARKS

B 1

SEQUENCE NO.
(OEP USE ONLY)STATE OF MARYLAND
PERMIT TO DRILL WELL

OEP PERMIT NUMBER

HO-81-1315

(THIS NUMBER IS TO BE PUNCHED
IN COLS. 3-6 ON ALL CARDS)

please print or type

fill in this form completely

Date Received

01/14/86

OWNER INFORMATION

15 Last Name LONG Owner P. ROBERT 34
 36 Street or RFD 3926 TEN OAKS RD. 55
 57 Town DAYTON 70 State 72 MD Zip 76 21036

DRILLER INFORMATION

Driller's Name Joseph L. Mayne 77 License No. 80 238
 Firm Name Joseph L. Mayne Well Drilling
 Address 5512 Ridge Rd. Mt. Airy, Md. 21771
 Signature Joseph L. Mayne Date 1/14/86

WELL INFORMATION

APPROX. PUMPING RATE (GAL. PER MIN.) 5
 AVERAGE DAILY QUANTITY NEEDED (GAL. PER DAY) 500

USE FOR WATER (CIRCLE APPROPRIATE BOX)

- ☒ HOME (SINGLE OR DOUBLE HOUSEHOLD UNIT ONLY)
☐ FARMING (LIVESTOCK WATERING & AGRICULTURAL IRRIGATION)
☐ INDUSTRIAL, COMMERCIAL, STATE AND FEDERAL GOV. OTHER (REQUIRES APPROPRIATION PERMIT)
☐ PUBLIC OR PRIVATE WATER COMPANY (REQUIRES APPROPRIATION PERMIT AND STATE HEALTH DEPARTMENT APPROVAL)
☐ TEST, OBSERVATION, MONITORING (MAY REQUIRE APPROPRIATION PERMIT)

APPROXIMATE DEPTH OF WELL 260 FEETAPPROXIMATE DIAMETER OF WELL 6 INCH

METHOD OF DRILLING (circle one)

BORED (or Augered) JETTED Jetted & DRIVEN
AIR-ROTARY AIR-PERCussion ROTARY (Hydraulic Rotary)
CABLE REverse-ROTary Drive-POINT
 other _____

REPLACEMENT OR DEEPEMED WELLS
(CIRCLE APPROPRIATE BOX)

- ☒ THIS WELL WILL NOT REPLACE AN EXISTING WELL
☐ THIS WELL WILL REPLACE A WELL THAT WILL BE ABANDONED AND SEALED
☐ THIS WELL WILL REPLACE A WELL THAT WILL BE USED AS A STANDBY
☐ THIS WELL WILL DEEPEMED AN EXISTING WELL

PERMIT NUMBER OF WELL TO BE REPLACED OR DEEPEMED (IF AVAILABLE) _____

Not to be filled in by driller (OEP USE ONLY)

APPROP. PERMIT NUMBER _____


FORCE BK WRITE INITIALS IN BOX PERMIT No. HO-81-1315

SPECIAL CONDITIONS

LOCATION OF WELL

HOWARD COUNTY
COLSMAN-~~GREEN~~ PROP. SUBDIVISION
 SECTION 1 LOT 17
DAYTON NEAREST TOWN
 MILES FROM TOWN (enter 0 if in town) 3 MI

DIRECTION OF WELL FROM TOWN (CIRCLE BOX)

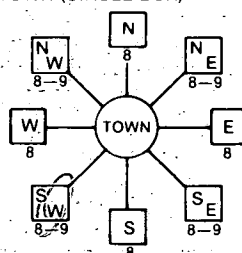

Triadelphia Road NEAR WHAT ROAD
 ON WHICH SIDE OF ROAD (CIRCLE APPROPRIATE BOX)
 NORTH ☒ WEST ☐ EAST ☐ SOUTH ☐
 DISTANCE FROM ROAD 90 FT
 ENTER FT or MI FT

NOT TO BE FILLED IN BY DRILLER
HEALTH DEPARTMENT APPROVAL

COUNTY NAME HOWARD COUNTY NO. R17576
 OEP SIGNATURE _____ STATE HEALTH INSERT S _____
 DATE ISSUED 01/16/86 CO SIGNATURE B. Nylon EXP. DATE 07/16/86
 NORTH GRID 502000 EAST GRID 0794000

SHOW MAJOR FEATURES OF BOX & LOCATE WELL WITH AN X


SOURCES OF DRILLING WATER

1. WELL
2. _____
3. _____

WRITE THE BOX NUMBER FROM THE MAP HERE

E 794
 N 500

DRAW A SKETCH BELOW SHOWING LOCATION OF WELL IN RELATION TO NEARBY TOWNS AND ROADS AND GIVE DISTANCE FROM WELL TO NEAREST ROAD JUNCTION

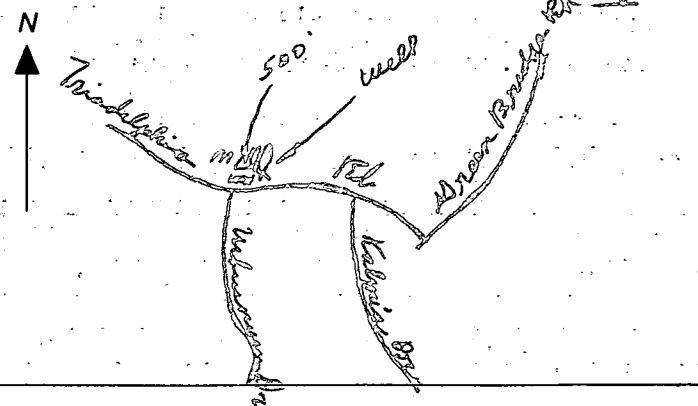

C1 00848

SEQUENCE NO.
(OEP USE ONLY)STATE OF MARYLAND
WELL COMPLETION REPORT
FILL IN THIS FORM COMPLETELY
PLEASE PRINT OR TYPETHIS REPORT MUST BE SUBMITTED WITHIN
45 DAYS AFTER WELL IS COMPLETED.(THIS NUMBER IS TO BE PUNCHED
IN COLS. 3-6 ON ALL CARDS)COUNTY
NUMBER

A 17576

DATE RECEIVED

DATE WELL COMPLETED

Depth of Well

PERMIT NO.
FROM "PERMIT TO DRILL WELL"

8 13

012986

22 26
165
(TO NEAREST FOOT)28 29 30 31 32 33 34 35 36 37
40-81-1313OWNER LONG ROBERT
STREET OR RFD TRINITY MILL RD first name
SUBDIVISION COLEMAN PROP. SECTION 17 LOT 17

WELL LOG

Not required for driven wells

STATE THE KIND OF FORMATIONS
PENETRATED, THEIR COLOR, DEPTH,
THICKNESS AND IF WATER BEARINGDESCRIPTION (Use
additional sheets if needed)FEET
FROM TOCheck
if water
bearing

Brown Shale

0 15

Sand

15 85

Gray Micaceous Rock

85 165

GROUTING RECORD

WELL HAS BEEN GROUTED
(Circle Appropriate Box)yes no
Y N
44 44

TYPE OF GROUTING MATERIAL

CEMENT CM BENTONITE CLAY BCNO. OF BAGS 13 NO. OF POUNDS 1222GALLONS OF WATER 78

DEPTH OF GROUT SEAL (to nearest foot)

from 0 ft. to 30 ft.
48 TOP 52 54 BOTTOM 58
(enter 0 if from surface)casing
types
insert
appropriate
code
below

CASING RECORD

STEEL CONCRETE
PLASTIC OTHER
ST CO
PL OT

MAIN CASING TYPE Nominal diameter top (main) casing (nearest inch) Total depth of main casing (nearest foot)

ST 6 90
60 61 63 64 66 70

EACH CASING

OTHER CASING (if used)

diameter inch depth (feet) from to

EACH CASING

screen type
or open hole
insert
appropriate
code
below

SCREEN RECORD

STEEL BRASS BRONZE PLASTIC OPEN HOLE OTHER
ST BR HO
PL OT

C2

EACH SCREEN

DEPTH (nearest ft.)

H0 89 165
8 9 11 15 17 21
23 24 26 30 32 36
38 39 41 45 47 51

SLOT SIZE 1 2 3

DIAMETER OF SCREEN (NEAREST INCH)

from to

GRAVEL PACK IF WELL DRILLED WAS FLOWING WELL INSERT F IN BOX 68

OEP USE ONLY
(NOT TO BE FILLED IN BY DRILLER)

T

(E.R.O.S.)

WQ

TELESCOPE CASING

LOG INDICATOR

OTHER DATA

C3

1 2

PUMPING TEST

HOURS PUMPED (nearest hour)

3

PUMPING RATE (gal. per min. to nearest gal.)

10

METHOD USED TO MEASURE PUMPING RATE

bucket

WATER LEVEL (distance from land surface)

BEFORE PUMPING

24

WHEN PUMPING

35

TYPE OF PUMP USED (for test)

A air P piston T turbine
C centrifugal R rotary O other (describe below)
J jet S submersible

PUMP INSTALLED

DRILLER WILL INSTALL PUMP YES NO

IF DRILLER INSTALLS PUMP, THIS SECTION MUST BE COMPLETED FOR ALL WELLS EXCEPT HOME USE TYPE OF PUMP INSTALLED PLACE (A,C,J,P,R,S,T,O) IN BOX - SEE ABOVE:

CAPACITY: GALLONS PER MINUTE (to nearest gallon)

PUMP HORSE POWER


PUMP COLUMN LENGTH (nearest ft.)

CASING HEIGHT (circle appropriate box and enter casing height)

LAND SURFACE (nearest foot)

LOCATION OF WELL ON LOT

SHOW PERMANENT STRUCTURE SUCH AS BUILDING, SEPTIC TANKS, AND/OR LANDMARKS AND INDICATE NOT LESS THAN TWO DISTANCES (MEASUREMENTS TO WELL)

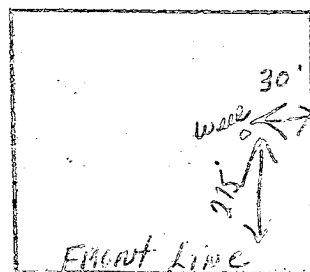

Owner Robert P. Lowe

Static water level (S.W.L.) below M.P. 24

Total time 30 min to reach pumping water level 34 ft. below M.P.

[illegible]

HOWARD COUNTY HEALTH DEPARTMENT

BUREAU OF ENVIRONMENTAL HEALTH

PUMP INSTALLATION

THE FOLLOWING STATEMENT MUST BE COMPLETED BY THE HOME OWNER

~~WHEN A PUMP IS INSTALLED BY A PERSON OTHER THAN THE WELL~~
DRILLER:

My well driller is not to install the pump for my water well, and I hereby certify that it will be my responsibility to have a Pump Permit taken out by a registered master plumber or certified pump installer. It will be my responsibility to notify the Health Department before and during the installation so that inspections can be made by their representative. (Pursuant to Chapter XVII, of the Plumbing Code of Howard County.)

Robert Long, Jr.

(Name)

3926 Ten Oaks Rd
Dayton Md. 21036

(Address)

HO 81 1313

(OEP Well Permit Number)


1/16/86

(Date)

5.00 AC. ±

DISTRIBUTION BOX DIVIDING LENGTH
100' length maximum
NEED 170' TRENCH

INLET 2' WIDE 5' STONE
3.5' BELOW SURFACE

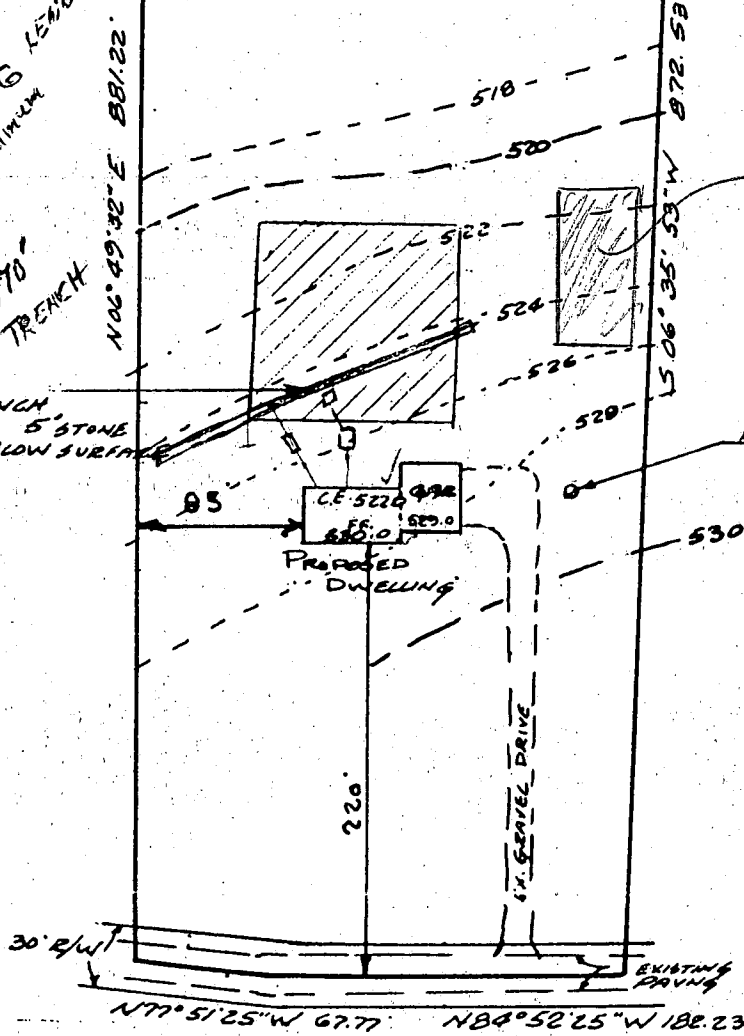

Existing building


W.B. 2/20

BP 70021

TRIADELPHIA MILL ROAD

HUDKINS ASSOCIATES, INC.
SUITE 231, JOSEPH SQUARE
5485 HARPERS FARM ROAD
COLUMBIA, MD 21044

SITE PLAN
Lot 17
RUSSELL COLEMAN PROPERTY
OWNER ROBERT LONG & WIFE
5TH ELEC. DIST. HOWARD CO. MARYLAND
1"=100' 3-30-86

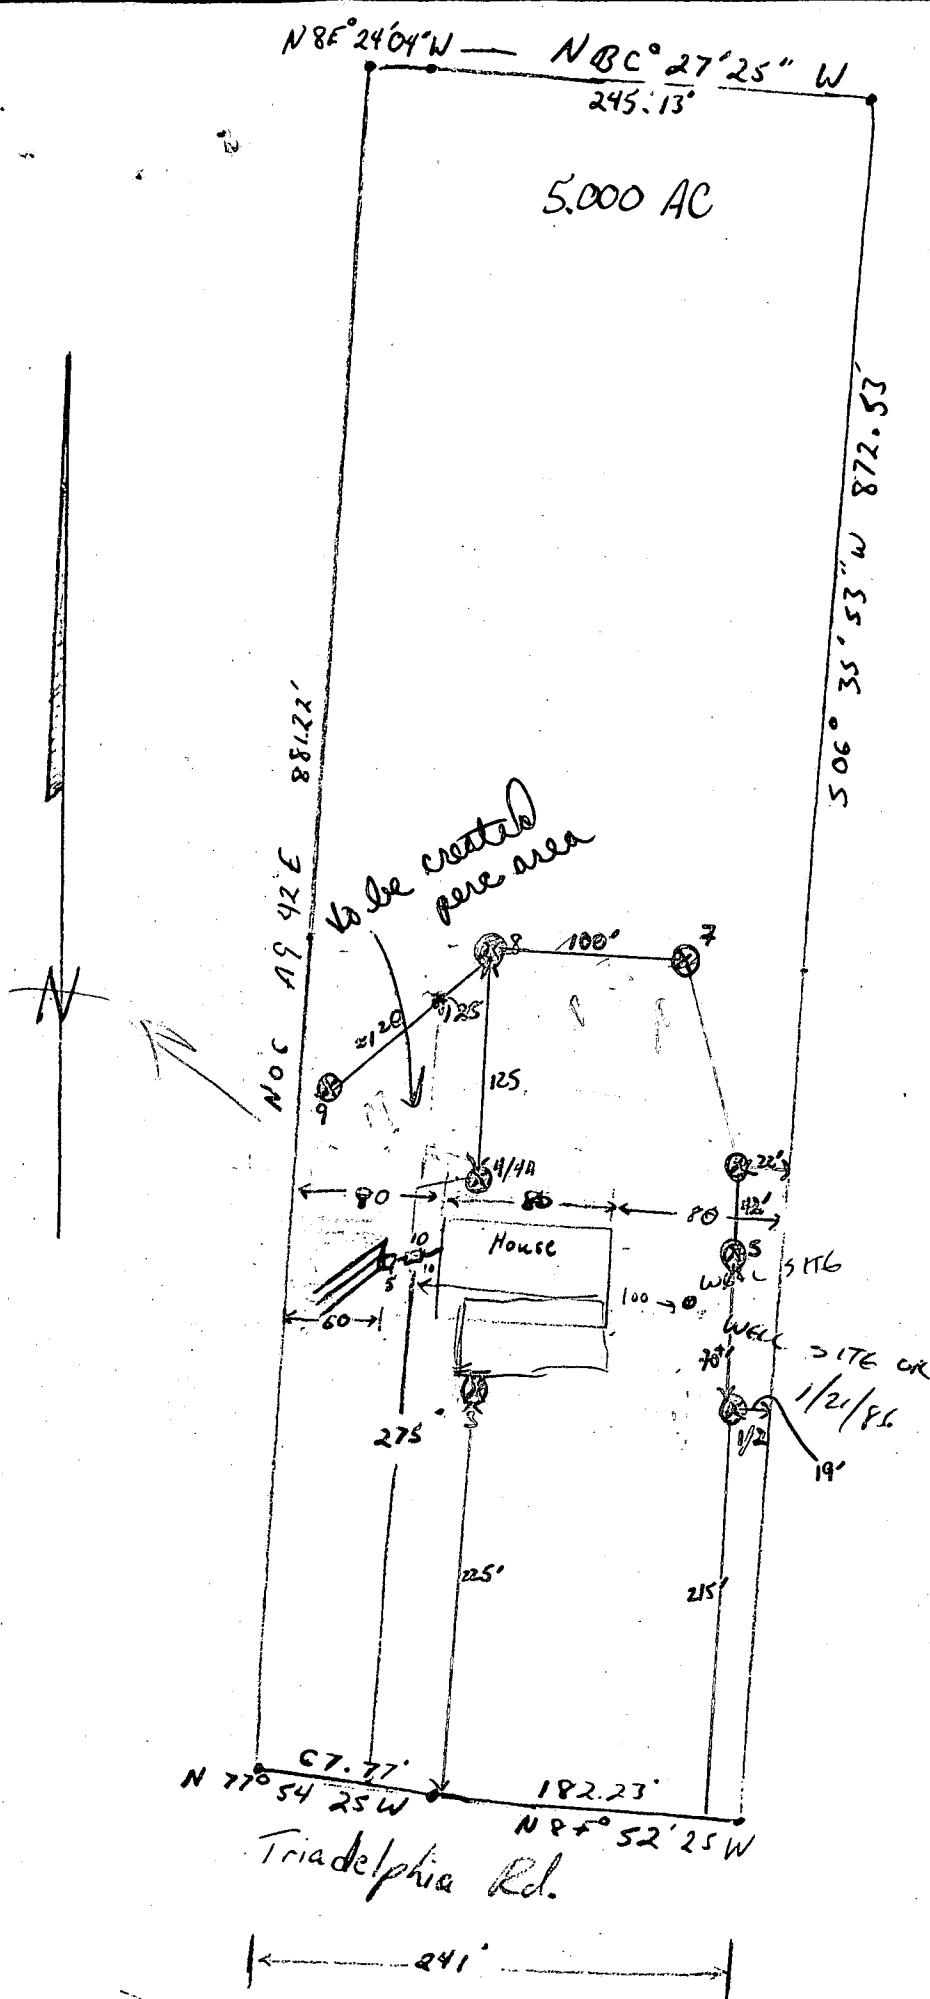


If house is
 shifted ($\approx 10-20'$) to
 the right, should
 yield 10,000 +
 easier trench access.

Rob Long
 Coleman & Lurch prop
 Lot #17


5/20/99

OK
PROCEED

Per owner,
intended use
for structure
shall be only
for family use
(pool table, ping
pong, etc). Owner
shall request
HD inspection
at time of plumbing
look up to septic

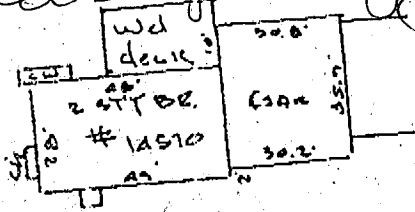

CONNECTION TO
EXISTING 4" PVC PIPE IN
BASEMENT
LEADING TO
EXISTING SEPTIC
SYSTEM.

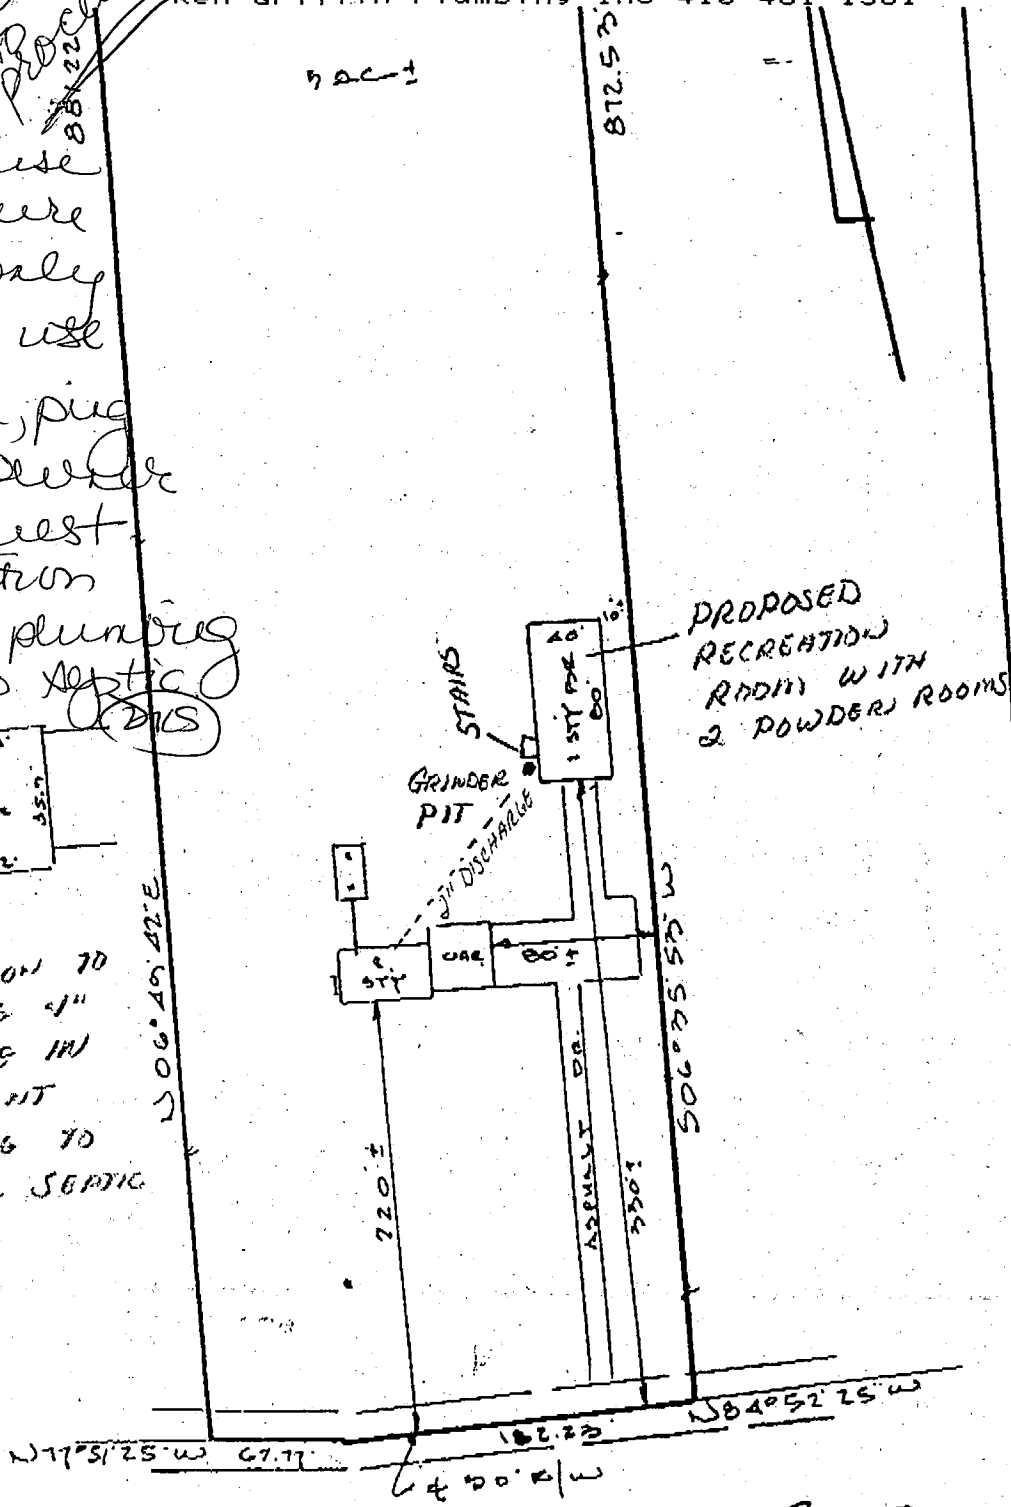

14570 TRIAD DELPHIA Mill Road

ON DRAWING

SCALE 1" = 100' DATE 3-22-1999

TIFICATION

SEAL

LDE Inc.

9250 Rumsey Road Suite 106
Columbia, Maryland 21045


(410) 715-1070 (Balt.)
(301) 596-3424 (Wash)
(410) 715-9540 (Fax)

I certify that I have surveyed
shown as: 14510
MILL ROAD
shown has been established
table survey procedures and
card information. This drawing
Title Transfer Financing, or
and IS NOT to be used for
of Property Lines, Location



PROPERTY KNOWN AS:

5TH ELECTION DISTRICT
HOWARD COUNTY MD

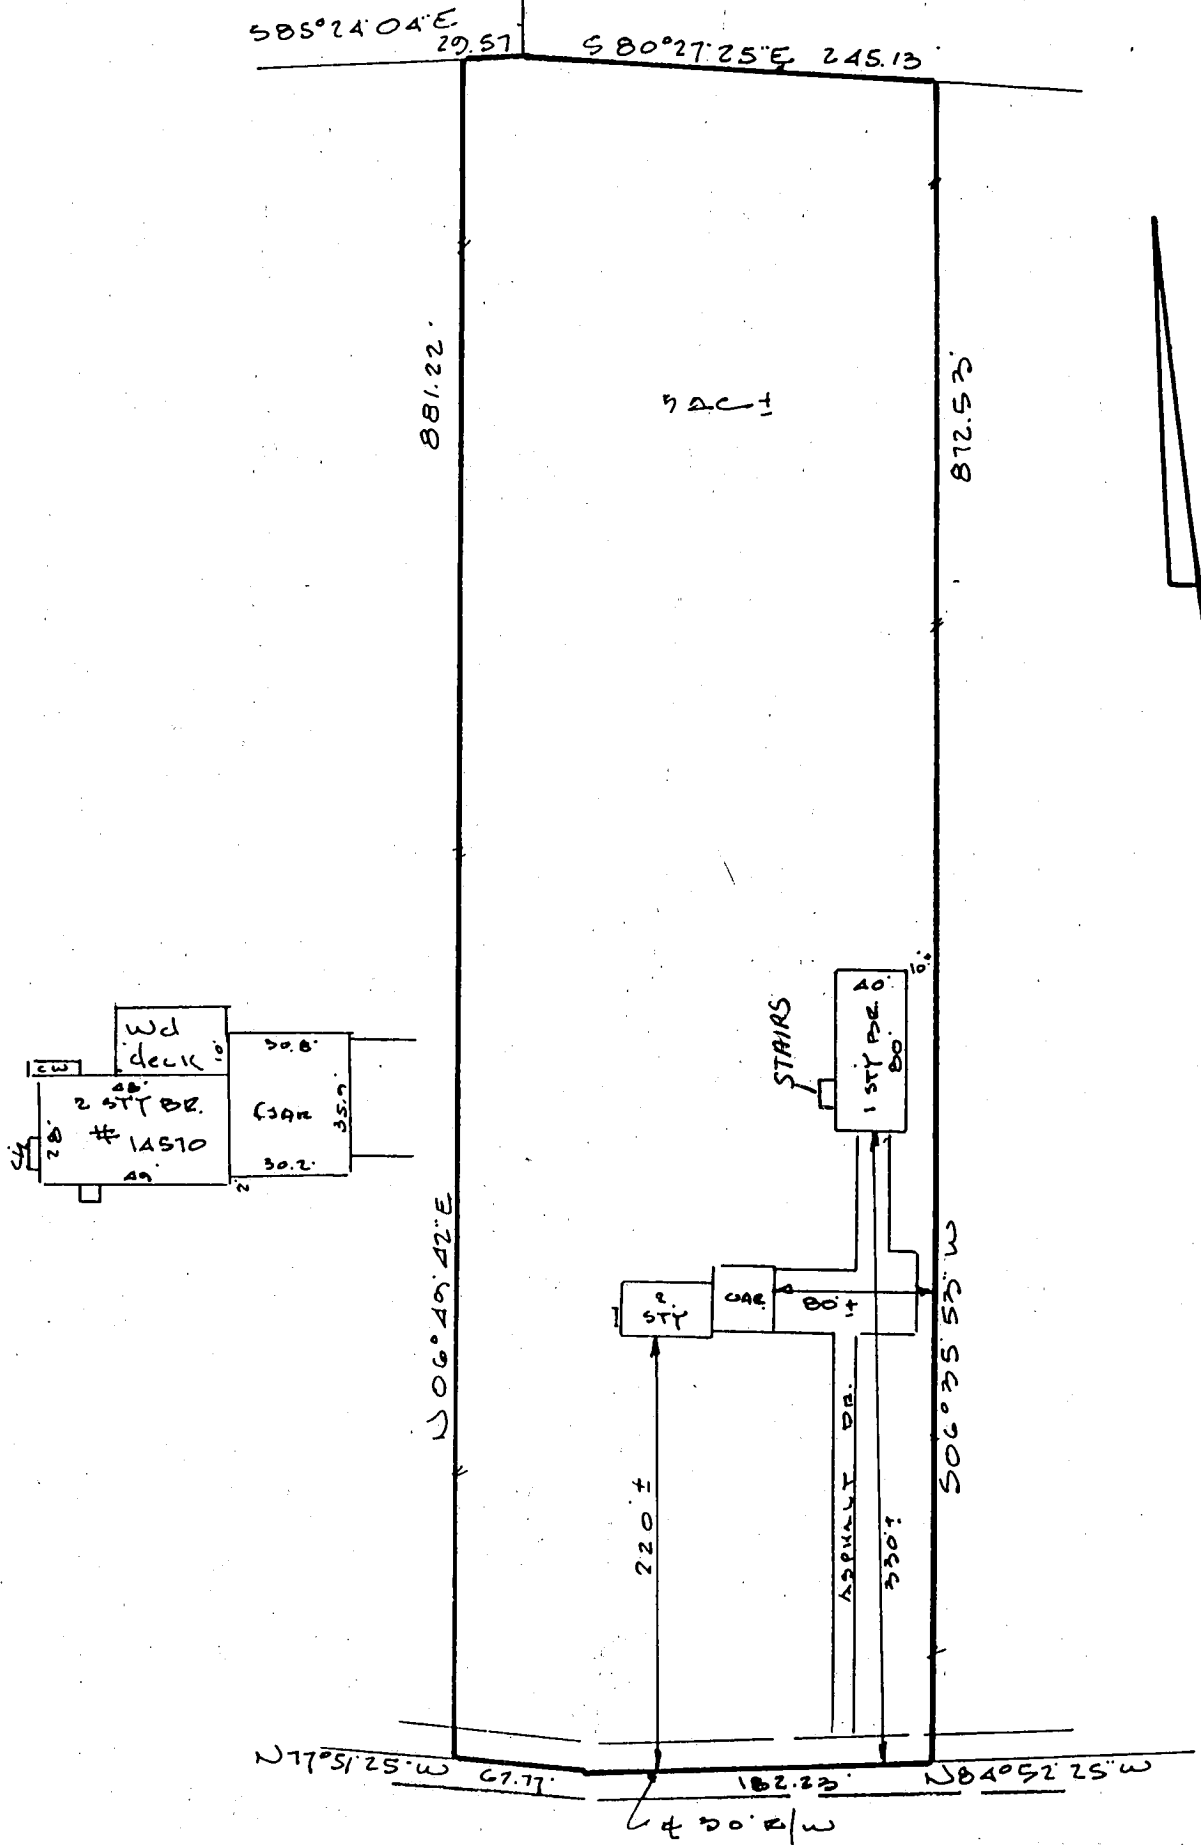

LOCATION DRAWING

TRIAD DELPHIA MILL ROAD

CERTIFICATION

This is to certify that I have surveyed the property known as: 14510

TRIAD DELPHIA MILL ROAD

The information shown has been established by current acceptable survey procedures and from available record information. This drawing is to be used for Title Transfer Financing, or Refinancing Only and IS NOT to be used for the Establishment of Property Lines, Location for Fences, Garages, Buildings, or other Existing or Future Improvements.

SEAL



SCALE

1" = 100'


DATE 3-22-1999

LDE Inc.


9250 Rumsey Road Suite 106
Columbia, Maryland 21045

(410) 715-1070 (Balt.)
(301) 596-3424 (Wash)
(410) 715-9540 (Fax)

ACCT #
D54570
SITE PLAN

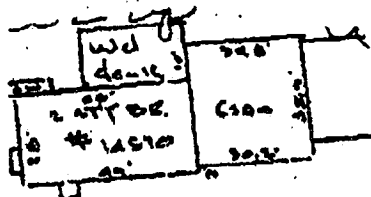

CONNECTION TO
EXISTING 4" PVC PIPE IN
BASEMENT
LEADING TO
EXISTING SEPTIC
SYSTEM.

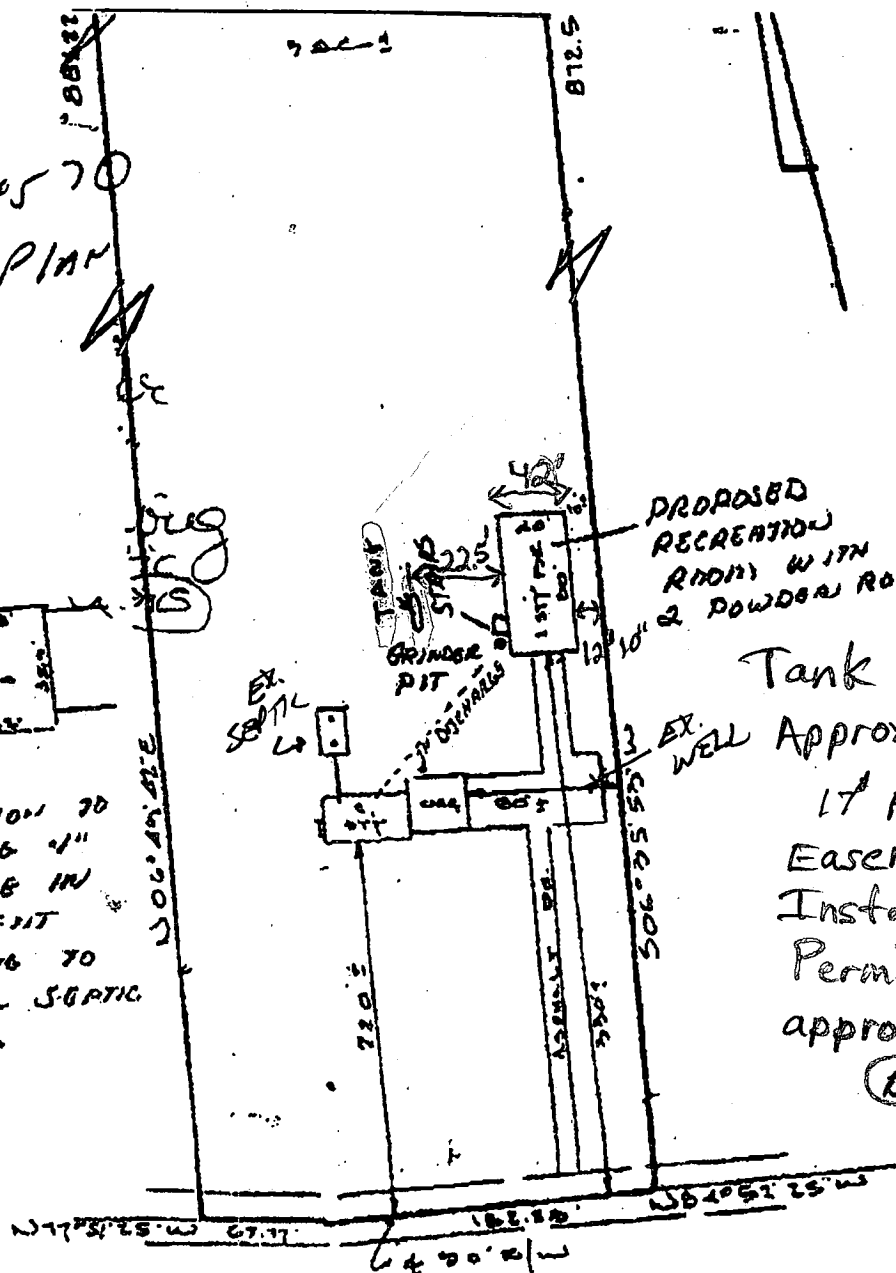

PROPOSED
RECREATION
ROOM WITH
2 POWDER ROOMS

Tank 4/15/015

Approximately
17' From
Easement
Installed Before
Permit. Will
approve as is.

(BB)

14570 TRI-DELPHIA TILL ROAD

ON DRAWING
TIFICATION

I certify that I have surveyed
shown as: 14570
410 MILL ROAD

shown has been established
table survey procedures and
cord information. This drawing
(Tilla Transfer Financing, or
and is NOT to be used for
of Property Lines, Location

SEAL



SCALE 1" = 100' DATE 3-22-1997

LDE Inc.

9250 Rumsey Road Suite 106
Columbia, Maryland 21045

(410) 715-1070 (Balt.)
(301) 596-3424 (Wash.)
(410) 715-9540 (Fax)