

PERMIT

SEWAGE DISPOSAL SYSTEM

MARYLAND STATE DEPARTMENT OF HEALTH

HOWARD COUNTY

ELLICOTT CITY

DISTRICT

DATE

INDEXED

INDEXED

approved
7-1-62
P 05396
A 05361
36474-B

4

6/22/62

Howard Pickett

IS PERMITTED TO INSTALL _____ ALTER _____

ADDRESS _____

A SEWAGE DISPOSAL SYSTEM LOCATED AT on Hobbs Rd - 1/2 mile north of Shady Lane

SUBDIVISION _____ ROAD _____ LOT _____

PROPERTY OWNER Jessie Stokes

ADDRESS Glenwood

SPECIFICATIONS

DRAIN FIELD ☒ DEPTH _____ FEET, BOTTOM AREA 300 SQ. FT.

SEEPAGE PITS _____ ABSORBENT SIDE-WALL AREA _____ SQ. FT.

SEPTIC TANK CAPACITY 750 GALLONS

FOR GARBAGE GRINDER, INCREASE DISPOSAL AREA 22% & TANK CAPACITY 50%.


OTHER Tile field to be installed in the area that passed percolation

PLANS APPROVED BY D. W. Monaghan DATE 6/21/62

FILL SEPTIC TANK AND DISTRIBUTION BOX WITH WATER BEFORE CALLING FOR AN INSPECTION. COVER NO WORK UNTIL INSPECTED AND APPROVED.

NEITHER THE HOWARD COUNTY COMMISSIONERS NOR THE HEALTH DEPARTMENT IS RESPONSIBLE FOR THE SUCCESSFUL OPERATION OF ANY SYSTEM.

A 36474-B
A 05361

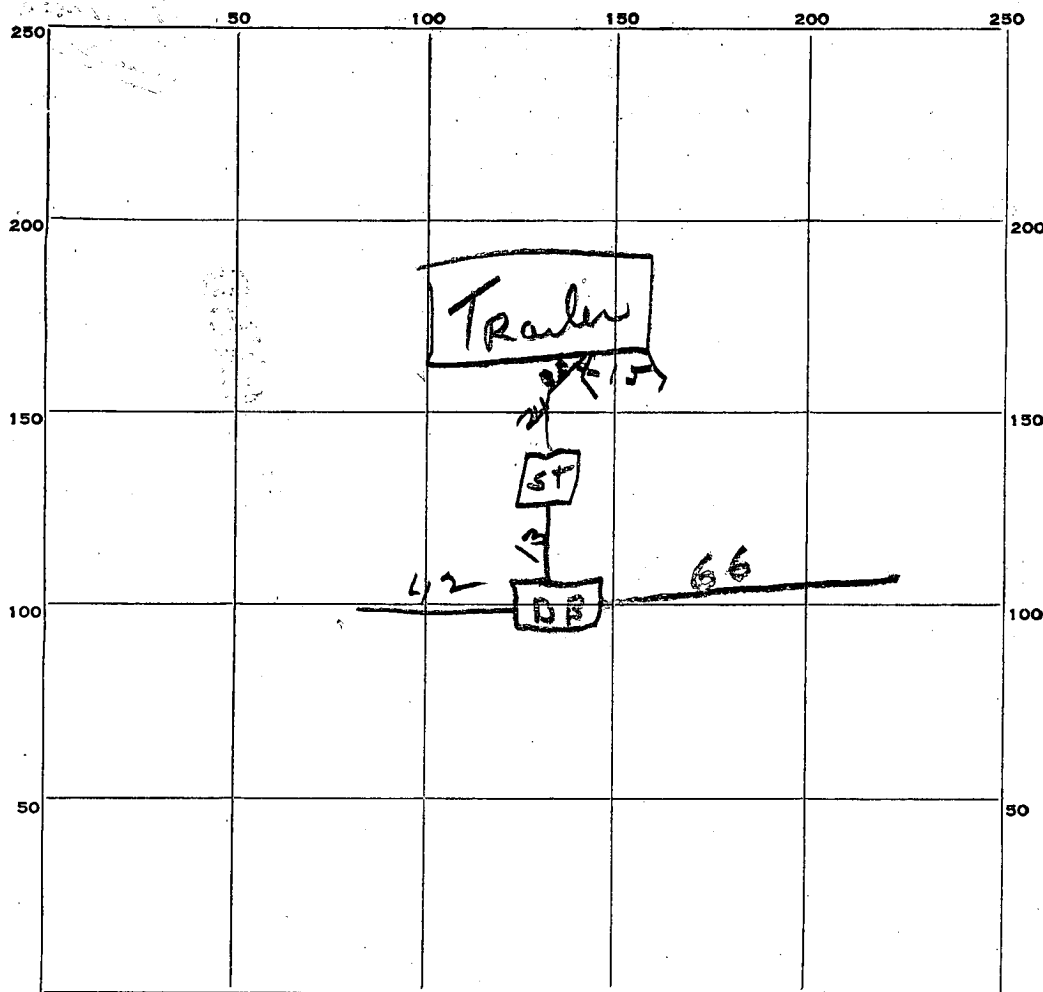

INDICATE NORTH. — NAME ADJOINING ROADWAY AS BASE LINE.

PERMIT CARD 7

SEPTIC TANK, LEVEL ✓ CLEANOUTS ✓

DISTRIBUTION BOX, LEVEL ✓

TILE FIELD, DEPTH 3 FT. TRENCH WIDTH 3 FT.

GRAVEL DEPTH 12 IN. TOTAL LENGTH 108 FT.

NUMBER OF TRENCHES TOTAL BOTTOM AREA 324 ~~sq~~

SEEPAGE PITS, INSIDE DIAMETER FT. DEPTH BELOW INLET FT.

ABSORBENT AREA SQ. FT.

REMARKS

DATE SYSTEM APPROVED 7-11-62 INSPECTOR Joe Mangan

ON TRIPLICATE.

CHECKED BLANKS.

APPLICATION

A 05361

P _____

MAKE FEE OF \$15.00 PAYABLE TO

HOWARD COUNTY HEALTH DEPT. - SANITATION

SEWAGE DISPOSAL TESTING

MARYLAND STATE DEPARTMENT OF HEALTH

HOWARD COUNTY

ELLICOTT CITY

Septic Tank - 750 gal

DISTRICT 4TH

Tile Field - 300 sq ft absorbent bottom area to be installed in area that passed per. test

DATE 6-20-62

TO: THE COUNTY HEALTH OFFICER
ELLICOTT CITY, MARYLAND

I, HEREBY, APPLY FOR THE NECESSARY TESTS IN ORDER TO CONSTRUCT (OR RECONSTRUCT) A SEWAGE DISPOSAL SYSTEM.

✓ PROPERTY OWNER Jesse F. Hakes John C. Fisher (Applicant)

✓ ADDRESS Glenwood, Md.

✓ PHONE Hu. 9-4157

PROPERTY LOCATION:

✓ SUBDIVISION Dairy Farm

✓ LOT NO. _____

✓ ROAD AND DESCRIPTION Hobbs Rd. West side 1/2 mile north of
Shady Lane

OCCUPANT _____

PHONE _____

PERSON TO CONSTRUCT SYSTEM John C. Fisher

ADDRESS Glenwood, Md.

PHONE Hu. 9-4157

✓ SIZE OF LOT _____

✓ TYPE BLDG. Trailer (bwe)

NUMBER OF BEDROOMS _____

IF NOT SINGLE RESIDENCE DESCRIBE _____

✓ SIGNATURE OF APPLICANT John C. Fisher

✓ APPROVED BY Donald E. Mraghan FOR Tile Field

(KIND OF SYSTEM)

DATE 6-21-62

REJECTED BY _____

FOR _____

(KIND OF SYSTEM)


DATE _____

HOLD PENDING FURTHER TESTS _____

DATE _____

REASONS FOR REJECTION OR HOLDING _____

THIS IS NOT A PERMIT

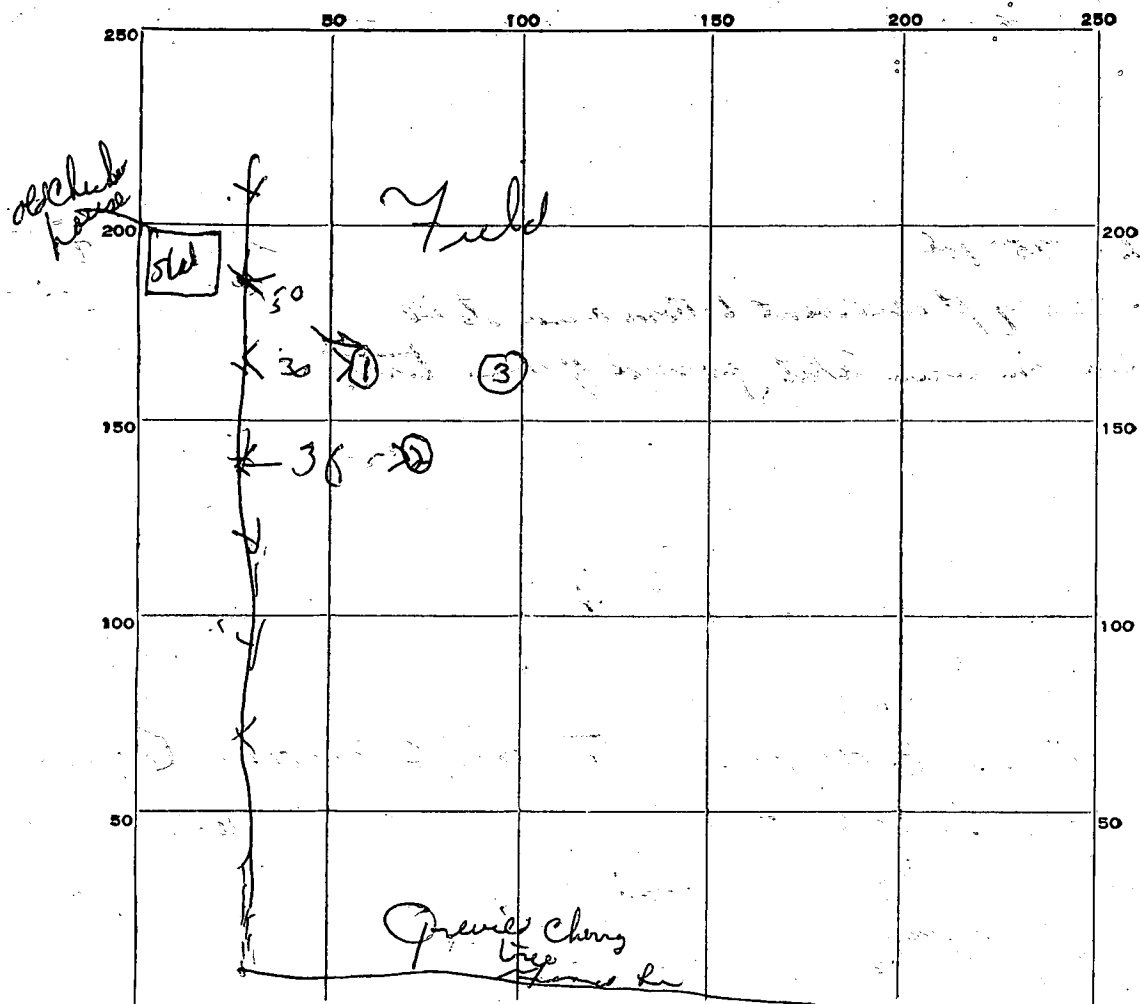

DATE	TEST NO.	DEPTH	PRE-WET		TEST - 1" DROP		TIME
			START	STOP	START	STOP	
6-21-62	1	3	255	301	301	308	7min
	2	3	300	305	305	313	8min
	3	3	301	slow pour			

SOIL AUGER FINDING _____

TESTED BY QJM - 6-21-62

REMARKS _____

ALSO PRESENT John C. Fisher

LOT NO. _____