

9/1/88 pm

PERMIT

SEWAGE DISPOSAL SYSTEM

MARYLAND STATE DEPARTMENT OF HEALTH

HOWARD COUNTY
BUREAU OF ENVIRONMENTAL HEALTH
461-9933

INDEXED

I. C. O. P.

{ Time expired }

42300
P 1587

A 36756

DISTRICT 4th

DATE 8-30-88

DATE SYSTEM APPROVED 9-1-88

INSPECTOR S. Abel

Olen Ketterman

IS PERMITTED TO INSTALL ☒ ALTER

ADDRESS 14960 Route 144, Woodbine, Maryland 21797 PHONE 442-1336

SUBDIVISION Triadelphia Estates ROAD 14820 Triadelphia Road LOT 1

PROPERTY OWNER Woodfield Homes, Inc.

ADDRESS

IF GARBAGE GRINDER IS USED INCREASE SEPTIC TANK CAPACITY BY 50% AND ABSORPTION AREA BY 22%.

GARBAGE GRINDER? YES NO ☒

SEPTIC TANK CAPACITY 1250 GALLONS NUMBER OF BEDROOMS 4

TRENCHES - 194 sq. ft. per bedroom. Trench to be 3 feet wide. Inlet 3½ feet below original grade. Bottom maximum depth 5½ feet below original grade. Effective area begins at 3½ feet below original grade. 2 feet of stone below distribution pipe.

LOCATION - SHALLOW SYSTEM ONLY. Beginning from the left front lot corner, place 1st trench 90 feet down the left (622.33') lot line and 110 feet off the left line as seen when facing property from Triadelphia Road. Run trenches along contour back towards the left lot line. MAINTAIN MINIMUM 100 FEET DISTANCE AND PROPER

ELEVATION FROM WELL TO SEPTIC. ALSO MAINTAIN 100' FROM SEPTIC TO NEIGHBORING WELL

NOTE - No trench to exceed 100 feet in length. Provide 6" - 8" diameter cleanout and cap to grade or above on septic tank.

PLANS APPROVED BY Bert Nixon DATE 5/18/87

COVER NO WORK UNTIL INSPECTED AND APPROVED.

NEITHER THE HOWARD COUNTY COUNCIL NOR THE HEALTH DEPARTMENT IS RESPONSIBLE FOR THE SUCCESSFUL OPERATION OF ANY SYSTEM.

NOTE: CLEANOUT REQUIRED EVERY 70 FEET OF SEWER LINE AND/OR AT 90° SWEEPS IN LINES FROM HOUSE TO DRAIN FIELDS.

NOTE: ALL PARTS OF SEPTIC SYSTEMS (I.E. TANK, DISTRIBUTION BOX, TRENCHES) TO BE 100 FEET FROM WELL (UNLESS OTHERWISE SPECIFICALLY AUTHORIZED)

NOTE: IF DEEP TRENCH(IES) ARE USED CALL FOR INSPECTION BEFORE AND AFTER PLACING GRAVEL IN TRENCH(IES).

NOTE: NO DRY WELL SHALL EXCEED 15 FOOT IN DIAMETER. NO ABSORPTION TRENCH TO EXCEED 100 FEET IN LENGTH.

NOTE: ALL PIPE FROM HOUSE TO SEPTIC TANK MUST BE CAST IRON OR SCHEDULE 40 PVC OR ABS.

PERMIT VOID AFTER TWO YEARS.

NOTE: INSTALL STAND PIPE ON SEPTIC TANK AND DRY WELL. STAND PIPES MUST BE 6 INCHES IN DIAMETER. CAST IRON, CONCRETE OR TERRA COTTA OR PVC OR ABS ACCEPTED. IF TOP OF SEPTIC TANK IS DEEPER THAN 3 FEET, MANHOLE TO GRADE REQUIRED.

NOTE: DISTRIBUTION BOXES MUST HAVE BAFFLES.

BOG. PERMIT SIGNED

AND RETURNED 3/28/89


Serial # 24315-ppml

*INSTALLER IS RESPONSIBLE FOR OBTAINING FINAL APPROVAL ON THIS PERMIT

*CALL 461-9933 FOR INSPECTION OF SEPTIC SYSTEMS.

EH - 2-1186

394
194
276
258
3776
175
126

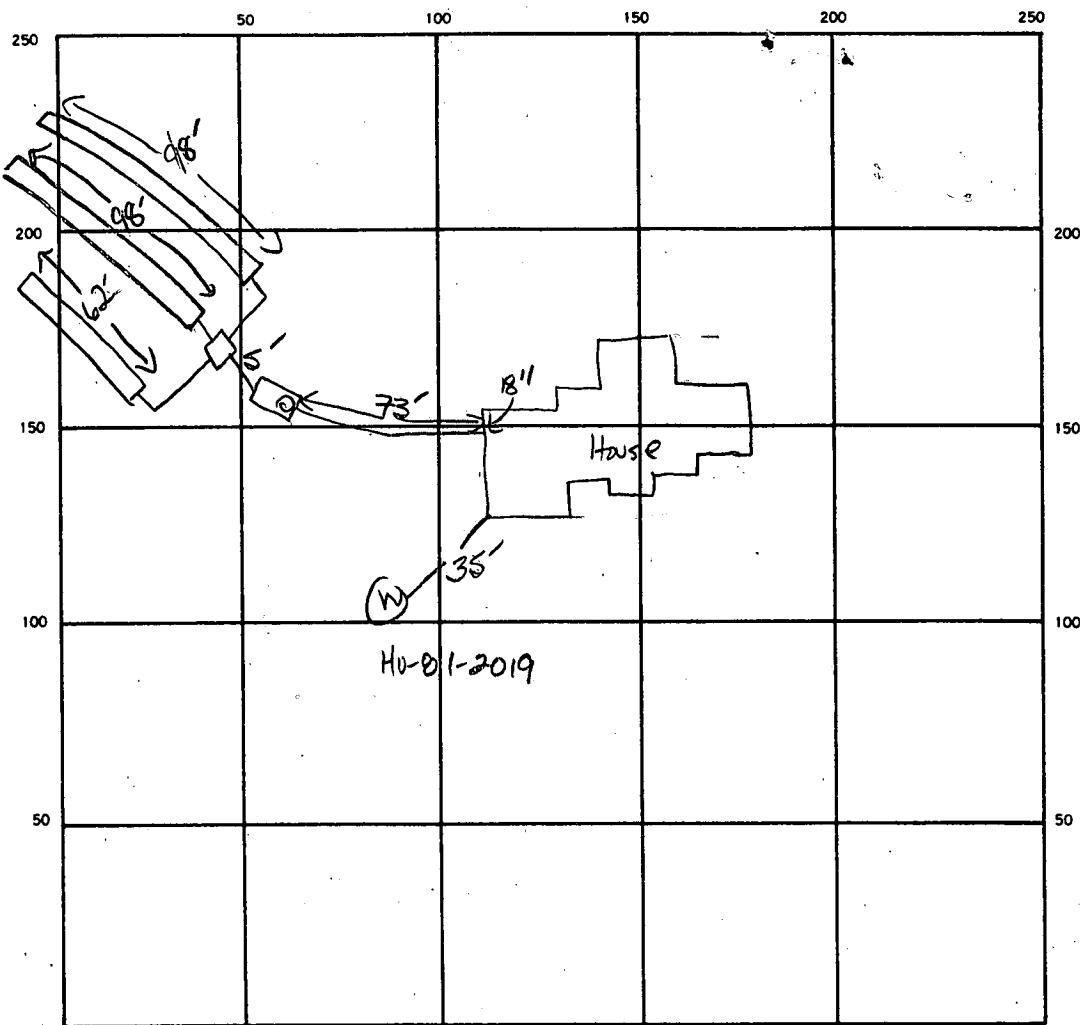

INDICATE NORTH. — NAME ADJOINING ROADWAY AS BASE LINE.
Triadelphia Rd.

SEPTIC TANK LEVEL ✓ 1500 GA CLEANOUTS ✓ 5

DISTRIBUTION BOX LEVEL ✓

DRAIN FIELD TILE FIELD DEPTH 5.5 FT. TRENCH WIDTH 3 FT. INLET DEPTH 3.5 FT.

EFFECTIVE GRAVEL DEPTH 2 FT. TOTAL LENGTH 258 FT.

NUMBER OF TRENCHES 3 ONE SIDEWALL BOTTOM AREA 774 SQ. FT.

DRYWELL INSIDE DIAMETER — FT. EFFECTIVE DEPTH BELOW INLET — FT.

ABSORBENT AREA 774 SQ. FT.

REMARKS 9/1/88 OK TO COVER. JAW

DATE SYSTEM APPROVED 9-1-88 INSPECTOR S. Abel

APPLICATION

PERCOLATION TESTING

A 36756

P _____

HOWARD COUNTY HEALTH DEPARTMENT
BUREAU OF ENVIRONMENTAL HEALTH
P.O. BOX 476 ELLICOTT CITY, MARYLAND 21043
TELEPHONE: 461-9933

DISTRICT _____

DATE 4/3/84

TO: THE COUNTY HEALTH OFFICER
ELLICOTT CITY, MARYLAND

I, HEREBY, APPLY FOR THE NECESSARY TEST IN ORDER TO CONSTRUCT (OR RECONSTRUCT) A SEWAGE DISPOSAL SYSTEM.

PROPERTY OWNER ARVID JACOBSON, PAUL JACOBSON, RANDALL JACOBSON

ADDRESS 11906 BLUE FEBRUARY WAY PHONE 730-1845

PROSPECTIVE BUYER _____

ADDRESS _____ PHONE _____

PROPERTY LOCATION:

SUBDIVISION TRIADELPHIA ESTATES LOT NO. 1

ROAD AND DESCRIPTION TRIADELPHIA ROAD

TAX MAP 21 PARCEL # 33 LOT 2

SIZE OF LOT 3.0 ACRES TYPE BLDG. SINGLE FAMILY
(SINGLE FAMILY DWELLING OR COMMERCIAL)

THE SYSTEM INSTALLED UNDER THIS APPLICATION IS ACCEPTABLE ONLY UNTIL PUBLIC FACILITIES BECOME AVAILABLE. I FULLY UNDERSTAND THE

FEE CONNECTED WITH THE FILING OF THIS PERC TEST APPLICATION IS NON-REFUNDABLE UNDER ANY CIRCUMSTANCES. I ALSO AGREE TO COMPLY

WITH ALL M.O.S.H.A. REQUIREMENTS IN TESTING THIS LOT. Randall Jacobson
(SIGNATURE OF APPLICANT)

APPROVED BY _____ FOR _____ DATE _____

REJECTED BY _____ FOR _____ DATE _____

HOLD PENDING FURTHER TESTS _____ DATE _____

REASONS FOR REJECTION OR HOLDING _____

THIS IS NOT A PERMIT

Tridelfia Estates


Lot 1

SOIL PROFILE

CLAY

BROWN
CLAY
&
ROCKS

WATER

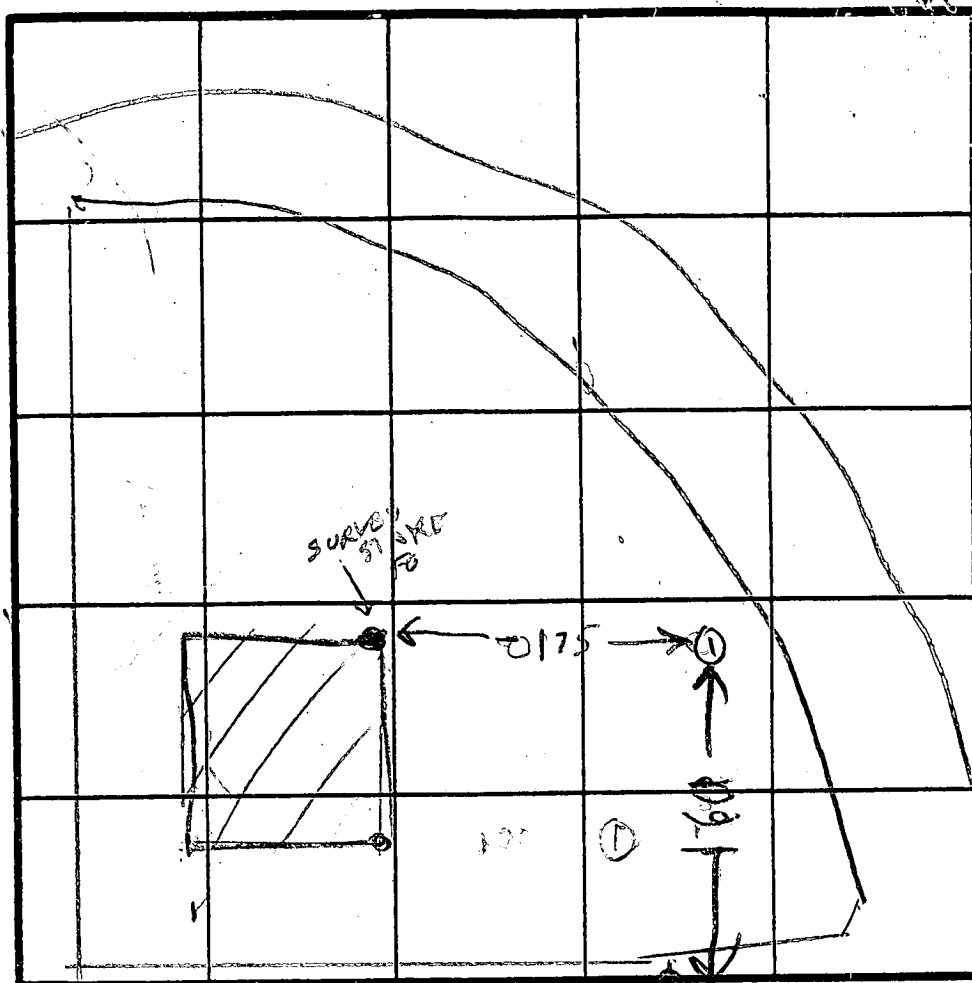

See the
sheet
for Layout
of lot
new
one

INDICATE NORTH - NAME ADJOINING ROADWAY AS BASE LINE.

TRIDELPHIA RD

DATE	TEST NO.	DEPTH	PRE-WET		TEST - 1" DROP		TIME
			START	STOP	START	STOP	
5/5/86	N	8	WATER 7 1/2 FT				
5/6/86	7S	4 1/2	1112	1113	1113	1117	4
	7V	13	LOOKS OK				
	8S	4	1125	1129	1129	1132	3
	9V	12	LOOKS OK				
	9S	4	1141	1144	1144	1147	3
	9D	8	1135	1136	1136	1139	
	9V	12	LOOKS OK				

REMARKS

TYPE OF SOIL

TESTED BY

RH

ALSO PRESENT

JACOBSON
W. MOODY

INLET 3

x 4 MIN

Lot 2 DOMINIC FEMIANO
14702 TRADEFAIR RD


Tradeaphy Estates

(4)
CLAY
SAND
LOAM

(1)
BROWN CLAY
BROWN SAND
LOAM
WATER

(2)
BROWN CLAY
BROWN SAND
LOAM

(3)
BROWN CLAY
TOPSOIL
BROWN SAND
LOAM

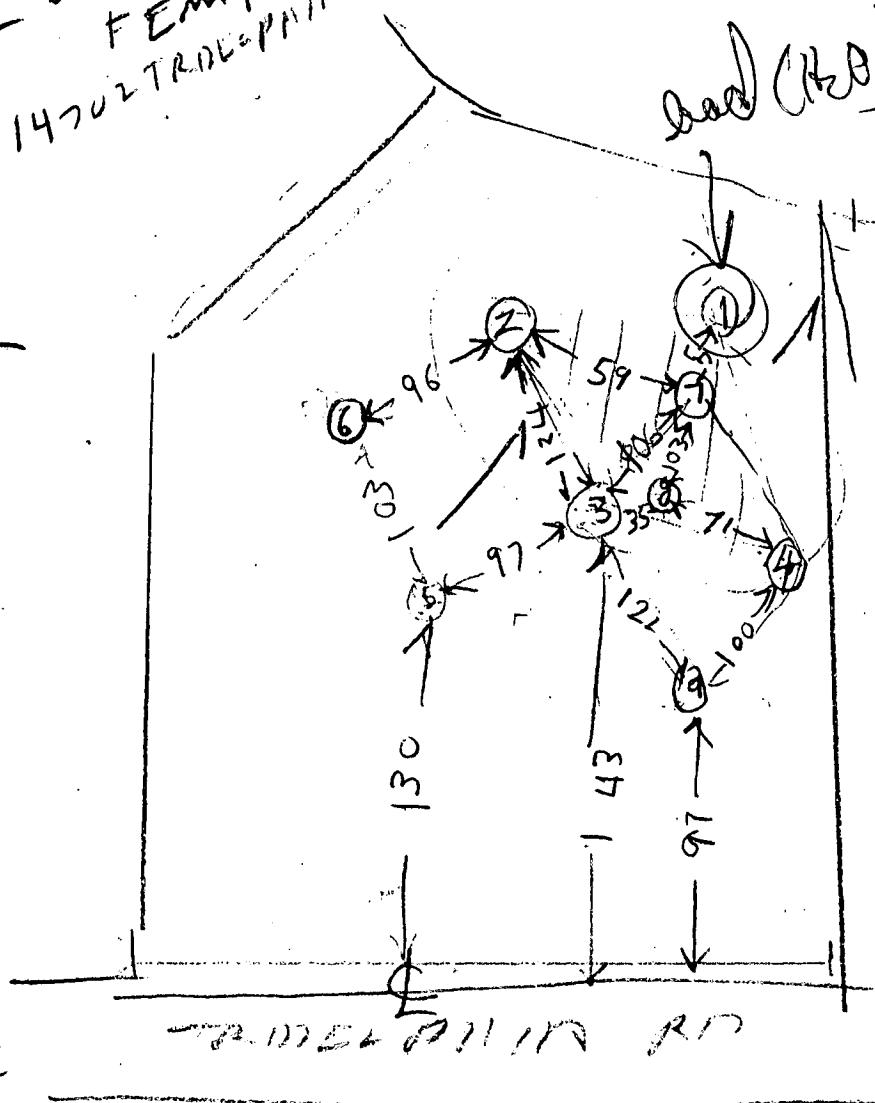

9 = HIGHEST
5 NEXT HIGHEST
6 8 3 2 = MEDIUM
4 = LOW
1 = LOWEST

CONTOUR MAP

5/18/87




holes 7, 7, 8, 9
appear to be
for lot #1

Others are for
lot #2.

4S	4.5	247	248	248	249	1	-
4V	12	LOOKS	OK				
1S	5	259	258	258	302	4	
1V	14	WATER	13 FT				
2S	4.5	305	309	309	311	2	
2V	12	LOOKS	OK				
3D	8	315	321	321	326	5	
3S	5	321	323	323	329	6	
3V	12	LOOKS	OK				

By R. H. HODGE

Philadelphia Estates
Lot NEW 2.

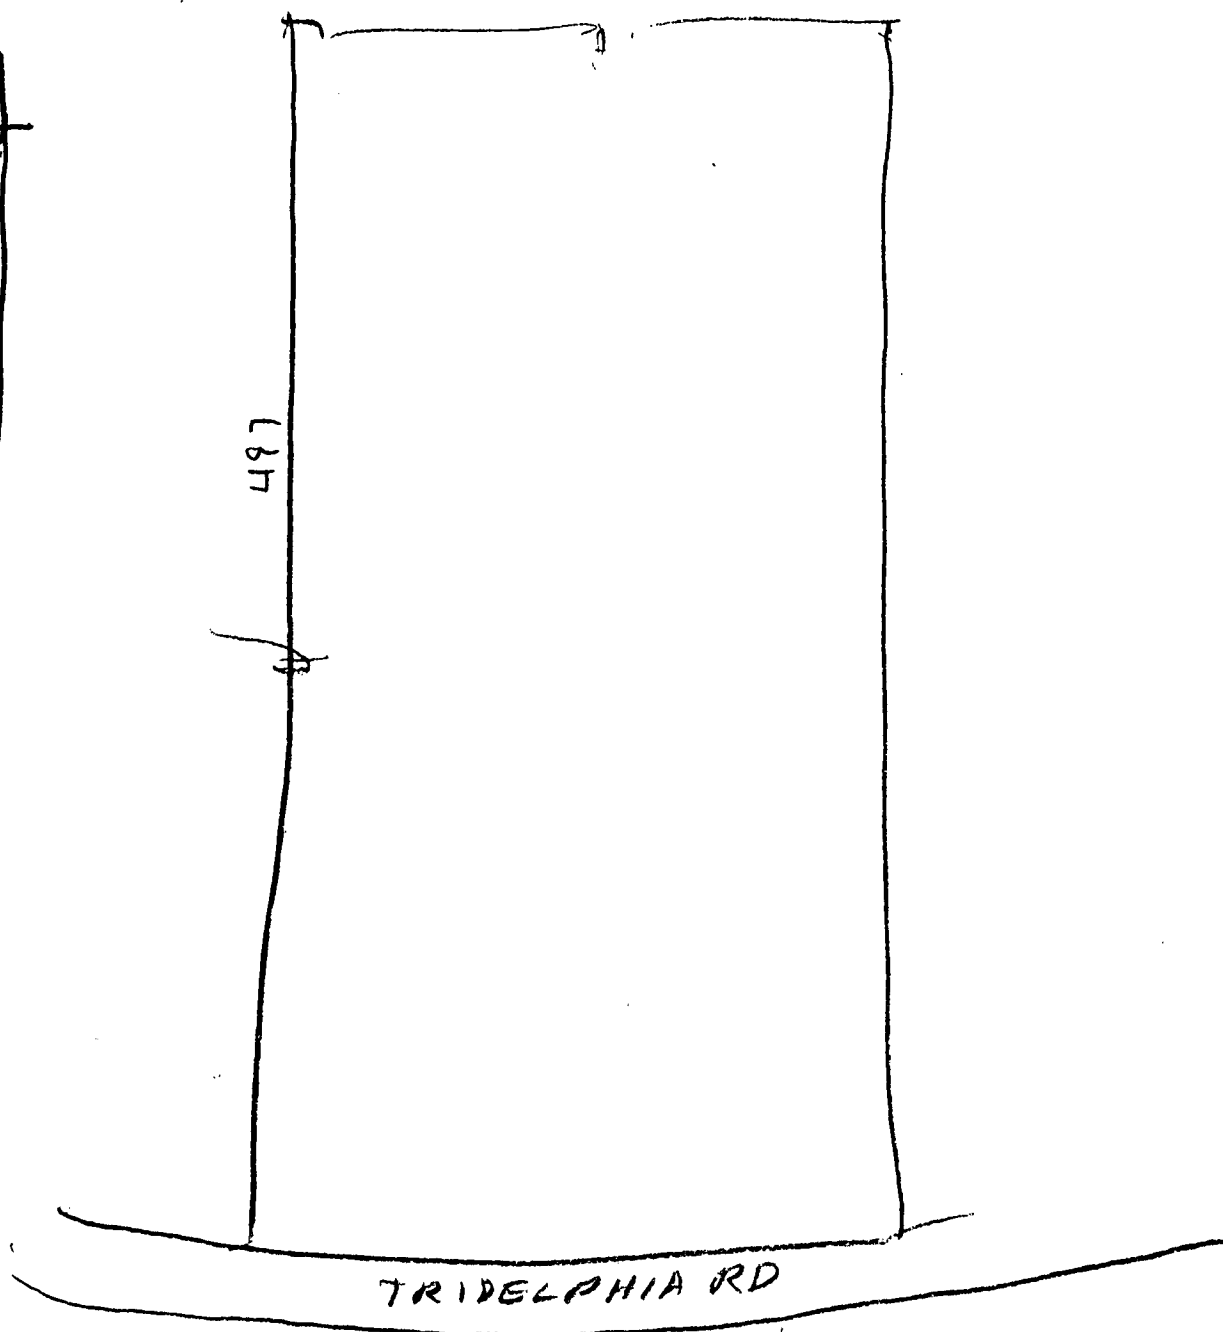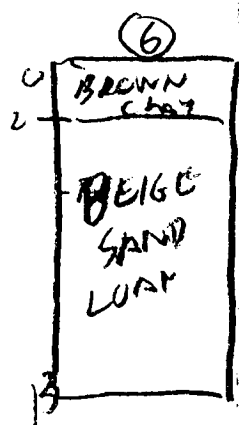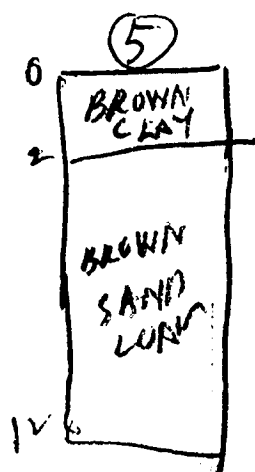

5/6/86	5S	4	1053	1055	1055	1057	2
5/6/86	5V	12	LOOKS	OK			
	6S	3/2	1100	1101	1101	1102	1
	6V	13	LOOKS	OK			

B 1 7213 <small>(THIS NUMBER IS TO BE PUNCHED IN COLS. 3-6 ON ALL CARDS)</small>	SEQUENCE NO. (OEP USE ONLY)	STATE OF MARYLAND PERMIT TO DRILL WELL please print or type	OEP PERMIT NUMBER H0-81-2019 <small>fill in this form completely</small>
Date Received <div style="border: 1px solid black; display: inline-block; padding: 2px;"> 8 13 </div>		B 3 LOCATION OF WELL <div style="border: 1px solid black; display: inline-block; padding: 2px;"> 8 COUNTY 21 </div> <div style="border: 1px solid black; display: inline-block; padding: 2px;"> 23 SUBDIVISION 42 </div> <div style="border: 1px solid black; display: inline-block; padding: 2px;"> SECTION 44 46 LOT 48 50 </div> <div style="border: 1px solid black; display: inline-block; padding: 2px;"> 52 NEAREST TOWN 71 </div>	
OWNER INFORMATION <div style="border: 1px solid black; display: inline-block; padding: 2px;"> 15 Last Name Owner First Name 34 </div> <div style="border: 1px solid black; display: inline-block; padding: 2px;"> 36 Street or RFD 55 </div> <div style="border: 1px solid black; display: inline-block; padding: 2px;"> 57 Town 70 State Zip 76 </div>		DRILLER INFORMATION <div style="border: 1px solid black; display: inline-block; padding: 2px;"> Driller's Name 77 License No. 80 </div> <div style="border: 1px solid black; display: inline-block; padding: 2px;"> Firm Name 9120 Brown Church Rd. Mt. Airy </div> <div style="border: 1px solid black; display: inline-block; padding: 2px;"> Address 3/3/87 </div> <div style="border: 1px solid black; display: inline-block; padding: 2px;"> Signature Date </div>	
B 2 WELL INFORMATION <div style="border: 1px solid black; display: inline-block; padding: 2px;"> 1 APPROX. PUMPING RATE (GAL. PER MIN.) 5 8 12 </div> <div style="border: 1px solid black; display: inline-block; padding: 2px;"> AVERAGE DAILY QUANTITY NEEDED (GAL. PER DAY) 500 14 20 </div>		B 4 DIRECTION OF WELL FROM TOWN (CIRCLE BOX) <div style="text-align: center;"> </div>	
USE FOR WATER (CIRCLE APPROPRIATE BOX) <input checked="" type="checkbox"/> D HOME (SINGLE OR DOUBLE HOUSEHOLD UNIT ONLY) <input type="checkbox"/> F FARMING (LIVESTOCK WATERING & AGRICULTURAL IRRIGATION) <input type="checkbox"/> I INDUSTRIAL, COMMERCIAL, STATE AND FEDERAL GOV. OTHER (REQUIRES APPROPRIATION PERMIT) <input type="checkbox"/> P PUBLIC OR PRIVATE WATER COMPANY (REQUIRES APPROPRIATION PERMIT AND STATE HEALTH DEPARTMENT APPROVAL) <input type="checkbox"/> T TEST, OBSERVATION, MONITORING (MAY REQUIRE APPROPRIATION PERMIT)		NOT TO BE FILLED IN BY DRILLER HEALTH DEPARTMENT APPROVAL <div style="border: 1px solid black; display: inline-block; padding: 2px;"> COUNTY NAME A 36756 COUNTY NO. </div> <div style="border: 1px solid black; display: inline-block; padding: 2px;"> OEP SIGNATURE DATE ISSUED 10/8/87 EXP. DATE </div> <div style="border: 1px solid black; display: inline-block; padding: 2px;"> NORTH GRID 515000 EAST GRID 0793000 </div>	
APPROXIMATE DEPTH OF WELL 50 FEET APPROXIMATE DIAMETER OF WELL 6" INCH		SHOW MAJOR FEATURES OF BOX & LOCATE WELL WITH AN X SOURCES OF DRILLING WATER 1. WELL 2. 3. WRITE THE BOX NUMBER FROM THE MAP HERE <div style="border: 1px solid black; display: inline-block; padding: 2px;"> 290 E 7903 510 N 5205 </div>	
METHOD OF DRILLING (circle one) BORED (or Augered) JETTED Jetted & DRIVEN <input checked="" type="checkbox"/> AIR-ROTARY AIR-PERCussion ROTARY (Hydraulic Rotary) CABLE REVERSE-ROTARY DRIVE-POINT other		REPLACEMENT OR DEEPEMED WELLS (CIRCLE APPROPRIATE BOX) <input checked="" type="checkbox"/> N THIS WELL WILL NOT REPLACE AN EXISTING WELL <input type="checkbox"/> Y THIS WELL WILL REPLACE A WELL THAT WILL BE ABANDONED AND SEALED <input type="checkbox"/> S THIS WELL WILL REPLACE A WELL THAT WILL BE USED AS A STANDBY <input type="checkbox"/> D THIS WELL WILL DEEPM AN EXISTING WELL PERMIT NUMBER OF WELL TO BE REPLACED OR DEEPEMED (IF AVAILABLE) 41 52	
Not to be filled in by driller (OEP USE ONLY) APPROP. PERMIT NUMBER 54 GAP 63 FORCE 85 WRITE INITIALS IN BOX. PERMIT NO. H0-81-2019 SPECIAL CONDITIONS D30-1845		DRAW A SKETCH BELOW SHOWING LOCATION OF WELL IN RELATION TO NEARBY TOWNS AND ROADS AND GIVE DISTANCE FROM WELL TO NEAREST ROAD JUNCTION 	

C1	2354	SEQUENCE NO. (OEP USE ONLY)	STATE OF MARYLAND WELL COMPLETION REPORT		THIS REPORT MUST BE SUBMITTED WITHIN 45 DAYS AFTER WELL IS COMPLETED.	
		(THIS NUMBER IS TO BE PUNCHED IN COLS. 3-6 ON ALL CARDS)	FILL IN THIS FORM COMPLETELY PLEASE PRINT OR TYPE		COUNTY NUMBER	A 56756
DATE Received		DATE WELL COMPLETED		Depth of Well		
[] [] [] [] [] []		02/19/88		22 65 26 (TO NEAREST FOOT)		
OWNER		last name		first name		
STREET OR RFD		TOWN		PERMIT NO.		
SUBDIVISION		SECTION		LOT		
[] [] [] [] [] []		[] [] [] [] [] []		FROM "PERMIT TO DRILL WELL"		
[] [] [] [] [] []		[] [] [] [] [] []		28 29 30 31 32 33 34 35 36 37		

OWNER	last name	first name	TOWN	PERMIT NO.
STREET OR RFD				
SUBDIVISION	SECTION	LOT		

WELL LOG		
Not required for driven wells		
STATE THE KIND OF FORMATIONS PENETRATED, THEIR COLOR, DEPTH, THICKNESS AND IF WATER BEARING		
DESCRIPTION (Use additional sheets if needed)	FEET	Check if water bearing
	FROM	TO
Top Soil	0	2
Sandy	2	44
Sand Stone	44	50
Micka	50	60
Sand Stone	60	65
Micka	65	65

GROUTING RECORD	
WELL HAS BEEN GROUTED (Circle Appropriate Box)	
TYPE OF GROUTING MATERIAL	
CEMENT	BENTONITE CLAY
CM	BC
NO. OF BAGS 12 NO. OF POUNDS 1200	
GALLONS OF WATER 22	
DEPTH OF GROUT SEAL (to nearest foot)	
from 0 ft. to 40 ft.	
(enter 0 if from surface)	

CASING RECORD										
casing types insert appropriate code below										
ST	CO									
PL	OT									
STEEL	CONCRETE									
PLASTIC	OTHER									
MAIN Nominal diameter Total depth										
CASING top (main) casing of main casing										
TYPE (nearest inch) (nearest foot)										
PL	6	65								
60	61	62	63	64	65	66	67	68	69	70

OTHER CASING (if used)	
diameter	depth (feet)
inch	from to
[] []	[] [] [] [] [] []

SCREEN RECORD		
screen type or open hole		
insert appropriate code below		
ST	BR	HO
STEEL	BRASS	OPEN
PL	OT	
PLASTIC	OTHER	

C2	
DEPTH (nearest ft.)	
1 40 73 105	
EACH SCREEN	
1 2 3 4 5 6 7 8 9 10 11 12 13 14 15 16 17 18 19 20 21 22 23 24 25 26 27 28 29 30 31 32 33 34 35 36 37 38 39 40 41 42 43 44 45 46 47 48 49 50 51	
SLOT SIZE 1 2 3	
DIAMETER OF SCREEN (NEAREST INCH)	
56 60	

GRAVEL PACK	
IF WELL DRILLED WAS FLOWING WELL INSERT F IN BOX 68	
[]	

OEP USE ONLY (NOT TO BE FILLED IN BY DRILLER)		
T	(E.R.O.S.)	WQ
70	72	74 75 76
TELESCOPE CASING	LOG INDICATOR	OTHER DATA

C3		
PUMPING TEST		
HOURS PUMPED (nearest hour)		
6		
PUMPING RATE (gal. per min. to nearest gal.)		
2		
METHOD USED TO MEASURE PUMPING RATE		
Bucket		
WATER LEVEL (distance from land surface)		
BEFORE PUMPING		
10		
WHEN PUMPING		
105		
TYPE OF PUMP USED (for test)		
A	P	T
air	piston	turbine
C	R	O
centrifugal	rotary	other (describe below)
J	S	
jet	submersible	

PUMP INSTALLED	
DRILLER WILL INSTALL PUMP YES NO	
(CIRCLE) (YES or NO)	
IF DRILLER INSTALLS PUMP, THIS SECTION MUST BE COMPLETED FOR ALL WELLS EXCEPT HOME USE	
TYPE OF PUMP INSTALLED	
PLACE (A,C,J,P,R,S,T,O)	
IN BOX - SEE ABOVE:	
CAPACITY:	
GALLONS PER MINUTE	
(to nearest gallon)	
PUMP HORSE POWER	
PUMP COLUMN LENGTH	
(nearest ft.)	
CASING HEIGHT (circle appropriate box and enter casing height)	
+ above	
- below	
LAND SURFACE	
(nearest foot)	

LOCATION OF WELL ON LOT	
SHOW PERMANENT STRUCTURE SUCH AS BUILDING, SEPTIC TANKS, AND/OR LANDMARKS AND INDICATE NOT LESS THAN TWO DISTANCES (MEASUREMENTS TO WELL)	
[Diagram showing well location on lot with distances 100' and 75' marked]	

CIRCLE APPROPRIATE LETTER	
A A WELL WAS ABANDONED AND SEALED WHEN THIS WELL WAS COMPLETED	
E ELECTRIC LOG OBTAINED	
P TEST WELL CONVERTED TO PRODUCTION WELL	

I HEREBY CERTIFY THAT THIS WELL HAS BEEN CONSTRUCTED IN ACCORDANCE WITH COMAR 10.17.13 "WELL CONSTRUCTION" AND IN CONFORMANCE WITH ALL CONDITIONS STATED IN THE ABOVE CAPTIONED PERMIT, AND THAT THE INFORMATION PRESENTED HEREIN IS ACCURATE AND COMPLETE TO THE BEST OF MY KNOWLEDGE.	
---	--

DRILLERS IDENT. NO. 273	
DRILLERS SIGNATURE	
(MUST MATCH SIGNATURE ON APPLICATION)	
SITE SUPERVISOR (sign. of driller or journeyman responsible for sitework if different from permittee)	

Page 1 of 1
Date 2/19/88

Review OK SA 3-5-88

FIELD DATA SHEET
HOWARD COUNTY WELL YIELD TEST

Well Permit No. HO - 81-2019
Location of property (road) Trudolph Rd
Subdivision Trudolph Est Lot 1 Block Plat Sec.
Well Driller Ralph Mayne Owner Randall Jacobson

Depth of well 265 ft
Distance of measuring point (M.P.) above ground 2 ft
Static water level (S.W.L.) below M.P. 10 ft

I. High rate pumping -- reservoir drawdown

Time pump started 7:10 Pumping rate 10 G.P.M
Total time 20 min to reach pumping water level 105 ft. below M.P.


II. Recovery pump test data - observations to be recorded every 15 minutes

TIME (in 15 minute intervals)	WATER LEVEL below M.P.	PUMPING RATE time to fill 1 gallon bucket	FLOW METER READING (if used)	CALCULATED FLOW (gallons per minute)
7:30	105'	27 sec		2.5 G.P.M
7:45	105'	27 sec		2'
8:00	105'	27 sec		2'
8:15	105'	27 sec		2'
8:30	105'	27 sec		2'
8:45	105'	27 sec		2'
9:00	105'	27 sec		2'
9:15	105'	27 sec		2'
9:30	105'	27 sec		2'
9:45	105'	27 sec		2'
10:00	105'	27 sec		2'
10:15	105'	27 sec		2'
10:30	105'	27 sec		2'
10:45	105'	27 sec		2'
11:00	105'	27 sec		2'
11:15	105'	27 sec		2'
11:30	105'	27 sec		2'
11:45	105'	27 sec		2'
12:00	105'	27 sec		2'
12:15	105'	27 sec		2'
12:30	105'	27 sec		2'
12:45	105'	27 sec		2'
1:00	105'	27 sec		2'
1:15	105'	27 sec		2'

55' 40 gpm 12 bags

135 105' 27 sec 2'

4

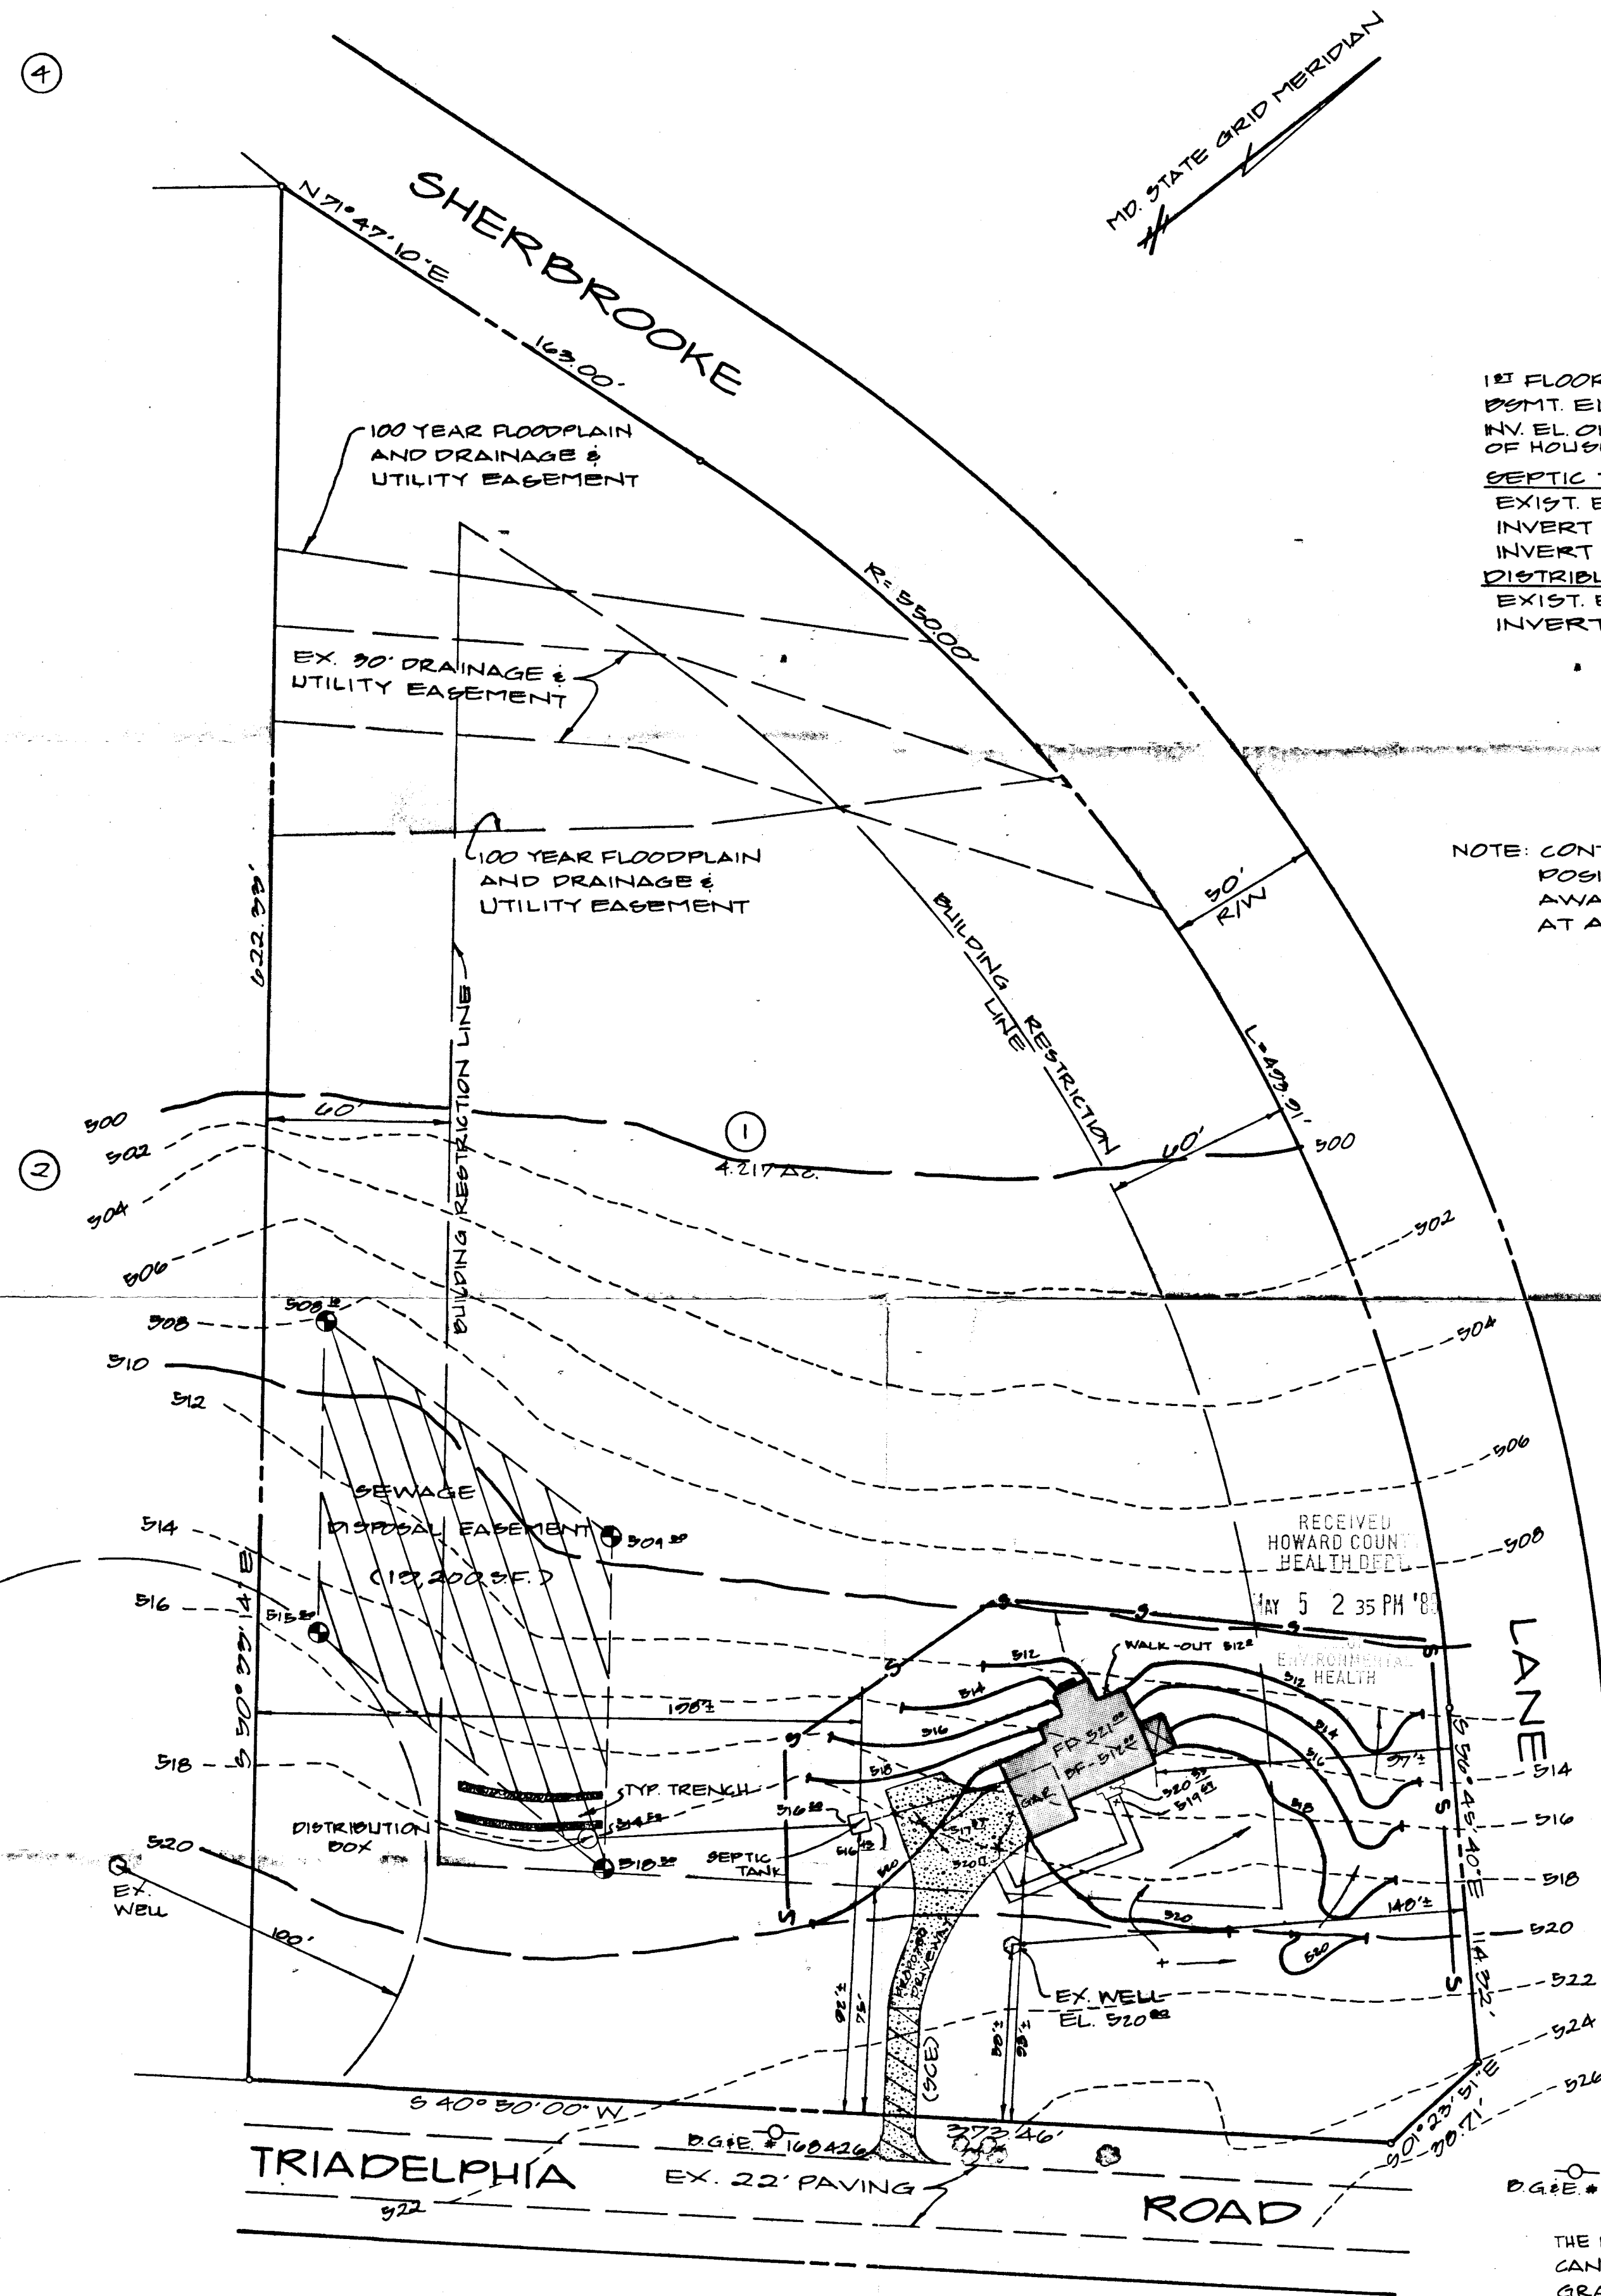

1ST FLOOR EL.	- 521.00
BSMT. EL.	- 512.00
INV. EL. OUT OF HOUSE	- 517.87
SEPTIC TANK	
EXIST. EL.	- 518.00
INVERT IN	- 516.45
INVERT OUT	- 516.22
DISTRIBUTION BOX	
EXIST. EL.	- 518.00
INVERT IN	- 514.82

NOTE: CONTRACTOR TO PROVIDE POSITIVE DRAINAGE AWAY FROM FOUNDATION AT ALL TIMES.

REVISED #18276
Date: 5-4-88
Comments:

5/5/88
Approved
S. Adel
elwarras
same

RECEIVED
HOWARD COUNTY
HEALTH DEPT.
MAY 5 2 35 PM '88
ENVIRONMENTAL
HEALTH

THE BASEMENT OF THIS HOUSE CANNOT BE SEWERED BY GRAVITY.

— S — S — SILT FENCE
(SCE) - STABILIZED CONSTRUCTION ENTRANCE

I CERTIFY THAT THE ABOVE MEASUREMENTS AND ELEVATIONS ARE ACTUAL AND CORRECT FOR THIS PROPERTY.



VITTI, ROBEL & ASSOCIATES, INC.
ENGINEERING & SURVEYING
1717 YORK ROAD SUITE 2B LUTHERVILLE, MD 21093
(301) 252-4552

Mark L. Robel
MARK L. ROBEL, #539
4-26-88
DATE

SITE PLAN
LOT 1
"TRIADELPHIA ESTATES"
4th ELECT. DIST.
SCALE: 1"=40'
HOWARD CO., MD.
APRIL, 1988


SET BACKS

REAR PL	10'
SIDE PL	10'
HOUSE	10'
SEPTIC	20'
WELL	10'

PRIVATE WELL & SEPTIC

NOTE:

A VACUUM BREAKER WILL BE
INSTALLED AS REQ'D.

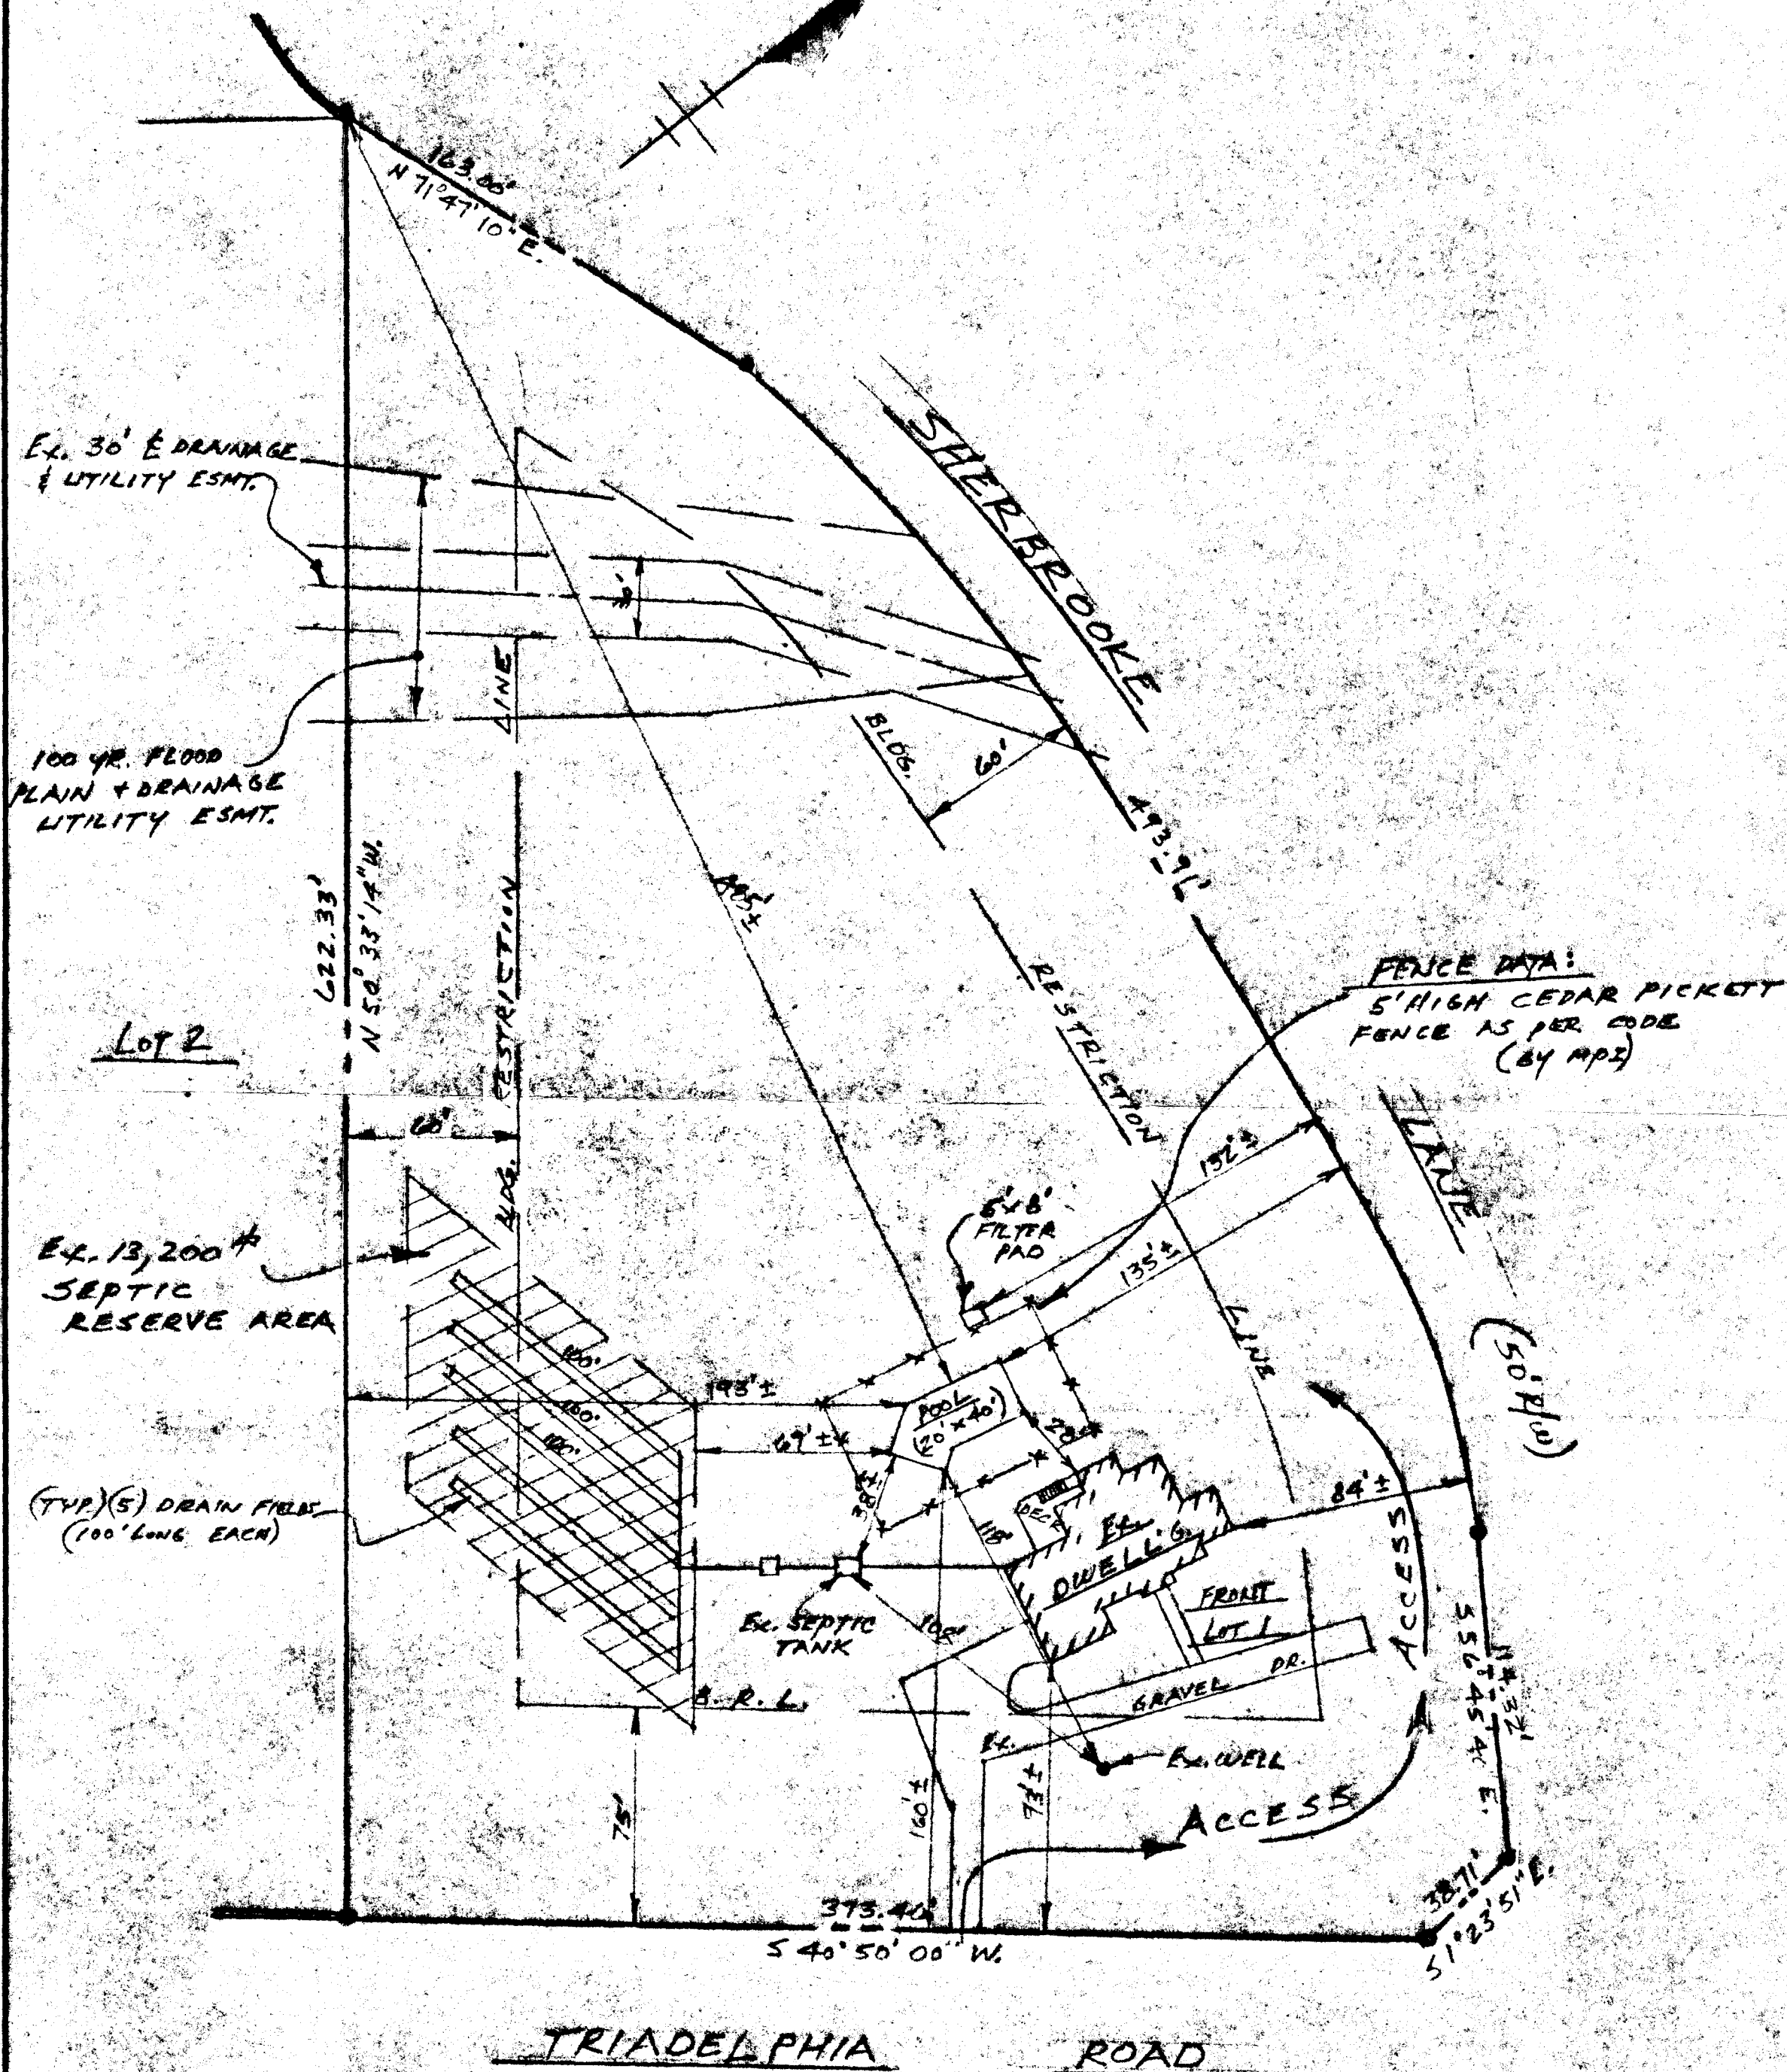

SITE PLAN

SCALE: 1" = 50'

14820 TRIADELPHIA RD.

HOWARD COUNTY, MD.

"TRIADELPHIA ESTATES"

4TH ELECTION DIST. LOT 1