

9/19/85
AP

9-19-85
approved
S. Abel

0 7153' (Not in file)

PERMIT

P 36003

A REPAIR

SEWAGE DISPOSAL SYSTEM

MARYLAND STATE DEPARTMENT OF HEALTH*

HOWARD COUNTY
BUREAU OF ENVIRONMENTAL HEALTH
992-2330

05-345580

INDEXED

ELLICOTT CITY

DISTRICT _____

DATE 9/18/88

Jack Fyock IS PERMITTED TO INSTALL _____ ALTER X

ADDRESS _____ PHONE 988-9270

SUBDIVISION Moorsefield ROAD 11801 Wayneridge Street 3

PROPERTY OWNER Carleen

ADDRESS 11801 Wayneridge Street
Fulton, Maryland

IF GARBAGE GRINDER IS USED INCREASE SEPTIC TANK CAPACITY BY 50% AND ABSORPTION AREA BY 22%.

GARBAGE GRINDER? YES _____ NO _____

SEPTIC TANK CAPACITY _____ GALLONS NUMBER OF BEDROOMS _____

REPAIR - CALL FOR INSPECTION WHEN GROUND IS OPENED UP SO SANITARIAN CAN RECOMMEND

REPAIR. 3'-10' 7" STONE - SANDY LOAM SOIL AT 3'-10"

TRENCH OFF LOWER DRYWELL. SAND

BUILDING PERMIT SIGNED AND RETURNED

10-17-03 B00144592-DECK

PLANS APPROVED BY C. Williams DATE 9/17/85

COVER NO WORK UNTIL INSPECTED AND APPROVED.

NEITHER THE HOWARD COUNTY COUNCIL NOR THE HEALTH DEPARTMENT IS RESPONSIBLE FOR THE SUCCESSFUL OPERATION OF ANY SYSTEM.

NOTE: IF TRENCH IS USED CALL FOR INSPECTION BEFORE AND AFTER PLACING GRAVEL IN TRENCH.

NOTE: NO DRY WELL SHALL EXCEED 15 FOOT IN DIAMETER. NO ABSORPTION TRENCH TO EXCEED 100 FEET IN LENGTH.

NOTE: ALL PIPE FROM HOUSE TO SEPTIC TANK MUST BE CAST IRON OR SCHEDULE 40 PVC OR ABS.


PERMIT VOID AFTER THREE YEARS.

NOTE: INSTALL STAND PIPE ON SEPTIC TANK AND DRY WELL. STAND PIPES MUST BE 6 INCHES IN DIAMETER. CAST IRON, CONCRETE OR TERRA COTTA, OR PVC OR ABS ACCEPTED. IF TOP OF SEPTIC TANK IS DEEPER THAN 3 FEET MANHOLE TO GRADE REQUIRED.

*INSTALLER IS RESPONSIBLE FOR OBTAINING FINAL APROVAL ON THIS PERMIT

*CALL 992-2330 FOR INSPECTION OF SEPTIC SYSTEMS.

P 36003

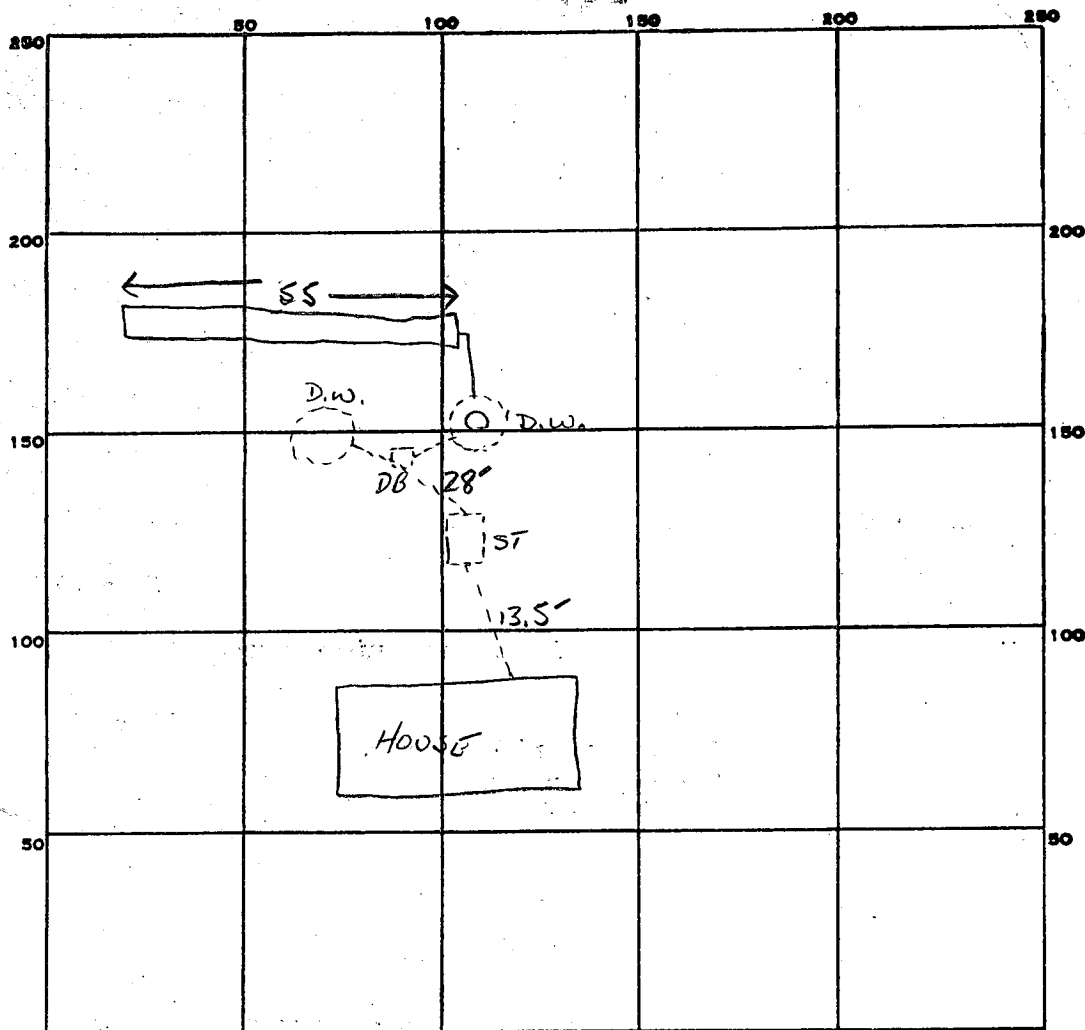

INDICATE NORTH. - NAME ADJOINING ROADWAY AS BASE LINE.

WAYNERIDGE ST

PERMIT CARD ☒

SEPTIC TANK, LEVEL EXISTING

CLEANOUTS ☒ D.W. (LOW)

DISTRIBUTION BOX, LEVEL EXISTING

TILE FIELD, DEPTH 10 FT. TRENCH WIDTH 2 FT.

GRAVEL DEPTH 7 FT IX TOTAL LENGTH 55 FT.

NUMBER OF TRENCHES 1 ONE SIDE WALL TOTAL BOTTOM AREA 38 50

SEEPAGE PITS, INSIDE DIAMETER FT. DEPTH BELOW INLET FT.

ABSORBENT AREA 385 SQ. FT.

REMARKS 9-19-85 OK TO ADD STONE TO TRENCH. SAGEL

DATE SYSTEM APPROVED

9-19-85

INSPECTOR

S. Abel

2/5/64 OKDW

PERMIT

07939
07/35

SEWAGE DISPOSAL SYSTEM

MARYLAND STATE DEPARTMENT OF HEALTH

HOWARD COUNTY

ELLICOTT CITY

DISTRICT

DATE

INDEXED

Elwood Seago

IS PERMITTED TO INSTALL ☒ ALTER

ADDRESS

PHONE

A SEWAGE DISPOSAL SYSTEM LOCATED AT

SUBDIVISION

Manassas

11501
ROAD

Wayne Ridge Rd. 3 E
FWITH

PROPERTY OWNER

ADDRESS

(Fleurette Carleen)

SPECIFICATIONS

for 3 bedrooms

DRAIN FIELD DEPTH FEET, BOTTOM AREA SQ. FT.

SEEPAGE PITS ☒

ABSORBENT SIDEWALL AREA

*11' x 11' deep below main
inlet 3 ft. below
ground*

SEPTIC TANK CAPACITY 750 GALLONS

FOR GARBAGE GRINDER, INCREASE DISPOSAL AREA 22% & TANK CAPACITY 50%

on septic system 130 ft. from front lot line and

66 ft. from left lot line as seen when facing lot from

Wayne Ridge Rd.

PLANS APPROVED BY

J. Hensinger


DATE

7-23-63

FILL SEPTIC TANK AND DISTRIBUTION BOX WITH WATER BEFORE CALLING FOR AN INSPECTION. COVER NO UNTIL INSPECTED AND APPROVED.

NEITHER THE HOWARD COUNTY COMMISSIONERS NOR THE HEALTH DEPARTMENT IS RESPONSIBLE FOR SUCCESSFUL OPERATION OF ANY SYSTEM.

11
 31
 11
 33
 34
 12
 68
 34
 429

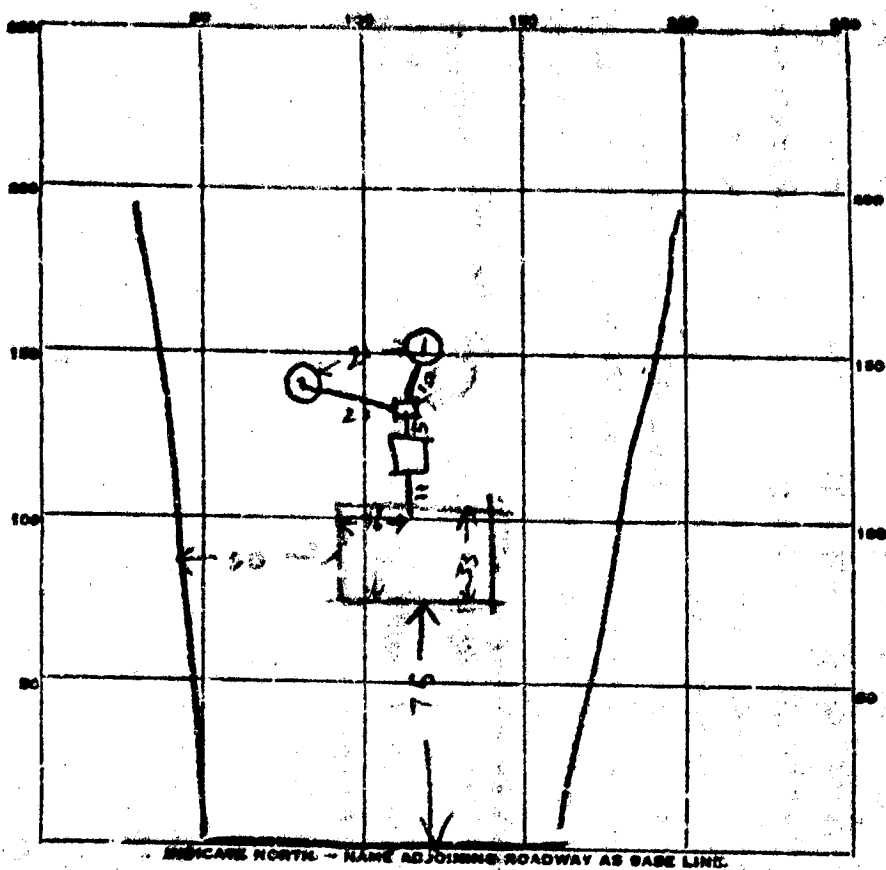

PERMIT CARD OK

SEPTIC TANK, LEVEL OK 750 concrete
top is 1 ft below grade

CLEARANCES OK

DISTRIBUTION BOX, LEVEL OK

TILE FIELD, DEPTH _____ FT. TRENCH WIDTH _____ FT.

GRAVEL DEPTH _____ IN. TOTAL LENGTH _____ FT.

NUMBER OF TRENCHES _____ TOTAL BOTTOM AREA _____

SEEPAGE PITS, INSIDE DIAMETER 400 FT. DEPTH BELOW INLET 5 ft not counting stone

ABSORBENT AREA 496 SQ. FT. stone

REMARKS Dry Well #1 - inlet 3 1/2 ft below grade. Depth below
is 8 ft. Diameter top is 8 ft. About 1 ft stone around dry well
8 x 3.1 x 8 = 200 sq ft not counting stone 10 x 3.1 x 8 = 249 sq ft not counting stone
Dry Well #2 - inlet 3 1/2 ft below grade. Depth below inlet
diameter top is 8 ft. About 1 ft stone around dry well
8 x 3.1 x 8 = 200 sq ft not counting stone 10 x 3.1 x 8 = 249 sq ft not counting stone

DATE SYSTEM APPROVED 5/12/64 INSPECTOR Perkins

WAGNER RIDGE ST.

SOIL AUGER FINDING _____
TESTED BY _____
REMARKS *BT 6 ft not good*
ALSO PRESENT *N. T. McQuinn* LOT NO. *38.*

11801 Wayneridge Street
Fulton, MD
Lot 3 Block B
Mooresfield

B00144592

October 3, 2003

Mr. Steven Kreig
Supervisor
Howard County Health Department
Bureau of Environmental Health
3525 Ellicott Mills Drive
Suite H
Ellicott City, MD 21043

Dear Mr. Kreig:

I would like to apply for a waiver on a request to build a deck within 10 feet of our septic tank. We agree that in the event the current tank would need to be replaced, we would relocate it more than 10 feet from the edge of the deck.

We feel that there is adequate access to service the tank in its current location once the deck is completed.

Thank you for your consideration. We can be contacted at 301-490-5492 if you have any questions.

Sincerely,

Nichelle Cinotti

10/17/03- Proposal Acceptable

Adequate access ^{to tank} OK - (SRK)

COMAR not specific on
10' standard, access is the intent.

NOTE:

THE RECORD PLAT AND/OR DEED WAS FOUND TO BE ONE OR MORE OF THE FOLLOWING:

1. MATHEMATICALLY INCORRECT
2. ILLEGIBLE
3. INCOMPLETE
4. NOT FOUND AT ALL
5. DOES NOT AGREE WITH EXISTING FIELD MONUMENTATION
6. DOES NOT AGREE WITH TAX ASSESSMENT RECORDS
7. DOES NOT AGREE WITH THE APPARENT LINES OF POSSESSION
8. DOES NOT AGREE WITH PRIOR SURVEYS


INFORMATION SHOWN HEREON IS A COMBINED INTERPRETATION OF SOME OR ALL OF THE ABOVE

A BOUNDARY SURVEY IS RECOMMENDED TO DETERMINE THE EXACT LOCATION OF BOUNDARY LINES & IMPROVEMENTS.

ENCROACHMENTS MAY EXIST.


WAYNERIDGE STREET

S 61°35'40" E R - 46.1 10
L - 105 16

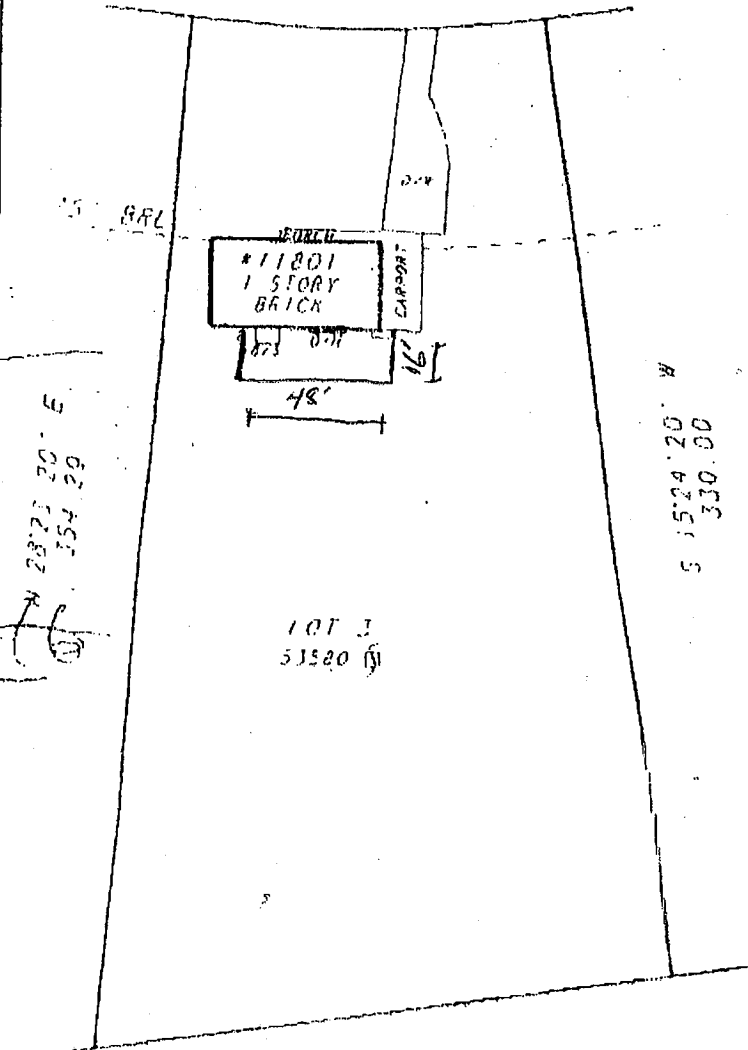

[Handwritten signature]

[Handwritten signature]

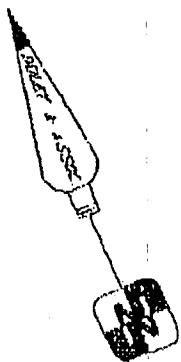

[Handwritten number: 800144592]

N 74°35'40" W
198.48

LOCATION SURVEY OF:

11801 WAYNERIDGE STREET

LOT 3 BLOCK B

PLAT ONE

MOORESFIELD

5TH ELECTION DISTRICT

PLAT BOOK 9 PAGE 5

HOWARD COUNTY MD

SCALE: 1"=60' DATE: 6-23-01

CASE # 01-07-0117

CARLEEN

FILE # 013122-019

DRAWN BY: B.G.

A LAND SURVEYING AND DESIGN COMPANY



DULEY
AND
ASSOCIATES, INC.
SERVING D.C., MD., VA.




HOUSE LOCATION SURVEYS
BOUNDARY SURVEYS - ALTA SURVEYS
TOPOGRAPHIC SURVEYS - SITE PLANS

8450 PENNSYLVANIA AVE
UPPER MARLBORO, MD. 20775

PHONE: 301-945-1111
PHONE: 1-800-84-DULEY

FAX: 301-888-5116
FAX: 888-55-DULEY

SURVEYOR'S CERTIFICATE

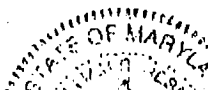

I HEREBY STATE THAT THE EXISTING PLURAL IMPROVEMENTS ON THE LAND DESCRIBED HEREIN WERE FULLY ESTABLISHED AS SHOWN ON THE PLAT.

WELL
0

DRIVEWAY

HOUSE

CAR
PORT

DOOR

DECK

16'

3'

3'

SEPTIC
TANK

STEPS
TO GRADE

48'

ROOF

CAR
PORT

8'

☒ - TANK

