

11/8/85 NOON

approved
11/15/85 S. ABEL, C. Williams

PERMIT

P 36030

A REPAIR

SEWAGE DISPOSAL SYSTEM

MARYLAND STATE DEPARTMENT OF HEALTH

HOWARD COUNTY

BUREAU OF ENVIRONMENTAL HEALTH

992-2330 461-7733

INDEXED

ELLICOTT CITY

DISTRICT 2ND

DATE 9/24/85

Melroy Plumbing (max) IS PERMITTED TO INSTALL X ALTER

ADDRESS 313 Glenrae Drive, Baltimore, Maryland 21228 PHONE 747-0900

SUBDIVISION _____ ROAD River Road LOT _____

PROPERTY OWNER Simkins Industries
River Road

ADDRESS Ellicott City, Maryland 21043

IF GARBAGE GRINDER IS USED INCREASE SEPTIC TANK CAPACITY BY 50% AND ABSORPTION AREA BY 22%.

GARBAGE GRINDER? YES _____ NO _____

SEPTIC TANK CAPACITY 2000 GALLONS NUMBER OF BEDROOMS _____

EVERLAST

Installation of a seal holding septic tank. Outlet pipe is to be sealed. Also, an alarm device is required.

PLANS APPROVED BY C. Williams DATE 9/24/85

COVER NO WORK UNTIL INSPECTED AND APPROVED.

NEITHER THE HOWARD COUNTY COUNCIL NOR THE HEALTH DEPARTMENT IS RESPONSIBLE FOR THE SUCCESSFUL OPERATION OF ANY SYSTEM.

NOTE: IF TRENCH IS USED CALL FOR INSPECTION BEFORE AND AFTER PLACING GRAVEL IN TRENCH.

NOTE: NO DRY WELL SHALL EXCEED 15 FOOT IN DIAMETER. NO ABSORPTION TRENCH TO EXCEED 100 FEET IN LENGTH.

NOTE: ALL PIPE FROM HOUSE TO SEPTIC TANK MUST BE CAST IRON OR SCHEDULE 40 PVC OR ABS.

PERMIT VOID AFTER THREE YEARS.


NOTE: INSTALL STAND PIPE ON SEPTIC TANK AND DRY WELL. STAND PIPES MUST BE 6 INCHES IN DIAMETER. CAST IRON, CONCRETE OR TERRA COTTA, OR PVC OR ABS ACCEPTED. IF TOP OF SEPTIC TANK IS DEEPER THAN 3 FEET MANHOLE TO GRADE REQUIRED.

***INSTALLER IS RESPONSIBLE FOR OBTAINING FINAL APPROVAL ON THIS PERMIT**

*CALL 992-2330 FOR INSPECTION OF SEPTIC SYSTEMS.

EH - 2-1082

A 36030
Repair

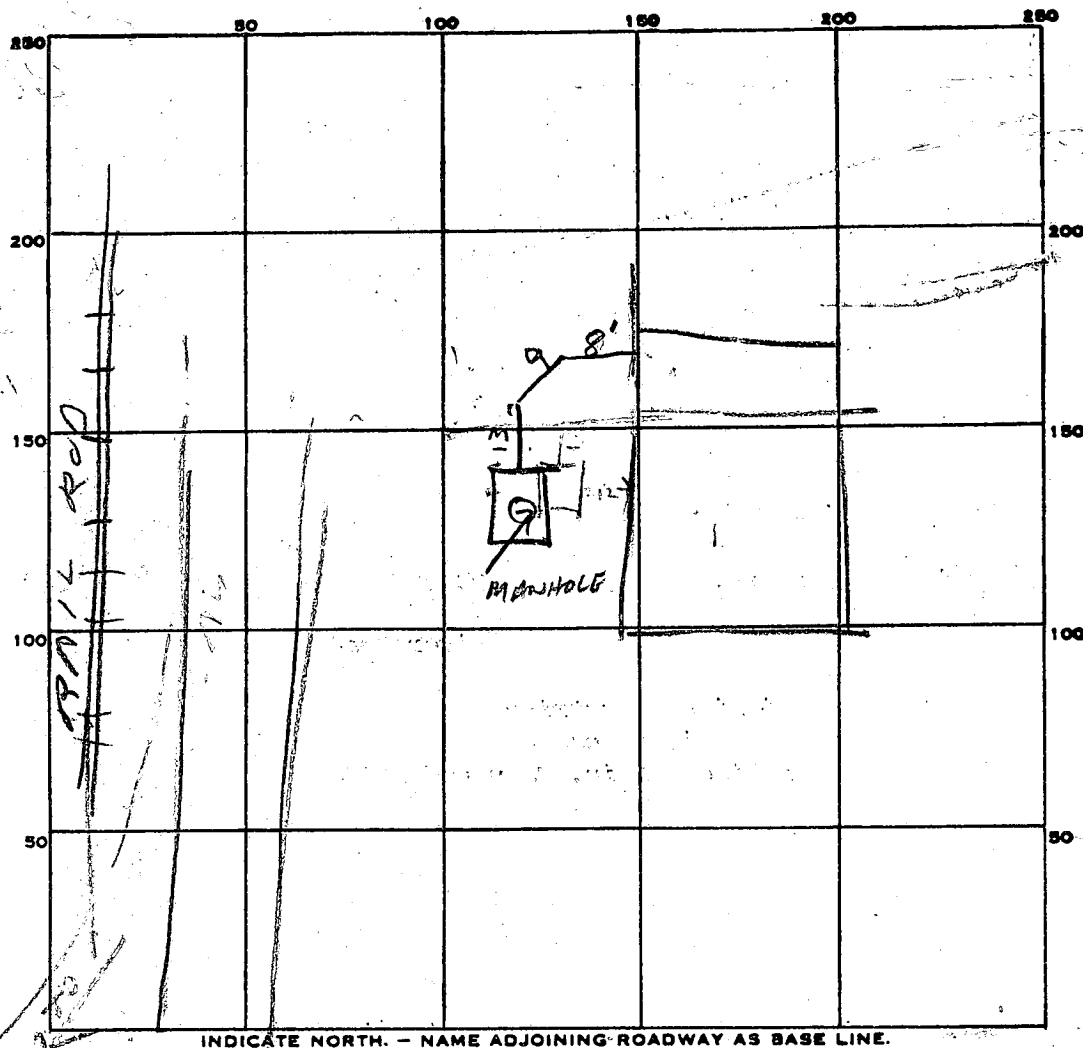

LAB SINK
 > 50 GPD
 HCL 1%
 Amm Molybdate
 Gallic Acid
 H₂SO₄ 1%

INDICATE NORTH. - NAME ADJOINING ROADWAY AS BASE LINE.

PERMIT CARD _____

SEPTIC TANK, LEVEL OK 2000

CLEANOUTS MANHOLE

DISTRIBUTION BOX, LEVEL _____

TILE FIELD, DEPTH _____ FT. TRENCH WIDTH _____ FT.

GRAVEL DEPTH _____ IN. TOTAL LENGTH _____ FT.

NUMBER OF TRENCHES _____ TOTAL BOTTOM AREA _____

SEEPAGE PITS, INSIDE DIAMETER _____ FT. DEPTH BELOW INLET _____ FT.

ABSORBENT AREA _____ SQ. FT.

REMARKS 11/8/85 - 2000 GAL TANK SET. HOOK UP TANK.

INSTALL ALARM SYSTEM AND MANHOLE & CALL RH.

11-15-85 ALARM IN PLACE - TEST FUNCTIONING; ALL PLUMBING IN
EXISTING BR (ie. SHOWER, SINK, AND TOILET) DISCONNECTED; SINK IN CHEMICAL
LAB CONNECTED TO STAINLESS STEEL TANK IN BASEMENT w/ DISCHARGE TO RIVER;
PERMIT FOR DISCHARGE TO BE MAILED TO OUR OFFICE.

DATE SYSTEM APPROVED 11-15-85 INSPECTOR S. Abel