

10/9/85  
~~10/9/85~~  
10/9/85  
3 PM

approved  
10/27/85  
C. Williams  
5TH  
P 31034

# PERMIT

SEWAGE DISPOSAL SYSTEM

A REPAIR

MARYLAND STATE DEPARTMENT OF HEALTH\*

05-342155

ELLICOTT CITY

HOWARD COUNTY  
BUREAU OF ENVIRONMENTAL HEALTH  
992-2330

INDEXED

DISTRICT \_\_\_\_\_

DATE 9/27/85

Arnolds Backhoe & Septic Service, Inc. IS PERMITTED TO INSTALL \_\_\_\_\_ ALTER X

ADDRESS 7212 Woodbine Road, Woodbine, Maryland 21797 PHONE 829-1504

SUBDIVISION \_\_\_\_\_ ROAD 6302 Trotter Road LOT \_\_\_\_\_

PROPERTY OWNER Mike Baluck PHONE: 531-2197

ADDRESS 6302 Trotter Road  
Clarksville, Maryland 21029

IF GARBAGE GRINDER IS USED INCREASE SEPTIC TANK CAPACITY BY 50% AND ABSORPTION AREA BY 22%.

GARBAGE GRINDER? YES \_\_\_\_\_ NO \_\_\_\_\_

SEPTIC TANK CAPACITY \_\_\_\_\_ GALLONS NUMBER OF BEDROOMS \_\_\_\_\_

REPAIR - CALL FOR INSPECTION WHEN GROUND IS OPENED UP SO SANITARIAN CAN RECOMMEND

REPAIR.

KITCHEN + LAUNDRY WATER PIPED DIRECTLY TO DRYWELL. INSTALL OUTLET PIPE

ON DRYWELL OR REPIPE KITCHEN + LAUNDRY INTO SEPTIC TANK,

INSTALL NEW TRENCH 60' LONG WITH 6" STOVE, C.W.

PLANS APPROVED BY C. Williams DATE 9/27/85

COVER NO WORK UNTIL INSPECTED AND APPROVED.

NEITHER THE HOWARD COUNTY COUNCIL NOR THE HEALTH DEPARTMENT IS RESPONSIBLE FOR THE SUCCESSFUL OPERATION OF ANY SYSTEM.

NOTE: IF TRENCH IS USED CALL FOR INSPECTION BEFORE AND AFTER PLACING GRAVEL IN TRENCH.

NOTE: NO DRY WELL SHALL EXCEED 15 FOOT IN DIAMETER. NO ABSORPTION TRENCH TO EXCEED 100 FEET IN LENGTH.

NOTE: ALL PIPE FROM HOUSE TO SEPTIC TANK MUST BE CAST IRON OR SCHEDULE 40 PVC OR ABS.

PERMIT VOID AFTER THREE YEARS


NOTE: INSTALL STAND PIPE ON SEPTIC TANK AND DRY WELL. STAND PIPES MUST BE 6 INCHES IN DIAMETER. CAST IRON, CONCRETE OR TERRA COTTA, OR PVC OR ABS ACCEPTED. IF TOP OF SEPTIC TANK IS DEEPER THAN 3 FEET MANHOLE TO GRADE REQUIRED.

**\*INSTALLER IS RESPONSIBLE FOR OBTAINING FINAL APROVAL ON THIS PERMIT**

\*CALL 992-2330 FOR INSPECTION OF SEPTIC SYSTEMS

EH - 2-1082

P 31034  
Repair

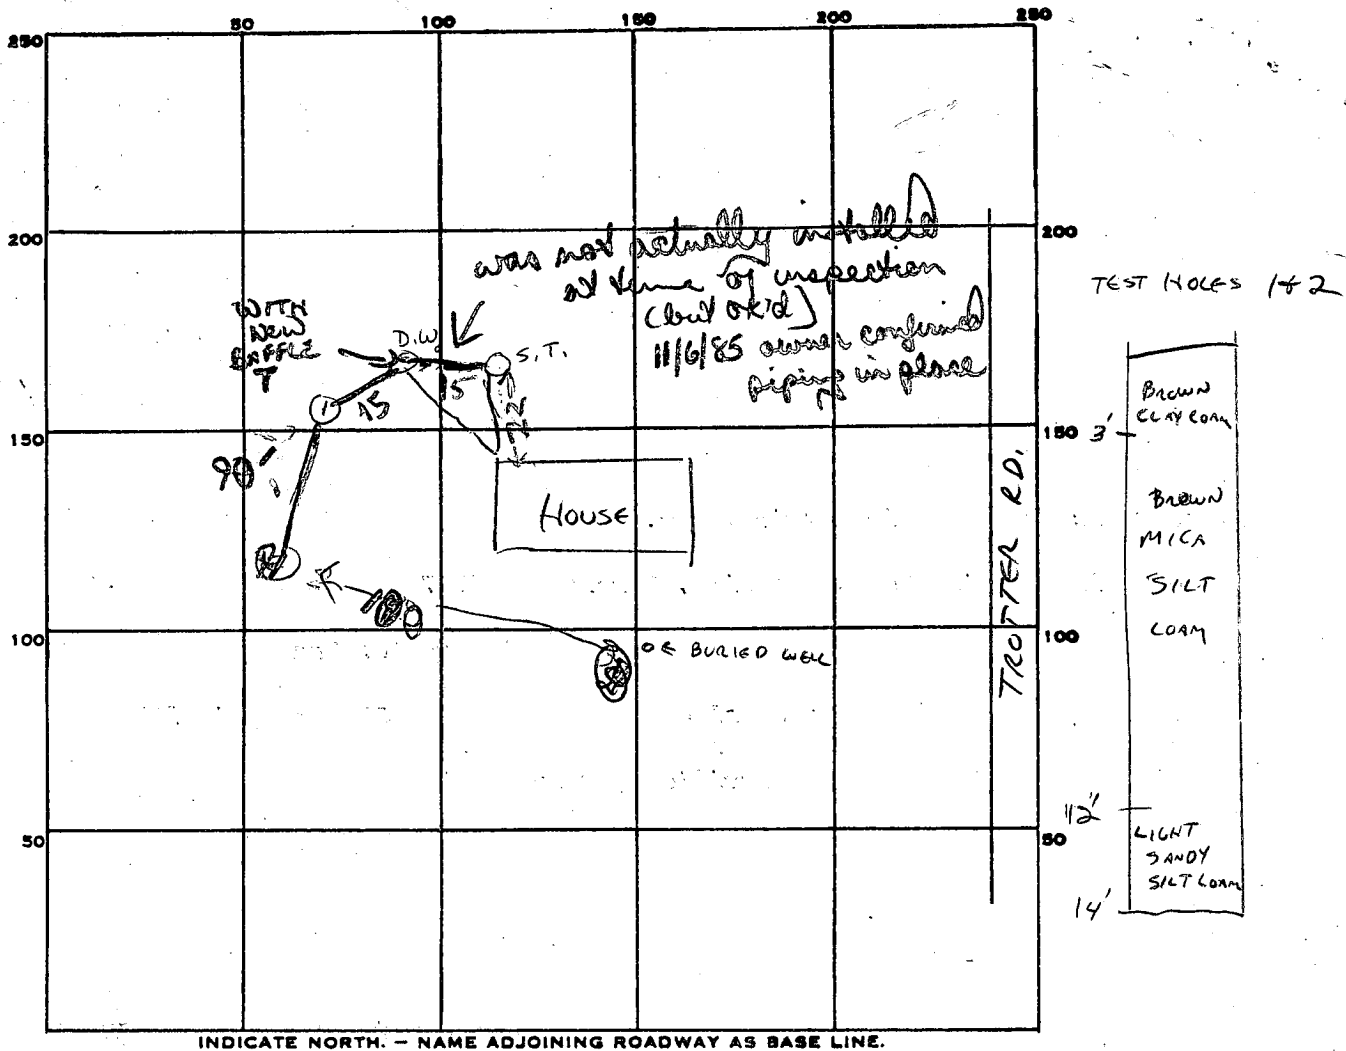

INDICATE NORTH. - NAME ADJOINING ROADWAY AS BASE LINE.

PERMIT CARD \_\_\_\_\_

SEPTIC TANK, LEVEL EXISTING

CLEANOUTS will build up new cleanouts on both S.T. + D.W. to ground level

DISTRIBUTION BOX, LEVEL N/A

TRENCH THE FIELD, DEPTH 10 FT. TRENCH WIDTH 2 FT.

GRAVEL DEPTH 6 ft TOTAL LENGTH 90 FT.  
 NUMBER OF TRENCHES 1 TOTAL BOTTOM AREA 540

11/15/85 -  
 CONV WITH OWNER -  
 BAFFLES AND CLEANOUT  
 ADDED TO DRYWELL.  
 CW

SEEPAGE PITS, INSIDE DIAMETER \_\_\_\_\_ FT. DEPTH BELOW INLET \_\_\_\_\_ FT.

ABSORBENT AREA \_\_\_\_\_ SQ. FT.

REMARKS 10/7/85 INSTALL MINIMUM OF 60' TRENCH - INLET 4'; BOTTOM 10'; CONNECT TO EXISTING DRYWELL

WITH OUTLET BAFFLE ADDED IF WASH + KITCHEN WATER IS TO REMAIN DIRECTLY PIPED TO DRYWELL.

10/9/85 303PM Stone, piping + paper in trench - OK to cover  
 need to come back + recheck for new cleanouts  
 on S.T. + D.W. OK TO COVER SYSTEM +  
 INSTALL CLEANOUTS + CALL RH BN

DATE SYSTEM APPROVED 11/6/85 NO c/o 11/15/85 owner has specs + is to install himself. Is aware that we need to see completed  
 INSPECTOR [Signature]