

4/7/86
AM

04-309756

4/11/86
septic repair
OK by
C. Williams

PERMIT

P 36736B

SEWAGE DISPOSAL SYSTEM

A REPAIR

MARYLAND STATE DEPARTMENT OF HEALTH

HOWARD COUNTY
BUREAU OF ENVIRONMENTAL HEALTH

ELLICOTT CITY

~~XXXXXX~~

INDEXED

DISTRICT _____

461-9933

DATE 4/02/86

_____ Herman Sirk _____ IS PERMITTED TO INSTALL _____ ALTER

ADDRESS 2555 Jennings Chapel Road, Woodbine, Maryland PHONE 489-4724

SUBDIVISION _____ ROAD 757 W. Watersville LOT _____

PROPERTY OWNER _____ Dale D. Diver _____

ADDRESS _____ 757 W. Watersville Road
Mt. Airy, Maryland 21771 _____

IF GARBAGE GRINDER IS USED INCREASE SEPTIC TANK CAPACITY BY 50% AND ABSORPTION AREA BY 22%.

GARBAGE GRINDER? YES _____ NO

SEPTIC TANK CAPACITY _____ GALLONS NUMBER OF BEDROOMS 3

REPAIR - CALL FOR INSPECTION WHEN GROUND IS OPENED UP SO SANITARIAN CAN RECOMMEND REPAIR.

TRENCH DFP OLD DRY WELL 37.5 SØ FT ABSORBENT
AREA ON ONE SIDE, 12 FT DEEP WITH INLET 5 FT
DEEP & FILLED WITH 7 FT OF STONE 54 FT LONG

PLANS APPROVED BY _____ C. Williams _____ DATE 4/02/86

COVER NO WORK UNTIL INSPECTED AND APPROVED.

NEITHER THE HOWARD COUNTY COUNCIL NOR THE HEALTH DEPARTMENT IS RESPONSIBLE FOR THE SUCCESSFUL OPERATION OF ANY SYSTEM.

NOTE: IF TRENCH IS USED CALL FOR INSPECTION BEFORE AND AFTER PLACING GRAVEL IN TRENCH.

NOTE: NO DRY WELL SHALL EXCEED 15 FOOT IN DIAMETER. NO ABSORPTION TRENCH TO EXCEED 100 FEET IN LENGTH.

NOTE: ALL PIPE FROM HOUSE TO SEPTIC TANK MUST BE CAST IRON OR SCHEDULE 40 PVC OR ABS.

PERMIT VOID AFTER THREE YEARS.

NOTE: INSTALL STAND PIPE ON SEPTIC TANK AND DRY WELL. STAND PIPES MUST BE 6 INCHES IN DIAMETER. CAST IRON, CONCRETE OR TERRA COTTA, OR PVC OR ABS ACCEPTED. IF TOP OF SEPTIC TANK IS DEEPER THAN 3 FEET MANHOLE TO GRADE REQUIRED.

***INSTALLER IS RESPONSIBLE FOR OBTAINING FINAL APPROVAL ON THIS PERMIT**

CALL 992-2330 FOR INSPECTION OF SEPTIC SYSTEMS.

EH - 2-1082


A Repair
36736B

TO RTE 99 ←

WATERSVILLE RD

①
CLAY TOPSOIL
3
1
4
SHALE & CLAY
SMALL SHALE SANDY LOAM

②
BROWN CLAY TOPSOIL
3
BROWN TAN SANDY LOAM
1 1/2

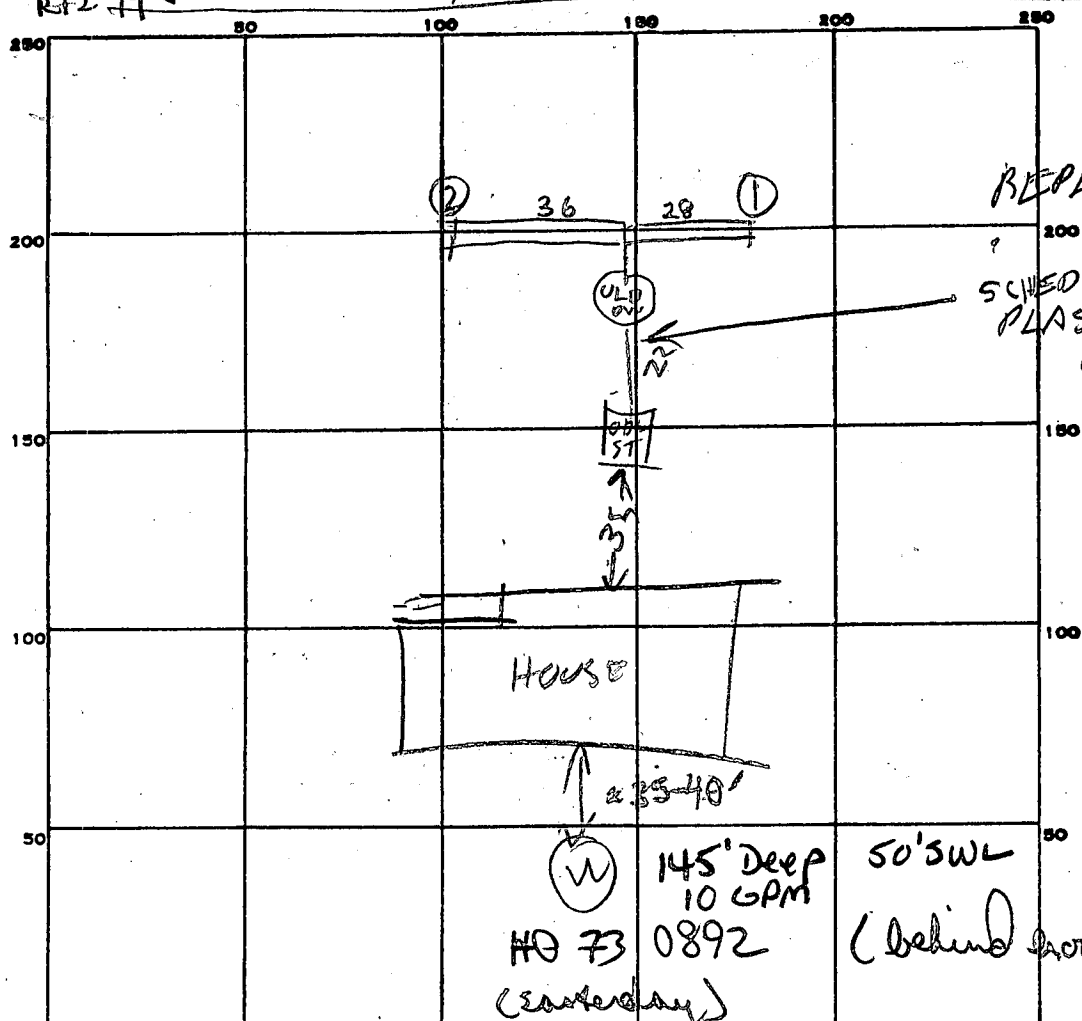

REPLACED
SCHEDULE 40
PLASTIC PIPE
PER HS
(Cold cast
iron pipe
that was
plugged
solid)

House
↑ & 35-40'
W 145' Deep 10 GPM
HO 73 0892 (centered)
50'SWL (behind house)

Comp Date 2/11/74

INDICATE NORTH. - NAME ADJOINING ROADWAY AS BASE LINE.

PERMIT CARD final

Existing on D.W. & S.T.

SEPTIC TANK, LEVEL _____

CLEANOUTS _____

DISTRIBUTION BOX, LEVEL _____

TILE FIELD, DEPTH 1 1/2-12 FT. TRENCH WIDTH 2 FT.

GRAVEL DEPTH 7 1/2 IN. TOTAL LENGTH 64 FT.

NUMBER OF TRENCHES 1 (keel off) 15102 wall TOTAL BOTTOM AREA 448

64
7
448
125
3
375
38
38

SEEPAGE PITS, INSIDE DIAMETER _____ FT. DEPTH BELOW INLET _____ FT.

ABSORBENT AREA 448 SQ. FT.

REMARKS 4/9/86 - SOIL OK WATER WELL IN BACK YARD

TRENCH DUG & SOME STONE PUT INTO TRENCH FINISH ADDING STONE & CONNECT DRY WELL TO TRENCH & CALL

4/9/86 OR to cover all work

DATE SYSTEM APPROVED 4/9/86

INSPECTOR B. W. Nylan