

4/18/85
AM ASAP

2 Insects
(washed & fixed)

2nd

approved
4/18/85
C Williams

PERMIT

P 35248
A REPAIR

SEWAGE DISPOSAL SYSTEM
MARYLAND STATE DEPARTMENT OF HEALTH

HOWARD COUNTY
BUREAU OF ENVIRONMENTAL HEALTH
992-2330

04-34783
INDEXED

ELLICOTT CITY
DISTRICT _____
DATE 4/9/85

Arnold Septic Tank Service IS PERMITTED TO INSTALL _____ ALTER X

ADDRESS Jacobs Road, Mt. Airy, Maryland 21771 PHONE 795-7873

SUBDIVISION Poplar Springs ROAD 912 Watersville Road LOT 69 PCL

PROPERTY OWNER Loren F. Mitchell
ADDRESS 912 Watersville Road
Mt. Airy, Maryland 21771

IF GARBAGE GRINDER IS USED INCREASE SEPTIC TANK CAPACITY BY 50% AND ABSORPTION AREA BY 22%.

GARBAGE GRINDER? YES _____ NO X

SEPTIC TANK CAPACITY 1000 GALLONS NUMBER OF BEDROOMS 2

~~REPAIR - CALL FOR INSPECTION WHEN GROUND IS OPENED UP SO SANITARIAN CAN RECOMMEND REPAIR.~~

DEEP TRENCH - 80 FT LONG 2 FT WIDE
9 1/2 FT DEEP FILLED WITH 6 FT OF STONE
OR 69 FT LONG 2 FT WIDE 10 1/2 FT DEEP FILLED
WITH 7 FT OF STONE

PLACE THE TRENCH 70 FT BEHIND
THE GARAGE RUNNING ACROSS THE
LOT ON CONTOUR RH

PLANS APPROVED BY Craig Williams DATE 4/03/85

COVER NO WORK UNTIL INSPECTED AND APPROVED.

NEITHER THE HOWARD COUNTY COUNCIL NOR THE HEALTH DEPARTMENT IS RESPONSIBLE FOR THE SUCCESSFUL OPERATION OF ANY SYSTEM.

NOTE: IF TRENCH IS USED CALL FOR INSPECTION BEFORE AND AFTER PLACING GRAVEL IN TRENCH.

NOTE: NO DRY WELL SHALL EXCEED 15 FOOT IN DIAMETER. NO ABSORPTION TRENCH TO EXCEED 100 FEET IN LENGTH.

NOTE: ALL PIPE FROM HOUSE TO SEPTIC TANK MUST BE CAST IRON OR SCHEDULE 40 PVC OR ABS.

PERMIT VOID AFTER THREE YEARS.


NOTE: INSTALL STAND PIPE ON SEPTIC TANK AND DRY WELL. STAND PIPES MUST BE 6 INCHES IN DIAMETER. CAST IRON, CONCRETE OR TERRA COTTA. OR PVC OR ABS ACCEPTED. IF TOP OF SEPTIC TANK IS DEEPER THAN 3 FEET MANHOLE TO GRADE REQUIRED.

*INSTALLER IS RESPONSIBLE FOR OBTAINING FINAL APROVAL ON THIS PERMIT

*CALL 992-2330 FOR INSPECTION OF SEPTIC SYSTEMS.

EH - 2-1082

P 35248

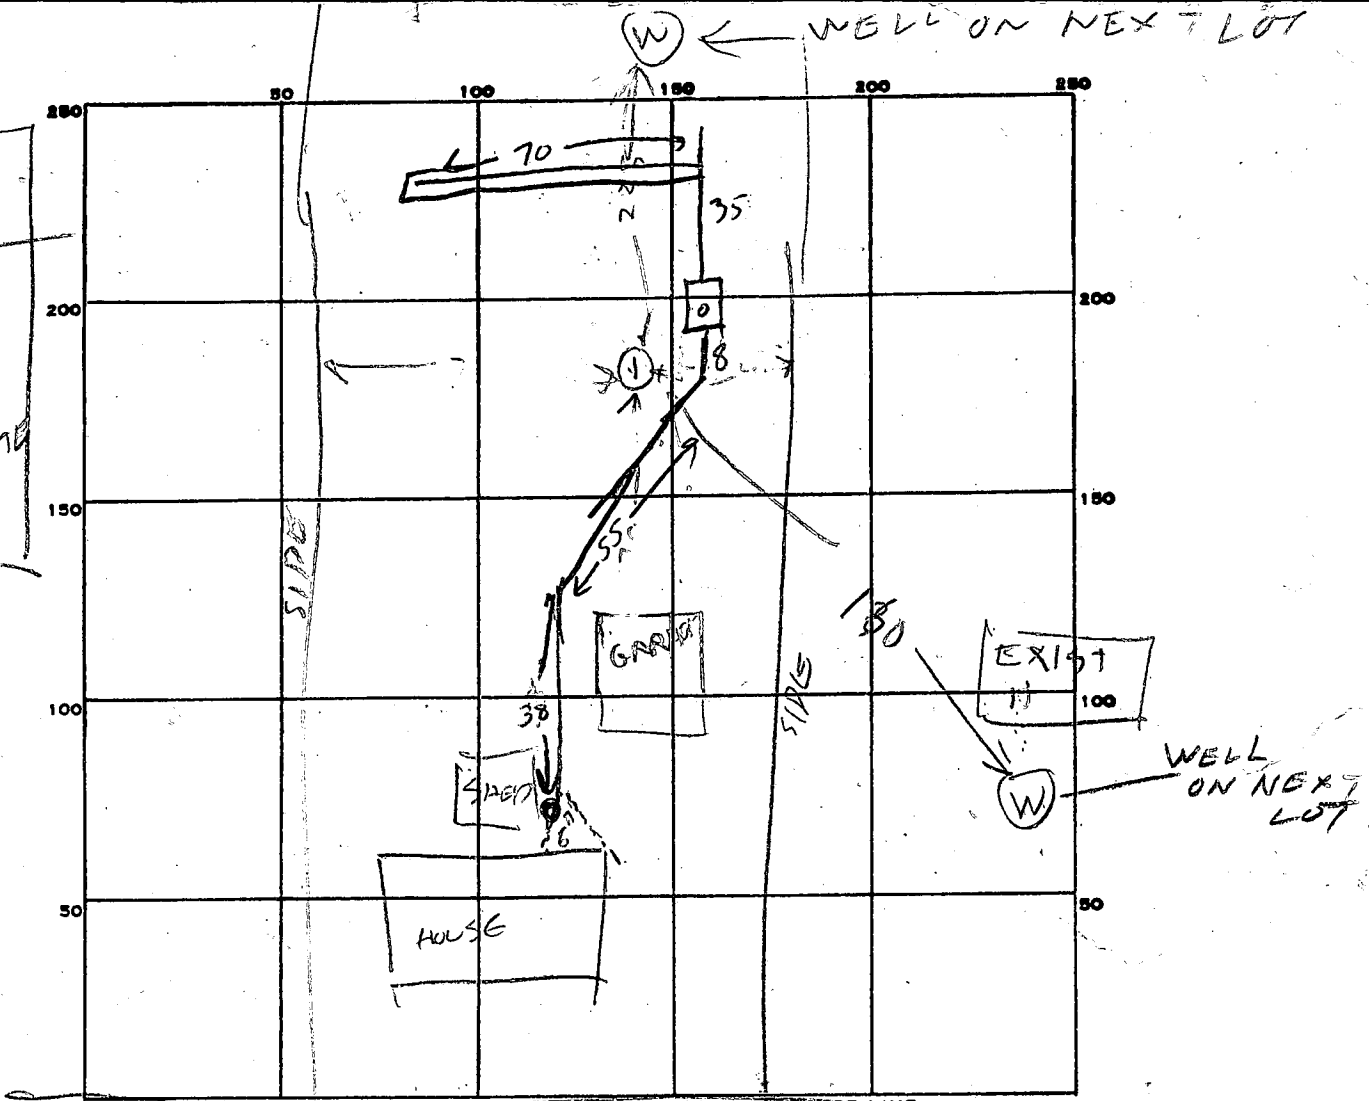

PERMIT CARD _____

SEPTIC TANK, LEVEL ST ✓

CLEANOUTS: ST IN LINE ✓

DISTRIBUTION BOX, LEVEL _____

TILE FIELD, DEPTH 10 1/2 FT. TRENCH WIDTH _____ FT.

GRAVEL DEPTH 7 FT IN. TOTAL LENGTH 70 FT.

NUMBER OF TRENCHES 1 ONE SIDEWALL TOTAL BOTTOM AREA 490

SEEPAGE PITS, INSIDE DIAMETER _____ FT. DEPTH BELOW INLET _____ FT.

ABSORBENT AREA 490 SQ. FT.

REMARKS	4/16/85	15	8	114	117	117	1126	9
		1V	12	LOOKS OK Below 3 1/2 FT				

SOIL OK BUT NOT SURE OF WELL SITE
 BOB ARNOLD TO MARK WELL SITE RH
 EXISTING DRY WELL ABANDONED & FILLED CW ✓

14/18/85 TWO LINES FROM HOUSE CONNECTED TO ONE NEW LINE TO TANK,
 TRENCH OK TO COVER CW

DATE SYSTEM APPROVED 4/18/85 INSPECTOR CW