

PERMIT

SEWAGE DISPOSAL SYSTEM

MARYLAND STATE DEPARTMENT OF HEALTH

HOWARD COUNTY

BUREAU OF ENVIRONMENTAL HEALTH

461-9933

04-396939
INDEXED

P 42718

A 34732

DISTRICT 4th

DATE 10/6/88

DATE SYSTEM APPROVED 10/6/88

INSPECTOR C. Bel

Jack Fyock

IS PERMITTED TO INSTALL ☒ ALTER ☐

ADDRESS _____ PHONE 988-9270

SUBDIVISION Charles Sharp ROAD 14240 Triadelphia Rd LOT 6

PROPERTY OWNER Grosen Development Steven & Miriah Dubin

ADDRESS _____

IF GARBAGE GRINDER IS USED INCREASE SEPTIC TANK CAPACITY BY 50% AND ABSORPTION AREA BY 22%.

GARBAGE GRINDER? YES ☐ NO ☒

SEPTIC TANK CAPACITY 1250 GALLONS NUMBER OF BEDROOMS 4

TRENCHES - 180 sq. ft. per bedroom. Trench to be 2 feet wide. Inlet 4.5 feet below original grade. Bottom maximum depth 8.5 feet below original grade. Effective area begins at 4.5 feet below original grade. 4 feet of stone below distribution pipe.

LOCATION - Place the first trench 195 feet up the right 446.00 ft. lot line and 110 feet off the same lot line as seen when facing the lot from Triadelphia Road. Run trenches on contour toward the right lot line.

NOTE - No trench to exceed 100 feet in length. Provide 6" - 3" diameter cleanout and above on septic tank. ok/cw

**BUILDING PERMIT SIGNED
AND RETURNED**

PLANS APPROVED BY Sid Abel DATE 7/21/88

COVER NO WORK UNTIL INSPECTED AND APPROVED.

NEITHER THE HOWARD COUNTY COUNCIL NOR THE HEALTH DEPARTMENT IS RESPONSIBLE FOR THE SUCCESSFUL OPERATION OF ANY SYSTEM.

NOTE: CLEANOUT REQUIRED EVERY 70 FEET OF SEWER LINE AND/OR AT 90° SWEEPS IN LINES FROM HOUSE TO DRAIN FIELDS.

NOTE: ALL PARTS OF SEPTIC SYSTEMS (I.E., TANK, DISTRIBUTION BOX, TRENCHES) TO BE 100 FEET FROM WELL (UNLESS OTHERWISE SPECIFICALLY AUTHORIZED)

NOTE: IF DEEP TRENCH(IES) ARE USED CALL FOR INSPECTION BEFORE AND AFTER PLACING GRAVEL IN TRENCH(IES).

NOTE: NO DRY WELL SHALL EXCEED 15 FOOT IN DIAMETER. NO ABSORPTION TRENCH TO EXCEED 100 FEET IN LENGTH.

NOTE: ALL PIPE FROM HOUSE TO SEPTIC TANK MUST BE CAST IRON OR SCHEDULE 40 PVC OR ABS.

PERMIT VOID AFTER TWO YEARS.

NOTE: INSTALL STAND PIPE ON SEPTIC TANK AND DRY WELL. STAND PIPES MUST BE 6 INCHES IN DIAMETER. CAST IRON, CONCRETE OR TERRA COTTA OR PVC OR ABS ACCEPTED. IF TOP OF SEPTIC TANK IS DEEPER THAN 3 FEET, MANHOLE TO GRADE REQUIRED.

NOTE: DISTRIBUTION BOXES MUST HAVE BAFFLES.

BLDG. PERMIT SIGNED

AND RETURNED 3/21/93


BLDG. PERMIT SIGNED

AND RETURNED 10/18/89

*INSTALLER IS RESPONSIBLE FOR OBTAINING FINAL APPROVAL ON THIS PERMIT

*CALL 461-9933 FOR INSPECTION OF SEPTIC SYSTEMS.

EH - 2-1186

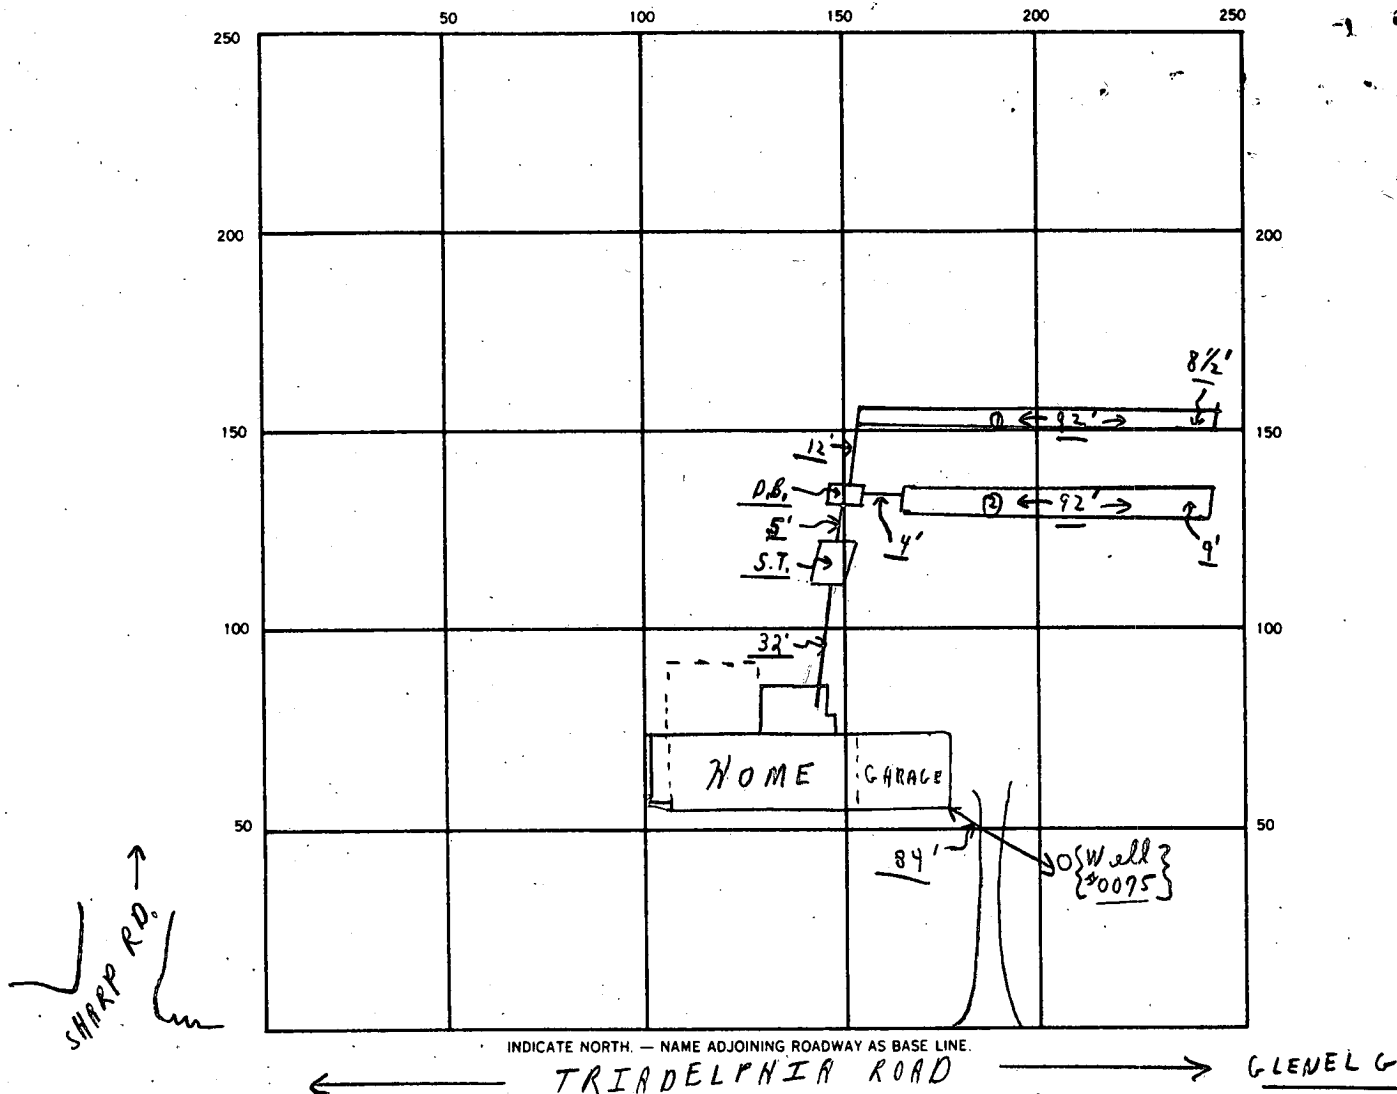

SEPTIC TANK, LEVEL OK CLEANOUTS OK

DISTRIBUTION BOX, LEVEL OK (RAFFLE IN)

DRAIN FIELD/TILE FIELD, DEPTH 8.5' + FT. TRENCH WIDTH 2 FT. INLET DEPTH 4.5 FT.

EFFECTIVE GRAVEL DEPTH 8.5' - 2.0' = 6.5' FT. TOTAL LENGTH 92' } 184 FT.

NUMBER OF TRENCHES 2 ONE SIDEWALL/BOTTOM AREA 736 SQ. FT.

DRYWELL INSIDE DIAMETER FT. EFFECTIVE DEPTH BELOW INLET FT.

ABSORBENT AREA 736 SQ. FT.

REMARKS 10/6/88 ① PARTIAL - ① TRENCH OK FOR STONE - ONLY, ② OK TO COVER
ALL WORK. C.B.D. (FILE FINALED.)

DATE SYSTEM APPROVED 10/6/88 INSPECTOR Charles Bryan Shesker

CHARLES SHARP
SUBDIVISION: SHARP PROPERTY

LOT NUMBER: #4 LOT 6
F 88 01

A 34732

DRY WELL OR DRY WELL AND TRENCH

		_____ sq. ft./bedroom
	<u>Septic Tank</u>	<u>Minimum Total square Feet</u>
3 bedroom	1000 gallon	_____
4 bedroom	1250 gallon	_____
5 bedroom	1500 gallon	_____

Inlet _____ feet below original grade.

Bottom maximum depth _____ feet below original grade.

Effective area begins at _____ feet below original grade.

NOTE: If trench is used to make up absorbent area, run the trench on level ground and leave a 5 foot earth buffer between dry well and trench. No trench is to exceed 100 feet in length. Trench inlet to be same as dry well, with _____ feet of stone below distribution pipe.

TRENCHES

180 sq. ft./bedroom

Trench to be 2 wide.

Inlet 4.5 feet below original grade.

Bottom maximum depth 8.5 feet below original grade.

Effective area begins at 4.5 feet below original grade.

4.5 feet of stone below distribution pipe.

- NOTE:
- (1) No trench to exceed 100 feet in length.
 - (2) If more than one trench used, a distribution box is required.
 - (3) Trenches to be installed on level ground.
 - (4) Call for inspection of trench before gravel is installed.
 - (5) Provide 6"-8" diameter cleanout and cap to grade or above on septic tank and drywell.
 - (6) If a Garbage disposal is used, increase septic tank capacity by 50% and increase absorbant sidewall area by 22%.

LOCATION: 7-21-88 PLACE THE FIRST TRENCH 195 FEET UP THE RIGHT
446.00 FE LOT LINE AND 110 FE OFF THE SAME LOT LINE
AS SEEN WHEN FACING THE LOT FROM TRIADOLPHIA RD. RUN
TRENCHES ON CONTOUR TOWARD THE RIGHT LOT LINE. S. O. BR

APPLICATION

SEWAGE DISPOSAL TESTING

STATE OF MARYLAND - DEPARTMENT OF HEALTH AND MENTAL HYGIENE

HOWARD COUNTY HEALTH DEPARTMENT
ENVIRONMENTAL HEALTH SERVICES

P. O. BOX 476 ELLICOTT CITY, MARYLAND 21043
TELEPHONE: 992-2330

A 34732

P _____

DISTRICT 4

DATE Jan 2, 1985

TO: THE COUNTY HEALTH OFFICER
ELLICOTT CITY, MARYLAND

I, HEREBY, APPLY FOR THE NECESSARY TEST IN ORDER TO CONSTRUCT (OR RECONSTRUCT) A SEWAGE DISPOSAL SYSTEM.

PROPERTY OWNER Charles A. Sharp Cosen Develop.

ADDRESS 3779 Sharp Rd Glenwood, Md 21738 PHONE 489-4630

PROPERTY LOCATION:

SUBDIVISION Par. 45, Map 21 14240 LOT NO. #4 Lot 6 R88-01

ROAD AND DESCRIPTION Northwest side Triadelphia Rd, 600' NE of Sharp Rd

SIZE OF LOT 3 ac TYPE BLDG. Residence (NUMBER OF BEDROOMS) 12

THE SYSTEM INSTALLED UNDER THIS APPLICATION IS ACCEPTABLE ONLY UNTIL PUBLIC FACILITIES BECOME AVAILABLE. I FULLY UNDERSTAND THE

FEE CONNECTED WITH THE FILING OF THIS PERC TEST APPLICATION IS NON-REFUNDABLE UNDER ANY CIRCUMSTANCES. I ALSO AGREE TO COMPLY

WITH ALL M.O.S.H.A. REQUIREMENTS IN TESTING THIS LOT. Charles A. Sharp
(SIGNATURE OF APPLICANT)

APPROVED BY _____ FOR _____ DATE _____

REJECTED BY _____ FOR _____ DATE _____

HOLD PENDING FURTHER TESTS _____ DATE _____

REASONS FOR REJECTION OR HOLDING 1-14-85 PERK OK, hold for CERTIFIED PLAT WITH LOT




LINES AND PERC. HOLES, SABEL

BLDG. PERMIT SIGNED

AND RETURNED 8/9/88

BP 20601
SAL

THIS IS NOT A PERMIT

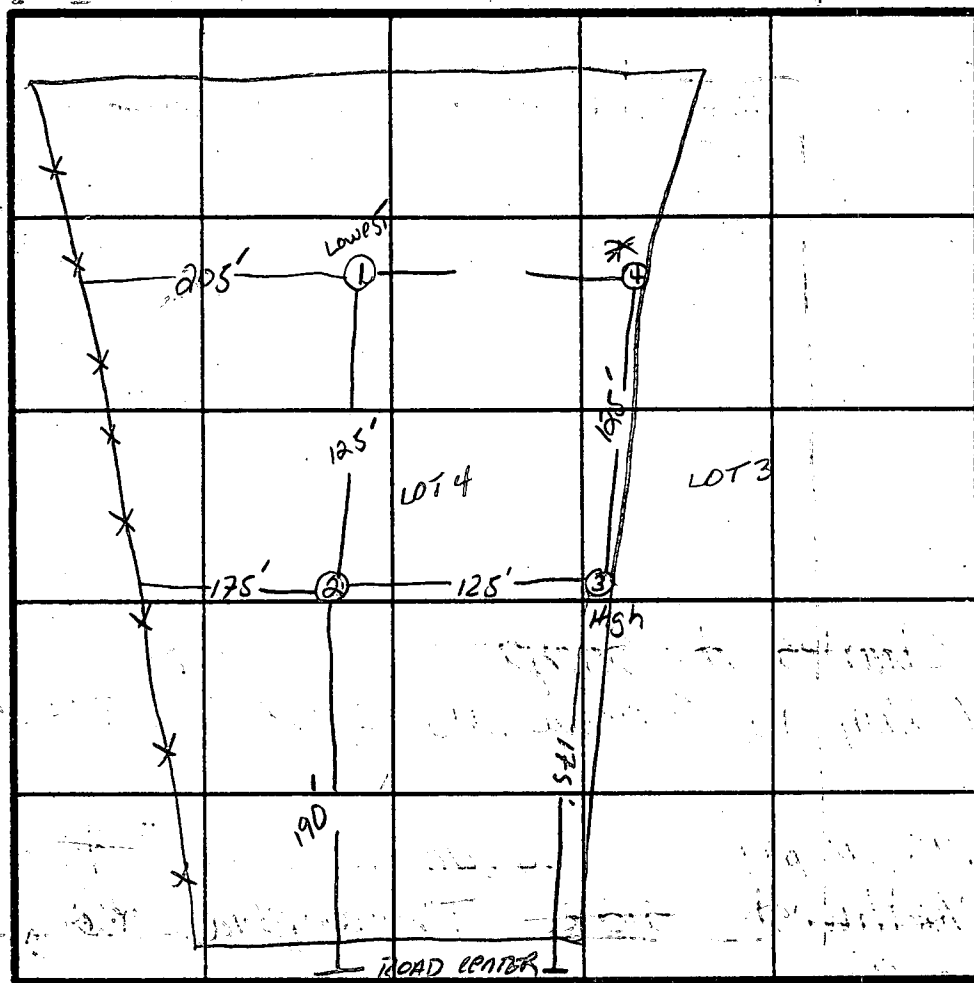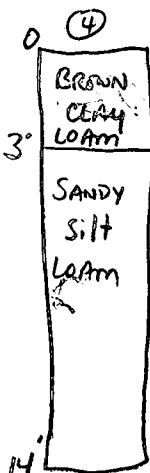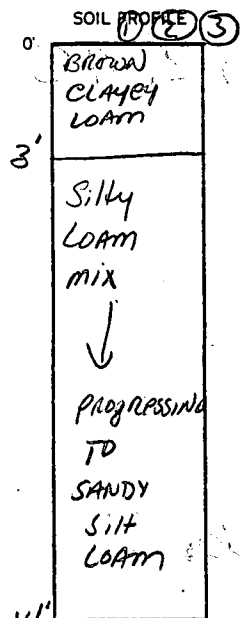

INDICATE NORTH - NAME ADJOINING ROADWAY AS 'BASE' LINE.
TRIADDELPHIA RD.

DATE	TEST NO.	DEPTH	PRE-WET		TEST 1" DROP		TIME
			START	STOP	START	STOP	
1/14/85	1S	5'	10:33	10:39	10:39	10:48	9min
	1M	9'	10:44	10:49	10:49	10:58	9min
	1V	14'	LOOK OK TO 14' uniform soil from 4'-14'				
1/14/85	2S	5'	10:53	10:58	10:58	11:05	8min
	2V	14'	LOOK Good to 14' uniform soil from 4'-14'				
1/14/85	3S	5'	11:09	11:15	11:15	11:24	11min
	3V	13.5'	LOOKS OK TO 13.5' UNIFORM SOIL 4'-13.5'				
1/14/85	4S	6'	11:19	11:24	11:24	11:31	7min
		14'	LOOKS OK TO 14' UNIFORM SOIL FROM 4'-14' FE.				



2
18
19
7
44
544
X = 11min.


REMARKS

TYPE OF SOIL SANDY Silt Loam

TESTED BY S. Abel, R. Hodges

ALSO PRESENT Chuck Sharp
NORMAN Collins - Excavator

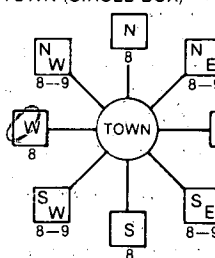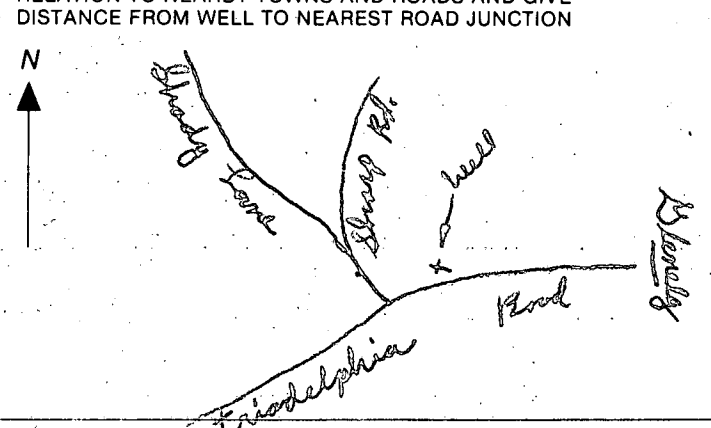B 1 1308 (THIS NUMBER IS TO BE PUNCHED IN COLS. 3-6 ON ALL CARDS)	SEQUENCE NO. (DP USE ONLY) STATE OF MARYLAND PERMIT TO DRILL WELL please print or type	STATE PERMIT NUMBER 40-88-0075 fill in this form completely
Date Received (APA) OWNER INFORMATION CROSEN DEVERKOPMENT CO. 31755 HADY LAKE GLENDWOOD 6721738	LOCATION OF WELL 40 HOWARD 8 COUNTY 23 SUBDIVISION SECTION 44 46 LOT 6 48 50 52 NEAREST TOWN GLENDLEIGH MILES FROM TOWN (enter 0 if in town) 1 73 76 77 78	
DRILLER INFORMATION Joseph L. Wagner 238 77 License No. 80 Joseph L. Wagner Well Drilling 5512 Ridge Rd. Mt. Airy, Md. 21771 Address Joseph L. Wagner 6/28/88 Date	B 4 DIRECTION OF WELL FROM TOWN (CIRCLE BOX)  NEAR WHAT ROAD Trindolphin Road ON WHICH SIDE OF ROAD (CIRCLE APPROPRIATE BOX) NORTH WEST EAST SOUTH 34 50 37 DISTANCE FROM ROAD ENTER FT or MI FT 38 39	
B 2 WELL INFORMATION APPROX. PUMPING RATE (GAL. PER MIN.) 5 8 12 AVERAGE DAILY QUANTITY NEEDED (GAL. PER DAY) 500 14 20	USE FOR WATER (CIRCLE APPROPRIATE BOX) ☒ HOME (SINGLE OR DOUBLE HOUSEHOLD UNIT ONLY) ☐ FARMING (LIVESTOCK WATERING & AGRICULTURAL IRRIGATION) ☐ INDUSTRIAL, COMMERCIAL, STATE AND FEDERAL GOV. OTHER (REQUIRES APPROPRIATION PERMIT) ☐ PUBLIC OR PRIVATE WATER COMPANY (REQUIRES APPROPRIATION PERMIT AND STATE HEALTH DEPARTMENT APPROVAL) ☐ TEST, OBSERVATION, MONITORING (MAY REQUIRE APPROPRIATION PERMIT)	
APPROXIMATE DEPTH OF WELL 240 24 28 FEET APPROXIMATE DIAMETER OF WELL 6 INCH METHOD OF DRILLING (circle one) BORED (or Augered) JETTED Jetted & DRIVEN AIR-ROTary AIR-PERcussion ROTARY (Hydraulic Rotary) CABLE REVERSE-ROTary Drive-POINT other	NOT TO BE FILLED IN BY DRILLER HEALTH DEPARTMENT APPROVAL Howard A 34 73.2 COUNTY NAME COUNTY NO. STATE SIGNATURE DATE ISSUED 080388 CO SIGNATURE Cray William 2/3/89 EXP. DATE NORTH GRID 520000 EAST GRID 0797000 SHOW MAJOR FEATURES OF BOX & LOCATE WELL WITH AN X SOURCES OF DRILLING WATER WRITE THE BOX NUMBER FROM THE MAP HERE E 790 7 N 520 0 DRAW A SKETCH BELOW SHOWING LOCATION OF WELL IN RELATION TO NEARBY TOWNS AND ROADS AND GIVE DISTANCE FROM WELL TO NEAREST ROAD JUNCTION 	
REPLACEMENT OR DEEPEMED WELLS (CIRCLE APPROPRIATE BOX) ☒ THIS WELL WILL NOT REPLACE AN EXISTING WELL ☐ THIS WELL WILL REPLACE A WELL THAT WILL BE ABANDONED AND SEALED ☐ THIS WELL WILL REPLACE A WELL THAT WILL BE USED AS A STANDBY ☐ THIS WELL WILL DEEPEMED AN EXISTING WELL PERMIT NUMBER OF WELL TO BE REPLACED OR DEEPEMED (IF AVAILABLE)		
Not to be filled in by driller (OEP USE ONLY) APPROP. PERMIT NUMBER FORCE CC WRITE INITIALS IN BOX PERMIT No. 40-88-0075 SPECIAL CONDITIONS		

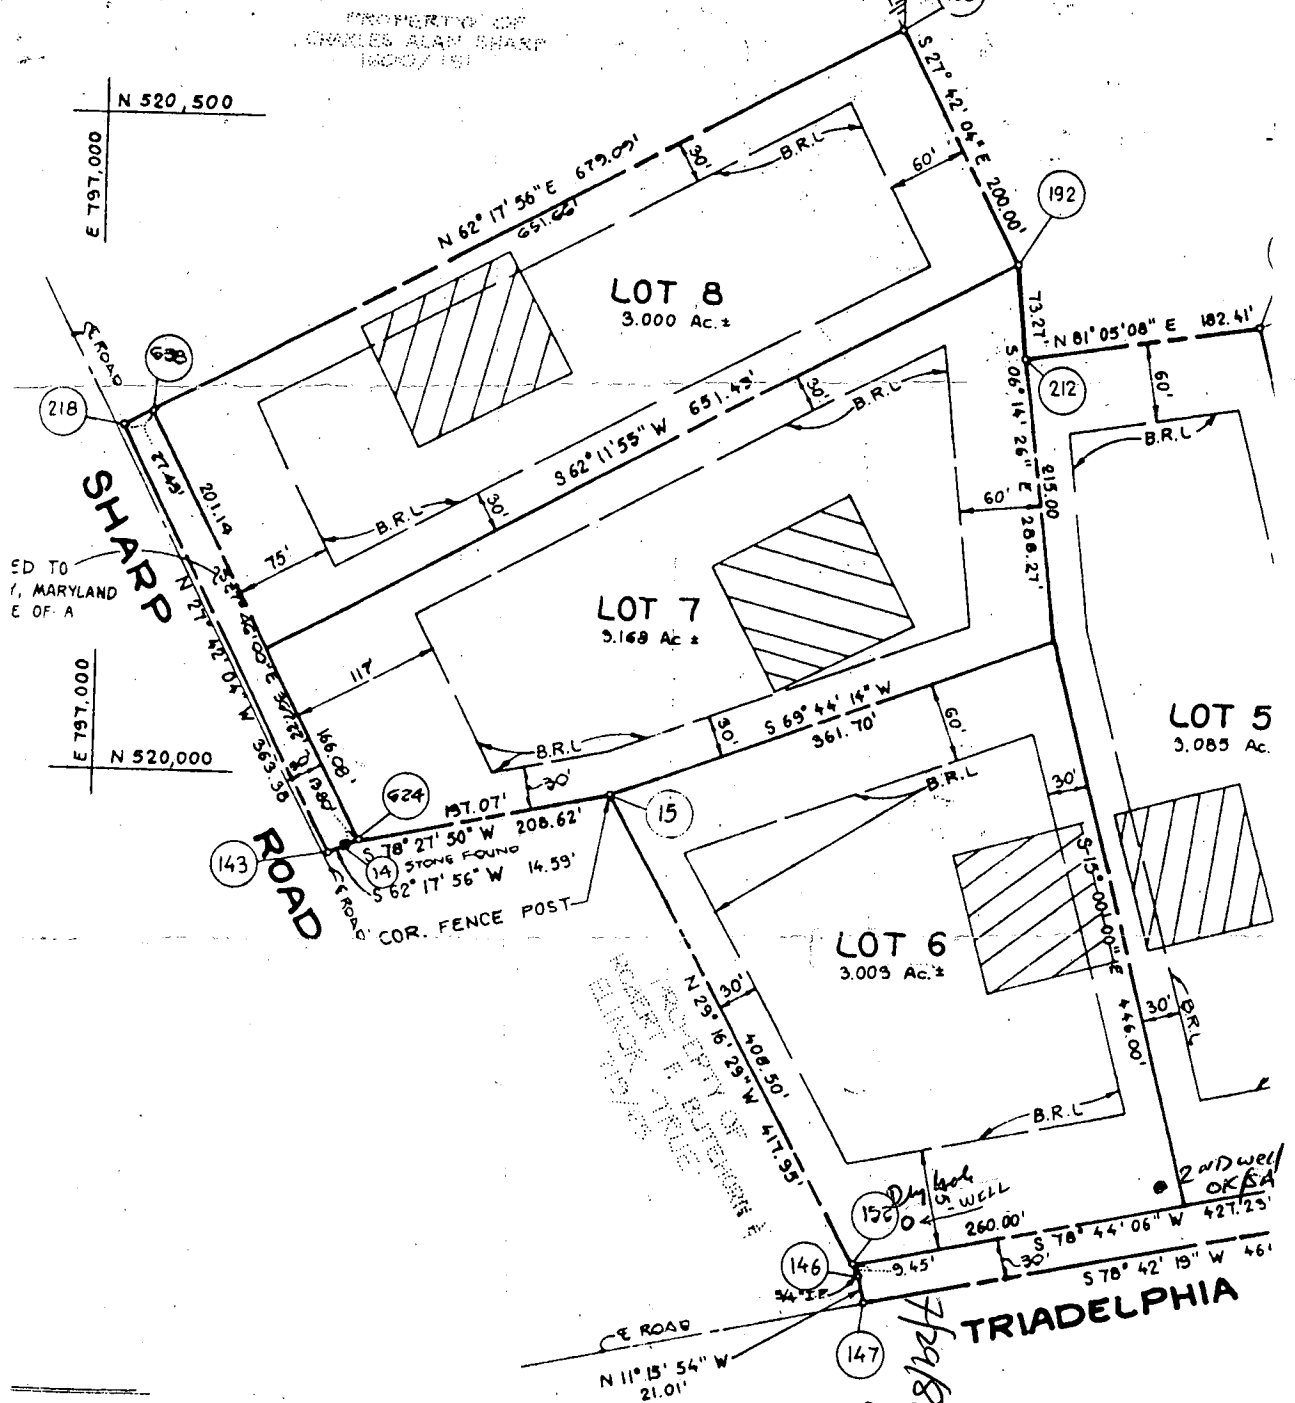

12.256 AC ±

0.550 AC ±

1.806 AC ±

OWNER & DEVELOPER

CHARLES A. SHARP
3779 SHARP ROAD
GLENWOOD, MARYLAND 21738

OWNER'S CERTIFICATE:

I, CHARLES ALAN SHARP, OWNER OF THE PROPERTY SHOWN AND DESCRIBED HEREON, HEREBY ADOPT THIS PLAN OF SUBDIVISION, AND IN CONSIDERATION OF THE APPROVAL OF THIS FINAL PLAT BY THE OFFICE OF PLANNING AND ZONING, ESTABLISH THE MINIMUM BUILDING RESTRICTION LINES AND GRANT UNTO HOWARD COUNTY, MARYLAND, ITS SUCCESSORS AND ASSIGNS, (1) THE RIGHT TO LAY, CONSTRUCT AND MAINTAIN SEWERS, DRAINS, WATER PIPES AND OTHER MUNICIPAL UTILITIES AND SERVICES, IN AND UNDER ALL ROADS AND STREET

PRIVATE SEWERAGE
HEALTH

DATE

8/5/88 3 HRS
7:30 START

Review

FIELD DATA SHEET
HOWARD COUNTY WELL YIELD TEST

Well Permit No. HO - 88-0075

Location of property (road) TRIADELPHIA RD.

Subdivision	SHARP PROPERTY	Lot 6	Block	Plat	Sec.
-------------	----------------	-------	-------	------	------

Well Driller JOSEPH MAYNE Owner CROSON DEVELOPMENT

Depth of well . ✓

Distance of measuring point (M.P.) above ground ✓

Static water level (S.W.L.) below M.P. ✓

I. High rate pumping -- reservoir drawdown

Time pump started _____ Pumping rate _____
Total time _____ to reach pumping water level _____ ft. below M.P.

II. Recovery pump test data - observations to be recorded every 15 minutes

[illegible]

C1 9608 SEQUENCE NO. (DENY USE ONLY)

STATE OF MARYLAND
WELL COMPLETION REPORT
FILL IN THIS FORM COMPLETELY
PLEASE PRINT OR TYPETHIS REPORT MUST BE SUBMITTED WITHIN
45 DAYS AFTER WELL IS COMPLETED.COUNTY
NUMBER A 34732

DATE Received

DATE WELL COMPLETED

Depth of Well

PERMIT NO.
FROM "PERMIT TO DRILL WELL"

1 2 3 4 5 6 7 8 9 10 11 12 13

14 15 16 17 18 19 20

21 22 23 24 25 26
(TO NEAREST FOOT)

27 28 29 30 31 32 33 34 35 36 37

OWNER CAUSEY DEVELOPMENT
last name TRIADOLPHIA RD first name GREENGL
STREET OR RFD
SUBDIVISION SHARP PROPERTY SECTION LOT 6

WELL LOG

Not required for driven wells

STATE THE KIND OF FORMATIONS
PENETRATED, THEIR COLOR, DEPTH,
THICKNESS AND IF WATER BEARING

DESCRIPTION (Use additional sheets if needed)

FEET
FROM TO

Check if water bearing

SANDSTONE 0 60
GRAY MICA 60 200
ROCKDry well 305'
Filled with cement
& drilling materials

GROUTING RECORD

WELL HAS BEEN GROUTED
(Circle Appropriate Box)yes ☒ no ☐

TYPE OF GROUTING MATERIAL

CEMENT ☒ BENTONITE CLAY ☐NO. OF BAGS 13 NO. OF POUNDS 1222GALLONS OF WATER 78

DEPTH OF GROUT SEAL (to nearest foot)

from 1 ft. to 50 ft.
(enter 0 if from surface)casing types
insert appropriate code below

CASING RECORD

ST CO
STEEL CONCRETE
PL OT
PLASTIC OTHER

MAIN CASING TYPE Nominal diameter top (main) casing (nearest inch) Total depth of main casing (nearest foot)

ST 60 61 A 63 64 17 66 67 70

OTHER CASING (if used)
diameter inch depth (feet) from toscreen type or open hole
insert appropriate code below
ST BR HO
STEEL BRASS OPEN HOLE
PL BRONZE HOLE
PLASTIC OTHERC2
DEPTH (nearest ft.)
1 2 3 4 5 6 7 8 9 10 11 12 13 14 15 16 17 18 19 20 21 22 23 24 25 26 27 28 29 30 31 32 33 34 35 36 37 38 39 40 41 42 43 44 45 46 47 48 49 50 51SLOT SIZE 1 2 3
DIAMETER OF SCREEN (NEAREST INCH)
from toGRAVEL PACK
IF WELL DRILLED WAS FLOWING WELL INSERT F IN BOX 68OEP USE ONLY
(NOT TO BE FILLED IN BY DRILLER)
T (E.R.O.S.) WQ
70 72 74 75 76
TELESCOPE CASING LOG INDICATOR OTHER DATA

C3

PUMPING TEST

HOURS PUMPED (nearest hour) 3PUMPING RATE (gal. per min. to nearest gal.) 12METHOD USED TO MEASURE PUMPING RATE Bucket

WATER LEVEL (distance from land surface)

BEFORE PUMPING 39WHEN PUMPING 39

TYPE OF PUMP USED (for test)

A air P piston T turbine
C centrifugal R rotary O other (describe below)
J jet S submersible

PUMP INSTALLED

DRILLER WILL INSTALL PUMP YES ☒ NO ☐
(CIRCLE) (YES or NO)
IF DRILLER INSTALLS PUMP, THIS SECTION MUST BE COMPLETED FOR ALL WELLS EXCEPT HOME USE
TYPE OF PUMP INSTALLED
PLACE (A,C,J,P,R,S,T,O) IN BOX - SEE ABOVE:CAPACITY: GALLONS PER MINUTE (to nearest gallon) 31 35
PUMP HORSE POWER 37 41
PUMP COLUMN LENGTH (nearest ft.) 43 47CASING HEIGHT (circle appropriate box and enter casing height)
+ above } LAND SURFACE (nearest foot)
- below }LOCATION OF WELL ON LOT
SHOW PERMANENT STRUCTURE SUCH AS BUILDING, SEPTIC TANKS, AND/OR LANDMARKS AND INDICATE NOT LESS THAN TWO DISTANCES (MEASUREMENTS TO WELL)CIRCLE APPROPRIATE LETTER
A A WELL WAS ABANDONED AND SEALED WHEN THIS WELL WAS COMPLETED
E ELECTRIC LOG OBTAINED
P TEST WELL CONVERTED TO PRODUCTION WELL

I HEREBY CERTIFY THAT THIS WELL HAS BEEN CONSTRUCTED IN ACCORDANCE WITH COMAR 10.17.13 "WELL CONSTRUCTION" AND IN CONFORMANCE WITH ALL CONDITIONS STATED IN THE ABOVE CAPTIONED PERMIT, AND THAT THE INFORMATION PRESENTED HEREIN IS ACCURATE AND COMPLETE TO THE BEST OF MY KNOWLEDGE.

DRILLERS IDENT. NO. 238
DRILLERS SIGNATURE James P. May
(MUST MATCH SIGNATURE ON APPLICATION)

SITE SUPERVISOR (sign. of driller or journeyman responsible for sitework if different from permittee)

COUNTY

FIELD DATA SHEET
HOWARD COUNTY WELL YIELD TEST

Well Permit No. HO - 88-0075
Location of property (road) Madellphia Rd.
Subdivision Charles Sharp Prop. Lot 6 Block Plat Sec.
Well Driller Joseph Mayne Owner Crosen Development Co.
Depth of well 205'
Distance of measuring point (M.P.) above ground 1'
Static water level (S.W.L.) below M.P. 39'

I. High rate pumping -- reservoir drawdown

Time pump started 7:30 Pumping rate 15 gpm.
Total time 3 min to reach pumping water level 59 ft. below M.P.

II. Recovery pump test data - observations to be recorded every 15 minutes

[illegible]

10/17/88 - AM.

HOWARD COUNTY HEALTH DEPARTMENT
Bureau of Environmental Health
3525-H Ellicott Mills Drive
Ellicott City, MD 21043
461-9933

APPLICATION FOR PITLESS ADAPTER, WELL PUMP AND PRESSURE TANK INSTALLATION

New Installation ☒
Replacement ☐

Receipt # 42776
Date 10/13/88

Name of Installer MARINO P+H INC.

Telephone 747-5615

License Number M-3095

Certified Well Pump Installer ☐ Well Driller ☐ Registered Plumber ☒

Name of Property Owner DON CROSEN

Telephone 854-6655

Subdivision CHARLES ALAN SHARP Lot # 6

Well Tag # HO-88-0075

Site Address 14240 TRADDELPHIA ROAD

Pump

- Type
 - Deep well jet ☐
 - Shallow well jet ☐
 - Submersible ☒ yes
- Make Goulds
- Model # 7E405412
- Capacity 12 GPM

Motor

- Horsepower 1/2
- RPM
- Voltage
 - 110
 - 220 ☒

Pitless Adapter

- Make BRASS 1"
- Model # 1"
- Depth 42"

- Pump exceeds well capacity Yes ☐ No ☒
- If Yes, is low pressure cutoff switch installed? Yes ☒ No ☐
- What methods are used to protect the pump and electrical wiring from vibrations? Torque arrestors yes Cable guards yes Other

Tank

- Capacity WX250
- Pressure relief valve? yes

Piping

- Type 1"-16016
- Size 1"
- NSF and/or BOCA Code approved yes
- Depth of supply line 42"

Well data

- Depth 205' ft.
- Yield 12 GPM
- Static water level 59' ft.
- Will water supply be disinfected by installer? By Builder


10/17/88 Pitless AT 40" - Pump being installed NO LINES TO HOUSE, INSIDE WORK COMPLETE. SAT
OK TO COVER TRENCH when dug except for AT pitless + house wall
I understand that it is my responsibility to notify the Howard County Health Department when the installation is ready for inspection (otherwise this permit is null and void).

All information given above is true to the best of my knowledge.

Signature of Applicant: Joseph D Marino

Date: 10-13-88



Note: A sticker indicating approval/status of the installation will be placed on the well casing at the time of the inspection.

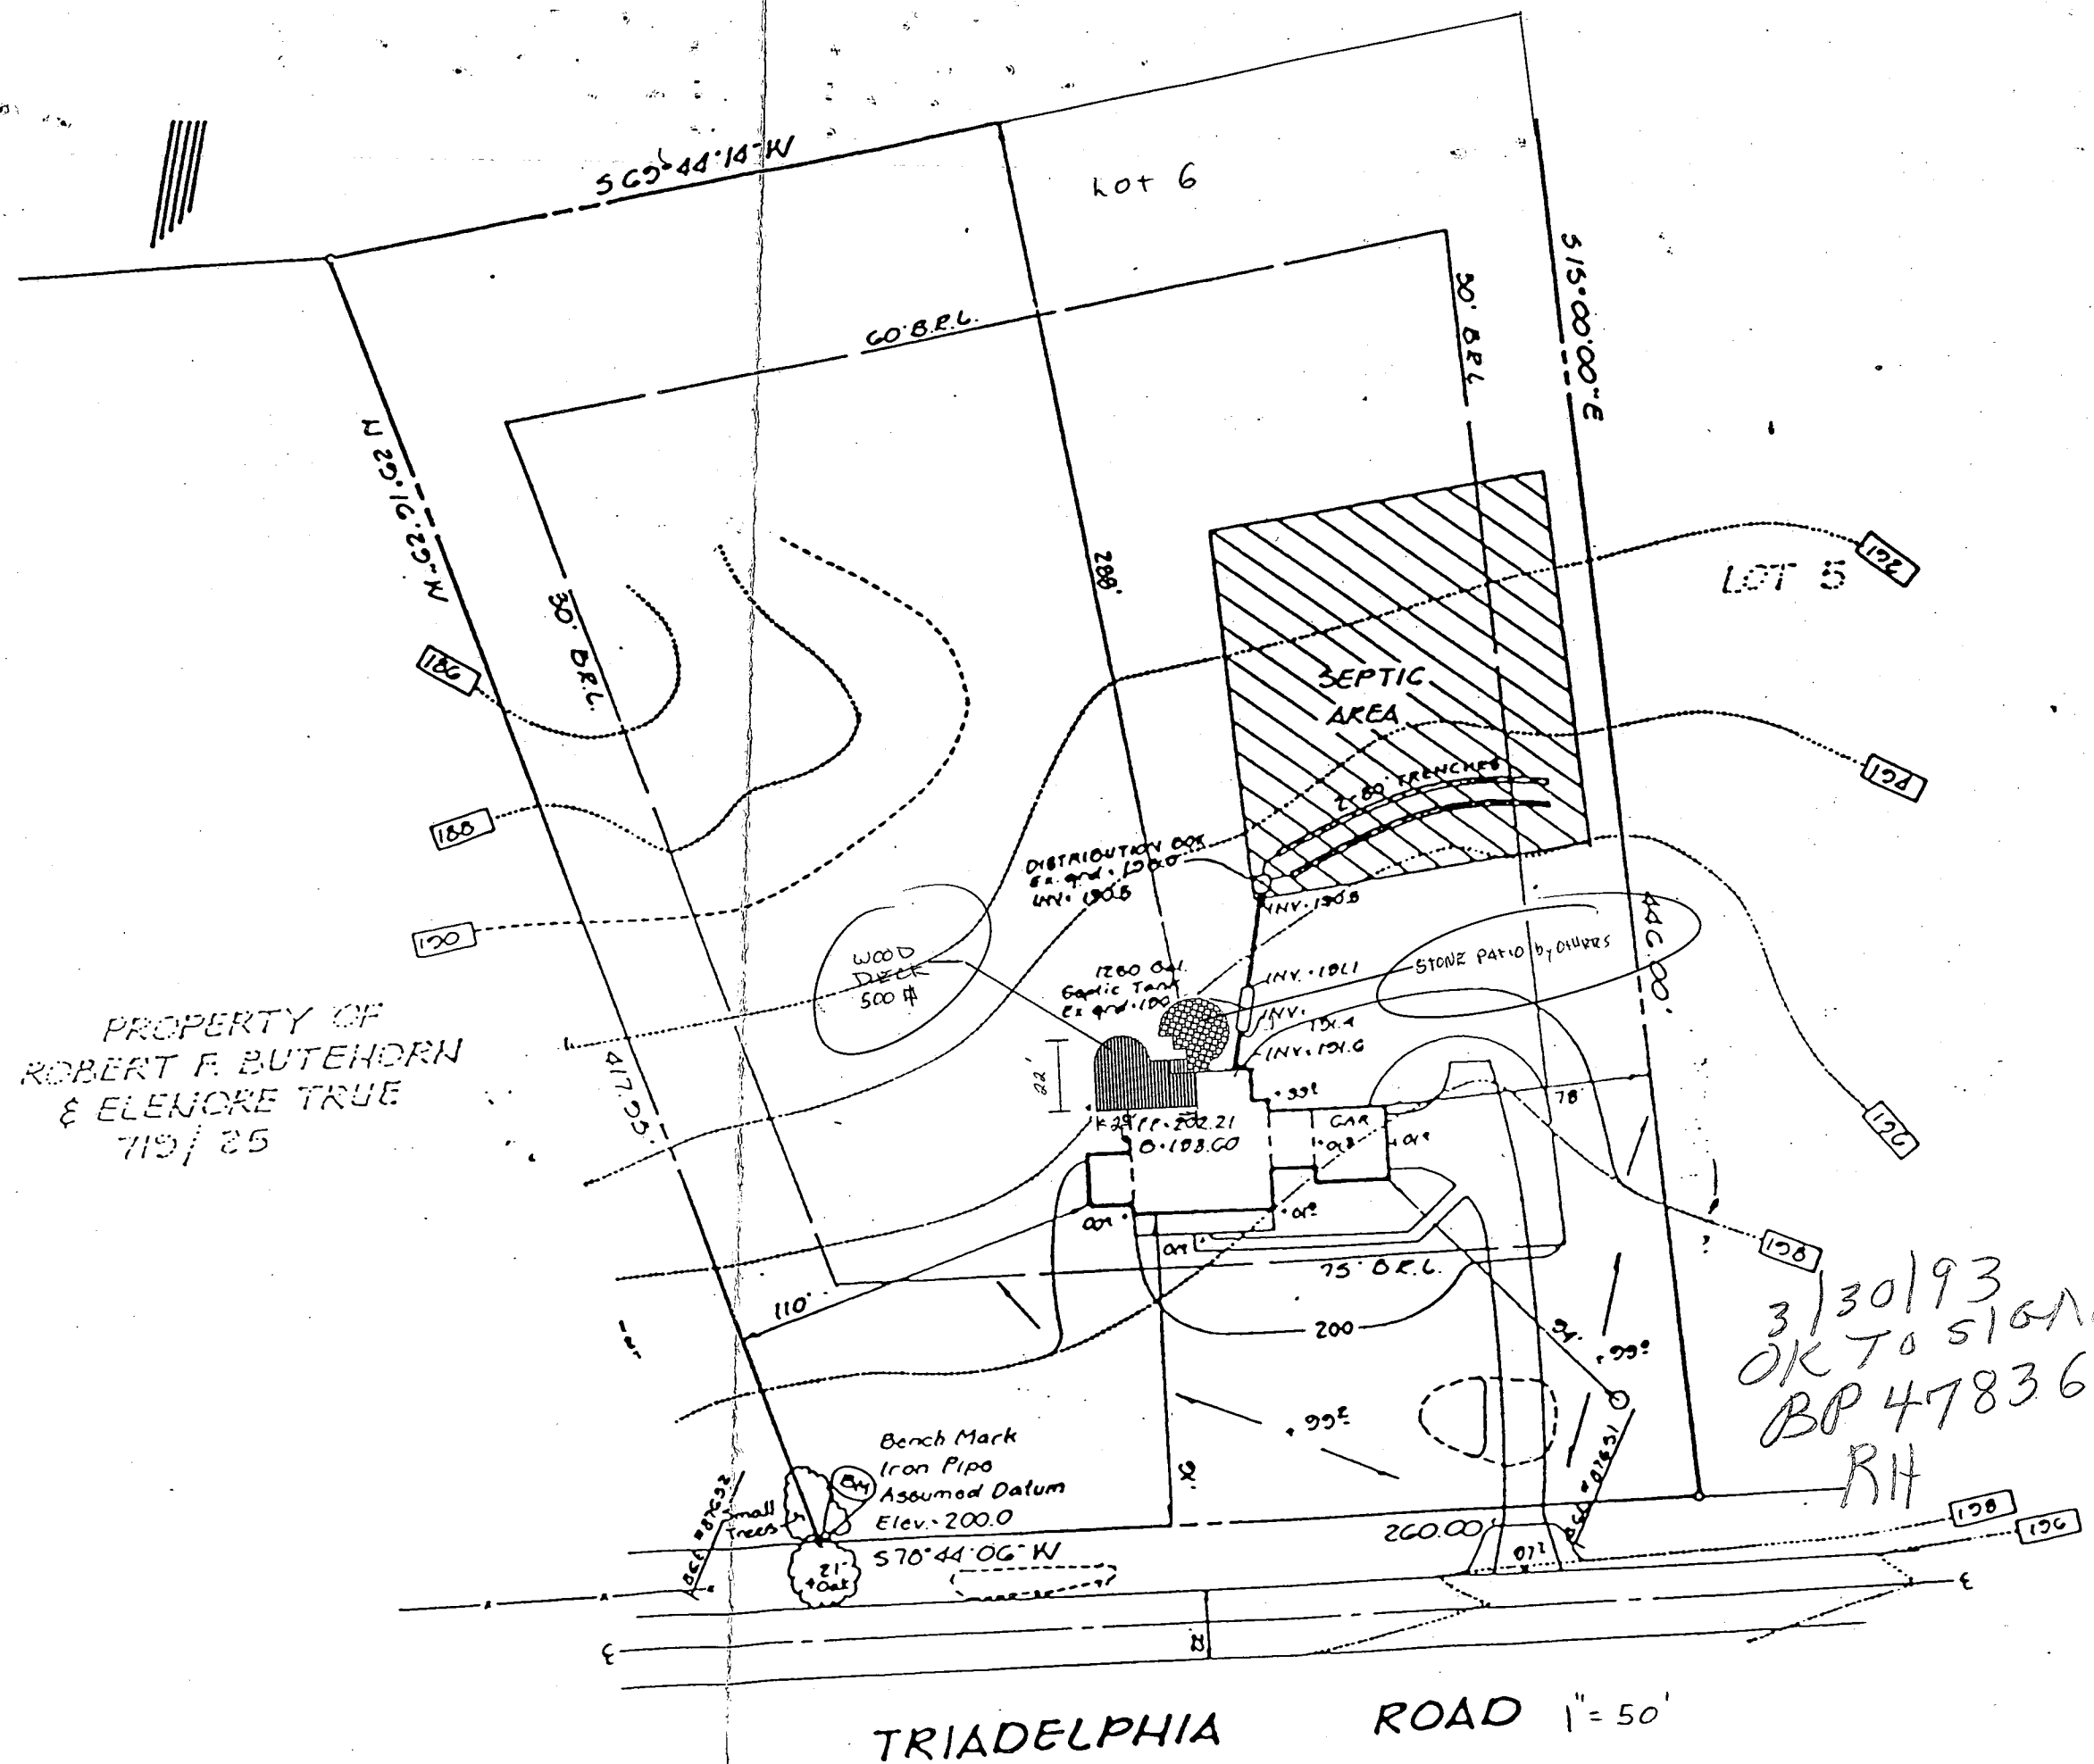

NOTE: No portion of this lot lies within the 100 Year Flood Plain.

Crosen
LOCATION OF HOUSE
14240 TRIADELPHIA ROAD
LOT 6
CHARLES SHARP
SUBDIVISION
LOTS 5-8
FOURTH ELECTION DISTRICT
HOWARD COUNTY, MARYLAND

Wall Check: 7-7-89
FF El: 202.9
Finol: 7-7-89

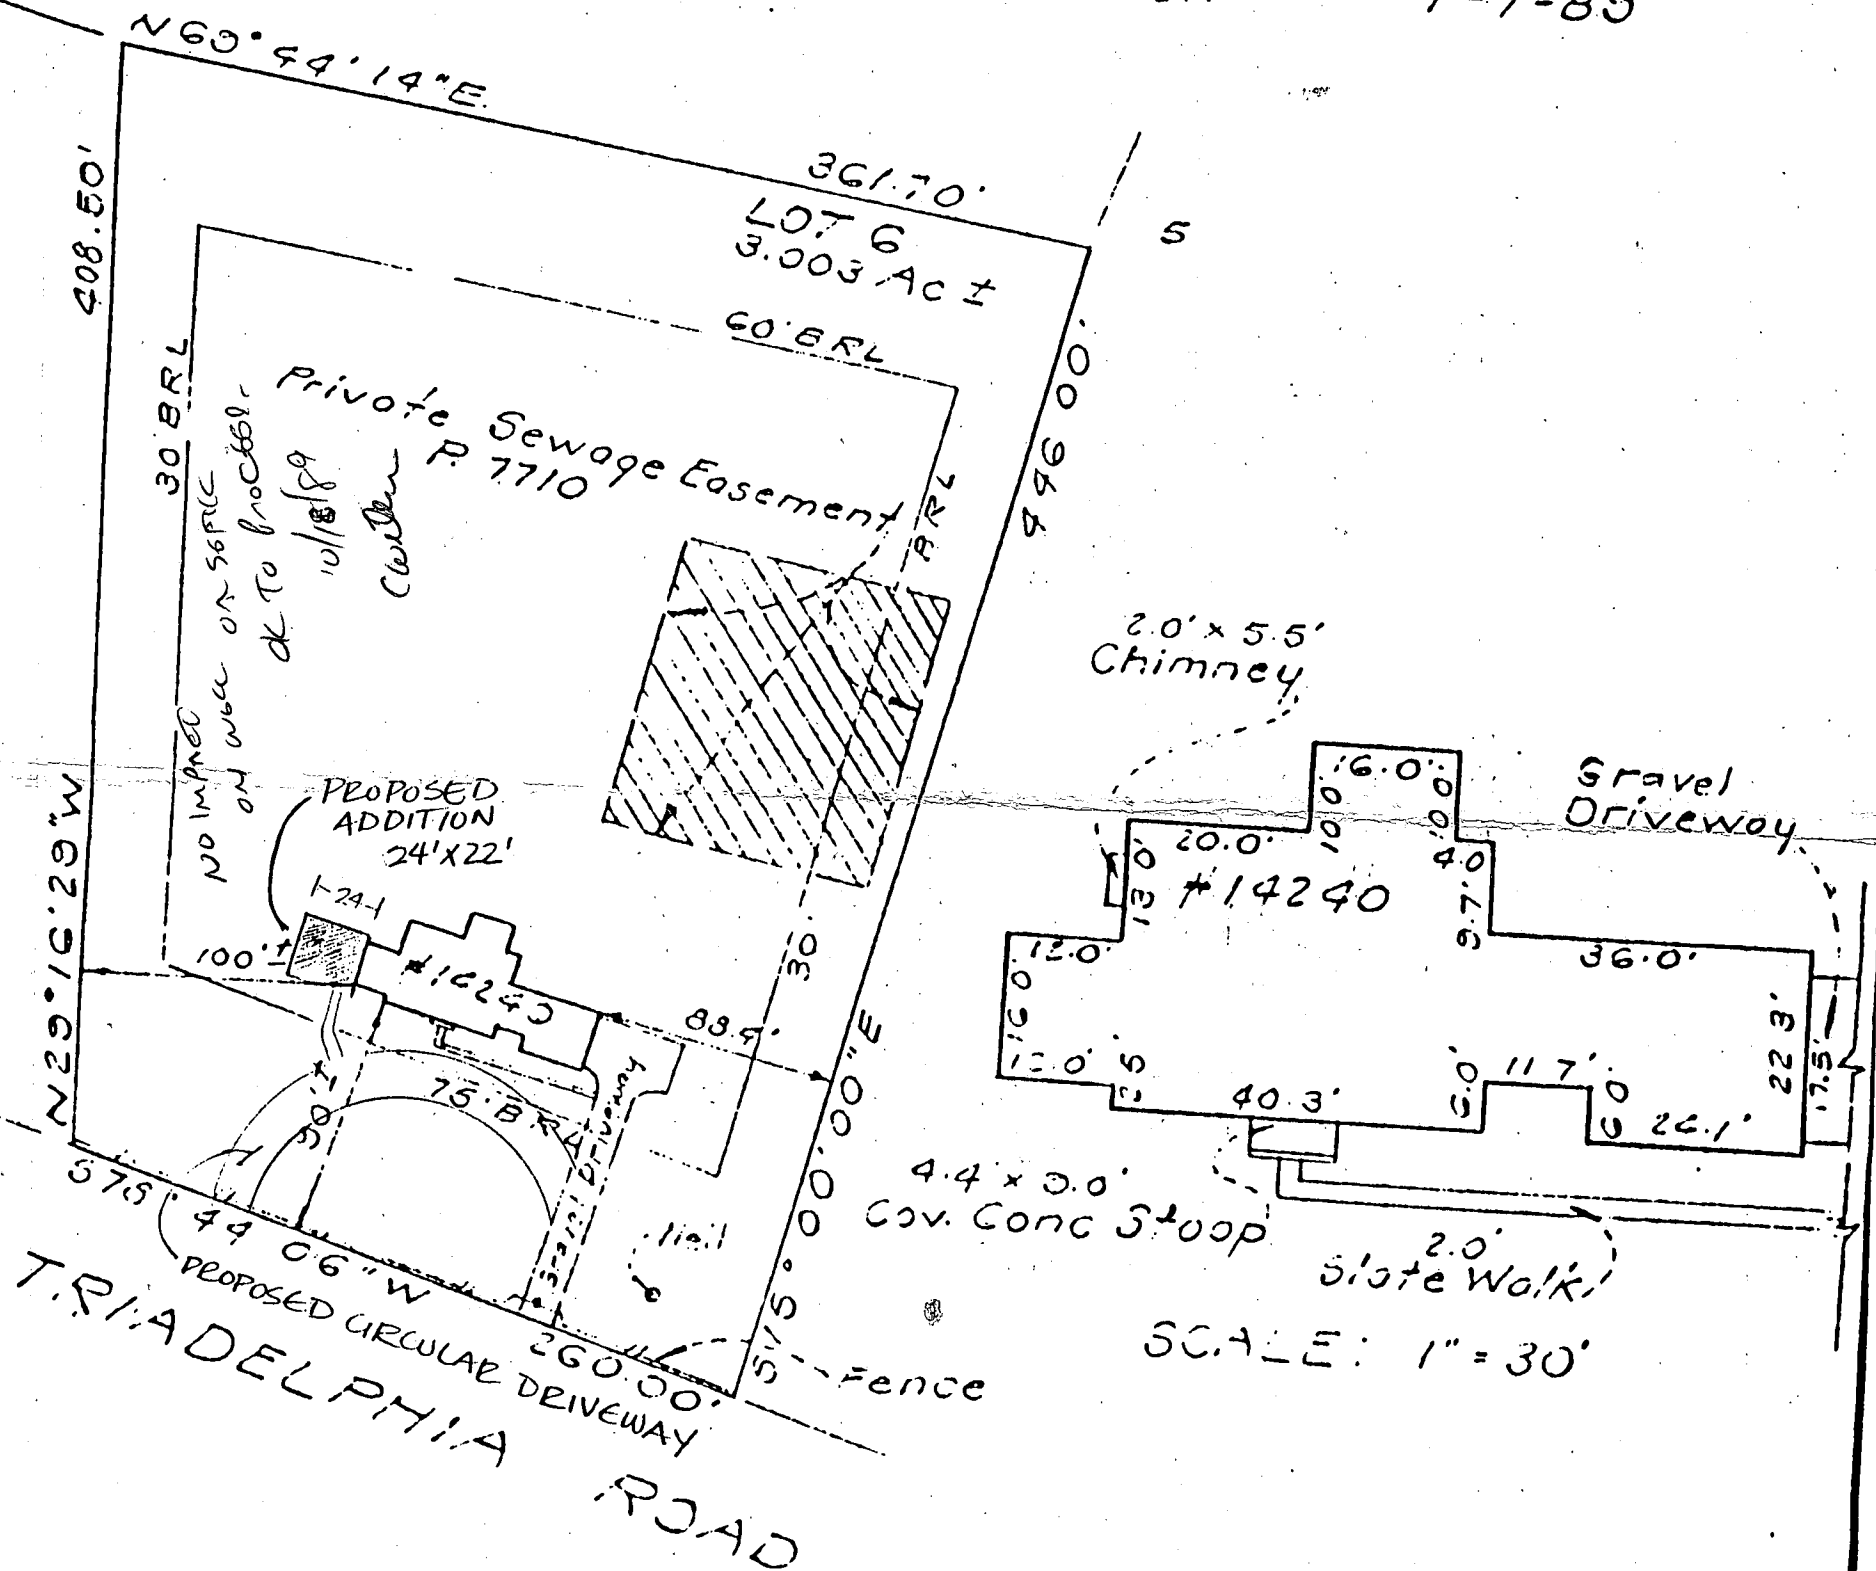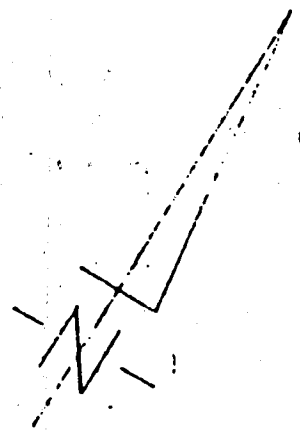

85-170

SURVEYOR'S CERTIFICATE

I hereby certify that the position of all existing improvements on the above described property have been carefully established by a transit-tape survey and that unless otherwise shown, there are no encroachments.

Donald B. Sackett 6059

CLARK • FINEFROCK & SACKETT, INC.

ENGINEERS • PLANNERS • SURVEYORS
7135 MINSTREL WAY
COLUMBIA, MD. 21045
(301) 381-7500-BALTO. • (301) 821-8100-WASH.

REFERENCE

Plat

7710

DRAWN BY JNF

DATE 7-3-89

SCALE 1"=100'

CHECKED BY KWC


FILE NO.

601-W

Serial No. 30601

0.15958":1'

1/1

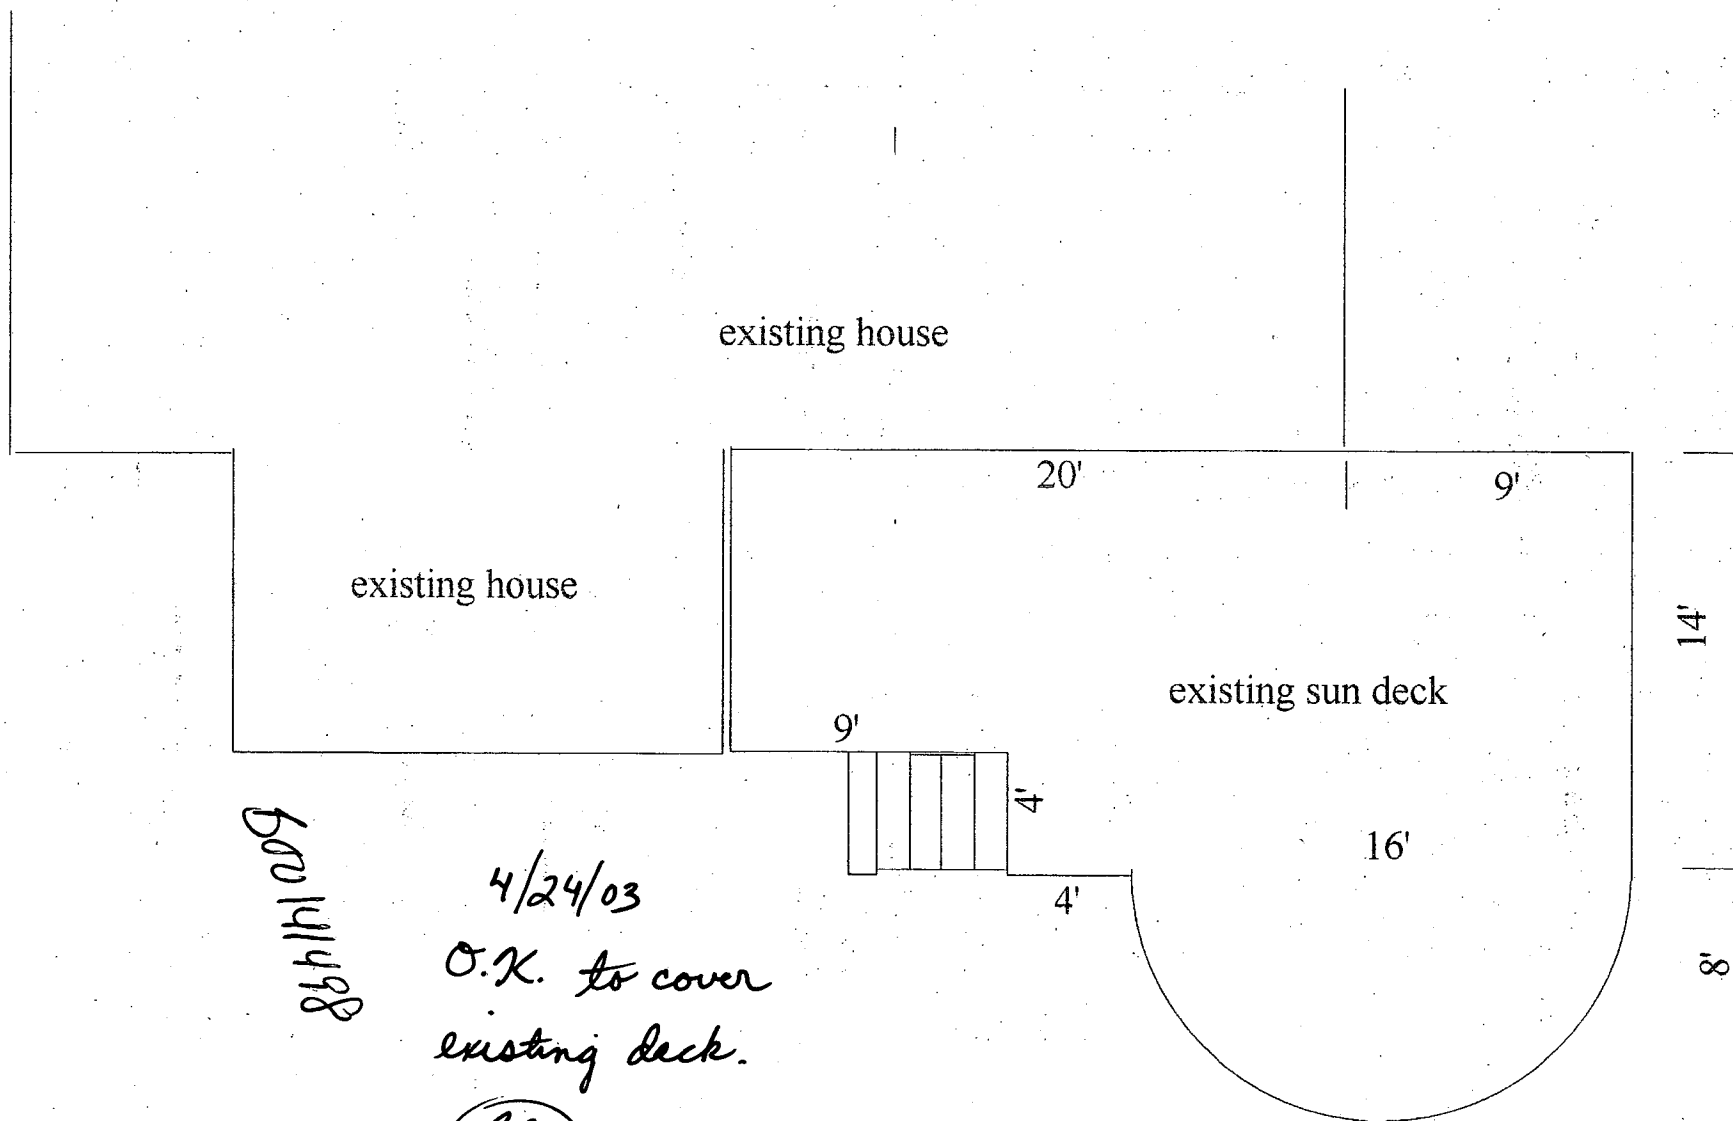


600141498

4/24/03

O.K. to cover
existing deck.

BB

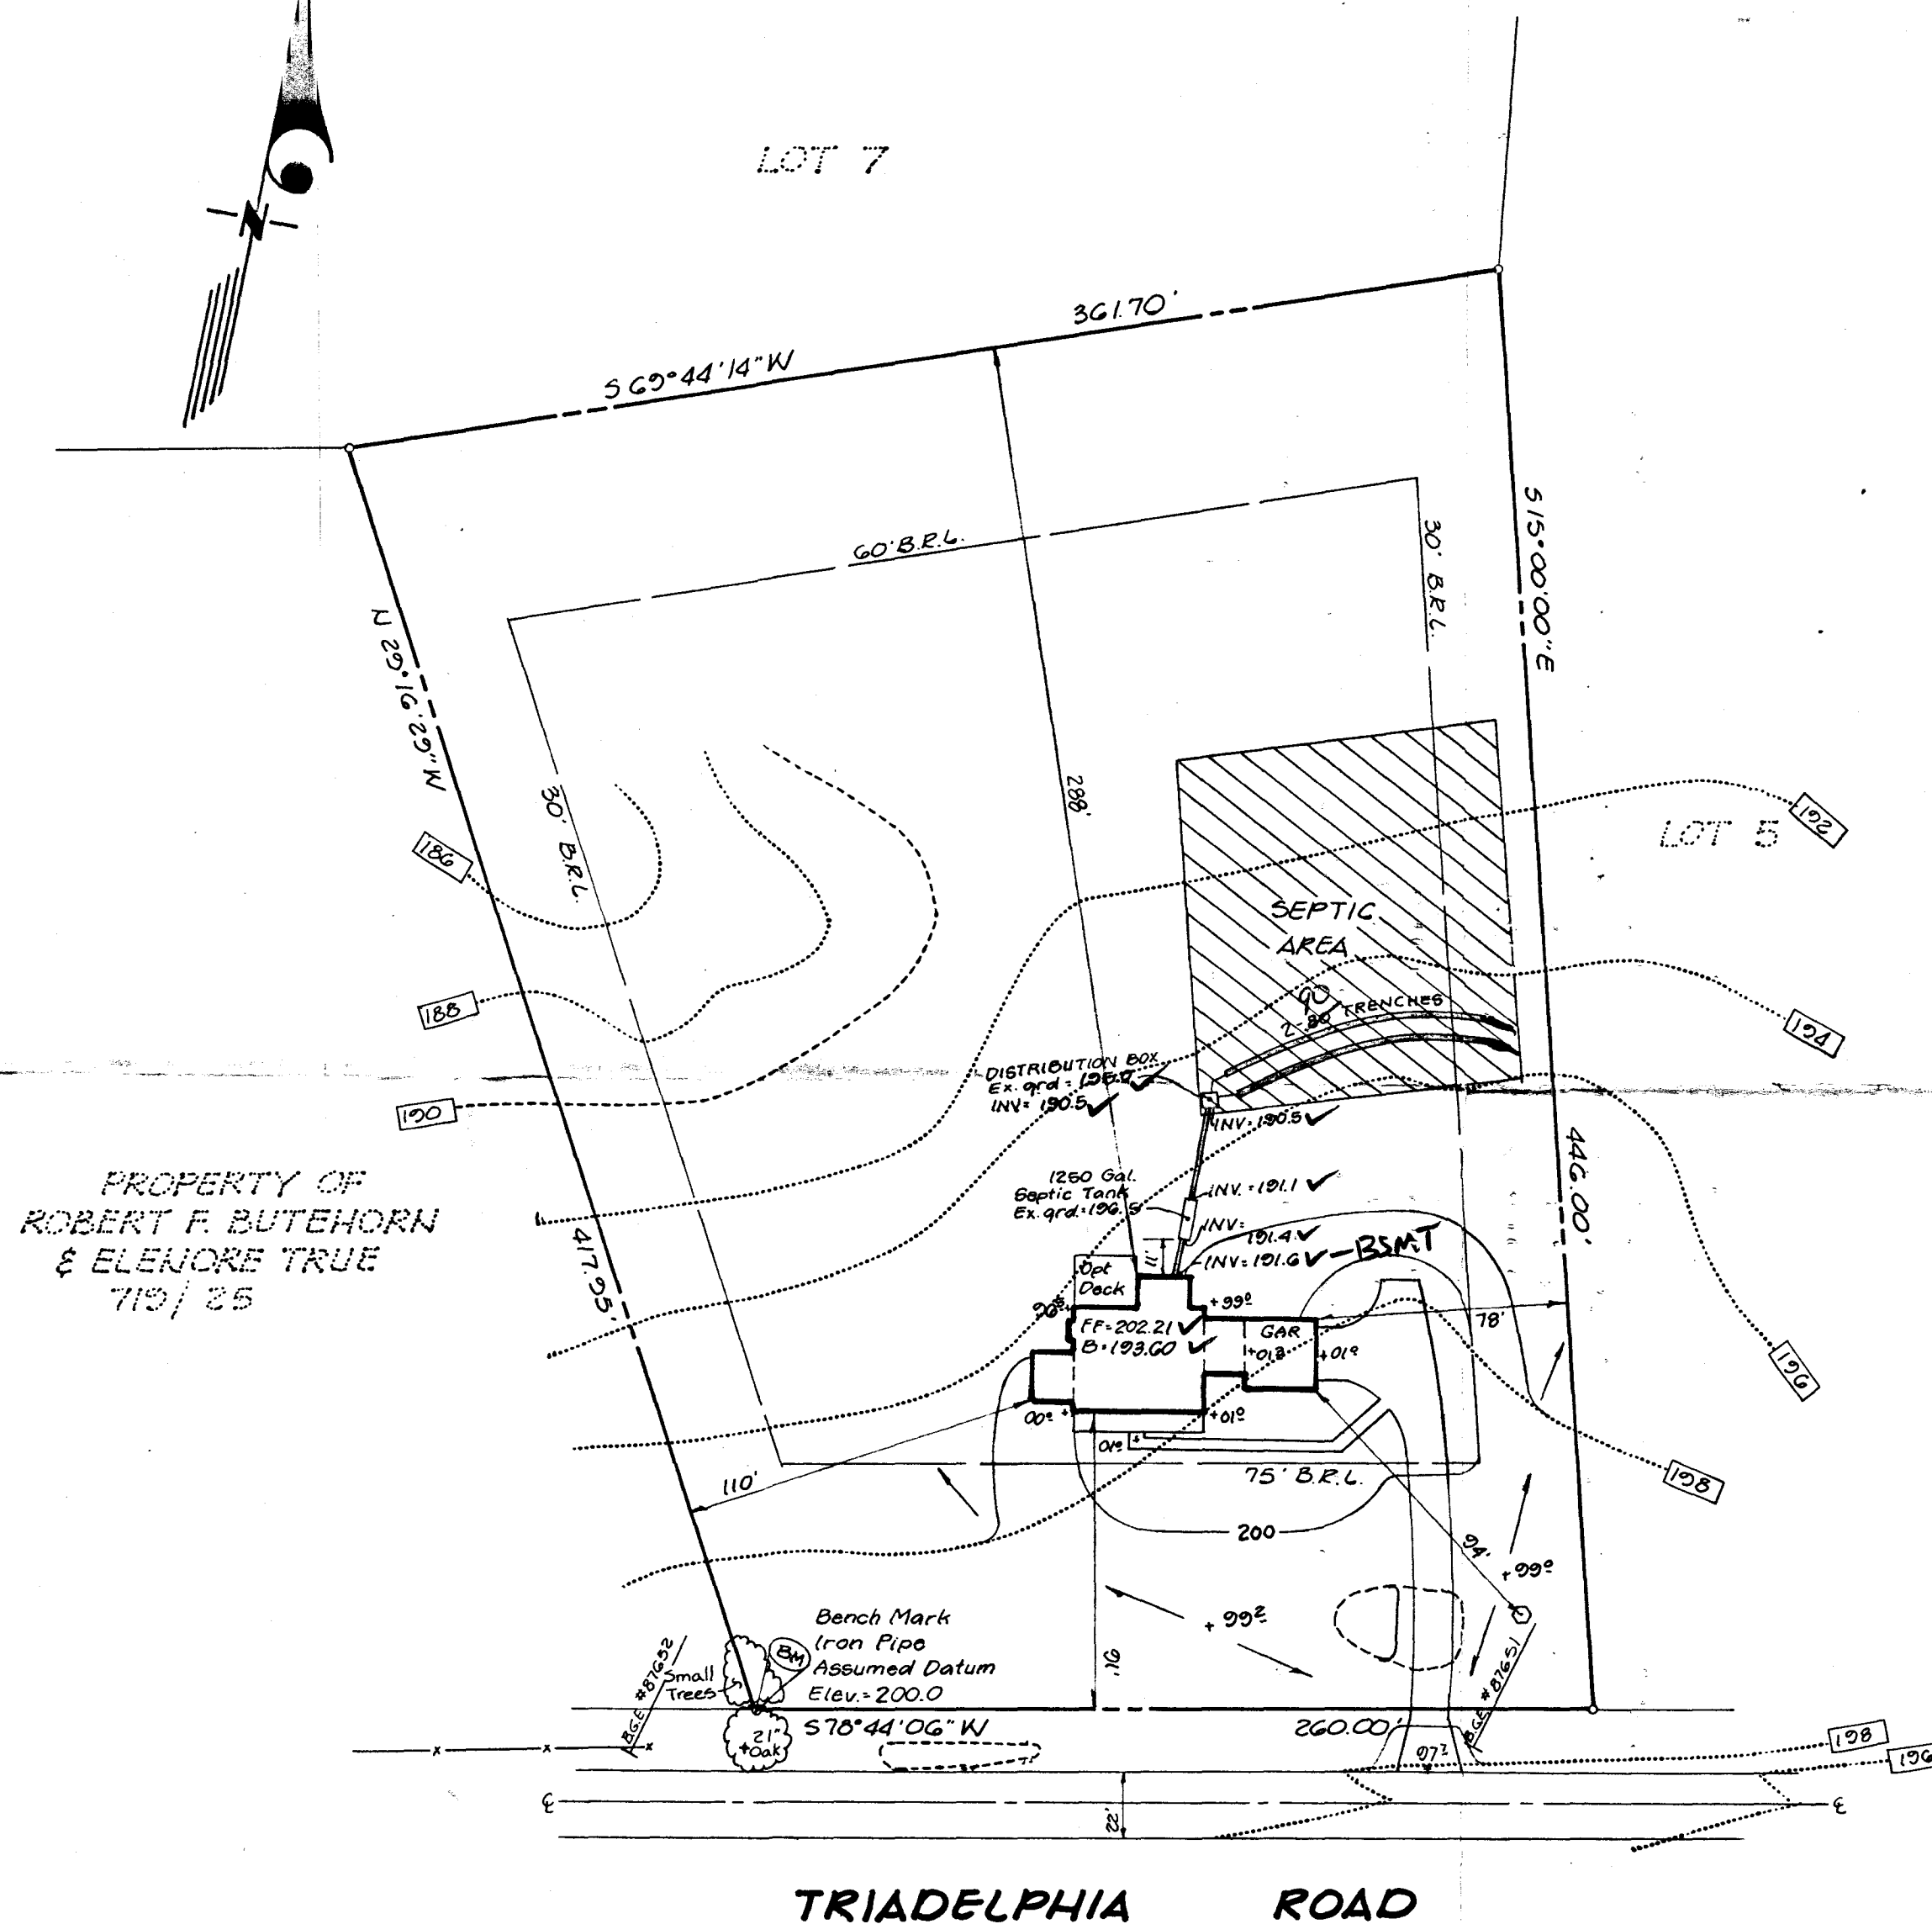


PROPERTY OF
ROBERT F. BUTEHORN
& ELENORE TRUE
719/25

TRIADELPHIA ROAD

8/9/88 elevations
on S&L

BLDG. PERMIT SIGNED
AND RETURNED 8/9/88
BP 20601
S-06

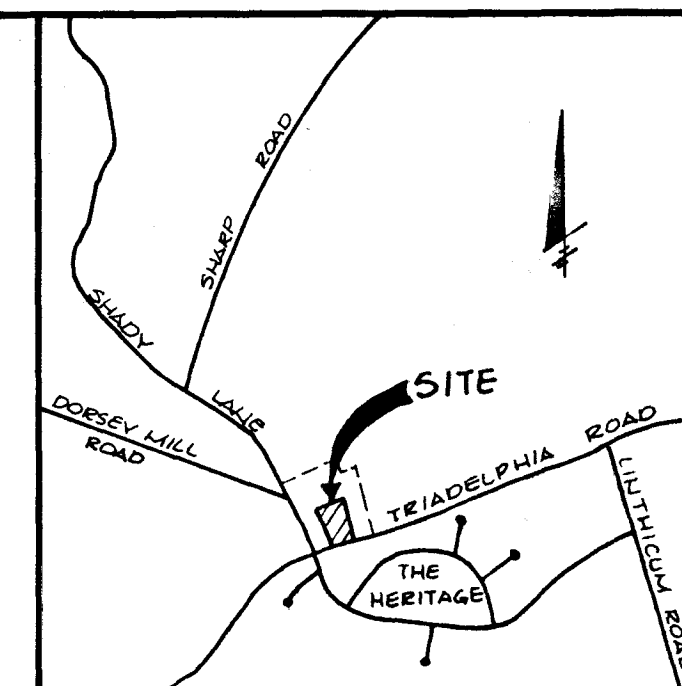

VICINITY MAP
SCALE: 1"=2000'

LEGEND

1. Contour Interval 2 ft
2. Existing Contour --- 190 ---
3. Proposed Contour --- 190 ---
4. Existing Spot Elev. 190 ±
5. Proposed Spot Elev. +20 ±
6. Direction of Drainage →

Topography prepared by Clark,
Finefrock, & Sackett.



CLARK • FINEFROCK & SACKETT, INC.
ENGINEERS • PLANNERS • SURVEYORS

7135 MINSTREL WAY • COLUMBIA, MD. 21045 • (301) 381-7200 - BALTO. • (301) 621-8100 - WASH.

DESIGNED P.D.M.	SITE DEVELOPMENT PLAN CHARLES SHARP SUBDIVISION LOT 6 FOURTH ELECTION DISTRICT HOWARD COUNTY, MARYLAND	SCALE 1"= 50'
DRAWN P.E.R.		DRAWING 1 of 1
CHECKED J.M.E.		JOB NO. 88-100
DATE August 1988		FILE NO. 88-100
For : Crosen Development Co. 3775 Sharp Road Glenwood, Maryland 21738		

