

approved 9/10/84
Stayed

03-300005

9/10/84
(AM.)

PERMIT

P 34126
A Repair

SEWAGE DISPOSAL SYSTEM

MARYLAND STATE DEPARTMENT OF HEALTH

ELLICOTT CITY

DISTRICT 3rd

DATE 7/20/84

HOWARD COUNTY
BUREAU OF ENVIRONMENTAL HEALTH
992-2330

INDEX

Alan Mink IS PERMITTED TO INSTALL _____ ALTER X

ADDRESS 13088 Williamfield Drive, Ellicott City, Md. 21043 PHONE 531-3693

SUBDIVISION Rosemary Estates ROAD 13088 Williamfield Drive LOT 15B

PROPERTY OWNER Alan Mink

ADDRESS 13088 Williamfield Drive, Ellicott City, Md. 21043 Phone: 531-3693
482-2888

IF GARBAGE GRINDER IS USED INCREASE SEPTIC TANK CAPACITY BY 50% AND ABSORPTION AREA BY 22%.

GARBAGE GRINDER? YES _____ NO _____

SEPTIC TANK CAPACITY _____ GALLONS NUMBER OF BEDROOMS _____

REPAIR - Need trench 25 feet long, 2 feet wide, 11 feet deep, 7 feet of stone.

Add new trench off old trench.

DIRECTION Williamfield to END then left into woods (same DW)
CEDAK Sid.

BLDG. PERMIT SIGNED
AND RETURNED 7/20/84
Serial # 60121
Addition

PLANS APPROVED BY Frank A. Skinner DATE 7/20/84

COVER NO WORK UNTIL INSPECTED AND APPROVED.

NEITHER THE HOWARD COUNTY COUNCIL NOR THE HEALTH DEPARTMENT IS RESPONSIBLE FOR THE SUCCESSFUL OPERATION OF ANY SYSTEM.

NOTE: IF TRENCH IS USED CALL FOR INSPECTION BEFORE AND AFTER PLACING GRAVEL IN TRENCH.

NOTE: NO DRY WELL SHALL EXCEED 15 FOOT IN DIAMETER. NO ABSORPTION TRENCH TO EXCEED 100 FEET IN LENGTH.

NOTE: ALL PIPE FROM HOUSE TO SEPTIC TANK MUST BE CAST IRON OR SCHEDULE 40 PVC OR ABS.

PERMIT VOID AFTER THREE YEARS.


NOTE: INSTALL STAND PIPE ON SEPTIC TANK AND DRY WELL. STAND PIPES MUST BE 6 INCHES IN DIAMETER. CAST IRON, CONCRETE OR TERRA COTTA, OR PVC OR ABS ACCEPTED. IF TOP OF SEPTIC TANK IS DEEPER THAN 3 FEET MANHOLE TO GRADE REQUIRED.

*INSTALLER IS RESPONSIBLE FOR OBTAINING FINAL APROVAL ON THIS PERMIT

*CALL 992-2330 FOR INSPECTION OF SEPTIC SYSTEMS.

EH - 2-1082

734126

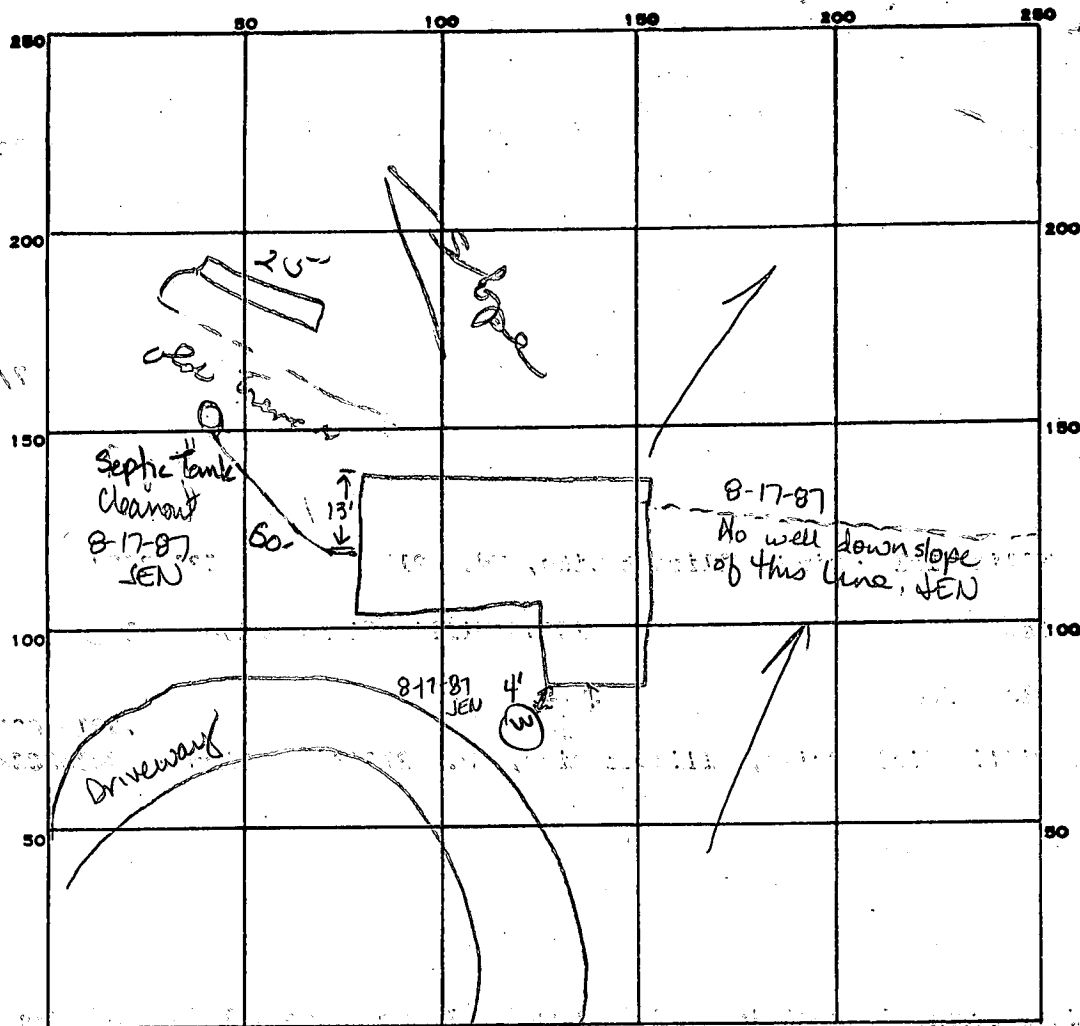

INDICATE NORTH. - NAME ADJOINING ROADWAY AS BASE LINE.

PERMIT CARD _____

SEPTIC TANK, LEVEL _____

CLEANOUTS _____

DISTRIBUTION BOX, LEVEL _____

TILE FIELD, DEPTH 10 FT. TRENCH WIDTH 2 FT.

GRAVEL DEPTH 7 IN. TOTAL LENGTH 25 FT.

NUMBER OF TRENCHES 1 TOTAL BOTTOM AREA 175

SEEPAGE PITS, INSIDE DIAMETER _____ FT. DEPTH BELOW INLET _____ FT.

ABSORBENT AREA 175 SQ. FT.

REMARKS 9/10/84 OK to add stone in trench
9/10/84 - OK to cover all work

DATE SYSTEM APPROVED 9/10/84 INSPECTOR S. Taylor

REGION 1

AREA _____ RATING _____

ACKNOWLEDGMENT AND CONTROLS	DATE

Howard County Department of Health
BUREAU OF ENVIRONMENTAL HEALTH

RECORD OF INVESTIGATION

DISPOSITION	DATE

LOCATION 13088 Williamfield Drive, Ellicott City ZIP 21043
OWNER ☒ Alan Mink ADDRESS same as above PHONE 531-3699
OCCUPANT ☐ Well site inspection ADDRESS same as above PHONE _____
COMPLAINANT Well site inspection ADDRESS same as above PHONE _____
REASON FOR INVESTIGATION Owner would like to replace well and use original well for a back-up. Low yield

CODES _____
RECEIVED BY JE Nadeau DATE 8-17-87 ASSIGNED TO _____ DATE _____

DATE OF INVESTIGATION 8-17-87 TIME 10:00 am WEATHER Sunny 90°±

REPORT Owner wants to drill an additional well to supplement his low yield well. Easterday recommended an area lower than the existing septic tank. Well should not be staked ^{lower} than the basement floor elevation at the back of the house.

DATE SUBMITTED 8-17-87

SANITARIAN

Jane E. Nadeau

1/30/76
around 11:00 A.M.
if possible

PERMIT

fleck HV
1-30-76

SEWAGE DISPOSAL SYSTEM

MARYLAND STATE DEPARTMENT OF HEALTH

HOWARD COUNTY

ELLICOTT CITY

DISTRICT 3rd

INDEXED

DATE 1/14/76

Jack Fyock

IS PERMITTED TO INSTALL X ALTER

ADDRESS Ten Oaks Road, Glenelg, Maryland

PHONE 286-2939

A SEWAGE DISPOSAL SYSTEM LOCATED AT _____

SUBDIVISION (Rosemary Estates)

ROAD Williamfield Drive

LOT 15

PROPERTY OWNER Alan Mink

ADDRESS 1510 Kanawha Street, Adelphia, Md. 20783

Phone: 445-1118

SPECIFICATIONS 3 bedrooms

DRAIN FIELD _____ DEPTH _____ FEET, BOTTOM AREA _____ SQ. FT.

SEEPAGE PITS _____ ABSORBENT SIDE-WALL AREA _____ SQ. FT.

SEPTIC TANK CAPACITY 1000 GALLONS

FOR GARBAGE GRINDER, INCREASE DISPOSAL AREA 22% & TANK CAPACITY 50%.

OTHER Trench - 75 ft. long for a total of 525 sq. ft. absorbent area. Inlet at 4 ft. and maximum depth 11 ft. Locate the trench 50 ft. from the left lot line and 385 ft. from the front lot line as seen when facing the property from the end of Williamfield Drive. Keep trench on as level ground as possible. If septic tank is 3 ft. of more below grade, use manhole type cleanout to grade. CALL FOR INSPECTION OF TRENCH BEFORE PLACING STONE IN TRENCH.

NOTE: ALL PIPE FROM HOUSE TO DISPOSAL AREA MUST BE CAST IRON.

PERMIT VOID AFTER THREE YEARS.

NOTE: INSTALL STAND PIPE ON SEPTIC TANK. STAND PIPES MUST BE 6 INCHES IN DIAMETER.

CAST IRON, CONCRETE OR TERRA COTTA ACCEPTED.

PLANS APPROVED BY Frank Skinner DATE 8/29/75 & 1/14/76


FILL SEPTIC TANK AND DISTRIBUTION BOX WITH WATER BEFORE CALLING FOR AN INSPECTION. COVER NO WORK UNTIL INSPECTED AND APPROVED.

NEITHER THE HOWARD COUNTY COMMISSIONERS NOR THE HEALTH DEPARTMENT IS RESPONSIBLE FOR THE SUCCESSFUL OPERATION OF ANY SYSTEM.

BLDG. PERMIT SIGNED
AND RETURNED 7/20/84

Serial # 60121
Addition

A 21454

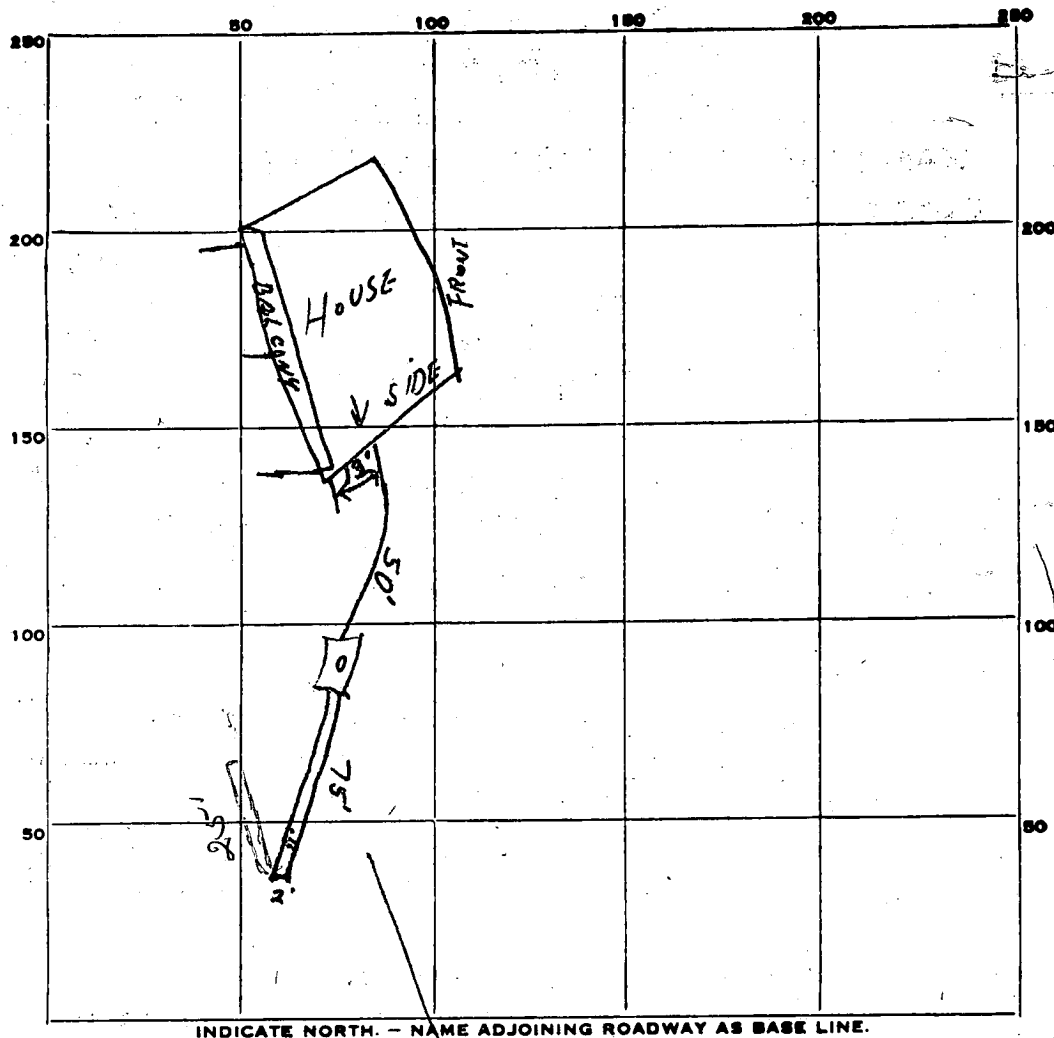

INDICATE NORTH. - NAME ADJOINING ROADWAY AS BASE LINE.

PERMIT CARD PRESENT

SEPTIC TANK, LEVEL OK

CLEANOUTS OK S.T

DISTRIBUTION BOX, LEVEL INLET PIPE COMES IN AT 4"

TRENCH DEPTH 11' FT. TRENCH WIDTH 2' FT.

GRAVEL DEPTH 7.0 FT. TOTAL LENGTH 75' FT.

NUMBER OF TRENCHES 1 TOTAL BOTTOM AREA N/A

SEEPAGE PITS, INSIDE DIAMETER N/A FT. DEPTH BELOW INLET N/A FT.

ABSORBENT AREA 525 EXACTLY SQ. FT.

REMARKS 1-30-76 OK TO PUT REST OF GRAVEL IN SYSTEM + BACKFILL.

DATE SYSTEM APPROVED

1-30-76

INSPECTOR

H. J. ZBAR

Rosemary Estate 114176

LOT NUMBER 15

Absorbant Area/bedroom _____

SEPTIC TANK 1000 gal 1250 gal 1500 gal
3 bdrms 4 bdrms 5 bdrms

_____ DRY WELL _____
_____ inlet _____ Max. depth _____ Abs. Area
Located _____

TRENCH	Inlet	Max. depth	# bedrooms	Length	Abs. Area
<u>X</u>	<u>4 ft</u>	<u>11 ft</u>	<u>3</u>	<u>75</u>	<u>525 SQ. FT.</u>
			<u>4</u>	<u>100</u>	<u>700 SQ. FT.</u>

Locate the trench 50 ft from the back lot line and 3 ft from the front lot line as shown on the plan. The trench is to be located at the end of Williamfield Drive. Keep trench on a level ground as possible.

If dry well and trench are used leave a 5' earth buffer between them.

- ✓ If septic tank is 3' or more below grade, use manhole type cleanout to grade.
- ✓ If more than one trench is used space them parallel, twice their depth apart.
- ✓ Call office for inspection of trench before placing stone in trench.
- ✓ All pipe from house to disposal area cast iron.
- ✓ Install standpipe (6" min.) on septic tank and dry well. Cast iron, concrete, terra cotta ok. Trench distribution lines may be clay, asbestos cement, orangburg type, open joint cast iron or heavy duty plastic. (Commercial standard Cs228-61).

4-12' holes
10,000 ft.
Re-test

Mink

APPLICATION

A 21454

SEWAGE DISPOSAL TESTING

P _____

STATE OF MARYLAND - DEPARTMENT OF HEALTH AND MENTAL HYGIENE

HOWARD COUNTY HEALTH DEPARTMENT
ENVIRONMENTAL HEALTH SERVICES

DISTRICT 3

P. O. BOX 476, ELLICOTT CITY, MARYLAND 21043
TELEPHONE: 465-5000, EXT. 356

DATE 5/6/75

3 B.R. | 4 B.R.
1000 gal. septic tank | 1250 gal. septic tank
Drywell to have 125 sq. ft. effective sidewall absorption area per bedroom to begin below the first 4 ft. of non-porous soil. Maximum depth permitted for drywell is 12 ft. below original grade. Place the drywell 385 ft. from the front lot line and 50 ft. from the left side line as seen when facing the property from Williamfield Drive.
NOTE: Manhole type cleanout to grade is required if septic tank is more than 3 ft. in ground.

TO: THE COUNTY HEALTH OFFICER
ELLICOTT CITY, MARYLAND

I, HEREBY, APPLY FOR THE NECESSARY TEST IN ORDER TO CONSTRUCT (OR RECONSTRUCT) A SEWAGE DISPOSAL SYSTEM.

PROPERTY OWNER Alan Mink

ADDRESS 1510 Kanawha Street, Adelphia, Md. 20783 PHONE 301-445-1118

PROPERTY LOCATION:

SUBDIVISION (Rosemary Estates) LOT NO. 15

ROAD AND DESCRIPTION Williamfield Drive

SIZE OF LOT 5.003 acres TYPE BLDG. 3 or 4

NUMBER OF BEDROOMS
(Single Fmly. Dwllg.)

IF NOT SINGLE RESIDENCE DESCRIBE _____

THE SYSTEM INSTALLED UNDER THIS APPLICATION IS ACCEPTABLE ONLY UNTIL PUBLIC FACILITIES BECOME AVAILABLE.

SIGNATURE OF APPLICANT /s/ Alan Mink

BLDG. PERMIT SIGNED
AND RETURNED 8/29/75

✓ APPROVED BY Frank Cherner FOR Drywell DATE 8/29/75
(KIND OF SYSTEM)


REJECTED BY _____ FOR _____ DATE _____
(KIND OF SYSTEM)

HOLD PENDING FURTHER TESTS _____ DATE _____

REASONS FOR REJECTION OR HOLDING 5/21/75 Hold for certified hole location P.S.

THIS IS NOT A PERMIT

0' ③
 3' clayey
 Silty loam
 12'
 0' ②
 4' clayey
 mixed
 6' Sand
 & silty loam
 12'

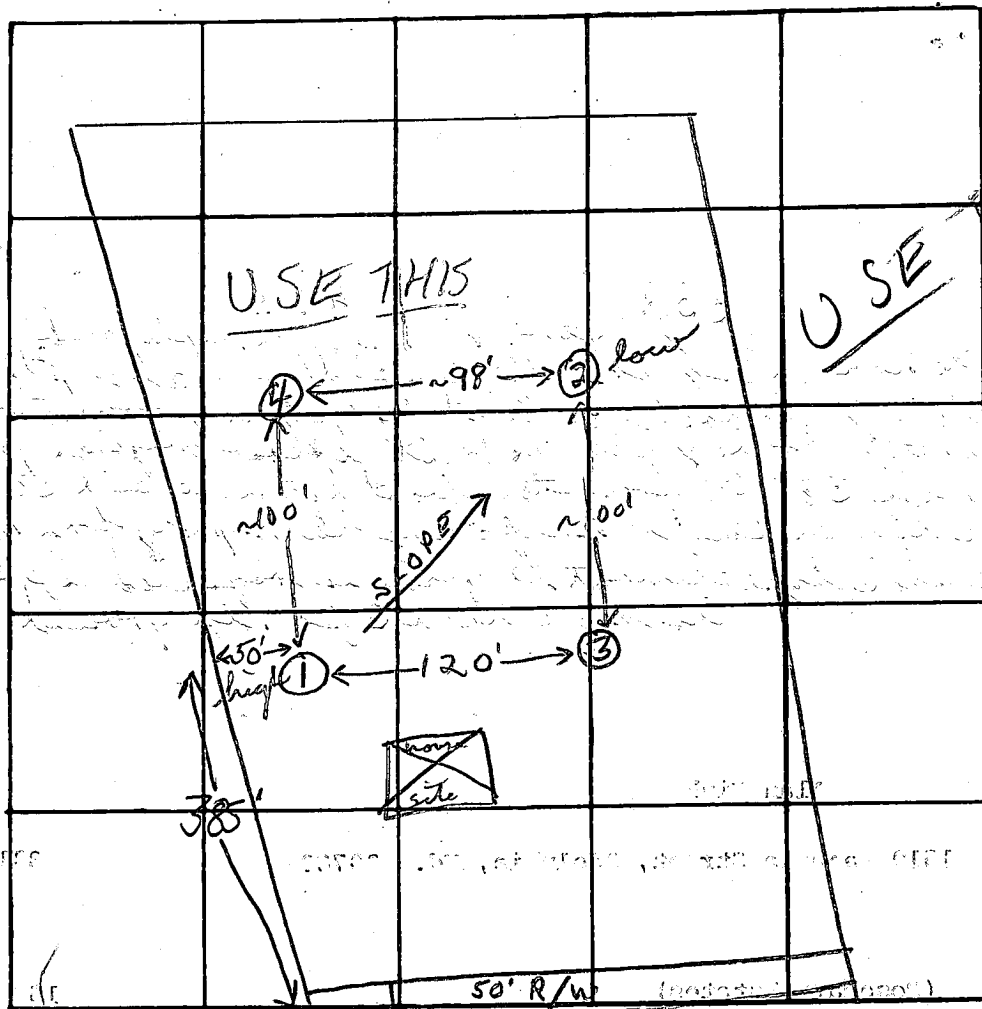

USE THIS

USE THIS

INDICATE NORTH NAME ADJOINING ROADWAY AS BASE LINE

Williamfield Dr

DATE	TEST NO.	DEPTH	PRE-WET		TEST - 1" DROP		TIME
			START	STOP	START	STOP	
5/21/25	1 high	5'	9:59	10:01	10:01	10:04	3min
(.011)	1A	12'	10:00	10:09	10:09	10:29	20min
	2	5 1/2'	10:25	10:26	10:26	10:28	2 min
	2A	12'	10:30	10:33	10:33	10:39	6 min
	3	5'	10:05	10:06	10:06	10:09	3min
	3A	12'	10:14	10:15	10:15	10:19	4 min
	4	12'	Visual; clayey to 2', mixed 2-5', sand & silty loam below				

7 min avg
 inlet 4'
 effective area
 sloped 4'
 1254/B.R.

REMARKS

Certify all holes toward rear of lot (4 holes)

TYPE OF SOIL

sandy & silty loam below top ~4' clayey soil

TESTED BY

F.S.

ALSO PRESENT:

J. Fyock & Co.

APPLICATION

A 21363

SEWAGE DISPOSAL TESTING

P _____

STATE OF MARYLAND - DEPARTMENT OF HEALTH AND MENTAL HYGIENE

HOWARD COUNTY HEALTH DEPARTMENT
ENVIRONMENTAL HEALTH SERVICES

DISTRICT 3

P. O. BOX 476, ELLICOTT CITY, MARYLAND 21043
TELEPHONE: 465-5000, EXT. 356

DATE 4/18/75

TO: THE COUNTY HEALTH OFFICER
ELLICOTT CITY, MARYLAND

I, HEREBY, APPLY FOR THE NECESSARY TEST IN ORDER TO CONSTRUCT (OR RECONSTRUCT) A SEWAGE DISPOSAL SYSTEM.

PROPERTY OWNER John Mikolasko and A. A. Krometis

ADDRESS 2205 Foxley Road, Timonium, Md. 21093 PHONE Work 765-2930
(Westinghouse)

PROPERTY LOCATION:

SUBDIVISION _____ LOT NO. 15

ROAD AND DESCRIPTION Williamfield Drive - Rosemary Lane - first driveway
to left on Rosemary Lane if using Triadelphia Road

SIZE OF LOT 5.003 acres TYPE BLDG. 3 or 4
NUMBER OF BEDROOMS

IF NOT SINGLE RESIDENCE DESCRIBE _____

THE SYSTEM INSTALLED UNDER THIS APPLICATION IS ACCEPTABLE ONLY UNTIL PUBLIC FACILITIES BECOME AVAILABLE.

SIGNATURE OF APPLICANT /s/ John Mikolasko




APPROVED BY _____ FOR _____ DATE _____
(KIND OF SYSTEM)

REJECTED BY _____ FOR _____ DATE _____
(KIND OF SYSTEM)

HOLD PENDING FURTHER TESTS _____ DATE _____

REASONS FOR REJECTION OR HOLDING 4/23/75 Hold for certified pers. hold location S.D.
5/21/75 not tested in rear S.D.

THIS IS NOT A PERMIT

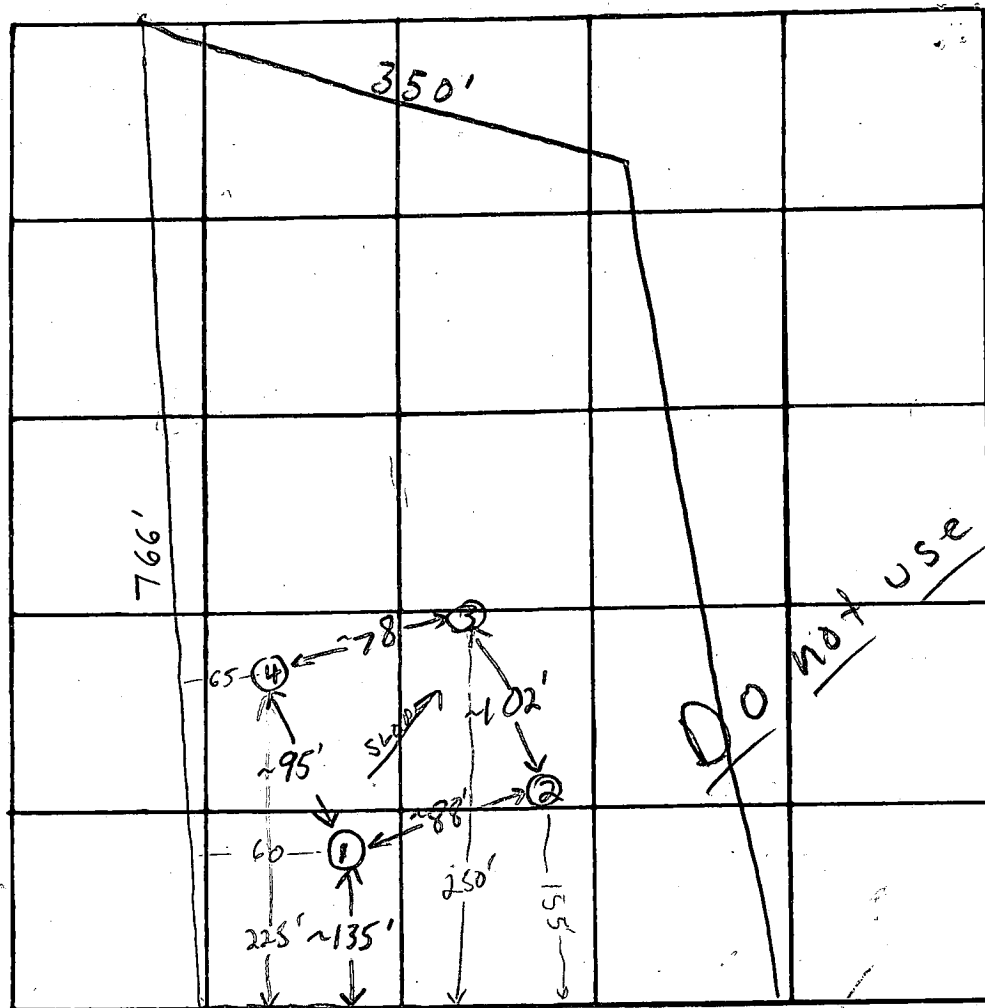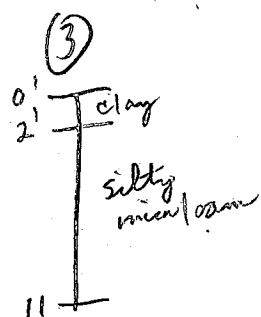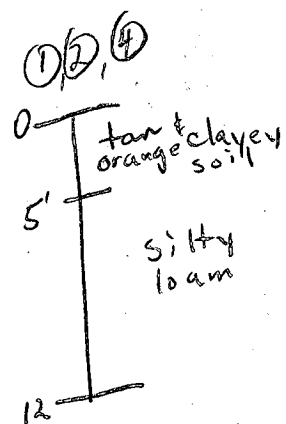

INDICATE NORTH - NAME ADJOINING HIGHWAY AS BASE LINE.
Williamfield Drive

DATE	TEST NO.	DEPTH	PRE-WET		TEST - 1" DROP		TIME
			START	STOP	START	STOP	
4/23/75	1 high	4 1/2'	2:52	2:54	2:54	2:56	2 min
	1A	12'	2:52	2:59	2:59	3:15	16 min
	2	5'	2:55	3:04	3:04	3:16	12 min
	2A	12'	2:55	2:58	2:58	3:03	5 min
	3 low	4'	3:00	3:02	3:02	3:05	3 min
	3A	11'	3:00	3:06	3:06	3:17	11 min
	4	11'	Visual; top 3' clayey, silty loam below				

REMARKS

excavated lot entirely all loam

TYPE OF SOIL

silty loam after 4-5' clayey soil

TESTED BY

F.S.

ALSO PRESENT:


Fyock & Co.

NOTE: The lot shown hereon complies with minimum ownership width and lot area as required by the Maryland State Department of Health Regulations.

APPROVED: FOR PRIVATE WATER AND PRIVATE SEWERAGE SYSTEMS, HOWARD COUNTY HEALTH DEPT.

J. J. [Signature]
County Health Officer

6/11/75
Date

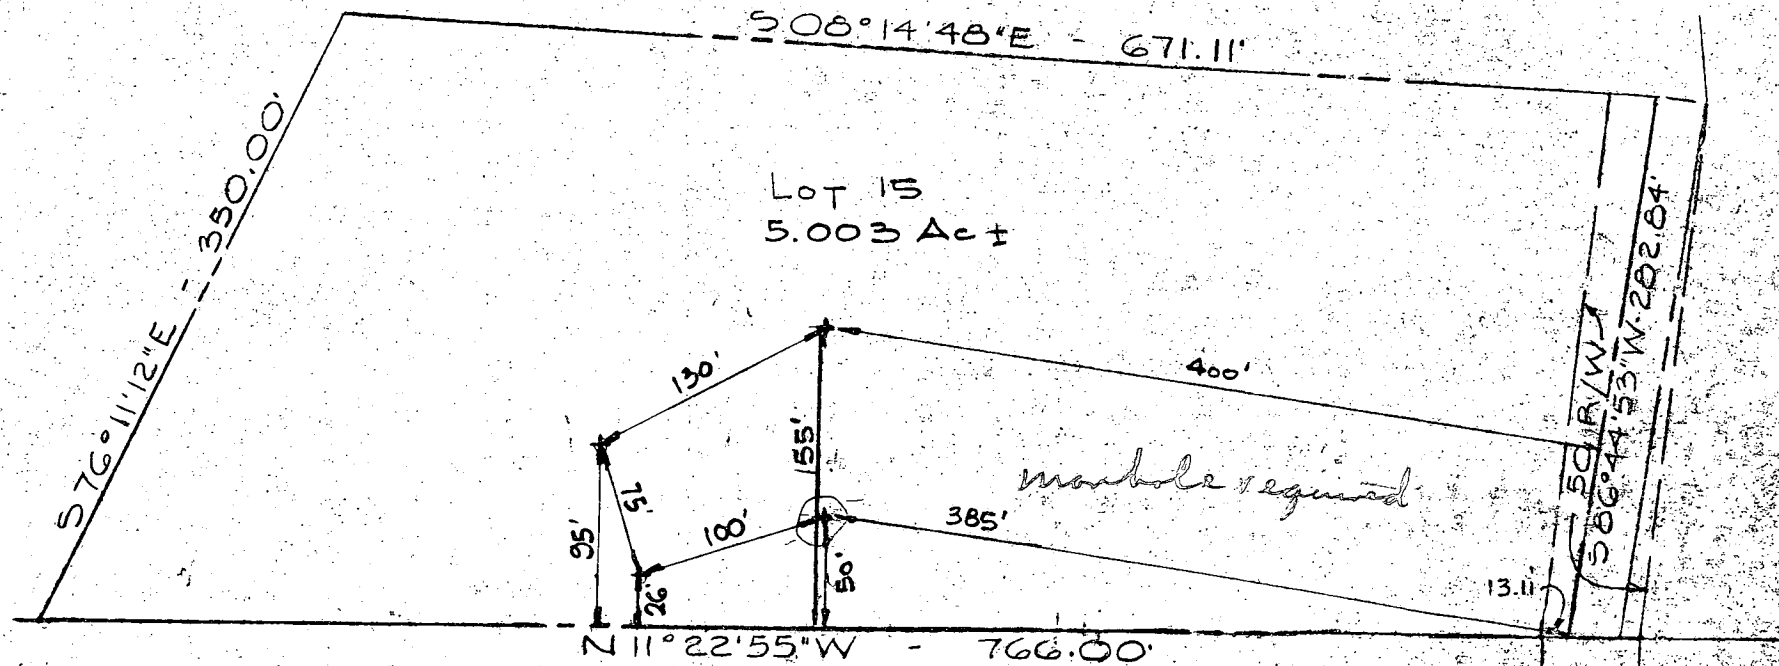

W. J. [Signature]
PURDUM & JESCHKE
ENGINEERS &
LAND SURVEYORS
3697 PARK AVENUE
ELICOTT CITY, MD. 21043

+ Percolation Test
field located

LOT 15
PROPERTY OF
ROSE MARY ESTATES
3RD ELECTION DISTRICT
HOWARD COUNTY, MARYLAND
SEPTEMBER 1974
SCALE: 1" = 100'

WILLIAMFIELD
DRIVE

B 1		0926		SEQUENCE NO. (WRA USE ONLY)		STATE OF MARYLAND WATER RESOURCES ADMINISTRATION TAWES STATE OFFICE BLDG., ANNAPOLIS, MARYLAND 21401 APPLICATION FOR PERMIT TO DRILL WELL		WRA PERMIT NUMBER HD-73-107-50 FILL IN THIS FORM COMPLETELY	
DATE RECEIVED (WRA USE ONLY) 12/15/75 10:00 A.M.		OWNER COL 15 LAST NAME 200 Conover Rd COL 36 Lemporeville Md 21554 COL 57		FIRST NAME COL 34 721 COL 55		COL 76			
B 1		CONTINUED		DRILLER INFORMATION		B 3		LOCATION OF WELL	
1 2 3 (SEQ. NO.) 6 DATE 6-27-75 LICENSE NUMBER 42 77 80 FIRST NAME Dr. F. Easterday DRILLER LAST NAME Easterday SIGNATURE Dr. F. Easterday		1 2 3 (SEQ. NO.) 6 COUNTY Howard SUBDIVISION 23 SECTION 44 46 LOT 15 NEAREST TOWN Glenely 52 71 MILES FROM TOWN (ENTER 0 IF IN TOWN) 73 M I 76 77 78		1 2 3 (SEQ. NO.) 6 COUNTY SUBDIVISION 23 SECTION 44 46 LOT 15 NEAREST TOWN 52 71 MILES FROM TOWN (ENTER 0 IF IN TOWN) 73 M I 76 77 78		1 2 3 (SEQ. NO.) 6 COUNTY SUBDIVISION 23 SECTION 44 46 LOT 15 NEAREST TOWN 52 71 MILES FROM TOWN (ENTER 0 IF IN TOWN) 73 M I 76 77 78		1 2 3 (SEQ. NO.) 6 COUNTY SUBDIVISION 23 SECTION 44 46 LOT 15 NEAREST TOWN 52 71 MILES FROM TOWN (ENTER 0 IF IN TOWN) 73 M I 76 77 78	
B 2		WELL INFORMATION		B 4		DIRECTION FROM TOWN (CIRCLE APPROPRIATE BOX)			
1 2 3 (SEQ. NO.) 6 MAXIMUM PUMPING RATE (GALLONS PER MINUTE) 5 8 12 AVERAGE DAILY QUANTITY NEEDED (GALLONS PER DAY) 600 14 20 USE FOR WATER (CIRCLE APPROPRIATE BOX) ☒ HOME (SINGLE OR DOUBLE HOUSEHOLD UNIT ONLY) ☐ FARMING, AGRICULTURE, IRRIGATION ☐ INDUSTRIAL, COMMERCIAL, STATE AND FEDERAL GOVERNMENT. ☐ MUNICIPAL WATER SUPPLY ☐ PRIVATE WATER COMPANY ☐ TEST MUST HAVE STATE HEALTH DEPT. APPROVAL		1 2 3 (SEQ. NO.) 6 COUNTY SUBDIVISION 23 SECTION 44 46 LOT 15 NEAREST TOWN 52 71 MILES FROM TOWN (ENTER 0 IF IN TOWN) 73 M I 76 77 78		1 2 3 (SEQ. NO.) 6 COUNTY SUBDIVISION 23 SECTION 44 46 LOT 15 NEAREST TOWN 52 71 MILES FROM TOWN (ENTER 0 IF IN TOWN) 73 M I 76 77 78		1 2 3 (SEQ. NO.) 6 COUNTY SUBDIVISION 23 SECTION 44 46 LOT 15 NEAREST TOWN 52 71 MILES FROM TOWN (ENTER 0 IF IN TOWN) 73 M I 76 77 78		1 2 3 (SEQ. NO.) 6 COUNTY SUBDIVISION 23 SECTION 44 46 LOT 15 NEAREST TOWN 52 71 MILES FROM TOWN (ENTER 0 IF IN TOWN) 73 M I 76 77 78	
APPROXIMATE DEPTH OF WELL 150 24 28 FEET APPROXIMATE DIAMETER OF WELL 6" (NEAREST INCH) METHOD OF DRILLING USED (CIRCLE APPROPRIATE METHOD) BORED (OR AUGERED) JETTED DRIVEN 30-37 AIR-ROTARY AIR-PERCUSSION ROTARY (HYDRAULIC ROTARY) CABLE REVERSE-ROTARY DRIVE-POINT OTHER (DESCRIBE)		APPROXIMATE DEPTH OF WELL 150 24 28 FEET APPROXIMATE DIAMETER OF WELL 6" (NEAREST INCH) METHOD OF DRILLING USED (CIRCLE APPROPRIATE METHOD) BORED (OR AUGERED) JETTED DRIVEN 30-37 AIR-ROTARY AIR-PERCUSSION ROTARY (HYDRAULIC ROTARY) CABLE REVERSE-ROTARY DRIVE-POINT OTHER (DESCRIBE)		APPROXIMATE DEPTH OF WELL 150 24 28 FEET APPROXIMATE DIAMETER OF WELL 6" (NEAREST INCH) METHOD OF DRILLING USED (CIRCLE APPROPRIATE METHOD) BORED (OR AUGERED) JETTED DRIVEN 30-37 AIR-ROTARY AIR-PERCUSSION ROTARY (HYDRAULIC ROTARY) CABLE REVERSE-ROTARY DRIVE-POINT OTHER (DESCRIBE)		APPROXIMATE DEPTH OF WELL 150 24 28 FEET APPROXIMATE DIAMETER OF WELL 6" (NEAREST INCH) METHOD OF DRILLING USED (CIRCLE APPROPRIATE METHOD) BORED (OR AUGERED) JETTED DRIVEN 30-37 AIR-ROTARY AIR-PERCUSSION ROTARY (HYDRAULIC ROTARY) CABLE REVERSE-ROTARY DRIVE-POINT OTHER (DESCRIBE)		APPROXIMATE DEPTH OF WELL 150 24 28 FEET APPROXIMATE DIAMETER OF WELL 6" (NEAREST INCH) METHOD OF DRILLING USED (CIRCLE APPROPRIATE METHOD) BORED (OR AUGERED) JETTED DRIVEN 30-37 AIR-ROTARY AIR-PERCUSSION ROTARY (HYDRAULIC ROTARY) CABLE REVERSE-ROTARY DRIVE-POINT OTHER (DESCRIBE)	
REPLACEMENT OR DEEPEENED WELLS (CIRCLE APPROPRIATE BOX) ☐ THIS WELL WILL NOT REPLACE AN EXISTING WELL ☒ THIS WELL WILL REPLACE A WELL THAT WILL BE ABANDONED AND SEALED ☐ THIS WELL WILL REPLACE A WELL THAT WILL BE USED AS A STANDBY ☐ THIS WELL WILL DEEPEEN AN EXISTING WELL PERMIT NUMBER OF WELL TO BE REPLACED OR DEEPEENED (IF AVAILABLE)		REPLACEMENT OR DEEPEENED WELLS (CIRCLE APPROPRIATE BOX) ☐ THIS WELL WILL NOT REPLACE AN EXISTING WELL ☒ THIS WELL WILL REPLACE A WELL THAT WILL BE ABANDONED AND SEALED ☐ THIS WELL WILL REPLACE A WELL THAT WILL BE USED AS A STANDBY ☐ THIS WELL WILL DEEPEEN AN EXISTING WELL PERMIT NUMBER OF WELL TO BE REPLACED OR DEEPEENED (IF AVAILABLE)		REPLACEMENT OR DEEPEENED WELLS (CIRCLE APPROPRIATE BOX) ☐ THIS WELL WILL NOT REPLACE AN EXISTING WELL ☒ THIS WELL WILL REPLACE 1 2 3 (SEQ. NO.) 6 STATE HEALTH (CIRCLE BOX) MO. DAY YR. DATE 12 30 75 43 48 APPROVED BY Donald D. Donahoe, Commissioner		1 2 3 (SEQ. NO.) 6 COUNTY NAME COUNTY NO. APPROVED BY Donald D. Donahoe, Commissioner		1 2 3 (SEQ. NO.) 6 COUNTY NAME COUNTY NO. APPROVED BY Donald D. Donahoe, Commissioner		1 2 3 (SEQ. NO.) 6 COUNTY NAME COUNTY NO. APPROVED BY Donald D. Donahoe, Commissioner		1 2 3 (SEQ. NO.) 6 COUNTY NAME COUNTY NO. APPROVED BY Donald D. Donahoe, Commissioner	
NORTH COORDINATE 50 51 52 53 54 55 EAST COORDINATE 57 58 59 60 61 62 63 ELEVATION AT WELL HEAD (FEET) 65 66 67 68		NORTH COORDINATE 50 51 52 53 54 55 EAST COORDINATE 57 58 59 60 61 62 63 ELEVATION AT WELL HEAD (FEET) 65 66 67 68		NORTH COORDINATE 50 51 52 53 54 55 EAST COORDINATE 57 58 59 60 61 62 63 ELEVATION AT WELL HEAD (FEET) 65 66 67 68		NORTH COORDINATE 50 51 52 53 54 55 EAST COORDINATE 57 58 59 60 61 62 63 ELEVATION AT WELL HEAD (FEET) 65 66 67 68		NORTH COORDINATE 50 51 52 53 54 55 EAST COORDINATE 57 58 59 60 61 62 63 ELEVATION AT WELL HEAD (FEET) 65 66 67 68	
BOX NUMBER E 810 N 520		BOX NUMBER E 810 N 520		BOX NUMBER E 810 N 520		BOX NUMBER E 810 N 520		BOX NUMBER E 810 N 520	
O/B X		O/B X		O/B X		O/B X		O/B X	
O/O		O/O		O/O		O/O		O/O	
B 5		CONTINUED		SPECIAL CONDITIONS 8-63 (WRA USE ONLY)		SPECIAL CONDITIONS 8-63 (WRA USE ONLY)		SPECIAL CONDITIONS 8-63 (WRA USE ONLY)	
1 2 3 (SEQ. NO.) 6		1 2 3 (SEQ. NO.) 6		1 2 3 (SEQ. NO.) 6		1 2 3 (SEQ. NO.) 6		1 2 3 (SEQ. NO.) 6	

C 1	8091	SEQUENCE NO. (WRA USE ONLY)	STATE OF MARYLAND WATER RESOURCES ADMINISTRATION TAWES STATE OFFICE BLDG., ANNAPOLIS, MD. 21401 WELL COMPLETION REPORT		THIS REPORT MUST BE SUBMITTED WITH- IN 30 DAYS AFTER WELL COMPLETION																																			
1 2 3 (SEQ. NO.) 6 (THIS NUMBER IS TO BE PUNCHED IN COLS. 3-6 ON ALL CARDS)				FILL IN THIS FORM COMPLETELY																																				
DATE RECEIVED (WRA USE ONLY)		DATE WELL COMPLETED		DEPTH OF WELL																																				
		12-11-75		400																																				
		22 (TO NEAREST FOOT) 26																																						
PERMIT NO. FROM "PERMIT TO DRILL WELL"		H0-A3-10110																																						
COUNTY NUMBER		42																																						
DRILLERS IDENTIFICATION NO.																																								
OWNER: <u>Mind Alan</u> LAST NAME: <u>Alan</u> FIRST NAME: <u>Alan</u>																																								
STREET OR RFD: <u>700 Longview Rd</u> POST OFFICE: <u>Simpsonville Md</u>																																								
WELL DESCRIPTION																																								
STATE THE KIND OF FORMATIONS PENETRATED, THEIR COLOR, DEPTH, THICKNESS AND IF WATER BEARING																																								
<table border="1" style="width:100%; border-collapse: collapse;"> <thead> <tr> <th style="width:40%;">DESCRIPTION (USE ADDITIONAL SHEETS IF NECESSARY)</th> <th style="width:10%;">FEET</th> <th style="width:10%;">FROM</th> <th style="width:10%;">TO</th> <th style="width:10%;">CHECK IF WATER BEARING</th> </tr> </thead> <tbody> <tr> <td>Top Soil</td> <td>0</td> <td>3</td> <td></td> <td></td> </tr> <tr> <td>Sandy Shale</td> <td>3</td> <td>50</td> <td></td> <td></td> </tr> <tr> <td>Brown Shale</td> <td>50</td> <td>80</td> <td></td> <td></td> </tr> <tr> <td>Mika</td> <td>80</td> <td>260</td> <td></td> <td></td> </tr> <tr> <td>Gray Rock</td> <td>260</td> <td>280</td> <td></td> <td></td> </tr> <tr> <td>Mika</td> <td>280</td> <td>400</td> <td></td> <td></td> </tr> </tbody> </table>						DESCRIPTION (USE ADDITIONAL SHEETS IF NECESSARY)	FEET	FROM	TO	CHECK IF WATER BEARING	Top Soil	0	3			Sandy Shale	3	50			Brown Shale	50	80			Mika	80	260			Gray Rock	260	280			Mika	280	400		
DESCRIPTION (USE ADDITIONAL SHEETS IF NECESSARY)	FEET	FROM	TO	CHECK IF WATER BEARING																																				
Top Soil	0	3																																						
Sandy Shale	3	50																																						
Brown Shale	50	80																																						
Mika	80	260																																						
Gray Rock	260	280																																						
Mika	280	400																																						
GROUTING RECORD																																								
WELL HAS BEEN GROUTED (CIRCLE APPROPRIATE BOX)																																								
YES ☒ NO ☐																																								
TYPE OF GROUTING MATERIAL (CIRCLE BOX)																																								
CEMENT ☒ BENTONITE CLAY ☐																																								
NO. OF BAGS <u>15</u> NO. OF POUNDS <u>1500</u>																																								
GALLONS OF WATER <u>75</u>																																								
DEPTH OF GROUT SEAL (TO NEAREST FOOT)																																								
FROM <u>0</u> FT. TO <u>46</u> FT.																																								
(ENTER 0 IF FROM SURFACE)																																								
CASING RECORD																																								
CASING TYPES																																								
(INSERT APPROPRIATE CODE BELOW)																																								
STEEL ☒ CONCRETE ☐																																								
PLASTIC ☐ OTHER ☐																																								
MAIN CASING TYPE																																								
S T																																								
NOMINAL DIAMETER TOP (MAIN) CASING (NEAREST INCH)																																								
6																																								
TOTAL DEPTH OF MAIN CASING (NEAREST FOOT)																																								
63																																								
OTHER CASING (IF USED)																																								
DIAMETER (INCH) DEPTH (FEET)																																								
FROM TO																																								
SCREEN RECORD																																								
SCREEN TYPE OR OPEN HOLE																																								
(INSERT APPROPRIATE CODE BELOW)																																								
STEEL ☒ BRASS OR BRONZE ☐ OPEN HOLE ☐																																								
PLASTIC ☐ OTHER ☐																																								
C 2																																								
1 2 3 (SEQ. NO.) 6																																								
DEPTH (NEAREST WHOLE FOOT)																																								
FROM <u>61</u> TO <u>400</u>																																								
EACH SCREEN																																								
1 H0 8 9 11 15 17 21																																								
2 23 24 26 30 32 36																																								
3 38 39 41 45 47 51																																								
SLOT SIZE 1, 2, 3																																								
DIAMETER OF SCREEN (NEAREST INCH)																																								
56 60																																								
GRAVEL PACK																																								
IF WELL DRILLED WAS A FLOWING WELL CIRCLE BOX																																								
68 ☐																																								
WRA USE ONLY (NOT TO BE FILLED IN BY DRILLER)																																								
TELESCOPE CASING																																								
70 ☐																																								
LOG INDICATOR																																								
72 ☐																																								
OTHER DATA AVAILABLE																																								
74 75 76																																								
77 78 79																																								
80 81 82																																								
83 84 85																																								
86 87 88																																								
89 90 91																																								
92 93 94																																								
95 96 97																																								
98 99 100																																								