

04-328655

app. 4/10/68
DW

3/29/68
Simpson
7/29/68

PERMIT

SEWAGE DISPOSAL SYSTEM

MARYLAND STATE DEPARTMENT OF HEALTH

HOWARD COUNTY

ELLICOTT CITY

INDEXED ✓

DISTRICT 1

DATE 3/29/68

P 1200

A 1275

Walter Post

IS PERMITTED TO INSTALL 1 ALTER

ADDRESS 301 Hamilton St., Silver Spring, Md.

PHONE 1-975-4993

A SEWAGE DISPOSAL SYSTEM LOCATED AT

SUPERVISION Robert Johnson

10625

ROAD Ed Marple Rd

LOT 8

PROPERTY OWNER

Robert Johnson

Robert Johnson

ADDRESS

BLDG. PERMIT SIGNED

AND RETURNED 8-11-68

Serial # 670 119873

SPECIFICATIONS - 6 Bedrooms

DRAIN FIELD DEPTH 4 FEET, BOTTOM AREA

60 SQ. FT.

SEEPAGE PITS ABSORBENT SIDE-WALL AREA

60 SQ. FT.

SEPTIC TANK CAPACITY 1,500 GALLONS

FOR GARBAGE GRINDER, INCREASE DISPOSAL AREA 25% & TANK CAPACITY 50%.

OTHER 10 Dry wells - 2 Dry wells - each 24 in. diameter and 3 ft. deep below

inlet pipe. Inlet pipe no deeper than 4 ft. below grade. first 2 chambers

120 ft. from left side line or deep when facing from Ed Marple Rd with one

dry well 200 ft. from front lot line and other dry well 200 ft. from front lot line

about 15 ft. from front lot line and about 35 ft. from front lot line.

PERMIT VOID AFTER THREE YEARS.

PLANS APPROVED BY D. W. McLaughlin

DATE 3/27/68

FILL SEPTIC TANK AND DISTRIBUTION BOX WITH WATER BEFORE CALLING FOR AN INSPECTION. COVER NO WORK UNTIL INSPECTED AND APPROVED.

NEITHER THE HOWARD COUNTY COMMISSIONERS NOR THE HEALTH DEPARTMENT IS RESPONSIBLE FOR THE SUCCESSFUL OPERATION OF ANY SYSTEM.

BLDG. PERMIT SIGNED

AND RETURNED 4/5/68


Serial # 4777-7rd

NOTIFY THE HEALTH DEPARTMENT 48 HOURS BEFORE EXCAVATIONS ARE TO BE BACK FILLED.

411934

344667-C

A11734-1662 Ed Warfield Rd L48

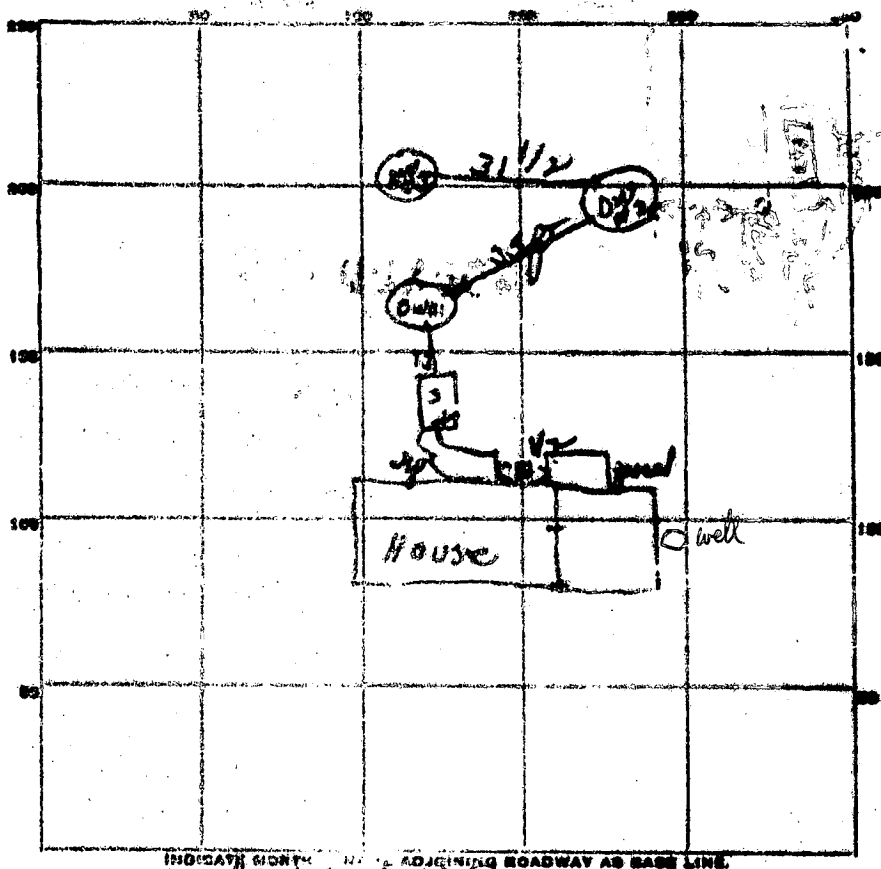

INDICATE NORTH ADJOINING ROADWAY AS BASE LINE

PERMIT CARD OK

SEPTIC TANK, LEVEL 6.5

CLEANOUTS OK - marked

DISTRIBUTION BOX, LEVEL _____

TILE FIELD, DEPTH _____ FT. TRENCH WIDTH _____ FT.

GRAVEL DEPTH _____ IN. TOTAL LENGTH _____ FT.

NUMBER OF TRENCHES _____ TOTAL BOTTOM AREA _____

SEEPAGE PIPS, INSIDE DIAMETER _____ FT. DEPTH BELOW INLET _____ FT.

ABSORBENT AREA _____ SQ. FT.

REMARKS 3/6/68
Dry Well #1 11 ft well to well diameter and 9 ft pipe inlet =
" " #2 10 1/2 " " " " " 9 ft " " "
" " #3 11 " " " " " 9 ft " " "

Total 27 ft


line from house to Septic Tank not yet installed - believe final inspection
when done - OK to come from Septic Tank to including dry wells

DATE SYSTEM IMPROVED

4/14/68

INSPECTOR

Jim M. M...

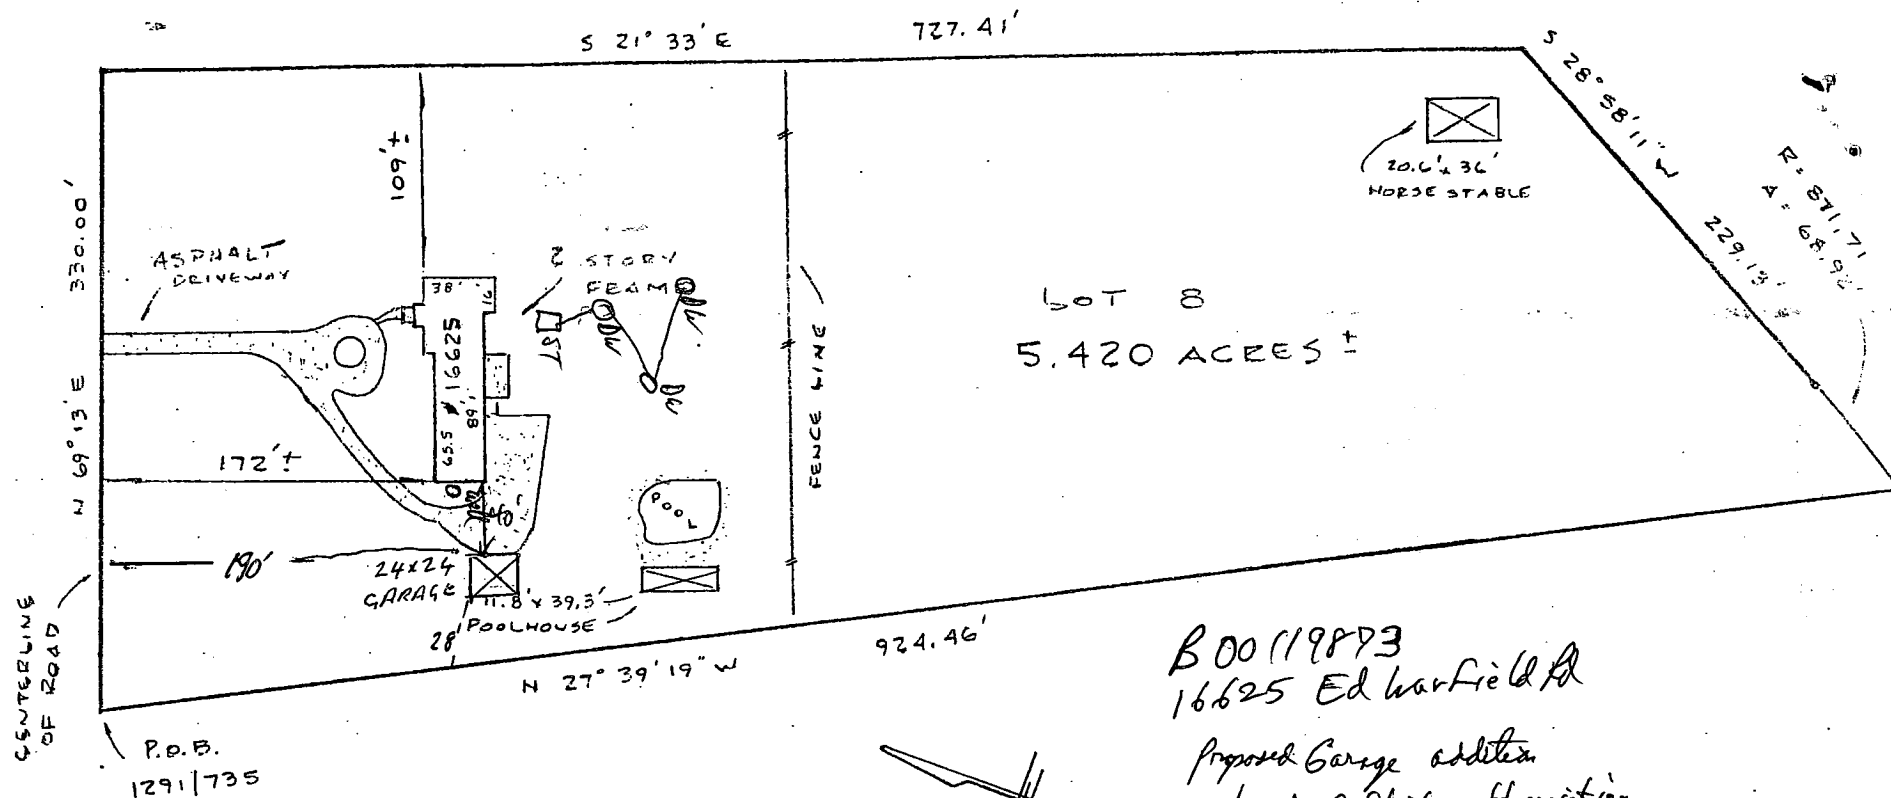

Subject property is shown in Zone C
on the National Flood Insurance Program
Flood Insurance Rate Map of HOWARD
County, Maryland. Panel# 13 OF 45
Community Panel# 240044 0013B
Effective Date: 4 DEC 86

This is to certify that I have surveyed the
property shown hereon, being the same property
described in a deed from
16625 ED WARFIELD ROAD
and recorded among the land records of HOWARD
COUNTY in Liber 1291 Folio 135 for the
purpose of locating the improvements thereon.

THIS PLAT SHOWS ONLY THAT THE IMPROVEMENTS ARE
CONTAINED WITHIN THE OUTLINES OF THE LOT AND IS
NOT TO BE USED TO ESTABLISH PROPERTY LINES.



J. Carl Hudgins PLS#96

LOCATION SURVEY

16625 ED WARFIELD ROAD
4th ELECTION DISTRICT
HOWARD COUNTY, MD.

NTT ASSOCIATES, INC.
16205 Old Frederick Road
Mt. Airy, Maryland 21771
Phone 442-2031

Scale 1" = 100'
Date 10-28-92
Field By RLG
Drawn By JLM
Drawing # AEC 3630

B00119873
16625 Ed Warfield Rd
Proposed Garage addition
has No Conflict w/ the existing
well or septic recommend approval
APK/HAY 8/11/99