

2/21/84
around 10:30 A.M.

03-296981
PERMIT

2/21/84 App'd J.S.

P 33565
A Repair

SEWAGE DISPOSAL SYSTEM

MARYLAND STATE DEPARTMENT OF HEALTH*

HOWARD COUNTY
BUREAU OF ENVIRONMENTAL HEALTH
992-2330

INDEX

ELLICOTT CITY
DISTRICT 3rd
DATE 2/17/84

Jenkins Brothers IS PERMITTED TO INSTALL _____ ALTER X

ADDRESS Route 144, Frederick Road, Ellicott City, Md. 21043 PHONE 465-6646

SUBDIVISION _____ ROAD 12224 Triadelphia Road LOT _____

PROPERTY OWNER Mr. Helsel

ADDRESS 12224 Triadelphia Road, Ellicott City, Md. 21043 Phone: 988-9565

IF GARBAGE GRINDER IS USED INCREASE SEPTIC TANK CAPACITY BY 50% AND ABSORPTION AREA BY 22%.

GARBAGE GRINDER? YES _____ NO _____

SEPTIC TANK CAPACITY _____ GALLONS NUMBER OF BEDROOMS _____

REPAIR - Replace existing septic tank with new 1000 gallon septic tank.

PLANS APPROVED BY Frank A. Skinner DATE 2/17/84 *B.P. 12/39 app.* *Bellevue & Son*

COVER NO WORK UNTIL INSPECTED AND APPROVED.

NEITHER THE HOWARD COUNTY COUNCIL NOR THE HEALTH DEPARTMENT IS RESPONSIBLE FOR THE SUCCESSFUL OPERATION OF ANY SYSTEM.

NOTE: IF TRENCH IS USED CALL FOR INSPECTION BEFORE AND AFTER PLACING GRAVEL IN TRENCH.

NOTE: NO DRY WELL SHALL EXCEED 15 FOOT IN DIAMETER. NO ABSORPTION TRENCH TO EXCEED 100 FEET IN LENGTH.

NOTE: ALL PIPE FROM HOUSE TO SEPTIC TANK MUST BE CAST IRON OR SCHEDULE 40 PVC OR ABS.

PERMIT VOID AFTER THREE YEARS.


NOTE: INSTALL STAND PIPE ON SEPTIC TANK AND DRY WELL. STAND PIPES MUST BE 6 INCHES IN DIAMETER. CAST IRON, CONCRETE OR TERRA COTTA, OR PVC OR ABS ACCEPTED. IF TOP OF SEPTIC TANK IS DEEPER THAN 3 FEET MANHOLE TO GRADE REQUIRED.

***INSTALLER IS RESPONSIBLE FOR OBTAINING FINAL APROVAL ON THIS PERMIT**

*CALL 992-2330 FOR INSPECTION OF SEPTIC SYSTEMS.

EH - 2-1082

X
P 33565

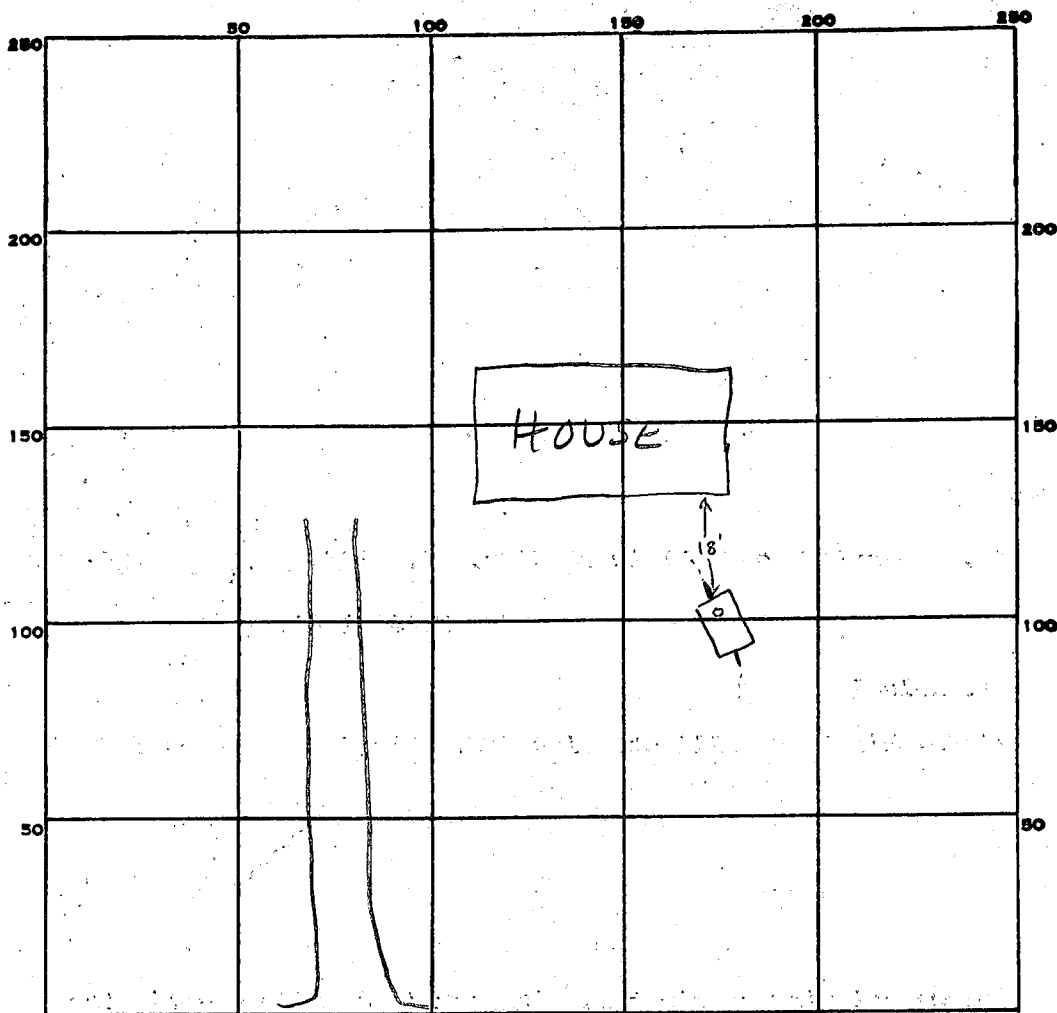

INDICATE NORTH. - NAME ADJOINING ROADWAY AS BASE LINE.

Triadelphia Road

PERMIT CARD ✓

SEPTIC TANK, LEVEL ✓

CLEANOUTS S.T. OK

DISTRIBUTION BOX, LEVEL na

TILE FIELD, DEPTH — FT. TRENCH WIDTH — FT.

GRAVEL DEPTH — IN. TOTAL LENGTH — FT.

NUMBER OF TRENCHES — TOTAL BOTTOM AREA —

SEEPAGE PITS, INSIDE DIAMETER — FT. DEPTH BELOW INLET — FT.

ABSORBENT AREA — SQ. FT.

REMARKS 2/21/84 ^{10:15} Not ready, J.S.

2/21/84 ^{2:30} OK to cover all work J.S.


DATE SYSTEM APPROVED

2/21/84

INSPECTOR


J. Skinnier

0049

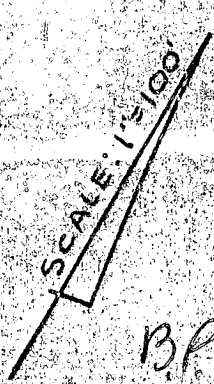

1361 H. Rd.
442-1578


8-11-72
DATE

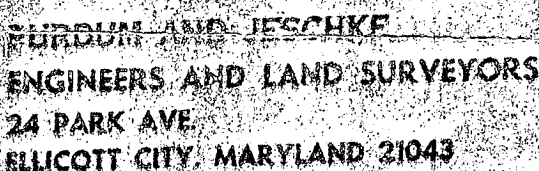

WILLIAM G. RASCH II REG. NO. 4575

NOTE:
THE LOT SHOWN HEREON
COMPLIES WITH MINIMUM
OWNERSHIP WIDTH AND LOT
AREA AS REQUIRED BY THE
MARYLAND STATE DEPART-
MENT OF HEALTH REGULATIONS

12139

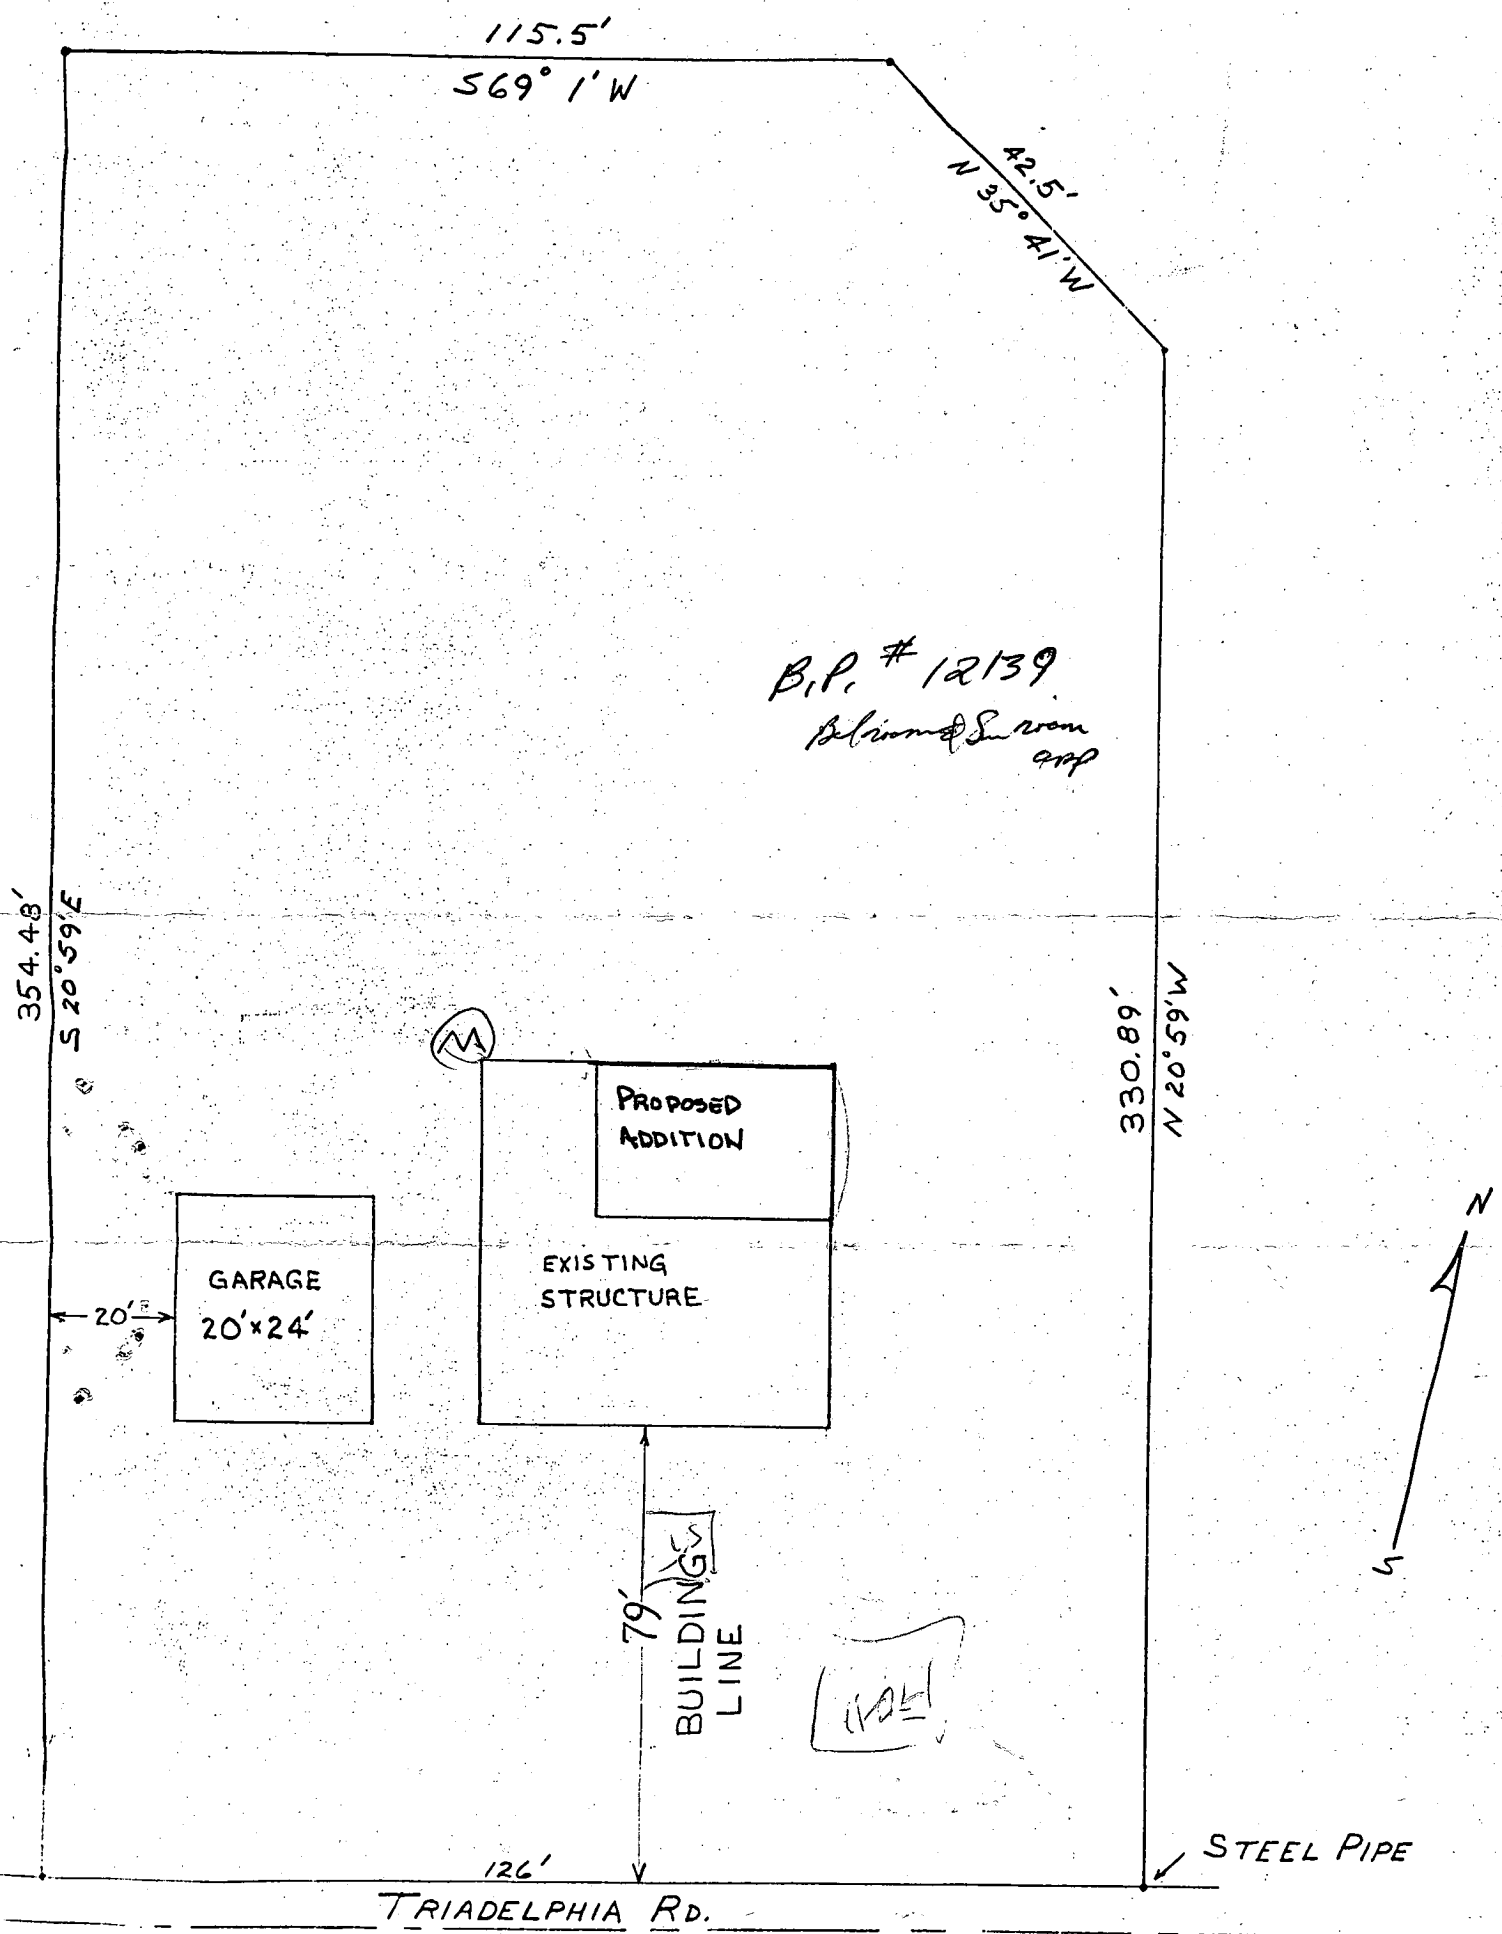

B.P. # 12139
Belmont & Son
9/87

5/25/87
no problem OK to sign
R/L

COUNTY: HOWARD	
FOLIO: 705	LIBER: 533
DISTRICT: 3RD	
DRAWN: W. ACEPA, JR	DATE: 14 APR 81

1" TO 50'

204'

813.52'

ERNEST R. SINES
SUBDIVISION
LOT 3, MAP 41
PARCEL 411
5th C.D. Dist.

B.P. 12070
7483 Pindell School Rd.

421.65'

NO

mini-barn

20'

75'

100'

SEPTIC
DRAIN
FIELD

100'

100'

150'

SEPTIC
TANK

HOUSE

WELL

DRIVEWAY

830'


COUNTY LAND FOR WIDENING OF ROAD

340'

PINDELL SCHOOL ROAD

5/26/87
NO PROBLEM
OK TO SIGN
Bjt

FRANCIS W. WERNICK, 7483 Pindell School Road, FULTON, Md. 20759

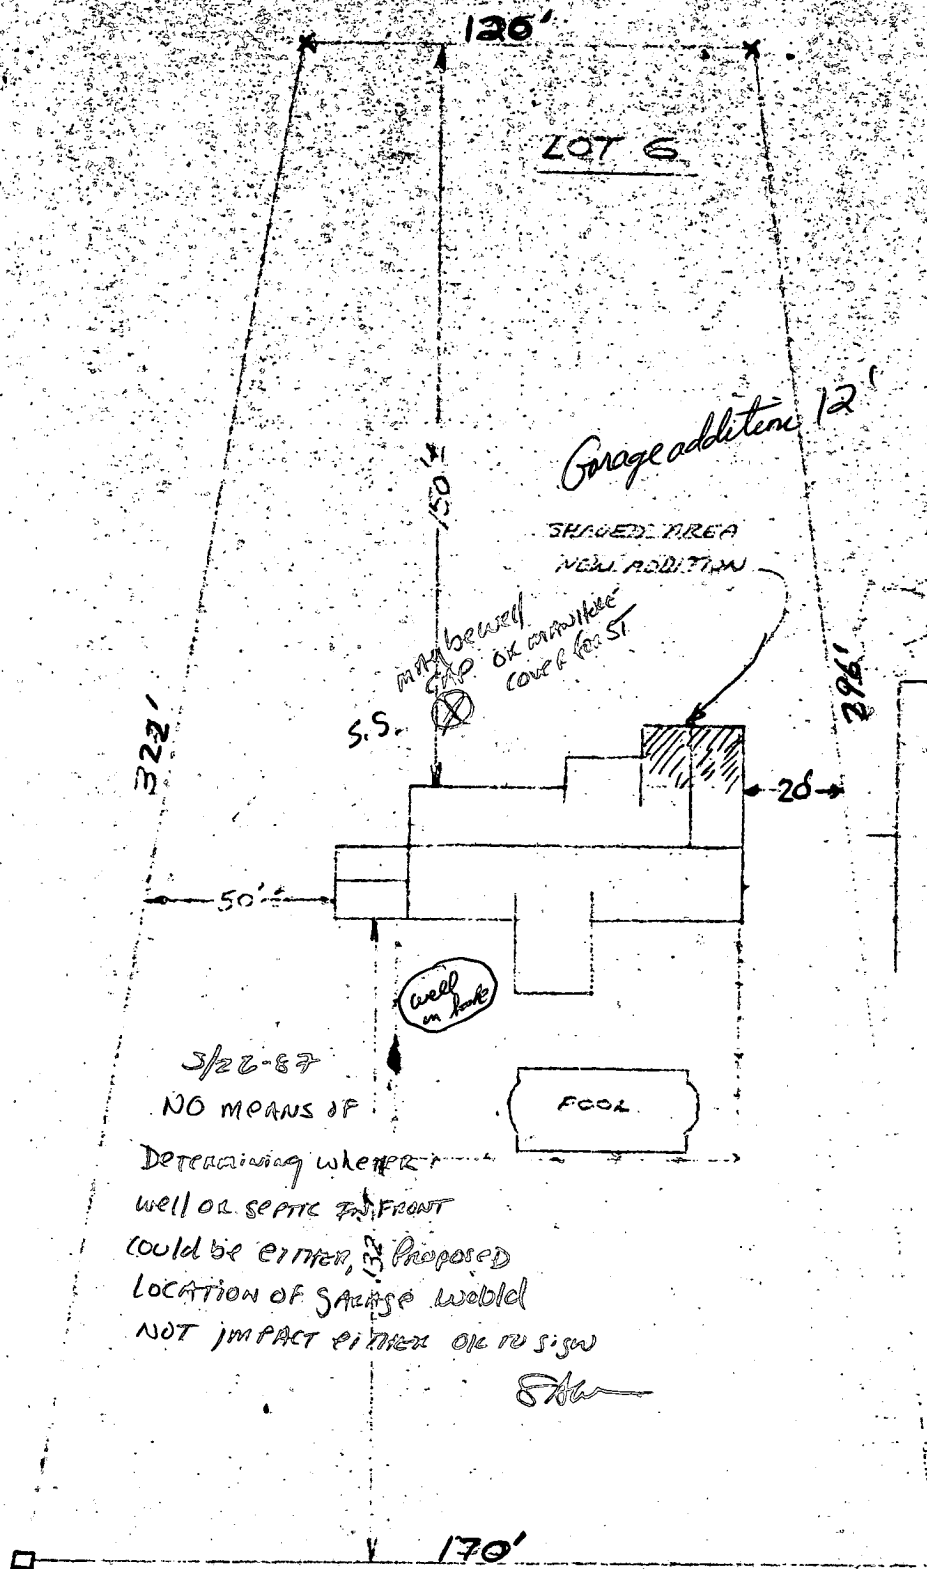


B.P. # 12053

EXISTING CONCRETE WALK

SITE PLAN

SCALE 1" = 40'

BREEZEWOOD FARM'S
10631 BREEZEWOOD DRIVE
HOWARD COUNTY MD 21763
LIBER CMP 710 FOLIO 101 LOT 6 SECT 1

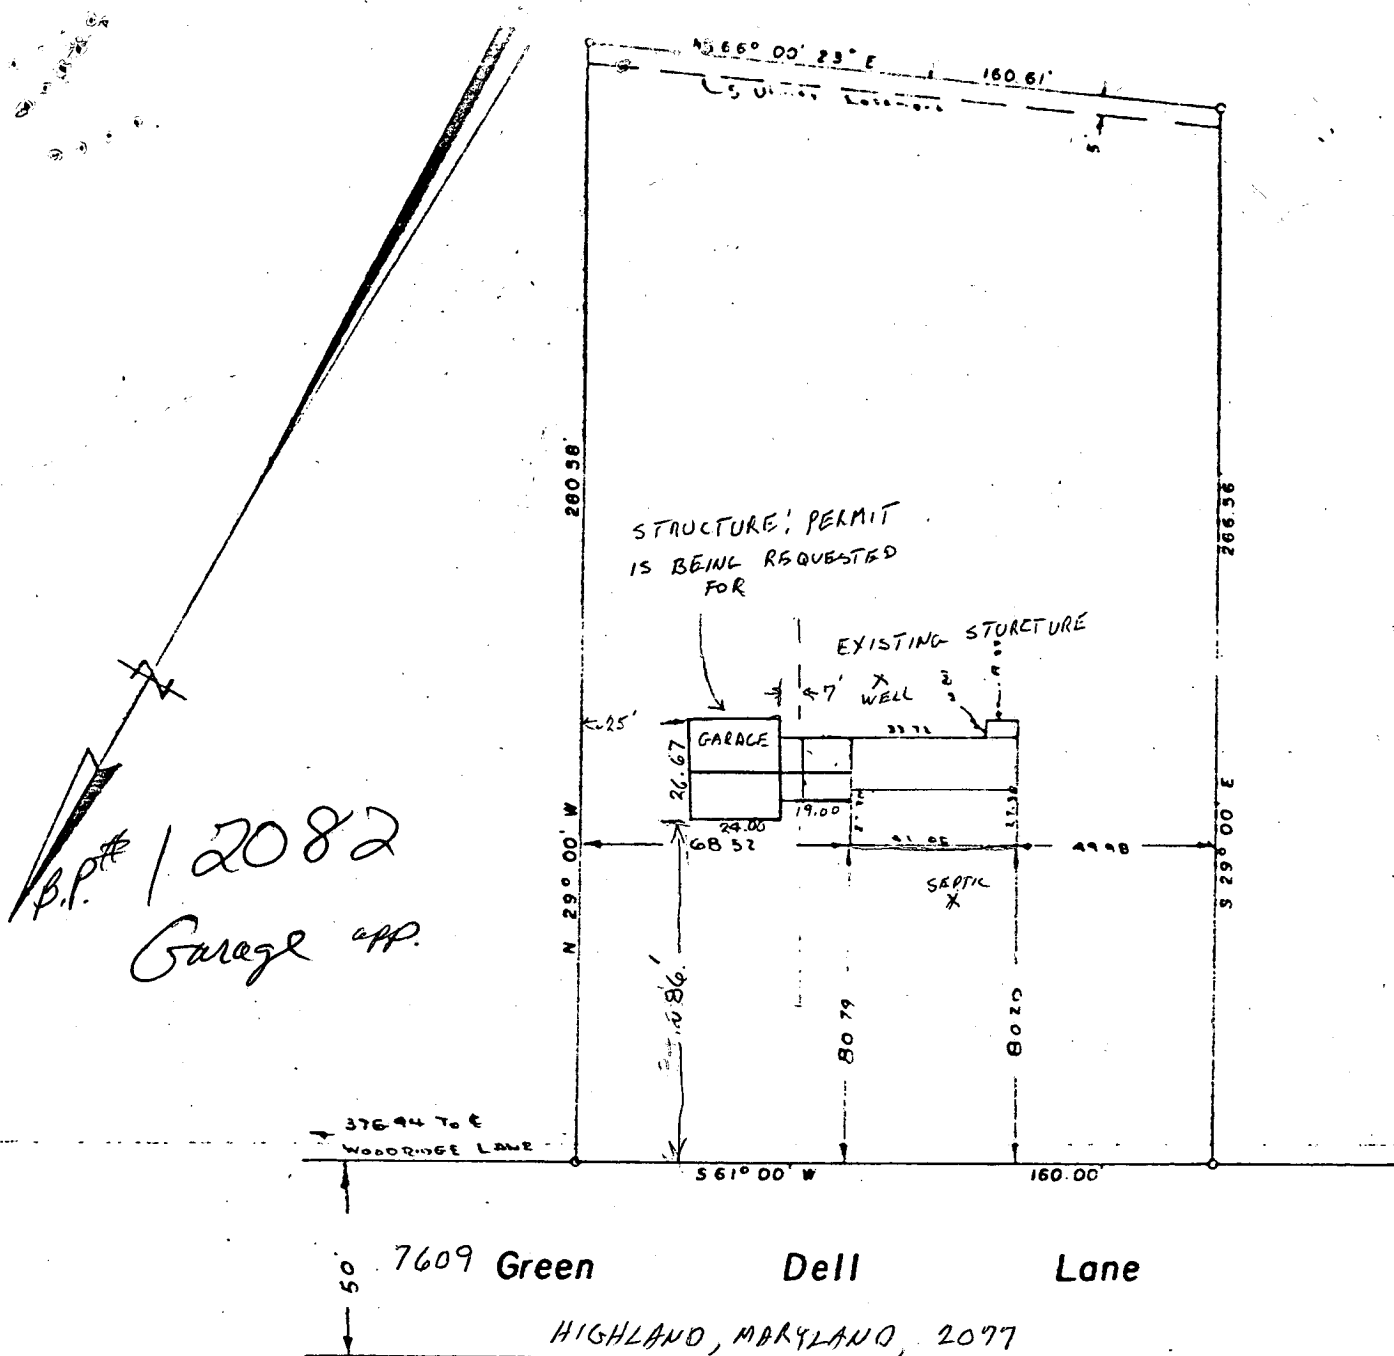

OWNER; CHARLES E. STEVENS

LOCATION SURVEY
OF
LOT NO. 38 SECT. 4 GREENWOOD FARMS
FIFTH ELECTION DISTRICT OF HOWARD COUNTY
HIGHLAND, MARYLAND
SCALE: 1 IN. = 50 FT. AUGUST 5, 1963

ENGINEERS CERTIFICATE

I hereby certify that the improvement shown hereon has been
located by a transit tape survey and there are no encroachments.

5/27/87 NO PROBLEM
OK TO SIGN
RH



Claude M. Skinner Jr.

Claude M. Skinner Jr. Reg. Engineer & Land Surveyor No. 2237

ROAD (60' R/W)

0 L=63.93
S/E 63.90

SHADED AREA INDICATES
PROP DRIVE WAY PAVING

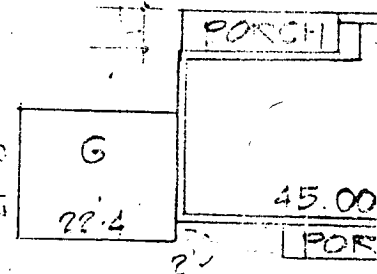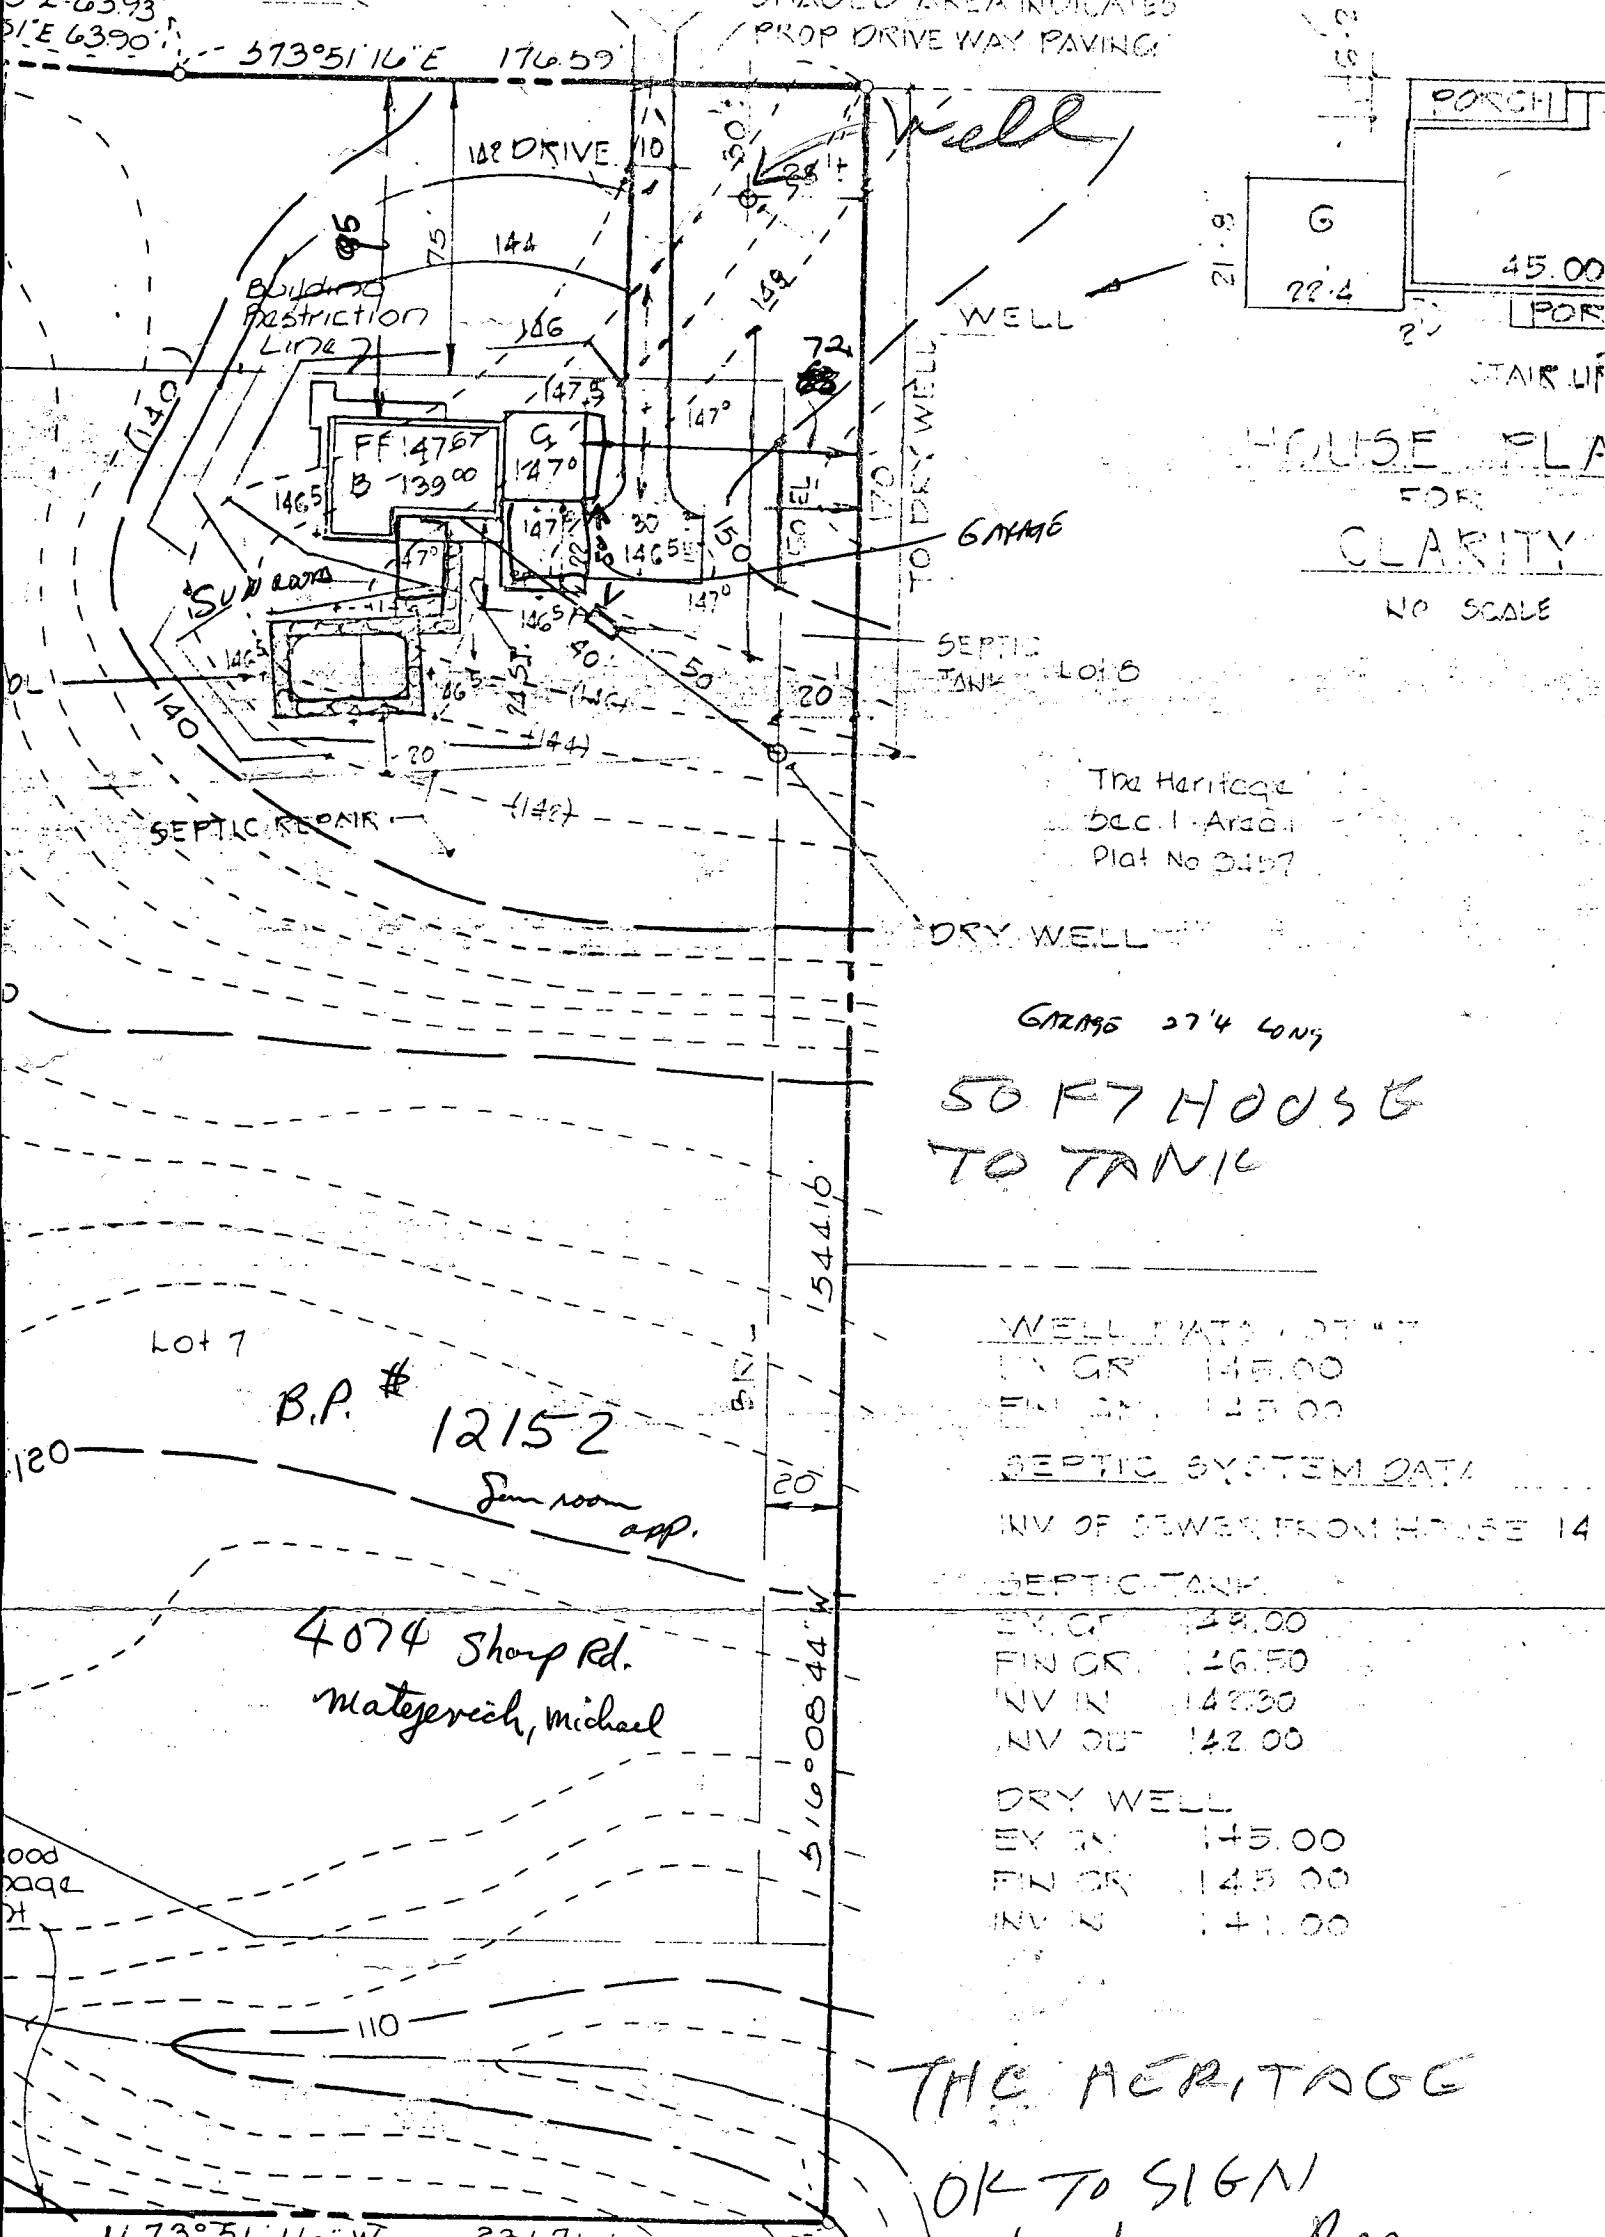

HOUSE PLAN
FOR
CLARITY
NO SCALE

GARAGE 27'4 LONG
50 FT HOUSE
TO TANK

WELL DATA LOT 7	
EX GR	145.00
FIN GR	145.00
SEPTIC SYSTEM DATA	
INV OF SEWER FROM HOUSE	14
SEPTIC TANK	
EX GR	128.00
FIN GR	126.50
INV IN	142.30
INV OUT	142.00
DRY WELL	
EX GR	145.00
FIN GR	145.00
INV IN	141.00

THE HERITAGE
OK TO SIGN
5/27/87 RH

B.P. # 12152
Sun room app.

4074 Sharp Rd.
Matejovich, Michael

N 73°31'16" W 231.76

ROAD (60' R/W)

SHADED AREA INDICATES
PROP DRIVE WAY PAVING.

PORCH

6

45.00

7.2

POK

STAIR UP

HOUSE FLA FOR CLARITY

NO SCALE

The Heritage
Belt Area
Plot No 0457

6/22/96 27'4 LONG
50 K7 HOUSE
TO TANK

WELL DATA 127 "7"
LN GR 145.00
FL GR 125.00

SEPTIC SYSTEM DATA

LINE OF SEWER FROM HOUSE 14

SEPTIC TANK

EX. GR. 14.00

FIN CR.	26.50
WV B.	42.50

INV IN	142.00
INV OUT	142.00

DRY WELL

EX 24 14

FIN 05	145 00
FIN 10	145 00

700

[illegible]

THE ACQUITAGE

OK TO SIGN

5/27/87

BJ

B.P. # 12152

Gen room app.

4074 Sharp Rd.
Matejovich, Michael

Good
page
H

N 73° 51' 16" W 231.76