

approved 4/12/84

stayed

4/12/84
new & later

PERMIT

A16541

P 33752

A Repair

SEWAGE DISPOSAL SYSTEM

MARYLAND STATE DEPARTMENT OF HEALTH*

HOWARD COUNTY
BUREAU OF ENVIRONMENTAL HEALTH
992-2330

INDEX
03-287637

ELLICOTT CITY

DISTRICT 3rd

DATE 4/9/84

Arnold Septic Tank Service

IS PERMITTED TO INSTALL ALTER X

ADDRESS Jacobs Road, Mt. Airy, Maryland 21771 PHONE 795-7873

SUBDIVISION Woodmark ROAD 12251 Yearling Court LOT 37, Blk. E, Sec. 9

PROPERTY OWNER Mrs. Murn

ADDRESS 12251 Yearling Court, Ellicott City, Md. 21043 Phone: 531-3078

IF GARBAGE GRINDER IS USED INCREASE SEPTIC TANK CAPACITY BY 50% AND ABSORPTION AREA BY 22%.

GARBAGE GRINDER? YES NO X

SEPTIC TANK CAPACITY GALLONS NUMBER OF BEDROOMS 4

TRENCH - 158 sq. ft. per bedroom. Inlet at 6 feet and bottom maximum depth 13 ft. below original grade, with 7 foot of stone in trench.

inlet 5' x 8' stone in 64' long trench up & off drywell for 4 B.D.
inlet 5' x 7' of stone is

BLDG. PERMIT SIGNED

AND RETURNED 4/13/84
Serial # 175-97
Sun deck

PLANS APPROVED BY Raymond Hodges & Frank A. Skinner

DATE 4/9/84

COVER NO WORK UNTIL INSPECTED AND APPROVED.

NEITHER THE HOWARD COUNTY COUNCIL NOR THE HEALTH DEPARTMENT IS RESPONSIBLE FOR THE SUCCESSFUL OPERATION OF ANY SYSTEM.

NOTE: IF TRENCH IS USED CALL FOR INSPECTION BEFORE AND AFTER PLACING GRAVEL IN TRENCH.

NOTE: NO DRY WELL SHALL EXCEED 15 FOOT IN DIAMETER. NO ABSORPTION TRENCH TO EXCEED 100 FEET IN LENGTH.

NOTE: ALL PIPE FROM HOUSE TO SEPTIC TANK MUST BE CAST IRON OR SCHEDULE 40 PVC OR ABS.

PERMIT VOID AFTER THREE YEARS.


NOTE: INSTALL STAND PIPE ON SEPTIC TANK AND DRY WELL. STAND PIPES MUST BE 6 INCHES IN DIAMETER. CAST IRON, CONCRETE OR TERRA COTTA, OR PVC OR ABS ACCEPTED. IF TOP OF SEPTIC TANK IS DEEPER THAN 3 FEET MANHOLE TO GRADE REQUIRED.

***INSTALLER IS RESPONSIBLE FOR OBTAINING FINAL APPROVAL ON THIS PERMIT**

*CALL 992-2330 FOR INSPECTION OF SEPTIC SYSTEMS.

EH - 2-1082

P 33752

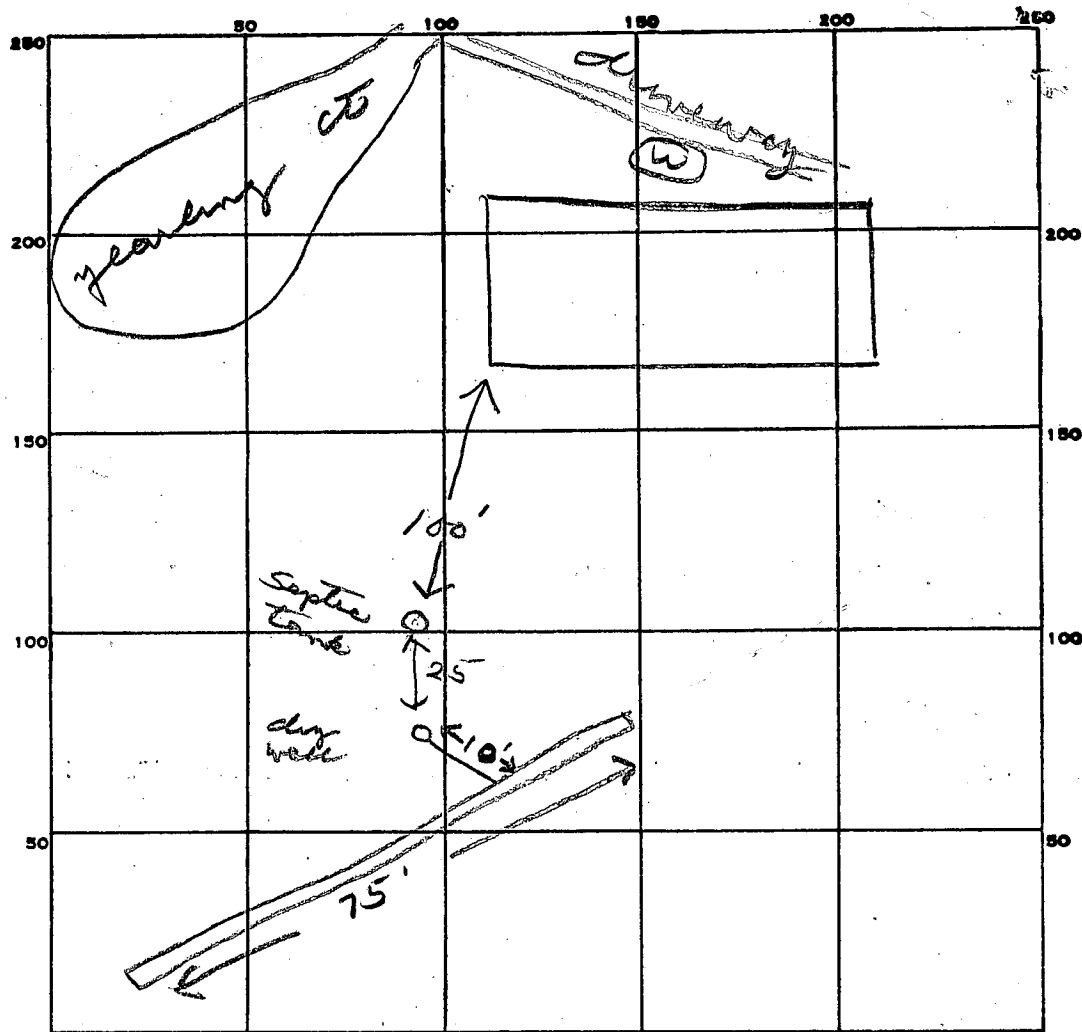

PERMIT CARD ☒

SEPTIC TANK, LEVEL _____

CLEANOUTS _____

DISTRIBUTION BOX, LEVEL _____

TILE FIELD, DEPTH 13 FT. TRENCH WIDTH 2 FT.

GRAVEL DEPTH 7 1/2 IN. TOTAL LENGTH 75 FT.

NUMBER OF TRENCHES 1 TOTAL BOTTOM AREA 562+

SEEPAGE PITS, INSIDE DIAMETER _____ FT. DEPTH BELOW INLET _____ FT.

ABSORBENT AREA _____ SQ. FT.

REMARKS 4/12/84 OK to add stone in trench.
4/12/84 OK to cover work of

DATE SYSTEM APPROVED 4/12/84 INSPECTOR Stayer

16 FT deep

Per at 5 1/2 ft

~~8~~ 12 ft

Wood Mark

12 23 1

Yearling Court

Lot 37 E Sect 9

13

R

6

7 ft stone

3 or 4 bedrooms ?

may or may not have
garbage grinder

158 per bedroom trench alone no garbage
125 " " " Dry Well + trench no garbage
grinder

7/125

2/15/84

FS does not have
paperwork FS

375

125

500

220

1600

1150

64 bedrooms
no disposal

A 16541


1759)

1225' yearling ct

LOT 37
SECT 02

MP 22-6

300.25

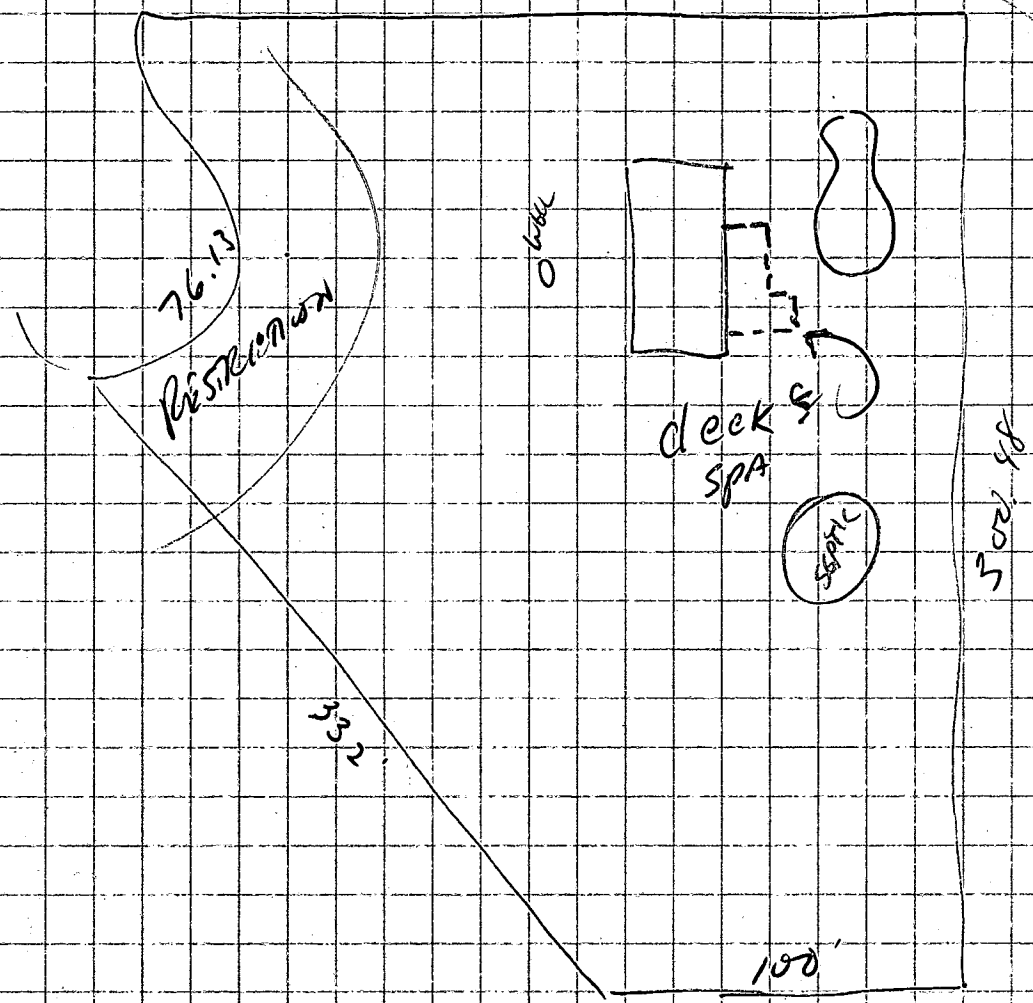

4/13/08
OK TO SIGN
DECK NOT NEAR
SEPTIC OR WELL
RH

A16541

SEWAGE DISPOSAL TESTING

STATE OF MARYLAND - DEPARTMENT OF HEALTH AND MENTAL HYGIENE

HOWARD COUNTY HEALTH DEPARTMENT
ENVIRONMENTAL HEALTH SERVICES

P. O. BOX 476 ELICOTT CITY, MARYLAND 21043
TELEPHONE 932-2330

DISTRICT

2nd

DATE

3/27/84

TO THE COUNTY HEALTH OFFICER
ELICOTT CITY, MARYLAND

I HEREBY APPLY FOR THE NECESSARY TEST IN ORDER TO CONSTRUCT (OR RECONSTRUCT) A SEWAGE DISPOSAL SYSTEM

PROPERTY OWNER

(?)

ADDRESS 12231 Yearling Court, Ellicott City, Md. 21043

PROPERTY LOCATION

SUBDIVISION

Woodmark

LOT NO.

37, Blk. E, Sec. 9

ROAD AND DESCRIPTION

12231 Yearling Court

SIZE OF LOT

(?)

TYPE BLDG

Existing House

(NUMBER OF BEDROOMS)

THE SYSTEM INSTALLED UNDER THIS APPLICATION IS ACCEPTABLE ONLY UNTIL PUBLIC FACILITIES BECOME AVAILABLE. I FULLY UNDERSTAND THE
FEE CONNECTED WITH THE FILING OF THIS PERC TEST APPLICATION IS NON-REFUNDABLE UNDER ANY CIRCUMSTANCES. I ALSO AGREE TO COMPLY
WITH ALL M.O.S.H.A. REQUIREMENTS IN TESTING THIS LOT. /s/ Bud Arnold

(SIGNATURE OF APPLICANT)

APPROVED BY

FOR

DATE

REJECTED BY

FOR


DATE

HOLD PENDING FURTHER TESTS

DATE

REASONS FOR REJECTION OR HOLDING


THIS IS NOT A PERMIT

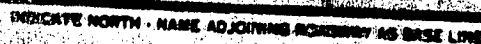

REMARKS _____

TYPE OF SOA _____

TESTED BY B. HODGES ALSO PRESENT BU. ARNOLD

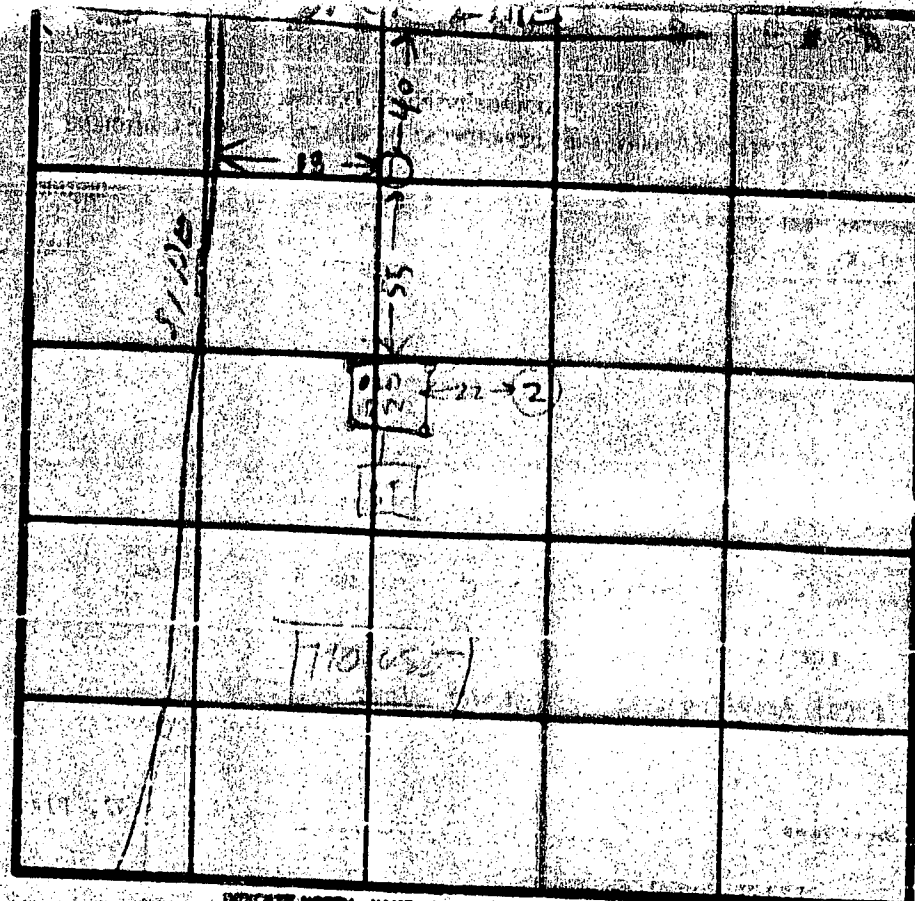

INDICATE NORTH - NAME ADJOINING PROPERTY AS WELL

[illegible]

REMARKS

TYPE OF WORK

TESTED BY

B. HODGES

ALSO PRESENT

ALV. ARNOLD

HOWARD COUNTY

ELICOTT CITY

DISTRICT 3

DATE 11/30/71

MARYLAND STATE DEPARTMENT OF HEALTH

TO: THE COUNTY HEALTH OFFICER
ELICOTT CITY, MARYLAND

I HEREBY APPLY FOR THE NECESSARY TESTS IN ORDER TO CONSTRUCT OR RECONSTRUCT A SEWAGE DISPOSAL SYSTEM.

PROPERTY OWNER Mark Wakefield, Jr.

12150 Mt. Albert Court

ADDRESS Ellicott City, Maryland, 21043

PHONE 531-5072

PROPERTY LOCATION

SUBDIVISION Woodmark, Inc.

LOT NO. 37, Block B, Sect. 9

ROAD AND DESCRIPTION Carroll Hill Road

OCCUPANT

PHONE

PERSON TO CONSTRUCT SYSTEM

ADDRESS

PHONE

SIZE OF LOT

128'x275'x75'x140'x150'x65'x265'

TYPE BLDG. 3 or 4

NUMBER OF BEDROOMS

IF NOT SINGLE RESIDENCE DESCRIBE

SIGNATURE OF APPLICANT Mark Wakefield, Jr.

APPROVED BY

W. M. Morgan

FOR

James H. Hall

DATE

9-18-72

REJECTED BY

FOR


DATE

HOLD PENDING FURTHER TESTS

DATE

REASONS FOR REJECTION OR HOLDING

THIS IS NOT A DEEDMIT

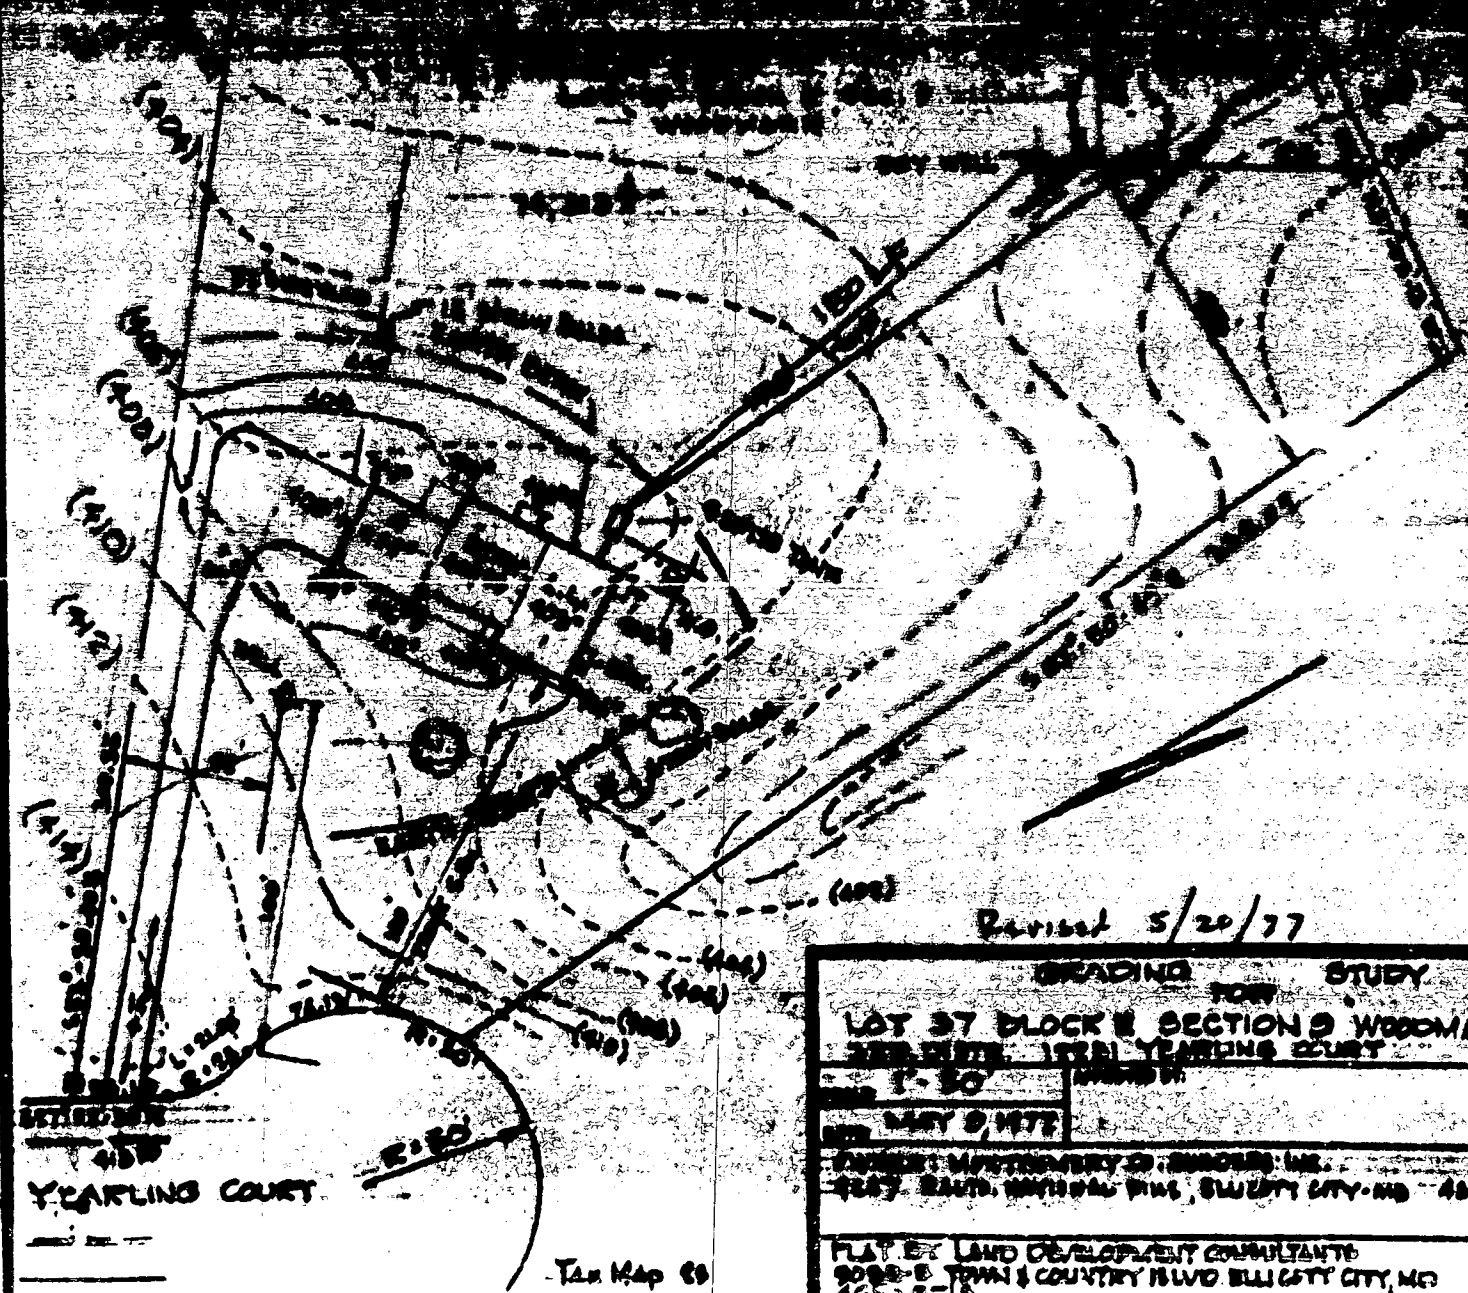

TOTAL AREA
 1.00 AC. (43,560 SQ. FT.)
 1.00 AC. (43,560 SQ. FT.)
 1.00 AC. (43,560 SQ. FT.)
 1.00 AC. (43,560 SQ. FT.)
 TOTAL 4.00 AC. (174,240 SQ. FT.)
 4.00 AC. (174,240 SQ. FT.)

Revised 5/20/77

GRADING STUDY	
LOT 37 BLOCK 8 SECTION 9 WOODMARK RD. IS TOWNSHIP 15N RANGE 10E	
TOWNSHIP 15N RANGE 10E	
DATE 1-30	BY TKS
DATE MAY 9, 1977	REVISION
OWNER: MORTIMER & SONS, INC.	
12345 E. MAIN ST., SUITE 100, BIRMINGHAM, AL 35201	
PLAT BY LAND DEVELOPMENT CONSULTANTS	
2000 E. TOWN & COUNTRY BLVD. BIRMINGHAM, AL 35201	
405-8-18	

YEARLING COURT

Tax Map 69

COVERED & HOUSE OCCUPIED

DIST FROM HOUSE TO TANK

ABOUT 120 FT

OWNER OF HOUSE IS

CRAIG WOOD BURN

12251 YEARLING CT

ELLCOTT CITY 9889701

BUILDER IS LISTED IN WELL GRANTED
SHEET

3/13/78 - DISCUSSED ABOVE WITH BUILDER

HE SAID HE WOULD HAVE PART OF
HOUSE SEWER NEAR HOUSE
UNCOVERED 1ST 30 FT

DATE RECEIVED (MONTH AND DAY)		DEPTH OF WELL 50		WELL NO. FOR PERMIT (SEE INSTRUCTIONS)		WELL IDENTIFICATION NO.	
OWNER LARRY NAME		CITY OR RFD		COUNTY		STATE	
WELL LOG		WELL DESCRIPTION		CONCRETE RECORD		PUMP RECORD	
STATE THE KIND OF CONSTRUCTION, MATERIALS, THEIR COLOR, DEPTH, THICKNESS AND IF CEMENT CEMENTED.		TYPE OF SEALING MATERIAL (SEE INSTRUCTIONS)		TYPE OF PUMP (SEE INSTRUCTIONS)		PUMP CAPACITY (GALLONS PER MINUTE) (NEAREST GALLON)	
CEMENT ☒ YES ☐ NO		BENTONITE CLAY ☒ YES ☐ NO		PUMP TYPE ☒ CENTRIFUGAL ☐ OTHER		PUMP CAPACITY (GALLONS PER MINUTE) (NEAREST GALLON)	
NO. OF BASE 10		NO. OF PUMPED 10		WATER LEVEL (DISTANCE FROM LAND SURFACE) 10		PUMP TYPE ☒ CENTRIFUGAL ☐ OTHER	
GALLONS OF WATER 10		DEPTH OF GROUT SEAL (NEAREST FEET) 10		TYPE OF PUMP USED (CIRCLE APPROPRIATE BOX) ☒ CENTRIFUGAL ☐ OTHER		PUMP TYPE ☒ CENTRIFUGAL ☐ OTHER	
CASING TYPE ☒ STEEL ☐ CONCRETE		MAIN CASING TYPE ☒ STEEL ☐ CONCRETE		NOMINAL DIAMETER TOP (NEAREST INCH) 10		TOTAL DEPTH OF MAIN CASING (NEAREST FOOT) 10	
OTHER CASING TYPE ☐ STEEL ☐ CONCRETE		DIAMETER (INCH) 10		DEPTH (FEET) 10		TYPE OF PUMP USED (CIRCLE APPROPRIATE BOX) ☒ CENTRIFUGAL ☐ OTHER	
SCREEN TYPE ☒ STEEL ☐ CONCRETE		MAIN SCREEN TYPE ☒ STEEL ☐ CONCRETE		NOMINAL DIAMETER TOP (NEAREST INCH) 10		TOTAL DEPTH OF MAIN SCREEN (NEAREST FOOT) 10	
OTHER SCREEN TYPE ☐ STEEL ☐ CONCRETE		DIAMETER (INCH) 10		DEPTH (FEET) 10		TYPE OF PUMP USED (CIRCLE APPROPRIATE BOX) ☒ CENTRIFUGAL ☐ OTHER	
CASING HEIGHT (CIRCLE APPROPRIATE BOX) ☒ ABOVE ☐ BELOW		LOCATION OF WELL ON LOT SHOW PERMANENT STRUCTURE SUCH AS BUILDINGS, SEPTIC TANKS, AND/OR OTHER LAND MARKS AND INDICATE NOT LESS THAN TWO DISTANCES (MEASUREMENTS TO WELL).		PUMP TYPE ☒ CENTRIFUGAL ☐ OTHER		PUMP CAPACITY (GALLONS PER MINUTE) (NEAREST GALLON)	
CIRCLE APPROPRIATE BOXES ☒ A WELL WAS ABANDONED AND SEALED WHEN THIS WELL WAS COMPLETED ☐ B ELECTRIC LOG OBTAINED ☐ C TEST WELL CONVERTED TO PRODUCTION WELL		I HEREBY CERTIFY THAT I HAVE COMPLIED WITH ALL CONDITIONS STATED ON THE ABOVE-CAPTIONED "PERMIT TO DRILL WELL", AND THAT INFORMATION CONTAINED IN THIS REPORT IS TRUE, ACCURATE, AND COMPLETE TO THE BEST OF MY KNOWLEDGE, INFORMATION AND BELIEF.		DRILLER'S NAME LARRY NAME		SIGNATURE LARRY NAME	
HEALTH		HEALTH		HEALTH		HEALTH	

[illegible]