

PERMIT

SEWAGE DISPOSAL SYSTEM

MARYLAND STATE DEPARTMENT OF HEALTH

HOWARD COUNTY

BUREAU OF ENVIRONMENTAL HEALTH

992-2330

ELLICOTT CITY

DISTRICT 3rd.

DATE 4/4/83

INDEX

RLO Contractors

IS PERMITTED TO INSTALL ☒ ALTER ☐

ADDRESS 7469 Flamewood Dr., Clarksville, MD 21029 PHONE 776-0444

SUBDIVISION Green Henge ROAD 12030 Triadelphia Rd. LOT 1, Sec.1

PROPERTY OWNER ~~Ray Marshall and Pat Goodman~~ Patricia A. Marshall

ADDRESS 5749 Yellow Rose Court, Columbia, Maryland Phone: 730-6514

IF GARBAGE GRINDER IS USED INCREASE SEPTIC TANK CAPACITY BY 50% AND ABSORPTION AREA BY 22%.

GARBAGE GRINDER? YES ☐ NO ☒

SEPTIC TANK CAPACITY 1000 GALLONS NUMBER OF BEDROOMS 3

BLDG. PERMIT SIGNED AND RETURNED

Trench and Drywell - 125 square foot sidewall area per bedroom. Drywell inlet max. to

be 3 feet below original grade and drywell bottom to be 9 feet below original grade. Place the drywell 145 feet from the front lot line and 78 feet from the left lot line as seen when facing the lot from Triadelphia Road. Add a trench off drywell to make necessary additional absorbent area after a 5 ft. earth buffer. Ditch is to be 9 ft. deep below original grade, with inlet at 3 1/2 ft. deep below original grade and filled with 5 1/2 ft. of stone. Run ditch on level ground toward perc hole #5 which is located 250 ft. from the front lot line and 35 ft. from the left lot line as seen when facing the lot from Triadelphia Road.

PLANS APPROVED BY Raymond Hodges DATE 11/17/82

COVER NO WORK UNTIL INSPECTED AND APPROVED.

NEITHER THE HOWARD COUNTY COUNCIL NOR THE HEALTH DEPARTMENT IS RESPONSIBLE FOR THE SUCCESSFUL OPERATION OF ANY SYSTEM.

NOTE: IF TRENCH IS USED CALL FOR INSPECTION BEFORE AND AFTER PLACING GRAVEL IN TRENCH.

NOTE: NO DRY WELL SHALL EXCEED 15 FOOT IN DIAMETER. NO ABSORPTION TRENCH TO EXCEED 100 FEET IN LENGTH.

NOTE: ALL PIPE FROM HOUSE TO SEPTIC TANK MUST BE CAST IRON OR SCHEDULE 40 PVC OR ABS.

PERMIT VOID AFTER THREE YEARS.

NOTE: INSTALL STAND PIPE ON SEPTIC TANK AND DRY WELL. STAND PIPES MUST BE 6 INCHES IN DIAMETER. CAST IRON, CONCRETE OR TERRA COTTA, OR PVC OR ABS ACCEPTED. IF TOP OF SEPTIC TANK IS DEEPER THAN 3 FEET MANHOLE TO GRADE REQUIRED.

*INSTALLER IS RESPONSIBLE FOR OBTAINING FINAL APROVAL ON THIS PERMIT

*CALL 992-2330 FOR INSPECTION OF SEPTIC SYSTEMS.

EH - 2-1082

APPROVED
4/13/83
RH

P 32634
A 32274

4/13/83
before 2:00 p.m.
possible


756 left side
175 front

70
40

30

15

A 32274

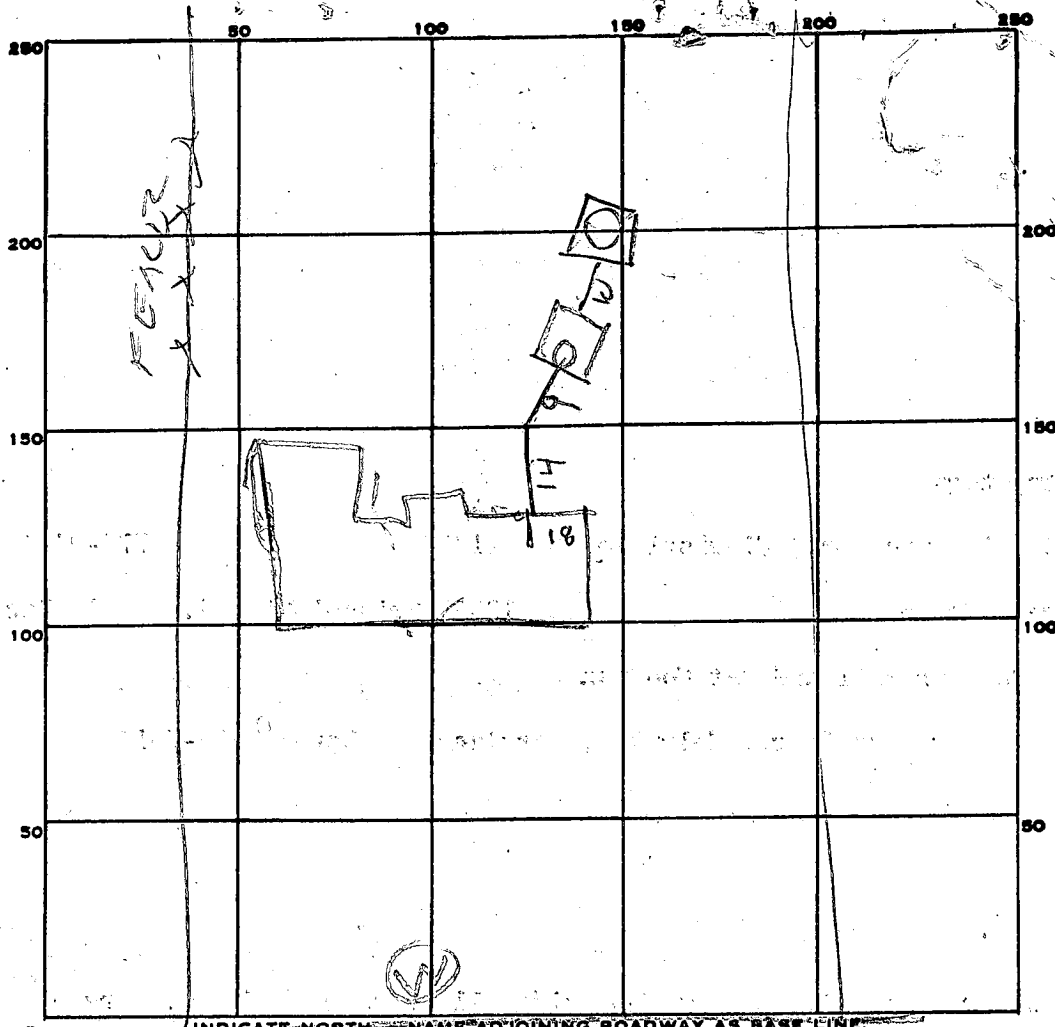

PERMIT CARD _____

SEPTIC TANK, LEVEL OK 1000

CLEANOUTS

TOP 2 1/2 FT BELOW GRADE

DISTRIBUTION BOX, LEVEL _____

TILE FIELD, DEPTH _____ FT. TRENCH WIDTH _____ FT.

GRAVEL DEPTH _____ IN. TOTAL LENGTH _____ FT.

NUMBER OF TRENCHES _____ TOTAL BOTTOM AREA _____

SEEPAGE PITS, INSIDE DIAMETER 60 FT. DEPTH BELOW INLET 6.5 FT.

ABSORBENT AREA 390 SQ. FT.

REMARKS 4/13/83 1230 PM - LOCATION OK BUT INCOMPLETE

4/13/83 204 PM - DW IS 7 1/2 FT DEEP BELOW TOP. BUT INCOMPLETE

OK TO COVER TANK & HOUSE SEWER

4/13/83 345 PM DW INLET 2 FT B.O.G.

DRY WELL FINISHED

DATE SYSTEM APPROVED

4/15/83

INSPECTOR

Raymond Hodges

C 1 203	SEQUENCE NO. (OEP USE ONLY)	STATE OF MARYLAND		THIS REPORT MUST BE SUBMITTED WITHIN 45 DAYS AFTER WELL IS COMPLETED.
		WELL COMPLETION REPORT		COUNTY NUMBER
(THIS NUMBER IS TO BE PUNCHED IN COES 3-6 ON ALL CARDS)		FILL IN THIS FORM COMPLETELY PLEASE PRINT OR TYPE		A 32274

Date Received (OEP use only)	DATE WELL COMPLETED 112382	Depth of Well 160 (TO NEAREST FOOT)	PERMIT NO. FROM "PERMIT TO DRILL WELL" 40-73-4318
---------------------------------	-------------------------------	---	---

OWNER last name John McDonough Builders	first name Triadelphia Road	TOWN West Friendship
STREET OR RFD Greenhauge	SECTION 1	LOT 1

WELL LOG Not required for driven wells		
STATE THE KIND OF FORMATIONS PENETRATED, THEIR COLOR, DEPTH, THICKNESS AND IF WATER BEARING		
DESCRIPTION (Use additional sheets if needed)	FEET FROM TO	Check if water bearing
TOP SOIL	0 2	
CLAY	2 5	
SHALE	5 10	
SAND STONE	10 28	
GRANITE	28 40	
SAND STONE	40 45	✓
QUARTZ	45 50	✓
GRANITE	50 60	✓
SAND STONE	60 160	
QUARTZ		
GRANITE		

GROUTING RECORD WELL HAS BEEN GROUTED (Circle Appropriate Box)		
TYPE OF GROUTING MATERIAL CEMENT ☒ BENTONITE CLAY ☒		
NO. OF BAGS 13 NO. OF POUNDS 1300		
GALLONS OF WATER 70		
DEPTH OF GROUT SEAL (to nearest foot) from 0 ft. to 29 ft. (enter 0 if from surface)		
CASING RECORD casing types insert appropriate code below		
STEEL ☒ CONCRETE ☒ PLASTIC ☒ OTHER ☒		
MAIN CASING TYPE S T 6 31		
OTHER CASING (if used) diameter inch depth (feet) from to		
E A C H S C R E E N		
screen type or open hole insert appropriate code below		
STEEL ☒ BRASS ☒ OPEN HOLE ☒ BRONZE ☒ PLASTIC ☒ OTHER ☒		
C 2 (Seq. no.)		
DEPTH (nearest ft.) H O 29 160		
E A C H S C R E E N		
SLOT SIZE 2 3		
DIAMETER OF SCREEN (NEAREST INCH) from 56 to 60		
GRAVEL PACK		
IF WELL DRILLED WAS FLOWING WELL CIRCLE BOX ☒		
OEP USE ONLY (NOT TO BE FILLED IN BY DRILLER)		
T (E.R.O.S.)		
W Q		
TELESCOPE CASING LOG INDICATOR OTHER DATA		

C 3 (Seq. no.)	
PUMPING TEST HOURS PUMPED (nearest hour) 3	
PUMPING RATE (gal. per min. to nearest gal.) 12	
METHOD USED TO MEASURE PUMPING RATE Bucket	
WATER LEVEL (distance from land surface)	
BEFORE PUMPING 41	
WHEN PUMPING 53	
TYPE OF PUMP USED (for test)	
A air P piston T turbine	
C centrifugal R rotary O other (describe below)	
J jet S submersible	
PUMP INSTALLED YES ☒ NO ☒	
DRILLER WILL INSTALL PUMP (CIRCLE APPROPRIATE BOX)	
IF DRILLER INSTALLS PUMP, THIS SECTION MUST BE COMPLETED FOR ALL WELLS EXCEPT HOME USE	
TYPE OF PUMP (WRITE APPROPRIATE LETTER IN BOX - SEE ABOVE: (A, C, J, P, R, S, T, O))	
CAPACITY: GALLONS PER MINUTE (to nearest gallon) 31	
PUMP HORSE POWER 37	
PUMP COLUMN LENGTH (nearest ft.) 41	
CASING HEIGHT (circle appropriate box and enter casing height)	
above 2 (nearest foot)	
below 40	
LOCATION OF WELL ON LOT	
SHOW PERMANENT STRUCTURE SUCH AS BUILDING, SEPTIC TANKS, AND/OR LANDMARKS AND INDICATE NOT LESS THAN TWO DISTANCES (MEASUREMENTS TO WELL)	

CIRCLE APPROPRIATE BOX	
☒ A A WELL WAS ABANDONED AND SEALED WHEN THIS WELL WAS COMPLETED	
☒ E ELECTRIC LOG OBTAINED	
☒ P TEST WELL CONVERTED TO PRODUCTION WELL	
I HEREBY CERTIFY THAT THIS WELL HAS BEEN CONSTRUCTED IN ACCORDANCE WITH COMAR 10.17.13 "WELL CONSTRUCTION" AND IN CONFORMANCE WITH ALL CONDITIONS STATED IN THE ABOVE CAPTIONED PERMIT, AND THAT THE INFORMATION PRESENTED HEREIN IS ACCURATE AND COMPLETE TO THE BEST OF MY KNOWLEDGE.	
DRILLERS IDENT. NO. 40	
George A. Lasterday	
DRILLERS SIGNATURE	
(MUST MATCH SIGNATURE ON APPLICATION)	
SITE SUPERVISOR (sign of driller or journeyman responsible for sitework if different from permittee)	

C 2 (Seq. no.)	
DEPTH (nearest ft.)	
H O 29 160	
E A C H S C R E E N	
SLOT SIZE 2 3	
DIAMETER OF SCREEN (NEAREST INCH)	
from 56 to 60	
GRAVEL PACK	
IF WELL DRILLED WAS FLOWING WELL CIRCLE BOX ☒	
OEP USE ONLY (NOT TO BE FILLED IN BY DRILLER)	
T (E.R.O.S.)	
W Q	
TELESCOPE CASING LOG INDICATOR OTHER DATA	

PUMP INSTALLED YES ☒ NO ☒	
DRILLER WILL INSTALL PUMP (CIRCLE APPROPRIATE BOX)	
IF DRILLER INSTALLS PUMP, THIS SECTION MUST BE COMPLETED FOR ALL WELLS EXCEPT HOME USE	
TYPE OF PUMP (WRITE APPROPRIATE LETTER IN BOX - SEE ABOVE: (A, C, J, P, R, S, T, O))	
CAPACITY: GALLONS PER MINUTE (to nearest gallon) 31	
PUMP HORSE POWER 37	
PUMP COLUMN LENGTH (nearest ft.) 41	
CASING HEIGHT (circle appropriate box and enter casing height)	
above 2 (nearest foot)	
below 40	
LOCATION OF WELL ON LOT	
SHOW PERMANENT STRUCTURE SUCH AS BUILDING, SEPTIC TANKS, AND/OR LANDMARKS AND INDICATE NOT LESS THAN TWO DISTANCES (MEASUREMENTS TO WELL)	

Date: _____

Review 1/25/83 OK J.S.

Maryland Well Permit No. HO-73-4318 Election District _____
Location of Property (road) Tridelpia Road
Subdivision Greenhenge Lot 1 Block _____ Plat _____ Sec. _____
Well Driller George F. Easterday Owner John Mc Donough Builders
Depth of Well _____
Distance of Measuring Point (M.P.) above ground + 2'
Static Water Level (S.W.L.) below M.P. 41'

Time pump started 11:45 Pumping rate 12
Total time 1/2 to reach pumping water level 48 ft. below M.P.

II. Recovery pump test data - observations to be recorded every 15 minutes.

[illegible]

APPLICATION

432274

SEWAGE DISPOSAL TESTING

STATE OF MARYLAND - DEPARTMENT OF HEALTH AND MENTAL HYGIENE

HOWARD COUNTY HEALTH DEPARTMENT
ENVIRONMENTAL HEALTH SERVICESP. O. BOX 473 ELLICOTT CITY, MARYLAND 21043
TELEPHONE: 992-2330

DISTRICT

DATE

P

3rd

2/17/82

TO: THE COUNTY HEALTH OFFICER
ELLICOTT CITY, MARYLAND

I, HEREBY, APPLY FOR THE NECESSARY TEST IN ORDER TO CONSTRUCT (OR RECONSTRUCT) A SEWAGE DISPOSAL SYSTEM.

PROPERTY OWNER

ADDRESS

PHONE

PROPERTY LOCATION:

SUBDIVISION

LOT NO.

ROAD AND DESCRIPTION

SIZE OF LOT

TYPE BLDG.

(NUMBER OF BEDROOMS)

THE SYSTEM INSTALLED UNDER THIS APPLICATION IS ACCEPTABLE ONLY UNTIL PUBLIC FACILITIES BECOME AVAILABLE. I FULLY UNDERSTAND THE
FEE CONNECTED WITH THE FILING OF THIS PERC TEST APPLICATION IS NON-REFUNDABLE UNDER ANY CIRCUMSTANCES. I ALSO AGREE TO COMPLY

WITH ALL M.O.S.H.A. REQUIREMENTS IN TESTING THIS LOT.

(SIGNATURE OF APPLICANT)

APPROVED BY

FOR

DATE

REJECTED BY

FOR

DATE

HOLD PENDING FURTHER TESTS

DATE

REASONS FOR REJECTION OR HOLDING

BLDG. PERMIT SIGNED

AND RETURNED

12/3/82
Serial # 51951 - S.T.O.

THIS IS NOT A PERMIT

SOIL PROFILE

0'

INDICATE NORTH - NAME ADJOINING ROADWAY AS BASE LINE.

DATE	TEST NO.	DEPTH	PRE-WET		TEST - 1" DROP		TIME
			START	STOP	START	STOP	

REMARKS _____

TYPE OF SOIL _____

TESTED BY _____ ALSO PRESENT _____

EHI 12 10/9

Retest

APPLICATION

SEWAGE DISPOSAL TESTING

STATE OF MARYLAND - DEPARTMENT OF HEALTH AND MENTAL HYGIENE

HOWARD COUNTY HEALTH DEPARTMENT
ENVIRONMENTAL HEALTH SERVICES
P. O. BOX 476 ELLICOTT CITY, MARYLAND 21043
TELEPHONE: 992-2330

A 32274

P _____

DISTRICT 3rd

DATE 10/27/82

TO: THE COUNTY HEALTH OFFICER
ELLICOTT CITY, MARYLAND

I, HEREBY, APPLY FOR THE NECESSARY TEST IN ORDER TO CONSTRUCT (OR RECONSTRUCT) A SEWAGE DISPOSAL SYSTEM.

PROPERTY OWNER Roy Marshall + Pat Goodman

ADDRESS 5829 Banneker Road PHONE 992-4449

PROPERTY LOCATION:

SUBDIVISION Greenhenge Sec 1 LOT NO. 1

ROAD AND DESCRIPTION Triadelphia Road

SIZE OF LOT approx 41,150 sq ft TYPE BLDG. 3 bedrooms
(NUMBER OF BEDROOMS)

THE SYSTEM INSTALLED UNDER THIS APPLICATION IS ACCEPTABLE ONLY UNTIL PUBLIC FACILITIES BECOME AVAILABLE. I FULLY UNDERSTAND THE
FEE CONNECTED WITH THE FILING OF THIS PERC TEST APPLICATION IS NON-REFUNDABLE UNDER ANY CIRCUMSTANCES. I ALSO AGREE TO COMPLY
WITH ALL M.O.S.H.A. REQUIREMENTS IN TESTING THIS LOT.

John Mc Donough Bldrs, Inc. by Dale Polter
(SIGNATURE OF APPLICANT)


APPROVED BY _____ FOR _____ DATE _____

REJECTED BY _____ FOR _____ DATE _____

HOLD PENDING FURTHER TESTS _____ DATE _____

REASONS FOR REJECTION OR HOLDING _____

THIS IS NOT A PERMIT

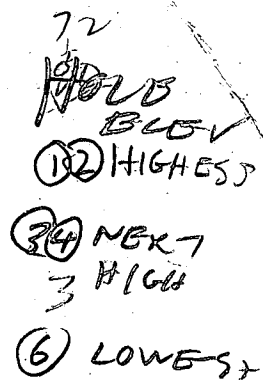

TRIDELPHIA B17

To Rt 144

REMARKS

TYPE OF SOIL

TESTED BY

ALSO PRESENT

EH-12-1079

LATE START HAD TO CONSULT WITH BUILDER ABOUT
HOUSE SITE

PRELIMINARY

APPLICATION

SEWAGE DISPOSAL TESTING

MARYLAND STATE DEPARTMENT OF HEALTH

A 10133

P

HOWARD COUNTY

ELLICOTT CITY

Septic Tank - ¹⁰⁰⁰750 gallons

DISTRICT 3

DATE 5/5/65

Dry well - 300 sq. ft. absorbent sidewall area below the inlet pipe located 115 ft. from front lot line and 15 ft. from right side lot line as seen when facing lot from Triadelphia Rd.

TO: THE COUNTY HEALTH OFFICER
ELLICOTT CITY, MARYLAND

VOID RE TEST
4/1/82 R.H.

I, HEREBY, APPLY FOR THE NECESSARY TESTS IN ORDER TO CONSTRUCT (OR RECONSTRUCT) A SEWAGE DISPOSAL SYSTEM.

SEE ATTACHED SHEET

PROPERTY OWNER Carwell, Inc.

ADDRESS 177 Chatham Rd., E. C. PHONE HO 5-2642

PROPERTY LOCATION:

SUBDIVISION GreenHenge (Carroll Property) Sec 1 LOT NO. 1

ROAD AND DESCRIPTION Triadelphia Rd.

OCCUPANT PHONE

PERSON TO CONSTRUCT SYSTEM PHONE

ADDRESS PHONE

SIZE OF LOT TYPE BLDG. 3 NUMBER OF BEDROOMS

IF NOT SINGLE RESIDENCE DESCRIBE

SIGNATURE OF APPLICANT /s/ Carl C. Hall, Pres.


✓ APPROVED BY J. H. Kilmore FOR Dry well (KIND OF SYSTEM) DATE 3/9/66

REJECTED BY FOR (KIND OF SYSTEM) DATE

HOLD PENDING FURTHER TESTS DATE

REASONS FOR REJECTION OR HOLDING

THIS IS NOT A PERMIT

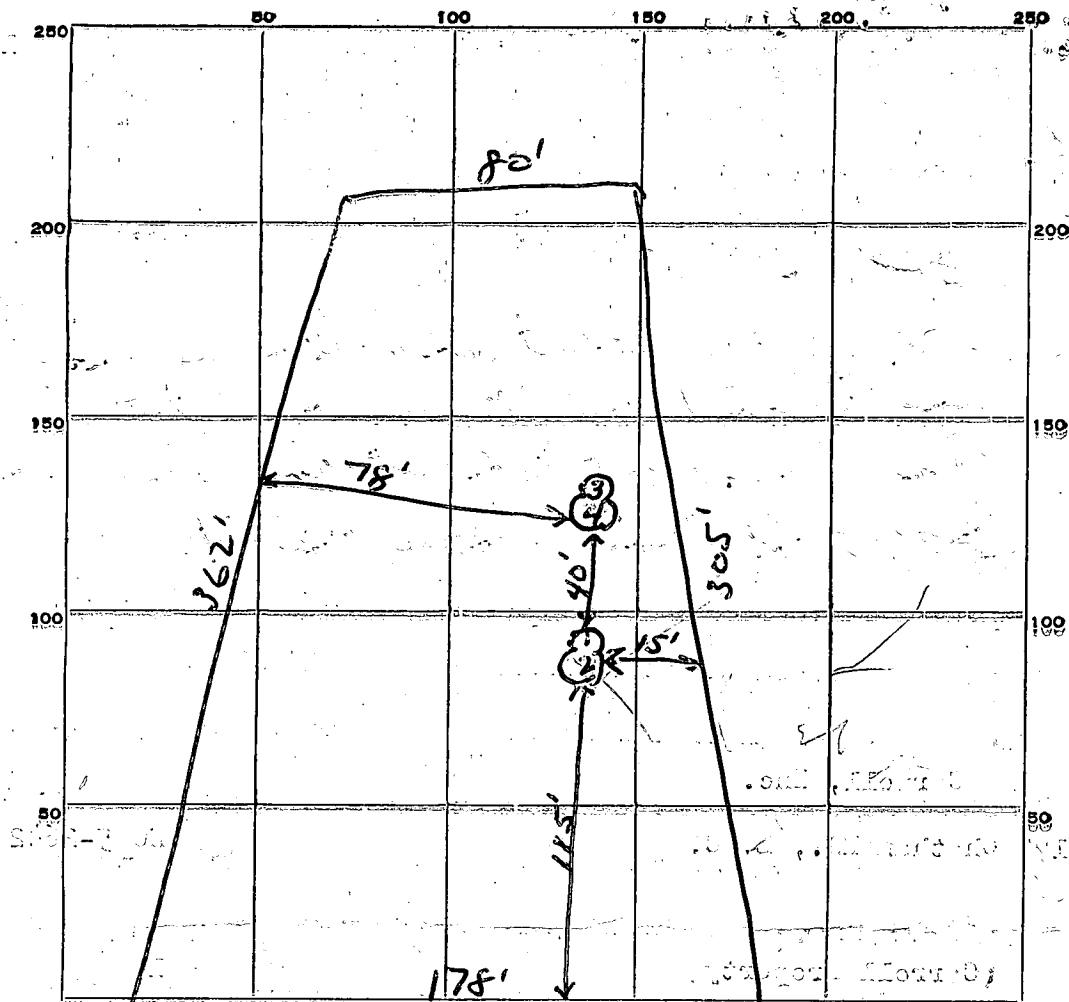

INDICATE NORTH - NAME ADJOINING ROADWAY AS BASE LINE:

TRIADDELPHIA RD

DATE	TEST NO.	DEPTH	PRE-WET		TEST - 1" DROP		TIME
			START	STOP	START	STOP	
5/12/65	1	8 1/2'	9:57	9:59	9:59	10:02	3 min
"	2	4'	9:58	10:00	10:00	10:03	3 min
"	3	4'	10:00	10:03	10:03	10:06	3 min
"	4	4'	10:00	10:03	10:03	10:08	5 min

3.66


SOIL AUGER FINDING Sandy soil

TESTED BY JHK

REMARKS J. L. Feaga

APPROVED : FOR PRIVATE
WATER & PRIVATE SEWERAGE SYSTEMS.
HOWARD COUNTY HEALTH DEPARTMENT.

Joyce M. Boyd, M.D./F.S. 11/16/82
COUNTY HEALTH OFFICER DATE

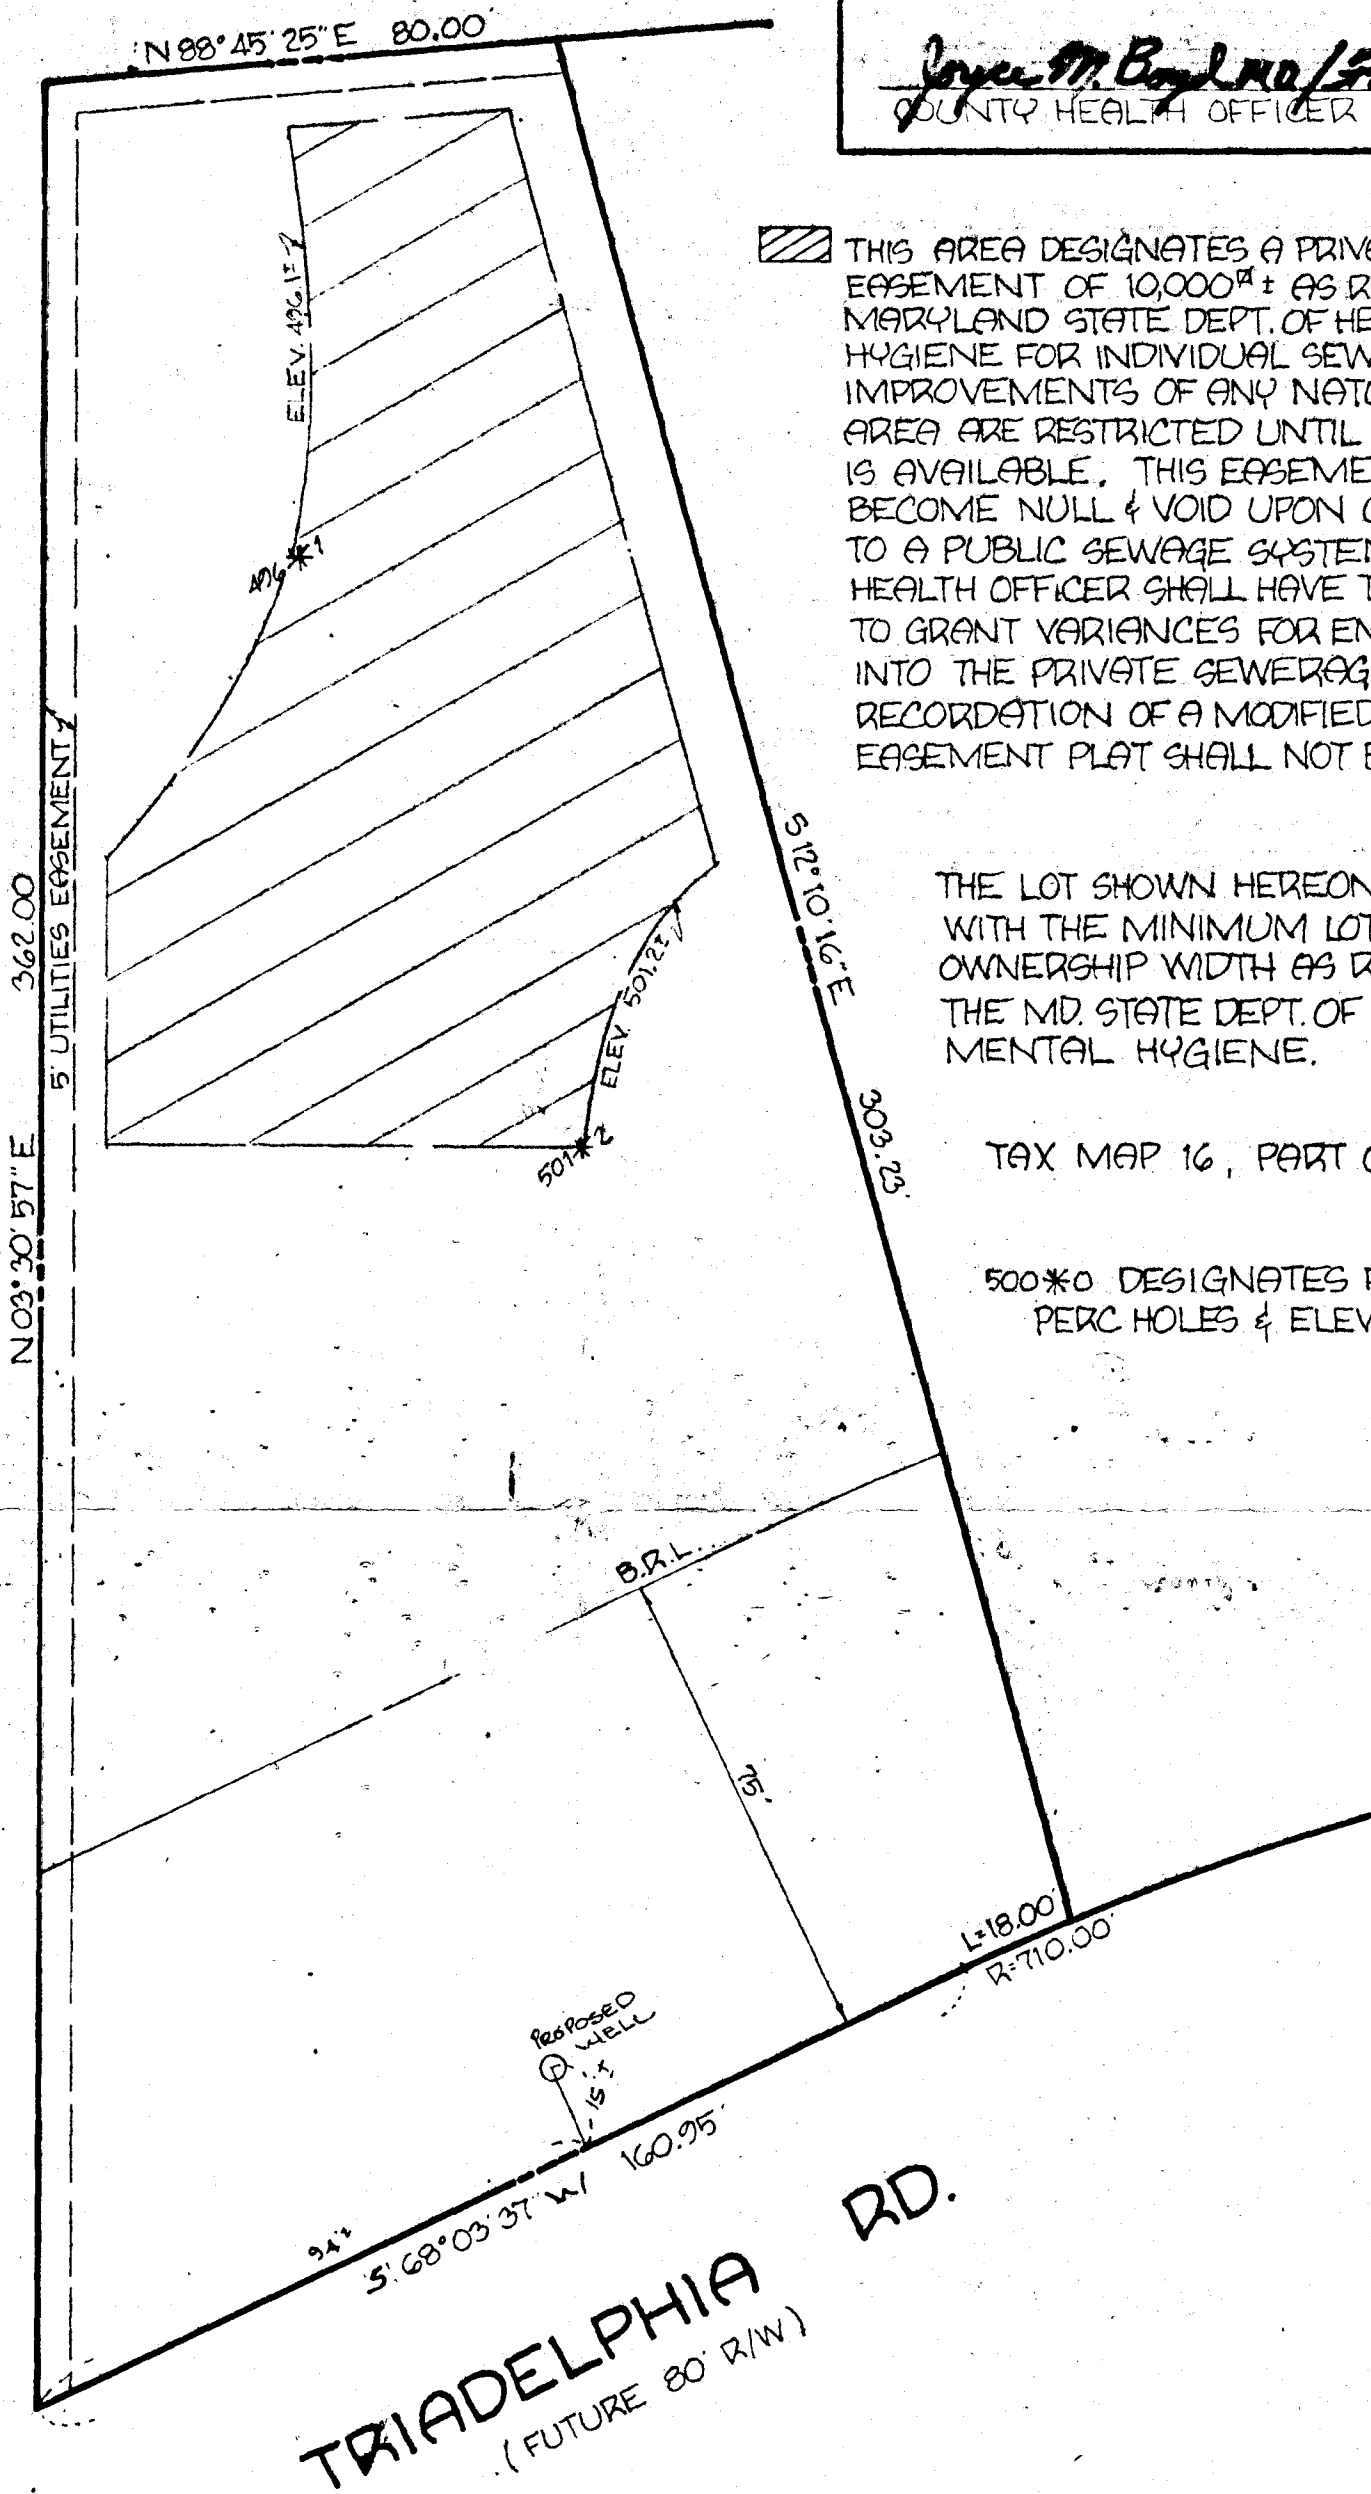


THIS AREA DESIGNATES A PRIVATE SEWERAGE EASEMENT OF 10,000^{sq} ft AS REQUIRED BY THE MARYLAND STATE DEPT. OF HEALTH & MENTAL HYGIENE FOR INDIVIDUAL SEWAGE DISPOSAL. IMPROVEMENTS OF ANY NATURE IN THIS AREA ARE RESTRICTED UNTIL PUBLIC SEWER IS AVAILABLE. THIS EASEMENT SHALL BECOME NULL & VOID UPON CONNECTION TO A PUBLIC SEWAGE SYSTEM. THE COUNTY HEALTH OFFICER SHALL HAVE THE AUTHORITY TO GRANT VARIANCES FOR ENCROACHMENTS INTO THE PRIVATE SEWERAGE EASEMENT. RECORDATION OF A MODIFIED SEWERAGE EASEMENT PLAT SHALL NOT BE NECESSARY.

THE LOT SHOWN HEREON COMPLIES WITH THE MINIMUM LOT AREA & OWNERSHIP WIDTH AS REQUIRED BY THE MD. STATE DEPT. OF HEALTH & MENTAL HYGIENE.

TAX MAP 16, PART OF PARCEL 240

500*0 DESIGNATES FIELD-LOCATED PERC HOLES & ELEVATIONS.

TRIADELPHIA RD.
(FUTURE 80' R/W)

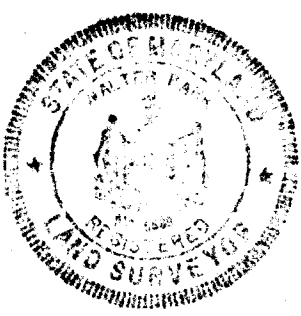

Walter Park
WALTER PARK
PROF. L.S. #5539
HUDKINS ASSOCIATES, INC.
231 JOSEPH SQUARE
COLUMBIA, MD. 21044

FIELD-LOCATED PERC HOLES & ELEVATIONS
LOT 1, SECTION 1
'GREENHEDGE' P.B. 10 / F. 42
3RD ELECTION DISTRICT
HOWARD COUNTY, MD.
NOV. 4, 1982 SCALE: 1" = 30'

B 1 0787 SEQUENCE NO.
(OEP USE ONLY)(THIS NUMBER IS TO BE PUNCHED
IN COLS. 3-6 ON ALL CARDS)STATE OF MARYLAND
PERMIT TO DRILL WELL

please print or type

OEP PERMIT NUMBER

H0-73-4318

fill in this form completely

Date Received 11/23/82 9:30 A.M.
(OEP Use Only)

OWNER INFORMATION

Last Name 15 MTC DION DOUGLAS LOHANN (B MILBERS) Owner 34 Name

58291 BIANNE KIER RD 1111
36 Street or RFD 55COLUMBIA MD 11 0210414
Town 57 State 76 Zip

B 1 Continued DRILLER INFORMATION

George F. Easterday 40
Driller's Name 77 License No. 80L.F. Easterday, Inc.
Firm Name9265 Brown Church Rd. Mt. Airy, Md.
AddressGeorge F. Easterday 10/29/82
Signature Date

B 2 WELL INFORMATION

APPROX. PUMPING RATE (GAL. PER MIN.) 5
23 6 12AVERAGE DAILY QUANTITY NEEDED (GAL. PER DAY) 500
14 20

USE FOR WATER (CIRCLE APPROPRIATE BOX)

- ☒ HOME (SINGLE OR DOUBLE HOUSEHOLD UNIT ONLY)
- ☐ FARMING (LIVESTOCK WATERING & AGRICULTURAL IRRIGATION)
- 22 ☐ INDUSTRIAL, COMMERCIAL, STATE AND FEDERAL GOV. OTHER (REQUIRES APPROPRIATION PERMIT)
- ☐ PUBLIC OR PRIVATE WATER COMPANY (REQUIRES APPROPRIATION PERMIT AND STATE HEALTH DEPARTMENT APPROVAL)
- ☐ TEST, OBSERVATION, MONITORING (MAY REQUIRE APPROPRIATION PERMIT)

APPROXIMATE DEPTH OF WELL 150 FEET
24 28APPROXIMATE DIAMETER OF WELL 6 INCH
30 37

METHOD OF DRILLING (circle one)

BORED (OR AUGERED) JETTED JETTED & DRIVEN

30 AIR ROTARY AIR PERCUSSION ROTARY (HYDRAULIC ROTARY)

37 CABLE REVERSE ROTARY DRIVE POINT

other

REPLACEMENT OR DEEPEMED WELLS
(CIRCLE APPROPRIATE BOX)

- ☒ THIS WELL WILL NOT REPLACE AN EXISTING WELL
- ☐ THIS WELL WILL REPLACE A WELL THAT WILL BE ABANDONED AND SEALED
- 39 ☐ THIS WELL WILL REPLACE A WELL THAT WILL BE USED AS A STANDBY

- ☐ THIS WELL WILL DEEPMEN AN EXISTING WELL
- PERMIT NUMBER OF WELL TO BE REPLACED OR DEEPEMED (IF AVAILABLE) 41 52

Not to be filled in by driller (OEP USE ONLY)

APPROP. PERMIT NUMBER 54 GAP 63

FORCE F5 WRITE INITIALS IN BOX PERMIT NO. H0-73-4318
64 68 70 71 72 73 74 75 76 77 78 79

B 5 SPECIAL CONDITIONS 8-63

1 2 3 6

B 3 LOCATION OF WELL

COUNTY Howard


SUBDIVISION Greenhenge

SECTION 23 LOT 1

NEAREST TOWN West Friendship

MILES FROM TOWN (enter 0 if in town) 3/4

B 4 DIRECTION OF WELL FROM TOWN (CIRCLE BOX)

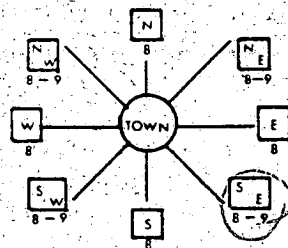

Tridelpia Road

11 NEAR WHAT ROAD 30

ON WHICH SIDE OF ROAD (CIRCLE APPROPRIATE BOX)

NORTH N

WEST W EAST E

SOUTH S

400 15

34 DISTANCE FROM ROAD 37 (CIRCLE APPROPRIATE BOX) 38 39

SHOW MAJOR FEATURES OF BOX & LOCATE WELL WITH AN X

SOURCES OF DRILLING WATER


- Well
-
-

WRITE THE BOX NUMBER FROM THE MAP HERE

820 9


520 9

DRAW A SKETCH BELOW SHOWING LOCATION OF WELL IN RELATION TO NEARBY TOWNS AND ROADS AND GIVE DISTANCE FROM WELL TO NEAREST ROAD JUNCTION

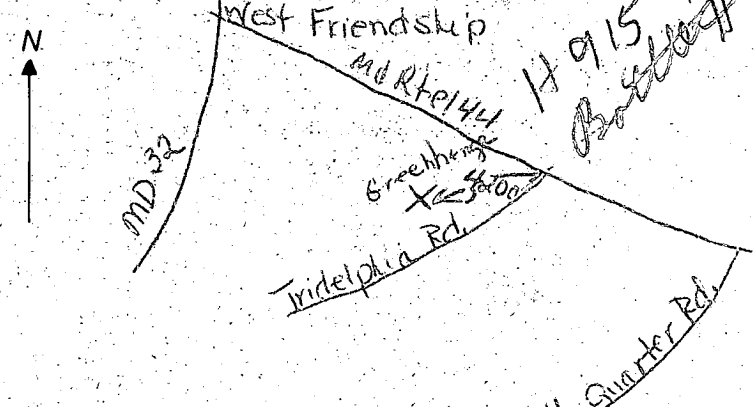B 4 NOT TO BE FILLED IN BY DRILLER
HEALTH DEPARTMENT APPROVALHOWARD 32274
COUNTY NAME COUNTY NO.

OEP SIGNATURE DATE ISSUED 11/16/82 CO SIGNATURE Frank Sklar

NORTH GRID 529 EAST GRID 0819 EXPIRES 05/16/83
50 55 57 63

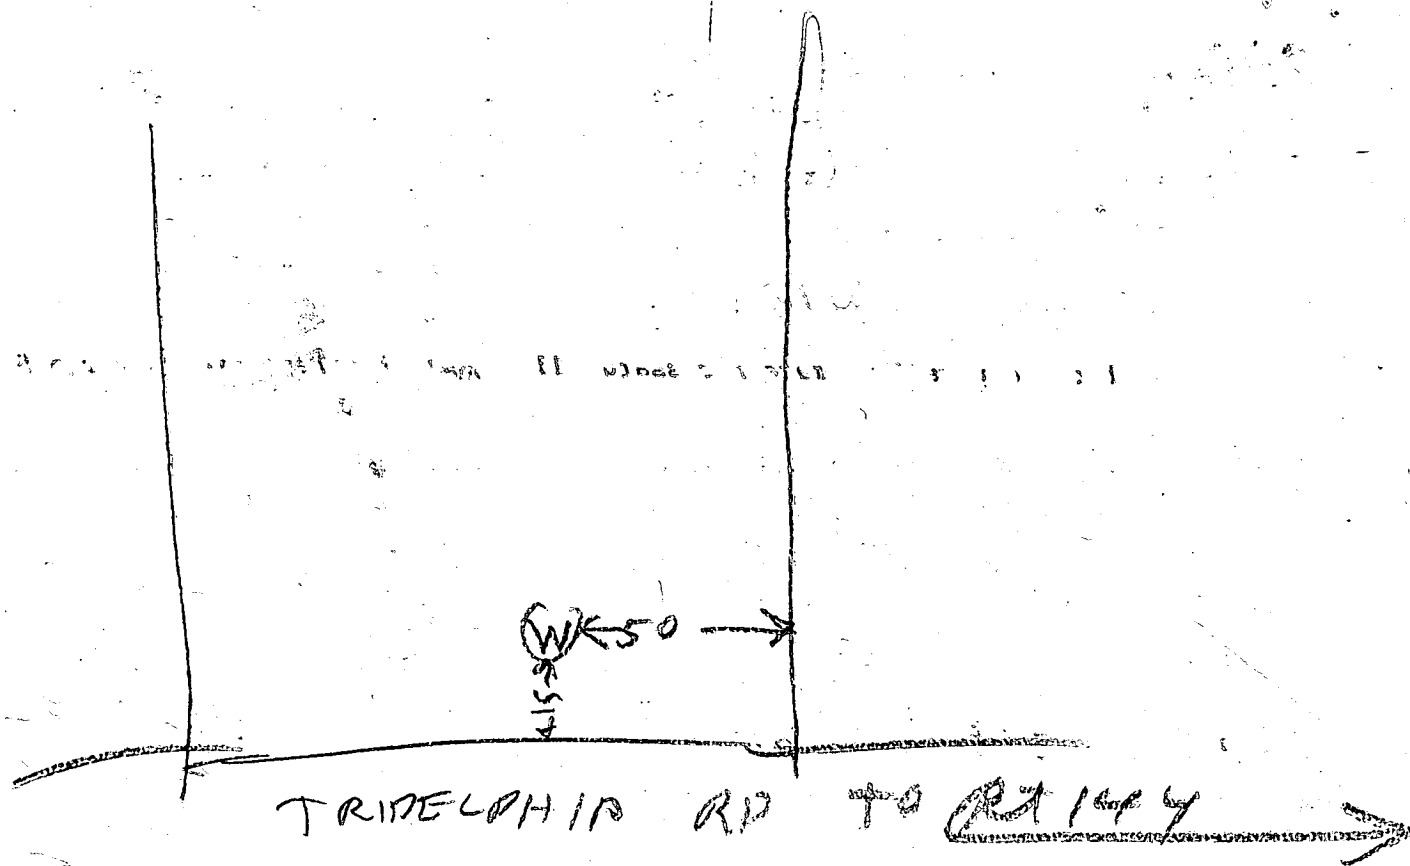


- ① LOCATION OK
- ② 29 FT OPEN HOLE MEASURED WITH A STRING
- ③ 31 FT CASING $1\frac{1}{2}$ FT OUT OF GROUND
- ④ 13 BAGS
- ⑤ WELL OK

11/23/82
Raymond Lodge

[illegible]

APPROVED : FOR PRIVATE
WATER & PRIVATE SEWERAGE SYSTEMS.
HOWARD COUNTY HEALTH DEPARTMENT.

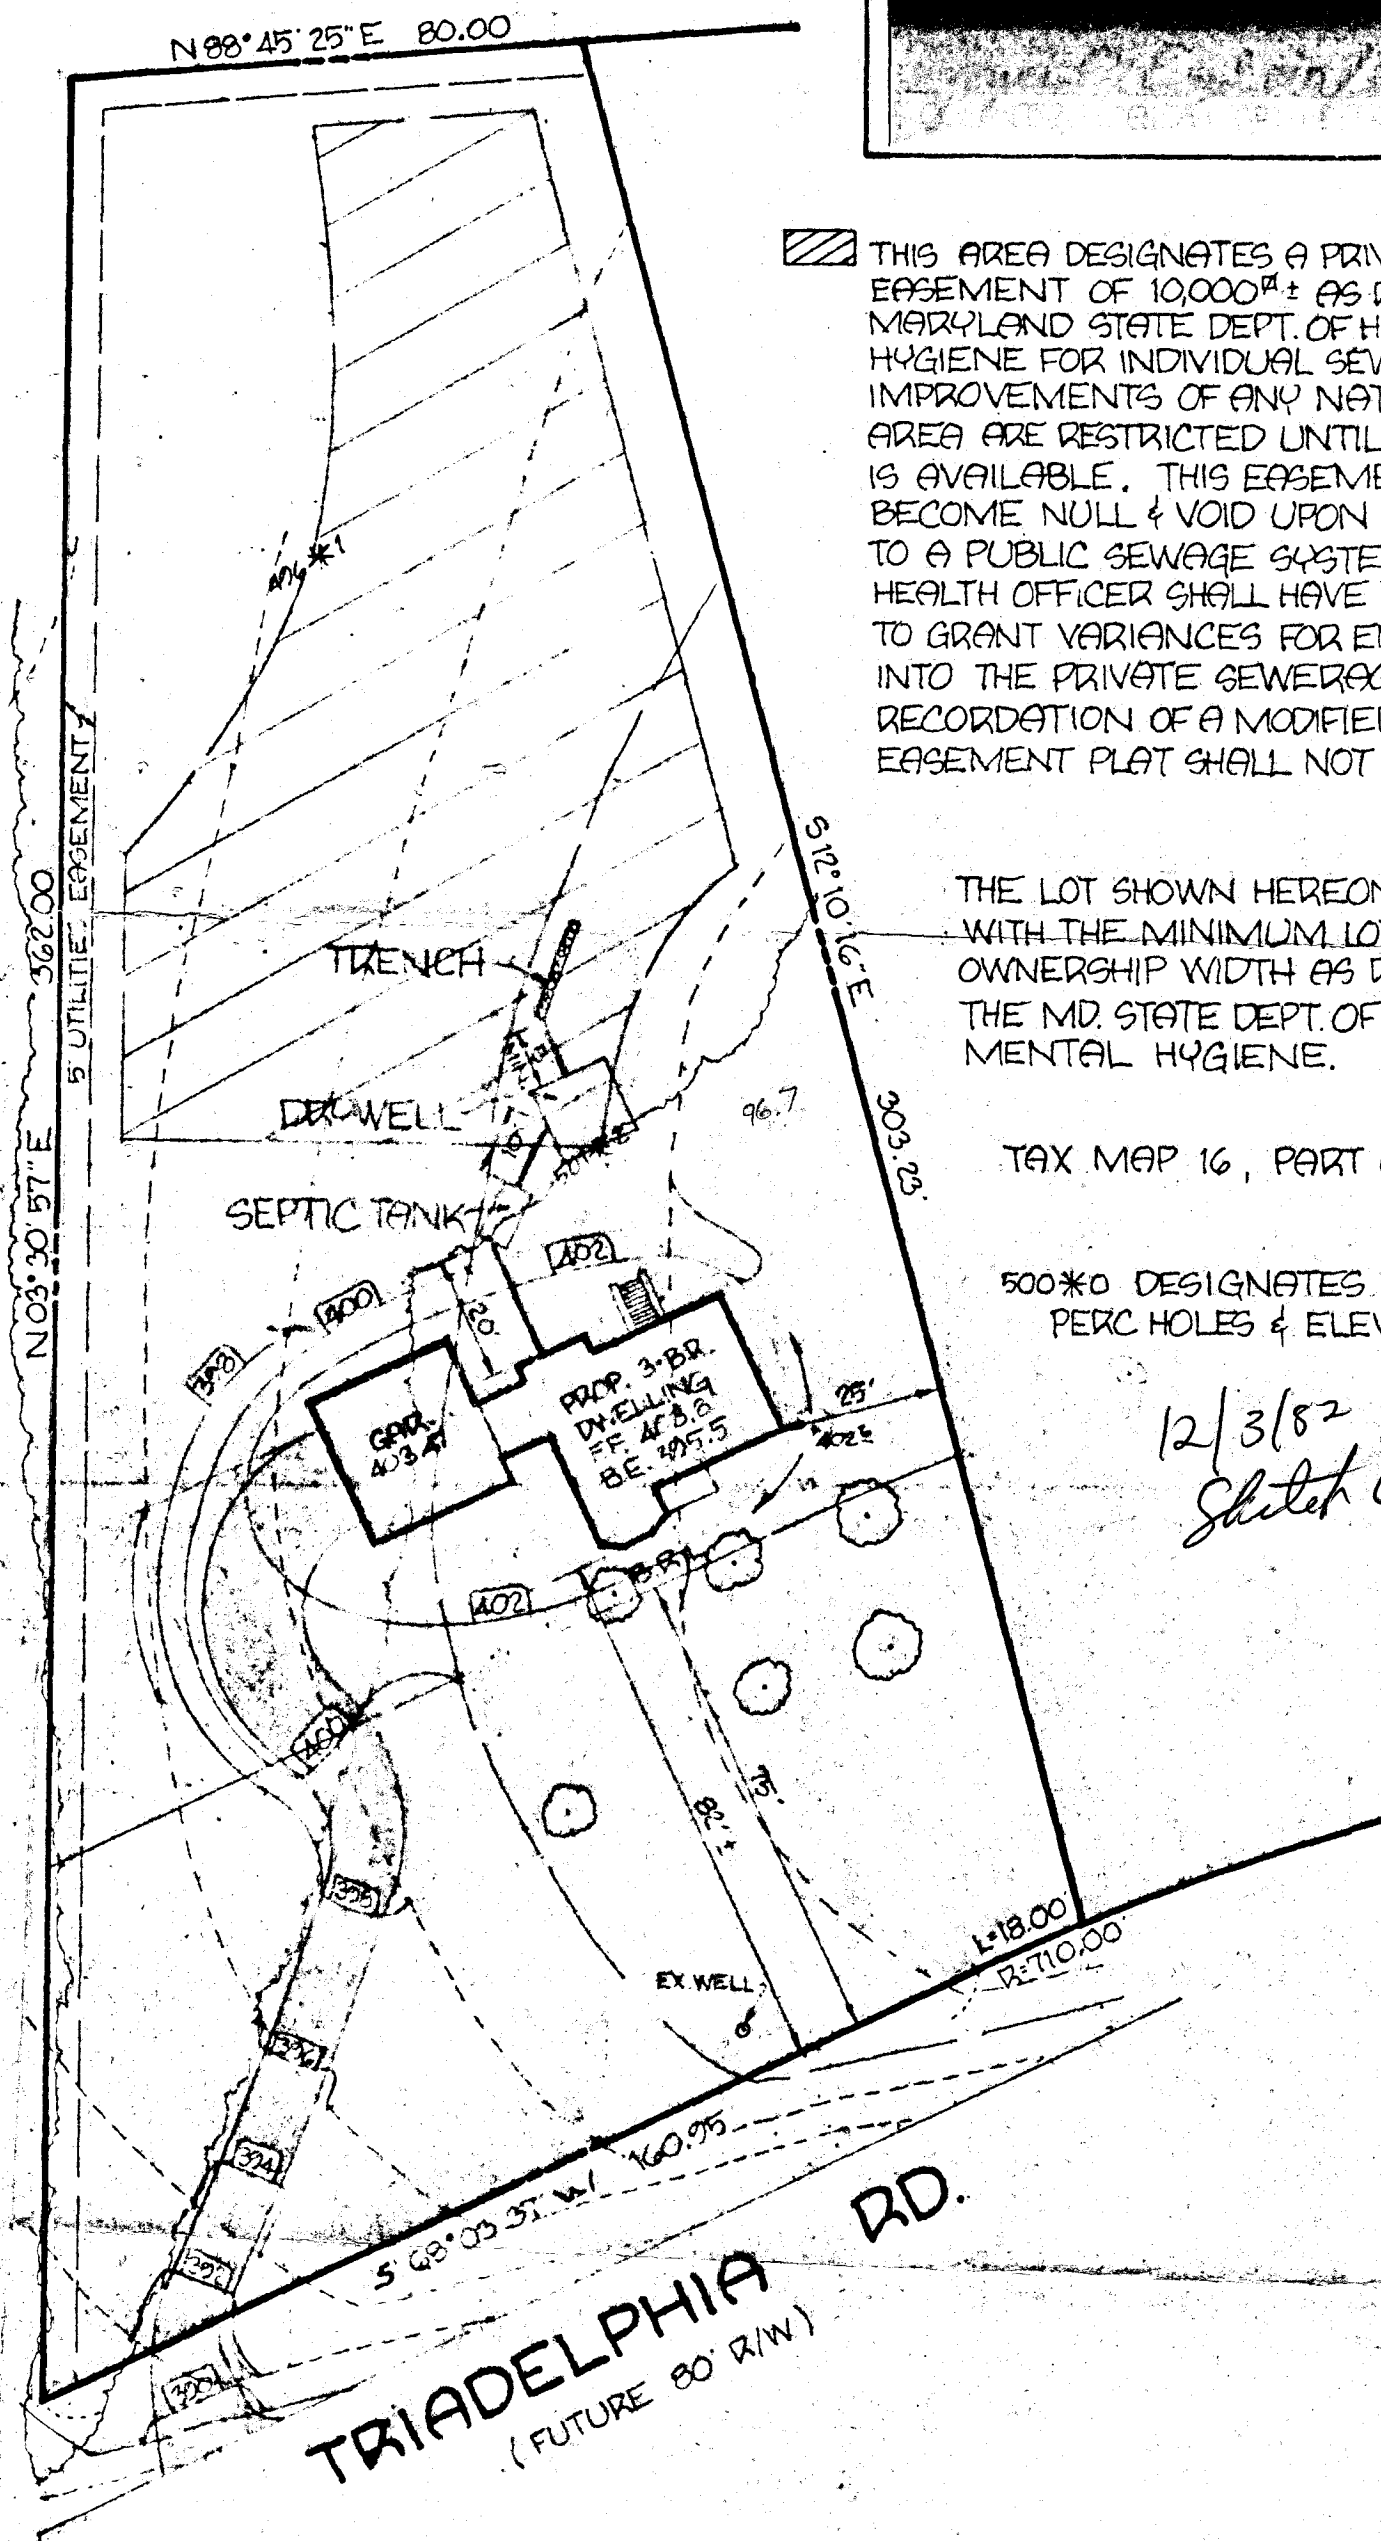


THIS AREA DESIGNATES A PRIVATE SEWERAGE EASEMENT OF 10,000^{sq} ft AS REQUIRED BY THE MARYLAND STATE DEPT. OF HEALTH & MENTAL HYGIENE FOR INDIVIDUAL SEWAGE DISPOSAL. IMPROVEMENTS OF ANY NATURE IN THIS AREA ARE RESTRICTED UNTIL PUBLIC SEWER IS AVAILABLE. THIS EASEMENT SHALL BECOME NULL & VOID UPON CONNECTION TO A PUBLIC SEWAGE SYSTEM. THE COUNTY HEALTH OFFICER SHALL HAVE THE AUTHORITY TO GRANT VARIANCES FOR ENCROACHMENTS INTO THE PRIVATE SEWERAGE EASEMENT. RECORDATION OF A MODIFIED SEWERAGE EASEMENT PLAT SHALL NOT BE NECESSARY.

THE LOT SHOWN HEREON COMPLIES WITH THE MINIMUM LOT AREA & OWNERSHIP WIDTH AS REQUIRED BY THE MD. STATE DEPT. OF HEALTH & MENTAL HYGIENE.

TAX MAP 16, PART OF PARCEL 240

500*0 DESIGNATES FIELD-LOCATED PERC HOLES & ELEVATIONS.

12/3/82
Sketch G.R. F.S.

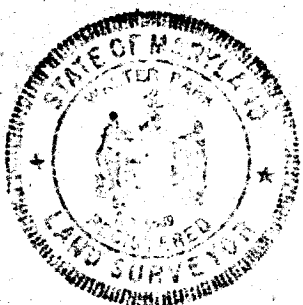

Walter Park
WALTER PARK
PROF. L.S. #5539
HUDKINS ASSOCIATES, INC.
231 JOSEPH SQUARE
COLUMBIA, MD. 21044


INV. @ HOUSE : 498.15
SEPTIC TANK
EX. GR. : 500.5 FIN. GR. : 500.5
INV. IN. : 498.55 INV. OUT. : 498.30
DRY WELL
EX. GR. : 501.2 FIN. GR. : 501.2
INV. IN. : 498.20 INV. OUT. : 498.20
TRENCH
EX. GR. : 500.3
FIN. GR. : 500.3
TOP OF STONE : 497.30
INV. IN. : 496.80
BOTTOM OF STONE : 491.30

SITE PLAN
LOT 1, SECTION 1
'GREENHENG' P.B. 10 / F. 42
3RD ELECTION DISTRICT
HOWARD COUNTY, MD.
NOV. 30, 1982 SCALE : 1" = 30'

Property known as: **LOT 1**
SECTION 1 GREEN HEDGE
3rd ELECTION DISTRICT

THIS PLAT CAN NOT BE USED TO ESTABLISH PROPERTY LINES OR CORNERS.

P.B. 10/42
HOWARD C. M.D.

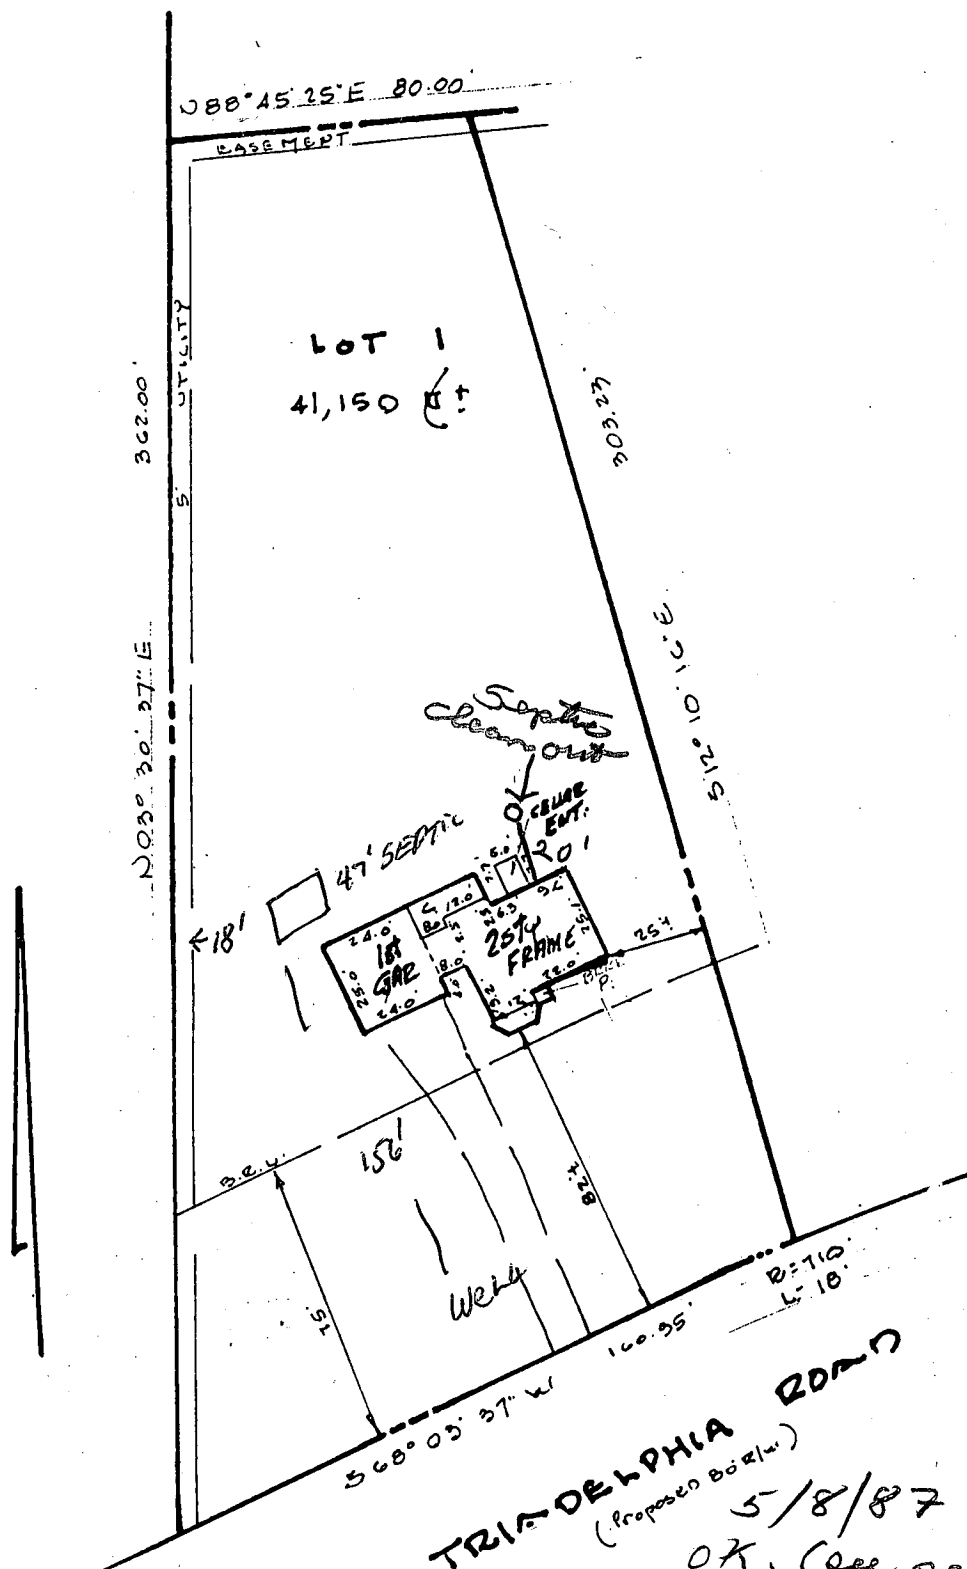


TRI-DELPHIA ROAD
 (Proposed Bldg (w))

*5/8/87 Bldg construction
 OK. (see septic tank location)
 No visible septic problems*

LOCATION SURVEY PLAT


4/27/1987

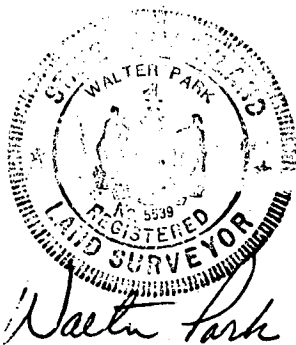CERTIFICATION	SEAL	SCALE 1" = 50' DATE
This is to certify that I have surveyed the property known as: <u>#12030</u> <u>12030 TRI-DELPHIA ROAD</u> For the purpose of showing the improvements shown and the improvements are located as shown.	 Walter Park	PHONE 828-9060 TOWSON 730-9060 COLUMBIA WALTER PARK, L.S. INC. SUITE 231, JOSEPH SQUARE 5485 HARPERS FARM ROAD WALTER PARK, L.S. COLUMBIA, MARYLAND 21044 # 5539

THIS PLAT CAN NOT BE USED TO ESTABLISH PROPERTY
LINES OR CORNERS.

SECTION 1 GREEN HEDGE
3rd ELECTION DISTRICT

P.B. 10/42
HOWARD G. MO

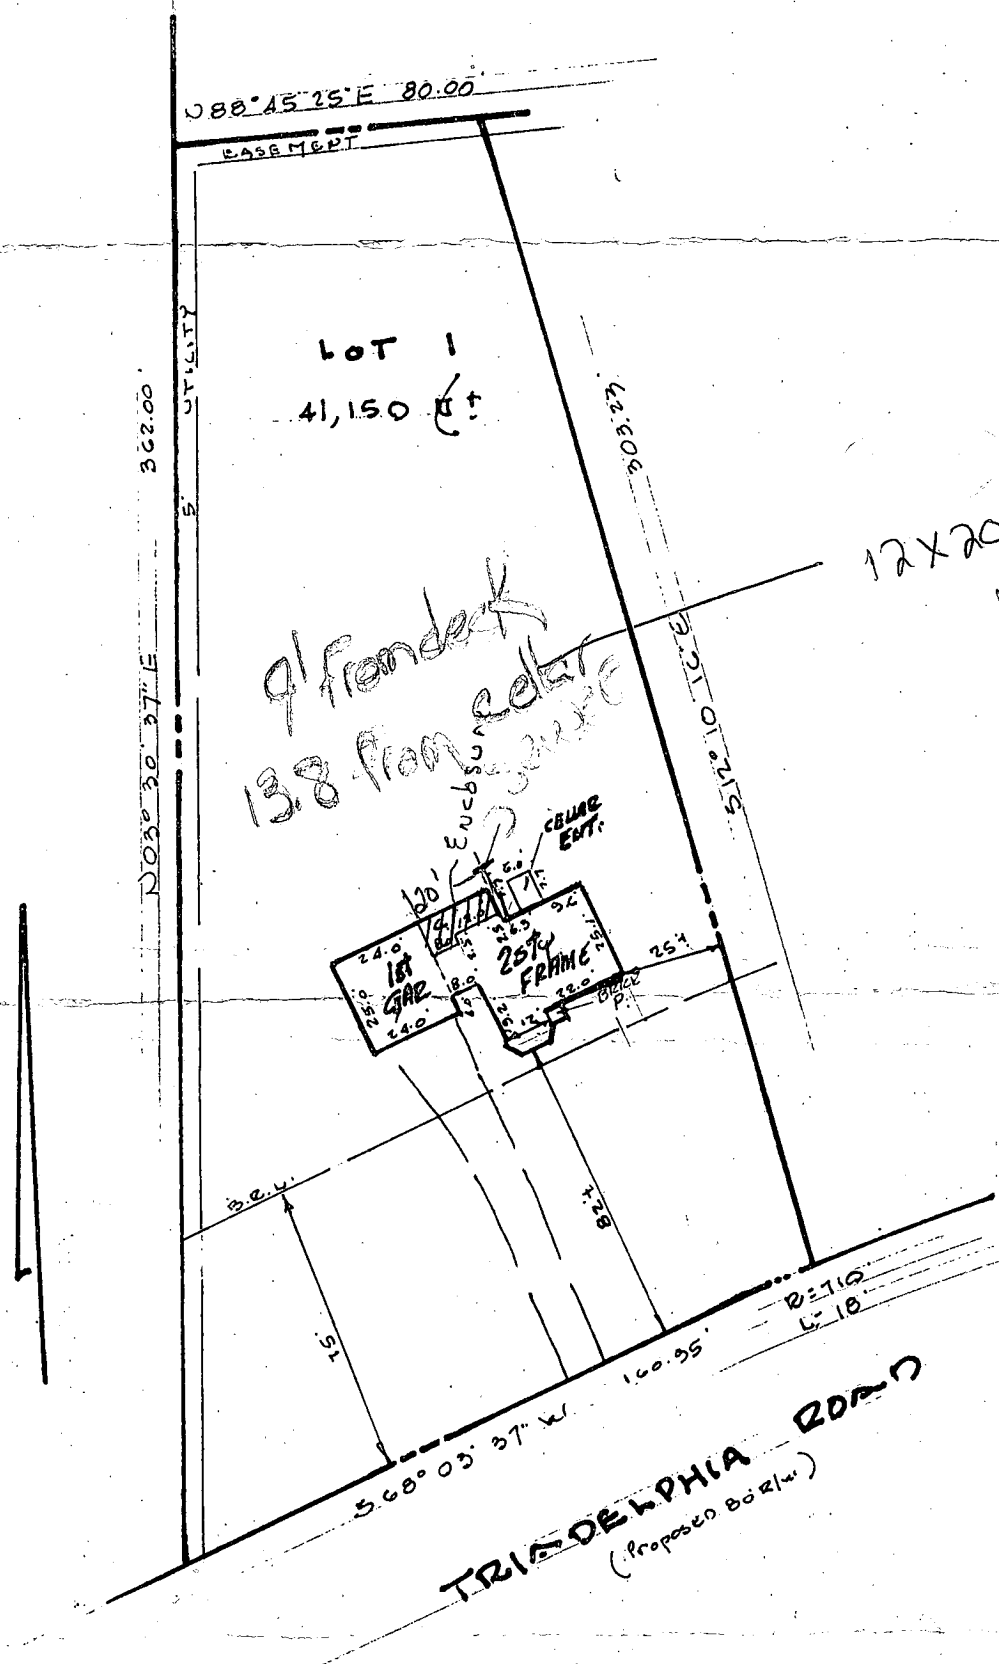

12x20 on slab
existing
with footer.

6/2/90
OK TO SIGN
BH

LOCATION SURVEY PLAT

4/27/1983

CERTIFICATION This is to certify that I have surveyed the property known as: <u>#12030</u> <u>12030 TRIADDELPHIA ROAD</u> for the purpose of locating the im- provements thereon, and the improvements are located as shown.	SEAL  <i>Walter Park</i>	SCALE 1" = 50' DATE 4/21/78 PHONE 828-9060 TOWSON 730-9060 COLUMBIA HUDKINS ASSOCIATES, INC. <i>Surveyors and Subdivision Designers</i> SUITE 231, JOSEPH SQUARE 5485 HARPERS FARM ROAD WALTER PARK, L.S. COLUMBIA, MARYLAND 21044 # 5539
32775		