

5/12/83
AM

approved
5-12-83
C. [signature]
P 32752
A 32298

PERMIT

SEWAGE DISPOSAL SYSTEM

MARYLAND STATE DEPARTMENT OF HEALTH

HOWARD COUNTY
BUREAU OF ENVIRONMENTAL HEALTH
992-2330

03-306518

INDL

ELLICOTT CITY
DISTRICT 3rd

DATE May 11, 1983

Herman Sirk

IS PERMITTED TO INSTALL ☒ ALTER ☐

ADDRESS 2555 Jennings Chapel Road, Woodbine, MD 21797 PHONE 489-4724

SUBDIVISION ROAD 1920 1900 Woodstock Rd. LOT

PROPERTY OWNER Louis Spittel Edward Walter

ADDRESS 8231 Main Street, Ellicott City, MD Phone: 465-2990

IF GARBAGE GRINDER IS USED INCREASE SEPTIC TANK CAPACITY BY 50% AND ABSORPTION AREA BY 22%.

GARBAGE GRINDER? YES ☐ NO ☒

SEPTIC TANK CAPACITY 1000 GALLONS NUMBER OF BEDROOMS 3

375 minimum total sq. ft. 3 bedrooms, 125 sq. ft. (per bedroom) Inlet 4 ft. below original grade.

Maximum depth 10 1/2 ft. below original grade. Effective area begins at 4 ft. below original

grade. NOTE: If trench is used to make up absorbent area, run the trench on level ground and

leave a 5 ft. earth buffer between drywell and trench. No trench is to exceed 100 ft. in

length. Trench inlet to be same as dry well, with 6 1/2 ft. of stone below distribution pipe.

LOCATION: Place drywell at location of highest perc hole - 30' from the left lot line and

340' from the front lot line as seen when facing the property from woodstock road.

PLANS APPROVED BY Craig Williams DATE 12/27/82

COVER NO WORK UNTIL INSPECTED AND APPROVED.

NEITHER THE HOWARD COUNTY COUNCIL NOR THE HEALTH DEPARTMENT IS RESPONSIBLE FOR THE SUCCESSFUL OPERATION OF ANY SYSTEM.

NOTE: IF TRENCH IS USED CALL FOR INSPECTION BEFORE AND AFTER PLACING GRAVEL IN TRENCH.

NOTE: NO DRY WELL SHALL EXCEED 15 FOOT IN DIAMETER. NO ABSORPTION TRENCH TO EXCEED 100 FEET IN LENGTH.

NOTE: ALL PIPE FROM HOUSE TO SEPTIC TANK MUST BE CAST IRON OR SCHEDULE 40 PVC OR ABS.

PERMIT VOID AFTER THREE YEARS.

NOTE: INSTALL STAND PIPE ON SEPTIC TANK AND DRY WELL. STAND PIPES MUST BE 6 INCHES IN DIAMETER, CAST IRON, CONCRETE OR TERRA COTTA, OR PVC OR ABS ACCEPTED. IF TOP OF SEPTIC TANK IS DEEPER THAN 3 FEET MANHOLE TO GRADE REQUIRED.

BLDG. PERMIT SIGNED
AND RETURNED 10-8-98
Serial # B70 114517
extend garage for family room & garage


*INSTALLER IS RESPONSIBLE FOR OBTAINING FINAL APPROVAL ON THIS PERMIT

BLDG. PERMIT SIGNED
AND RETURNED 11/7/83
Serial # 56345 - Seaweed Patch

*CALL 992-2330 FOR INSPECTION OF SEPTIC SYSTEMS.

BLDG. PERMIT SIGNED
AND RETURNED 9/15/82-1082
T84-44505 for Pool

A 32298

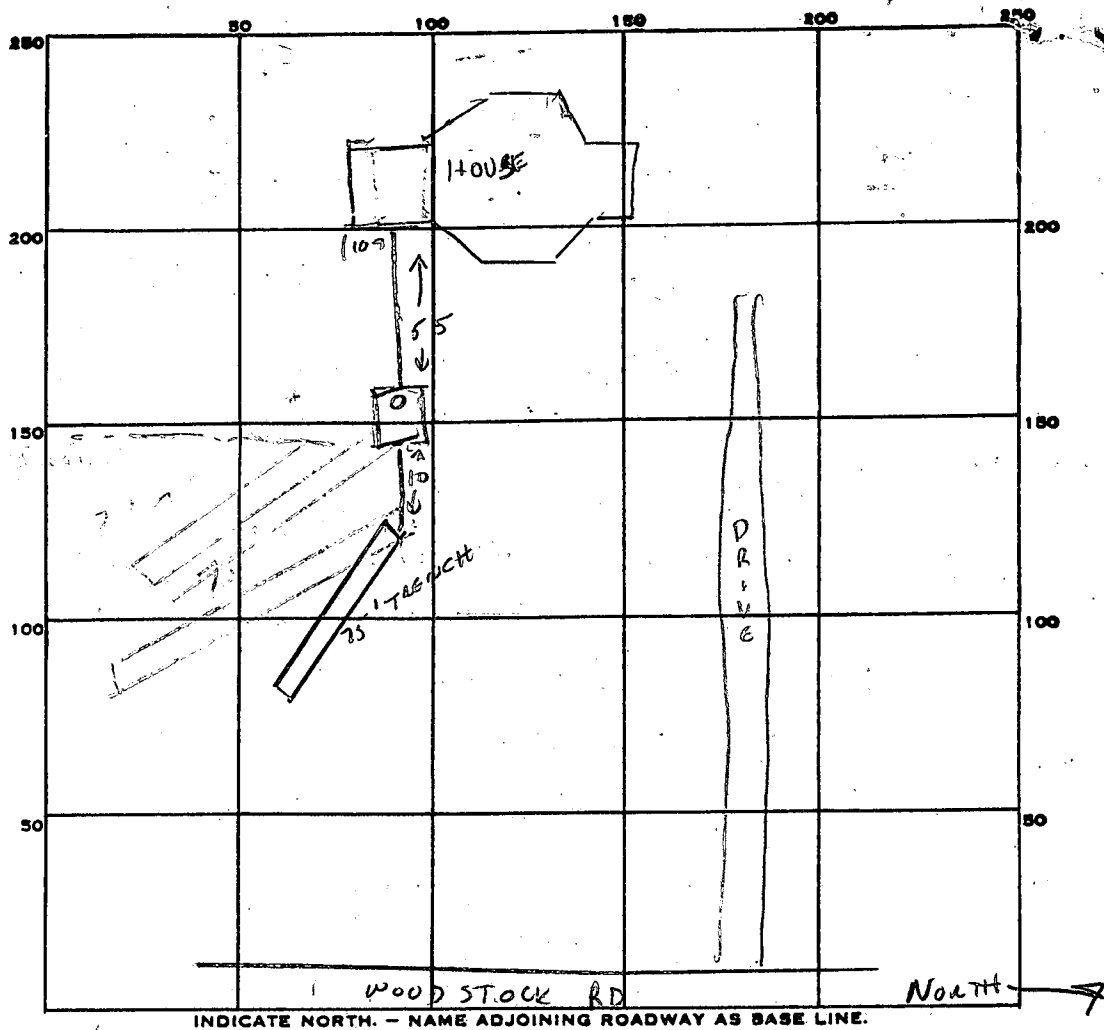

PERMIT CARD _____

SEPTIC TANK, LEVEL ☒ _____

CLEANOUTS ST ☒ _____

DISTRIBUTION BOX, LEVEL _____

TILE FIELD, DEPTH 10 1/2 FT. TRENCH WIDTH 2 FT.

GRAVEL DEPTH 6 1/2 IN. TOTAL LENGTH 75 FT.

NUMBER OF TRENCHES 1 TOTAL BOTTOM AREA 487

SEEPAGE PITS, INSIDE DIAMETER _____ FT. DEPTH BELOW INLET _____ FT.

ABSORBENT AREA 487 SQ. FT.

REMARKS _____

DATE SYSTEM APPROVED 5-12-83 INSPECTOR C. W. O'Han

APPLICATION

SEWAGE DISPOSAL TESTING

STATE OF MARYLAND - DEPARTMENT OF HEALTH AND MENTAL HYGIENE

HOWARD COUNTY HEALTH DEPARTMENT
ENVIRONMENTAL HEALTH SERVICES

P. O. BOX 476 ELLICOTT CITY, MARYLAND 21043
TELEPHONE: 992-2330

A 32298

P _____

DISTRICT 3rd

DATE 11/8/82

TO: THE COUNTY HEALTH OFFICER
ELLICOTT CITY, MARYLAND

I, HEREBY, APPLY FOR THE NECESSARY TEST IN ORDER TO CONSTRUCT (OR RECONSTRUCT) A SEWAGE DISPOSAL SYSTEM.

PROPERTY OWNER LOUIS A. SPITTEL

ADDRESS 8231 MAIN STREET PHONE 465-2990
ELLICOTT CITY

PROPERTY LOCATION:

SUBDIVISION _____ LOT NO. _____

ROAD AND DESCRIPTION 500 FT. NORTH OF RT. 99 ON LEFT
SIDE OF 1900 WOODSTOCK RD.

SIZE OF LOT 3.684 AC. TYPE BLDG. 3
(NUMBER OF BEDROOMS)

THE SYSTEM INSTALLED UNDER THIS APPLICATION IS ACCEPTABLE ONLY UNTIL PUBLIC FACILITIES BECOME AVAILABLE. I FULLY UNDERSTAND THE
FEE CONNECTED WITH THE FILING OF THIS PERC TEST APPLICATION IS NON-REFUNDABLE UNDER ANY CIRCUMSTANCES. I ALSO AGREE TO COMPLY
WITH ALL M.O.S.H.A. REQUIREMENTS IN TESTING THIS LOT

(SIGNATURE OF APPLICANT)

APPROVED BY _____ FOR _____ DATE _____


REJECTED BY _____ FOR _____ DATE _____

HOLD PENDING FURTHER TESTS _____ DATE _____

REASONS FOR REJECTION OR HOLDING _____

BLDG. PERMIT SIGNED
AND RETURNED 3/3/83
Serial # 52774

THIS IS NOT A PERMIT

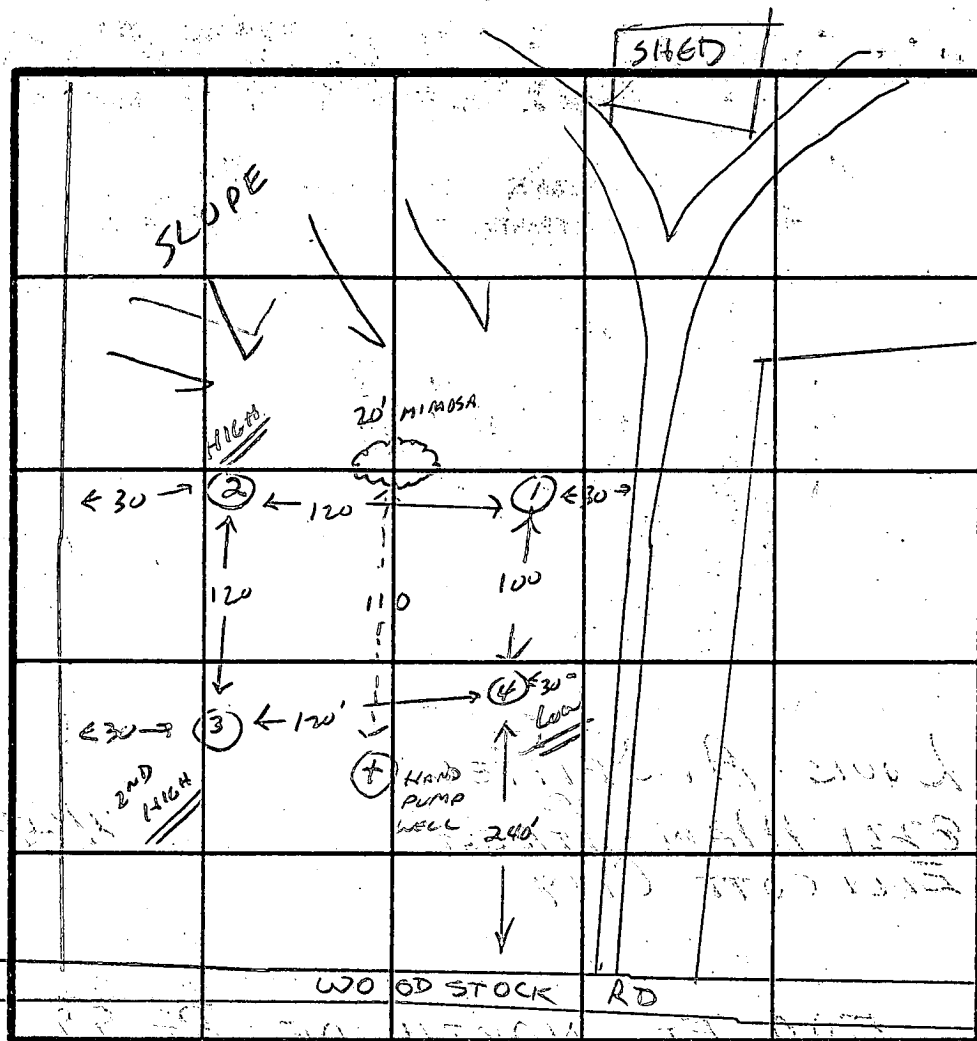





INDICATE NORTH - NAME ADJOINING ROADWAY AS BASE LINE.

DATE	TEST NO.	DEPTH	PRE-WET		TEST - 1" DROP		TIME
			START	STOP	START	STOP	
12-17-82	1 S	5'	10:33	10:36	10:36	10:41	5 MIN
	V	12'	SAND				
HIGH	2 S	4'	10:35	10:37	10:37	10:39	2 MIN
	V	13'	SAND				
	S1	5'	10:48	SOME MOVEMENT -		DUG DEEPER	
	3 S2	6'	10:56	10:59	10:59	10:03	4 MIN
2ND HIGH	V	12'	SAND				
LOW	4 S	4'	10:51	11:01	10:01	SOME MOVEMENT DUG DEEPER	
	S2	5'	11:15	11:21	11:21	11:32	11 MIN
	V	14'	SAND				

REMARKS 25' DEEP HAND PUMP WELL AT LOW END OF PERC AREA - FOR IRRIGATION ONLY

TYPE OF SOIL CLAY - SAND LOAM OVER SAND (WATER AT OR ABOVE 25' DEPTH)

TESTED BY Carroll ALSO PRESENT OLLIN KOTTERMAN
LOUIS SPITTEL

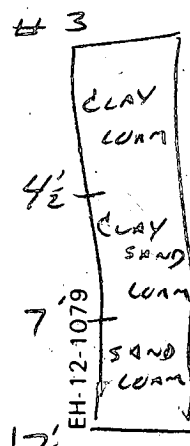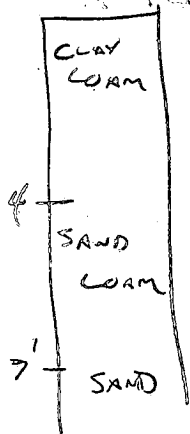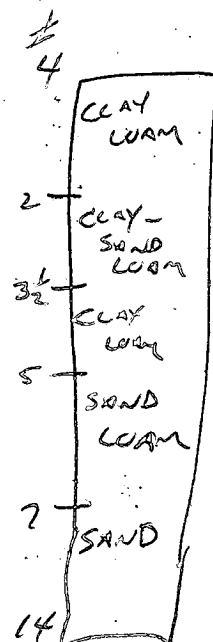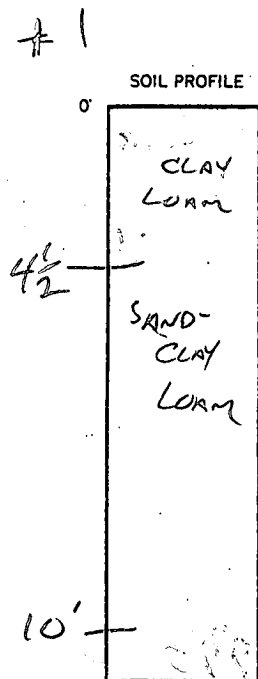

RECORDED
Liber 199
Folio 409

APPLICATION

SEWAGE DISPOSAL TESTING

STATE OF MARYLAND - DEPARTMENT OF HEALTH AND MENTAL HYGIENE

HOWARD COUNTY HEALTH DEPARTMENT
ENVIRONMENTAL HEALTH SERVICES

P.O. BOX 476 ELLICOTT, MARYLAND 21043
TELEPHONE: 992-2330

A 29121

P _____

DISTRICT 3rd

DATE 10/31/78

TO: THE COUNTY HEALTH OFFICER
ELLICOTT CITY, MARYLAND

I, HEREBY, APPLY FOR THE NECESSARY TEST IN ORDER TO CONSTRUCT (OR RECONSTRUCT) A SEWAGE DISPOSAL SYSTEM.

PROPERTY OWNER Edgar A. Patterson, 1 S. Wickham Rd., Balto., Md. 21229

ADDRESS Contractor - Louis A. Spittel PHONE 465-2990

PROPERTY LOCATION:

SUBDIVISION _____ LOT NO. _____


ROAD AND DESCRIPTION Woodstock Road - next to green rancher - which is 3rd house in on
the left when turning right off Route 99 into Woodstock Road

SIZE OF LOT 3.684 acres m/l TYPE BLDG. 3 or 4 bedrooms

THE SYSTEM INSTALLED UNDER THIS APPLICATION IS ACCEPTABLE ONLY UNTIL PUBLIC FACILITIES BECOME AVAILABLE.

I FULLY UNDERSTAND THE FEE CONNECTED WITH THE FILING OF THIS PERC TEST APPLICATION IS NON-REFUNDABLE UNDER

ANY CIRCUMSTANCES.

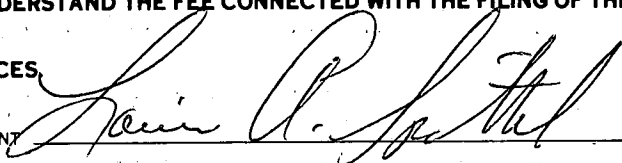SIGNATURE OF APPLICANT 

APPROVED BY _____ FOR _____ DATE _____

REJECTED BY _____ FOR _____ DATE _____


HOLD PENDING FURTHER TESTS _____ DATE _____

REASONS FOR REJECTION OR HOLDING for certified holes by Parks per Mr. Spittel

THIS IS NOT A PERMIT

SOIL PROFILE

Brown
clay
sandy
loam

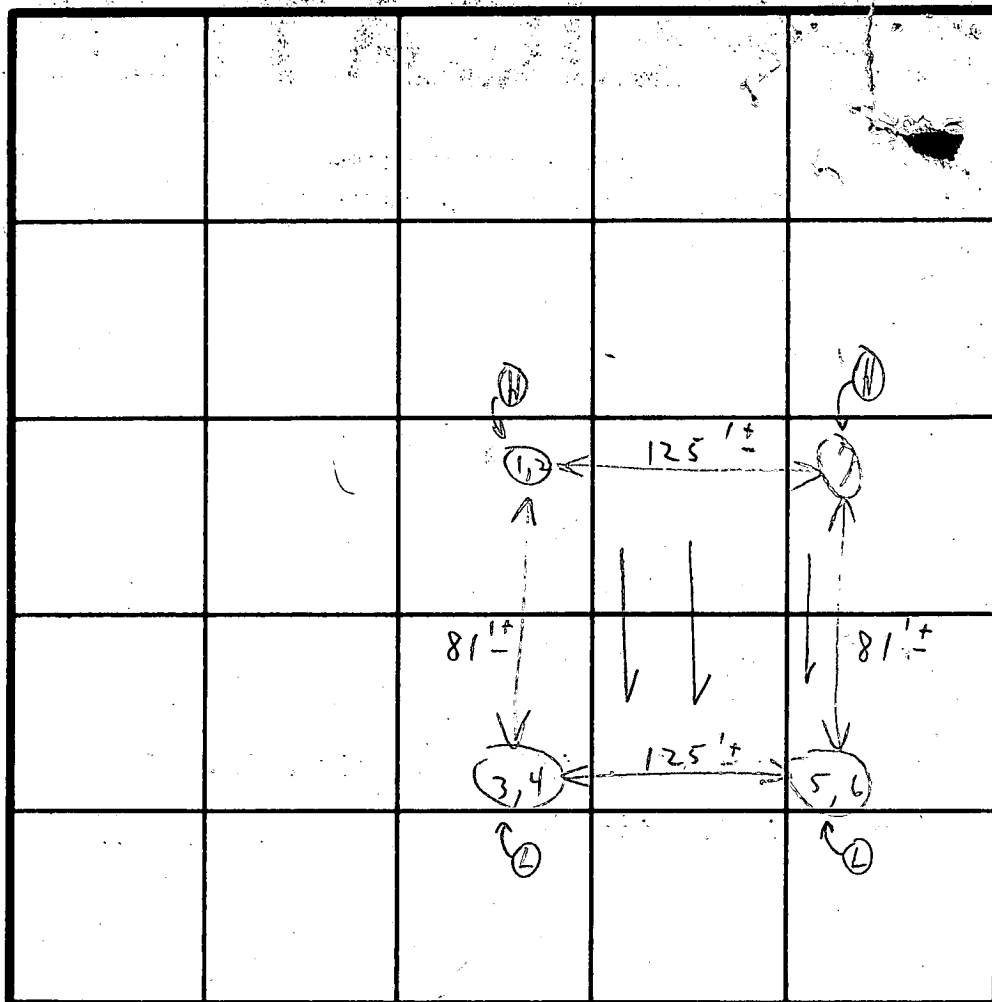

INDICATE NORTH - NAME ADJOINING ROADWAY AS BASE LINE.

DATE	TEST NO.	DEPTH	PRE-WET		TEST - 1" DROP		TIME
			START	STOP	START	STOP	
11/7/78	1	4'	2:04	2:05	2:05	2:06	1 min
	(H) 2	13'	2:04	2:06	2:06	2:08	2 min
	3	3'	1:55	1:58	1:58	2:03	5 min
	(L) 4	14'	1:55	1:57	1:57	2:00	3 min
	5	4 1/2'	1:48	1:50	1:50	1:52	2 min
	(L) 6	12 1/2'	1:42	1:44	1:44	1:48	4 min
	(H) 7	(14')	Visual		sandy loam		

REMARKS

TYPE OF SOIL

TESTED BY

Tests in open field

C. B. D.

ALSO PRESENT

(2) Mr. Ketterman &
(3) son

at site (1) Mr. Spittler to have Mr. Beck
certify to his presence

B 1	1573	SEQUENCE NO. (OEP USE ONLY)	STATE OF MARYLAND 2/24/83 PERMIT TO DRILL WELL 10:30 please print or type. Grant	OEP PERMIT NUMBER H0-73-4385 fill in this form completely
(THIS NUMBER IS TO BE PUNCHED IN COLS. 3-6 ON ALL CARDS)				
Date Received 0 1 2 0 8 3 (OEP Use Only)		LOCATION OF WELL COUNTY Howard SUBDIVISION tax map 9. parcel 155 SECTION none LOT none NEAREST TOWN Woodstock MILES FROM TOWN (enter 0 if in town) I		
OWNER INFORMATION Last Name 15 SPITTEL Owner 34 Name ELLA Street or RFD 36 8231 MAIN ST 55 Town 57 ELLICOTT CITY MD 76 Zip		B 3 DIRECTION OF WELL FROM TOWN (CIRCLE BOX) 		
B 1 Continued DRILLER INFORMATION Driller's Name Ralph Mayne 273 77 License No. 80 Firm Name Ralph Mayne (well Drilling) Address Rt. Box 9120 Mt. Airy Md. Signature Ralph Mayne 11/2/83 Date		B 4 NEAR WHAT ROAD Woodstock Rd. ON WHICH SIDE OF ROAD (CIRCLE APPROPRIATE BOX) NORTH WEST SOUTH EAST 400 DISTANCE FROM ROAD (CIRCLE APPROPRIATE BOX)		
B 2 WELL INFORMATION APPROX. PUMPING RATE (GAL. PER MIN.) 5 AVERAGE DAILY QUANTITY NEEDED (GAL. PER DAY) 500		SHOW MAJOR FEATURES OF BOX & LOCATE WELL WITH AN X SOURCES OF DRILLING WATER 1. well 2. 3. WRITE THE BOX NUMBER FROM THE MAP HERE 830 2 540 1		
USE FOR WATER (CIRCLE APPROPRIATE BOX) ☒ HOME (SINGLE OR DOUBLE HOUSEHOLD UNIT ONLY) ☐ FARMING (LIVESTOCK WATERING & AGRICULTURAL IRRIGATION) ☐ INDUSTRIAL, COMMERCIAL, STATE AND FEDERAL GOV. OTHER (REQUIRES APPROPRIATION PERMIT) ☐ PUBLIC OR PRIVATE WATER COMPANY (REQUIRES APPROPRIATION PERMIT AND STATE HEALTH DEPARTMENT APPROVAL) ☐ TEST, OBSERVATION, MONITORING (MAY REQUIRE APPROPRIATION PERMIT)		LOCATION OK 36' CASING 1 1/2' ABOVE GR 31' OPEN 8 BAGS CEMENT 2-24-83 CW		
APPROXIMATE DEPTH OF WELL 150 FEET APPROXIMATE DIAMETER OF WELL 6 INCH METHOD OF DRILLING (circle one) BORED (OR AUGERED) AIR ROTARY JETTED AIR PERCUSSION JETTED & DRIVEN ROTARY (HYDRAULIC ROTARY) CABLE REVERSE ROTARY DRIVE POINT other		DRAW A SKETCH BELOW SHOWING LOCATION OF WELL IN RELATION TO NEARBY TOWNS AND ROADS AND GIVE DISTANCE FROM WELL TO NEAREST ROAD JUNCTION. 		
REPLACEMENT OR DEEPEINED WELLS (CIRCLE APPROPRIATE BOX) ☒ THIS WELL WILL NOT REPLACE AN EXISTING WELL ☐ THIS WELL WILL REPLACE A WELL THAT WILL BE ABANDONED AND SEALED ☐ THIS WELL WILL REPLACE A WELL THAT WILL BE USED AS A STANDBY ☐ THIS WELL WILL DEEPEIN AN EXISTING WELL PERMIT NUMBER OF WELL TO BE REPLACED OR DEEPEINED (IF AVAILABLE) 41		NOT TO BE FILLED IN BY DRILLER HEALTH DEPARTMENT APPROVAL COUNTY NAME HOWARD COUNTY NO. A32298 OEP SIGNATURE DATE ISSUED 12/01/83 STATE HEALTH CIRCLE BOX 41 CO SIGNATURE NORTH GRID 541 EAST GRID 0832 EXPIRES 08/01/83		
Not to be filled in by driller (OEP USE ONLY) APPROP. PERMIT NUMBER 54 GAP 63 FORCE F S WRITE INITIALS IN BOX 64 68 PERMIT No. H0-73-4385 70 71 72 73 74 75 76 77 78 79		SPECIAL CONDITIONS 8-63		

Review

FIELD DATA SHEET

HOWARD COUNTY WELL YIELD TEST

We'll Permit No. MO - 73-4385
Location of property (road) WOODSTOCK RD
Subdivision TAX MAP 9 PARCELS 155 Lot Block Plat Sec.
Well Driller RALPH MAYNE Owner L.A. SPITTEL

Depth of well 300 FT
Distance of measuring point (M.P.) above ground 1 1/2
Static water level (S.W.L.) below M.P. 30

1. High rate pumping -- reservoir drawdown

Time pump started 9:15 Pumping rate 96 gpm
Total time 30 min to reach pumping water level 110 ft. below N.P.

II. Recovery pump test data - observations to be recorded every 15 minutes

[illegible]

C1	6228	SEQUENCE NO. (OEP USE ONLY)	STATE OF MARYLAND WELL COMPLETION REPORT FILL IN THIS FORM COMPLETELY PLEASE PRINT OR TYPE	THIS REPORT MUST BE SUBMITTED WITHIN 45 DAYS AFTER WELL IS COMPLETED.
(THIS NUMBER IS TO BE PUNCHED IN CQ'S 3-6 ON ALL CARDS)		COUNTY NUMBER A 32298		
Date Received (OEP use only)	DATE WELL COMPLETED 09/24/83		Depth of Well 300 ft (TO NEAREST FOOT)	PERMIT NO. FROM "PERMIT TO DRILL WELL" 40-73-4385

OWNER Spittel last name	L. A. first name	TOWN Woodstock
STREET OR RFD Woodstock Rd.		
SUBDIVISION tax map 9, par. 155		

WELL LOG		
Not required for driven wells		
STATE THE KIND OF FORMATIONS PENETRATED, THEIR COLOR, DEPTH, THICKNESS AND IF WATER BEARING		
DESCRIPTION (Use additional sheets if needed)	FEET	Check if water bearing
	FROM	TO
Top Soil	0	2
Sandy	2	26
Sand Stone	26	40
ARATE	40	50
Sand Stone	50	55
GRATE	55	300

GROUTING RECORD																	
WELL HAS BEEN GROUTED ☒ YES ☐ NO (Circle Appropriate Box)																	
TYPE OF GROUTING MATERIAL CEMENT ☒ BENTONITE CLAY ☒																	
NO. OF BAGS 8 NO. OF POUNDS 800 GALLONS OF WATER 48 DEPTH OF GROUT SEAL (to nearest foot) from 0 ft. to 30+ ft. (enter 0 if from surface)																	
CASING RECORD																	
casing types insert appropriate code below																	
<table style="width:100%; text-align: center;"> <tr> <td>☒ ST</td> <td>☒ CO</td> </tr> <tr> <td>STEEL</td> <td>CONCRETE</td> </tr> <tr> <td>☒ PL</td> <td>☐ OT</td> </tr> <tr> <td>PLASTIC</td> <td>OTHER</td> </tr> </table>			☒ ST	☒ CO	STEEL	CONCRETE	☒ PL	☐ OT	PLASTIC	OTHER							
☒ ST	☒ CO																
STEEL	CONCRETE																
☒ PL	☐ OT																
PLASTIC	OTHER																
MAIN CASING TYPE ☒ PL 6 36 60 61 62 64 66 70																	
Nominal diameter top(main) casing (nearest inch) Total depth of main casing (nearest foot)																	
OTHER CASING (if used) diameter inch depth (feet) from to																	
EACH CASING																	
screen type or openhole insert appropriate code below																	
<table style="width:100%; text-align: center;"> <tr> <td>☒ ST</td> <td>☒ BR</td> <td>☒ HO</td> </tr> <tr> <td>STEEL</td> <td>BRASS</td> <td>OPEN HOLE</td> </tr> <tr> <td></td> <td>BRONZE</td> <td></td> </tr> <tr> <td>☒ PL</td> <td>☐ OT</td> <td></td> </tr> <tr> <td>PLASTIC</td> <td>OTHER</td> <td></td> </tr> </table>			☒ ST	☒ BR	☒ HO	STEEL	BRASS	OPEN HOLE		BRONZE		☒ PL	☐ OT		PLASTIC	OTHER	
☒ ST	☒ BR	☒ HO															
STEEL	BRASS	OPEN HOLE															
	BRONZE																
☒ PL	☐ OT																
PLASTIC	OTHER																
C2 (seq. no.)																	
DEPTH (nearest ft.) 34 300 EACH SCREEN																	
SLOT SIZE 2																	
DIAMETER OF SCREEN (NEAREST INCH) from to																	
GRAVEL PACK																	
IF WELL DRILLED WAS FLOWING WELL CIRCLE BOX ☒																	

PUMPING TEST	
HOURS PUMPED (nearest hour)	6
PUMPING RATE (gal. per min. to nearest gal.)	1
METHOD USED TO MEASURE PUMPING RATE	Bucket
WATER LEVEL (distance from land surface)	
BEFORE PUMPING	30
WHEN PUMPING	300
TYPE OF PUMP USED (for test)	
☒ A air	☐ P piston
☐ C centrifugal	☐ R rotary
☐ J jet	☒ S submersible
☐ T turbine	☐ O other (describe below)

PUMP INSTALLED	
DRILLER WILL INSTALL PUMP (CIRCLE APPROPRIATE BOX)	☒ YES ☐ NO
IF DRILLER INSTALLS PUMP, THIS SECTION MUST BE COMPLETED FOR ALL WELLS EXCEPT HOME USE	
TYPE OF PUMP (WRITE APPROPRIATE LETTER IN BOX - SEE ABOVE: (A, C, J, P, R, S, T, O))	
CAPACITY: GALLONS PER MINUTE (to nearest gallon)	
PUMP HORSE POWER	
PUMP COLUMN LENGTH (nearest ft.)	
CASING HEIGHT (circle appropriate box and enter casing height)	
☒ above	2 (nearest foot)
☐ below	

CIRCLE APPROPRIATE BOX	
☒ A	A WELL WAS ABANDONED AND SEALED WHEN THIS WELL WAS COMPLETED
☐ E	ELECTRIC LOG OBTAINED
☐ P	TEST WELL CONVERTED TO PRODUCTION WELL
I HEREBY CERTIFY THAT THIS WELL HAS BEEN CONSTRUCTED IN ACCORDANCE WITH COMAR 10.17.13 "WELL CONSTRUCTION" AND IN CONFORMANCE WITH ALL CONDITIONS STATED IN THE ABOVE CAPTIONED PERMIT, AND THAT THE INFORMATION PRESENTED HEREIN IS ACCURATE AND COMPLETE TO THE BEST OF MY KNOWLEDGE.	
DRILLERS IDENT. NO. 223	
DRILLERS SIGNATURE Ralph Mayne (MUST MATCH SIGNATURE ON APPLICATION)	
SITE SUPERVISOR (sign of driller or journeyman responsible for sitework if different from permittee)	

LOCATION OF WELL ON LOT	
SHOW PERMANENT STRUCTURE SUCH AS BUILDING, SEPTIC TANKS, AND/OR LANDMARKS AND INDICATE NOT LESS THAN TWO DISTANCES (MEASUREMENTS TO WELL)	
OEP USE ONLY (NOT TO BE FILLED IN BY DRILLER)	
☐ T	(E.R.O.S.)
☐ 70	☐ 72
TELESCOPE CASING	LOG INDICATOR
WQ ☐ 74 ☐ 75 ☐ 76 OTHER DATA	

Page 1 of 1
Date Feb 24, 1983

Review 4/11/83 OK PS.

FIELD DATA SHEET
HOWARD COUNTY WELL YIELD TEST

Well Permit No. HO - 73-4385
Location of property (road) Woodstock Rd.
Subdivision Tax map 9, Parcel 155 Lot — Block — Plat — Sec. —
Well Driller Ralph Mayne Owner L.A. Spittel

Depth of well 300 ft
Distance of measuring point (M.P.) above ground 12 ft
Static water level (S.W.L.) below M.P. 30 ft

I. High rate pumping -- reservoir drawdown

Time pump started 9:15 Pumping rate 9 G.P.M.
Total time 30 min to reach pumping water level 110 ft. below M.P.


II. Recovery pump test data - observations to be recorded every 15 minutes


TIME (in 15 minute intervals)	WATER LEVEL below M.P.	PUMPING RATE time to fill 6 gallon bucket	FLOW METER READING (if used)	CALCULATED FLOW (gallons per minute)
9:45	110 ft	55 sec	—	1 G.P.M. +
10:00	110 ft	55 sec	—	1 "
10:15	110 ft	55 sec	—	1 "
10:30	110 ft	55 sec	—	1 "
10:45	110 ft	55 sec	—	1 "
11:00	110 ft	55 sec	—	1 "
11:15	110 ft	55 sec	—	1 G.P.M. +
11:30	110 ft	55 sec	—	1 "
11:45	110 ft	55 sec	—	1 "
12:00	110 ft	55 sec	—	1 "
12:15	110 ft	55 sec	—	1 "
12:30	110 ft	55 sec	—	1 "
12:45	110 ft	55 sec	—	1 G.P.M. +
1:00	110 ft	55 sec	—	1 "
1:15	110 ft	55 sec	—	1 "
1:30	110 ft	55 sec	—	1 "
1:45	110 ft	55 sec	—	1 "
2:00	110 ft	55 sec	—	1 "
2:15	110 ft	55 sec	—	1 "
2:30	110 ft	55 sec	—	1 G.P.M. +
2:45	110 ft	55 sec	—	1 "
3:00	110 ft	55 sec	—	1 "
3:15	110 ft	55 sec	—	1 "
3:30	110 ft	55 sec	—	1 "
3:45	110 ft	55 sec	—	1 G.P.M. +

2/1/83

Well Site OK

S. 22° 06' 08" W.

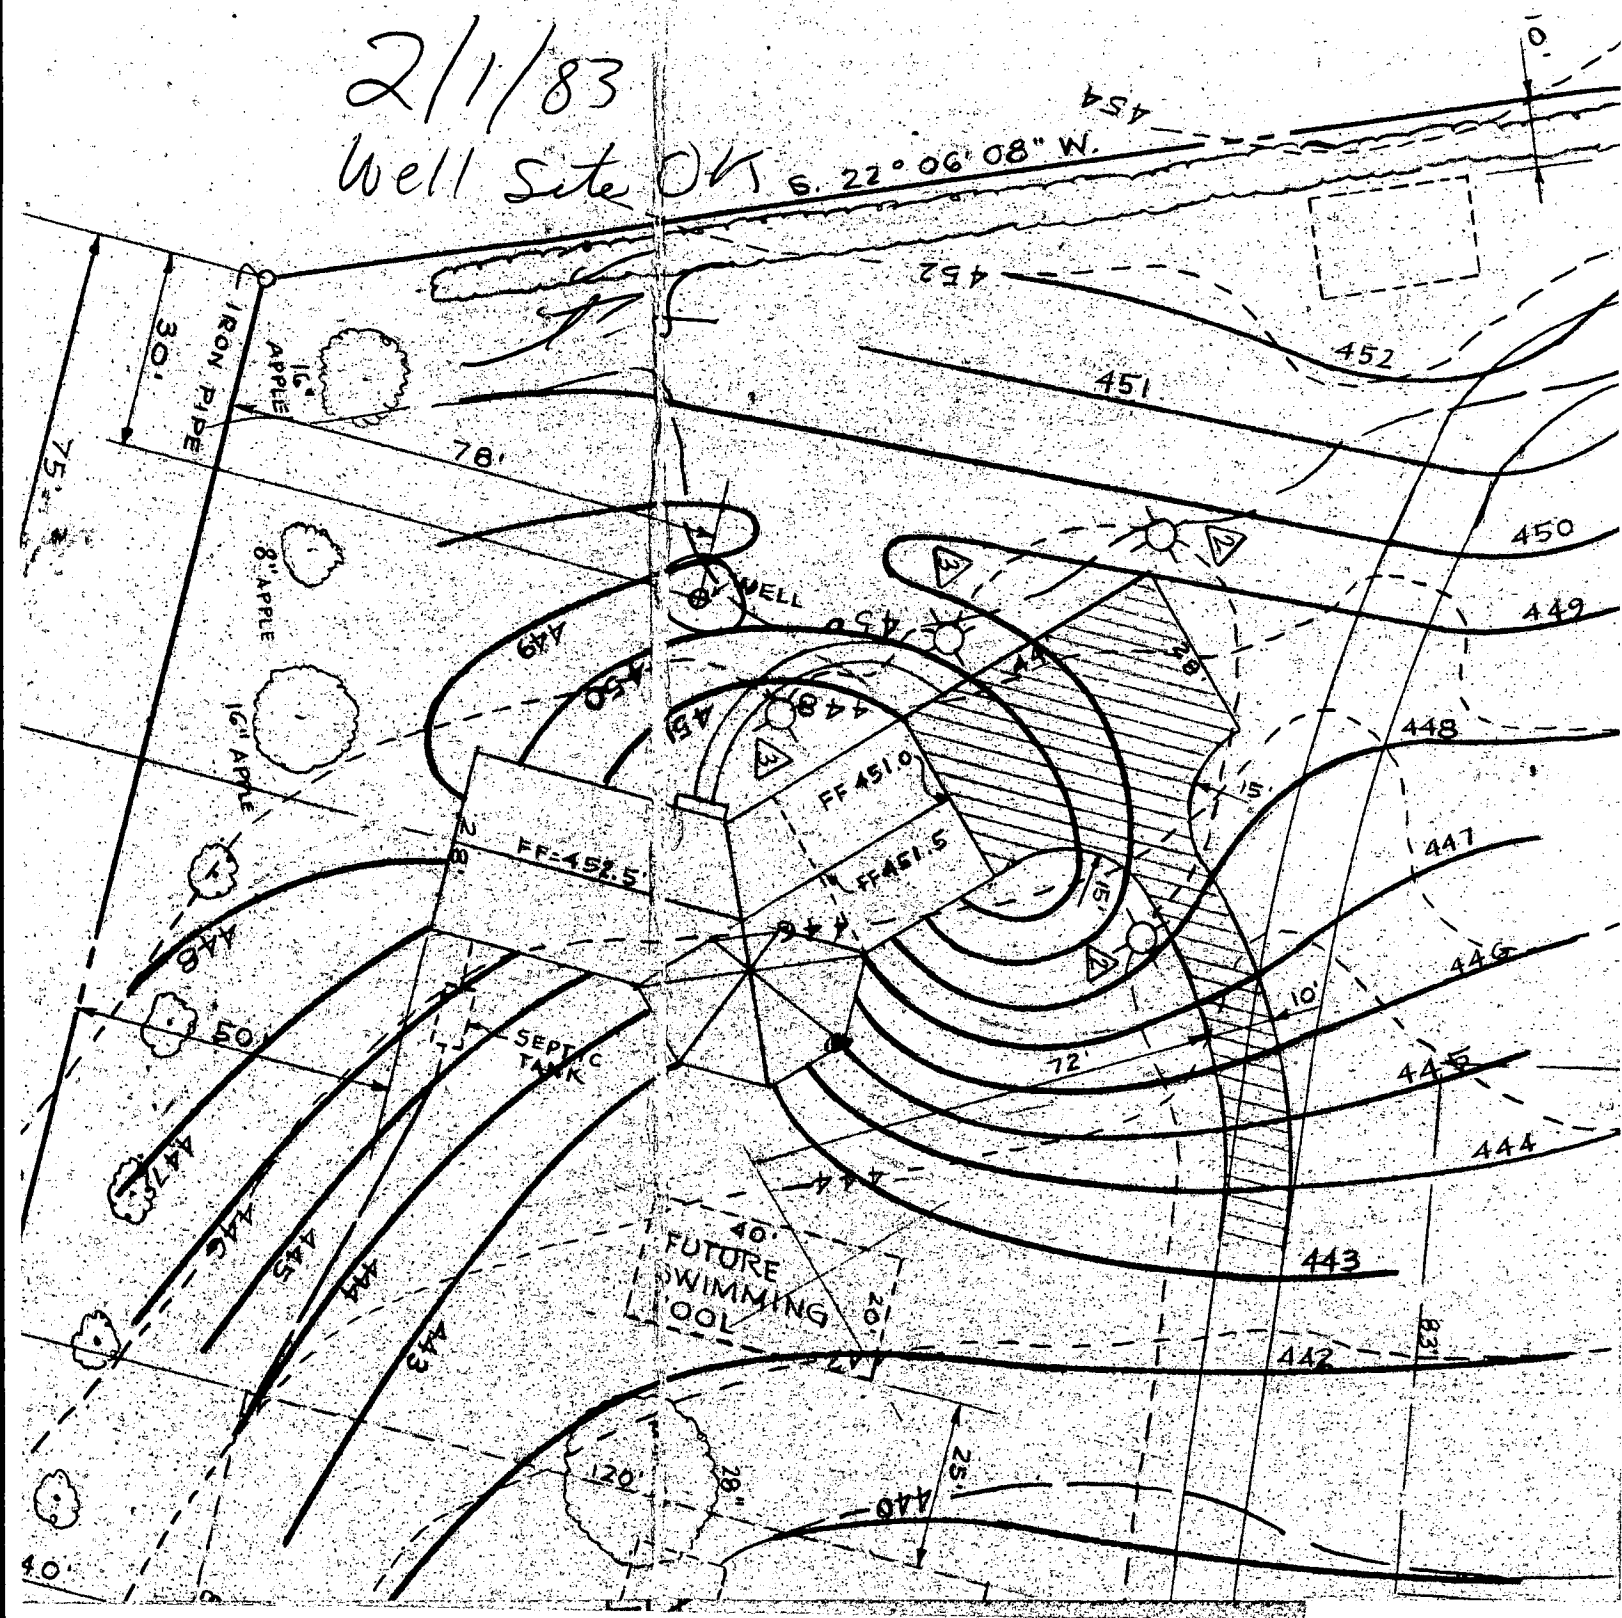

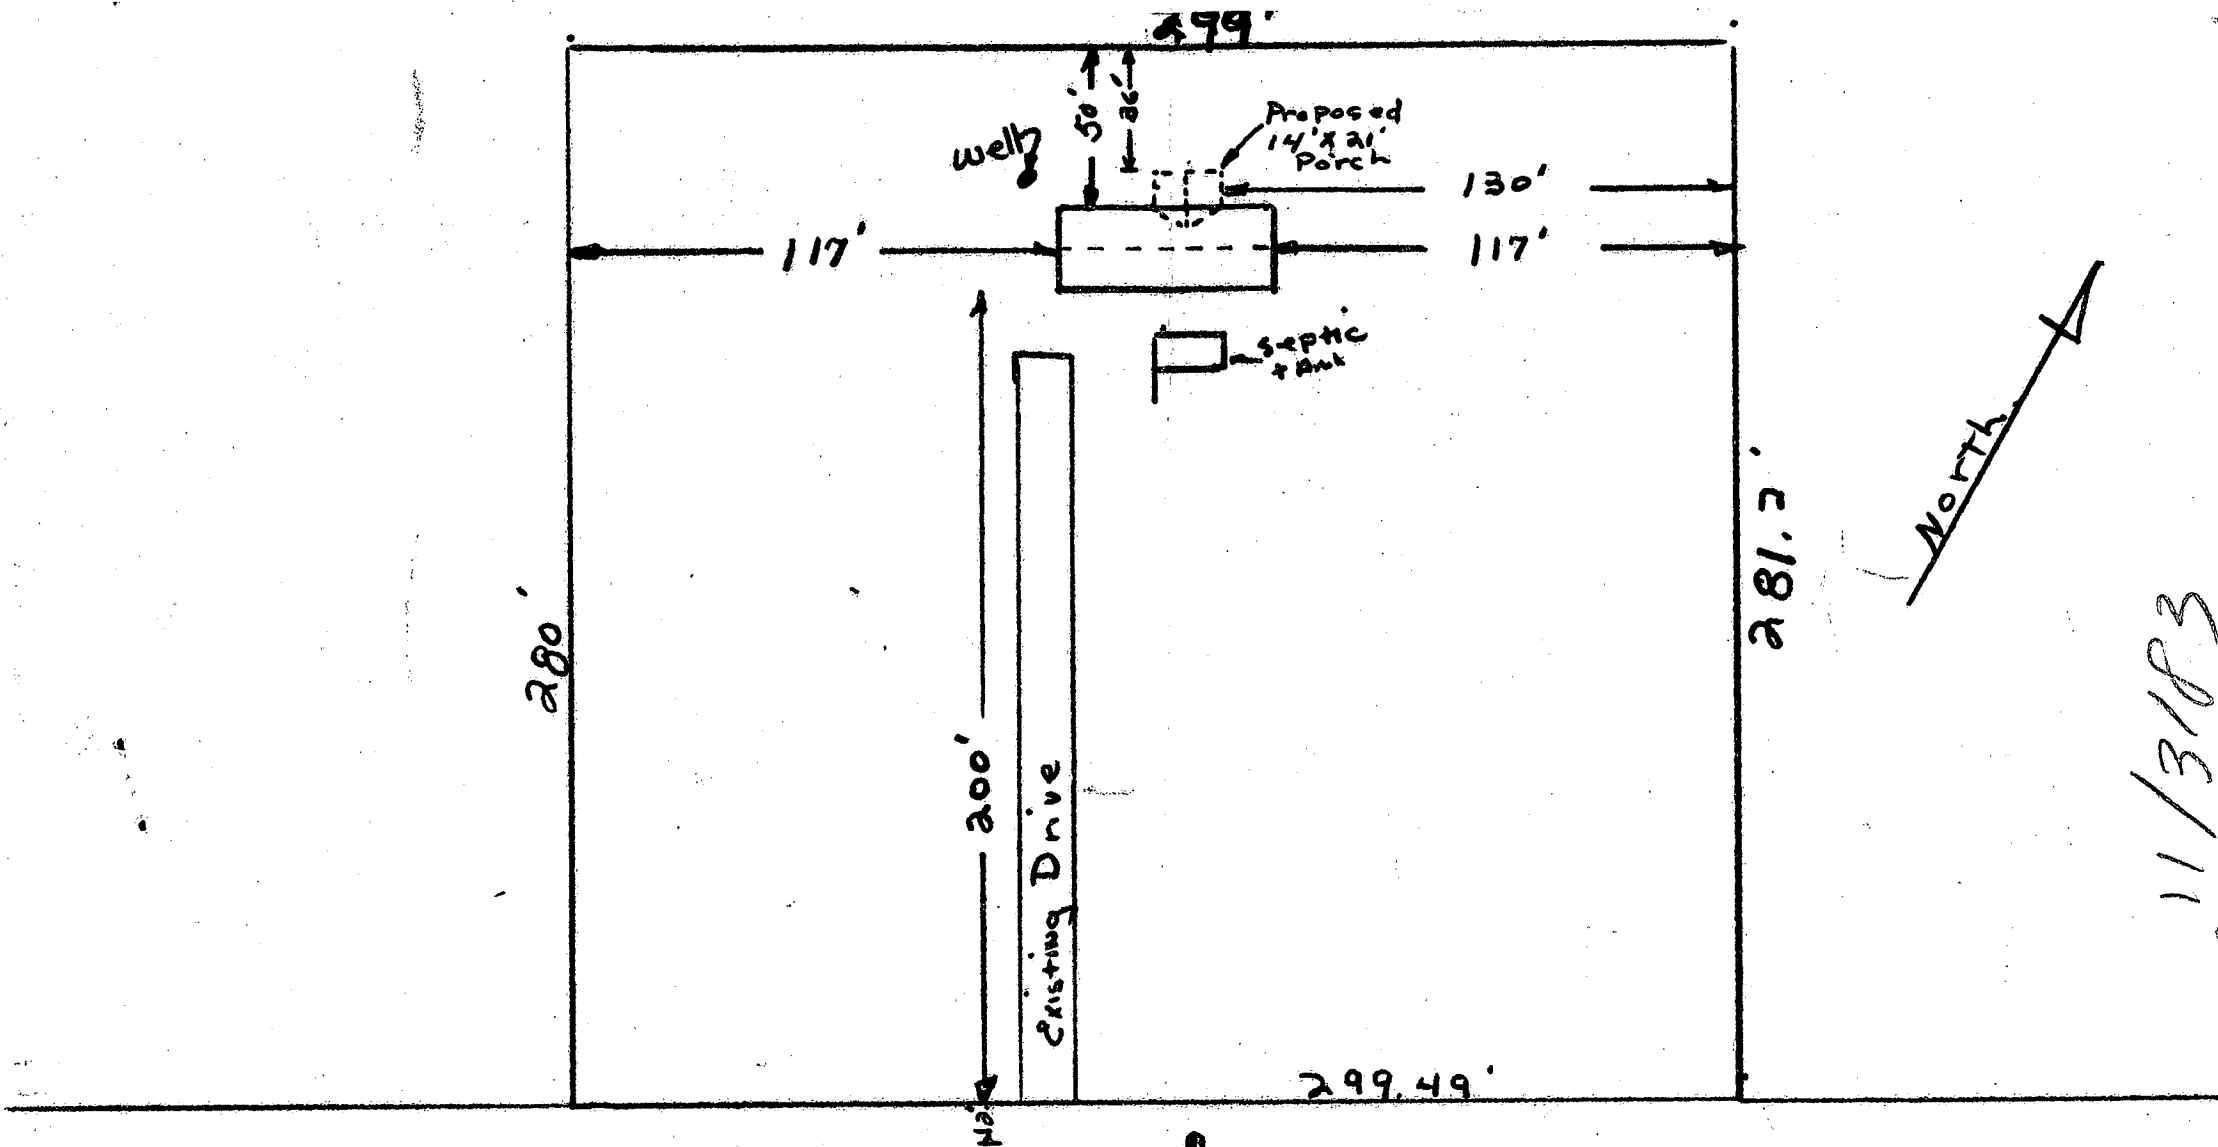

Woodstock Rd


scale 1" = 50'
 3rd Election Dist.
 Not in Sub division
 No building within 200'

owner: Richard McNicholas
 1900 Woodstock Rd.
 21163

contractor: Potts const. Co.
 744-837

11/3/83

no sewage no problem
 OK to begin PTH

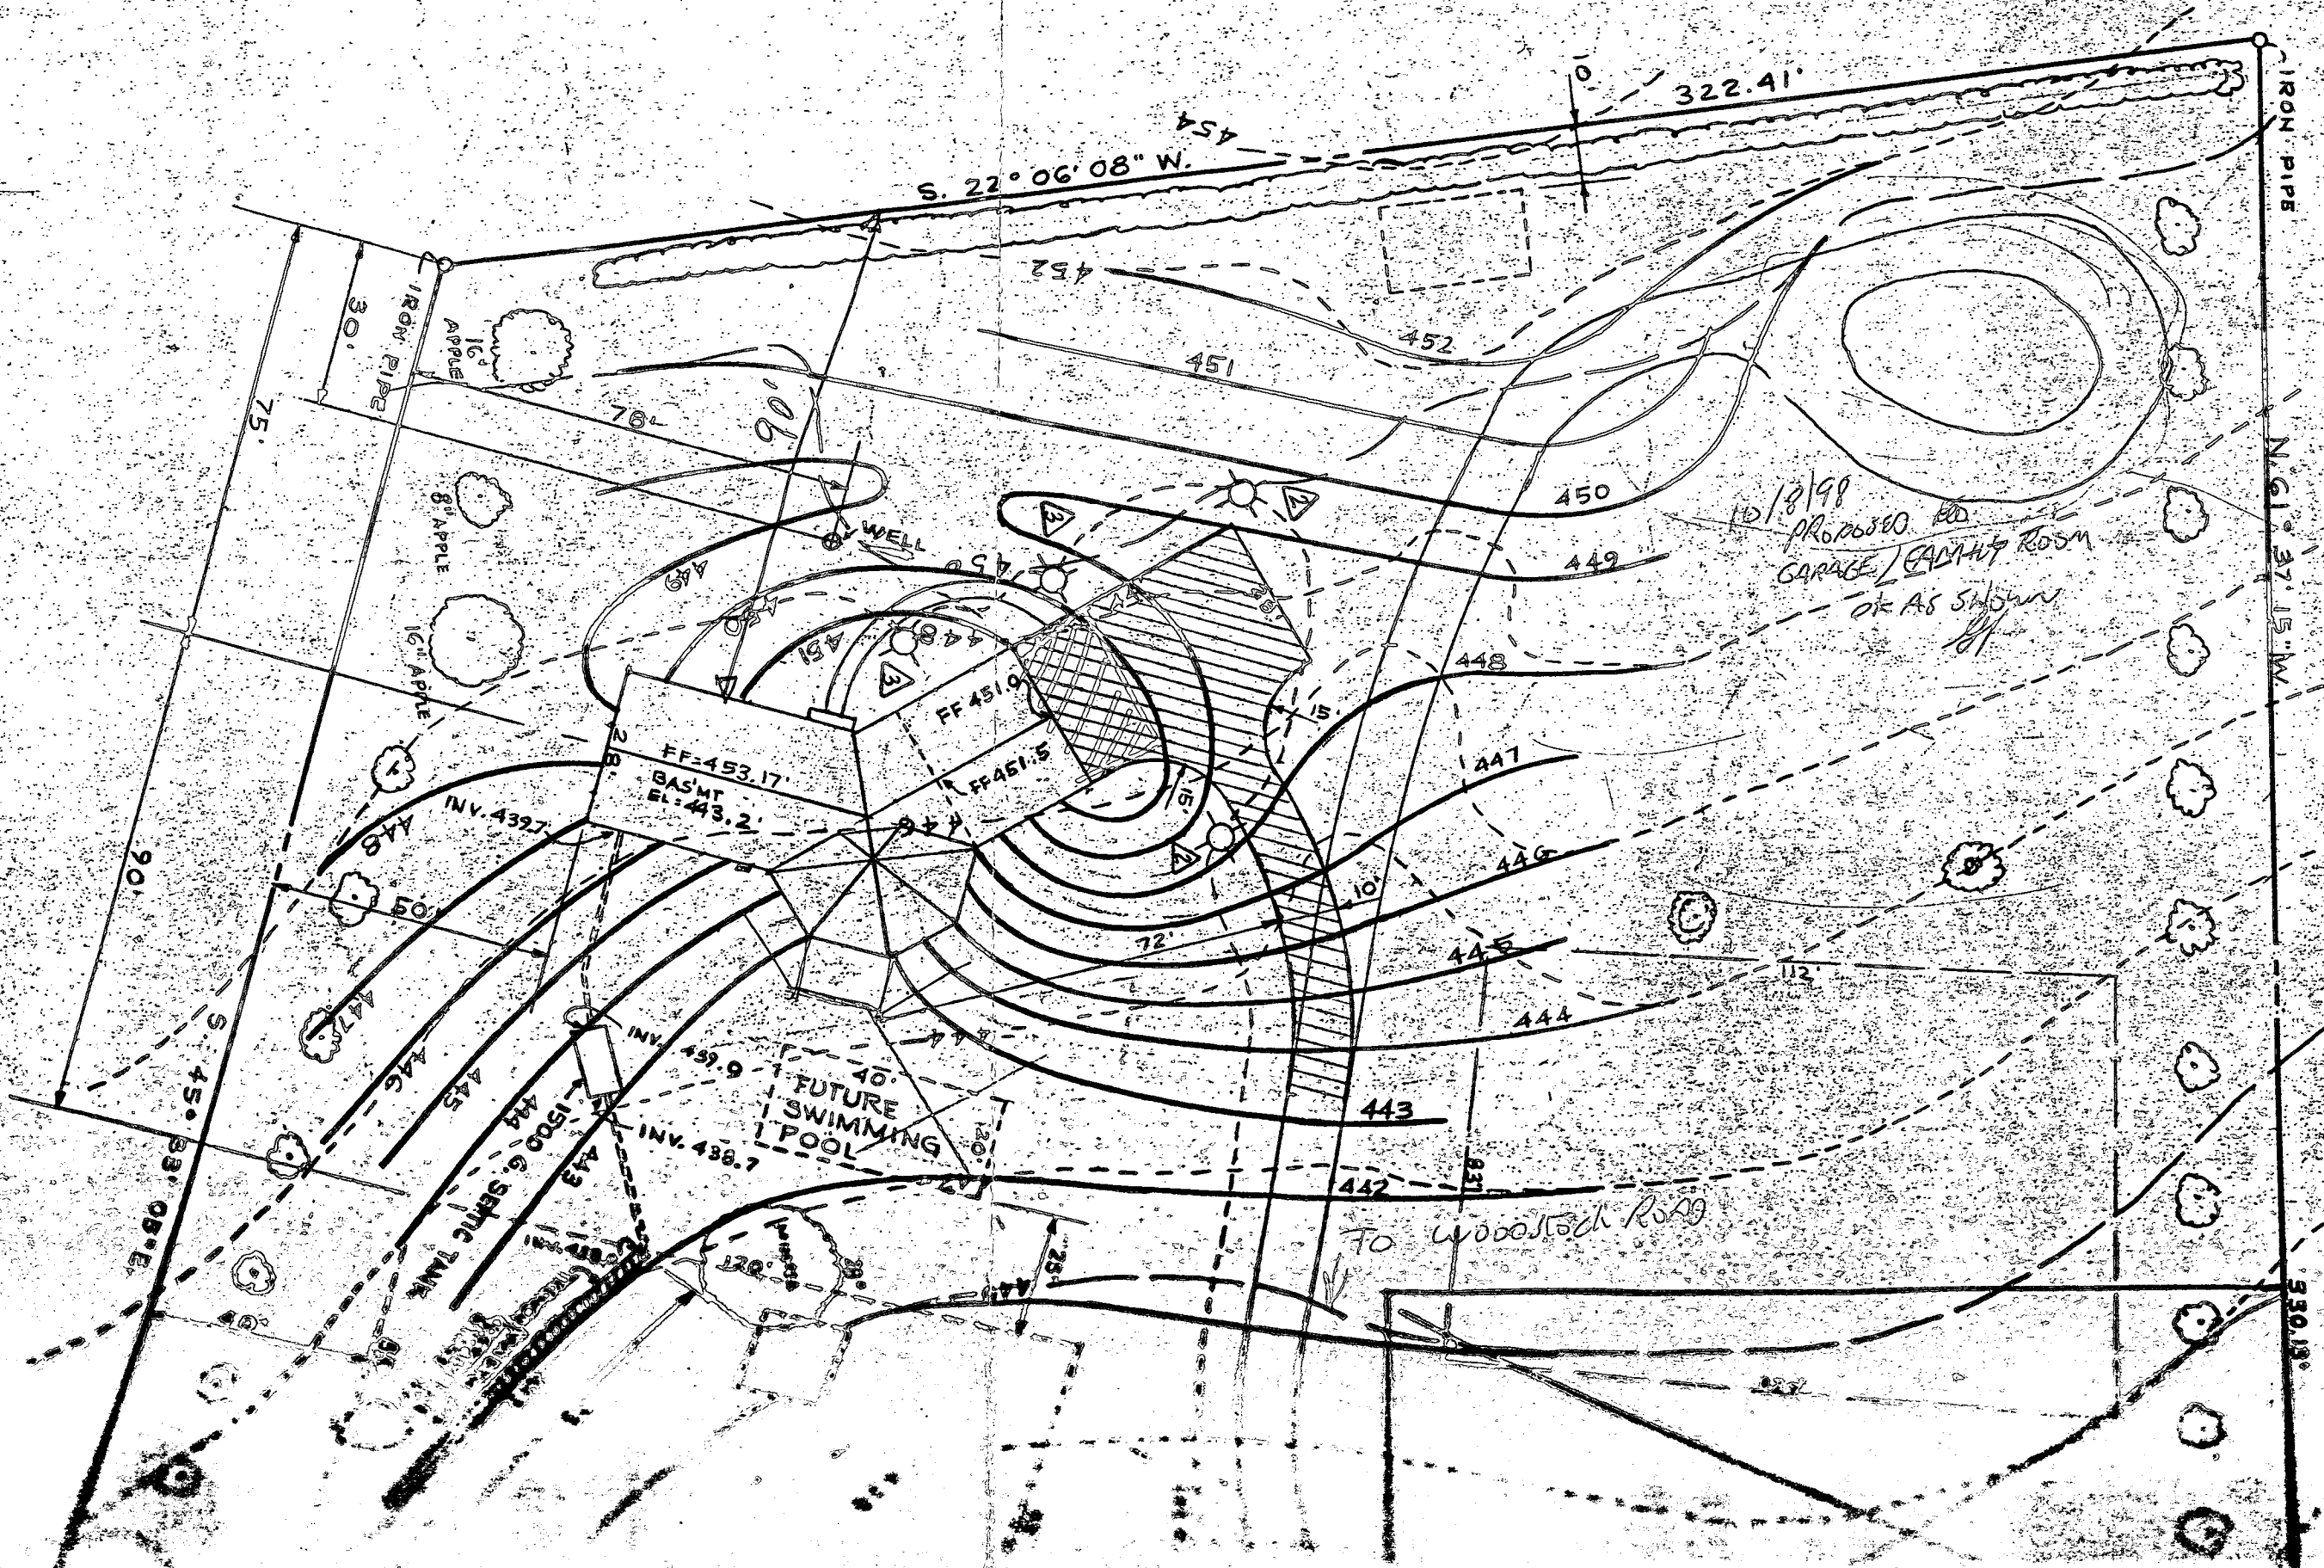

POOL ELEVATION:

DIRECTIONS:

I-695 (NORTH) TO I-70 (WEST), CONTINUE OF ROUTE 29
(NORTH) & FOLLOW TO END, TURN LEFT; ROUTE 99,
CONTINUE APPROX. 4.5 MILES TO WOODSTOCK RD
& TURN RIGHT. SITE ON LEFT 1920
WOODSTOCK RD.

NOTE:


VACUUM BREAKER WILL BE
INSTALLED AS PER CODE,

3.684 ACRES

SITE PLAN

SCALE: 1"=30'

1920 WOODSTOCK RD.
HOWARD COUNTY, MD. 21763
3RD ELECTION DISTRICT

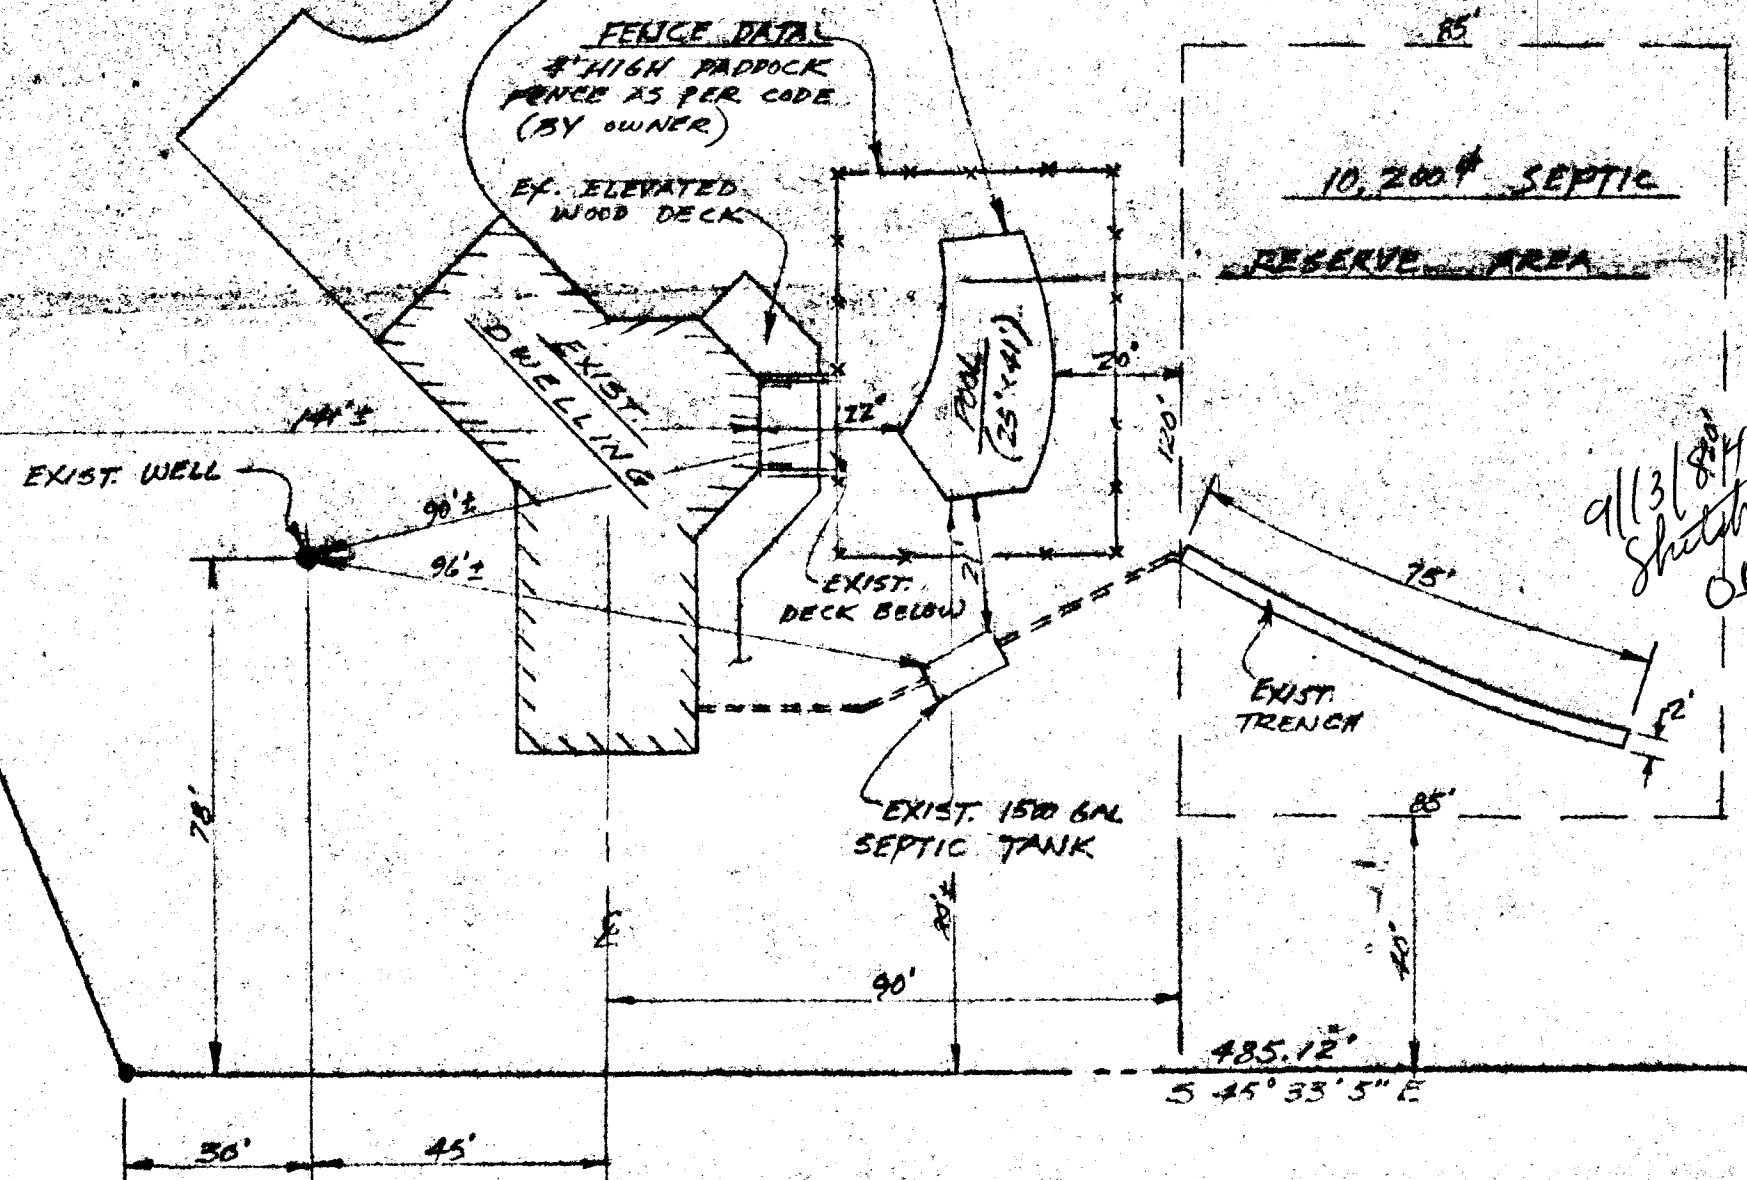

9/13/84
Sketch for Pool
ON P.S.