

11/5/84 Appl. 7.2

11/5/84
H.H. 11/1/84
Approved
Hoot
10 would be better

PERMIT

SEWAGE DISPOSAL SYSTEM

MARYLAND STATE DEPARTMENT OF HEALTH

P 34468

A 32456

HOWARD COUNTY
BUREAU OF ENVIRONMENTAL HEALTH
992-2330

ELLICOTT CITY
DISTRICT 5th

INDEXED

DATE 10/15/84

Charlie Green IS PERMITTED TO INSTALL X ALTER

ADDRESS _____ PHONE 795-6099

SUBDIVISION _____ ROAD 13041 Triadelphia Mill LOT Parcel 176, Tap Map 34

PROPERTY OWNER E. Alexander Adams MR & MRS TOM JOVER (JONES?)
2906 Ramblewood Road

ADDRESS Ellicott City, Maryland 21043

IF GARBAGE GRINDER IS USED INCREASE SEPTIC TANK CAPACITY BY 50% AND ABSORPTION AREA BY 22%.

GARBAGE GRINDER? YES _____ NO X

SEPTIC TANK CAPACITY 1250 GALLONS NUMBER OF BEDROOMS 4

TRENCHES - 180 sq. ft per bedroom - bottom area of leaching bed. Trench to be 5-7 feet wide. Inlet 5-6 feet below original grade. Bottom maximum depth 8 feet below original grade. Effective area begins at 5 feet below original grade. 2 feet of stone below distribution pipe. LOCATION: Start the trench about 30 feet behind the house. Run trench diagonally off to left rear side of lot. Keep trench on level ground. If trench is 5 feet or more in width, 2 parallel sets of perforated pipe required in trench. No trench to exceed 100 feet in length. If more than one trench used, a distribution box is required. Call for inspection of trench before gravel is installed. Provide 6" - 8" diameter cleanout and cap to grade or above on septic tank.

PLANS APPROVED BY Frank Skinner DATE 10/9/84

COVER NO WORK UNTIL INSPECTED AND APPROVED.

NEITHER THE HOWARD COUNTY COUNCIL NOR THE HEALTH DEPARTMENT IS RESPONSIBLE FOR THE SUCCESSFUL OPERATION OF ANY SYSTEM.

NOTE: IF TRENCH IS USED CALL FOR INSPECTION BEFORE AND AFTER PLACING GRAVEL IN TRENCH.

NOTE: NO DRY WELL SHALL EXCEED 15 FOOT IN DIAMETER. NO ABSORPTION TRENCH TO EXCEED 100 FEET IN LENGTH.

NOTE: ALL PIPE FROM HOUSE TO SEPTIC TANK MUST BE CAST IRON OR SCHEDULE 40 PVC OR ABS.

PERMIT VOID AFTER THREE YEARS.


NOTE: INSTALL STAND PIPE ON SEPTIC TANK AND DRY WELL. STAND PIPES MUST BE 6 INCHES IN DIAMETER. CAST IRON, CONCRETE OR TERRA COTTA, OR PVC OR ABS ACCEPTED. IF TOP OF SEPTIC TANK IS DEEPER THAN 3 FEET MANHOLE TO GRADE REQUIRED.

*INSTALLER IS RESPONSIBLE FOR OBTAINING FINAL APROVAL ON THIS PERMIT

*CALL 992-2330 FOR INSPECTION OF SEPTIC SYSTEMS.

EH - 2-1082

A 32456

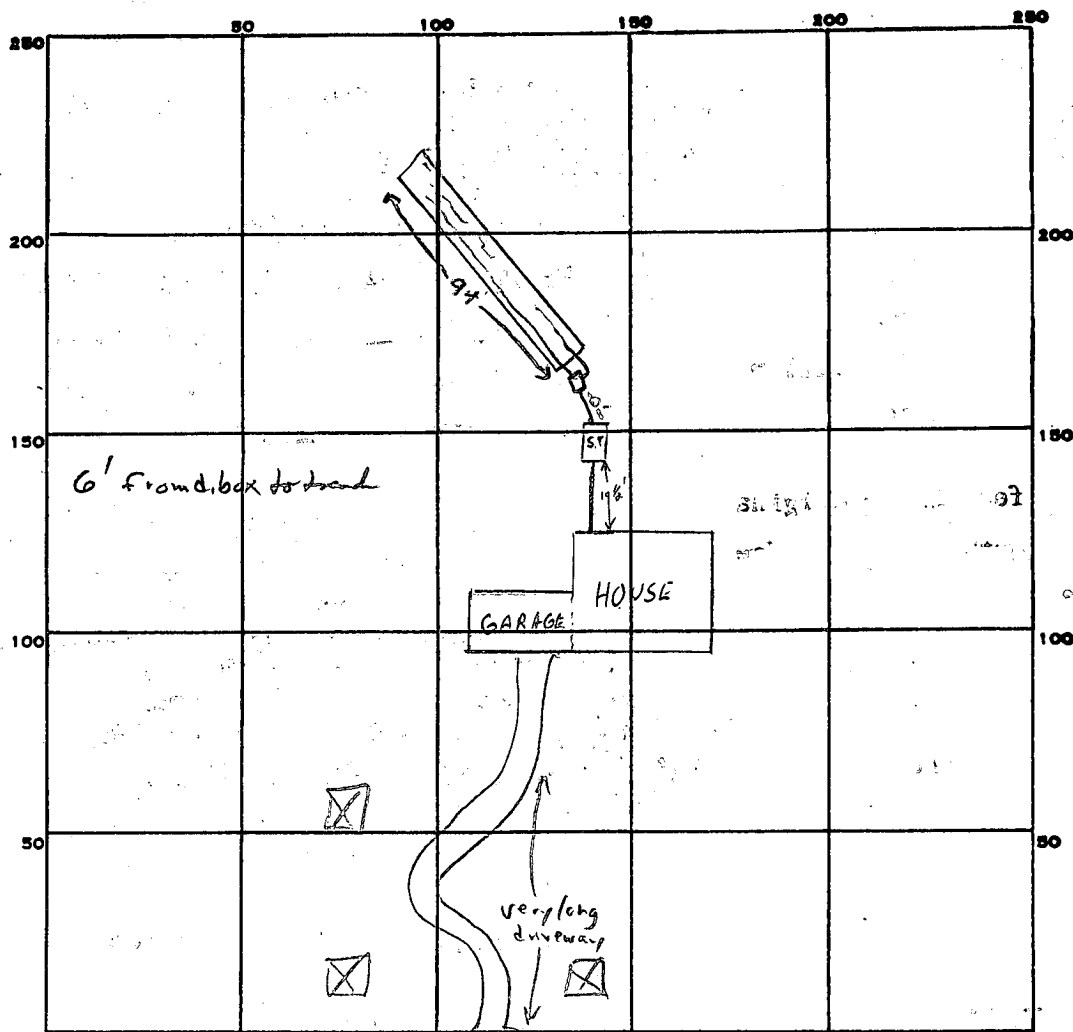

INDICATE NORTH. - NAME ADJOINING ROADWAY AS BASE LINE.

Triadelphia Mill Rd

PERMIT CARD ✓ signed OK F.S.

SEPTIC TANK, LEVEL ✓

CLEANOUTS S.T. no cap but C. Green will supply cap
see note

DISTRIBUTION BOX, LEVEL ✓

TILE FIELD, DEPTH 8 FT. TRENCH WIDTH 7 FT.

GRAVEL DEPTH 2 1/2 FT. TOTAL LENGTH 94 FT.

NUMBER OF TRENCHES 1 TOTAL BOTTOM AREA 658

94
7
658

SEEPAGE PITS, INSIDE DIAMETER — FT. DEPTH BELOW INLET 2 FT.

ABSORBENT AREA 658 SQ. FT.

REMARKS 11/2/84 O.K. to add stone and 2 distribution lines in trench. Install pipe from Septic tank
to distribution box & from box to trench. Cement pipes into & out of septic tank and distribution box.
O.K. to partially backfill some of trench, as rain predicted this weekend. Call for inspection before
completely backfilling trench, box, & tank. Spoke to Mr. Green @ Side J. Skinner
11/5/84 O.K. to cover all work

DATE SYSTEM APPROVED 11/5/84

INSPECTOR Frank Skinner

APPLICATION

SEWAGE DISPOSAL TESTING

STATE OF MARYLAND - DEPARTMENT OF HEALTH AND MENTAL HYGIENE

HOWARD COUNTY HEALTH DEPARTMENT
ENVIRONMENTAL HEALTH SERVICES

P. O. BOX 476 ELLICOTT CITY, MARYLAND 21043
TELEPHONE: 992-2330

DISTRICT 5th.

DATE 2/07/83

A 32456
P _____

TO: THE COUNTY HEALTH OFFICER
ELLICOTT CITY, MARYLAND

I, HEREBY, APPLY FOR THE NECESSARY TEST IN ORDER TO CONSTRUCT (OR RECONSTRUCT) A SEWAGE DISPOSAL SYSTEM.

PROPERTY OWNER: (Estate of Carrie Tyler) Contract Purchaser - E. Alexander Adams
2906 Ramblewood Road, Ellicott City, Md. HOME: 461-9636
ADDRESS _____ PHONE WORK: 465-5300

PROPERTY LOCATION:

SUBDIVISION Triadelphia Mill Road Parcel 176, Tax Map 34 LOT NO. _____

ROAD AND DESCRIPTION Rt. 108 to Clarksville, Right on Ten Oaks Road, left on Triadelphia Mill Road, 1/4 mil to 13049 Turn in there - go all the way back until the road dead ends.

SIZE OF LOT 12.542 Acres TYPE BLDG. 3-6r 4 Bedrooms
(NUMBER OF BEDROOMS)

THE SYSTEM INSTALLED UNDER THIS APPLICATION IS ACCEPTABLE ONLY UNTIL PUBLIC FACILITIES BECOME AVAILABLE. I FULLY UNDERSTAND THE FEE CONNECTED WITH THE FILING OF THIS PERC TEST APPLICATION IS NON-REFUNDABLE UNDER ANY CIRCUMSTANCES. I ALSO AGREE TO COMPLY WITH ALL M.O.S.H.A. REQUIREMENTS IN TESTING THIS LOT.

E. A. Adams
(SIGNATURE OF APPLICANT)

APPROVED BY _____ FOR _____ DATE _____

REJECTED BY _____ FOR _____ DATE _____

HOLD PENDING FURTHER TESTS _____ DATE _____


REASONS FOR REJECTION OR HOLDING _____

THIS IS NOT A PERMIT

SOIL PROFILE

0' REDDISH CLAY
3' GRAY SAND & SHALE

2' RED CLAY
4' GRAY HARD SAND SHALE
10 1/2' HARD

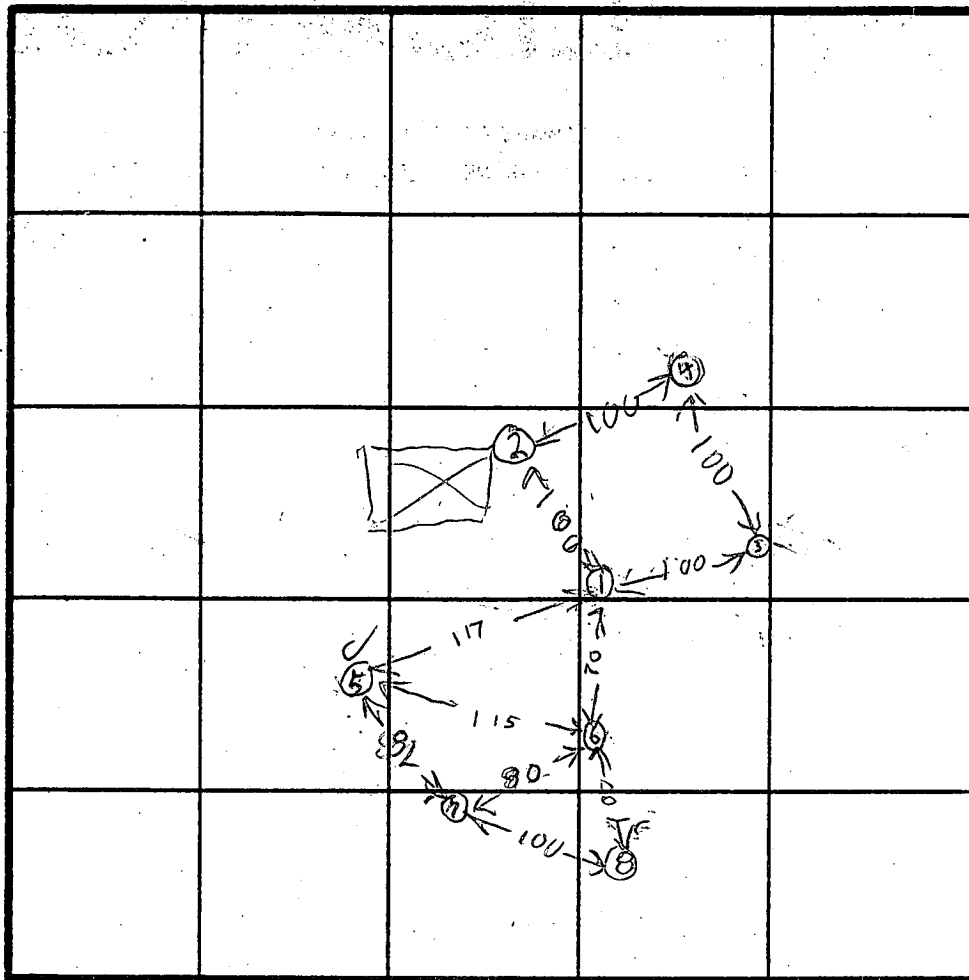

INDICATE NORTH - NAME ADJOINING ROADWAY AS BASE LINE.

RED CLAY
GRAY SAND & SHALE

CLAY
HARD GRAY SAND SHALE
EH 12-1079

DATE	TEST NO.	DEPTH	PRE-WET		TEST - 1" DROP		TIME
			START	STOP	START	STOP	
2/9/82	515 BP	4 8	200 200	204 206	204 206	209 220	5 14
	3V 80 85	11 9 4	Looks OK 211 217	OK 213 229	See profile 213 1st inch	219	6
	6V	11	Looks OK	OK	See profile		
	6M	5	230	243	243	254	11
	73 7D	5 8 1/2	325 327	335 355	335 355	354	9
	7V	12 1/2	Looks OK	Questionable	See Profile		
	8V	10 1/2	Looks OK	Unsatisfactory	See Profile		

2/9/82
REMARKS: ADAMS WANTS A NEW AREA NOT USING ANY OF OLD HOLES BECAUSE THE OLD HOLES WOULD BE TOO HIGH

TYPE OF SOIL

TESTED BY R HODGES

ALSO PRESENT

H SIRK & SON
A ADAMS

APPLICATION

SEWAGE DISPOSAL TESTING

STATE OF MARYLAND - DEPARTMENT OF HEALTH AND MENTAL HYGIENE

A 29721

P _____

HOWARD COUNTY HEALTH DEPARTMENT
ENVIRONMENTAL HEALTH SERVICES

P.O. BOX 476 ELLICOTT, MARYLAND 21043
TELEPHONE: 992-2330

DISTRICT ✓ 5

DATE ✓ 4-17-79

TO: THE COUNTY HEALTH OFFICER
ELLICOTT CITY, MARYLAND

I HEREBY APPLY FOR THE NECESSARY TEST IN ORDER TO CONSTRUCT (OR RECONSTRUCT) A SEWAGE DISPOSAL SYSTEM.

PROPERTY OWNER (Estate of Carrie Tyler) Contract Purchaser/Applicant E. Alexander + Betty Adams

ADDRESS ✓ 2906 Ramblewood Road, Elllicott City Md PHONE ✓ 465-5300 (Work)
461-8636 (Home)

PROPERTY LOCATION:

SUBDIVISION ✓ Parcel 176 Tax Map 34 LOT NO. ✓

ROAD AND DESCRIPTION direction Rt 108 to Clarksville, right on Ten Oaks Rd, left
on Philadelphia Mill Rd - 6th drive way on left adjacent to
left edge of chain lawn

SIZE OF LOT 12.542 Acres TYPE BLDG. ✓ Single Family - residential

THE SYSTEM INSTALLED UNDER THIS APPLICATION IS ACCEPTABLE ONLY UNTIL PUBLIC FACILITIES BECOME AVAILABLE.

I FULLY UNDERSTAND THE FEE CONNECTED WITH THE FILING OF THIS PERC TEST APPLICATION IS NON-REFUNDABLE UNDER

ANY CIRCUMSTANCES.

SIGNATURE OF APPLICANT ✓ E. Alexander Adams

APPROVED BY J. [Signature] FOR anywell DATE 5/4/79

REJECTED BY _____ FOR _____ DATE _____

HOLD PENDING FURTHER TESTS _____ DATE _____

REASONS FOR REJECTION OR HOLDING _____


THIS IS NOT A PERMIT

TRIADELPHIA MILL RD

SOIL PROFILE

0-5 ft
clay
5-14 ft
clay, sandy,
with some shale

4' - 11'
13 min
156 sq ft

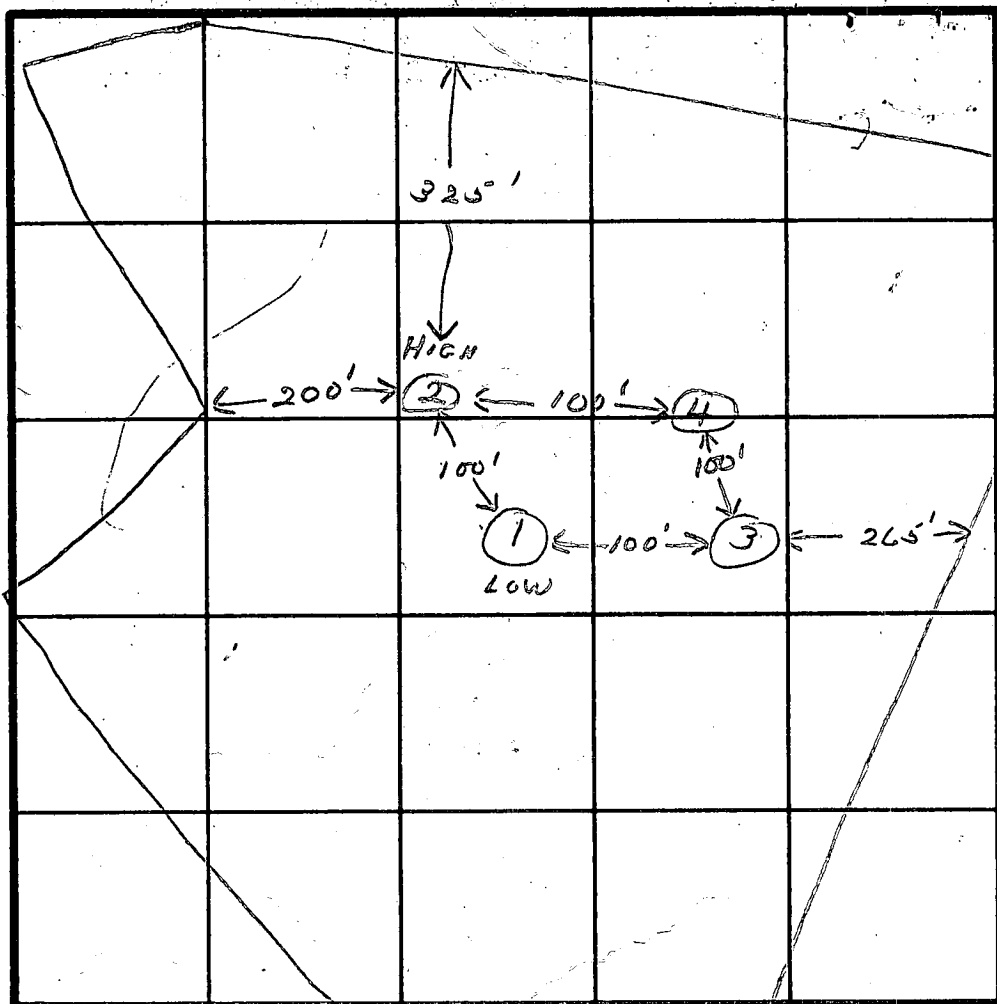

INDICATE NORTH NAME ADJOINING ROADWAY AS BASE LINE.

DATE	TEST NO.	DEPTH	PRE-WET		TEST - 1" DROP		TIME
			START	STOP	START	STOP	
5/3/79	15	5	10:11	10:20	10:20	10:41	21
	1D	14	10:12	10:20	10:20	10:42	22
	25	4	10:38	- 1/2" drop			failed
	2D	12	10:37	10:44	10:44	10:51	7
	35	4	11:18	11:23	11:23	11:31	8
	3D	13	11:23	11:36	11:36	11:46	10
	*25	4 1/2	11:04	11:06	11:06	11:14	8
	4	13	VISUAL				

REMARKS Lot in woods. Lowered shelf on #2

TYPE OF SOIL all holes consistent

TESTED BY *JS* ALSO PRESENT *H. Sub*


ADAMS FAMILY

WELL 102

100


I CERTIFY THE BELOW MEASUREMENTS AND ELEVATIONS ARE ACTUAL AND CORRECT FOR THIS PROPERTY.

CRAIG L STEWART ARCHITECT PA

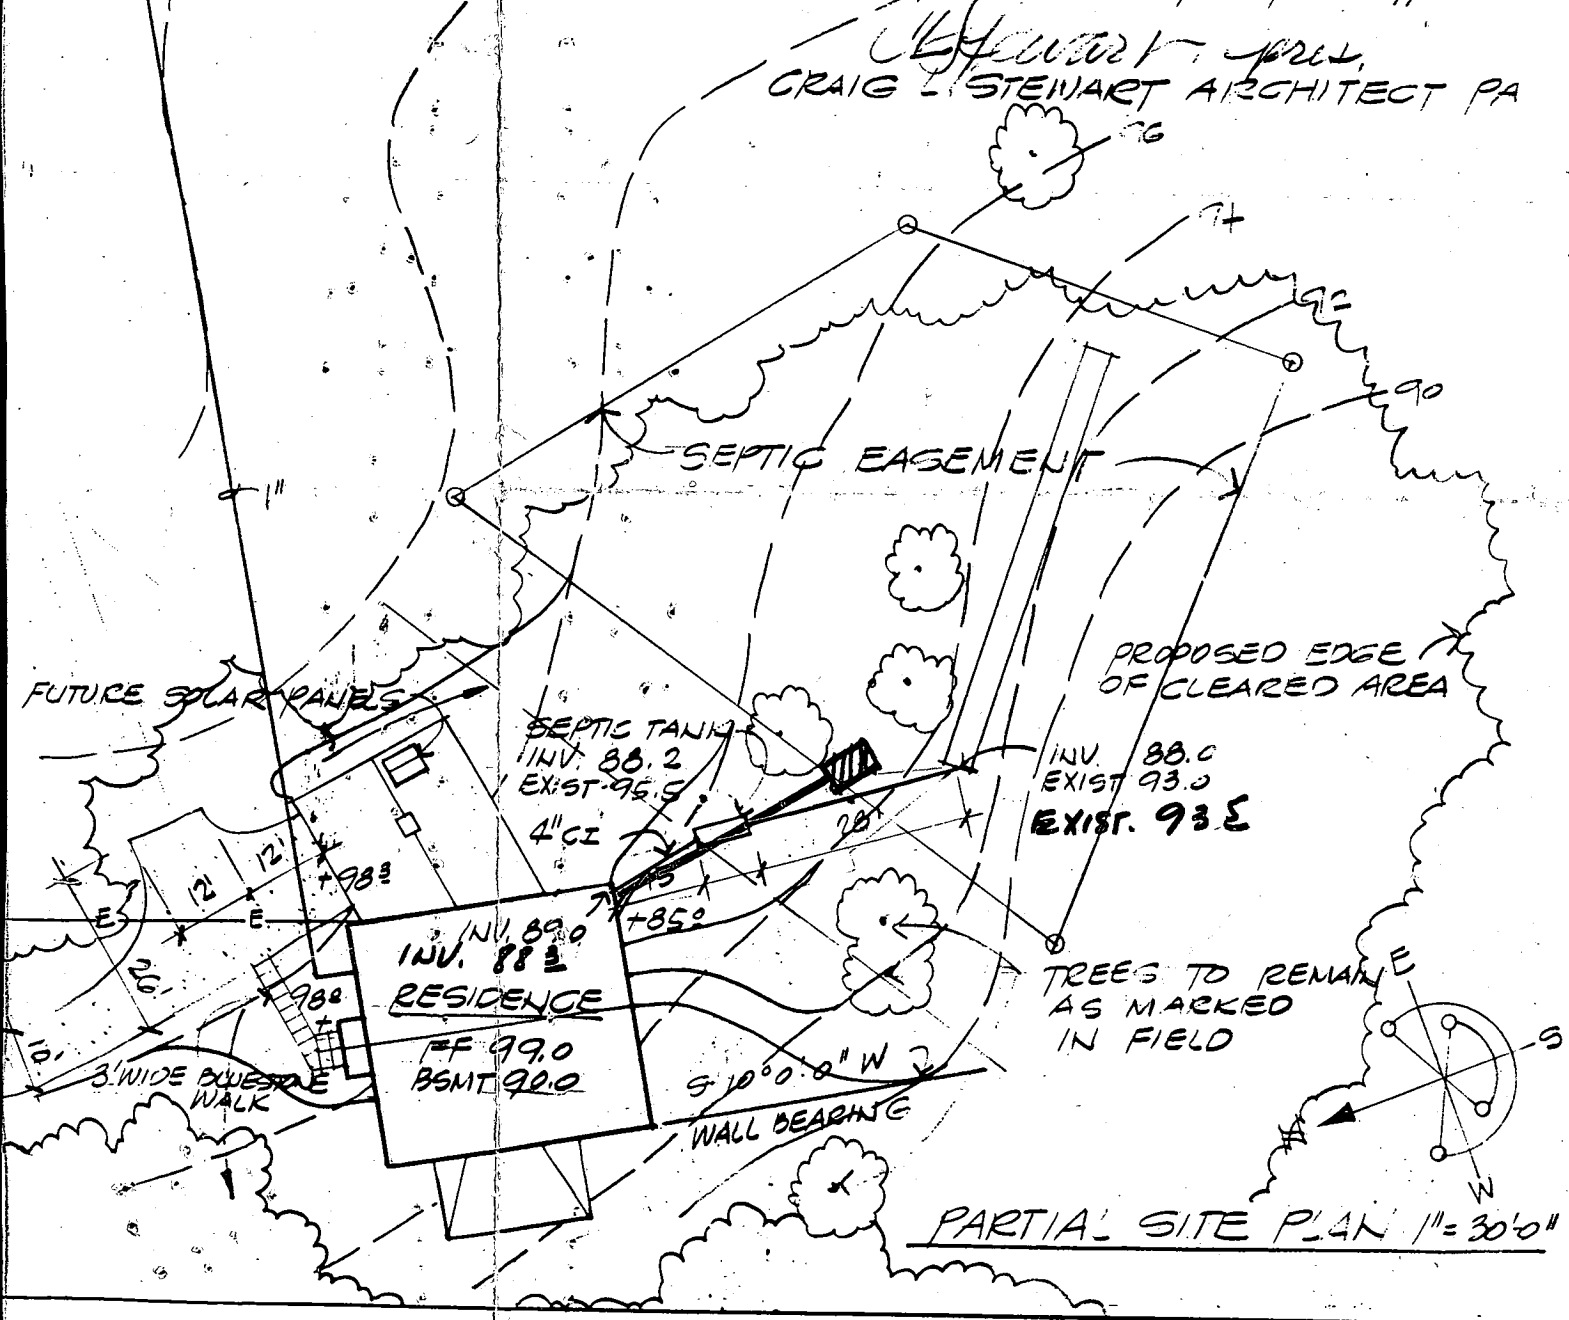

PARTIAL SITE PLAN 1"=30'0"

4" PVC FOR DRAIN

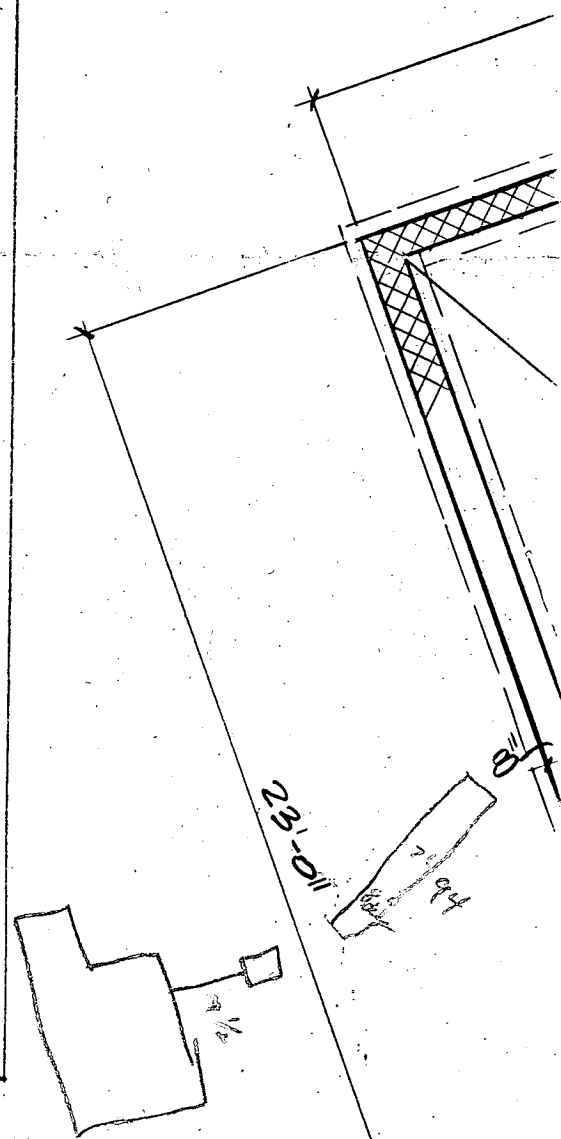

C 1 7684 SEQUENCE NO. (OEP USE ONLY)

(THIS NUMBER IS TO BE PUNCHED IN COLS. 3-5 ON ALL CARDS)

Date Received (OEP use only)

DATE WELL COMPLETED

070793

STATE OF MARYLAND
WELL COMPLETION REPORT
FILL IN THIS FORM COMPLETELY
PLEASE PRINT OR TYPE

THIS REPORT MUST BE SUBMITTED WITHIN 45 DAYS AFTER WELL IS COMPLETED.

COUNTY NUMBER

A 32456

PERMIT NO.

FROM "PERMIT TO DRILL WELL"

HO-81-0035

OWNER Adams last name Alex first name
STREET OR RFD Triadelphia Mill Road TOWN Clarksville
SUBDIVISION tax map 34: Parcel 176 SECTION LOTWELL LOG
Not required for driven wells
STATE THE KIND OF FORMATIONS PENETRATED, THEIR COLOR, DEPTH, THICKNESS AND IF WATER BEARING

DESCRIPTION (Use additional sheets if needed) FEET FROM TO Check if water bearing

Top Soil	0	2	
Sandy	2	11	
Sand Stone	11	30	✓
Mica	30	55	
Sand Stone	55	60	✓
Mica	60	200	

GROUTING RECORD
WELL HAS BEEN GROUTED (Circle Appropriate Box) YES ☒ Y NO ☒ N
TYPE OF GROUTING MATERIAL
CEMENT ☒ CM BENTONITE CLAY ☒ BC
NO. OF BAGS 5 NO. OF POUNDS 500
GALLONS OF WATER 30
DEPTH OF GROUT SEAL (to nearest foot) from 0 ft. to 20 ft. (enter 0 if from surface)CASING RECORD
casing types insert appropriate code below
STEEL ☒ ST CONCRETE ☒ CO
PLASTIC ☒ PL OTHER ☒ OTMAIN CASING TYPE
Nominal diameter (top/main) casing (nearest inch) 6
Total depth of main casing (nearest foot) 22

OTHER CASING (if used) diameter (nearest inch) depth (feet) from to

SCREEN RECORD
screen type or openhole insert appropriate code below
STEEL ☒ ST BRASS ☒ BR BRONZE ☒ HO OPEN HOLE
PLASTIC ☒ PL OTHER ☒ OTC 2 (seq. no.)
DEPTH (nearest ft.) 20 200
SLOT SIZE 1 2 3
DIAMETER OF SCREEN (NEAREST INCH) from toGRAVEL PACK
IF WELL DRILLED WAS FLOWING WELL CIRCLE BOX ☒ F
OEP USE ONLY (NOT TO BE FILLED IN BY DRILLER)T (E.R.O.S.)
TELESCOPE CASING LOG INDICATOR OTHER DATA

C 3 (seq. no.)

PUMPING TEST
HOURS PUMPED (nearest hour) 3

PUMPING RATE (gal. per min. to nearest gal.) 6

METHOD USED TO MEASURE PUMPING RATE Bucket

WATER LEVEL (distance from land surface) BEFORE PUMPING 16

WHEN PUMPING 200

TYPE OF PUMP USED (for test)

A air P piston T turbine

C centrifugal R rotary O other (describe below)

J jet S submersible

PUMP INSTALLED YES NO

DRILLER WILL INSTALL PUMP (CIRCLE APPROPRIATE BOX) ☒ Y ☒ N

IF DRILLER INSTALLS PUMP, THIS SECTION MUST BE COMPLETED FOR ALL WELLS EXCEPT HOME USE

TYPE OF PUMP (WRITE APPROPRIATE LETTER IN BOX - SEE ABOVE) (A, C, J, P, R, S, T, O)

CAPACITY GALLONS PER MINUTE (to nearest gallon) 31 35

PUMP HORSE POWER 27 41

PUMP COLUMN LENGTH (nearest ft.) 43 47

CASING HEIGHT (circle appropriate box and enter casing height)

LAND SURFACE

LOCATION OF WELL ON LOT

SHOW PERMANENT STRUCTURE SUCH AS BUILDING, SEPTIC TANKS, AND/OR LANDMARKS AND INDICATE NOT LESS THAN TWO DISTANCES (MEASUREMENTS TO WELL)

Diagram showing the location of the well on the lot. The well is located 100 feet from the road and 150 feet from the septic tank.

CIRCLE APPROPRIATE BOX
A A WELL WAS ABANDONED AND SEALED WHEN THIS WELL WAS COMPLETED
E ELECTRIC LOG OBTAINED
P TEST WELL CONVERTED TO PRODUCTION WELL

I HEREBY CERTIFY THAT THIS WELL HAS BEEN CONSTRUCTED IN ACCORDANCE WITH COMAR 10.17.13 "WELL CONSTRUCTION" AND IN CONFORMANCE WITH ALL CONDITIONS STATED IN THE ABOVE CAPTIONED PERMIT, AND THAT THE INFORMATION PRESENTED HEREIN IS ACCURATE AND COMPLETE TO THE BEST OF MY KNOWLEDGE.

DRILLERS IDENT NO. 223

DRILLERS SIGNATURE (MUST MATCH SIGNATURE ON APPLICATION)

SITE SUPERVISOR (sign of driller or journeyman responsible for sitework if different from permittee)

B 1	2323	SEQUENCE NO. (OEP USE ONLY) 7/8/83	STATE OF MARYLAND PERMIT TO DRILL WELL please print or type	OEP PERMIT NUMBER HO-81-0035 fill in this form completely
Date Received 0 3 0 4 8 3 (OEP Use Only)		LOCATION OF WELL		
OWNER INFORMATION		COUNTY Howard		
Last Name 15 ADAMS		SUBDIVISION tax map 34, parcel 176		
Owner 2906 ADAMS WOOD RD		SECTION NONE		
34 Name ELLICOTT CITY MD 21043		LOT 12.5 ACRES		
Street or RFD		NEAREST TOWN CLARKSVILLE		
Town 57		MILES FROM TOWN (enter 0 if in town) 2		
State		73 76 77 78		
76 Zip				
B 1 Continued		DRILLER INFORMATION		
Driller's Name Ralph Mayne		77 License No. 80 273		
Firm Name Rt. 3 Box 9120 Mt. Airy Md.				
Address Ralph Mayne 3/1/83				
Signature		Date		
B 2		WELL INFORMATION		
APPROX. PUMPING RATE (GAL. PER MIN.) 5				
AVERAGE DAILY QUANTITY NEEDED (GAL. PER DAY) 500				
USE FOR WATER (CIRCLE APPROPRIATE BOX)				
☒ HOME (SINGLE OR DOUBLE HOUSEHOLD UNIT ONLY) ☐ FARMING (LIVESTOCK WATERING & AGRICULTURAL IRRIGATION) ☐ INDUSTRIAL, COMMERCIAL, STATE AND FEDERAL GOV. OTHER (REQUIRES APPROPRIATION PERMIT) ☐ PUBLIC OR PRIVATE WATER COMPANY (REQUIRES APPROPRIATION PERMIT AND STATE HEALTH DEPARTMENT APPROVAL) ☐ TEST, OBSERVATION, MONITORING (MAY REQUIRE APPROPRIATION PERMIT)				
APPROXIMATE DEPTH OF WELL 150 FEET				
APPROXIMATE DIAMETER OF WELL 6 INCH				
METHOD OF DRILLING (circle one)				
BORED (OR AUGERED) JETTED JETTED & DRIVEN ☒ AIR ROTARY AIR PERCUSSION ROTARY (HYDRAULIC ROTARY) CABLE REVERSE ROTARY DRIVE POINT other _____				
REPLACEMENT OR DEEPEMED WELLS (CIRCLE APPROPRIATE BOX)				
☒ THIS WELL WILL NOT REPLACE AN EXISTING WELL ☐ THIS WELL WILL REPLACE A WELL THAT WILL BE ABANDONED AND SEALED ☐ THIS WELL WILL REPLACE A WELL THAT WILL BE USED AS A STANDBY ☐ THIS WELL WILL DEEPEM AN EXISTING WELL PERMIT NUMBER OF WELL TO BE REPLACED OR DEEPEMED (IF AVAILABLE) 41 _____				
Not to be filled in by driller (OEP USE ONLY)				
APPROX. PERMIT NUMBER 54 GAP 63				
FORCE ☒ AS WRITE INITIALS IN BOX PERMIT No. HO-81-0035				
B 5 SPECIAL CONDITIONS 8-63				

LOCATION OF WELL

DIRECTION OF WELL FROM TOWN (CIRCLE BOX)

ON WHICH SIDE OF ROAD (CIRCLE APPROPRIATE BOX)

NEAR WHAT ROAD
Tridelyia Mill Rd.

11 30

ON WHICH SIDE OF ROAD (CIRCLE APPROPRIATE BOX)

1400

34 37 38 39

SHOW MAJOR FEATURES OF BOX & LOCATE WELL WITH AN X

SOURCES OF DRILLING WATER

- well
-
-

WRITE THE BOX NUMBER FROM THE MAP HERE

E 800 9
N 500 1

22' - casing
2' - above gr
18' - open
5' - replacement

7/8/83

DRAW A SKETCH BELOW SHOWING LOCATION OF WELL IN RELATION TO NEARBY TOWNS AND ROADS AND GIVE DISTANCE FROM WELL TO NEAREST ROAD JUNCTION

N

Tridelyia Mill Rd.

well 1400'

Brighton Dam Rd.

CLARKSVILLE

B 4

NOT TO BE FILLED IN BY DRILLER HEALTH DEPARTMENT APPROVAL

HOWARD

COUNTY NAME

A32456

COUNTY NO.

OEP SIGNATURE

DATE ISSUED

43 48

CO SIGNATURE

43 48

NORTH GRID

50 55 57 63

EAST GRID

0800

EXPIRES

070483

Page 3 of
Date July 7, 1983

FIELD DATA SHEET
HOWARD COUNTY WELL YIELD TEST

Well Driller Roland Munn Owner Alex Adams

Depth of well 200'
Distance of measuring point (M.P.) above ground 2'
Static water level (S.W.L.) below M.P. 16'


Time pump started 10:30 Pumping rate 9 GPM
Total time 15 min to reach pumping water level 62 ft. below M.P.

[illegible]

WELL 106

I CERTIFY THE BELOW MEASUREMENTS AND ELEVATIONS ARE ACTUAL AND CORRECT FOR THIS PROPERTY.

1/24/00
CRAIG STEWART ARCHITECT

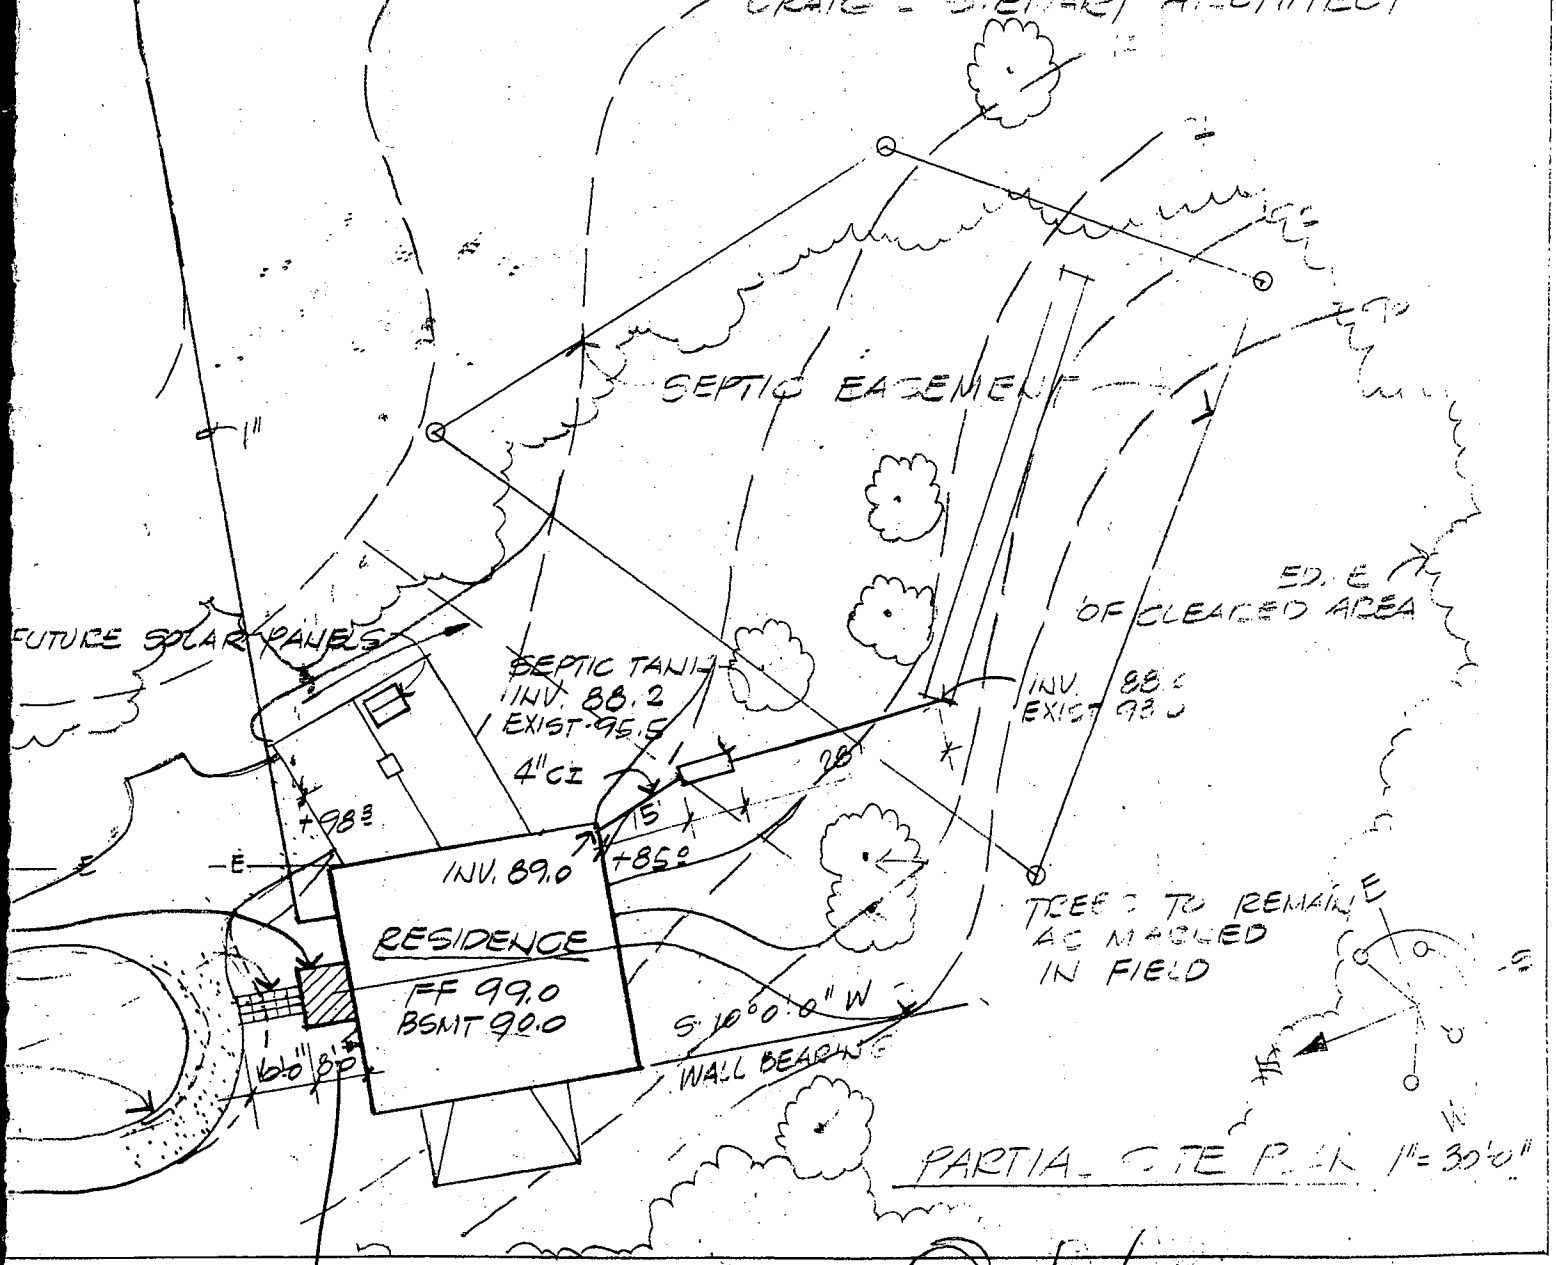

FOYER ADDITION OK (MK) 1/24/00

ELPHIA MILL RD - CLARKSVILLE MD

12-17-99

20756 - Real Estate Dept

DEPARTMENT OF INSPECTIONS, LICENSES AND PERMITS
3430 COURT HOUSE DRIVE
ELLICOTT CITY, MD 21043
PERMITS (410) 313-2455 INSPECTIONS (410) 313-1810
AUTOMATED INFORMATION (410) 313-3600

HOWARD COUNTY
PERMIT APPLICATION

PERMIT NUMBER
B00021845

Building Address 13041 Triadelphia Mill Rd
Clarksville Md 21019

Suite/Apt. #: N/A SDP/WP/Petition #: N/A

Census Tract 605101 Subdivision N/A

Section N/A Area N/A Lot N/A

Tax Map 37 Parcel 176 Grid 4

Zoning R2-DXO Map Coordinates 1406 Lot size

Property Owner's Name Mr & Mrs Tom Jover

Address 13041 Triadelphia Mill Rd

City Clarksville State Md Zip Code 21019

Home Phone 301-834-2986 Work Phone

Applicant's Name & Mailing Address, (if other than stated hereon):

Existing Use SFD

Proposed Use SFD

Estimated Construction Cost \$ 20,000

Description of Work New foyer

Contractor Company A+B LLC

Contact Person

Address

City State Zip Code

License No. Phone Fax

Occupant or Tenant Mr & Mrs Tom Jover

Contact Name Craig Stewart

Address 8329 Main St.

City Ellicott City State Md Zip Code 21043

Phone 410-465-7687 Fax

Engineer or Architect Company Stewart McQuinn

Contact Person Craig Stewart

Address 8329 Main St

City Ellicott City State Md Zip Code 21043

Phone 410-465-7687 Fax 410-465-7737

BUILDING DESCRIPTION - COMMERCIAL		BUILDING DESCRIPTION - RESIDENTIAL	
Building Characteristics	Utilities	Building Characteristics	Utilities
Height:	Water Supply: ☐ Public ☐ Private	SF Dwelling ☒ SF Townhouse ☐	Water Supply: ☐ Public ☒ Private
No. of stories:	Sewage Disposal: ☐ Public ☐ Private	1st floor: <u>8'</u> <u>11'4"</u>	Sewage Disposal: ☐ Public ☒ Private
Gross area, sq. ft. per floor:	Electric Yes ☐ No ☐	2nd floor: <u> </u>	Electric Yes ☒ No ☐
Use group:	Gas Yes ☐ No ☐	Basement: <u> </u>	Gas Yes ☐ No ☒
Construction type:	Heating System:	Finished Basement ☐ Unfinished Basement ☐	Heating System:
☐ Reinforced Concrete	Electric ☐ Oil ☐	Crawl space ☐ Slab on Grade ☒	Electric ☐ Oil ☐
☐ Structural Steel	Natural Gas ☐	No. of Bedrooms <u> </u>	Natural Gas ☐
☐ Masonry	Propane Gas ☐	Multi-family dwellings:	Propane Gas ☐
☐ Wood Frame	Sprinkler system: <u>N/A</u> ☐	No. of efficiency units: <u> </u>	Sprinkler system: <u>N/A</u> ☐
☐ State Certified Modular	☐ Full ☐ Partial ☐ Other Suppression ☐ # of Heads <u> </u>	No. of 1 BR units: <u> </u>	<u> </u> NFPA #13D
		No. of 2 BR units: <u> </u>	<u> </u> NFPA #13R
		No. of 3 BR units: <u> </u>	<u> </u> Other:
		Other Structure: <u> </u>	
		Dimensions: <u> </u>	
		Footings: <u> </u>	
		Roof: <u> </u>	
		☐ State Certified Modular	
		☐ Manufactured Home	

THE UNDERSIGNED HEREBY CERTIFIES AND AGREES AS FOLLOWS: (1) THAT HE/SHE IS AUTHORIZED TO MAKE THIS APPLICATION; (2) THAT THE INFORMATION IS CORRECT; (3) THAT HE/SHE WILL COMPLY WITH ALL REGULATIONS OF HOWARD COUNTY WHICH ARE APPLICABLE THEREON; (4) THAT HE/SHE WILL PERFORM NO WORK ON THE ABOVE REFERENCED PROPERTY NOT SPECIFICALLY DESCRIBED IN THIS APPLICATION; (5) THAT HE/SHE GRANTS COUNTY OFFICIALS THE RIGHT TO ENTER ONTO THIS PROPERTY FOR THE PURPOSE OF INSPECTING THE WORK PERMITTED AND POSTING NOTICES.

Applicant's Signature Craig Stewart AIA Print Name CRAIG L STEWART

Title/Company Architect Date 12-17-99

Checks payable to: DIRECTOR OF FINANCE OF HOWARD COUNTY
** PLEASE WRITE NEATLY AND LEGIBLY. **
- FOR OFFICE USE ONLY -

AGENCY	DATE	SIGNATURE APPROVAL	DEPT SETBACK INFORMATION	PROPERTY ID#
Land Development DPZ			Front: <u> </u>	Filing fee \$ <u>25</u>
State Highways			Rear: <u> </u>	Permit fee \$ <u> </u>
Building Official			Side: <u> </u>	Excise tax \$ <u> </u>
Dev Engineering DPZ			Side St: <u> </u>	Sub-total paid \$ <u> </u>
Health	<u>1/24/00</u>	<u>Mark E. Ripkin</u>	All minimum setbacks met? YES ☐ NO ☐	Add'l permit fee \$ <u> </u>
Fire Protection			Is Entrance Permit required? YES ☐ NO ☐	TOTAL FEES \$ <u> </u>
Is Sediment Control approval required prior to issuance? YES ☐ NO ☐			Historic District? YES ☐ NO ☐	Balance due \$ <u> </u>
CONTINGENCY CONSTRUCTION START			Lot Coverage for New Town Zone <u> </u>	Check # <u>1442</u>
ONE STOP SHOP: ☐			SDP/Red-line approval date <u> </u>	Validation # <u>26219</u>
Distribution of Copies			Accepted by <u> </u>	
White: Building Official				
Green: LDD, DPZ				
Yellow: DED, DPZ				
Pink: Health				
Gold: SHA				