

PERMIT

SEWAGE DISPOSAL SYSTEM

MARYLAND STATE DEPARTMENT OF HEALTH

HOWARD COUNTY

ELLICOTT CITY

DISTRICT _____

DATE 7/22/82

INDEX

Cecil Crenshaw

IS PERMITTED TO INSTALL _____ ALTER X

ADDRESS 5454 Waterloo Road, Columbia, Md.

PHONE 465-4774

SUBDIVISION _____

ROAD

6393 W. Rockburn Rd.

LOT _____

PROPERTY OWNER

Mr. Edward H. Morris

JAMES Z. KEFALOS

ADDRESS

6393 West Rockburn Hill, Elkridge, Md.

SPECIFICATIONS

SEPTIC TANK CAPACITY _____ GALLONS

DRAIN FIELD _____ DEPTH _____ FEET, BOTTOM AREA _____ SQ. FT.

DEEP TRENCH _____ DEPTH _____ FEET, BOTTOM AREA _____ SQ. FT.

SEEPAGE PITS _____ ABSORBENT SIDE-WALL AREA _____ SQ. FT.

INLET PIPE _____ FT. BELOW ORIGINAL GRADE, MAXIMUM DEPTH _____ FT. BELOW ORIGINAL GRADE

EFFECTIVE DEPTH AT _____ FT. BELOW ORIGINAL GRADE.

LOCATE DISPOSAL AREA _____ FT. FROM _____ LOT LINE AND _____ FT. FROM _____ LOT LINE AS SEEN WHEN
FACING LOT FROM _____

REPAIR - CALL FOR INSPECTION WHEN GROUND IS OPENED UP SO SANITARIAN CAN
RECOMMEND REPAIR.

REPAIR PERC RUN RECENTLY
ON ANOTHER SHEET

PLANS APPROVED BY

Palmer E. Wipe

DATE

July 12, 1982

COVER NO WORK UNTIL INSPECTED AND APPROVED

NEITHER THE HOWARD COUNTY COUNCIL NOR THE HEALTH DEPARTMENT IS RESPONSIBLE FOR THE SUCCESSFUL OPERATION OF ANY SYSTEM.

NOTE: IF TRENCH IS USED CALL FOR INSPECTION BEFORE PLACING GRAVEL IN TRENCH.

NOTE: NO DRY WELL SHALL EXCEED 15 FOOT IN DIAMETER.

NOTE: ALL PIPE FROM HOUSE TO DISPOSAL AREA MUST BE CAST IRON.

PERMIT VOID AFTER THREE YEARS.


NOTE: INSTALL STAND PIPE ON SEPTIC TANK AND DRY WELL. STAND PIPES MUST BE 6 INCHES IN DIAMETER, CAST IRON, CONCRETE OR TERRA
COTTA ACCEPTED.

*INSTALLER IS RESPONSIBLE FOR OBTAINING FINAL APPROVAL ON THIS PERMIT.

DEPT. PERMITS

AND RETURNED

6-19-88
Serial # 20112108
Large addition

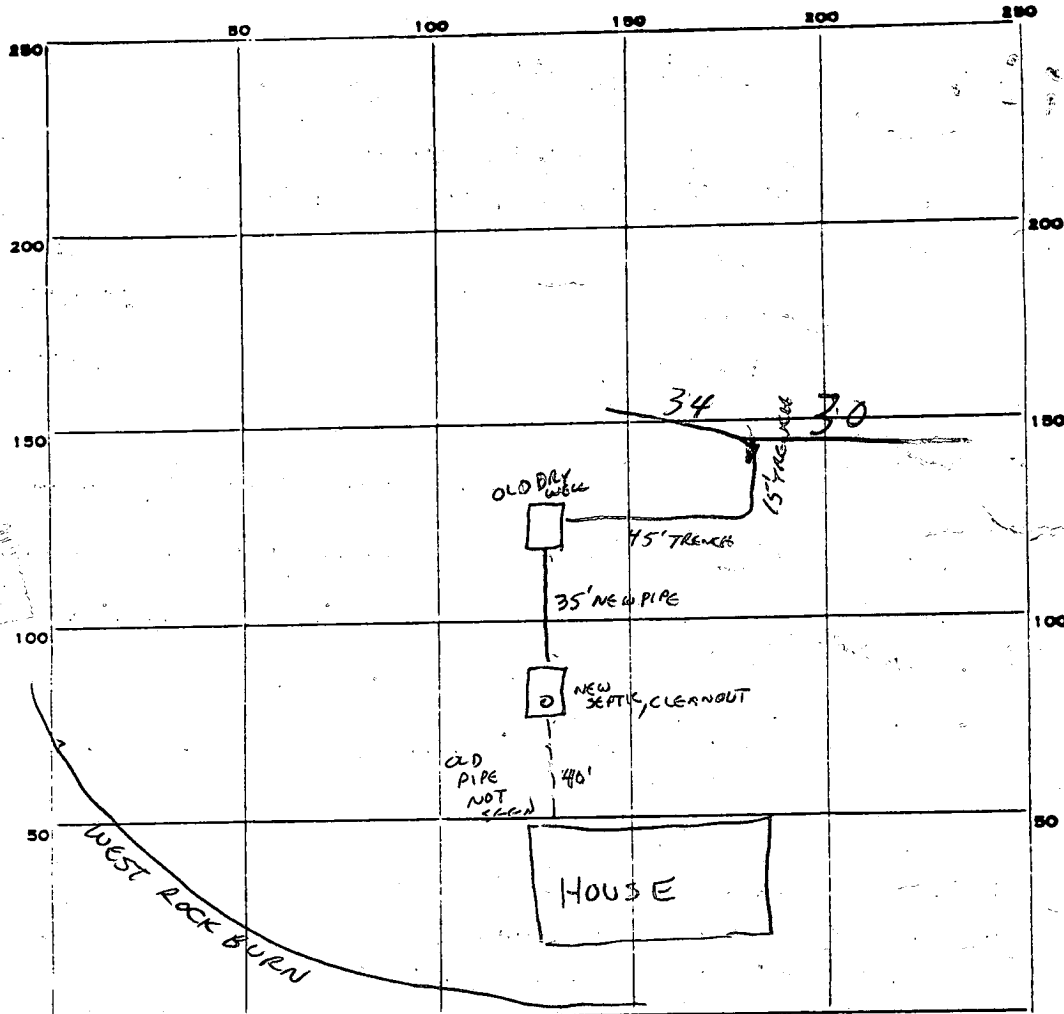

30
34
15
45
124
6
744

PERMIT CARD ✓

SEPTIC TANK, LEVEL ✓

CLEANOUTS ✓ ST OK

DISTRIBUTION BOX, LEVEL —

TILE FIELD, DEPTH 8 FT. TRENCH WIDTH 2 FT.

GRAVEL DEPTH 6 FT. TOTAL LENGTH 124 FT.

NUMBER OF TRENCHES 1 TOTAL ONESIDE BOTTOM AREA 744

SEEPAGE PITS, INSIDE DIAMETER — FT. DEPTH BELOW INLET — FT.

ABSORBENT AREA — SQ. FT.

REMARKS 7-23-82 AM - TANK & 3/4 TRENCH w/ GRAVEL SATISFACTORY.
CONTINUE w/ TRENCH AND PAPER, CW

7/26/82 230PM REST OF DITCH FINISHED RH

DATE SYSTEM APPROVED

7/24/82

INSPECTOR

Raymond Heger

Repair perc
6/24/82
9:30 A.M.

APPLICATION

7480

SEWAGE DISPOSAL TESTING

STATE OF MARYLAND - DEPARTMENT OF HEALTH AND MENTAL HYGIENE

HOWARD COUNTY HEALTH DEPARTMENT
ENVIRONMENTAL HEALTH SERVICES

P. O. BOX 473 ELLICOTT CITY, MARYLAND 21043
TELEPHONE: 992-2330

1000 GAL TANK

DEEP DITCH - 480 SQ FT

DISTRICT

DATE 6/22/82

ABSORBENT SIDEWALL AREA ON ONE SIDE

INLET TO DITCH TO BE 3 1/2 FT DEEP BOTTOM OF
DITCH TO BE 8 1/2 FT DEEP & DITCH IS TO BE FILLED
WITH 5 FT OF STONE DITCH TO BE 96 FT LONG
DITCH TO BE OFF OLD DRY WELL RUNNING

TO: THE COUNTY HEALTH OFFICER
ELLICOTT CITY, MARYLAND

NEAR PERC HOLE #3 TOWARD PERC

HOLE #2 & THEN TOWARD PERC HOLE #1

I HEREBY APPLY FOR THE NECESSARY TEST IN ORDER TO CONSTRUCT (OR RECONSTRUCT) A SEWAGE DISPOSAL SYSTEM

PROPERTY OWNER

Sappingtons - Tenants

Mr. Worthington - Attorney handling estate.

ADDRESS

6393 W. Rockburn Hill, Elkridge, Maryland 21227

PHONE

PERC HOLE #3 IS 20 FT FROM OLD

PROPERTY LOCATION

DRY WELL & 50 FT BEHIND THE HOUSE

SUBDIVISION

LOT NO.

ROAD AND DESCRIPTION

6393 W. Rockburn Hill

PERC HOLE #2 IS 40 FT FROM OLD DRY WELL
& 90 FT BEHIND THE HOUSE

SIZE OF LOT

(?)

TYPE BLDG.

Existing House 3

(NUMBER OF BEDROOMS)

PERC HOLE IS 48 FT FROM THE

OLD DRY WELL AND 54 FT FROM

THE SYSTEM INSTALLED UNDER THIS APPLICATION IS ACCEPTABLE ONLY UNTIL PUBLIC FACILITIES BECOME AVAILABLE. I FULLY UNDERSTAND THE

PERC HOLE #2

FEE CONNECTED WITH THE FILING OF THIS PERC TEST APPLICATION IS NON-REFUNDABLE UNDER ANY CIRCUMSTANCES. I ALSO AGREE TO COMPLY

WITH ALL M.O.S.H.A. REQUIREMENTS IN TESTING THIS LOT.

/s/ Cecil Crenshaw

(SIGNATURE OF APPLICANT)

APPROVED BY

FOR

DATE

REJECTED BY

FOR

DATE

HOLD PENDING FURTHER TESTS

DATE

REASONS FOR REJECTION OR HOLDING

THIS IS NOT A PERMIT

SOIL PROFILE

HOLE
ELEV.

①③ HIGH

② LOW

ST = OLD
TANK

17 W. OLD
DRY
WEL

INDICATE NORTH - NAME ADJOINING ROADWAY AS BASE LINE

[illegible]

REMARKS

OLD STEEL TANK TO BE REPLACED
WITH NEW CONCRETE TANK.

TYPE OF SOIL

TESTED BY

ALSO PRESENT

MISSAPPINGTON

C CRENshaw

OF 20' R/W TO "UTTER ROAD" (RESERVING UNTO TILTON H. DODDIN AND WIFE, HEIRS AND ASSIGNS THE RIGHT TO USE THE R/W IN COMMON WITH GRANTEES) FOR EGRESS AND ACCESS DEED REF: LIPER 181 FOLIO 142
NOTE: R/W ENDS AT INTERSECTION WITH 1/4" (S 37 1/2° E 1 P) LINE OF DEED LIPER H.S.K. 159 FOLIO 490. R/W CONTINUES TO ROCKBURN HILL ROAD BY 15' R/W GRANTED BY DEED LIPER 192 FOLIO 143

6' R/W TO ROCKBURN HILL ROAD DEED REF: LIPER 441 FOLIO 373
BEGIN LIPER 192 FOLIO 343 AT END OF 7 1/4" OR S 60 1/2° W 36.2 P LINE OF LIPER B.M. J.R. No. 181 FOLIO 142

NOTES

- 1) THIS PLAT CANNOT BE USED TO ESTABLISH PROPERTY LINES OR CORNERS
- 2) EXACT LOCATION OF IMPROVEMENTS AND PROPERTY LINES ARE SUBJECT TO THE RESULTS OF AN ACCURATE BOUNDARY SURVEY.
- 3) SUBJECT TO THE RIGHT TO DIVERT WATER FROM STREAM FOR PROPER WATER SUPPLY. ALSO, INGRESS AND EGRESS AT, IN, OVER OR UPON LAND ADJACENT FOR WATER SUPPLY. DEED REF. LIPER 80 FOLIO 272.
- 4) SUBJECT TO AGREEMENT WITH CONSOLIDATED GAS ELECTRIC LIGHT AND POWER COMPANY OF BALTIMORE. DEED REF: LIPER 169 FOLIO 191.
- 5) ENCUMBRANCE BY DEEDS: 22 22 A.C. (SAVING AND EXCEPTING TWO (2) 20' WIDE STRIPS DEED REFS: LIPER 77 FOLIO 406 LIPER 77 FOLIO 497.

TILTON H. DODDIN and WIFE
DEED REF: LIPER 181 FOLIO 142


(SAVE & EXCEPT)
LIPER 446 FOLIO 369
LIPER 441 FOLIO 373
SAC DC

9/19/85
BE signed after
fully discussing
H.S. concerns
w/owner. DGS

(SAVE & EXCEPT)
LIPER 464 FOLIO 240
1. S 18° 09' 08" E 44.05'
2. S 65° 39' 09" W 78.45'
3. N 23° 45' 36" E 36.86'
4. N 47° 30' 19" E 65.43'
0.03 AC

I HEREBY CERTIFY THAT I HAVE MADE A SURVEY OF THIS LOT FOR THE PURPOSE OF LOCATING THE IMPROVEMENTS THEREON AND THAT THEY ARE LOCATED AS SHOWN

REG NO T720

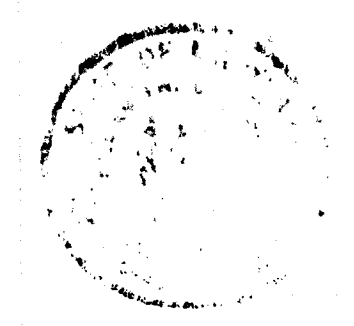

LOCATION SURVEY
PROPERTY OF THE ESTATE OF
EDWARD H. MORRIS
#6393 ROCKBURN HILL ROAD
HOWARD COUNTY, MD 1st ELECTION DIST.
SCALE 1"=60' DATE: JUN 16, 1984

PREPARED BY:
W.T. GADLER
SURVEYOR
307 MAIN STREET
REISTERSTOWN, MD 21136