

9/1/82

around noon please

PERMIT

SEWAGE DISPOSAL SYSTEM

MARYLAND STATE DEPARTMENT OF HEALTH

HOWARD COUNTY

ELLICOTT CITY

DISTRICT 2nd

DATE 8/26/82

03-281809

Full with

Lat 38 Septic System

INDEX

Jack Fyock

IS PERMITTED TO INSTALL ALTER X

ADDRESS 13775 Triadelphia Road, Glenelg, Md. 21737 PHONE 988-9270

SUBDIVISION Woodmark ROAD 12252 Yearling Court LOT 38 Bk. E. Sec. 9

PROPERTY OWNER Brenda and Richard Carter

ADDRESS 12252 Yearling Court, Ellicott City, Md. 21043 Phone: 988-9595

SPECIFICATIONS

SEPTIC TANK CAPACITY _____ GALLONS

DRAIN FIELD _____ DEPTH _____ FEET, BOTTOM AREA _____ SQ. FT.

DEEP TRENCH _____ DEPTH _____ FEET, BOTTOM AREA _____ SQ. FT.

SEEPAGE PITS _____ ABSORBENT SIDE-WALL AREA _____ SQ. FT.

INLET PIPE _____ FT. BELOW ORIGINAL GRADE. MAXIMUM DEPTH _____ FT. BELOW ORIGINAL GRADE

EFFECTIVE DEPTH AT _____ FT. BELOW ORIGINAL GRADE.

LOCATE DISPOSAL AREA _____ FT. FROM _____ LOT LINE AND _____ FT. FROM _____ LOT LINE AS SEEN WHEN
FACING LOT FROM

REPAIR - Moving septic tank to new location to accomodate addition that is to be
added onto house.

PLANS APPROVED BY Palmer F. Wine DATE 8/26/82

COVER NO WORK UNTIL INSPECTED AND APPROVED.

NEITHER THE HOWARD COUNTY COUNCIL NOR THE HEALTH DEPARTMENT IS RESPONSIBLE FOR THE SUCCESSFUL OPERATION OF ANY SYSTEM.

NOTE: IF TRENCH IS USED CALL FOR INSPECTION BEFORE PLACING GRAVEL IN TRENCH.

NOTE: NO DRY WELL SHALL EXCEED 15 FOOT IN DIAMETER.

NOTE: ALL PIPE FROM HOUSE TO DISPOSAL AREA MUST BE CAST IRON.

PERMIT VOID AFTER THREE YEARS.

NOTE: INSTALL STAND PIPE ON SEPTIC TANK AND DRY WELL. STAND PIPES MUST BE 6 INCHES IN DIAMETER. CAST IRON, CONCRETE OR TERRA
COTTA ACCEPTED.


*INSTALLER IS RESPONSIBLE FOR OBTAINING FINAL APPROVAL ON THIS PERMIT.

BLDG. PERMIT SIGNED
AND RETURNED 9/7/82

Serial No. 50903

Adding Bathroom.

HEAVY
PLASTIC
PIPE

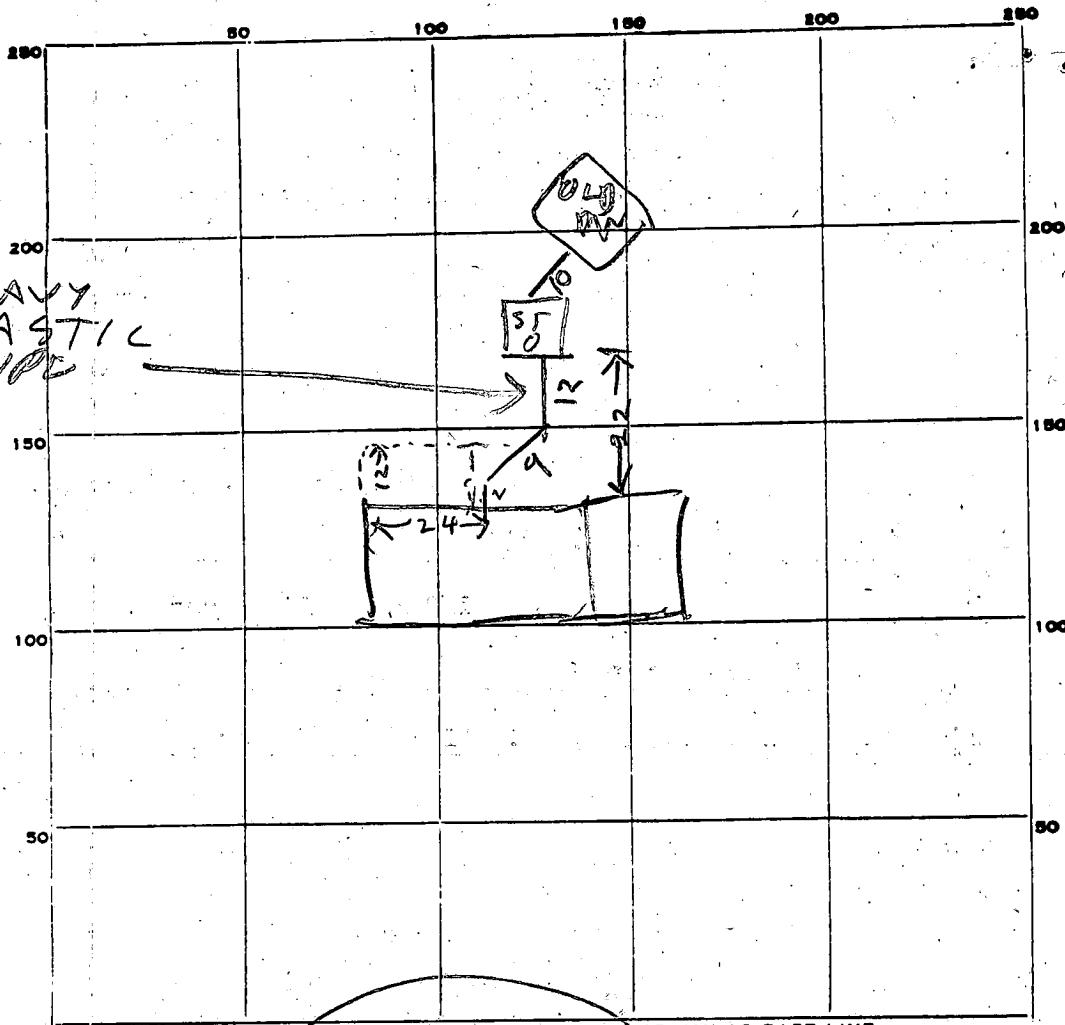

INDICATE NORTH. - NAME ADJOINING ROADWAY AS BASE LINE.

PERMIT CARD

YES

SEPTIC TANK, LEVEL

TOP 3 INCHES

CLEANOUTS

OK

DISTRIBUTION BOX, LEVEL

TILE FIELD, DEPTH

FT.

TRENCH WIDTH

FT.

GRAVEL DEPTH

IN.

TOTAL LENGTH

FT.

NUMBER OF TRENCHES

TOTAL BOTTOM AREA

SEEPAGE PITS, INSIDE DIAMETER

FT.

DEPTH BELOW INLET

FT.

ABSORBENT AREA

SQ. FT.

REMARKS

9/1/82

OLD CONCRETE TANK MOVED

TO PERMIT 12 FT BUILDING ADDITION

NEW LOCATION OF TANK WILL BE 10-12 FT

FROM NEW ADDITION OLD DW NOT

OVER FLOWING

DATE SYSTEM APPROVED

9/1/82

INSPECTOR

Raymond Stodge

B 1	1355	SEQUENCE NO. (WRA USE ONLY)	STATE OF MARYLAND WATER RESOURCES ADMINISTRATION TAWES STATE OFFICE BLDG., ANNAPOLIS, MARYLAND 21401 APPLICATION FOR PERMIT TO DRILL WELL	WRA PERMIT NUMBER 110-75-0597
1 2 3 (SEQ. NO.) 6 (THIS NUMBER IS TO BE PUNCHED IN COLS. 3-6 ON ALL CARDS)				FILL IN THIS FORM COMPLETELY

DATE RECEIVED (WRA USE ONLY) 1/25/74	OWNER Carter, Richard COL 15 LAST NAME	First Name Latter COL. 34
STREET OR RFD COL 36	COL. 55	
POST OFFICE COL 57	COL. 76	

B 1	CONTINUED	DRILLER INFORMATION
1 2 3 (SEQ. NO.) 6		
DATE 10-25-73	LICENSE NUMBER 4242	80
FIRST NAME J. P. Blum	DRILLER J. P. Blum	LAST NAME
SIGNATURE J. P. Blum		

B 3	LOCATION OF WELL	
1 2 3 (SEQ. NO.) 6		
COUNTY Howard	21	
SUBDIVISION Woodlands	42	
SECTION 9	LOT 38E	80
NEAREST TOWN Maryfield	71	
MILES FROM TOWN (ENTER 0 IF IN TOWN) 2	76 77 78	

B 2	WELL INFORMATION	
1 2 3 (SEQ. NO.) 6		
MAXIMUM PUMPING RATE (GALLONS PER MINUTE) 8	12	
AVERAGE DAILY QUANTITY NEEDED (GALLONS PER DAY) 1600	20	
USE FOR WATER (CIRCLE APPROPRIATE BOX)		
☒ HOME (SINGLE OR DOUBLE HOUSEHOLD UNIT ONLY)		
☐ FARMING, AGRICULTURE, IRRIGATION		
☐ INDUSTRIAL, COMMERCIAL, STATE AND FEDERAL GOVERNMENT.		
☐ MUNICIPAL WATER SUPPLY		
☐ PRIVATE WATER COMPANY		
☐ TEST		

B 4	DIRECTION FROM TOWN (CIRCLE APPROPRIATE BOX)			
1 2 3 (SEQ. NO.) 6				
☒ NORTH	☐ EAST	☐ N E NORTHEAST	☐ S E SOUTHEAST	
☒ SOUTH	☐ WEST	☐ N W NORTHWEST	☐ S W SOUTHWEST	
NEAR WHAT ROAD Cannals Mill Rd.	11			
ON WHICH SIDE OF ROAD (CIRCLE APPROPRIATE BOX)	☐ NORTH	☐ SOUTH	☐ EAST	☒ WEST
DISTANCE FROM ROAD (ENTER DISTANCE AND CIRCLE APPROPRIATE BOX) 1000	34			
DRAW A SKETCH BELOW SHOWING LOCATION OF WELL IN RELATION TO NEARBY TOWNS, ROADS AND STREAMS WITH NORTH IN THE DIRECTION OF THE ARROW, AND GIVE DISTANCE FROM WELL TO NEAREST ROAD JUNCTION OR STREAM CROSSING SHOWN ON THE SKETCH. ALSO SHOW, BY MEANS OF AN "X", THE WELL LOCATION IN THE BOX BELOW, AND THE BOX NUMBER FROM THE WELL LOCATION MAP.				

APPROXIMATE DEPTH OF WELL 24 150 28 FEET
APPROXIMATE DIAMETER OF WELL 6 (NEAREST INCH)
METHOD OF DRILLING USED (CIRCLE APPROPRIATE METHOD)
☒ BORED (OR AUGERED) ☐ JETTED ☐ DRIVEN
80-37 ☒ AIR-ROTARY ☐ AIR-PERCUSSION ☐ ROTARY (HYDRAULIC ROTARY)
☒ CABLE ☐ REVERSE-ROTARY ☐ DRIVE-POINT
OTHER (DESCRIBE)
REPLACEMENT OR DEEPEINED WELLS (CIRCLE APPROPRIATE BOX)
☒ THIS WELL WILL NOT REPLACE AN EXISTING WELL
☐ THIS WELL WILL REPLACE A WELL THAT WILL BE ABANDONED AND SEALED
☐ THIS WELL WILL REPLACE A WELL THAT WILL BE USED AS A STANDBY
☐ THIS WELL WILL DEEPEIN AN EXISTING WELL PERMIT NUMBER OF WELL TO BE REPLACED OR DEEPEINED (IF AVAILABLE)

1/25/74

90' casing
50' open around casing
21 bags cement grout
OK WWZ

Sketch area with North arrow and handwritten notes.

NOT TO BE FILLED IN BY DRILLER (WRA USE ONLY)	
APPROPRIATION PERMIT NUMBER 54	ENGINEER REVIEW DISTRICT NO. 63
FORCE 67 68	CONDITIONS 70 71 72 73 74 75 76 77 78 79


B 4	CONTINUED	HEALTH DEPARTMENT APPROVAL
1 2 3 (SEQ. NO.) 6		
41	STATE HEALTH (CIRCLE BOX)	COUNTY NAME Howard
DATE 102073	APPROVED BY Palmer F. Wine, Director	

BOX NUMBER E 810 N 520	NORTH COORDINATE 50 51 52 53 54 55	EAST COORDINATE 57 58 59 60 61 62 63
ELEVATION AT WELL HEAD (FEET) 65 66 67 68	0/0 5/0	

B 5	SPECIAL CONDITIONS 8-63 (WRA USE ONLY)	
1 2 3 (SEQ. NO.) 6		

C 1	4789	SEQUENCE NO. (DWR USE ONLY)	STATE OF MARYLAND WATER RESOURCES ADMINISTRATION TAWES STATE OFFICE BLDG., ANNAPOLIS, MD. 21401 WELL COMPLETION REPORT		THIS REPORT MUST BE SUBMITTED WITHIN 30 DAYS AFTER WELL COMPLETION FILL IN THIS FORM COMPLETELY COUNTY NUMBER																		
DATE RECEIVED (DWR USE ONLY)		DATE WELL COMPLETED		DEPTH OF WELL	PERMIT NO. FROM "PERMIT TO DRILL WELL"																		
1 2 3 (SEQ. NO.) 6 (THIS NUMBER IS TO BE PUNCHED IN COLUMNS 3-6 ON ALL CARDS)		Jan 24 - 79		300	40-73-0547																		
8-13		15 20		22 (TO NEAREST FOOT) 26	28 29 30 31 32 33 34 35 36 37																		
OWNER		LAST NAME		FIRST NAME	DRILLERS IDENTIFICATION NO.																		
Carter		Richard		Ellicott City Md.	42																		
STREET OR RFD		POST OFFICE																					
03-20-01																							
WELL LOG			GROUTING RECORD																				
STATE THE KIND OF FORMATIONS PENETRATED, THEIR COLOR, DEPTH, THICKNESS AND IF WATER BEARING			WELL HAS BEEN GROUTED (CIRCLE APPROPRIATE BOX)																				
<table border="1" style="width:100%; border-collapse: collapse;"> <tr> <th style="width:40%;">DESCRIPTION (USE ADDITIONAL SHEETS IF NECESSARY)</th> <th style="width:20%;">FEET</th> <th style="width:40%;">CHECK IF WATER BEARING</th> </tr> <tr> <td></td> <td>FROM TO</td> <td></td> </tr> <tr> <td>Top soil</td> <td>0 2</td> <td></td> </tr> <tr> <td>Sandy</td> <td>2 85</td> <td></td> </tr> <tr> <td>Sand stone</td> <td>85 140</td> <td>✓</td> </tr> <tr> <td>Granite</td> <td>140 300</td> <td>✓</td> </tr> </table>			DESCRIPTION (USE ADDITIONAL SHEETS IF NECESSARY)	FEET	CHECK IF WATER BEARING		FROM TO		Top soil	0 2		Sandy	2 85		Sand stone	85 140	✓	Granite	140 300	✓	TYPE OF GROUTING MATERIAL (CIRCLE BOX)		
			DESCRIPTION (USE ADDITIONAL SHEETS IF NECESSARY)	FEET	CHECK IF WATER BEARING																		
	FROM TO																						
Top soil	0 2																						
Sandy	2 85																						
Sand stone	85 140	✓																					
Granite	140 300	✓																					
			CEMENT ☒ BENTONITE CLAY ☒																				
			NO. OF BAGS NO. OF POUNDS																				
			GALLONS OF WATER																				
			DEPTH OF GROUT SEAL (TO NEAREST FOOT)																				
			FROM 48 52 FT. TO 54 58 FT. (ENTER 0 IF FROM SURFACE)																				
Casing Record			Casing Types																				
			☒ STEEL ☒ CONCRETE ☐ PLASTIC ☐ OTHER																				
MAIN CASING TYPE			NOMINAL DIAMETER TOP (MAIN) CASING (NEAREST INCH)																				
S +			6 90																				
60 61 63 64 66 70																							
Other Casing (if used)			Diameter (inch)																				
			Depth (feet) FROM TO																				
SCREEN TYPE OR OPEN HOLE			SCREEN RECORD																				
☒ STEEL ☐ BRASS OR BRONZE ☐ OPEN HOLE ☐ PLASTIC ☐ OTHER			☒ STEEL ☐ BRASS OR BRONZE ☐ OPEN HOLE ☐ PLASTIC ☐ OTHER																				
C 2			1 2 3 (SEQ. NO.) 6																				
EACH SCREEN			DEPTH (NEAREST WHOLE FOOT)																				
1 40			FROM 88 TO 300																				
2			8 9 11 15 17 21																				
3			23 24 26 30 32 36																				
			38 39 41 45 47 51																				
			SLOT SIZE 1. 2. 3.																				
Diameter of screen			(NEAREST INCH)																				
56 60			FROM TO																				
Gravel pack																							
IF WELL DRILLED WAS A FLOWING WELL CIRCLE BOX			68 F																				
DWR USE ONLY (NOT TO BE FILLED IN BY DRILLER)			(E.R.O.S.)																				
T 70			W Q 72 74 75 76																				
TELESCOPE CASING			LOG INDICATOR OTHER DATA AVAILABLE																				
CIRCLE APPROPRIATE BOXES ☐ A WELL WAS ABANDONED AND SEALED WHEN THIS WELL WAS COMPLETED ☐ ELECTRIC LOG OBTAINED ☐ TEST WELL CONVERTED TO PRODUCTION WELL I HEREBY CERTIFY THAT I HAVE COMPLIED WITH ALL CONDITIONS STATED ON THE ABOVE-CAPTIONED "PERMIT TO DRILL WELL", AND THAT INFORMATION CONTAINED IN THIS REPORT IS TRUE, ACCURATE, AND COMPLETE TO THE BEST OF MY KNOWLEDGE, INFORMATION AND BELIEF. DRILLERS NAME (PLEASE PRINT) J. F. Easterday SIGNATURE J. F. Easterday			PUMPING TEST																				
			HOURS PUMPED (TO NEAREST HOUR) 2 PUMPING RATE (GALLONS PER MINUTE TO NEAREST GALLON) 92 METHOD USED TO MEASURE PUMPING RATE bucket WATER LEVEL (DISTANCE FROM LAND SURFACE) BEFORE PUMPING 70 (NEAREST FOOT) WHEN PUMPING 300 (NEAREST FOOT) TYPE OF PUMP USED (CIRCLE APPROPRIATE BOX) (FOR PUMPING TEST) ☒ AIR ☐ PISTON ☐ TURBINE ☐ CENTRIFUGAL ☐ ROTARY ☐ OTHER (DESCRIBE BELOW) ☐ JET ☐ SUBMERSIBLE																				
PUMP INSTALLED TYPE OF PUMP (WRITE APPROPRIATE LETTER IN BOX - SEE ABOVE: A, C, J, P, R, S, T, O) DRILLER WILL INSTALL PUMP (CIRCLE APPROPRIATE BOX) CAPACITY: GALLONS PER MINUTE (TO NEAREST GALLON) 31 35 PUMP HORSE POWER 37 41 PUMP COLUMN LENGTH (NEAREST FOOT) 43 47			LOCATION OF WELL ON LOT																				
			SHOW PERMANENT STRUCTURE SUCH AS BUILDINGS, SEPTIC TANKS, AND/OR OTHER LAND MARKS AND INDICATE NOT LESS THAN TWO DISTANCES (MEASUREMENTS TO WELL). HOUSE 90' 8' well Rd.																				

Serial # 50903

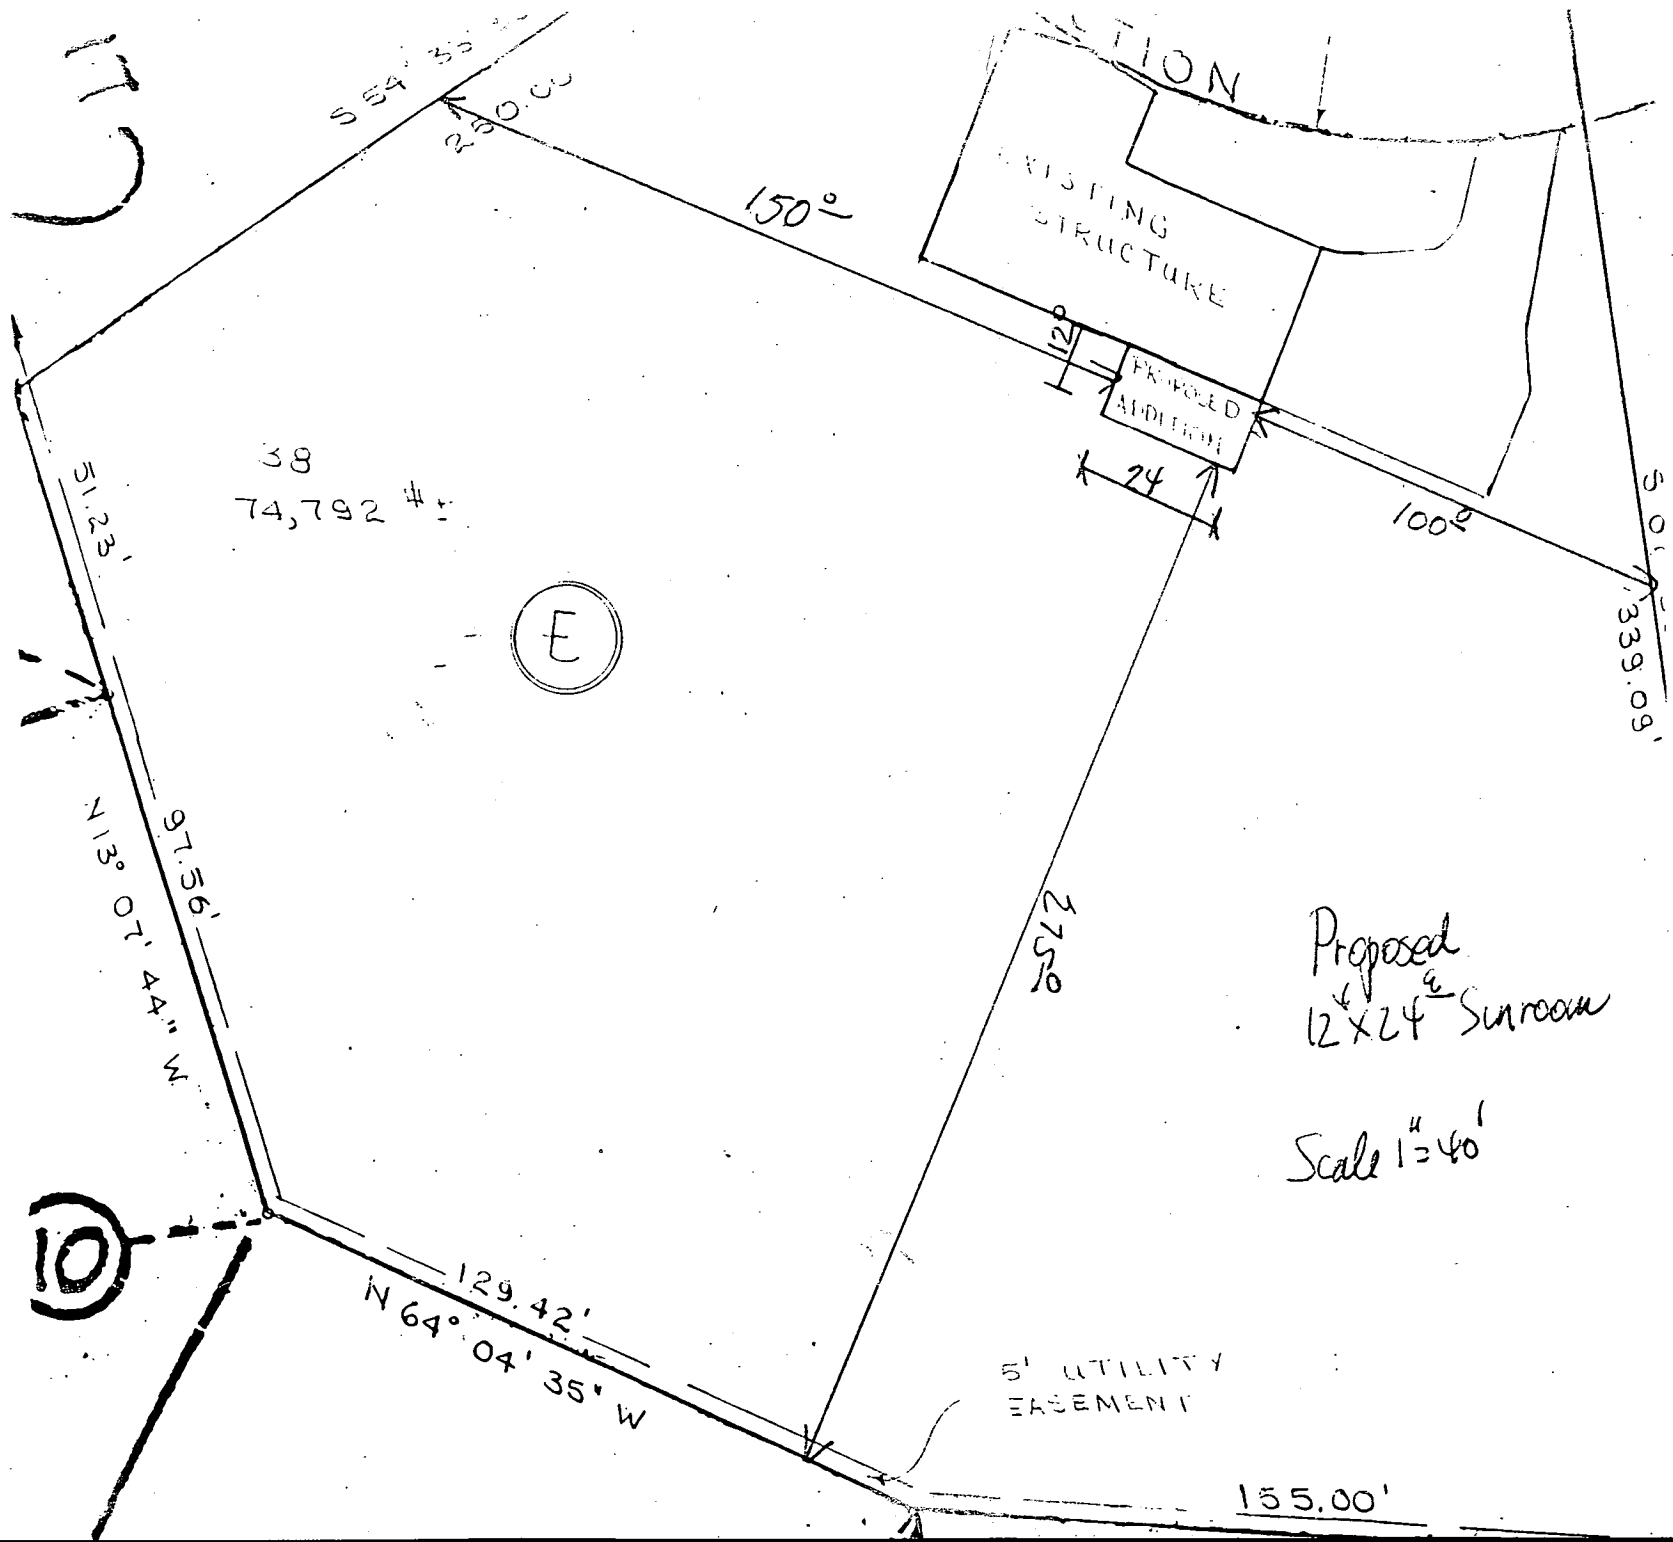

PERMIT

SEWAGE DISPOSAL SYSTEM

MARYLAND STATE DEPARTMENT OF HEALTH

HOWARD COUNTY

ELLICOTT CITY

DISTRICT 3rd

DATE 9/10/73

File INDEXED

1/31/74 final inspection
Tattrie and Levy

IS PERMITTED TO INSTALL X ALTER

ADDRESS 7000 Longview Road, Simpsonville, Md. 21150 PHONE 531-5266

A SEWAGE DISPOSAL SYSTEM LOCATED AT

SUBDIVISION Woodmark ROAD Yearling Court LOT 38, Blk.E, Sec.9
~~Rockhill Mill Road~~

PROPERTY OWNER Richard H. and Brenda E. Carter

ADDRESS 10118 Carillon Drive, Ellicott City, Md. Phone: 465-5068

SPECIFICATIONS 4 bedrooms

DRAIN FIELD _____ DEPTH _____ FEET, BOTTOM AREA _____ SQ. FT.

SEEPAGE PITS _____ ABSORBENT SIDE-WALL AREA _____ SQ. FT.

SEPTIC TANK CAPACITY 1250 GALLONS

FOR GARBAGE GRINDER, INCREASE DISPOSAL AREA 22% & TANK CAPACITY 50%.

OTHER DRY WELL - 100 sq. ft. absorbent sidewall area per bedroom to begin below the first 3 1/2 ft. of non porous soil. Maximum depth permitted for dry well is 11 ft. Locate dry well 180 ft. from rear property line and 100 ft. from right side line as seen from Yearling Court.

NOTE: ALL PIPE FROM HOUSE TO DRY WELL MUST BE CAST IRON.
PERMIT VOID AFTER THREE YEARS.


NOTE: INSTALL STAND PIPE ON SEPTIC TANK AND DRY WELL.

PLANS APPROVED BY Robert V. Torre DATE 9/28/72 & 8/28/73

FILL SEPTIC TANK AND DISTRIBUTION BOX WITH WATER BEFORE CALLING FOR AN INSPECTION. COVER NO WORK UNTIL INSPECTED AND APPROVED.

NEITHER THE HOWARD COUNTY COMMISSIONERS NOR THE HEALTH DEPARTMENT IS RESPONSIBLE FOR THE SUCCESSFUL OPERATION OF ANY SYSTEM.

A 16539

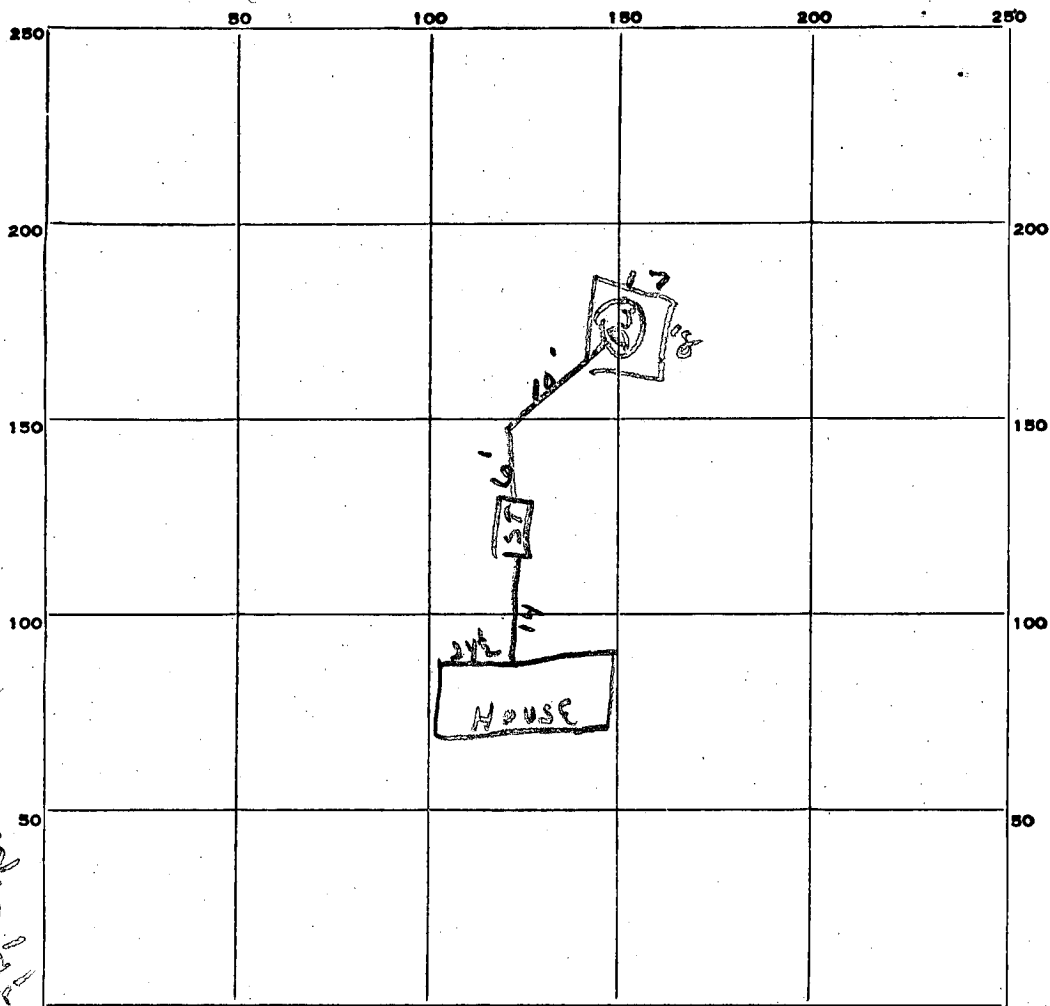

INDICATE NORTH. — NAME ADJOINING ROADWAY AS BASE LINE.

PERMIT CARD Agreed

SEPTIC TANK, LEVEL 125' 0" gnd.

CLEANOUTS 0

DISTRIBUTION BOX, LEVEL _____

TILE FIELD, DEPTH _____ FT. TRENCH WIDTH _____ FT.

GRAVEL DEPTH _____ IN. TOTAL LENGTH _____ FT.

NUMBER OF TRENCHES _____

TOTAL BOTTOM AREA _____

SEEPAGE PITS, ^{outside perimeter} ~~INSIDE~~ DIAMETER 17' x 18' FT.

DEPTH BELOW INLET 6 1/2 FT.

ABSORBENT AREA 455 SQ. FT.

REMARKS _____

DATE SYSTEM APPROVED 1/30/74

INSPECTOR R. Toner

Preliminary

8/6/73 - Visual hole needed.

APPLICATION

A 16539

SEWAGE DISPOSAL TESTING

P

MARYLAND STATE DEPARTMENT OF HEALTH

HOWARD COUNTY *Septic Tank - 3 bedroom - 1000 gal.*
4 " - 1250 gal.

ELLICOTT CITY

DISTRICT 3

Dry well - 100 sq. ft. absorbent sidewall area per bedroom to begin below the first 3 1/2 ft. of non porous soil. Maximum depth permitted for dry well is 11 ft. Locate dry well 220 ft. from rear property line and 100 ft. from side line as seen from Yearling Ct.

DATE 11/30/71

change 8/22/73

8/28/73 3 PM

8/28/73 12 ft hole OK R-1

TO: THE COUNTY HEALTH OFFICER
ELLICOTT CITY, MARYLAND

I, HEREBY, APPLY FOR THE NECESSARY TESTS IN ORDER TO CONSTRUCT (OR RECONSTRUCT) A SEWAGE DISPOSAL SYSTEM.

PROPERTY OWNER Mark Wakefield, Jr.
12150 Mt. Albert Court
ADDRESS Ellicott City, Md., 21043 PHONE 531-5072

PROPERTY LOCATION:

SUBDIVISION Woodmark, Inc. LOT NO 38, Block E, Sec. 9

ROAD AND DESCRIPTION ~~Carroll Mill Road~~ Yearling Court

OCCUPANT _____ PHONE _____

PERSON TO CONSTRUCT SYSTEM _____

ADDRESS _____ PHONE _____

SIZE OF LOT 120'x125'x100'x25'x260'x75'x275' TYPE BLDG. (3) or (4)
NUMBER OF BEDROOMS

IF NOT SINGLE RESIDENCE DESCRIBE _____

SIGNATURE OF APPLICANT Mark Wakefield, Jr.


APPROVED BY Robert V. Tane FOR Dry well DATE 9/28/72
(KIND OF SYSTEM)

REJECTED BY _____ FOR _____ DATE _____
(KIND OF SYSTEM)

HOLD PENDING FURTHER TESTS _____ DATE _____

REASONS FOR REJECTION OR HOLDING _____

THIS IS NOT A PERMIT

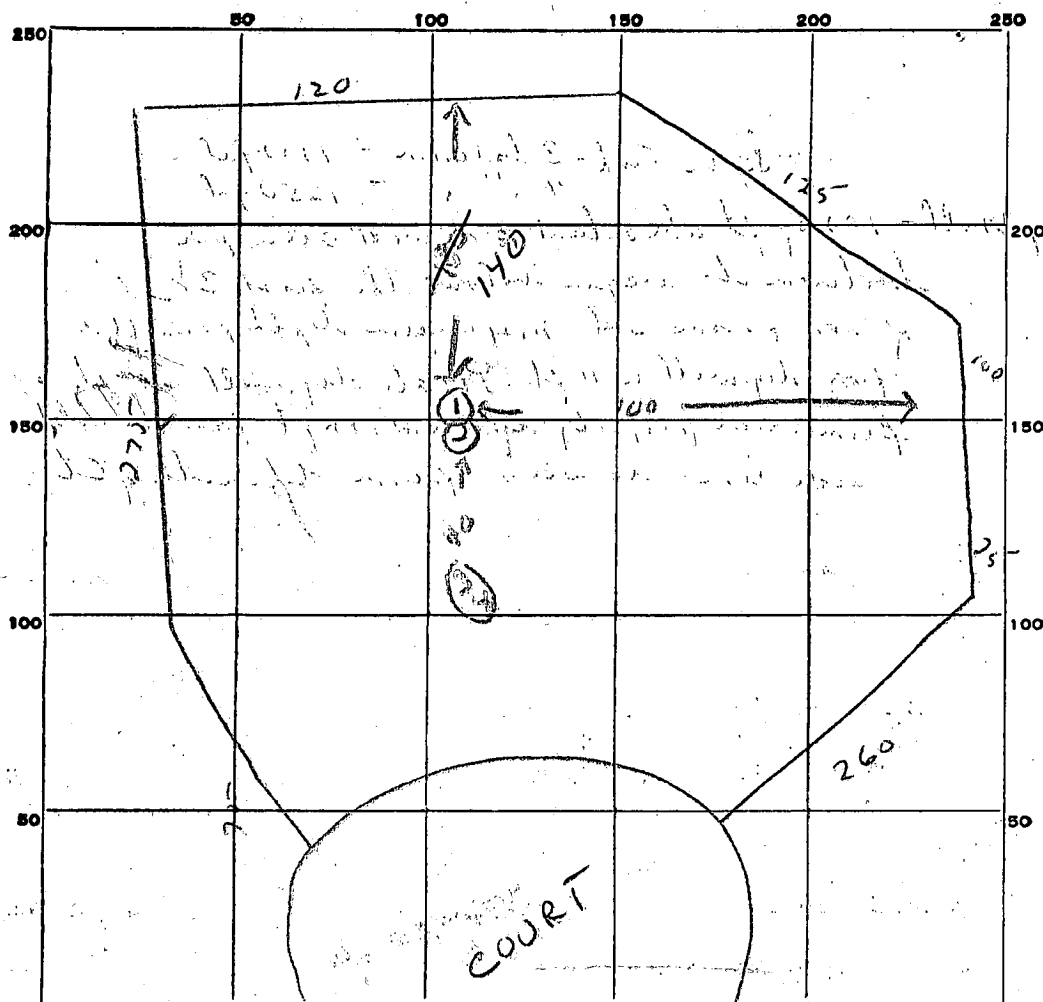

INDICATE NORTH. - NAME ADJOINING ROADWAY AS BASE LINE.

DATE	TEST NO.	DEPTH	PRE-WET		TEST - 1" DROP		TIME
			START	STOP	START	STOP	
5/11	1	4 ft	10 ²³	10 ²⁹	10 ²⁹	10 ⁴²	13 min
	2	11 ft	10 ²⁴	10²⁹	10²⁹	10 ²⁵	2 min
	3	4 1/2 ft	10 ²⁴	10 ²⁷	10 ²⁷	10 ³⁴	7 min
	4	10 1/2 ft	10 ²⁵	10 ²⁶	10 ²⁶	10 ²⁸	2 min
5/12/11		Water pit					

SOIL AUGER FINDING

TESTED BY.

REMARKS.

APPLICATION

SEWAGE DISPOSAL TESTING

A 16539

P

MARYLAND STATE DEPARTMENT OF HEALTH

HOWARD COUNTY *Septic Tank - 3 bedroom - 1000 gal.*
4 " - 1250 gal

ELLICOTT CITY

DISTRICT 3

DATE 11/30/71

*Dry well - 100 sq. ft. absorbent sidewall area per
bedroom to be dug below the first 3 1/2 ft
of non porous soil. Maximum depth permitted
for dry well is 11 ft. Locate dry well 220 ft
from rear property line and 100 ft. from right
side line as seen from Upending Ct.*

TO: THE COUNTY HEALTH OFFICER
ELLICOTT CITY, MARYLAND

I, HEREBY, APPLY FOR THE NECESSARY TESTS IN ORDER TO CONSTRUCT (OR RECONSTRUCT) A SEWAGE DISPOSAL SYSTEM.

PROPERTY OWNER Mark Wakefield, Jr.

12150 Mt. Albert Court

ADDRESS Ellicott City, Md., 21043

PHONE 531-5072

PROPERTY LOCATION:

SUBDIVISION Woodmark, Inc.

LOT NO. 38, Block E, Sec. 9

ROAD AND DESCRIPTION Carroll Mill Road

OCCUPANT

PHONE

PERSON TO CONSTRUCT SYSTEM

ADDRESS

PHONE

SIZE OF LOT 120'x125'x100'x25'x260'x75'x275'

TYPE BLDG. 3 or 4

NUMBER OF BEDROOMS

IF NOT SINGLE RESIDENCE DESCRIBE

SIGNATURE OF APPLICANT Mark Wakefield, Jr.

APPROVED BY Robert V. Tona

FOR

Dry well
(KIND OF SYSTEM)

DATE

9/28/72

REJECTED BY

FOR

(KIND OF SYSTEM)


DATE

HOLD PENDING FURTHER TESTS

DATE

REASONS FOR REJECTION OR HOLDING

THIS IS NOT A PERMIT

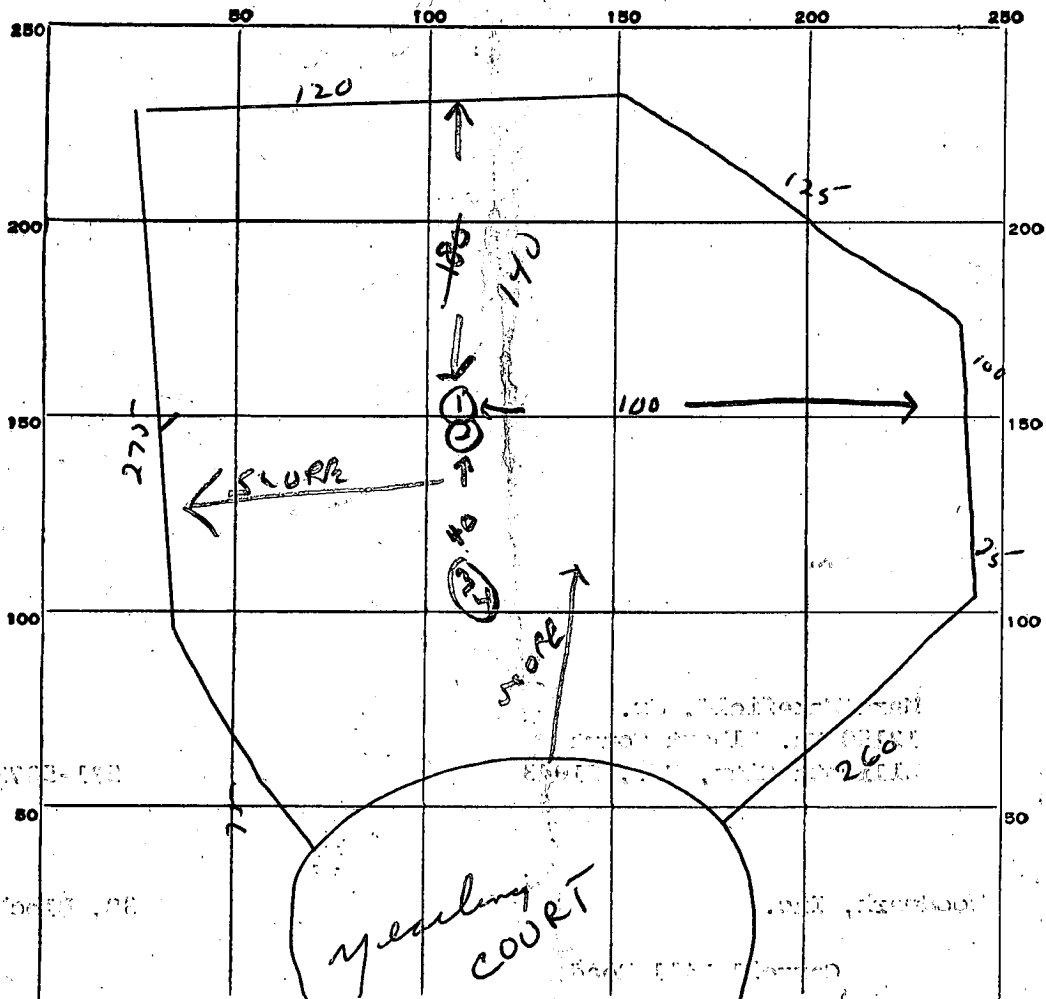

INDICATE NORTH. - NAME ADJOINING ROADWAY AS BASE LINE.

DATE	TEST NO.	DEPTH	PRE-WET		TEST - 1" DROP		TIME
			START	STOP	START	STOP	
12/15/71	1	4 ft.	10 23	10 29	10 29	10 42	13 min
	2	11 ft.	10 24	—	—	10 26	2 min
	3	4 1/2 ft.	10 24	10 27	10 27	10 34	7 min
	4	10 1/2 ft.	10 25	10 26	10 26	10 28	2 min

LOT 38E


SOIL AUGER FINDING _____

TESTED BY R. Torre

REMARKS _____

175 SUN. JUNE 24, 1973 190
 6/24/73
 R. L. Linn
 8/28/73
 SUNDAY
 JUNE 1973

18882 Richard Carter
 8-14-73

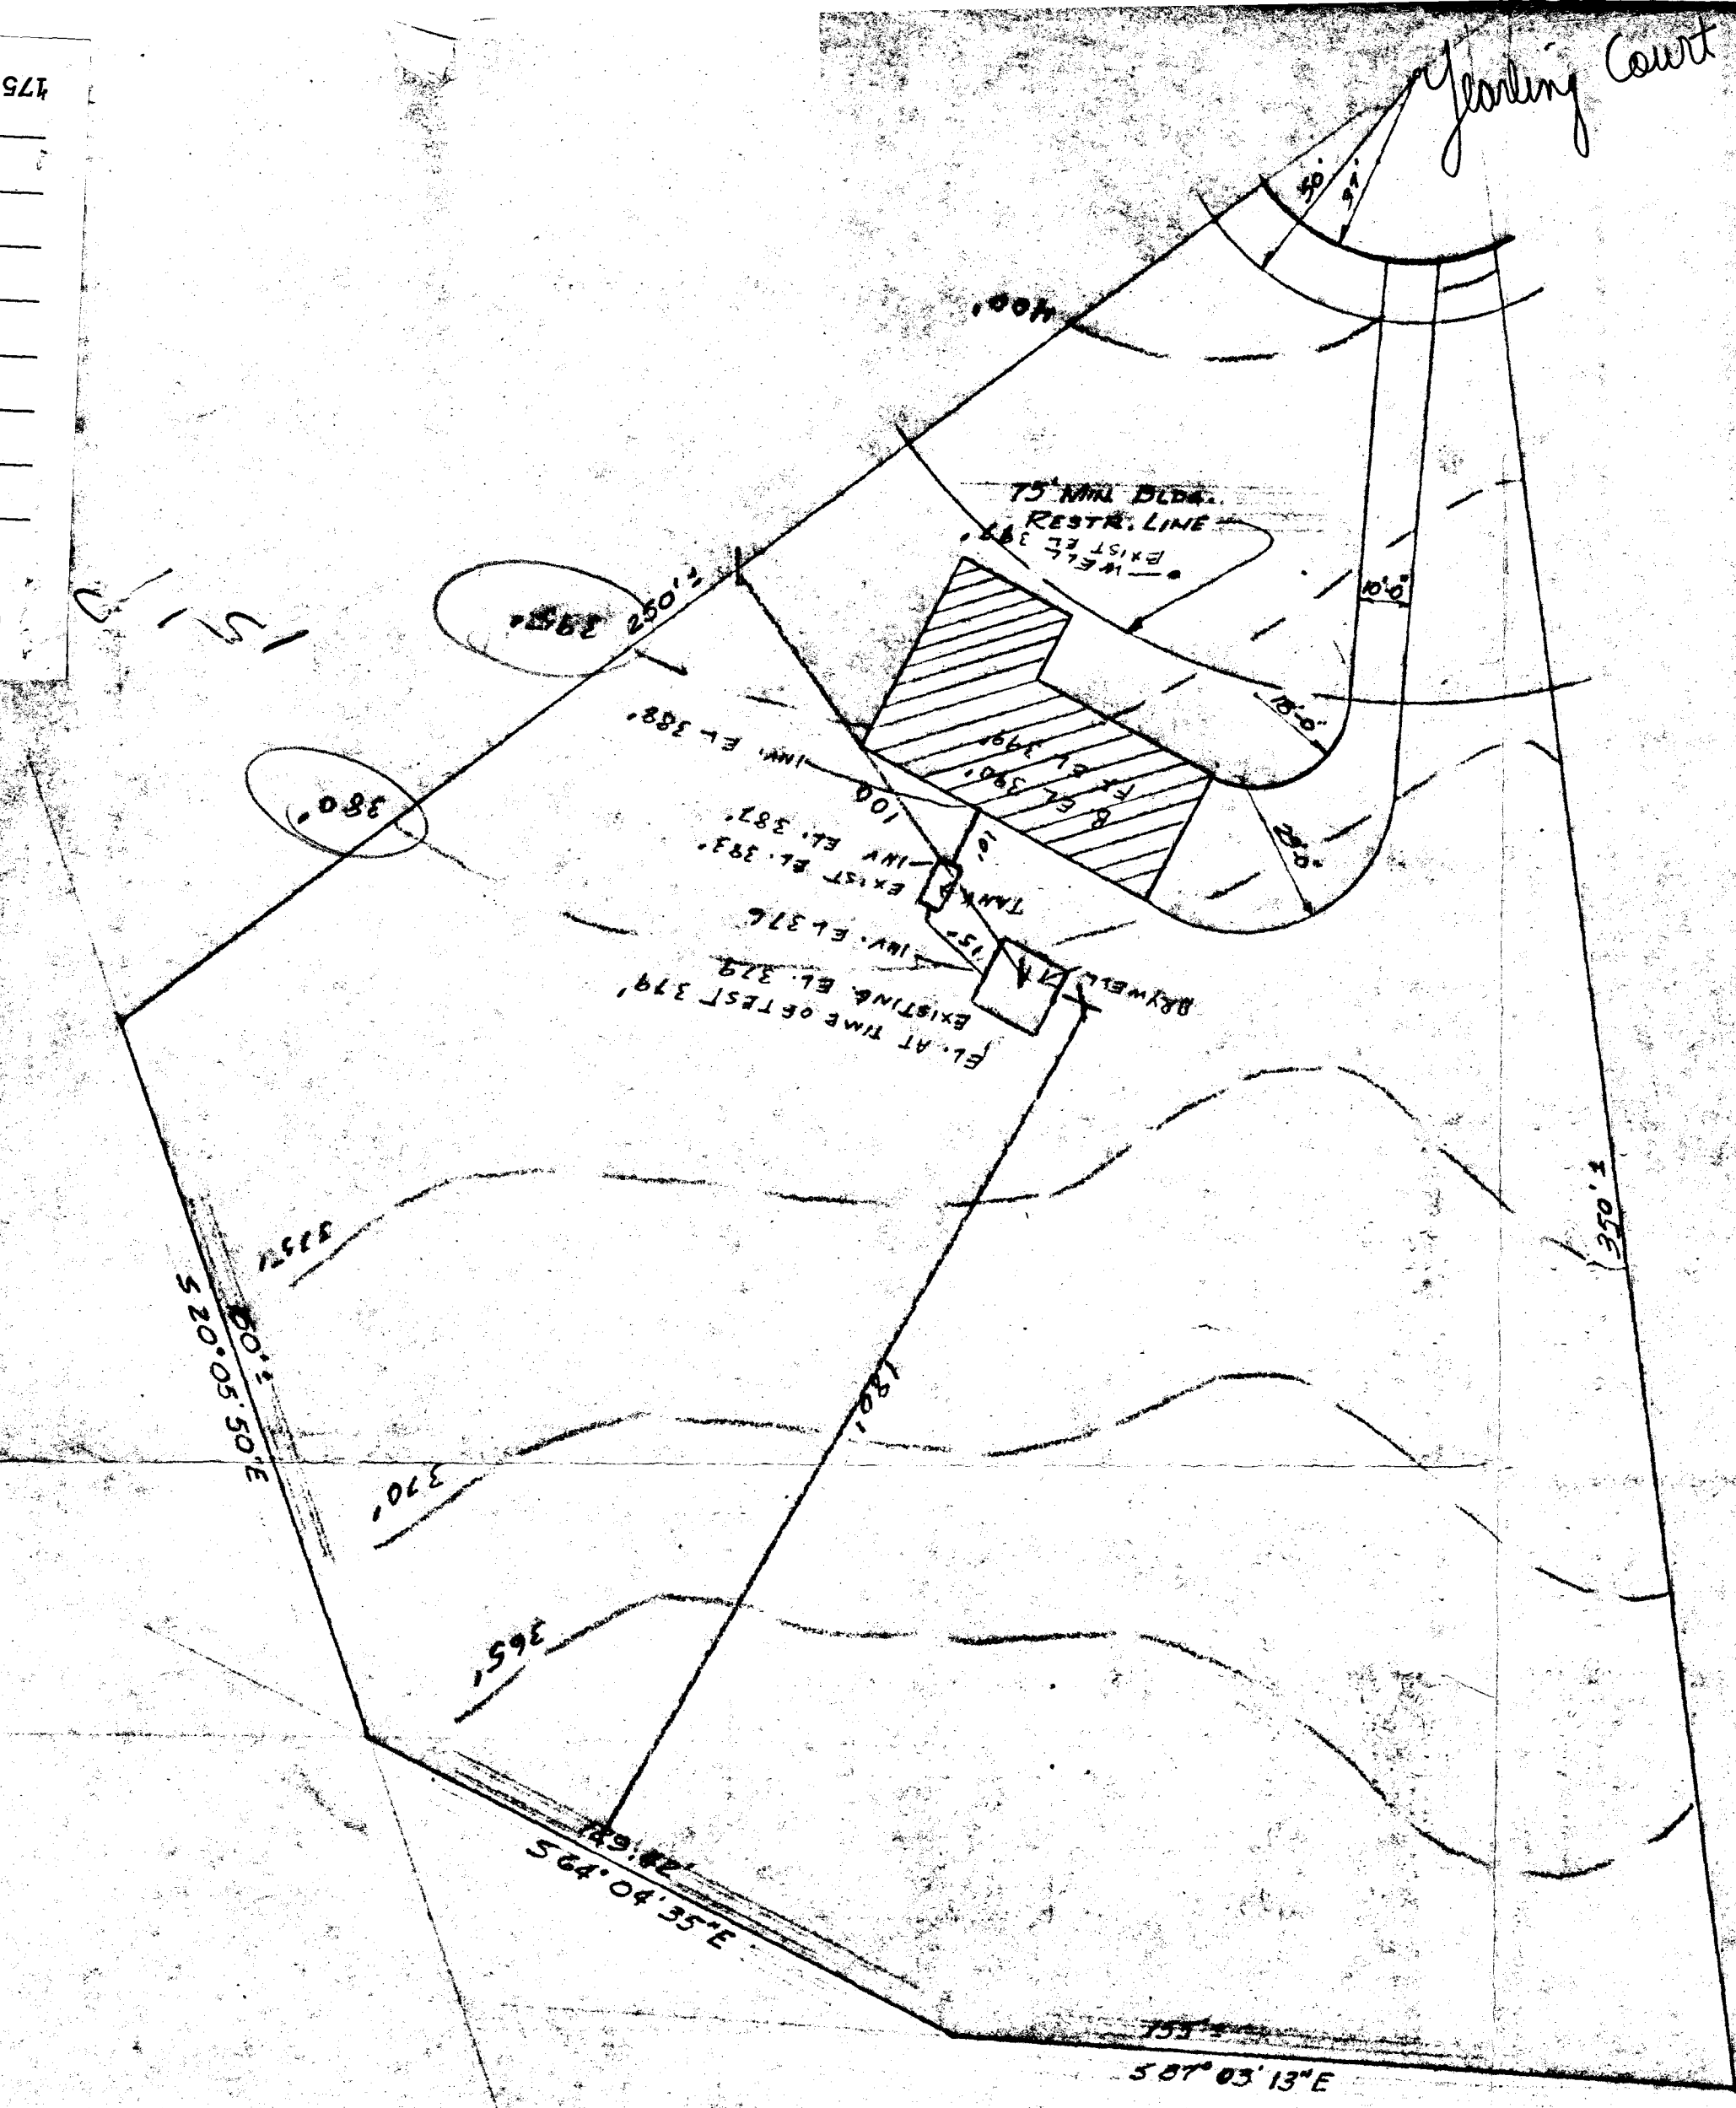

PLOT PLAN

REVISED:-	OWNER:- MR. & MRS. RICHARD H. CARTER
	LOCATION:- SECTION 9 BLOCK E, LOT 38
	DEVELOPMENT:- WOODMARK
	COUNTY:- HOWARD
	BUILDER:-
	DATE:- APRIL 14, 1973
	SHEET 1 OF 5