

11/9/82
around 11 AM
11/8/82
around 3:00 P.M.

PERMIT

SEWAGE DISPOSAL SYSTEM

MARYLAND STATE DEPARTMENT OF HEALTH

HOWARD COUNTY

05-341639

RE INDEX

Approved 11/9/82
32198
A-00000
P 22312
P 32198

ELLCOTT CITY

DISTRICT 5th

DATE 9/23/82

Paul Schissler - South Carroll Lachhoe Service

IS PERMITTED TO INSTALL ☒ ALTER

ADDRESS 7311 Brangles Road, Marriottsville, Md. 21104

PHONE 795-2642

SUBDIVISION

ROAD 13049 Triadelphia Mill Rd, Lot

PROPERTY OWNER

David Lindsay

WEINSTEIN Farm dirt removed again 13049

ADDRESS 14123 Castee Boulevard, Silver Spring, Md. 20904

SPECIFICATIONS 3 bedrooms

SEPTIC TANK CAPACITY 1000 GALLONS

DRAIN FIELD DEPTH FEET. BOTTOM AREA SQ. FT.

DEEP TRENCH DEPTH FEET. BOTTOM AREA SQ. FT.

DRY WELL
AND
TRENCH

SEEPAGE PITS ☒ ABSORBENT SIDE-WALL AREA 130 SQ. FT. per bedroom (300 sq. ft. total in dry

INLET PIPE 4 FT. BELOW ORIGINAL GRADE. MAXIMUM DEPTH 11 FT. BELOW ORIGINAL GRADE

EFFECTIVE DEPTH AT 5 FT. BELOW ORIGINAL GRADE.

LOCATE DISPOSAL AREA 135 FT. FROM 483.94' LOT LINE AND 80 FT. FROM 523.30' LOT LINE

RECOMMENDATION

Trench to be 15 ft. long for a total of 90 sq. ft. absorption area. Inlet at 4 ft. and maximum depth 11 ft. below original grade. Run trench across high side of lot, following contour, towards perc hole #3 on attached perc test.

PLANS APPROVED BY William N. Zepp & Fred Prosselt

DATE 11/28/75 & 8/13/82

COVER NO WORK UNTIL INSPECTED AND APPROVED.

NEITHER THE HOWARD COUNTY COUNCIL NOR THE HEALTH DEPARTMENT IS RESPONSIBLE FOR THE SUCCESSFUL OPERATION OF ANY SYSTEM.

NOTE: IF TRENCH IS USED CALL FOR INSPECTION BEFORE PLACING GRAVEL IN TRENCH.

NOTE: NO DRY WELL SHALL EXCEED 18 FEET IN DIAMETER.

NOTE: ALL PIPE FROM HOUSE TO DISPOSAL AREA MUST BE CAST IRON.

PERMIT VOID AFTER THREE YEARS.

NOTE: INSTALL STAND PIPE ON SEPTIC TANK AND DRY WELL. STAND PIPES MUST BE 6 INCHES IN DIAMETER. CAST IRON, CONCRETE OR TERRA

COTTA ACCEPTED.

*INSTALLER IS RESPONSIBLE FOR OBTAINING FINAL APPROVAL ON THIS PERMIT.

BLDG. PERMIT SIGNED
AND RETURNED 11/10/82


688 10727
detached garage

BLDG. PERMIT SIGNED
AND RETURNED 1/27/86

David 688
Family room

EH-2-1079

32198

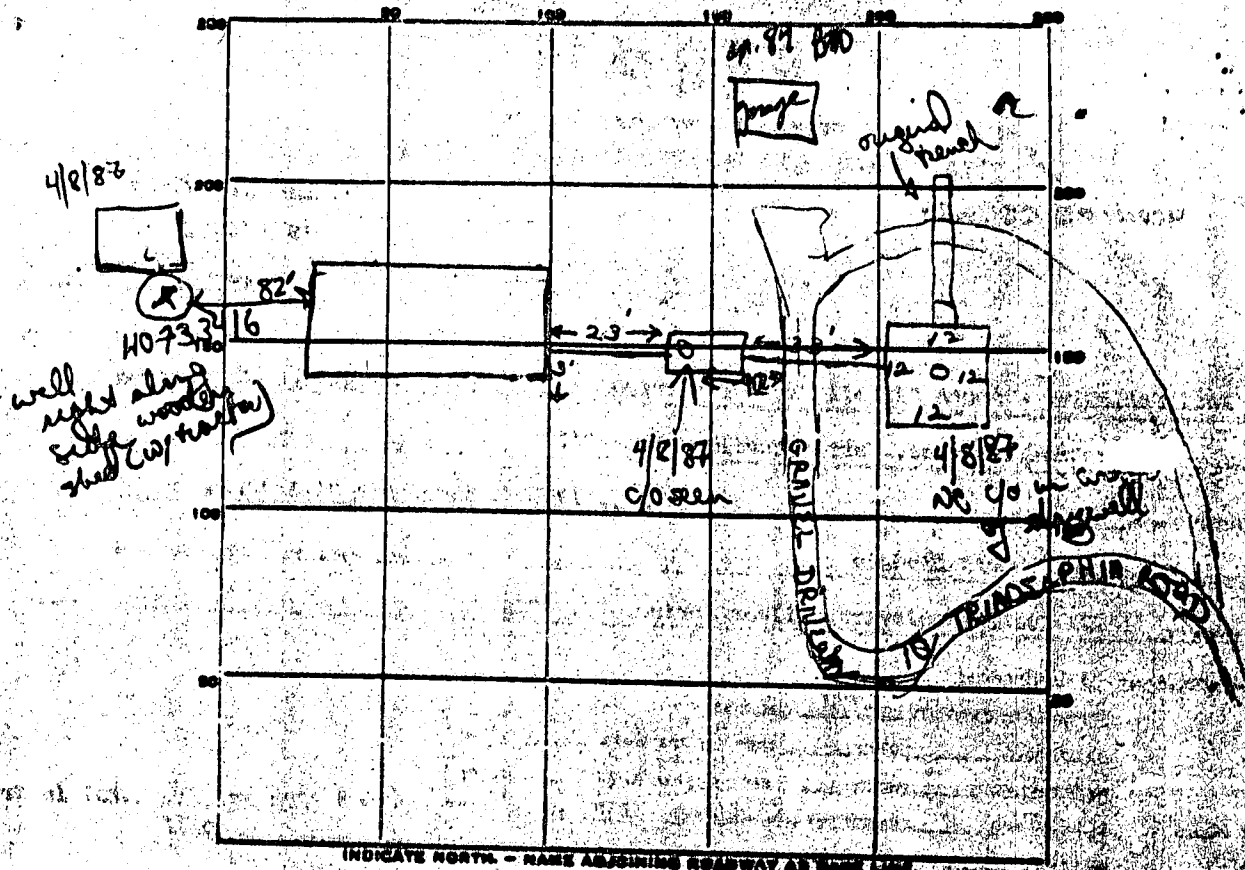

PERMIT CARD ✓

SEPTIC TANK, LEVEL ✓ 1000 gal CLEANOUTS ST DW

DISTRIBUTION BOX, LEVEL ✓

TILE FIELD, DEPTH 11 FT. TRENCH WIDTH 5 FT.

GRAVEL DEPTH 7 IN. TOTAL LENGTH 17 FT.

NUMBER OF TRENCHES 1 TOTAL BOTTOM AREA 102

SEEPAGE PITS, INSIDE DIAMETER 48 FT. DEPTH BELOW INLET 7 FT.


ABSORBENT AREA 390 SQ. FT.

REMARKS 11/8/82 OK to add stone in trench. fl
11/9/82 OK to cover all work fl

DATE SYSTEM APPROVED 11/9/82 INSPECTOR Stanger

22312

System in P. 14. Plot @ 3' off actual high @ 5' show depth 11'.
 Acc systems (future) in vicinity of hole 3, if restricted to max depth
 of 19'.

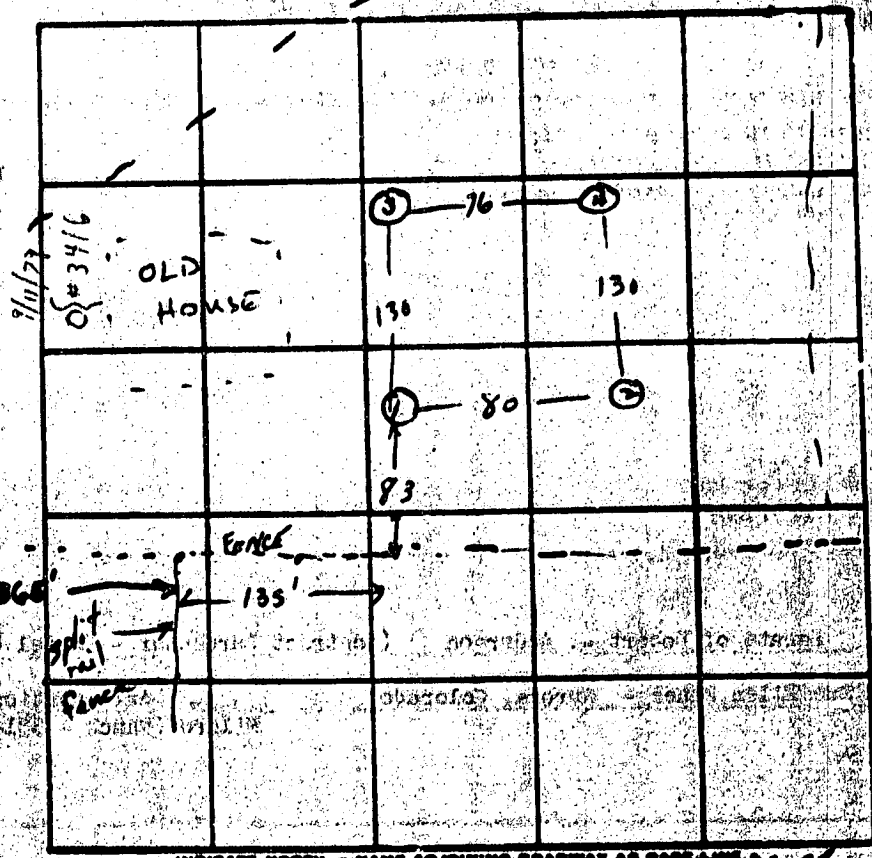

B. CA/over

R. 12

DATE	TEST NO.	DEPTH	PRE-WET		TEST 1 - 1000		TIME
			START	STOP	START	STOP	
11/5/75	1	5	9:42	9:43	9:49	9:50	25
	1-A	12	9:42	9:45	9:45	9:51	6
	2	6	9:44	9:45	9:45	9:52	7
	2-A	12	9:44	9:47	9:47	9:52	5
	3	11	Visual; most air to 4, 4-A; dry				4
	4	5	9:53	9:55	9:55	9:57	2
	4-A	12 3/4	9:53	9:55	9:55	9:57	2


still in clay

REMARKS: Some shale in bottom of 3, 4
 TYPE OF SOIL: Sandy loam
 TESTED BY: NWZ ALSO PRESENT: Eyer, H. Namik

C 1	6903	SEQUENCE NO. (WRA USE ONLY)	STATE OF MARYLAND WATER RESOURCES ADMINISTRATION TAWES STATE OFFICE BLDG., ANNAPOLIS, MD. 21401		THIS REPORT MUST BE SUBMITTED WITHIN 30 DAYS AFTER WELL COMPLETION
1 2 3 (SEQ. NO.) 6 (THIS NUMBER IS TO BE PUNCHED IN COLS. 3-6 ON ALL CARDS)		WELL COMPLETION REPORT		FILL IN THIS FORM COMPLETELY	
DATE RECEIVED (WRA USE ONLY)		DEPTH OF WELL		PERMIT NO. FROM "PERMIT TO DRILL WELL"	
DATE WELL COMPLETED		22 (TO NEAREST FOOT) 26		17-73-3416	
8-13		15 20		28 29 30 31 32 33 34 35 36 37	
OWNER <u>ZEPHER</u>		LAST NAME		FIRST NAME	
STREET OR RFD		POST OFFICE		COUNTY NUMBER	
WELL DESCRIPTION					
WELL LOG		GROUTING RECORD			
STATE THE KIND OF FORMATIONS PENETRATED, THEIR COLOR, DEPTH, THICKNESS AND IF WATER BEARING		WELL HAS BEEN GROUTED (CIRCLE APPROPRIATE BOX)			
DESCRIPTION (USE ADDITIONAL SHEETS IF NECESSARY)		TYPE OF GROUTING MATERIAL (CIRCLE BOX)			
FEET		CEMENT ☒ M BENTONITE CLAY ☒ B C			
FROM TO CHECK IF WATER BEARING		NO. OF BAGS <u>9</u> NO. OF POUNDS <u>900</u>			
GALLONS OF WATER <u>45</u>		GALLONS OF WATER <u>45</u>			
DEPTH OF GROUT SEAL (TO NEAREST FOOT)		FROM <u>0</u> FT. TO <u>30</u> FT.			
(ENTER 0 IF FROM SURFACE)		48 52 54 58			
CASING TYPES		CIRCUIT RECORD			
INSERT APPROPRIATE CODE BELOW		STEEL ☒ S T CONCRETE ☒ C O			
MAIN CASING TYPE		PLASTIC ☒ P L OTHER ☒ O T			
NOMINAL DIAMETER TOP (MAIN) CASING (NEAREST INCH)		TOTAL DEPTH OF MAIN CASING (NEAREST FOOT)			
60 61 63 64 66 70		60 61 63 64 66 70			
OTHER CASING (IF USED)		PUMP INSTALLED			
DIAMETER (INCH) DEPTH (FEET) FROM TO		TYPE OF PUMP (WRITE APPROPRIATE LETTER IN BOX - SEE ABOVE: A, C, J, P, R, S, T, O)			
CAPACITY:		GALLONS PER MINUTE (TO NEAREST GALLON)			
PUMP HORSE POWER		PUMP COLUMN LENGTH (NEAREST FOOT)			
CIRCUIT RECORD		CASING HEIGHT (CIRCLE APPROPRIATE BOX AND ENTER CASING HEIGHT)			
STEEL ☒ S T BRASS OR BRONZE ☒ B R OPEN HOLE ☒ H O		+ ABOVE LAND SURFACE (NEAREST FOOT)			
PLASTIC ☒ P L OTHER ☒ O T		- BELOW 49 50 51			
C 2		LOCATION OF WELL ON LOT			
1 2 3 (SEQ. NO.) 6		SHOW PERMANENT STRUCTURE SUCH AS BUILDINGS, SEPTIC TANKS, AND/OR OTHER LAND MARKS AND INDICATE NOT LESS THAN TWO DISTANCES (MEASUREMENTS TO WELL).			
DEPTH (NEAREST WHOLE FOOT)		DIA. OF SCREEN (NEAREST INCH)			
FROM TO		GRAVEL PACK			
23 24 26 30 32 36		IF WELL DRILLED WAS A FLOWING WELL, CIRCLE BOX			
38 39 41 45 47 51		WRA USE ONLY (NOT TO BE FILLED IN BY DRILLER)			
SLOT SIZE 1. 2. 3.		T (E.R.O.S.) W Q			
DIAMETER OF SCREEN		TELESCOPE CASING			
FROM TO		LOG INDICATOR			
56 60		74 75 76 OTHER DATA AVAILABLE			
70 72		74 75 76 OTHER DATA AVAILABLE			

GENERAL NOTES:

- 1) THIS PLAT IS PREPARED FOR THE BENEFIT OF THE CLIENT SIGNING THE HOUSE LOCATION SURVEY APPROVAL FORM INsofar AS IT IS REQUIRED BY A LENDER OR TITLE INSURANCE COMPANY OR ITS AGENTS IN CONNECTION WITH THE CONTEMPLATED TRANSFER, FINANCING OR RE-FINANCING. UNLESS INDICATED AS BEING A BOUNDARY SURVEY, THIS PLAT IS NOT INTENDED FOR USE IN THE ESTABLISHMENT OF PROPERTY LINES AND IS NOT TO BE RELIED UPON FOR THE ESTABLISHMENT OR LOCATIONS OF FENCES, GARAGES, BUILDINGS OR OTHER EXISTING OR FUTURE IMPROVEMENTS. AS A RESULT, THIS PLAT DOES NOT PROVIDE FOR ACCURATE IDENTIFICATION OF PROPERTY LINE, BUT SUCH IDENTIFICATION MAY NOT BE REQUIRED FOR THE TRANSFER OF TITLE OR SECURING FINANCING OR RE-FINANCING.
- 2) SUBJECT PROPERTY IS SHOWN IN ZONE _____ ON THE NATIONAL FLOOD INSURANCE PROGRAM FLOOD INSURANCE RATE MAP OF _____ COUNTY, MARYLAND, COMMUNITY PANEL No. _____, EFFECTIVE DATE: _____.
- 3) THE OFFSETS FROM BUILDING LINE TO PROPERTY LINE AS SHOWN ON THE PLAT HEREON ARE TO AN ACCURACY OF 2' PLUS OR MINUS (±).
- 4) GRAVEL DRIVEWAY APPEARS TO ENCROACH ONTO ADJOINING PROPERTY AT INDICATED AREAS.

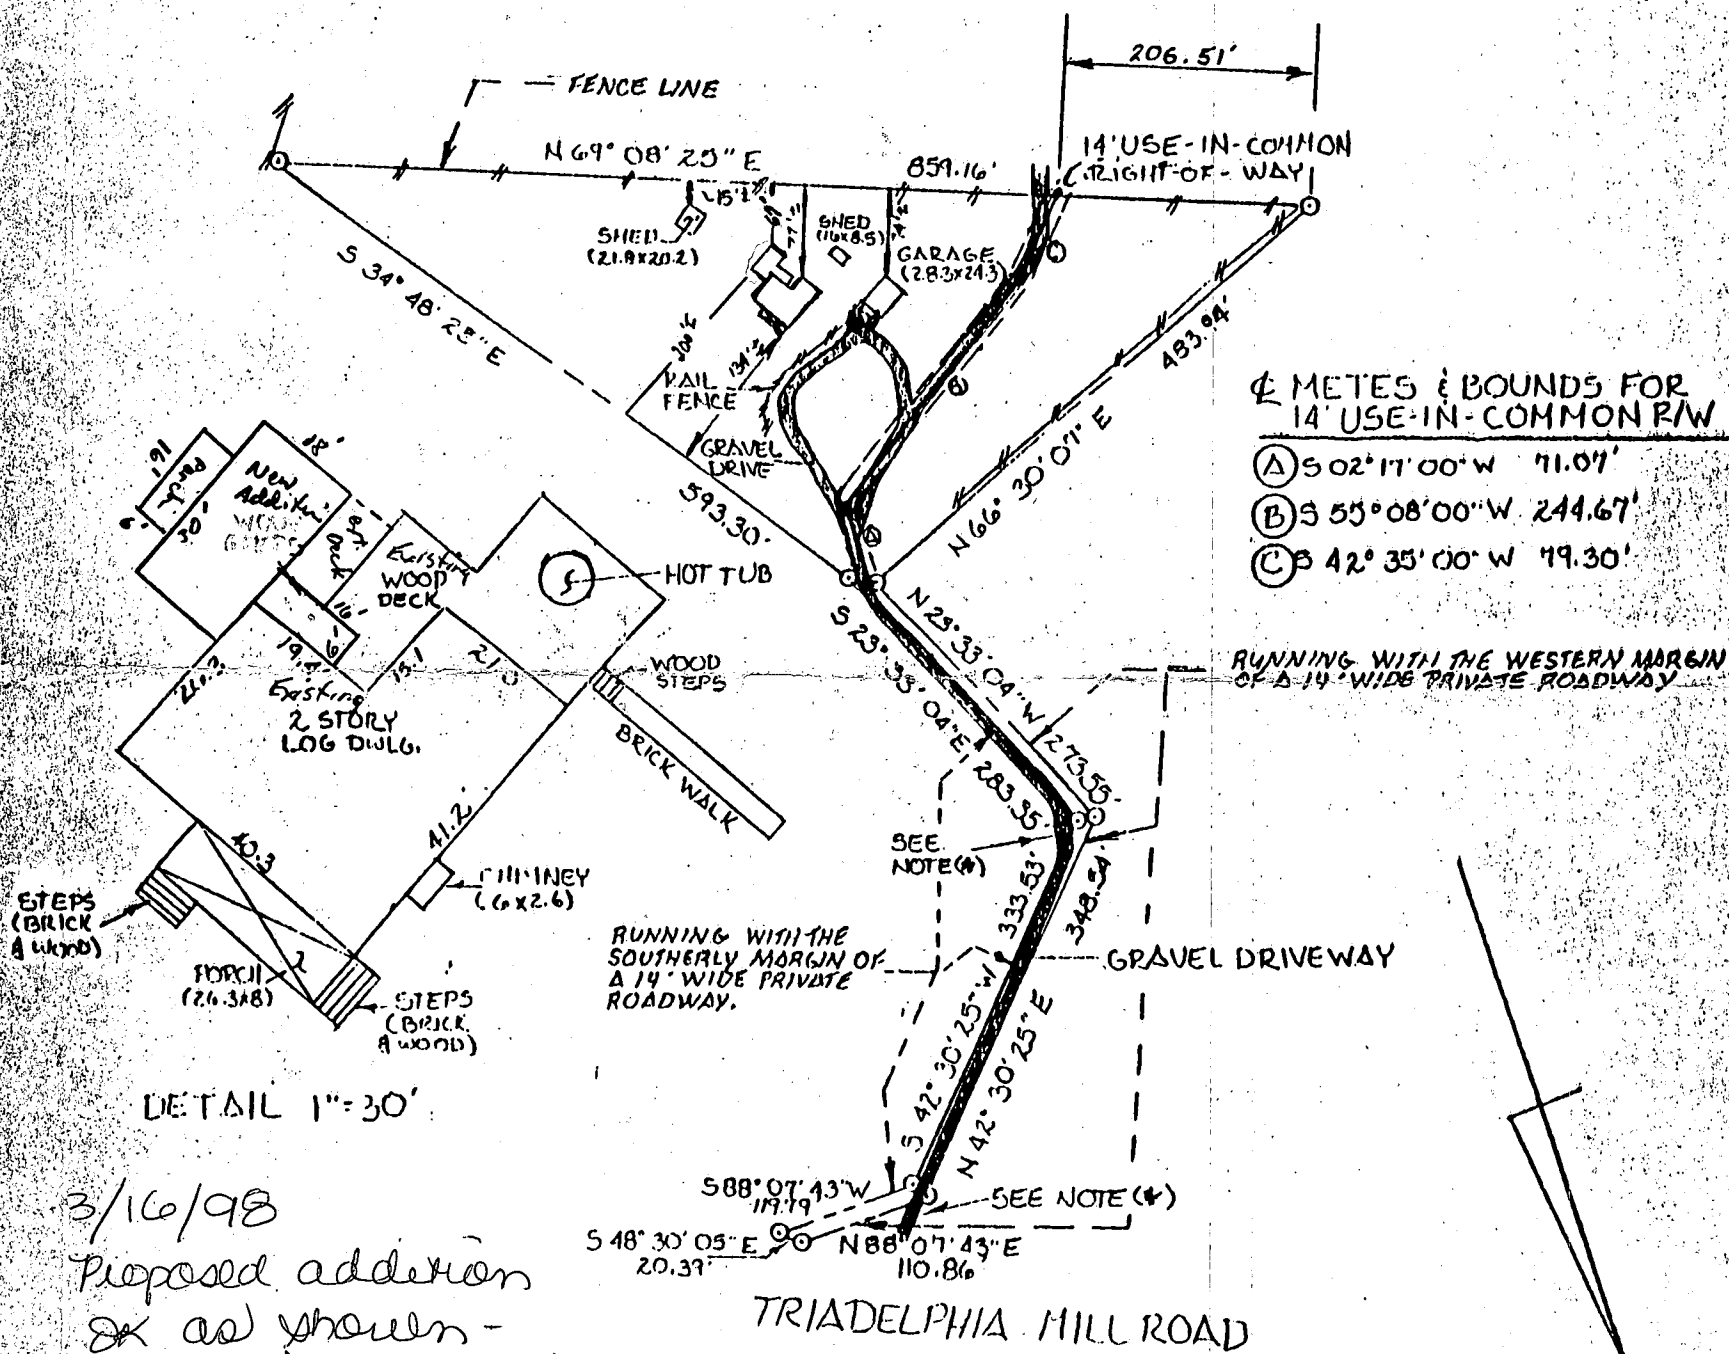

3/16/98
Proposed addition
~~OK~~ as shown -
no septic upgrade
required at this time.

DKS

#13049
TRIADELPHIA MILL ROAD
HOWARD COUNTY, MARYLAND
DEED REFERENCE: 1098/449

FISHER, COLLINS & CARTER, INC.
CIVIL ENGINEERING CONSULTANTS & LAND SURVEYORS
CENTENNIAL SQUARE OFFICE PARK - 10272 BALTIMORE NATIONAL PIKE
BLISSITT CITY, MARYLAND 21044
(301) 461-1029



PROFESSIONAL LAND SURVEYOR
REG. 14763

HOUSE LOCATION DRAWING

FOUNDATION LOCATION:
FINAL LOCATION: 5/6/97
BOUNDARY SURVEY:

SCALE: 1"=200
DATE: 5/19/97
DRAWN BY: KEL
CHECKED BY: MLR
PROJECT No: 3173

3/4/98

SITE INSPECTION SHEET

OWNER: Melvin Weinstein

DATE REQUESTED: _____

ADDRESS: 13049 Triadelphia Mill Rd
Clarksville, MD 21029


DRILLER: _____

WELL TAG # _____

COUNTY # _____

PROPOSAL: _____

LOCATION DIAGRAM

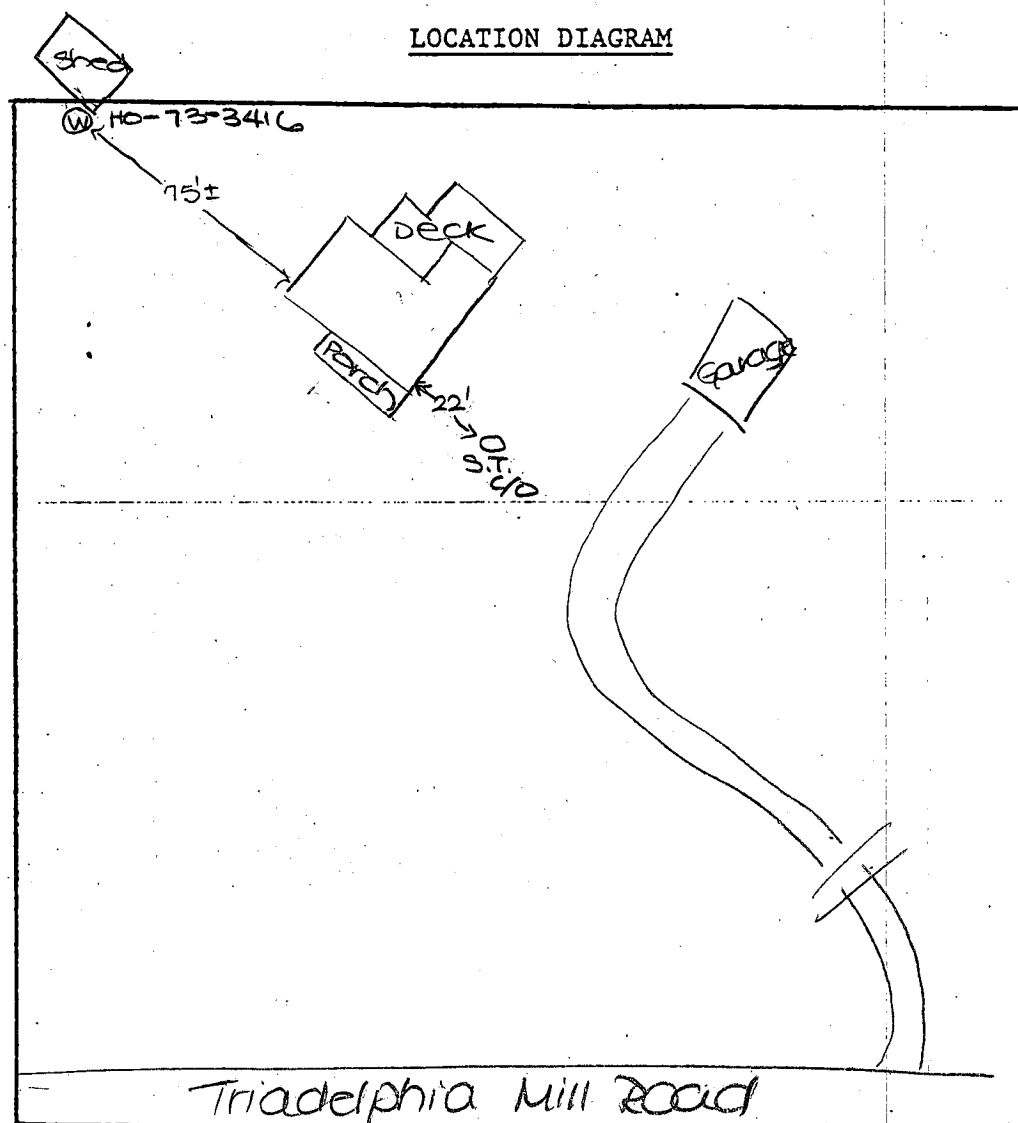

COMMENTS: Existing well and septic tank located. Unable to
determine type of drainfields(?) currently serving property.
(Owner not at site)

DATE: 3/4/98

INSPECTOR: Southern

Б 00110088

Yellow - Engineering
Pink - Health Dept.
Gold - S.H.A.

CK 7386

A