

10/19/82
around noon

10/19/82 Appl. S.S.

PERMIT

P 32216

A Repair

SEWAGE DISPOSAL SYSTEM

MARYLAND STATE DEPARTMENT OF HEALTH

HOWARD COUNTY

ELLICOTT CITY

DISTRICT 2nd

INDEX

DATE 10/4/82

Emerson Feaga IS PERMITTED TO INSTALL ALTER X

ADDRESS Old Frederick Road, Woodstock, Md. 21163 PHONE 465-5167

SUBDIVISION _____ ROAD Mt. Hebron Drive & Calvin Circle LOT _____

PROPERTY OWNER Mount Hebron Presbyterian Church

ADDRESS Mt. Hebron Drive & Calvin Circle, Ellicott City, Maryland 21043

SPECIFICATIONS

SEPTIC TANK CAPACITY _____ GALLONS
DRAIN FIELD _____ DEPTH _____ FEET, BOTTOM AREA _____ SQ. FT.
DEEP TRENCH _____ DEPTH _____ FEET, BOTTOM AREA _____ SQ. FT.
SEEPAGE PITS _____ ABSORBENT SIDE-WALL AREA _____ SQ. FT.
INLET PIPE _____ FT. BELOW ORIGINAL GRADE. MAXIMUM DEPTH _____ FT. BELOW ORIGINAL GRADE
EFFECTIVE DEPTH AT _____ FT. BELOW ORIGINAL GRADE.
LOCATE DISPOSAL AREA _____ FT. FROM _____ LOT LINE AND _____ FT. FROM _____ LOT LINE AS SEEN WHEN
FACING LOT FROM

REPAIR - Call for an appointment when ground is opened up and Sanitation will
recommend the repair system.

PLANS APPROVED BY Palmer F. Wine DATE 10/4/82

COVER NO WORK UNTIL INSPECTED AND APPROVED.

NEITHER THE HOWARD COUNTY COUNCIL NOR THE HEALTH DEPARTMENT IS RESPONSIBLE FOR THE SUCCESSFUL OPERATION OF ANY SYSTEM.

NOTE: IF TRENCH IS USED CALL FOR INSPECTION BEFORE PLACING GRAVEL IN TRENCH.

NOTE: NO DRY WELL SHALL EXCEED 15 FOOT IN DIAMETER.


NOTE: ALL PIPE FROM HOUSE TO DISPOSAL AREA MUST BE CAST IRON.

PERMIT VOID AFTER THREE YEARS.

NOTE: INSTALL STAND PIPE ON SEPTIC TANK AND DRY WELL. STAND PIPES MUST BE 6 INCHES IN DIAMETER. CAST IRON, CONCRETE OR TERRAZO ACCEPTED.

*INSTALLER IS RESPONSIBLE FOR OBTAINING FINAL APPROVAL ON THIS PERMIT.

X
P 32216

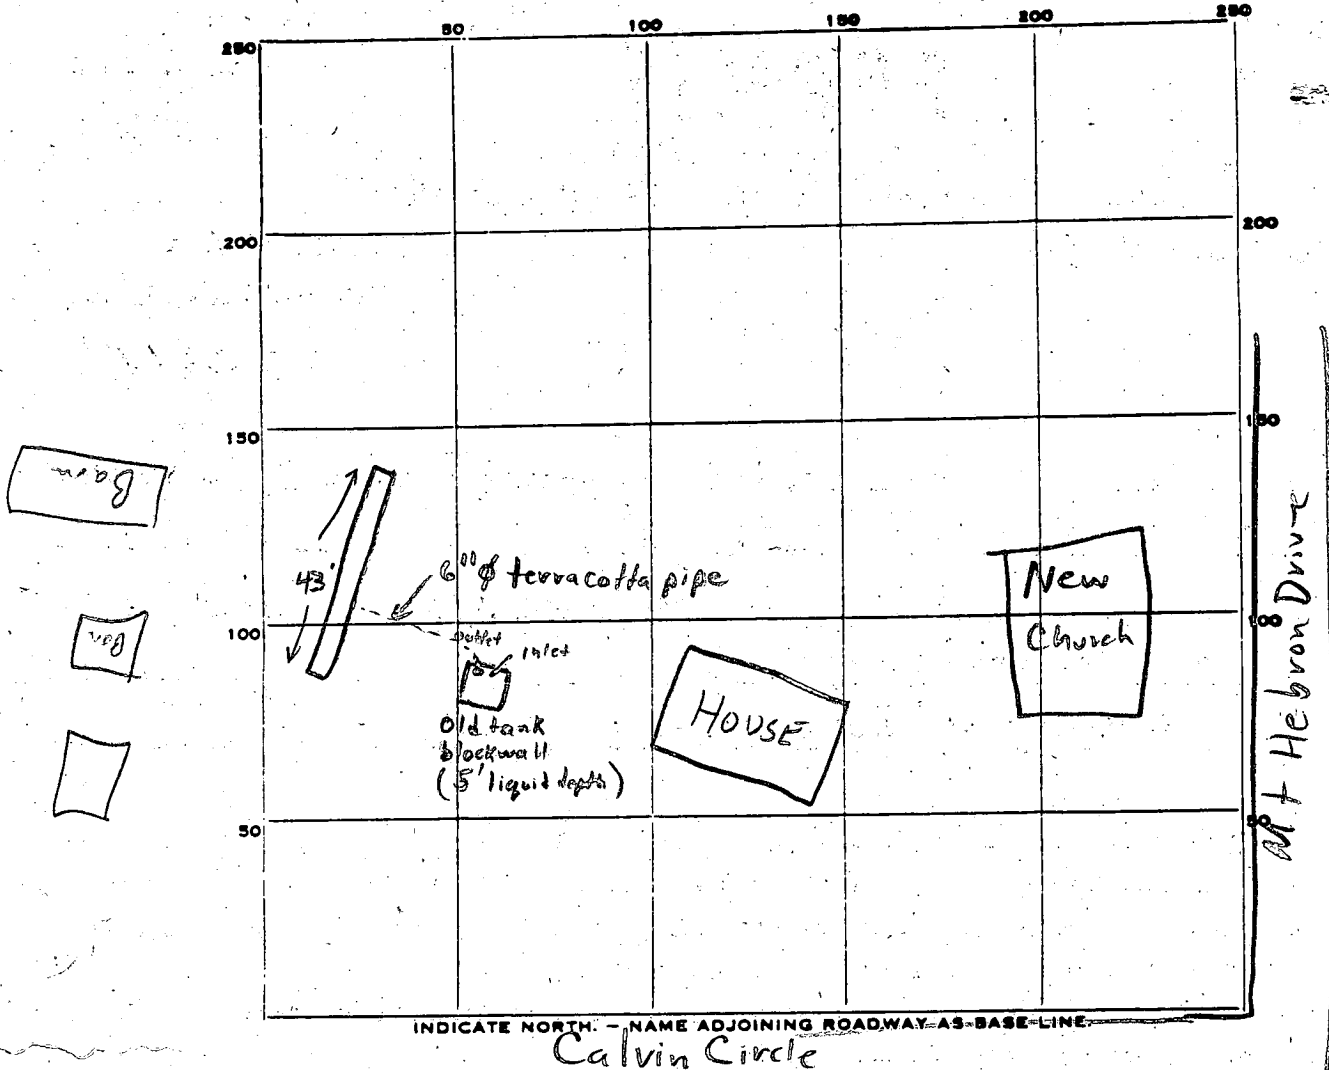

PERMIT CARD ☒ OK signed F.S.

SEPTIC TANK, LEVEL existing

CLEANOUTS _____

DISTRIBUTION BOX, LEVEL n.a.

TILE FIELD, DEPTH 9 FT. TRENCH WIDTH 2 FT.

GRAVEL DEPTH 8 FT. TOTAL LENGTH 43' FT.

NUMBER OF TRENCHES 1 ONE SIDE TOTAL BOTTOM AREA + 322 sq

SEEPAGE PITS, INSIDE DIAMETER - FT. DEPTH BELOW INLET 7 1/2 FT.

ABSORBENT AREA + 322 SQ. FT.

REMARKS 10/19/82 Spoke to E. Frogg & F. Baker, O.K. to put gravel in trench; septic tank must be pumped out F.S.

DATE SYSTEM APPROVED 10/19/82

INSPECTOR F. Skinner

43
28
215
301

APPLICATION

*Repair
perc*

*4/4/79 - cancelled
9:30 P.M.*

*4/12/79
9:30 A.M.*

SEWAGE DISPOSAL TESTING

STATE OF MARYLAND - DEPARTMENT OF HEALTH AND MENTAL HYGIENE

A _____

P _____

HOWARD COUNTY HEALTH DEPARTMENT
ENVIRONMENTAL HEALTH SERVICES

P.O. BOX 476 ELLICOTT, MARYLAND 21043
TELEPHONE: 992-2330

DISTRICT 2nd

DATE 4/3/79

TO: THE COUNTY HEALTH OFFICER
ELLICOTT CITY, MARYLAND

I, HEREBY, APPLY FOR THE NECESSARY TEST IN ORDER TO CONSTRUCT (OR RECONSTRUCT) A SEWAGE DISPOSAL SYSTEM.

PROPERTY OWNER Tenant House on Church Property Mt. Hebron Presbyterian Church
(tenant house)
ADDRESS Mt. Hebron Drive, Ellicott City, Md. PHONE _____

PROPERTY LOCATION:

SUBDIVISION _____ LOT NO. _____

ROAD AND DESCRIPTION Mt. Hebron Drive - straight on back until you see a Blue Dodge pick-up
On same road (Driveway as Fessers 2310

SIZE OF LOT ? TYPE BLDG. ?

THE SYSTEM INSTALLED UNDER THIS APPLICATION IS ACCEPTABLE ONLY UNTIL PUBLIC FACILITIES BECOME AVAILABLE.

I FULLY UNDERSTAND THE FEE CONNECTED WITH THE FILING OF THIS PERC TEST APPLICATION IS NON-REFUNDABLE UNDER ANY CIRCUMSTANCES.

SIGNATURE OF APPLICANT /s/ Jenkins Brothers

APPROVED BY _____ FOR _____ DATE _____


REJECTED BY _____ FOR _____ DATE _____

HOLD PENDING FURTHER TESTS _____ DATE _____

Repair existing house 4/12/79 recommend a 15' x 15' dry well
REASONS FOR REJECTION OR HOLDING inlet 2' and maximum depth - 10' location in D. hole
area 19' towards church from septic tank cleanout
and stay at least 20' off any part of house. C.B.D. Limited area - see dry well

THIS IS NOT A PERMIT

07

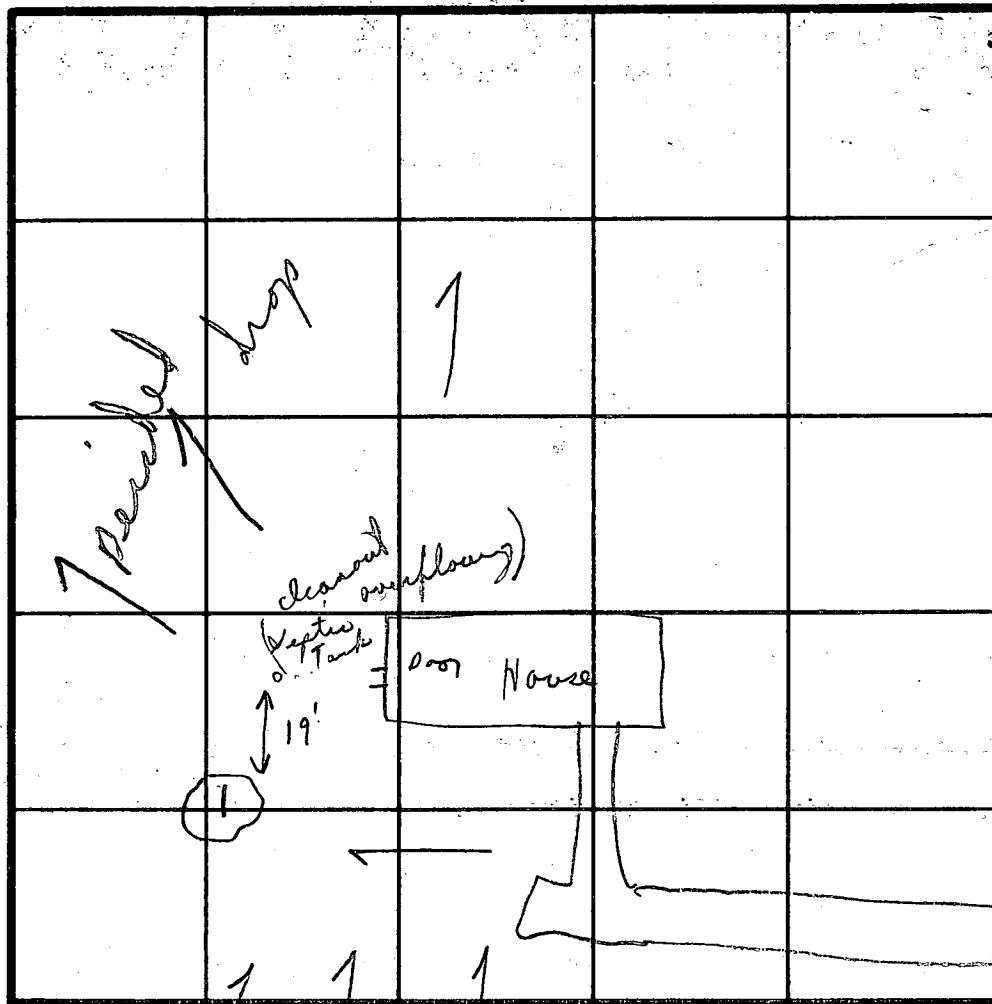

INDICATE NORTH - NAME ADJOINING ROADWAY AS BASE LINE

[illegible]

2'-10' (Mud)
Well) Depth

REMARKS

TYPE OF SOIL

TESTED BY

Public water in -
Public sewer to be in - 1-3 years per the

C. B. ~~2~~

ALSO PRESENT

Mr. Jenkins
Mr. Allen