

5/5/83
5/6/83
ready to go
G.M. please

PERMIT

SEWAGE DISPOSAL SYSTEM

MARYLAND STATE DEPARTMENT OF HEALTH

HOWARD COUNTY

BUREAU OF ENVIRONMENTAL HEALTH

992-2330

03-281248

INDEXED

P 32572

A Repair

APPROVED 5/5/83
JS/cw

ELLICOTT CITY

DISTRICT 3rd

3/21/83

DATE XXX/XXX/XXX

George W. Burgess

Herman Lark

IS PERMITTED TO INSTALL _____ ALTER X

ADDRESS 13176 Triadelphia Road, Ellicott City, Md. 21043 PHONE 531-3697

SUBDIVISION _____ ROAD 13176 Triadelphia Road LOT _____

PROPERTY OWNER George W. Burgess

ADDRESS same as above

IF GARBAGE GRINDER IS USED INCREASE SEPTIC TANK CAPACITY BY 50% AND ABSORPTION AREA BY 22%.

GARBAGE GRINDER? YES _____ NO _____

SEPTIC TANK CAPACITY 1000 GALLONS NUMBER OF BEDROOMS 3

REPAIR - Call for an appointment when ground is opened up and Sanitarian will recommend the repair system.

Complete system - 1000 gal. septic tank
70ft trench - inlet 3ft max 10ft with 7ft
of stones. 15-8 sq. ft per bedroom.

Location - start trench 95ft from Triadelphia
Rd and 95ft from left property line. Trench
to run towards left front property line JS

PLANS APPROVED BY Palmer F. Wine DATE 3/21/83

COVER NO WORK UNTIL INSPECTED AND APPROVED.

NEITHER THE HOWARD COUNTY COUNCIL NOR THE HEALTH DEPARTMENT IS RESPONSIBLE FOR THE SUCCESSFUL OPERATION OF ANY SYSTEM.

NOTE: IF TRENCH IS USED CALL FOR INSPECTION BEFORE AND AFTER PLACING GRAVEL IN TRENCH.

NOTE: NO DRY WELL SHALL EXCEED 15 FOOT IN DIAMETER. NO ABSORPTION TRENCH TO EXCEED 100 FEET IN LENGTH.

NOTE: ALL PIPE FROM HOUSE TO SEPTIC TANK MUST BE CAST IRON OR SCHEDULE 40 PVC OR ABS.

PERMIT VOID AFTER THREE YEARS.


NOTE: INSTALL STAND PIPE ON SEPTIC TANK AND DRY WELL. STAND PIPES MUST BE 6 INCHES IN DIAMETER. CAST IRON, CONCRETE OR TERRA COTTA, OR PVC OR ABS ACCEPTED. IF TOP OF SEPTIC TANK IS DEEPER THAN 3 FEET MANHOLE TO GRADE REQUIRED.

*INSTALLER IS RESPONSIBLE FOR OBTAINING FINAL APROVAL ON THIS PERMIT

*CALL 992-2330 FOR INSPECTION OF SEPTIC SYSTEMS.

EH - 2-1082

P 32572

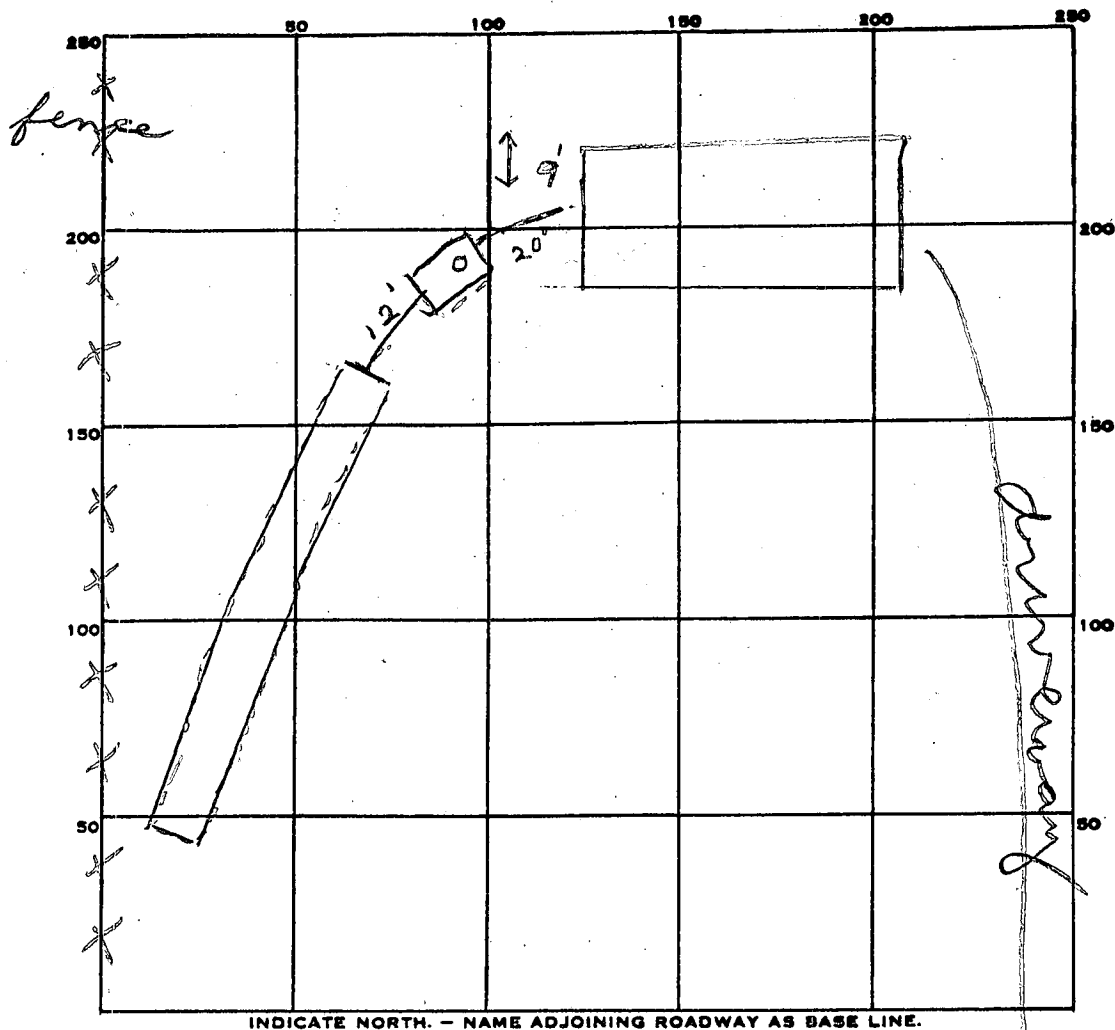

INDICATE NORTH. - NAME ADJOINING ROADWAY AS BASE LINE.

PERMIT CARD ☒

Philadelphia Rd

SEPTIC TANK, LEVEL ☒

1000

CLEANOUTS ☒

ST

DISTRIBUTION BOX, LEVEL ☐

TILE FIELD, DEPTH 10 FT.

TRENCH WIDTH 2 FT.

GRAVEL DEPTH 7 IN.

TOTAL LENGTH 70 FT.

NUMBER OF TRENCHES 1

TOTAL BOTTOM AREA

SEEPAGE PITS, INSIDE DIAMETER FT.

DEPTH BELOW INLET FT.

ABSORBENT AREA SQ. FT.

REMARKS 5/5/83 OK to add stone in trench fs

5/5/83 OK to cover all work to septic tanks.

Must see house connections, call when ready fs

NO RECORD OF FINAL INSPECTION REQUEST AS OF 7/17/95

IN DEX AS APPROVED (CW)

DATE SYSTEM APPROVED 5/5/83

INSPECTOR JS/CW

APPLICATION

SEWAGE DISPOSAL TESTING

STATE OF MARYLAND - DEPARTMENT OF HEALTH AND MENTAL HYGIENE

HOWARD COUNTY HEALTH DEPARTMENT
ENVIRONMENTAL HEALTH SERVICES

P. O. BOX 476 ELLICOTT CITY, MARYLAND 21043
TELEPHONE: 992-2330

DISTRICT _____

DATE _____

A Repair
P 32572

TO: THE COUNTY HEALTH OFFICER
ELLICOTT CITY, MARYLAND

I, HEREBY, APPLY FOR THE NECESSARY TEST IN ORDER TO CONSTRUCT (OR RECONSTRUCT) A SEWAGE DISPOSAL SYSTEM.

PROPERTY OWNER George W. Burgess

ADDRESS 13176 Treadelphus Rd PHONE 531-3197

PROPERTY LOCATION:

SUBDIVISION N/A LOT NO. _____

ROAD AND DESCRIPTION Tax map 22, parcel 198 (existing house)

SIZE OF LOT 2/acre TYPE BLDG. 2
(NUMBER OF BEDROOMS)

THE SYSTEM INSTALLED UNDER THIS APPLICATION IS ACCEPTABLE ONLY UNTIL PUBLIC FACILITIES BECOME AVAILABLE. I FULLY UNDERSTAND THE
FEE CONNECTED WITH THE FILING OF THIS PERC TEST APPLICATION IS NON-REFUNDABLE UNDER ANY CIRCUMSTANCES. I ALSO AGREE TO COMPLY

WITH ALL M.O.S.H.A. REQUIREMENTS IN TESTING THIS LOT. George W. Burgess
(SIGNATURE OF APPLICANT)

APPROVED BY _____ FOR _____ DATE _____

REJECTED BY _____ FOR _____ DATE _____



HOLD PENDING FURTHER TESTS _____ DATE _____

REASONS FOR REJECTION OR HOLDING _____

THIS IS NOT A PERMIT

①

SOIL PROFILE

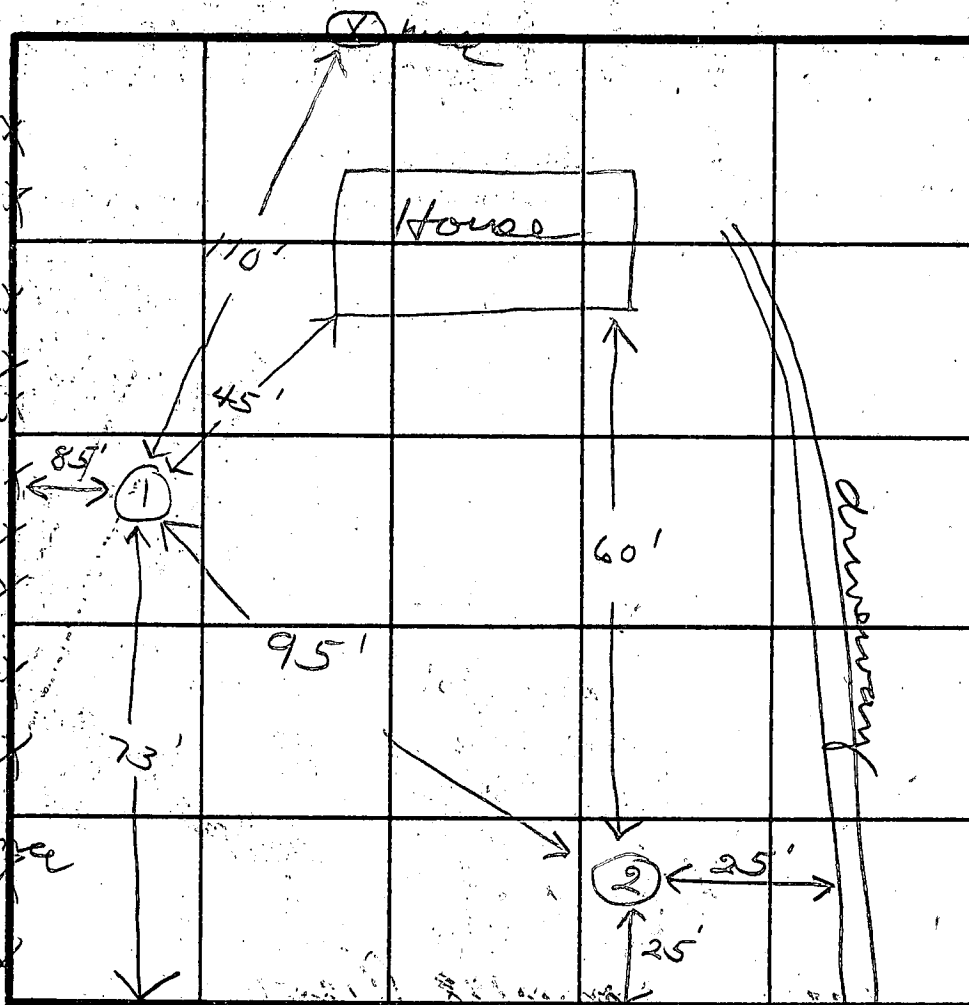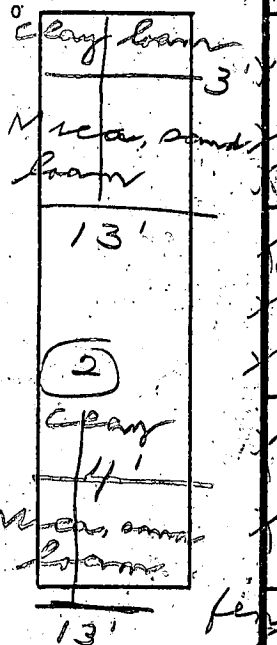

INDICATE NORTH - NAME ADJOINING ROADWAY AS BASE LINE.

Tradelphia Rd

Inlet 3'

Main 10'

158 sq. ft

Per volume

DATE	TEST NO.	DEPTH	PRE-WET		TEST - 1" DROP		TIME
			START	STOP	START	STOP	
4/5/83	1 S	3	9:35	9:40	9:40	9:45	5
	M	8	9:38	9:40	9:40	9:42	2
	2 S	3	9:53	10:05	10:05	10:20	15
	D	13					

See drawing other sheet

REMARKS Trench to start 9.5 ft from Tradelpia Rd, & 9.5 ft from left prop. line. Trench to run toward left front corner property.

TYPE OF SOIL

TESTED BY

JS

ALSO PRESENT

H. Sisk

9:30 AM
H/C/RB

APPLICATION

SEWAGE DISPOSAL TESTING

STATE OF MARYLAND · DEPARTMENT OF HEALTH AND MENTAL HYGIENE

HOWARD COUNTY HEALTH DEPARTMENT
ENVIRONMENTAL HEALTH SERVICES
P. O. BOX 476 ELLICOTT CITY, MARYLAND 21043
TELEPHONE: 992-2330

A Repair
P P32572

DISTRICT _____

DATE _____

TO: THE COUNTY HEALTH OFFICER
ELLICOTT CITY, MARYLAND

I, HEREBY, APPLY FOR THE NECESSARY TEST IN ORDER TO CONSTRUCT (OR RECONSTRUCT) A SEWAGE DISPOSAL SYSTEM.

PROPERTY OWNER George W. Burgess
ADDRESS 13176 Trudolph Rd PHONE 531-3697

PROPERTY LOCATION:

SUBDIVISION N/A LOT NO. _____
ROAD AND DESCRIPTION tax map 22, parcel 98 (existing house)

SIZE OF LOT ~1 acre TYPE BLDG. 2
(NUMBER OF BEDROOMS)

THE SYSTEM INSTALLED UNDER THIS APPLICATION IS ACCEPTABLE ONLY UNTIL PUBLIC FACILITIES BECOME AVAILABLE. I FULLY UNDERSTAND THE
FEE CONNECTED WITH THE FILING OF THIS PERC TEST APPLICATION IS NON-REFUNDABLE UNDER ANY CIRCUMSTANCES. I ALSO AGREE TO COMPLY
WITH ALL M.O.S.H.A. REQUIREMENTS IN TESTING THIS LOT. George W. Burgess
(SIGNATURE OF APPLICANT)

APPROVED BY _____ FOR _____ DATE _____

REJECTED BY _____ FOR _____ DATE _____


HOLD PENDING FURTHER TESTS _____ DATE _____

REASONS FOR REJECTION OR HOLDING _____

THIS IS NOT A PERMIT

SOIL PROFILE

0'

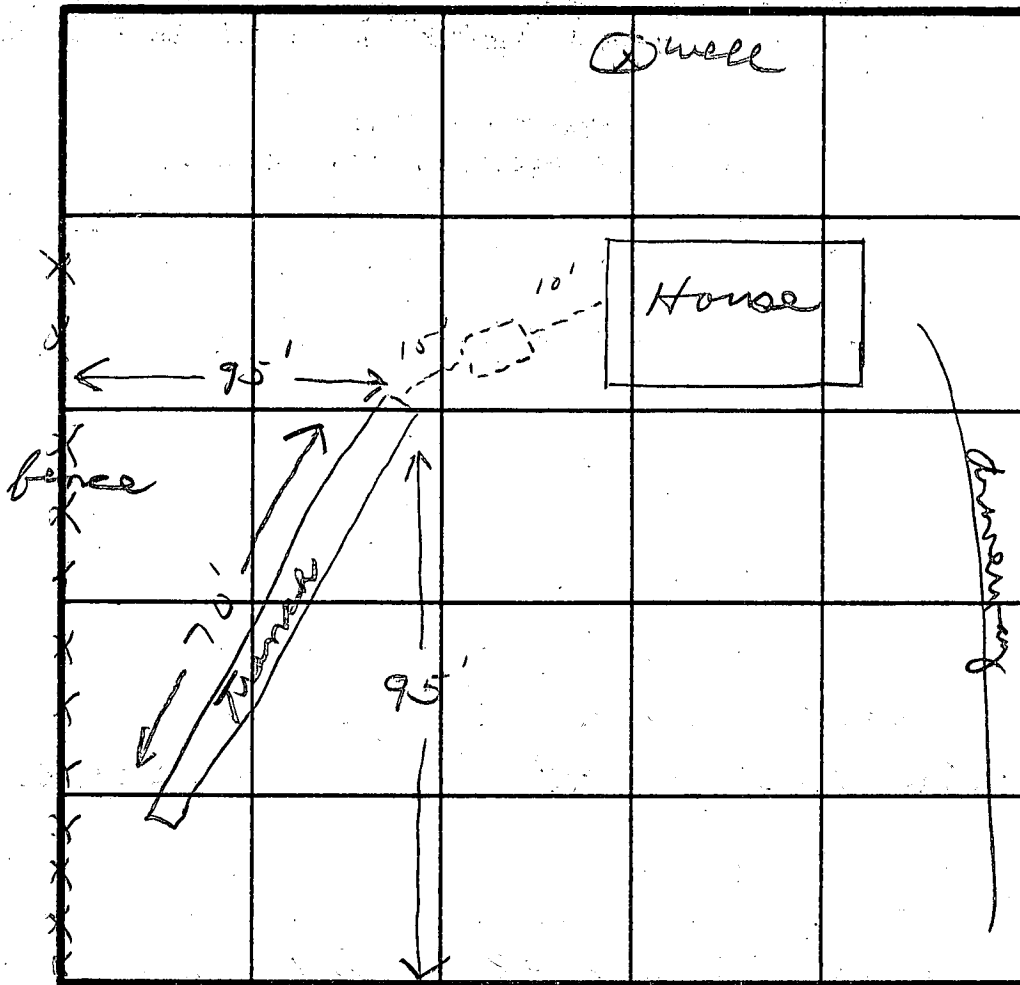

INDICATE NORTH - NAME ADJOINING ROADWAY AS BASE LINE.
Philadelphia Rd

DATE	TEST NO.	DEPTH	PRE-WET		TEST - 1" DROP		TIME
			START	STOP	START	STOP	

REMARKS _____

TYPE OF SOIL _____

TESTED BY _____ ALSO PRESENT _____