

2-16-98
ASAP

PERMIT

SEWAGE DISPOSAL SYSTEM

MARYLAND STATE DEPARTMENT OF HEALTH

HOWARD COUNTY

BUREAU OF ENVIRONMENTAL HEALTH
461-9933

(INDEXED)

04-344723

P 40852

A 31158

DISTRICT 4th

DATE 1/22/88

DATE SYSTEM APPROVED 2-16-88

INSPECTOR JEN

Arnold Backhoe & Septic Services, Inc.

IS PERMITTED TO INSTALL X ALTER

ADDRESS P. O. Box 15, Woodbine, Maryland 21797 PHONE 795-7873

SUBDIVISION Patapsco Overlook ROAD ⁶¹³~~621~~ Weller Drive LOT 14

PROPERTY OWNER Robert Goddard

ADDRESS

IF GARBAGE GRINDER IS USED INCREASE SEPTIC TANK CAPACITY BY 50% AND ABSORPTION AREA BY 22%.

GARBAGE GRINDER? YES NO X

SEPTIC TANK CAPACITY 1000 GALLONS NUMBER OF BEDROOMS 3

150 ft trench
4 / 600
4
20
20

TRENCHES - 200 sq. ft. per bedroom. Trench to be 2 feet wide. Inlet maximum depth 3 feet below original grade. Bottom maximum depth 7 feet below original grade. Effective area begins at 3 feet below original grade. 4 feet of stone below distribution pipe.

LOCATION - Start first trench 200 feet from the rear lot line and 130 feet from the left lot line as seen when facing the property from Weller Drive. Run trenches along contour toward left side of property.

NOTE - No trench to exceed 100 feet in length. Provide 6" - 8" diameter cleanout and cap to grade or above on septic tank. ok/cw

PLANS APPROVED BY C. Williams DATE 12/29/86

COVER NO WORK UNTIL INSPECTED AND APPROVED.

NEITHER THE HOWARD COUNTY COUNCIL NOR THE HEALTH DEPARTMENT IS RESPONSIBLE FOR THE SUCCESSFUL OPERATION OF ANY SYSTEM.

NOTE: CLEANOUT REQUIRED EVERY 70 FEET OF SEWER LINE AND/OR AT 90° SWEEPS IN LINES FROM HOUSE TO DRAIN FIELDS.

NOTE: ALL PARTS OF SEPTIC SYSTEMS (I.E., TANK, DISTRIBUTION BOX, TRENCHES) TO BE 100 FEET FROM WELL (UNLESS OTHERWISE SPECIFICALLY AUTHORIZED)

NOTE: IF DEEP TRENCHES ARE USED CALL FOR INSPECTION BEFORE AND AFTER PLACING GRAVEL IN TRENCHES.

NOTE: NO DRY WELL SHALL EXCEED 15 FOOT IN DIAMETER. NO ABSORPTION TRENCH TO EXCEED 100 FEET IN LENGTH.

NOTE: ALL PIPE FROM HOUSE TO SEPTIC TANK MUST BE CAST IRON OR SCHEDULE 40 PVC OR ABS.

PERMIT VOID AFTER TWO YEARS.

NOTE: INSTALL STAND PIPE ON SEPTIC TANK AND DRY WELL. STAND PIPES MUST BE 6 INCHES IN DIAMETER. CAST IRON, CONCRETE OR TERRA COTTA OR PVC OR ABS ACCEPTED. IF TOP OF SEPTIC TANK IS DEEPER THAN 3 FEET, MANHOLE TO GRADE REQUIRED.

NOTE: DISTRIBUTION BOXES MUST HAVE BAFFLES.

*INSTALLER IS RESPONSIBLE FOR OBTAINING FINAL APPROVAL ON THIS PERMIT


*CALL 461-9933 FOR INSPECTION OF SEPTIC SYSTEMS.

EH - 2-1186

A 31158

2-16-88
WPI

Well line, and
electrical line
ok at house
connection.
Trench partially
covered.
Pitless adaptor
at 44 inches.
No tank installed
yet. JENadeau

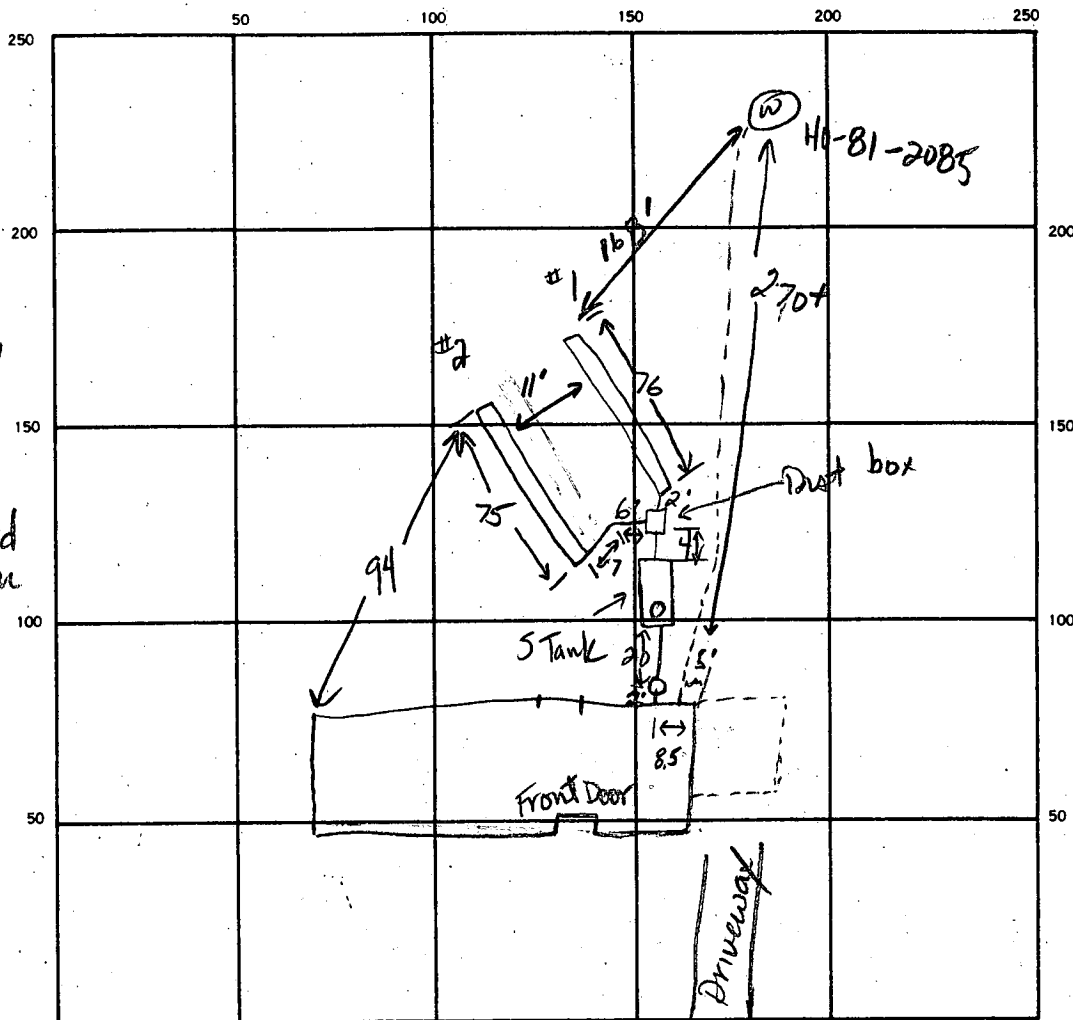

INDICATE NORTH. — NAME ADJOINING ROADWAY AS BASE LINE.

Weller Drive

39
24
156
78
936

112
24
448
224
2688

70
24
280
140
168


SEPTIC TANK. LEVEL 1000 gal CLEANOUTS one in line, one on septic tank
DISTRIBUTION BOX. LEVEL ok w/ baffle
DRAIN FIELD/TILE FIELD. DEPTH 7 7 FT. TRENCH WIDTH 2 FT. INLET DEPTH 3 3 FT.
EFFECTIVE GRAVEL DEPTH 7 7 FT. TOTAL LENGTH 76 75 FT.
NUMBER OF TRENCHES 2 ONE SIDEWALL/BOTTOM AREA 304 300 SQ. FT.
DRYWELL INSIDE DIAMETER FT. EFFECTIVE DEPTH BELOW INLET FT.
ABSORBENT AREA 604 SQ. FT.

REMARKS 2-16-88 ok to add stone, pipe and paper to both trenches.
OK to cover to distribution box and trench #1. JENadeau
2-16-88 ok to cover trench #2 and all other work. JEN

DATE SYSTEM APPROVED 2-16-88

INSPECTOR Jane E. Nadeau

SEE HOWARD CO. DRIVEWAY
ENTRANCE DETAIL
R. 6.00. ENTRANCE SHALL
MEET EX. GRADES. REPAIR
CURE AS NEEDED.

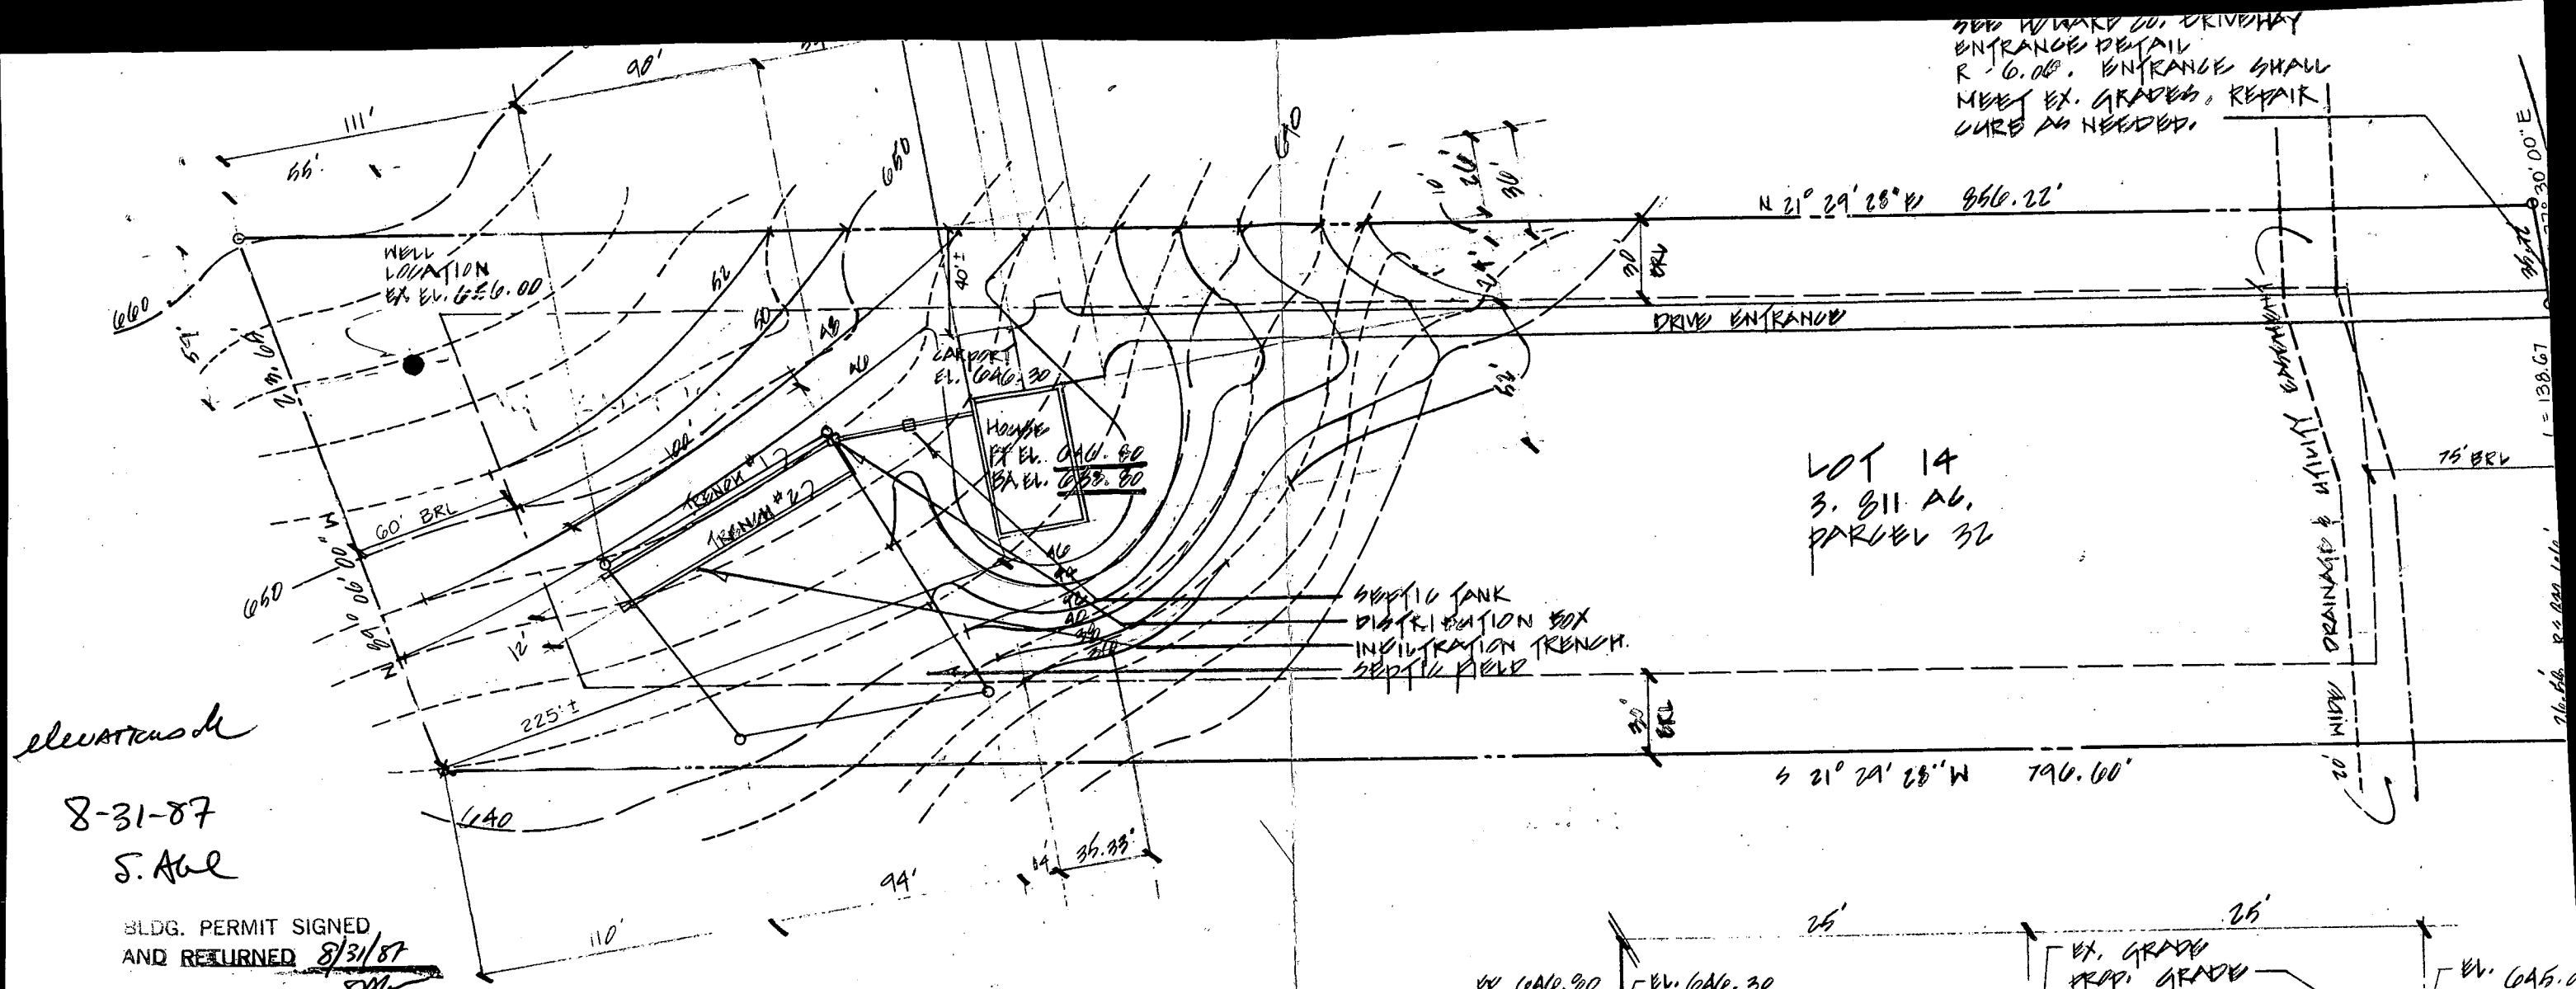

LOT 14
3.811 AC.
PARCEL 32


elevations in
8-31-87
S. Aul

BLDG. PERMIT SIGNED
AND RETURNED 8/31/87
886

KEY
--- EXISTING CONTOURS
--- PROPOSED CONTOURS
BP14093

ELEVATIONS.
EL. 643.30 INV. EL. OUT OF HOUSE (-BSMT)
EL. 642.80 INV. EL. INTO SEPTIC TANK
EL. 642.50 INV. EL. OUT SEPTIC TANK
EL. 645.00 EX. EL. AT SEPTIC TANK
EL. 642.00 INV. EL. INTO DIST. BOX.
EL. 645.00 EX. EL. AT DIST. BOX.
EXISTING ELEVATION AT TRENCHES:
#1 EL. 645.00
#2 EL. 644.50
EL. 641.90 INV. INTO TRENCH

NOTES
- ALL TRENCHES SHALL BE 2' WIDE.
- INSTALL 4' OF GROUND BELOW DISTRIBUTION PIPE.
- TRENCHES SHALL BE INSTALLED ON LEVEL GROUND.
- CALL FOR HOWARD CO. INSPECTION OF TRENCHES
BEFORE GRAVEL IS INSTALLED.
- PROVIDE 6" - 8" DIA. CLEANOUT AND CAP TO
GRADE ON SEPTIC TANK AND DISTRIBUTION BOX.
- TOPOGRAPHY INFORMATION TAKEN FROM
PLAN PREPARED BY BOENDER ASSOCIATES
MARCH, 1981.
- PLAN PREPARED FOR MR. ROBERT GODDARD.
(301) 465-0528.

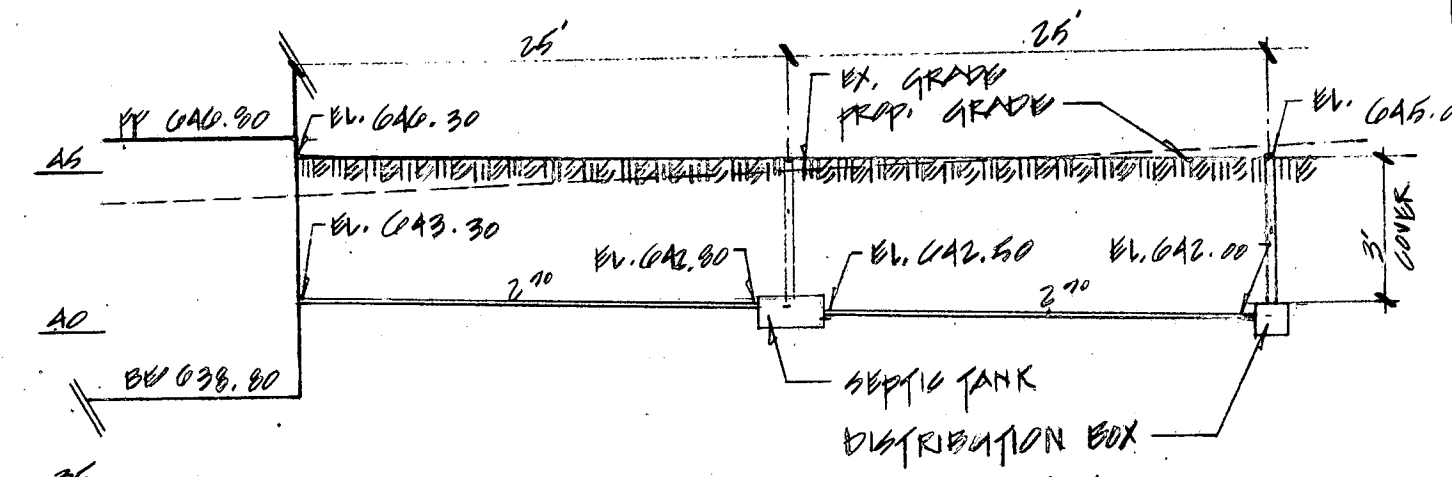

CROSS SECTION SEPTIC SYSTEM
SCALE: VERT: 1"=6'
HOR: 1"=6'

SITE PLAN - SEPTIC DESIGN
LOT 14 - PATAPSCO OVERLOOK SUBDIVISION
TAX MAP 2, ZONED R, RECORD PLAT # 6782
4TH ELECTION DIST. HOWARD CO. MD.
SCALE: 1"=60'-0" DATE: 7/23/87

REVISED 8/25/81 AS PER HEALTH
DEPT. COMMENTS.

I CERTIFY THAT THE ABOVE MEASUREMENTS AND
ELEVATIONS ARE ACTUAL AND CORRECT FOR THIS PROPERTY.

APPLICATION

3/1/58

SEWAGE DISPOSAL TESTING

P. _____

STATE OF MARYLAND - DEPARTMENT OF HEALTH AND MENTAL HYGIENE

HOWARD COUNTY HEALTH DEPARTMENT
ENVIRONMENTAL HEALTH SERVICES

P. O. BOX 476, ELLICOTT CITY, MARYLAND 21043
TELEPHONE: 465-5000, EXT. 356

DISTRICT 4th

DATE 2/9/81

TO: THE COUNTY HEALTH OFFICER
ELLICOTT CITY, MARYLAND

I, HEREBY, APPLY FOR THE NECESSARY TEST IN ORDER TO CONSTRUCT (OR RECONSTRUCT) A SEWAGE DISPOSAL SYSTEM.

PROPERTY OWNER Georgia Ave. Properties Inc.

ADDRESS c/o E. Brook Lee III, 13838 Ga. Ave, Wheaton Md. PHONE _____

PROPERTY LOCATION:

SUBDIVISION Georgia Ave Properties LOT NO. 14

ROAD AND DESCRIPTION Md. Rte. 94 and Old Frederick Rd.

SIZE OF LOT 3 ac + TYPE BLDG. 3 or 4

IF NOT SINGLE RESIDENCE DESCRIBE NA NUMBER OF BEDROOMS _____

THE SYSTEM INSTALLED UNDER THIS APPLICATION IS ACCEPTABLE ONLY UNTIL PUBLIC FACILITIES BECOME AVAILABLE.

SIGNATURE OF APPLICANT [Signature]
Agent

APPROVED BY _____ FOR _____ DATE _____
(KIND OF SYSTEM)




REJECTED BY _____ FOR _____ DATE _____
(KIND OF SYSTEM)

HOLD PENDING FURTHER TESTS _____ DATE _____

REASONS FOR REJECTION OR HOLDING _____

THIS IS NOT A PERMIT

207124

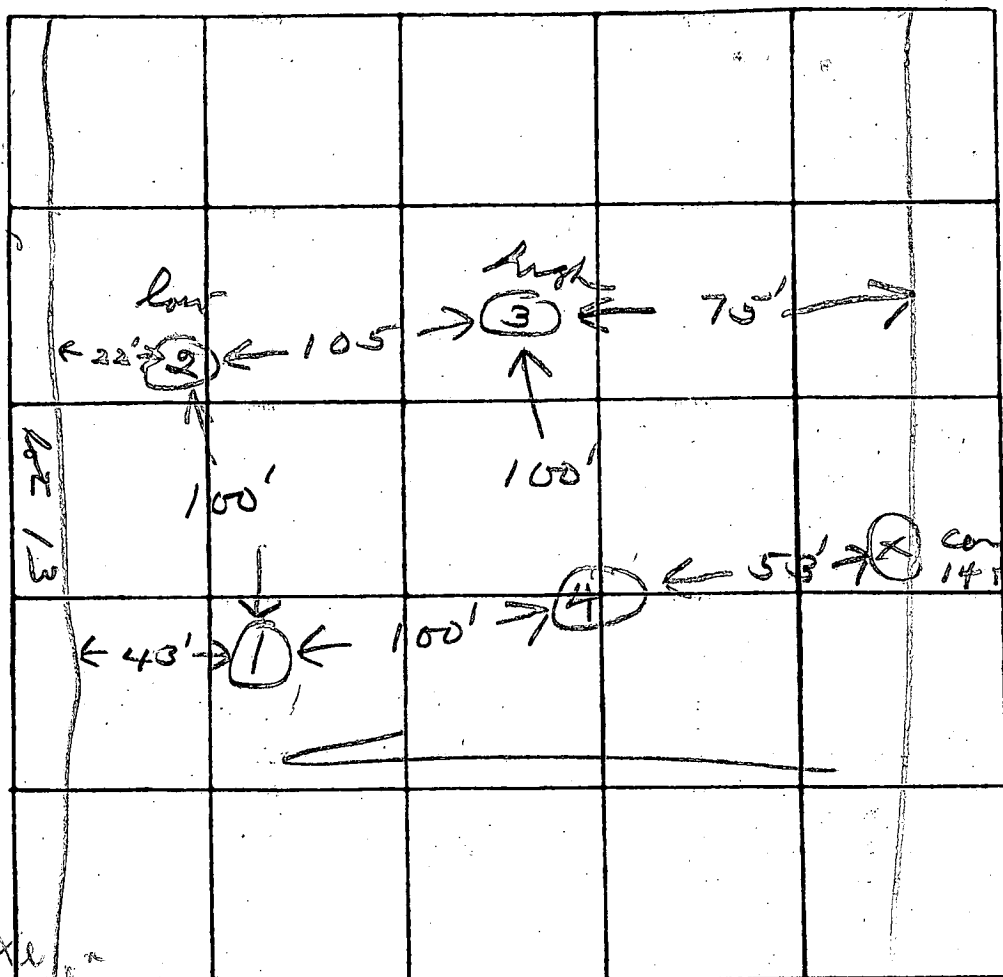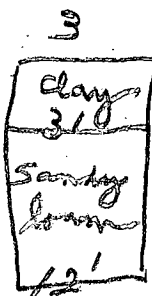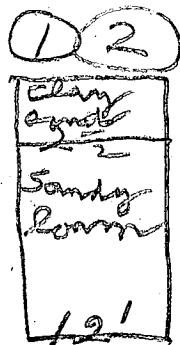

INDICATE NORTH. - NAME ADJOINING ROADWAY AS BASE LINE

ROAD A

[illegible]

under
3!

8 min

48

REMARKS

TYPE OF SOIL

TESTED BY

ALSO PRESENT

Dense Nodules

APPLICATION

PERCOLATION TESTING

HOWARD COUNTY HEALTH DEPARTMENT
BUREAU OF ENVIRONMENTAL HEALTH
P.O. BOX 476 ELLICOTT CITY, MARYLAND 21043
TELEPHONE: 461-9933

A 38439

P _____

DISTRICT 4th

DATE 1-19-87

TO: THE COUNTY HEALTH OFFICER
ELLICOTT CITY, MARYLAND

I, HEREBY, APPLY FOR THE NECESSARY TEST IN ORDER TO CONSTRUCT (OR RECONSTRUCT) A SEWAGE DISPOSAL SYSTEM.

PROPERTY OWNER ROBERT W. GODDARD

ADDRESS 6802 RICHARDSON RD BALTO MD 21207 PHONE 298-5359

PROSPECTIVE BUYER _____

ADDRESS _____ PHONE _____

PROPERTY LOCATION:

SUBDIVISION PATAPSCO OVERLOOK SEC. 2 LOT NO. NEW LOT 3
14 SECT 2

ROAD AND DESCRIPTION WELLER DRIVE Per

TAX MAP 2 PARCEL # 32

SIZE OF LOT 3.811 ACRES TYPE BLDG. SINGLE FAMILY DWELLING
(SINGLE FAMILY DWELLING OR COMMERCIAL)

THE SYSTEM INSTALLED UNDER THIS APPLICATION IS ACCEPTABLE ONLY UNTIL PUBLIC FACILITIES BECOME AVAILABLE. I FULLY UNDERSTAND THE FEE CONNECTED WITH THE FILING OF THIS PERC TEST APPLICATION IS NON-REFUNDABLE UNDER ANY CIRCUMSTANCES. I ALSO AGREE TO COMPLY WITH ALL M.O.S.H.A. REQUIREMENTS IN TESTING THIS LOT.

(SIGNATURE OF APPLICANT)

APPROVED BY _____ FOR _____ DATE _____

REJECTED BY _____ FOR _____ DATE _____

HOLD PENDING FURTHER TESTS _____ DATE _____

REASONS FOR REJECTION OR HOLDING 2/6/87 - RECOMMEND USE

ORIGINAL TEST AREA, RETEST - ROLL, WATER
TOO SLOW & TOO FAST PERC TEST R12


THIS IS NOT A PERMIT

*ok to pass
owner's wife contacted
update. 5/8/87*

32 45 7 2
52 7 2
OUT

SOIL PROFILE

CLAY
BROWN
GRAY
SAND
LOAM
SOME
SPAL

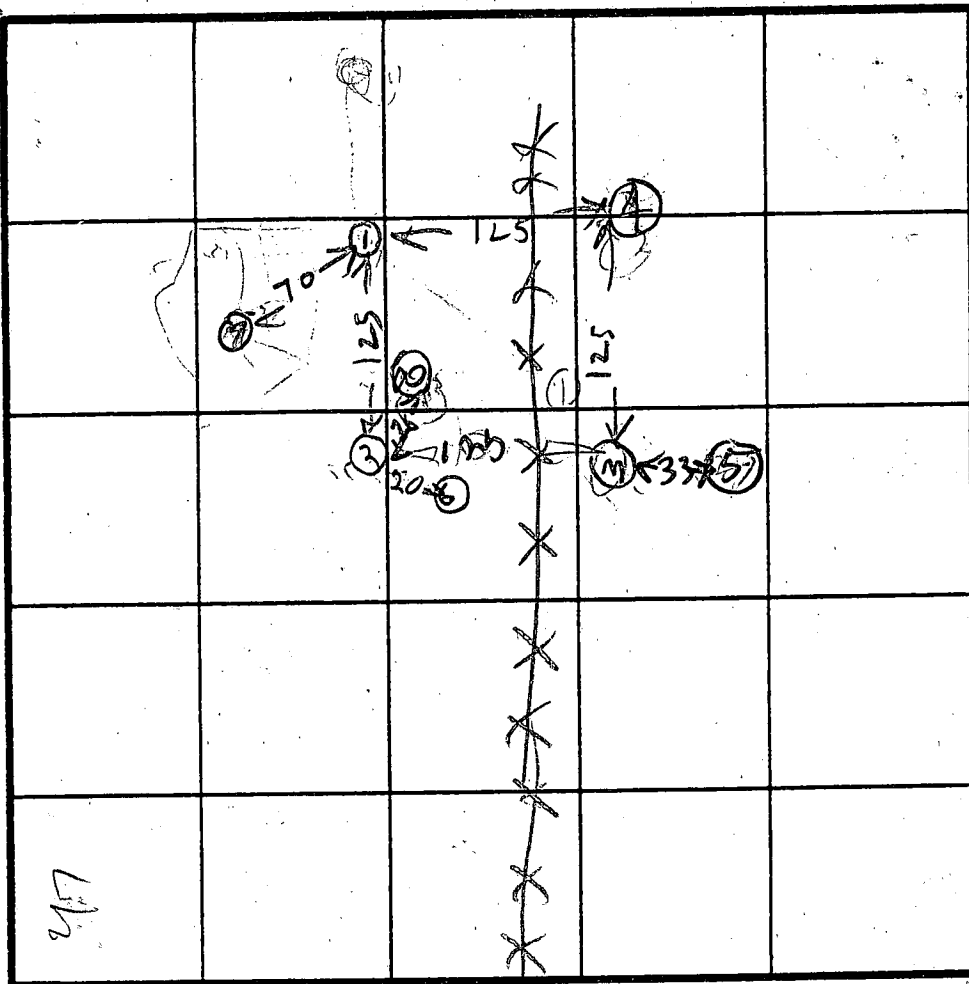

HOLE
ELEVATION
①② HIGH
③④ LOW

INDICATE NORTH - NAME ADJOINING ROADWAY AS BASE LINE.

WAGON BINE RD

DATE	TEST NO.	DEPTH	PRE-WET		TEST - 1" DROP		TIME
			START	STOP	START	STOP	
2/6/27	1B	8	211	213	213	225	13
	1S	4	214	218	218	225	7
	IV	13	OK				
	2B	7.5	225	232	232	245	13
	2S	4	230	232	232	245	13
	2V	11	ROCK BOTTOM				
	3S	3	240	252	252	307	15
	3D	6.5	240	244	244	248	4
	3V	12	WATER 11 FT				
	4S	4	256	327	327	308	7
	4D	8.5	256	302	302	308	7
	4V	14	WATER 13.5 FT				
	5V	19	WATER 9 FT				
2/6/27	6V	10	ROCK BOTTOM				
	7V	2	ROCK BOTTOM				

Too Fast

②
SANDY
BOYB
SHALE
SANDY
BOYB
SHALE
HARD
BOTTOM

③
CLAY
BOYB
SHALE
BROWN
SAND
LOAM
BOYB
SHALE
WATER

④
CLAY
SAND
LOAM
BOYB
SHALE
WATER

REMARKS

Holer Dug Differently Than staked by surveyor

See Page 2 for Visual / to be

R HODGES

TYPE OF SOIL

TESTED BY

ALSO PRESENT

BOB and Wayne

Robert Goodland

512°30'00"W
50.00'

24

MATCH LINE SEE SHEET 2 OF 3

S 21° 29' 28" W

900.27'

LOT 15
4.084 AC.

E 780,000
N 55° 33' 50" E

B.R.L.

DRIVE

S 70° 53' 07" E
157.00'

N 21° 29' 28" E

856.22'

B.R.L. INDICATES
BUILDING RESTRICTION LINES

LOT 14
3.811 AC.

NEW
LOT 3
not

20' WIDE DRAINAGE
AND UTILITY EASEMENT
1000' x 1000'

S 21° 29' 28" W

796.60'

LOT 13
3500 AC.

20' DRAINAGE
AND UTILITY EASEMENT

FILL AREA NON-BUILDABLE
BECAUSE OF NON-COMPACTION

N 21° 29' 28" E

739.65'

LOT 12
3550 AC.

N 58° 04' 04" W
79.15'

GEORGIA AVENUE PROPERTIES
429/774

TOTAL AREA TABULATIONS

6

60'

216.35'

N 89° 06' 00" W

60'

213.65'

1,185.50'

60'

219.65'

60'

210.00'

30'

30'

75'

BR

BR


BR

BR

BR

A38439

NATAPSCO OVERLOOK Sect 2

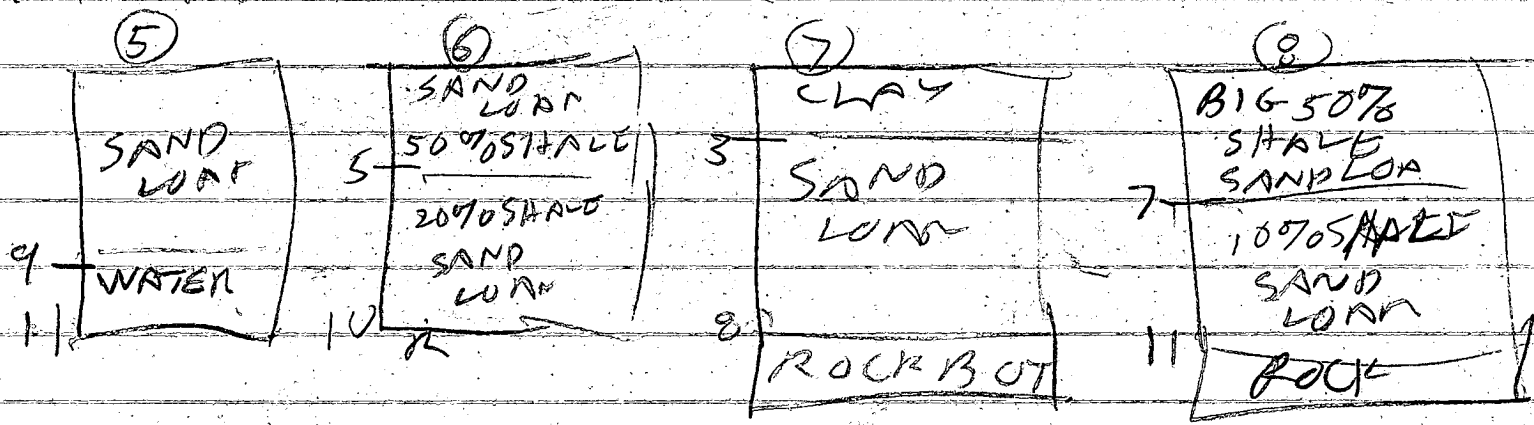

PRELIMINARY

APPLICATION

SEWAGE DISPOSAL TESTING

STATE OF MARYLAND - DEPARTMENT OF HEALTH AND MENTAL HYGIENE

HOWARD COUNTY HEALTH DEPARTMENT
ENVIRONMENTAL HEALTH SERVICES

P. O. BOX 473 ELLICOTT CITY, MARYLAND 21043
TELEPHONE: 992-2330

DISTRICT

4th

DATE

March 26, 1981

A 31258

P _____

TO: THE COUNTY HEALTH OFFICER
ELLICOTT CITY, MARYLAND

I, HEREBY, APPLY FOR THE NECESSARY TEST IN ORDER TO CONSTRUCT (OR RECONSTRUCT) A SEWAGE DISPOSAL SYSTEM:

PROPERTY OWNER Georgia Avenue Properties, Inc.

ADDRESS 13638 Georgia Avenue, Wheaton, Md 20906

Jack Boender
465-7777

PHONE

PROPERTY LOCATION:

SUBDIVISION Georgia Avenue

LOT NO.

24

ROAD AND DESCRIPTION Route 94 and Old Frederick Road

SIZE OF LOT 3 acres m/1

TYPE BLDG. 3 or 4 bedrooms

(NUMBER OF BEDROOMS)

THE SYSTEM INSTALLED UNDER THIS APPLICATION IS ACCEPTABLE ONLY UNTIL PUBLIC FACILITIES BECOME AVAILABLE. I FULLY UNDERSTAND THE FEE CONNECTED WITH THE FILING OF THIS PERC TEST APPLICATION IS NON-REFUNDABLE UNDER ANY CIRCUMSTANCES. I ALSO AGREE TO COMPLY WITH ALL M.O.S.H.A. REQUIREMENTS IN TESTING THIS LOT. /s/ Jack Boender for E. Brooke Lee, III

(SIGNATURE OF APPLICANT)

APPROVED BY _____ FOR _____ DATE _____

REJECTED BY _____ FOR _____ DATE _____



HOLD PENDING FURTHER TESTS _____ DATE _____

REASONS FOR REJECTION OR HOLDING _____

THIS IS NOT A PERMIT

LOT 24

① SOIL PROFILE

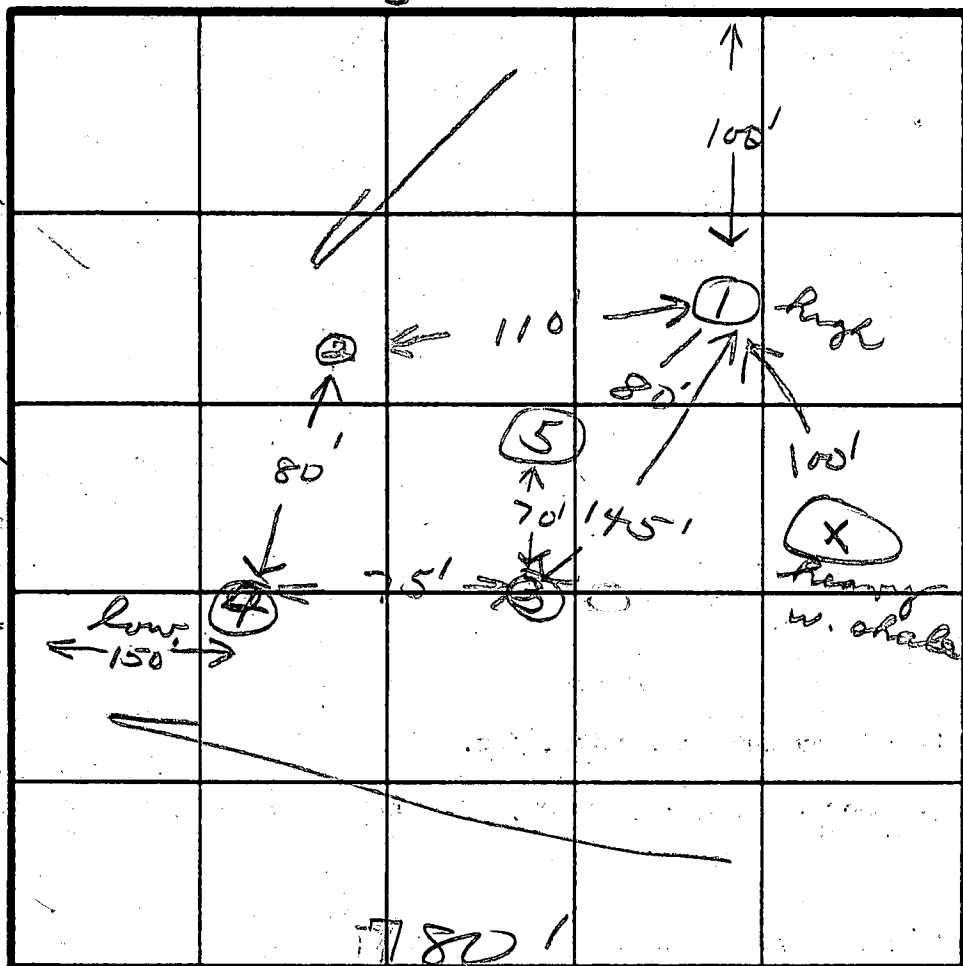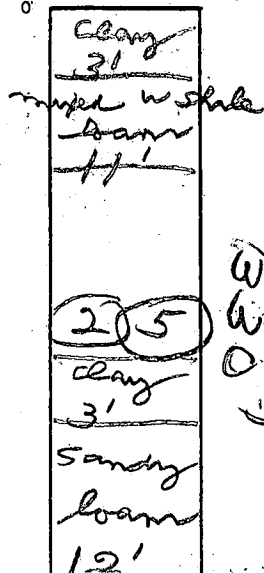


INDICATE NORTH - NAME ADJOINING ROADWAY AS BASE LINE.

DATE	TEST NO.	DEPTH	PRE-WET		TEST - 1" DROP		TIME
			START	STOP	START	STOP	
4/2/81	15	306	1:35	1:43	1:43	1:54	11
	1M	80	1:35	1:36	1:36	1:37	1
	25	4	1:45	1:51	1:51	2:00	9
	2M	8	1:45	1:50	1:50	1:58	8
	35	4	1:58	2:02	2:02	2:09	7
	3M	8	1:58	2:01	2:01	2:05	4
	45	4	2:10	2:20	2:20	2:36	16
	4M	8	2:10	2:12	2:12	2:14	2
	5V	14					

3' meter

8 mm

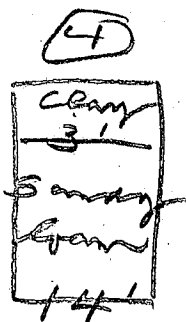

REMARKS

OK



TYPE OF SOIL

TESTED BY

[Signature]

ALSO PRESENT

Rickard Lee

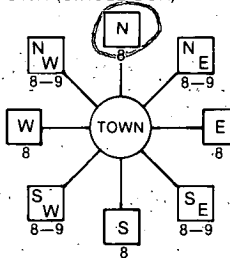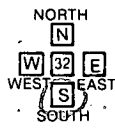B 1 1709 (THIS NUMBER IS TO BE PUNCHED IN COLS. 3-6 ON ALL CARDS)	SEQUENCE NO. (OEP USE ONLY)	STATE OF MARYLAND PERMIT TO DRILL WELL please print or type	OEP PERMIT NUMBER 40-81-2085 fill in this form completely
Date Received 2/19/87 OWNER INFORMATION 60 Howard 15 Last Name 34 Robert 36 6802 55 Richardson Rd 57 13a 70 State 72 1207 76 Zip		B 3 LOCATION OF WELL Howard 8 COUNTY 21 Patapsco Overlook 23 SUBDIVISION 42 SECTION 2 44 46 LOT 14 48 50 Lisbon 52 NEAREST TOWN 71 MILES FROM TOWN (enter 0 if in town) 1 73 76 77 78	
DRILLER INFORMATION Bernard Feezer 77 License No. 80 111 16089 Frederick Rd. Lisbon Address Bernard Feezer 21765 Date		B 4 DIRECTION OF WELL FROM TOWN (CIRCLE BOX)  NEAR WHAT ROAD Weller Drive 30 ON WHICH SIDE OF ROAD (CIRCLE APPROPRIATE BOX)  34 800 37 DISTANCE FROM ROAD ENTER FT or MI FT 38 39	
B 2 WELL INFORMATION APPROX. PUMPING RATE (GAL. PER MIN.) 5 8 12 AVERAGE DAILY QUANTITY NEEDED (GAL. PER DAY) 500 14 20		USE FOR WATER (CIRCLE APPROPRIATE BOX) ☒ D HOME (SINGLE OR DOUBLE HOUSEHOLD UNIT ONLY) ☐ F FARMING (LIVESTOCK WATERING & AGRICULTURAL IRRIGATION) ☐ I INDUSTRIAL, COMMERCIAL, STATE AND FEDERAL GOV. OTHER (REQUIRES APPROPRIATION PERMIT) ☐ P PUBLIC OR PRIVATE WATER COMPANY (REQUIRES APPROPRIATION PERMIT AND STATE HEALTH DEPARTMENT APPROVAL) ☐ T TEST, OBSERVATION, MONITORING (MAY REQUIRE APPROPRIATION PERMIT)	
APPROXIMATE DEPTH OF WELL 250 24 28 FEET		NOT TO BE FILLED IN BY DRILLER HEALTH DEPARTMENT APPROVAL Howard COUNTY NAME A 31158 COUNTY NO. OEP SIGNATURE DATE ISSUED 052087 43 48 CO SIGNATURE NORTH GRID 553000 50 55 EAST GRID 0780000 57 63	
APPROXIMATE DIAMETER OF WELL 6 NEAREST INCH		SHOW MAJOR FEATURES OF BOX & LOCATE WELL WITH AN X SOURCES OF DRILLING WATER 1. Tap into 2. you just finished WRITE THE BOX NUMBER FROM THE MAP HERE 780 55A 3 6/19/87	
METHOD OF DRILLING (circle one) BORED (or Augered) JETTED Jetted & DRIVEN 30 AIR-ROTary AIR-PERCussion ROTARY (Hydraulic Rotary) 37 CABLE REVERSE-ROTary Drive-POINT other		REPLACEMENT OR DEEPEINED WELLS (CIRCLE APPROPRIATE BOX) ☒ N THIS WELL WILL NOT REPLACE AN EXISTING WELL ☐ Y THIS WELL WILL REPLACE A WELL THAT WILL BE ABANDONED AND SEALED 39 ☐ S THIS WELL WILL REPLACE A WELL THAT WILL BE USED AS A STANDBY ☐ D THIS WELL WILL DEEPEIN AN EXISTING WELL PERMIT NUMBER OF WELL TO BE REPLACED OR DEEPEINED (IF AVAILABLE) 41 52	
Not to be filled in by driller (OEP USE ONLY)			
APPROP. PERMIT NUMBER 54 GAP 63 FORCE 5 WRITE INITIALS IN BOX PERMIT No. 40-81-2085 67 68 70 71 72 73 74 75 76 77 78 79			
SPECIAL CONDITIONS			

HEALTH
 HARMAD CONT'D
 HEALTH

C1 1106
SEQUENCE NO. (OEP USE ONLY)
1 2 3 6
(THIS NUMBER IS TO BE PUNCHED
IN COLS. 3-6 ON ALL CARDS)

STATE OF MARYLAND
WELL COMPLETION REPORT
FILL IN THIS FORM COMPLETELY
PLEASE PRINT OR TYPE

THIS REPORT MUST BE SUBMITTED WITHIN
45 DAYS AFTER WELL IS COMPLETED.

COUNTY
NUMBER A31158

DATE Received
8 13

DATE WELL COMPLETED
04/19/87
15 20

Depth of Well
22 250 26
(TO NEAREST FOOT)

PERMIT NO.
FROM "PERMIT TO DRILL WELL"
40-81-2085
28 29 30 31 32 33 34 35 36 37

OWNER Goddard Robert
last name first name
STREET OR RFD Weller Dr.
SUBDIVISION Patapsco SECTION 2 TOWN Lisbon LOT 14

WELL LOG
Not required for driven wells
STATE THE KIND OF FORMATIONS
PENETRATED, THEIR COLOR, DEPTH,
THICKNESS AND IF WATER BEARING

DESCRIPTION (Use additional sheets if needed)	FEET		Check if water bearing
	FROM	TO	
orange soil	0	10	
Brown soil	10	45	
shell (soft)	45	70	✓
shell (hard)	70	115	✓
shale	115	125	✓
gray & white rock	125	250	✓

GROUTING RECORD
WELL HAS BEEN GROUTED
(Circle Appropriate Box)
yes ☒ no ☐
TYPE OF GROUTING MATERIAL
CEMENT ☒ BENTONITE CLAY ☐
NO. OF BAGS 22 NO. OF POUNDS 2068
GALLONS OF WATER 132
DEPTH OF GROUT SEAL (to nearest foot)
from 0 ft. to 50 ft.
(enter 0 if from surface)

CASING RECORD
casing
types
insert
appropriate
code
below
STEEL ☒ CONCRETE ☐
PLASTIC ☐ OTHER ☐
MAIN Nominal diameter Total depth
CASING top (main) casing of main casing
TYPE (nearest inch) (nearest foot)
ST 106 71 70

OTHER CASING (if used)
diameter depth (feet)
inch from to
EACH CASING

screen type or open hole
insert
appropriate
code
below
STEEL ☒ BRASS ☐ OPEN ☐
HOLE
PLASTIC ☐ OTHER ☐

DEPTH (nearest ft.)
H 75 250
EACH SCREEN

SLOT SIZE 1 2 3
DIAMETER OF SCREEN (NEAREST INCH)
56 60

GRAVEL PACK
IF WELL DRILLED WAS
FLOWING WELL INSERT
F IN BOX 68

OEP USE ONLY
(NOT TO BE FILLED IN BY DRILLER)
T (E.R.O.S.) WQ
70 72 74 75 76
TELESCOPE LOG OTHER DATA
CASING INDICATOR

PUMPING TEST
HOURS PUMPED (nearest hour) 03
PUMPING RATE (gal. per min. to nearest gal.) 8
METHOD USED TO MEASURE PUMPING RATE 8 gpm
WATER LEVEL (distance from land surface)
BEFORE PUMPING 34
WHEN PUMPING 10
TYPE OF PUMP USED (for test)
A air P piston T turbine
C centrifugal R rotary O other (describe below)
J jet S submersible

PUMP INSTALLED
DRILLER WILL INSTALL PUMP YES NO
(CIRCLE) (YES or NO)
IF DRILLER INSTALLS PUMP, THIS SECTION
MUST BE COMPLETED FOR ALL WELLS
EXCEPT HOME USE
TYPE OF PUMP INSTALLED
PLACE (A,C,J,P,R,S,T,O)
IN BOX - SEE ABOVE:
CAPACITY:
GALLONS PER MINUTE (to nearest gallon)
PUMP HORSE POWER
PUMP COLUMN LENGTH (nearest ft.)
CASING HEIGHT (circle appropriate box and enter casing height)
+ above } LAND SURFACE
- below } (nearest foot)

LOCATION OF WELL ON LOT
SHOW PERMANENT STRUCTURE SUCH AS
BUILDING, SEPTIC TANKS, AND/OR
LANDMARKS AND INDICATE NOT LESS
THAN TWO DISTANCES
(MEASUREMENTS TO WELL)
Weller Dr.
110' to
100' to
40' to

CIRCLE APPROPRIATE LETTER
A A WELL WAS ABANDONED AND SEALED
WHEN THIS WELL WAS COMPLETED
E ELECTRIC LOG OBTAINED
P TEST WELL CONVERTED TO PRODUCTION
WELL
I HEREBY CERTIFY THAT THIS WELL HAS BEEN CONSTRUCTED IN
ACCORDANCE WITH COMAR 10.17.13 "WELL CONSTRUCTION"
AND IN CONFORMANCE WITH ALL CONDITIONS STATED IN THE
ABOVE CAPTIONED PERMIT, AND THAT THE INFORMATION
PRESENTED HEREIN IS ACCURATE AND COMPLETE TO THE BEST
OF MY KNOWLEDGE.
DRILLERS IDENT. NO. 270
DRILLERS SIGNATURE
(MUST MATCH SIGNATURE ON APPLICATION)
SITE SUPERVISOR (sign. of driller or journeyman
responsible for sitework if different from permittee)

Well Permit No. HO - 81-2085
Location of property (road) Weller Dr
Subdivision Patapsco Overlook Lot 14 Block Plat Sec.
Well Driller Teeyer Owner Robt. Goddard
Depth of well 250'
Distance of measuring point (M.P.) above ground 2'
Static water level (S.W.L.) below M.P. 34'

Time pump started 1:15 Pumping rate 12
Total time 30 min to reach pumping water level 70 ft. below M.P.

[illegible]

APPLICATION FOR PITLESS ADAPTER, WELL PUMP AND PRESSURE TANK INSTALLATION

Howard County Health Department
Bureau of Environmental Health
3525-H Ellicott Mills Drive
Court House Square
Ellicott City, Md. 21043
461-9933

New Installation _____
Replacement _____

Receipt # _____
Date _____

Name of Installer _____

Telephone _____

License number _____

Certified Well Pump Installer _____ Well Driller _____ Registered Plumber _____

Name of Property Owner Robert Goddard

Telephone _____

Subdivision Potapscow Overlook Lot # 14 Well tag # HD-81-2085

Site Address 613 Weller Drive

Pump

1. Type
 - a. Deep well jet _____
 - b. Shallow well jet _____
 - c. Submersible _____

Motor

1. Horsepower _____
2. RPM _____
3. Voltage _____
 - a. 110 _____
 - b. 220 _____

Pitless Adapter

1. Make _____
2. Model # _____
3. Depth _____

2. Make _____
3. Model # _____
4. Capacity _____ GPM
5. Pump exceeds well capacity Yes _____ No _____
6. If Yes, is low pressure cutoff switch installed? Yes _____ No _____
7. What methods are used to protect the pump and electrical wiring from vibrations? Torque arrestors _____ Cable guards _____ Other _____

Tank

1. Capacity _____
2. Pressure relief valve? _____

Piping

1. Type _____
2. Size _____
3. NSF and/or BOCA Code approved _____
4. Depth of supply line _____

Well data

1. Depth _____ ft.
2. Yield _____ GPM
3. Static water level _____ ft.
4. Will water supply be disinfected by installer? _____

2-16-88 Well line and electrical line
ok at house connection. Trench partially
covered. Pitless adapter at 44 inches. NO tank installed yet JE Nadeau


I understand that it is my responsibility to notify the Howard County Health Department when the installation is ready for inspection (otherwise this permit is null and void).

All information given above is true to the best of my knowledge.

Signature of Applicant: _____

Date: _____

Note: A sticker indicating approval/status of the installation will be placed on the well casing at the time of the inspection.

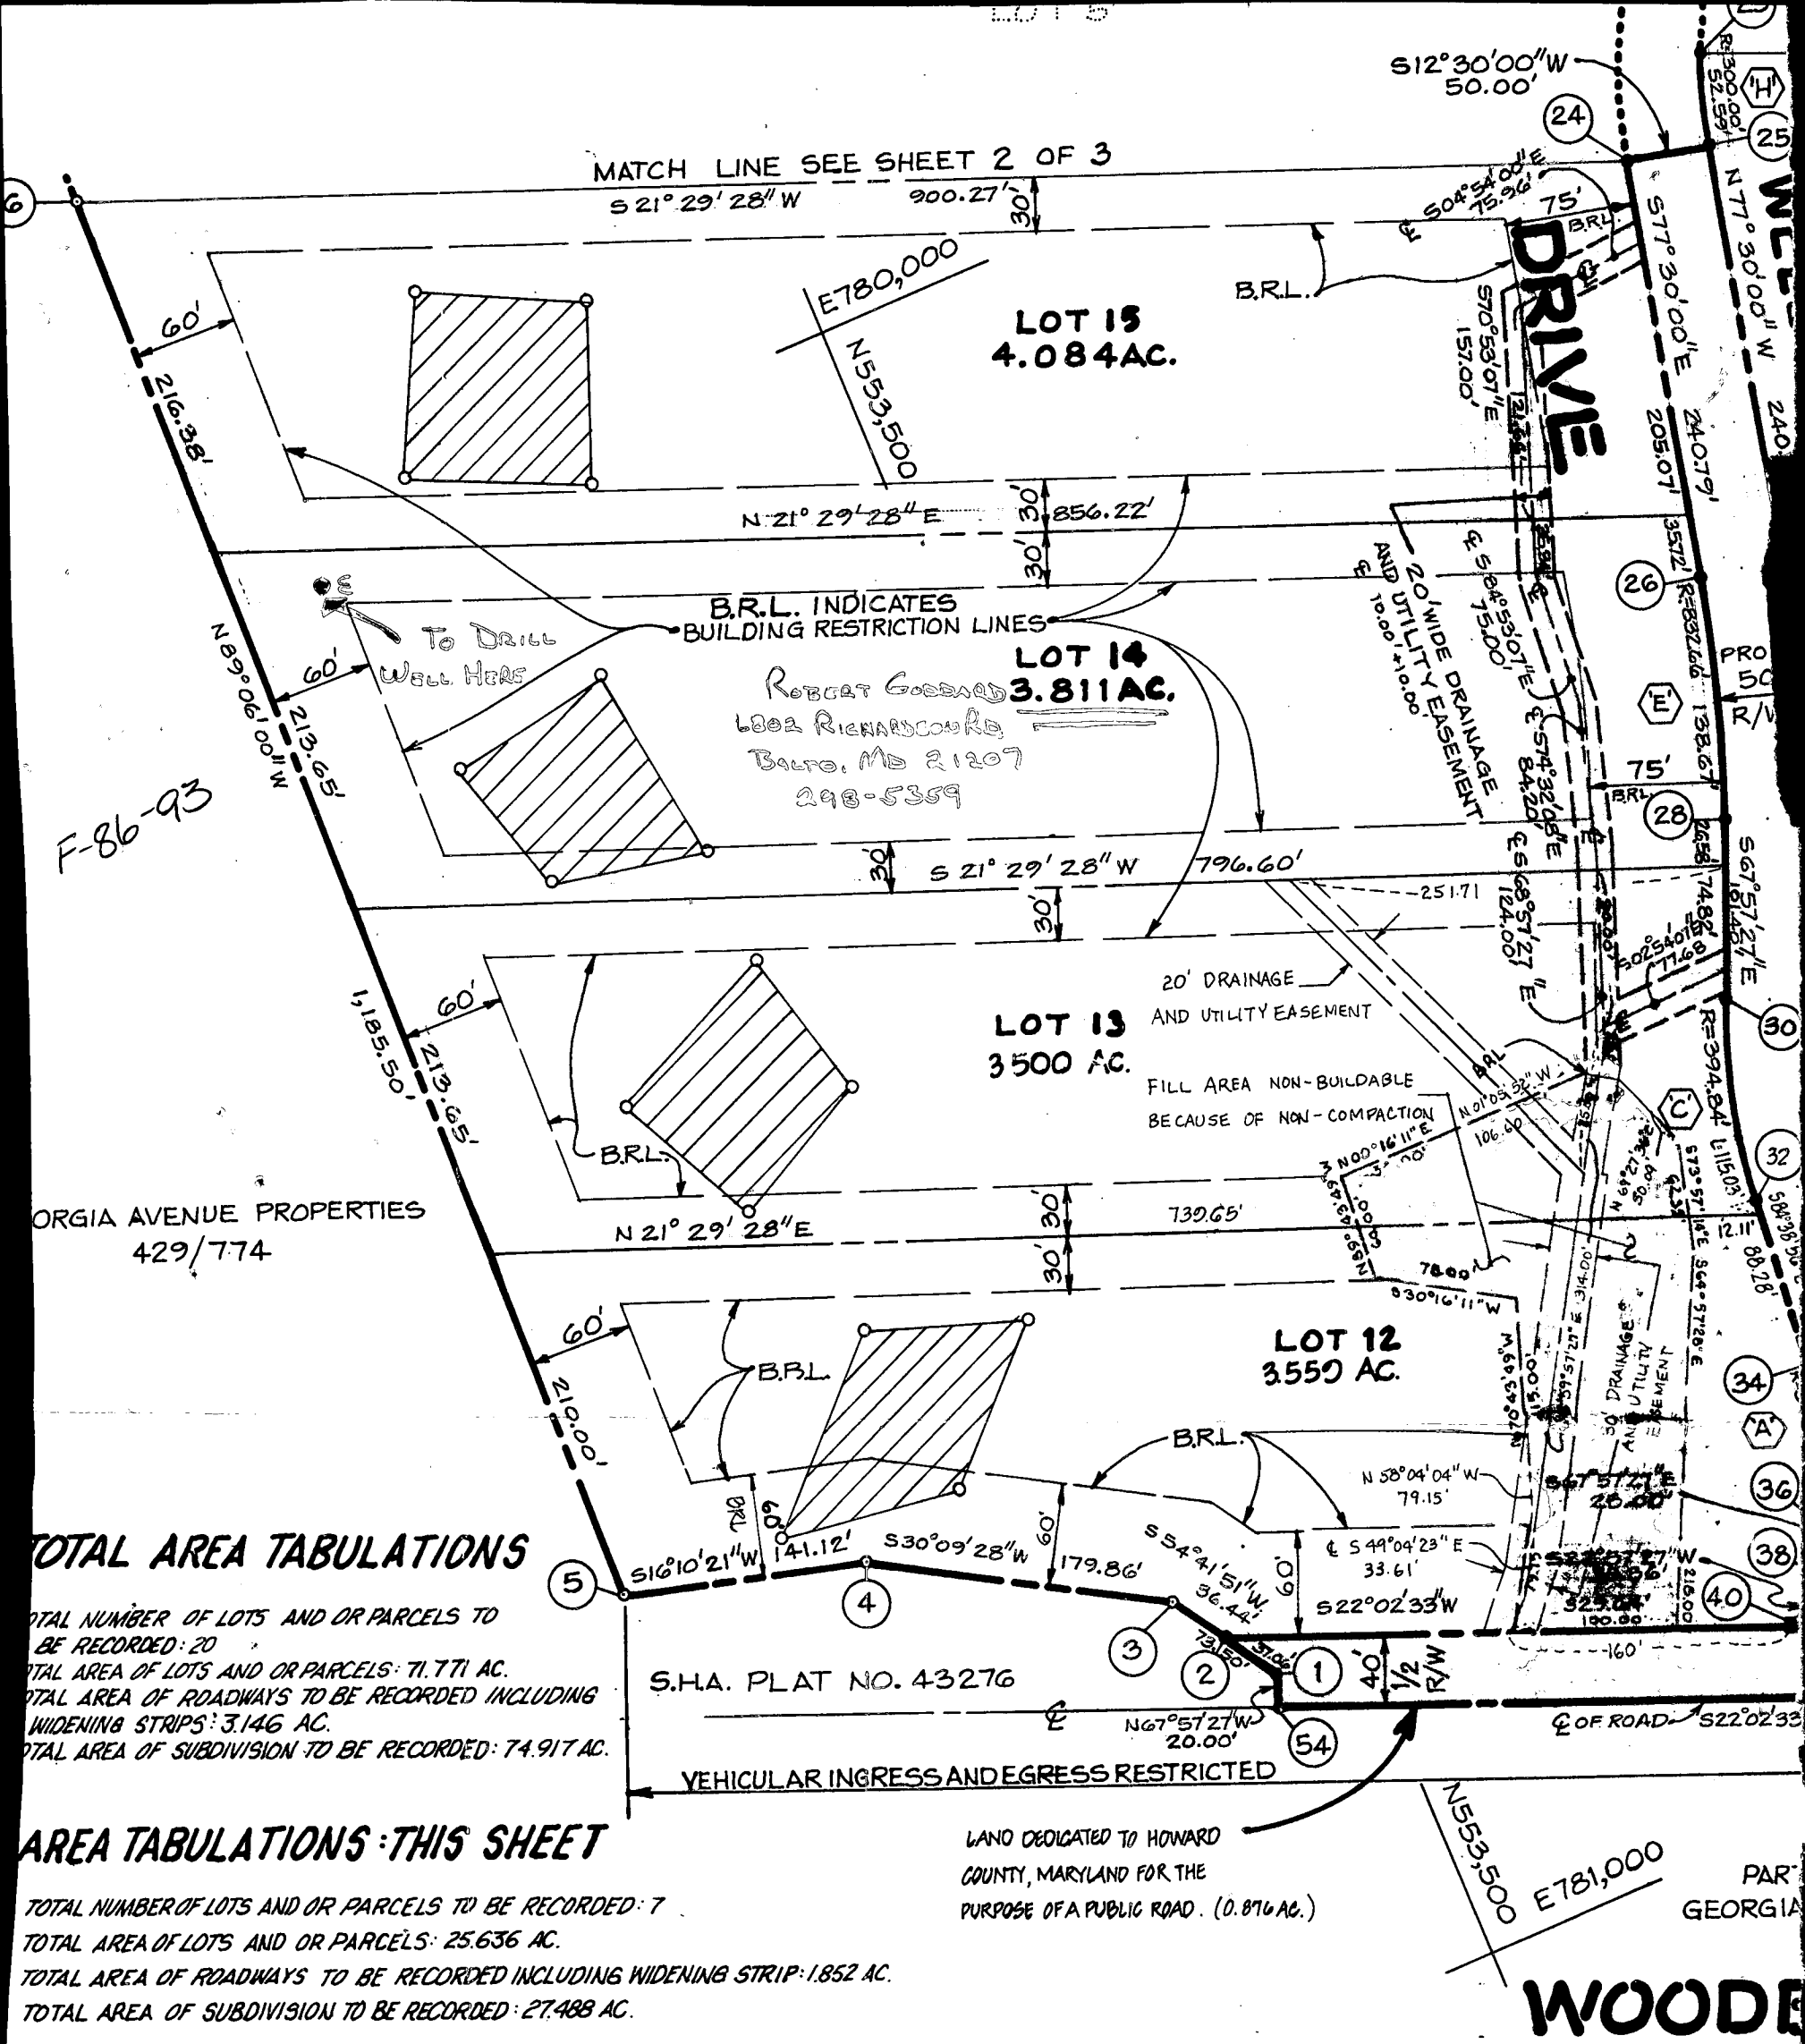

TOTAL AREA TABULATIONS

TOTAL NUMBER OF LOTS AND OR PARCELS TO BE RECORDED: 20
TOTAL AREA OF LOTS AND OR PARCELS: 71.771 AC.
TOTAL AREA OF ROADWAYS TO BE RECORDED INCLUDING WIDENING STRIPS: 3.146 AC.
TOTAL AREA OF SUBDIVISION TO BE RECORDED: 74.917 AC.

AREA TABULATIONS: THIS SHEET

TOTAL NUMBER OF LOTS AND OR PARCELS TO BE RECORDED: 7
TOTAL AREA OF LOTS AND OR PARCELS: 25.636 AC.
TOTAL AREA OF ROADWAYS TO BE RECORDED INCLUDING WIDENING STRIP: 1.852 AC.
TOTAL AREA OF SUBDIVISION TO BE RECORDED: 27.488 AC.

APPROVED: FOR PRIVATE WATER AND PRIVATE SEWERAGE SYSTEMS. HOWARD COUNTY HEALTH DEPARTMENT.

J. J. J. J. 6-18-86
HOWARD COUNTY HEALTH OFFICER DATE

APPROVED: HOWARD COUNTY OFFICE OF PLANNING AND ZONING.

PLANNING DIRECTOR DATE

APPROVED: FOR STORM DRAINAGE SYSTEMS AND PUBLIC ROADS. HOWARD COUNTY DEPARTMENT OF PUBLIC WORKS.

OWNERS STATEMENT

WE, GEORGIA AVENUE PROPERTIES INC, A MARYLAND CORPORATION BY: E. BROOKE LEE III, PRESIDENT AND E. BROOKE LEE III, TREASURER, OWNERS OF PROPERTY SHOWN AND DESCRIBED HEREON, HEREBY ADOPT THIS PLAN SUBDIVISION, AND IN CONSIDERATION OF THE APPROVAL OF THIS PLAN BY THE OFFICE OF PLANNING AND ZONING, ESTABLISH THE MINIMUM RESTRICTION LINES AND GRANT UNTO HOWARD COUNTY, MARYLAND, ITS SUCCESSORS AND ASSIGNS, (1) THE RIGHT TO LAY, CONSTRUCT AND SEWERS, DRAINS, WATER PIPES AND OTHER MUNICIPAL UTILITIES AND SERVICES, IN AND UNDER ALL ROADS AND STREET RIGHT-OF-WAYS AND SPECIFIC EASEMENT AREAS SHOWN HEREON; (2) THE RIGHT TO REQUIRE FOR PUBLIC USE THE BEDS OF THE STREETS AND/OR ROADS AND FLOODPLAIN OPEN SPACE WHERE APPLICABLE, AND FOR GOOD AND OTHER VALUABLE HEREBY GRANT THE RIGHT AND OPTION TO HOWARD COUNTY TO ACQUIRE SIMPLE TITLE TO THE BEDS OF THE STREETS AND/OR ROADS AND FLOOD DRAINAGE FACILITIES AND OPEN SPACE WHERE APPLICABLE; AND (3) REQUIRE DEDICATION OF WATERWAYS AND DRAINAGE EASEMENTS FOR THE PURPOSE OF THERE CONSTRUCTION, REPAIR, AND MAINTENANCE; AND (4) THAT NO OR SIMILAR STRUCTURE OF ANY KIND SHALL BE ERECTED ON OR OVER THE EASEMENTS AND RIGHT-OF-WAYS.

WITNESS MY/OUR HANDS THIS 27 DAY OF Aug. 1981

E. Brooke Lee *E. Brooke Lee*

2-16-98
A&AP

PERMIT

SEWAGE DISPOSAL SYSTEM

MARYLAND STATE DEPARTMENT OF HEALTH

HOWARD COUNTY

BUREAU OF ENVIRONMENTAL HEALTH

461-9933

INDEXED

04-344723

P 40852

A 31158

DISTRICT 4th

DATE 1/22/88

DATE SYSTEM APPROVED 2-16-88

INSPECTOR JEN

Arnold Backhoe & Septic Services, Inc.

IS PERMITTED TO INSTALL X ALTER

ADDRESS P. O. Box 15, Woodbine, Maryland 21797 PHONE 795-7873

SUBDIVISION Patapsco Overlook ROAD 613 ~~621~~ Weller Drive LOT 14

PROPERTY OWNER Robert Goddard

ADDRESS _____

IF GARBAGE GRINDER IS USED INCREASE SEPTIC TANK CAPACITY BY 50% AND ABSORPTION AREA BY 22%.

GARBAGE GRINDER? YES _____ NO X

SEPTIC TANK CAPACITY 1000 GALLONS NUMBER OF BEDROOMS 3

150 ft trench
4 1/4" 600
20
20

TRENCHES - 200 sq. ft. per bedroom. Trench to be 2 feet wide. Inlet maximum depth 3 feet below original grade. Bottom maximum depth 7 feet below original grade. Effective area begins at 3 feet below original grade. 4 feet of stone below distribution pipe.

LOCATION - Start first trench 200 feet from the rear lot line and 130 feet from the left lot line as seen when facing the property from Weller Drive. Run trenches along contour toward left side of property.

NOTE - No trench to exceed 100 feet in length. Provide 6" - 8" diameter cleanout and cap to grade or above on septic tank. ok/c.w.

PLANS APPROVED BY C. Williams DATE 12/29/86

COVER NO WORK UNTIL INSPECTED AND APPROVED.

NEITHER THE HOWARD COUNTY COUNCIL NOR THE HEALTH DEPARTMENT IS RESPONSIBLE FOR THE SUCCESSFUL OPERATION OF ANY SYSTEM.

NOTE: CLEANOUT REQUIRED EVERY 70 FEET OF SEWER LINE AND/OR AT 90° SWEEPS IN LINES FROM HOUSE TO DRAIN FIELDS.

NOTE: ALL PARTS OF SEPTIC SYSTEMS (I.E., TANK, DISTRIBUTION BOX, TRENCHES) TO BE 100 FEET FROM WELL (UNLESS OTHERWISE SPECIFICALLY AUTHORIZED)

NOTE: IF DEEP TRENCH(ES) ARE USED CALL FOR INSPECTION BEFORE AND AFTER PLACING GRAVEL IN TRENCH(ES).

NOTE: NO DRY WELL SHALL EXCEED 15 FOOT IN DIAMETER. NO ABSORPTION TRENCH TO EXCEED 100 FEET IN LENGTH.

NOTE: ALL PIPE FROM HOUSE TO SEPTIC TANK MUST BE CAST IRON OR SCHEDULE 40 PVC OR ABS.

PERMIT VOID AFTER TWO YEARS.

NOTE: INSTALL STAND PIPE ON SEPTIC TANK AND DRY WELL. STAND PIPES MUST BE 6 INCHES IN DIAMETER. CAST IRON, CONCRETE OR TERRA COTTA OR PVC OR ABS ACCEPTED. IF TOP OF SEPTIC TANK IS DEEPER THAN 3 FEET, MANHOLE TO GRADE REQUIRED.

NOTE: DISTRIBUTION BOXES MUST HAVE BAFFLES.

**BUILDING PERMIT SIGNED
AND RETURNED**

9720 80015816 GREAT ROOM
2 CAR GARAGE

***INSTALLER IS RESPONSIBLE FOR OBTAINING FINAL APPROVAL ON THIS PERMIT**

*CALL 461-9933 FOR INSPECTION OF SEPTIC SYSTEMS.


EH - 2-1186

31158

Great ~~heron~~ + 2 CAA 6AEP

ALL INFORMATION CONTAINED HEREIN IS UNCLASSIFIED
DATE 08-19-2007 BY SP-6 JRS/KJS

REPAIR

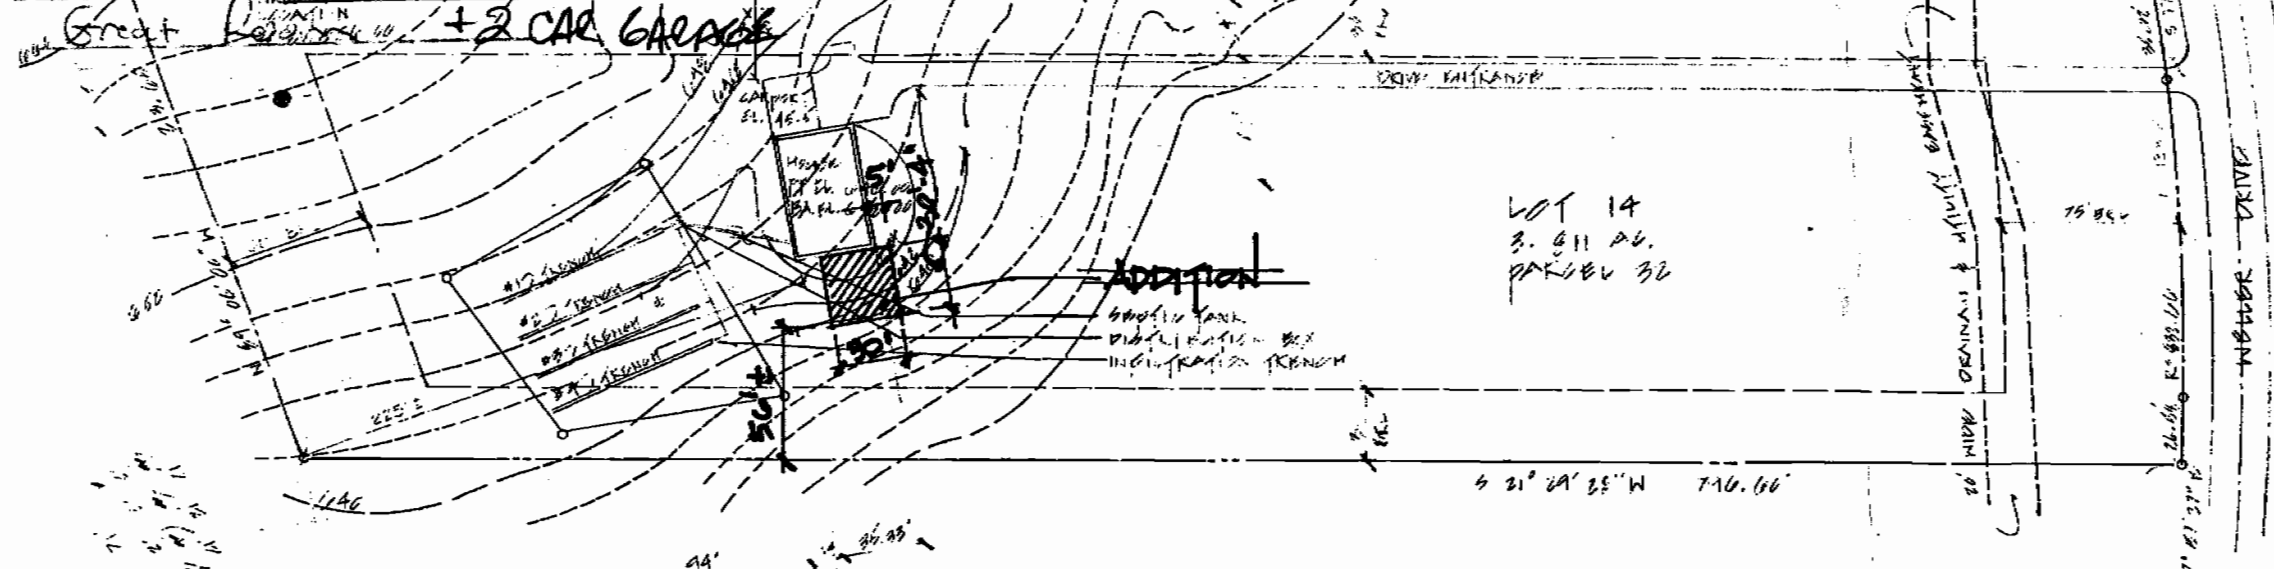[illegible]

VER: 1.06
HBR: 1.06

LOT 14 - PALAPOL OVERLOOK / APPROXIMATE
TAX MAP 2, ZONED R, RECORD # 678 - 1/1/80
4TH ELECTION DIST HOWARD CO MD.
ACRES: 1.0000 DATE: 7/25/81

613. Weller R.