

04-344804

PERMIT
SEWAGE DISPOSAL SYSTEM
HOWARD COUNTY HEALTH DEPARTMENT
BUREAU OF ENVIRONMENTAL HEALTH
410-313-2640

P 513600

A 31255

ISSUE DATE 5/23/2000

APPROVAL DATE 5/23/2000

A. E. Haspert Contracting LLC IS PERMITTED TO INSTALL x ALTER

ADDRESS 45 Gina Court, Sykesville, MD 21784 PHONE 410-781-6777

SUBDIVISION Patapsco Overlook II LOT NUMBER 21 ADDRESS 655 Weller Drive

PROPERTY OWNER P. Todd & C. Wojciechowski PROPERTY OWNER'S ADDRESS 9112 Avenue A

SEPTIC TANK CAPACITY 1000 GALLONS Baltimore, MD 21219

PUMP CHAMBER CAPACITY GALLONS

NUMBER OF BEDROOMS 3

SQUARE FEET PER BEDROOM 210

LINEAR FEET OF TRENCH REQUIRED 157.5

TRENCHES: Trenches to be 2 feet wide. Inlet 3.5 feet below original grade. Bottom maximum depth
7.5 feet below original grade. 4 feet of stone below distribution box.

LOCATION: Place the distribution box 60 feet from the breakpoint in the left lot line
(120.00'/390.00' intersection). Run trenches along contour toward front of
property.

PLANS APPROVED Mark E. Rifkin DATE 1-24-2000

PERMIT VOID AFTER 2 YEARS

NOTE: CONTRACTOR RESPONSIBLE FOR SCHEDULING A PRE-CONSTRUCTION INSPECTION FOR ALL INSTALLATIONS

NOTE: TOP OF SEPTIC TANKS ARE TO BE NO DEEPER THAN 3.0 FEET BELOW FINISH GRADE

NOTE: WATERTIGHT SEPTIC TANKS REQUIRED

NOTE: CLEANOUT REQUIRED EVERY 70 FEET OF SEWER LINE AND/OR AT 90° SWEEPS IN LINES FROM HOUSE TO DRAIN FIELDS, 90° ELBOWS ARE NOT ACCEPTABLE

NOTE: ALL PARTS OF SEPTIC SYSTEMS (I.E. TANK, DISTRIBUTION BOX, DRAINFIELDS) TO BE 100 FEET FROM ANY WATER WELL UNLESS OTHERWISE SPECIFICALLY AUTHORIZED

NOTE: NO ABSORPTION TRENCH TO EXCEED 100 FEET IN LENGTH UNLESS SPECIFICALLY AUTHORIZED

NOTE: ALL PIPE FROM HOUSE TO SEPTIC TANK MUST BE CAST IRON OR SCHEDULE 35/40 PVC OR ABS

NOTE: MANHOLE RISERS REQUIRED ON ALL SEPTIC TANKS AND PUMP CHAMBERS


NOTE: DISTRIBUTION BOXES MUST HAVE BAFFLES

NOTE: IF PUMPED SEPTIC SYSTEM REQUIRED, (1) SEPTIC PUMP DETAIL TO BE PROVIDED BY INSTALLER PRIOR TO ISSUANCE OF SEPTIC PERMIT (2) PUMP PERFORMANCE TEST IS NECESSARY PRIOR TO HEALTH DEPARTMENT APPROVAL OF SEPTIC PERMIT

NEITHER THE HOWARD COUNTY COUNCIL NOR THE HEALTH DEPARTMENT IS RESPONSIBLE FOR THE
SUCCESSFUL OPERATION OF ANY SYSTEM
PERMITTEE RESPONSIBLE FOR OBTAINING FINAL APPROVAL ON THIS PERMIT
CALL 410-313-2640 FOR INSPECTION OF SEPTIC SYSTEM

491255

NOT TO SCALE

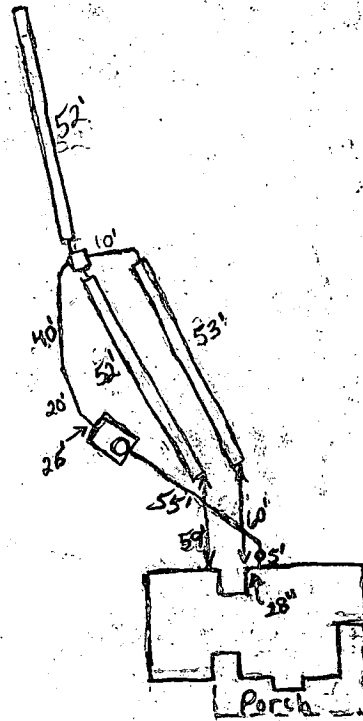

H0-92-0347

TRENCH DATA

TRENCH WIDTH 2.0'
TRENCH INLET DEPTH 3.5'
TRENCH BOTTOM DEPTH 7.5'
DEPTH OF STONE 4.0'
NUMBER OF TRENCHES 3
TOTAL TRENCH LENGTH 157'
ABSORBENT AREA 628 sq. ft.
DISTRIBUTION BOX LEVEL OK
BAFFLE IN DISTRIBUTION BOX Yes

SEPTIC TANK DATA

SEPTIC TANK 1000 MS GALLONS
MANHOLE RISER Yes
6 INCH INSPECTION PORT Yes

~~PUMP CHAMBER DATA~~

~~PUMP CHAMBER
GALLONS _____
MANHOLE RISER _____
ALARM _____
PUMP PERFORMANCE TEST _____~~

PRE-CONSTRUCTION INSPECTION: _____

INSPECTION COMMENTS: 6/28/00 House connection made. O.K. to cover up to D.B. after
cleanouts are installed on tank. O.K. to cover well line, pitless. Pump
not installed yet. 20' sleeve across driveway. BB 6/29/00 WPI O.K. Trenches
dug. Distribution box needs baffle (contractor said he would install
levelers). To leave one trench open and the ends of the other trenches after
stoned. BB 6/30/00 Everything satisfactory. O.K. to cover BB

INSPECTOR Brian Baper DATE SYSTEM APPROVED 6/30/00

HOWARD COUNTY HEALTH DEPARTMENT
Bureau of Environmental Health
3525-H Ellicott Mills Drive
Ellicott City, MD 21043

FAX: 313-2648 PHONE: 313-2640

APPLICATION FOR PITLESS ADAPTER, WELL PUMP AND PRESSURE TANK INSTALLATION

New Installation ☒
Replacement ☐

Receipt #

Date

6/27/2000

Name of Installer ROBT. L. FREEZER CO. INC.

Telephone 410-781-4655

License Number 2122

Certified Well Pump Installer ☒ Well Driller ☐ Registered Plumber ☒

Name of Property Owner B42: AL HASPOLT

Telephone 410-781-6777

Subdivision PATMSCO OVERLOOK Lot # 21

Well Tag # HO-92-0347

Site Address 655 WELLS DRIVE

Pump

1. Type

a. Deep well jet

b. Shallow well jet

c. Submersible ☒

2. Make GOULDS

3. Model # SG505412

4. Capacity 5 GPM

5. Pump exceeds well capacity Yes ☒ No ☐

6. If Yes, is low pressure cutoff switch installed? Yes ☐ No ☒

7. What methods are used to protect the pump and electrical wiring from vibrations? Torque arrestors ☐ Cable guards ☒ Other ☐

WEU-X-TROL

Tank WUX 203

1. Capacity 32 GPM

2. Pressure relief valve? YES

Motor

1. Horsepower 1/2

2. RPM 3450

3. Voltage

a. 110

b. 220 ☒

Pitless Adapter

1. Make HARVARD

2. Model # PT200

3. Depth 42"

Piping

1. Type Pvc

2. Size 1"

3. NSF and/or BOCA Code approved YES

4. Depth of supply line 42"

Well data

1. Depth 300 ft.

2. Yield 1.5 GPM

3. Static water level ft.

4. Will water supply be disinfected by installer? YES

I understand that it is my responsibility to notify the Howard County Health Department when the installation is ready for inspection (otherwise this permit is null and void).

All information given above is true to the best of my knowledge.

Signature of Applicant Robert L. Freezer

Date: 6/27/2000

Note: A sticker indicating approval/status of the installation will be placed on the well casing at the time of the inspection.

Approved Septic System Plan
Howard County Health Department

BPR INC

475 Goldenrod Terrace #103

Westminster, MD 21157

410-876-0333


475 GOLD

SL

WESTMINS

410-876-

Mark E. Riffin 1/24/00
Signature Date

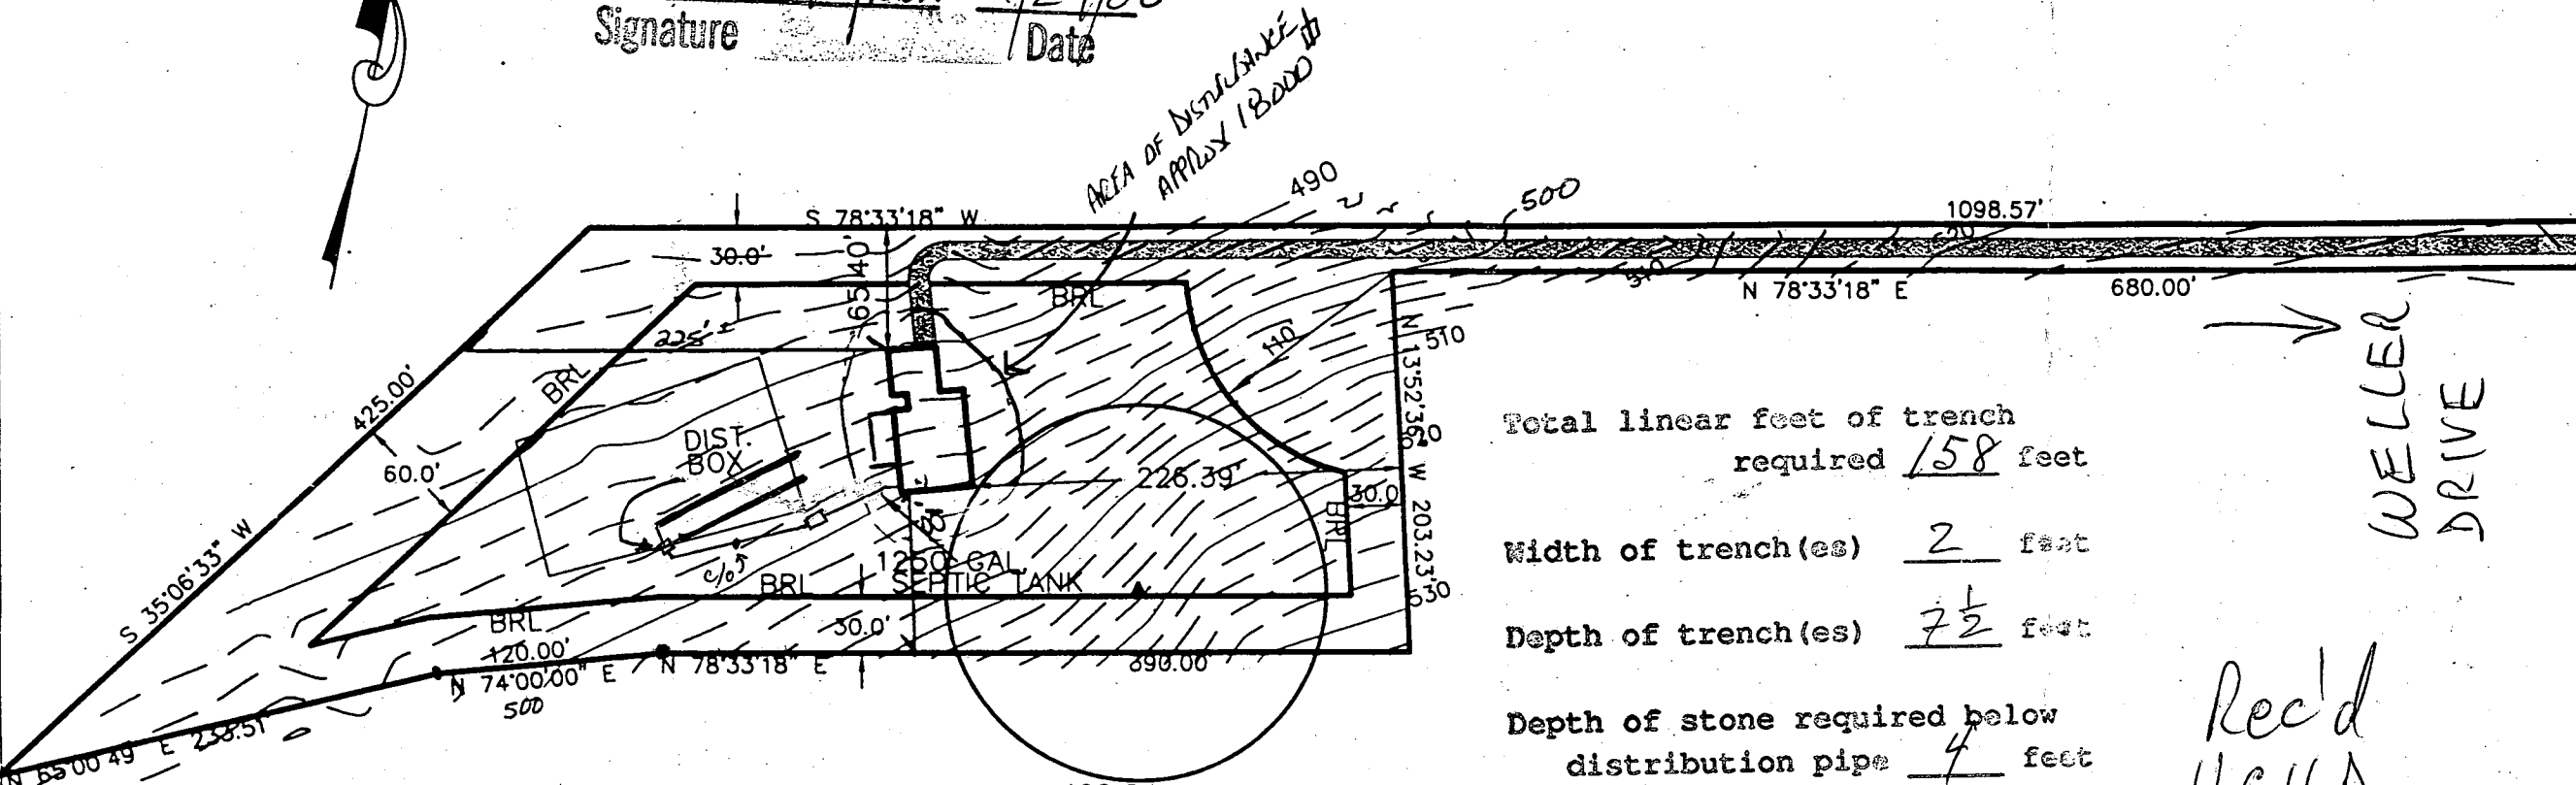

Total linear feet of trench
required 158 feet

Width of trench(es) 2 feet

Depth of trench(es) 7 1/2 feet

Depth of stone required below
distribution pipe 4 feet


WELLER
DRIVE

HOUSE INV. 497.0
S. TANK INV. 496.3
S. TANK OUT 496.0

GROUND ELEV. SEPTIC TANK 499.0
TOP ELEV. SEPTIC TANK 495.5
ELEV. DIST. BOX 492.5
GROUND ELEV. DIST. BOX 496.0

MINIMUM 18" FINISHED COVER
AT SEPTIC TANK

1:100

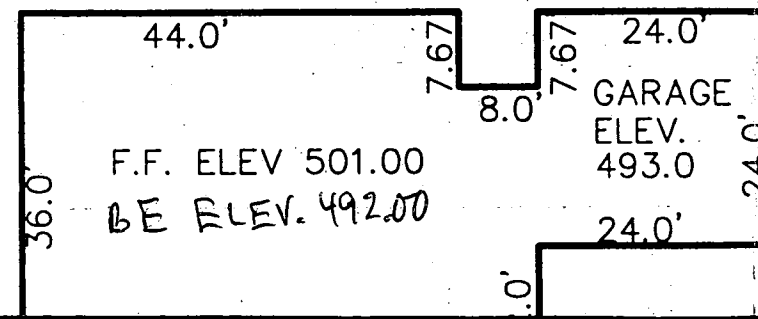

Rec'd
HCHD

Jan 13 '00

PLOT PLAN

LOT 21 PATAPSCO OVERLOOK

655 Weller Drive

HOWARD COUNTY
PERMIT APPLICATION

PERMIT NUMBER

B0022095

Building Address LOSS WELLFR DRIVE
Waldorf MD 21771
Suite/Apt. #: _____ SDP/WP/Petition #: _____
Census Tract 6040 Subdivision PATAPSCO OVERLOOK
Section 2 Area N/A Lot 21
Tax Map 2 Parcel 227 Grid 24
Zoning RC-DEM Map Coordinates 3F6 Lot size _____

Property Owner's Name PAUL & TODD + CHUCK
WATKINCHOWSKI
Address 9112 AVENUE A
City BALTD. State MD Zip Code 21219
Home Phone 410-477-2642 Work Phone _____
Applicant's Name & Mailing Address, (if other than stated hereon):
N/A
Phone _____ Fax _____

Existing Use GARAGE LOT
Proposed Use SFD W/ ATTACHED GARAGE
Estimated Construction Cost \$ 100,000.00
Description of Work BUILD SFD W/ PORCH, GARAGE AND
12' x 30' REAR DECK 3 BR 2 1/2 BATH
unfinished bsm't w/ RT

Contractor Company A.E. HASPETH CONTRACTING
Contact Person AL HASPETH
Address 45 GINA COURT
City SVESVILLE State MD Zip Code 21784
License No. 31598
Phone 410-781-6777 Fax 410-552-5073

Occupant or Tenant _____
Contact Name _____
Address _____
City _____ State _____ Zip Code _____
Phone _____ Fax _____

Engineer or Architect Company GBL CUSTOM HOME DESIGN
Contact Person GREG LITTLE
Address 4317 HOLWOODS DR
City HAMPSTAD State MD Zip Code 21074
Phone 410-833-8320 Fax _____

BUILDING DESCRIPTION - COMMERCIAL

Building Characteristics

Utilities

Height: _____
No. of stories: _____
Gross area, sq. ft. per floor: _____
Use group: _____
Construction type:
☐ Reinforced Concrete
☐ Structural Steel
☐ Masonry
☐ Wood Frame
☐ State Certified Modular

Water Supply: _____
☐ Public
☐ Private
Sewage Disposal: _____
☐ Public
☐ Private
Electric Yes ☐ No ☐
Gas Yes ☐ No ☐
Heating System:
Electric ☐ Oil ☐
Natural Gas ☐
Propane Gas ☐
Sprinkler system: N/A ☐
☐ Full
☐ Partial
☐ Other Suppression
☐ # of Heads

BUILDING DESCRIPTION - RESIDENTIAL

Building Characteristics

Utilities

SF Dwelling ☒ SF Townhouse ☐
Depth _____ Width _____
1st floor: _____
2nd floor: _____
Basement: _____
Finished Basement ☐ Unfinished Basement ☒
Crawl space ☐ Slab on Grade ☐
No. of Bedrooms 3
Multi-family dwellings:
No. of efficiency units: _____
No. of 1 BR units: _____
No. of 2 BR units: _____
No. of 3 BR units: _____
Other Structure: _____
Dimensions: _____
Footings: _____
Roof: _____
☐ State Certified Modular
☐ Manufactured Home

Water Supply: _____
☐ Public
☒ Private
Sewage Disposal: _____
☐ Public
☒ Private
Electric Yes ☒ No ☐
Gas Yes ☐ No ☒
Heating System:
Electric ☒ Oil ☐
Natural Gas ☐
Propane Gas ☐
Sprinkler system: N/A ☒
☐ NFPA #13D
☐ NFPA #13R
☐ Other:

THE UNDERSIGNED HEREBY CERTIFIES AND AGREES AS FOLLOWS: (1) THAT HE/SHE IS AUTHORIZED TO MAKE THIS APPLICATION; (2) THAT THE INFORMATION IS CORRECT; (3) THAT HE/SHE WILL COMPLY WITH ALL REGULATIONS OF HOWARD COUNTY WHICH ARE APPLICABLE THEREON; (4) THAT HE/SHE WILL PERFORM NO WORK ON THE ABOVE REFERENCED PROPERTY NOT SPECIFICALLY DESCRIBED IN THIS APPLICATION; (5) THAT HE/SHE GRANTS COUNTY OFFICIALS THE RIGHT TO ENTER ONTO THIS PROPERTY FOR THE PURPOSE OF INSPECTING THE WORK PERMITTED AND POSTING NOTICES.

Applicant's Signature Albert E. Haspeth
Title/Company A.E. HASPETH CONTRACTING L.L.C.

Print Name ALBERT E. HASPETH
Date JANUARY 12 2000

Checks payable to: DIRECTOR OF FINANCE OF HOWARD COUNTY
** PLEASE WRITE NEATLY AND LEGIBLY. **
FOR OFFICE USE ONLY

AGENCY DATE SIGNATURE APPROVAL
☒ Land Development, DPZ
☒ State Highways
☒ Building Official
☒ Dev. Engineering, DPZ
☒ Health 1/24/00 Mark E. Ripstein
☒ Fire Protection

Is Sediment Control approval required prior to issuance?
YES ☒ NO ☐

CONTINGENCY CONSTRUCTION START: ☐
ONE STOP SHOP: ☐

DPZ SETBACK INFORMATION

Front: 11' Min
Rear: 30' Min
Side: 30' Min
Side St.: N/A
All minimum setbacks met? YES ☒ NO ☐
Is Entrance Permit required? YES ☐ NO ☒
Historic District? YES ☐ NO ☒
Lot Coverage for NewTown Zone _____
SDP/Red-line approval date _____



PROPERTY ID#

44687
Filing fee \$ 25
Permit fee \$ _____
Excise tax \$ _____
Sub-total paid \$ _____
Add'l permit fee \$ _____
TOTAL FEES \$ _____
Balance due \$ _____
Check # 3156
Validation # 26329

Distribution of Copies- White: Building Official Green: LDD, DPZ Yellow: DED, DPZ Pink: Health Gold: SHA

BPR INC

475 GOLDENROD TERRACE
SUITE 103
WESTMINSTER MD 21157
410-876-0333, 857-9030

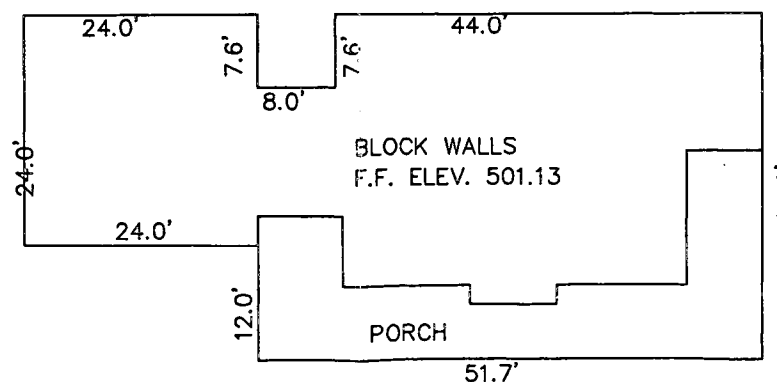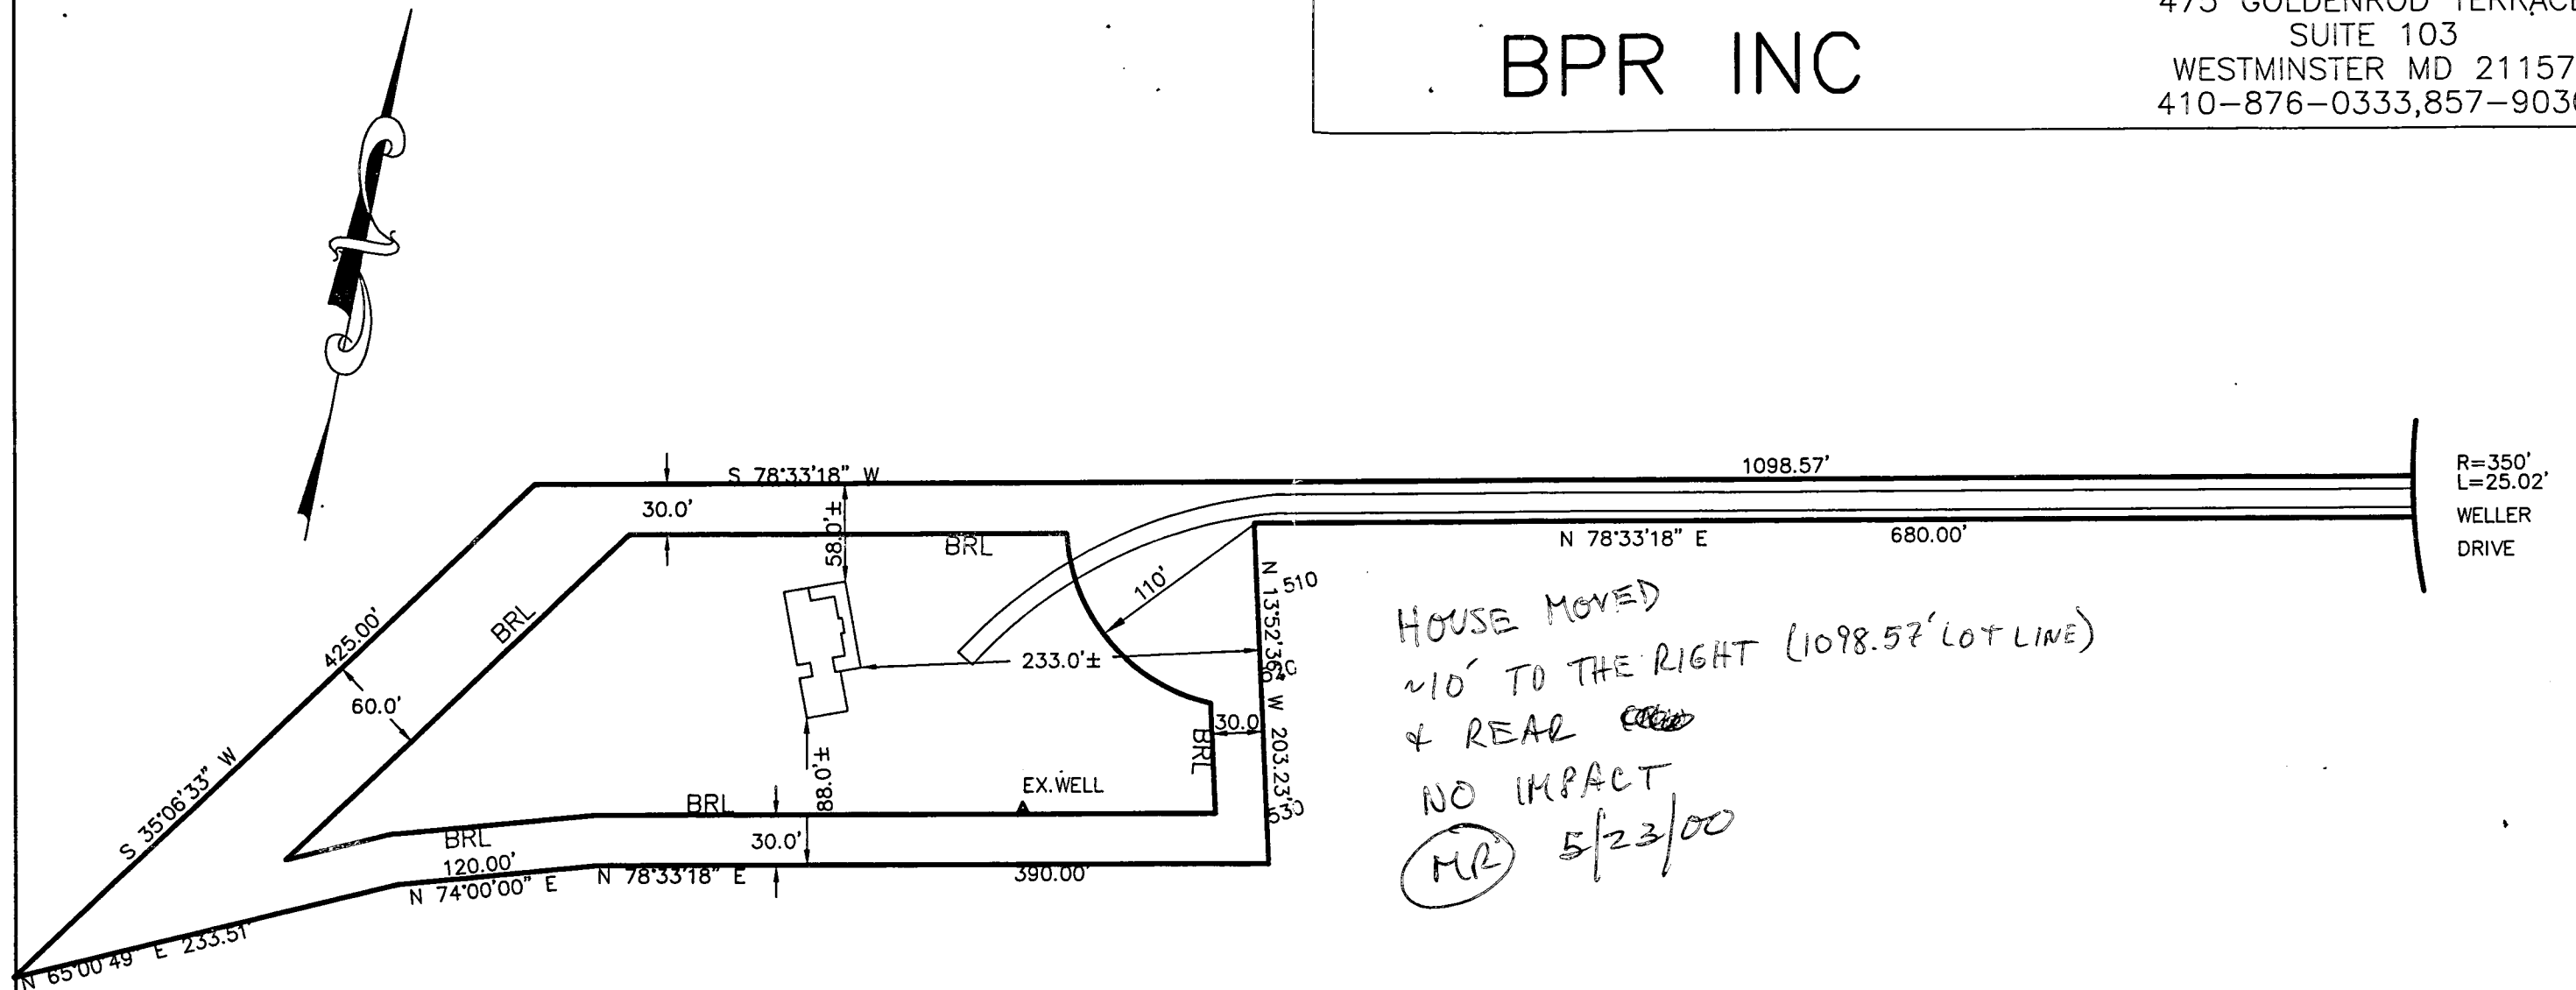

DETAIL SCALE: 1"=20'

**LOCATION DRAWING
LOT 21 PATAPSCO OVERLOOK
SECTION 2 RECORDED AS PLAT 6783
4TH ELECTION DISTRICT
655 WELLER DRIVE
HOWARD COUNTY MD.**

[Signature]
2/18/00

SCALE 100 ft.=1 inch.
Revisions and Updates

PRELIMINARY

APPLICATION

SEWAGE DISPOSAL TESTING

STATE OF MARYLAND - DEPARTMENT OF HEALTH AND MENTAL HYGIENE

HOWARD COUNTY HEALTH DEPARTMENT
ENVIRONMENTAL HEALTH SERVICES

P.O. BOX 476 ELLICOTT, MARYLAND 21043
TELEPHONE: 992-2330

31255
A 31159
P _____

DISTRICT 4th
DATE 2/9/81 3/26/81

TO: THE COUNTY HEALTH OFFICER
ELLICOTT CITY, MARYLAND

I HEREBY APPLY FOR THE NECESSARY TEST IN ORDER TO CONSTRUCT (OR RECONSTRUCT) A SEWAGE DISPOSAL SYSTEM.

PROPERTY OWNER Georgia Avenue Properties, Inc. (PATRICIA TODD & CHUCK WOSCIECHOWSKI)

ADDRESS c/o E. Brooke Lee III, 13838 Georgia Avenue, PHONE Boender - 465-7777
Wheaton, Md.

PROPERTY LOCATION:

SUBDIVISION _____ LOT NO. 15-21

ROAD AND DESCRIPTION Md. Rte. 94 and Old Frederick Road
(655 WELER DRIVE)

PERMIT SIGNED
AND RETURNED 1/24/2000
Serial# B00122096

SIZE OF LOT 3 acres m/1 TYPE BLDG. SFD - 3 or 4 bedrooms

THE SYSTEM INSTALLED UNDER THIS APPLICATION IS ACCEPTABLE ONLY UNTIL PUBLIC FACILITIES BECOME AVAILABLE.

I FULLY UNDERSTAND THE FEE CONNECTED WITH THE FILING OF THIS PERC TEST APPLICATION IS NON-REFUNDABLE UNDER ANY CIRCUMSTANCES.

SIGNATURE OF APPLICANT /s/ John A. Boender, Agent

APPROVED BY _____ FOR _____ DATE _____

REJECTED BY _____ FOR _____ DATE _____

HOLD PENDING FURTHER TESTS _____ DATE _____

REASONS FOR REJECTION OR HOLDING _____

THIS IS NOT A PERMIT

corner 2


SOIL PROFILE

4' 1' clay, sand
1' clay shale
sand,
clay
fine gr. w. shale
1.2'

(2) (5)

clay
4'

sand,
clay
small amount
of w. shale
1.2'

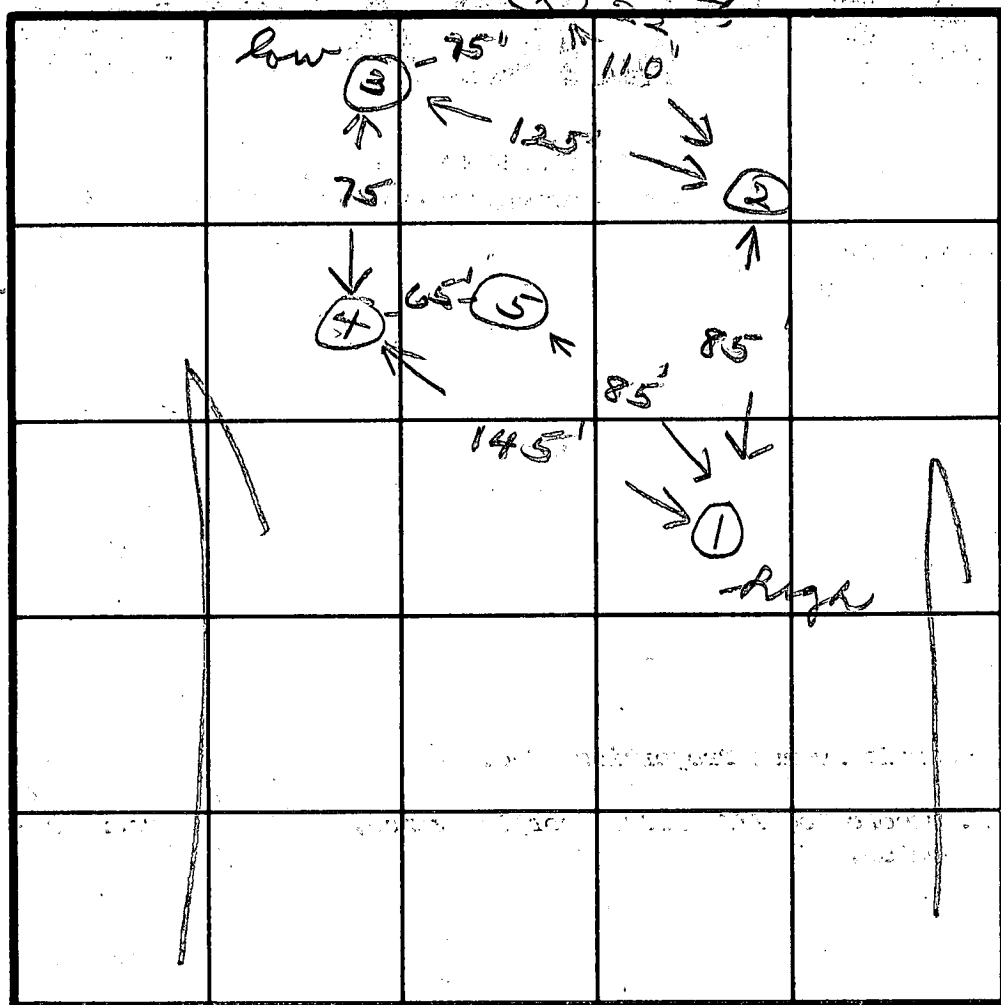

INDICATE NORTH - NAME ADJOINING ROADWAY AS BASE LINE

4
clay

3
sand, clay

2
mudstone

1
W. shale

DATE	TEST NO.	DEPTH	PRE-WET		TEST - 1" DROP		TIME
			START	STOP	START	STOP	
3/27/81	1 S	3 1/2	10:55	—			failed
	1 M	8	10:55	11:00	11:00	11:06	6
	2 S	3 1/2	11:04	—			failed
	2 M	8	11:04	11:15	11:15	11:31	16
	3 S	3	11:17	11:23	11:23	11:30	7
	3 M	7	11:17	11:19	11:17	11:23	4
	4 S	3	11:27	11:32	11:32	11:36	4
	4 M	7	11:30	11:32	11:32	11:35	3
	1 SA	4	11:52	12:00	12:00	12:06	6
	2 SA	4	11:57	12:07	12:07	12:23	16
	5 L	13					

REMARKS OK

TYPE OF SOIL _____

TESTED BY [Signature] ALSO PRESENT Paul Noyes

ALSO PRESENT Dave Noyes


F-86-93

LISBON MANOR
LOT 4
P. 4150

SHEET

RECORDED: 7
AC.



INCLUDING WIDENING STRIPS: NONE
27.299 AC.

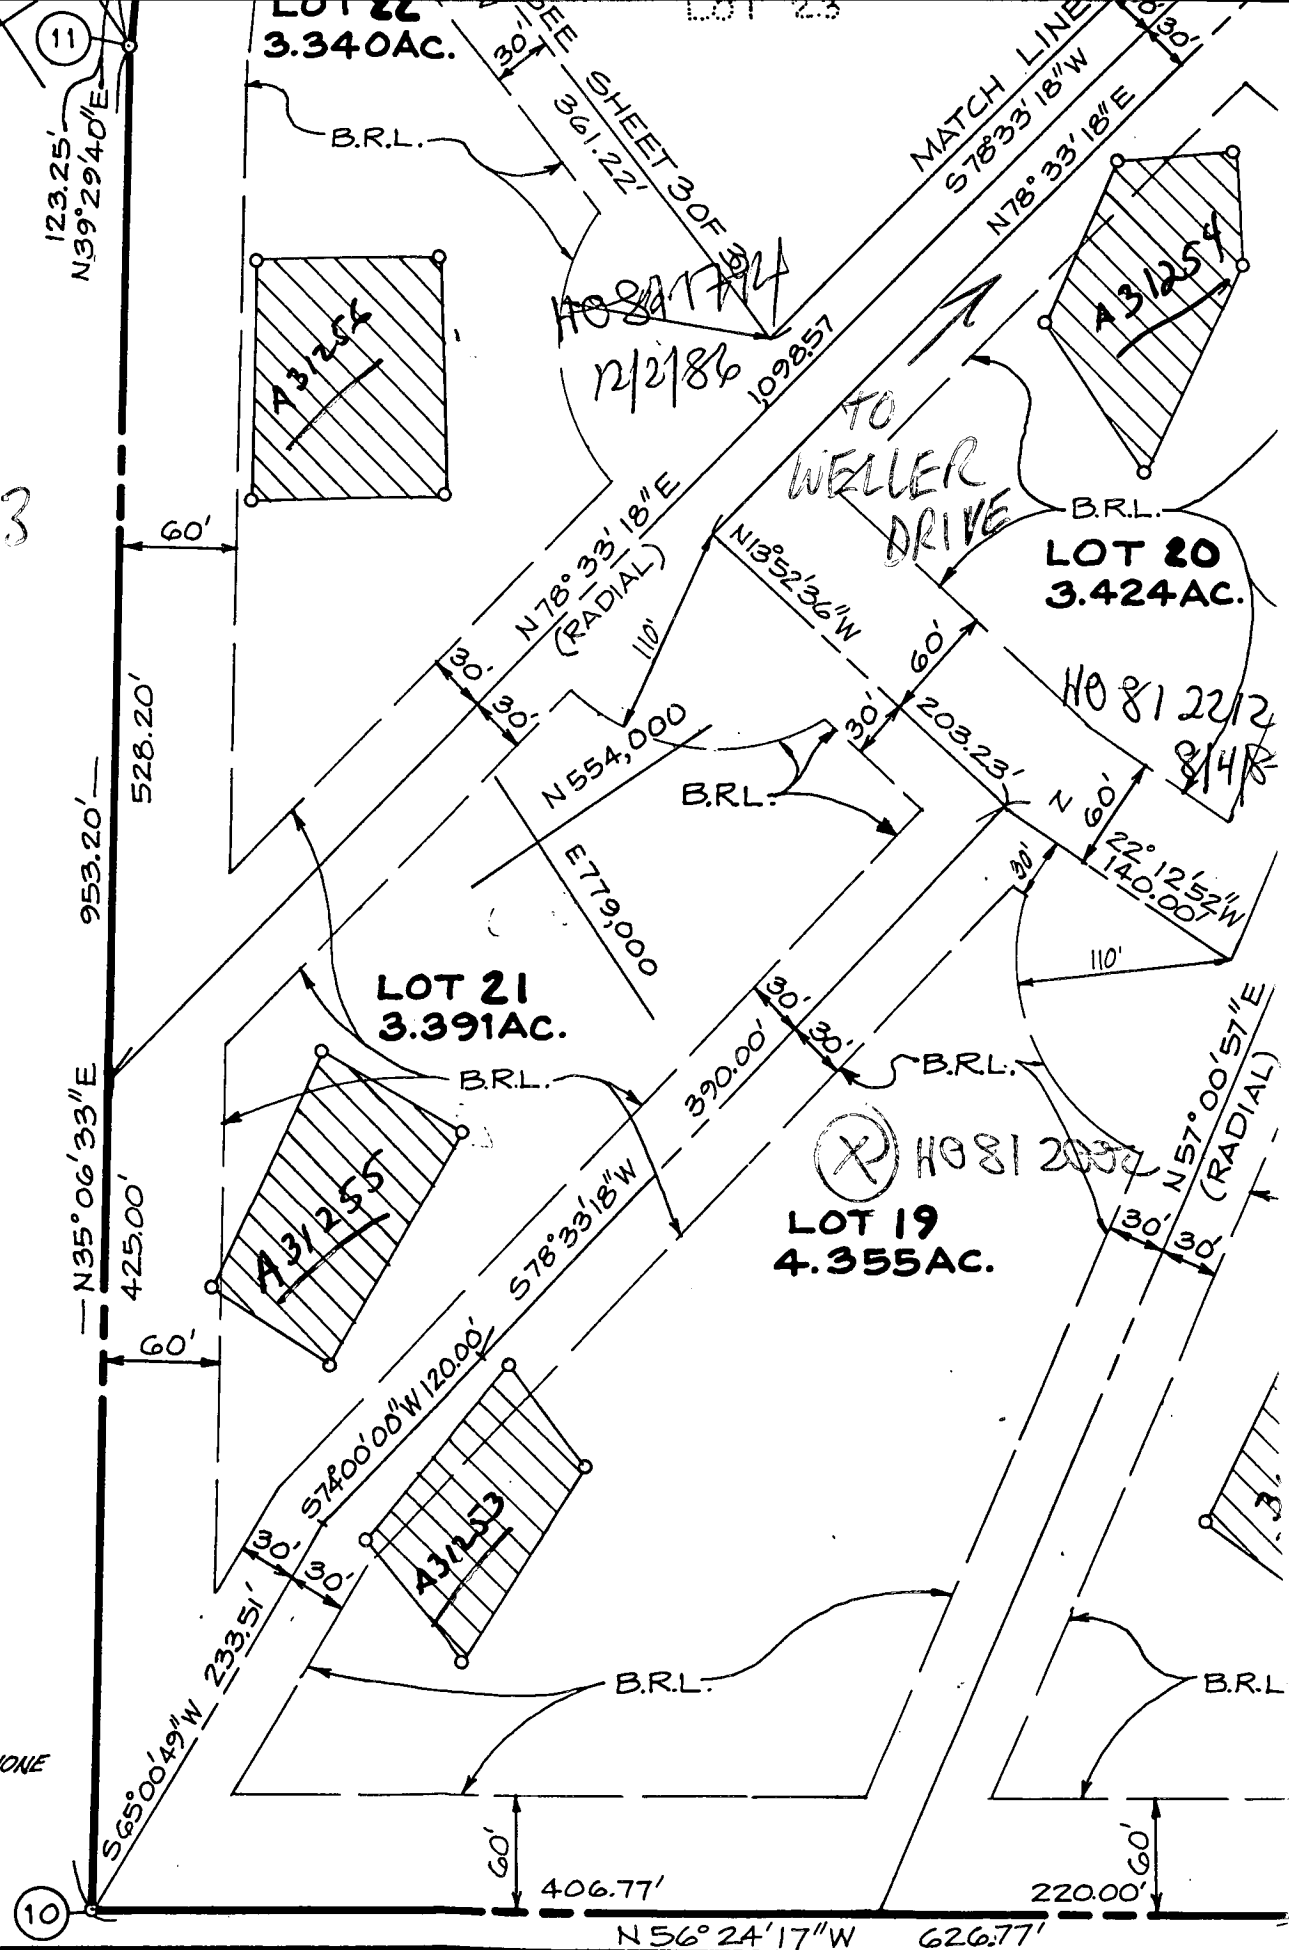

OWNERS STATEMENT

PRIVATE
ALTH


WE, GEORGIA AVENUE PROPERTIES INC. A MARYLAND CORPORATION BY: E. BROOKE LEE
PRESIDENT AND E. BROOKE LEE III, TREASURER, OWNERS OF THE
PROPERTY SHOWN AND DESCRIBED HEREON, HEREBY ADOPT THIS PLAN OF
SUBDIVISION AND IN CONSIDERATION OF THE APPROVAL OF THE BOARD OF

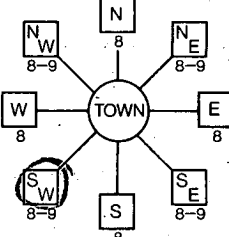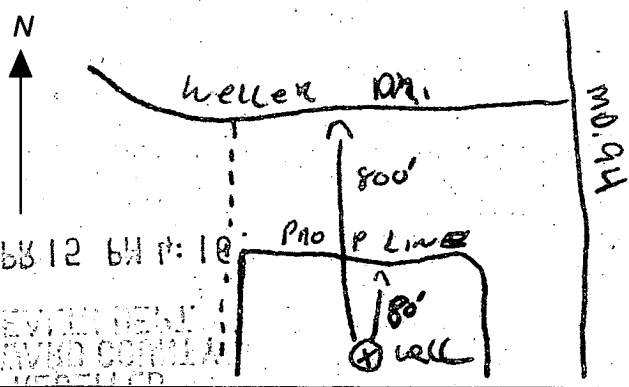B 1 00226 (THIS NUMBER IS TO BE PUNCHED IN COLS. 3-6 ON ALL CARDS)	SEQUENCE NO. (DP USE ONLY)	STATE OF MARYLAND APPLICATION FOR PERMIT TO DRILL WELL please print or type	STATE PERMIT NUMBER H0-92-0342 fill in this form completely
Date Received (APA) 04/16/93		B 3 LOCATION OF WELL	
OWNER INFORMATION MARSH ROBERT H. 16113 PATASCOP OVER MT AIRY MD 21721		HOWARD 8 COUNTY 23 SUBDIVISION SECTION 2 LOT 21 WOODBINE 52 NEAREST TOWN MILES FROM TOWN (enter 0 if in town) 1 MI	
DRILLER INFORMATION Ralph MAYNE 253 77 License No. 80 Ralph MAYNE Well Drilling 9120 Brown Church Rd. Mt. Airy Address Ralph Mayne 4/10/93 Signature Date		B 4 DIRECTION OF WELL FROM TOWN (CIRCLE BOX) 	
WELL INFORMATION APPROX. PUMPING RATE (GAL. PER MIN.) 5 AVERAGE DAILY QUANTITY NEEDED (GAL. PER DAY) 500		LOCATION OF WELL WELLS DR. NEAR WHAT ROAD ON WHICH SIDE OF ROAD (CIRCLE APPROPRIATE BOX) NORTH WEST EAST SOUTH 34 800 37 DISTANCE FROM ROAD ENTER FT or MI 1/4	
USE FOR WATER (CIRCLE APPROPRIATE BOX) ☒ HOME (SINGLE OR DOUBLE HOUSEHOLD UNIT ONLY) ☐ FARMING (LIVESTOCK WATERING & AGRICULTURAL IRRIGATION) ☐ INDUSTRIAL, COMMERCIAL, STATE AND FEDERAL GOV. OTHER (REQUIRES APPROPRIATION PERMIT) ☐ PUBLIC OR PRIVATE WATER COMPANY (REQUIRES APPROPRIATION PERMIT AND STATE HEALTH DEPARTMENT APPROVAL) ☐ TEST, OBSERVATION, MONITORING (MAY REQUIRE APPROPRIATION PERMIT)		NOT TO BE FILLED IN BY DRILLER HEALTH DEPARTMENT APPROVAL HOWARD COUNTY NAME A# 31255 COUNTY NO. STATE SIGNATURE DATE ISSUED 04/22/93 CO SIGNATURE Charles B. [Signature] EXP. DATE 4/22/94 NORTH GRID 553000 EAST GRID 0779000	
APPROXIMATE DEPTH OF WELL 150 FEET APPROXIMATE DIAMETER OF WELL 6" NEAREST INCH		SHOW MAJOR FEATURES OF BOX & LOCATE WELL WITH AN X SOURCES OF DRILLING WATER 1. well 2. 3. WRITE THE BOX NUMBER FROM THE MAP HERE E 7709 N 5503	
METHOD OF DRILLING (circle one) BORED (or Augered) JETTED Jetted & DRIVEN AIR-ROTARY AIR-PERCussion ROTARY (Hydraulic Rotary) CABLE REVERSE-ROTARY Drive-POINT other		DRAW A SKETCH BELOW SHOWING LOCATION OF WELL IN RELATION TO NEARBY TOWNS AND ROADS AND GIVE DISTANCE FROM WELL TO NEAREST ROAD JUNCTION 	
REPLACEMENT OR DEEPEMED WELLS (CIRCLE APPROPRIATE BOX) ☒ THIS WELL WILL NOT REPLACE AN EXISTING WELL ☐ THIS WELL WILL REPLACE A WELL THAT WILL BE ABANDONED AND SEALED ☐ THIS WELL WILL REPLACE A WELL THAT WILL BE USED AS A STANDBY ☐ THIS WELL WILL DEEPEMED AN EXISTING WELL PERMIT NUMBER OF WELL TO BE REPLACED OR DEEPEMED (IF AVAILABLE)		Not to be filled in by driller (OEP USE ONLY) APPROX. PERMIT NUMBER FORCE 1/2 WRITE INITIALS IN BOX PERMIT No. H0-92-0342 SPECIAL CONDITIONS 489-3650	

Mr Robert Marsh

NOTE:

B.R.L. INDICATES
BUILDING RESTRICTION LINES.

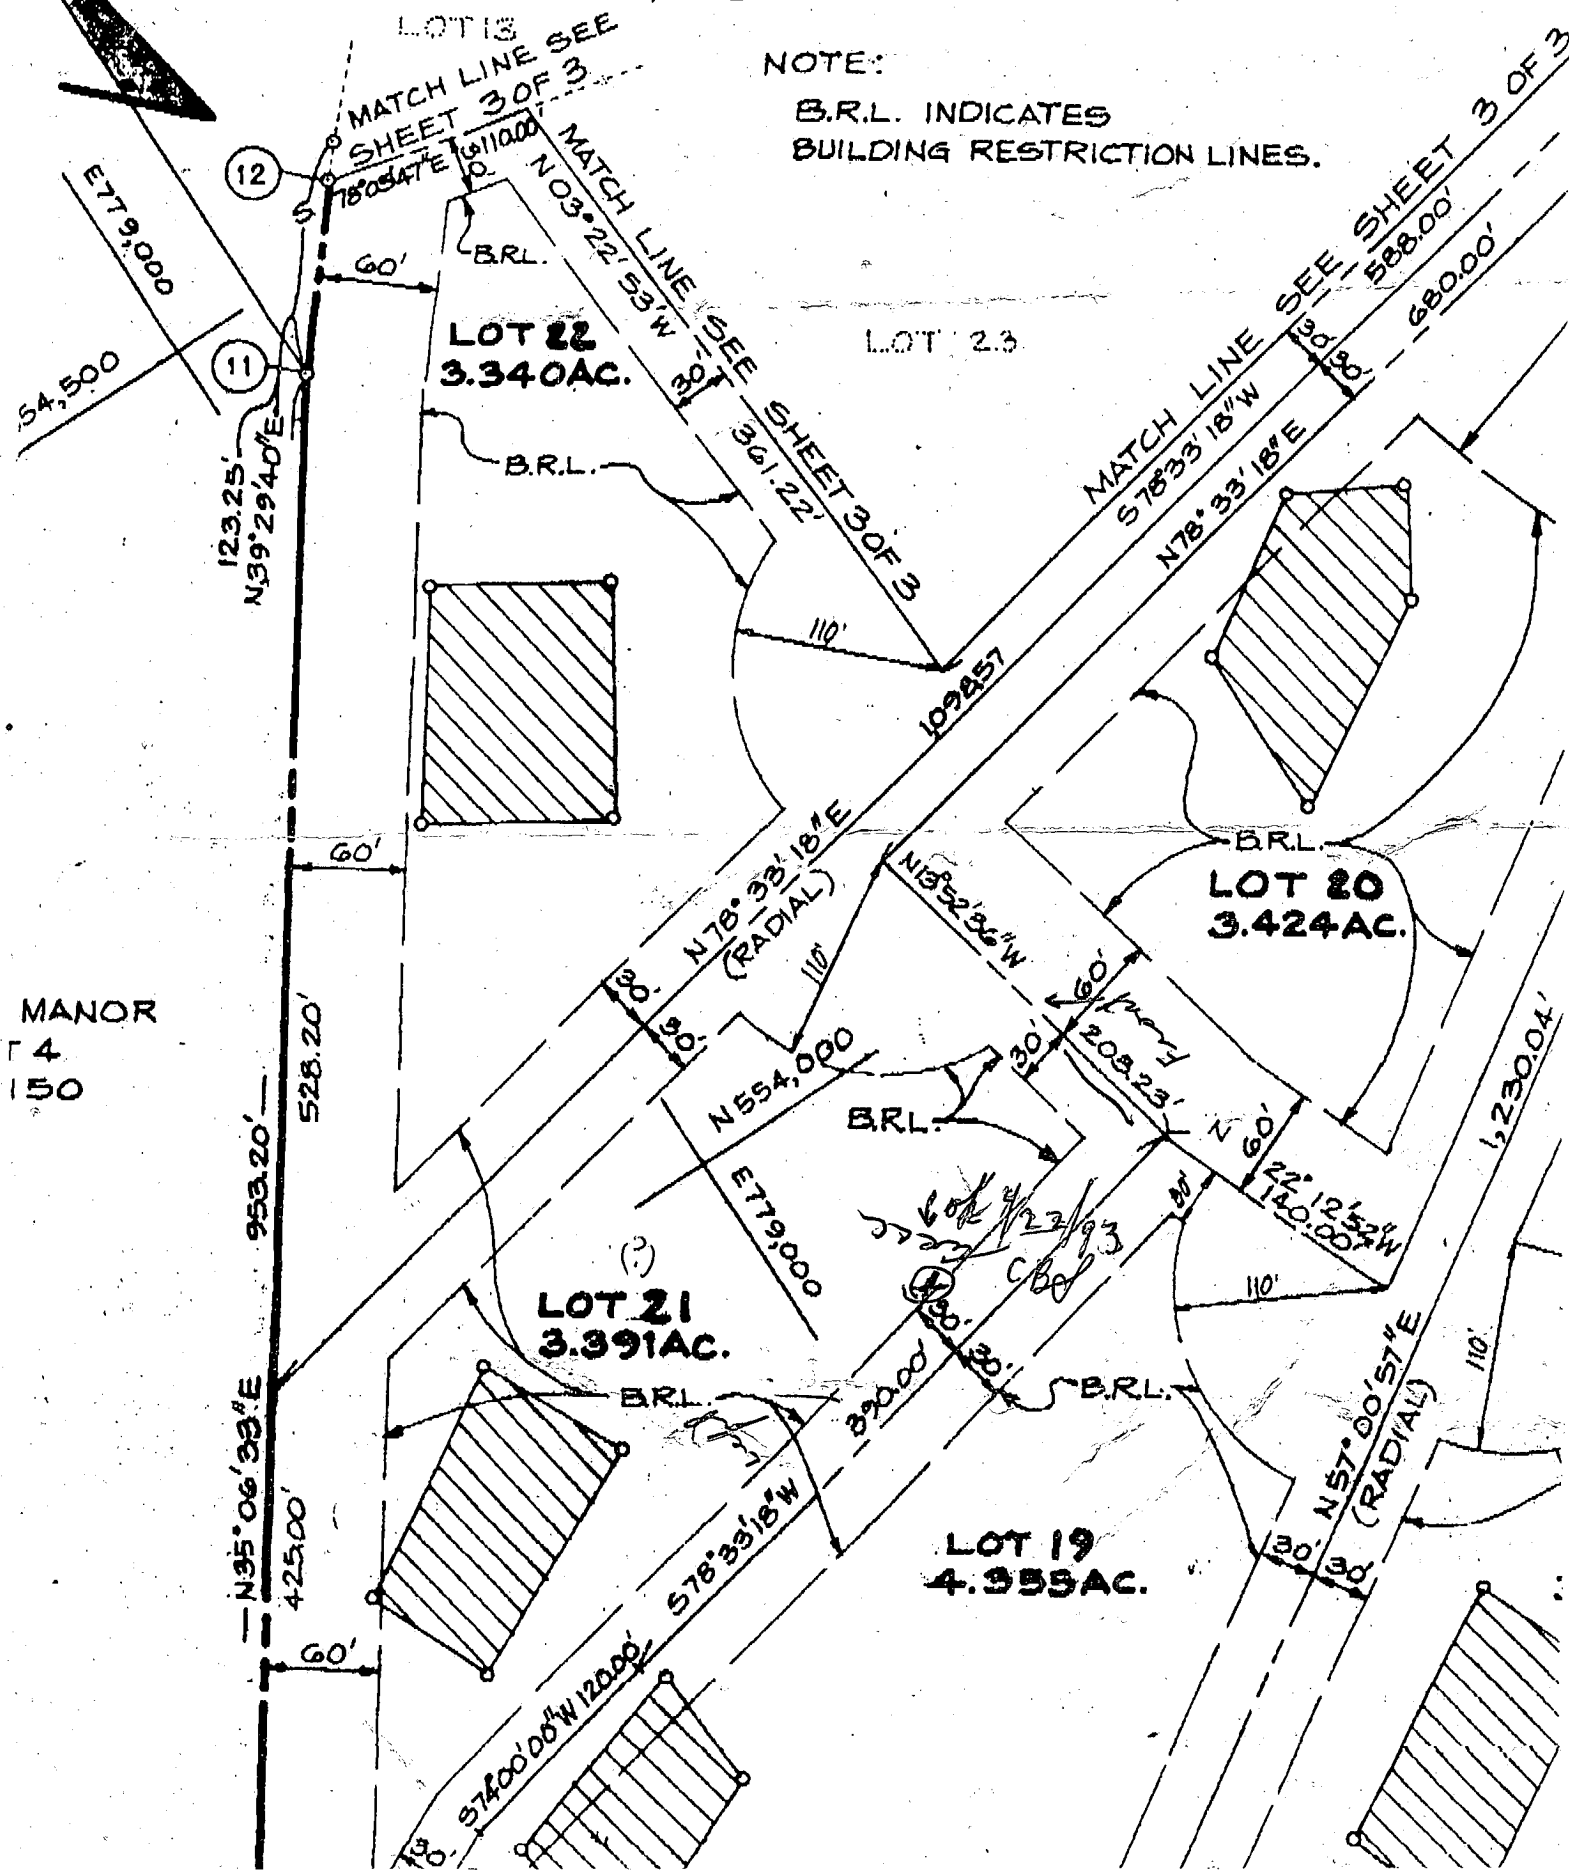

FIELD DATA SHEET
HOWARD COUNTY WELL YIELD TEST

Well Permit No. HO - 92-0342
Location of property (road) WELLEN DR.
Subdivision PAT APS CO OVER LOUIS Lot 21 Block — Plat — Sec. —
Well Driller RALPH MAYNE Owner MARSH, Robert

Depth of well 225'
Distance of measuring point (M.P.) above ground 217
Static water level (S.W.L.) below M.P. 427

I. High rate pumping -- reservoir drawdown

Time pump started 8:30 Pumping rate 12.6 gpm
Total time 15 min to reach pumping water level 136 ft. below M.P.

II. Recovery pump test data - observations to be recorded every 15 minutes

[illegible]