

12/15/80
30 A-M

03-290956

PERMIT

SEWAGE DISPOSAL SYSTEM

MARYLAND STATE DEPARTMENT OF HEALTH

HOWARD COUNTY

P 31058

A Repair

NOT APPROVED

12/2/80 FS/CW

ELLICOTT CITY

DISTRICT 3rd

DATE 12/2/80

NO WORK PERFORMED AS OF 7/17/95
ONLY KNOWN RECORD
FOR EXISTING HOUSE
INDEX AS NOT APPROVED

INDEXED

Bud Arnold

IS PERMITTED TO INSTALL ALTER X

ADDRESS Jacobs Road, Mt. Airy, Maryland 21771 PHONE 795-7873

SUBDIVISION ROAD 1461 1466 Woodstock Road LOT

PROPERTY OWNER David Mayne

ADDRESS 1466 Woodstock Road, Woodstock, Md. 21163 Phone: 465-3097

SPECIFICATIONS

SEPTIC TANK CAPACITY GALLONS

DRAIN FIELD DEPTH FEET, BOTTOM AREA SQ. FT.

DEEP TRENCH DEPTH FEET, BOTTOM AREA SQ. FT.

SEEPAGE PITS ABSORBENT SIDE-WALL AREA SQ. FT.

INLET PIPE FT. BELOW ORIGINAL GRADE. MAXIMUM DEPTH FT. BELOW ORIGINAL GRADE

EFFECTIVE DEPTH AT FT. BELOW ORIGINAL GRADE.

LOCATE DISPOSAL AREA FT. FROM LOT LINE AND FT. FROM LOT LINE AS SEEN WHEN FACING LOT FROM

REPAIR - Call for an appointment when ground is opened up and Sanitarian will recommend the repair system.

PLANS APPROVED BY Palmer F. Wine DATE 12/2/80

COVER NO WORK UNTIL INSPECTED AND APPROVED.

NEITHER THE HOWARD COUNTY COUNCIL NOR THE HEALTH DEPARTMENT IS RESPONSIBLE FOR THE SUCCESSFUL OPERATION OF ANY SYSTEM.

NOTE: IF TRENCH IS USED CALL FOR INSPECTION BEFORE PLACING GRAVEL IN TRENCH.

NOTE: NO DRY WELL SHALL EXCEED 15 FOOT IN DIAMETER.


NOTE: ALL PIPE FROM HOUSE TO DISPOSAL AREA MUST BE CAST IRON.

PERMIT VOID AFTER THREE YEARS.

NOTE: INSTALL STAND PIPE ON SEPTIC TANK AND DRY WELL. STAND PIPES MUST BE 6 INCHES IN DIAMETER. CAST IRON, CONCRETE OR TERRA COTTA ACCEPTED.

*INSTALLER IS RESPONSIBLE FOR OBTAINING FINAL APPROVAL ON THIS PERMIT.

P 31058

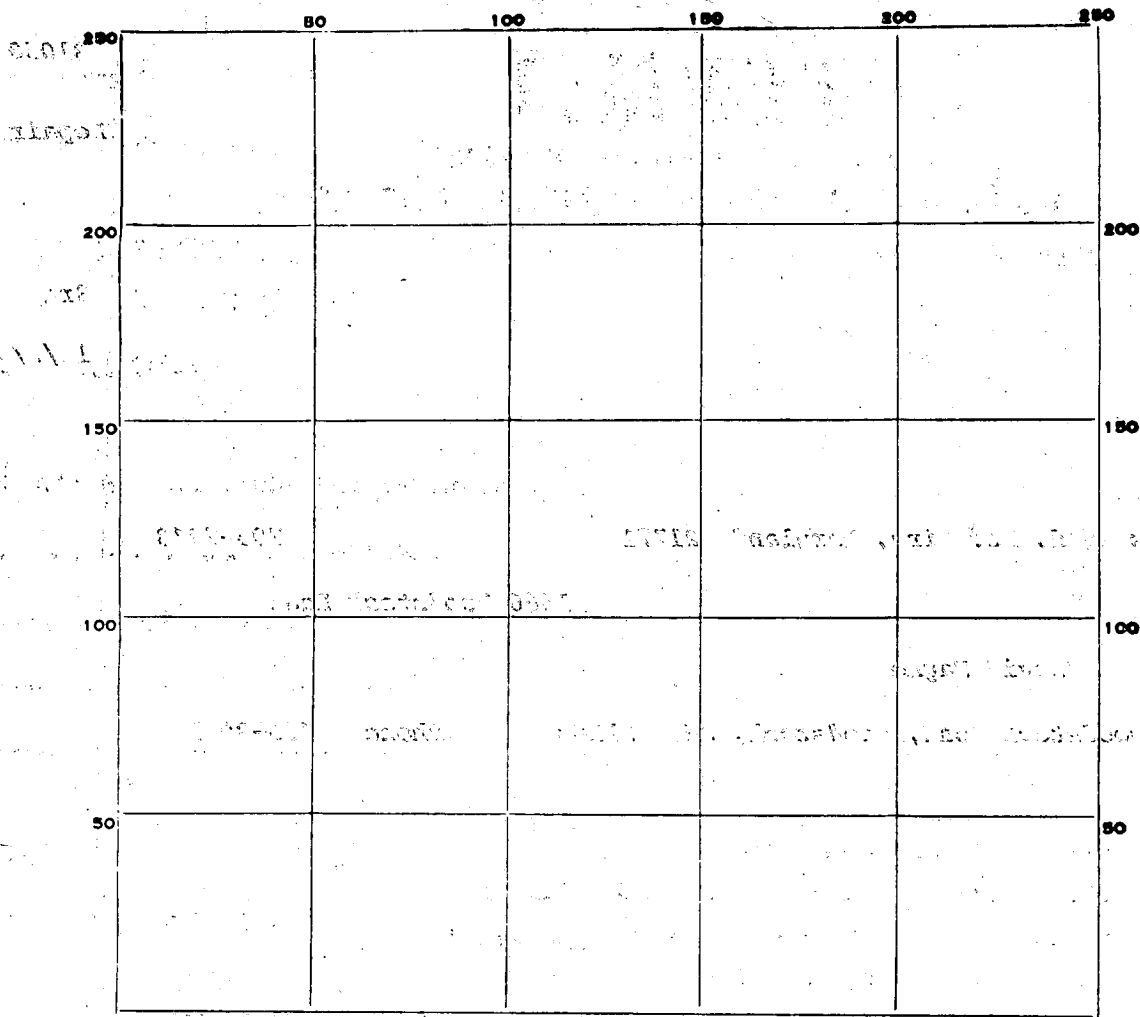

INDICATE NORTH. — NAME ADJOINING ROADWAY AS BASE LINE.

PERMIT CARD _____

SEPTIC TANK, LEVEL _____ CLEANOUTS _____

DISTRIBUTION BOX, LEVEL _____

TILE FIELD, DEPTH _____ FT. TRENCH WIDTH _____ FT.

GRAVEL DEPTH _____ IN. TOTAL LENGTH _____ FT.

NUMBER OF TRENCHES _____ TOTAL BOTTOM AREA _____

SEEPAGE PITS, INSIDE DIAMETER _____ FT. DEPTH BELOW INLET _____ FT.

ABSORBENT AREA _____ SQ. FT.

REMARKS 12/1/80 See

DATE SYSTEM APPROVED _____ INSPECTOR _____

Then The House. I told Mrs Mayne that it would probably fail the perc test. She wants to put in a sealed tank if it fails the perc. There are two sealed tanks across the street: one for the Woodstock Inn & one for a house owned by Carey rented by Plat

12/17/80 - No Sealed Tank allowed per FS

5/22/87 REINSPECT BUD ARNOLD, CW & SA,

PROPERTY BOUNDARIES NOT KNOWN. (200-300') CONSIDERABLE LAND AROUND HOUSE.

ALL APPEARS TOO STEEP FOR WELL OR SEPTIC EXCEPT AREA TO LEFT OF HOUSE WHICH HAS ROCK OUTCROP.

2ND STORY ADDITION ON BACK OF HOUSE, POORLY SUPPORTED. NO PERMIT.

EXISTING PRIVY & HAND DUG WELL IN DISREPAIR. CW,


6/10/87

NO CONTACT FROM PROPERTY OWNER

BOB GEMILL - NOTIFIED OF VIOLATION OF BUILDING CODE, HE WILL INVESTIGATE. CW

3058

VERY STEEP
SLOPE

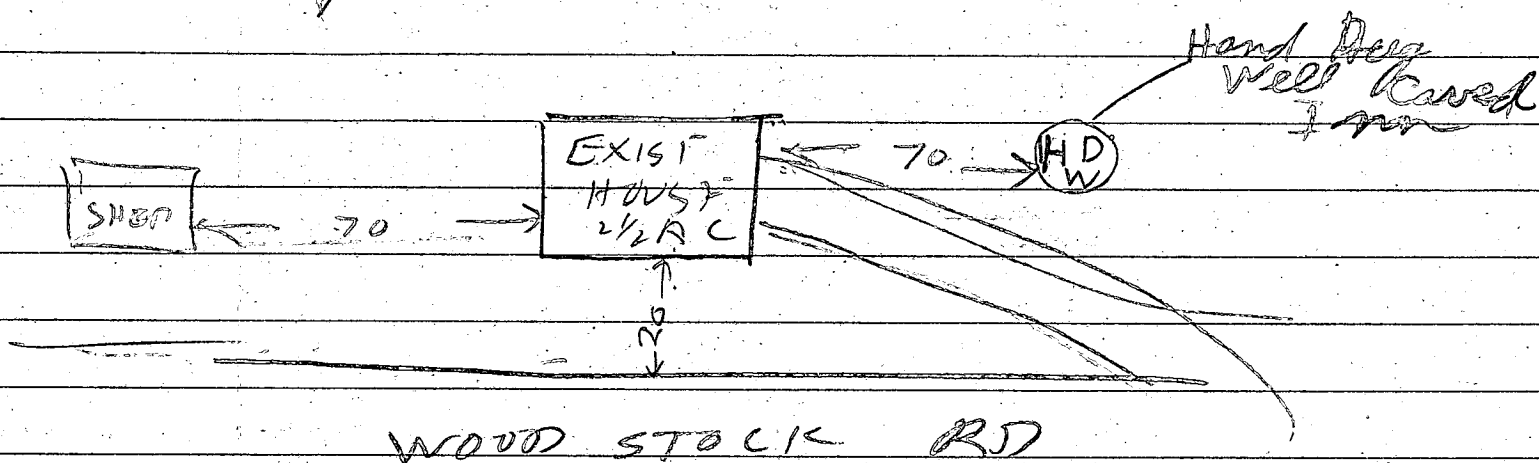

12/15/80 - Visited Site Talked to Bud Arnold
& Mrs Mayme. Bud Arnold did not dig
any holes. House has no septic system
& no well. Hand Dug well Covered. They want both. Grounds is sandy Rocky
with steep slope left in back yard. 2 1/2
ac lot with only a little area on the sides
& in front of the house, that is lower
OVER